


SEWER LINE FROM MH 608 TO 612 TO BE REPLACED INPLACE UNDER EMERGENCY W.O.


CAMPBELL RD NW

PLAN
SCALE: 1"=50'
PROFILE
SCALE: 1"=50' HORIZ.
1"=5' VERT.

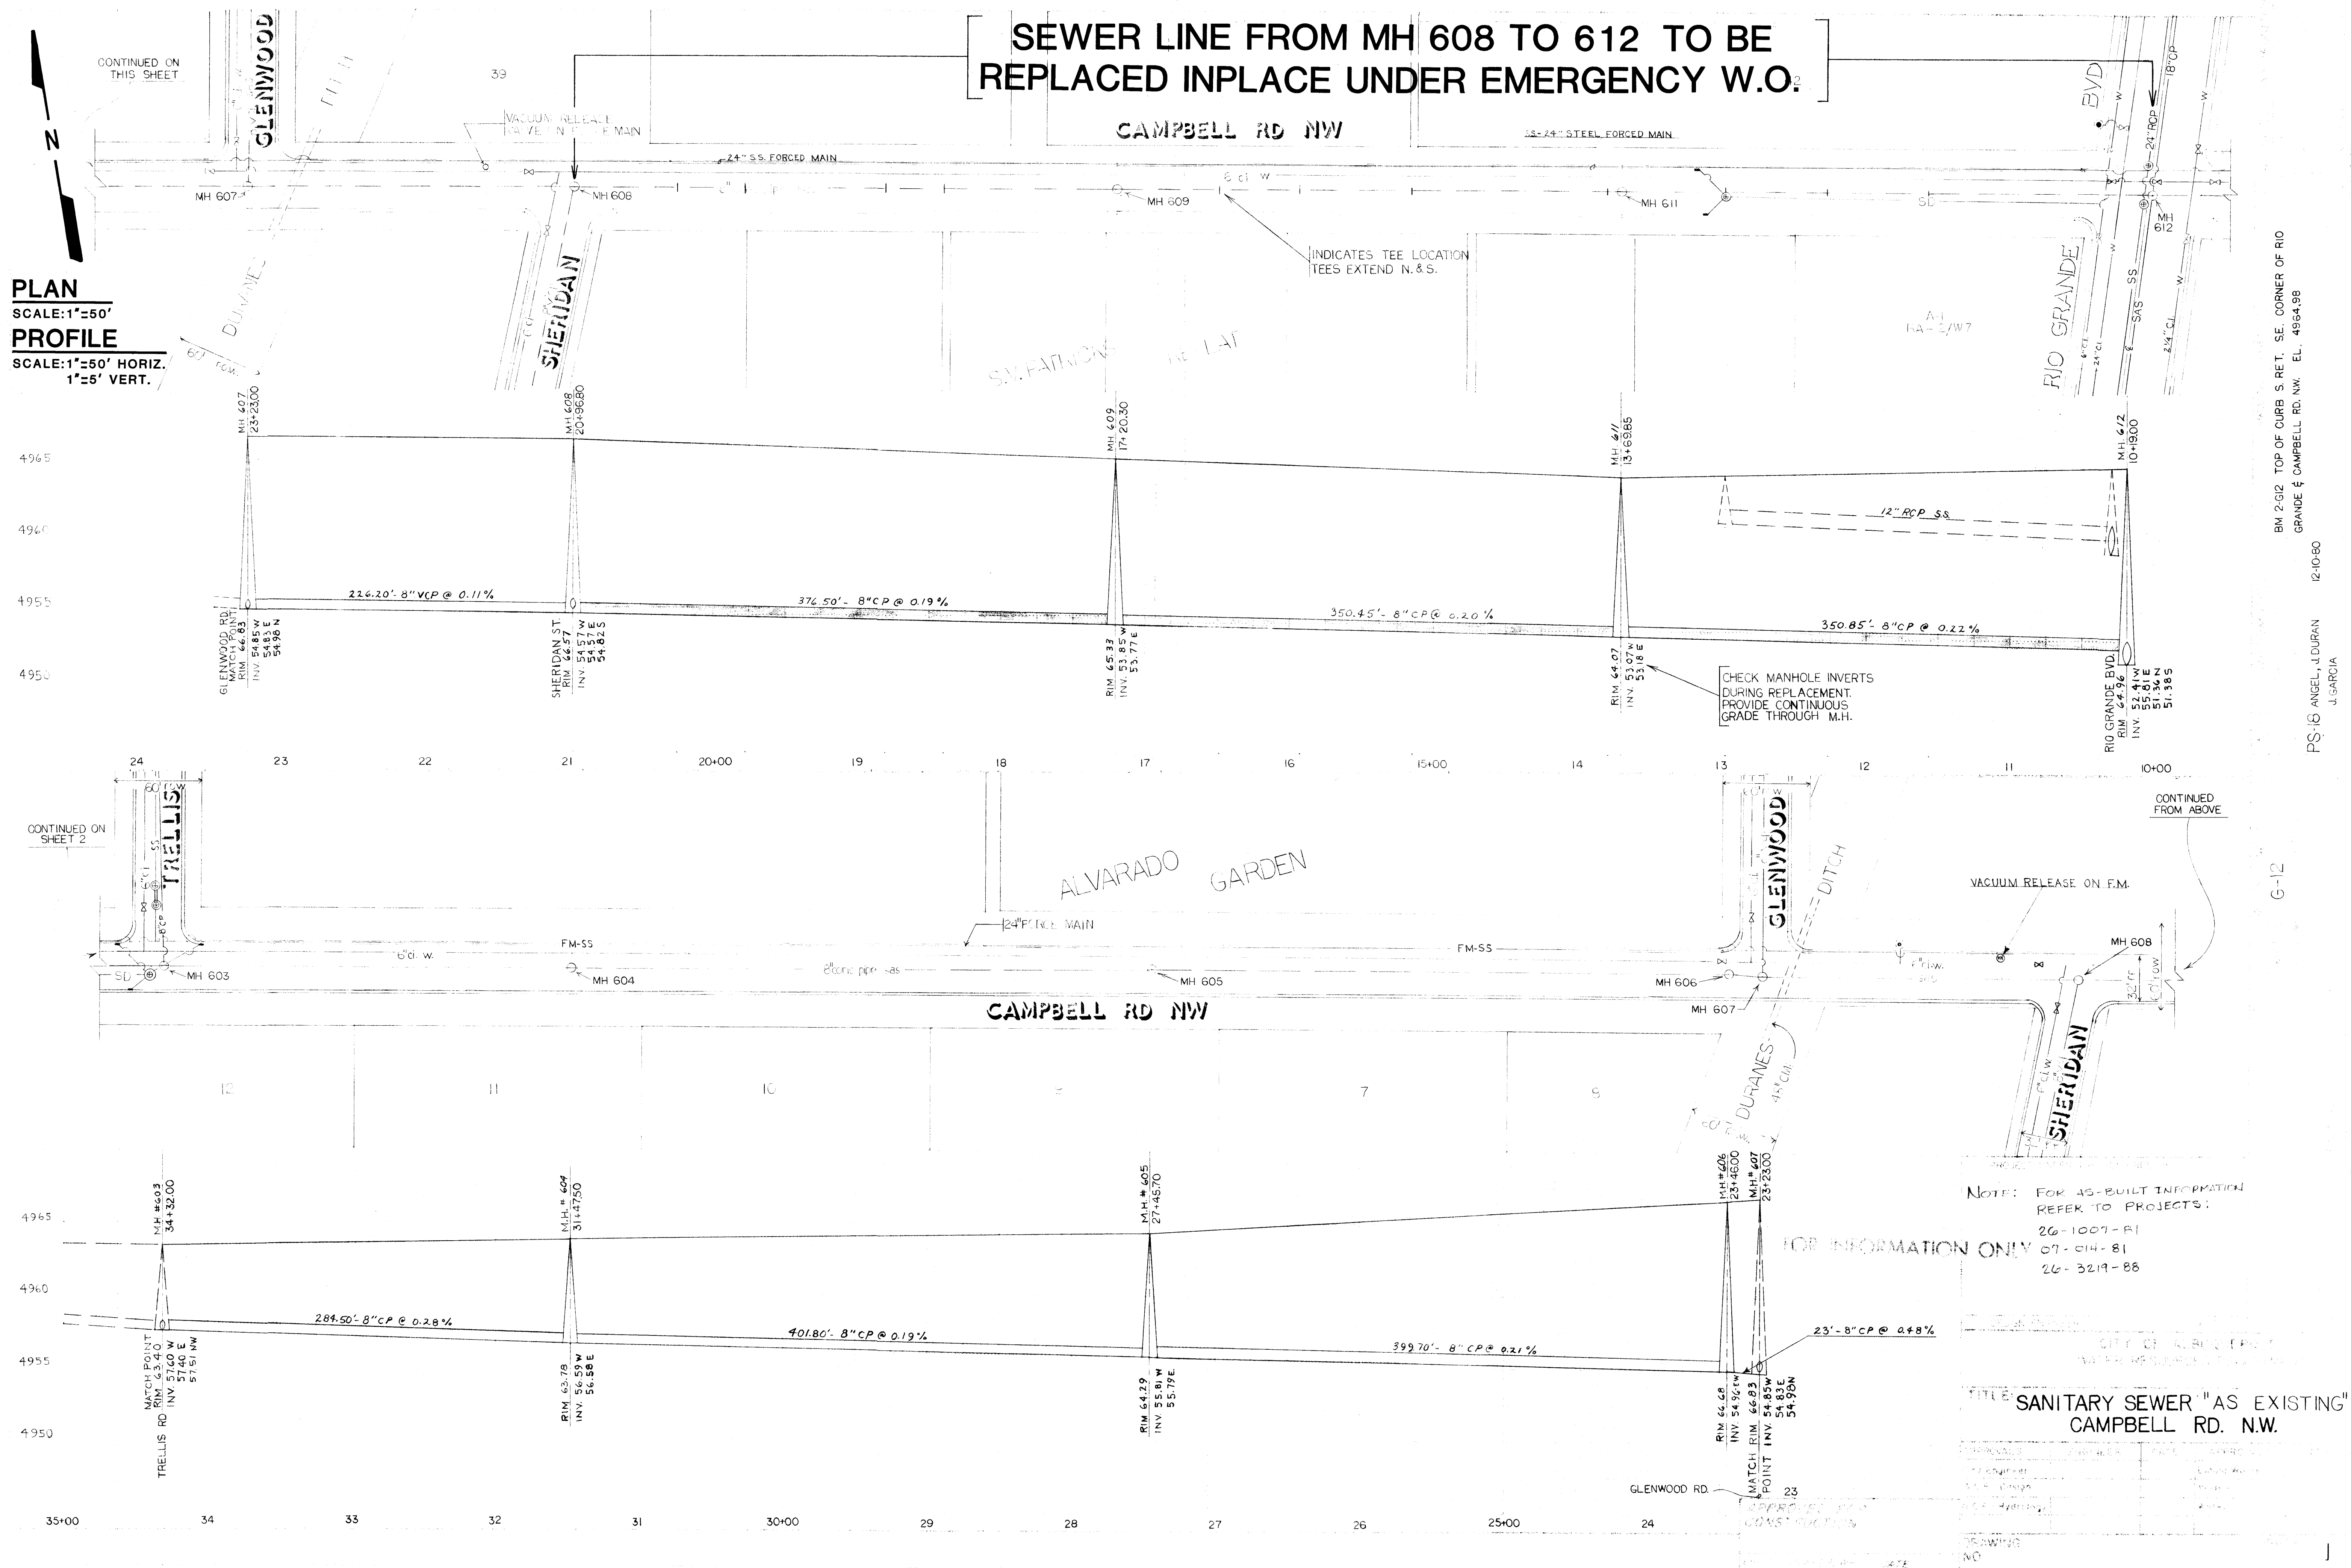


01 01 11 01 18 01

PLAN
SCALE: 1"=50'
PROFILE
SCALE: 1"=50' HORIZ.
1"=5' VERT.

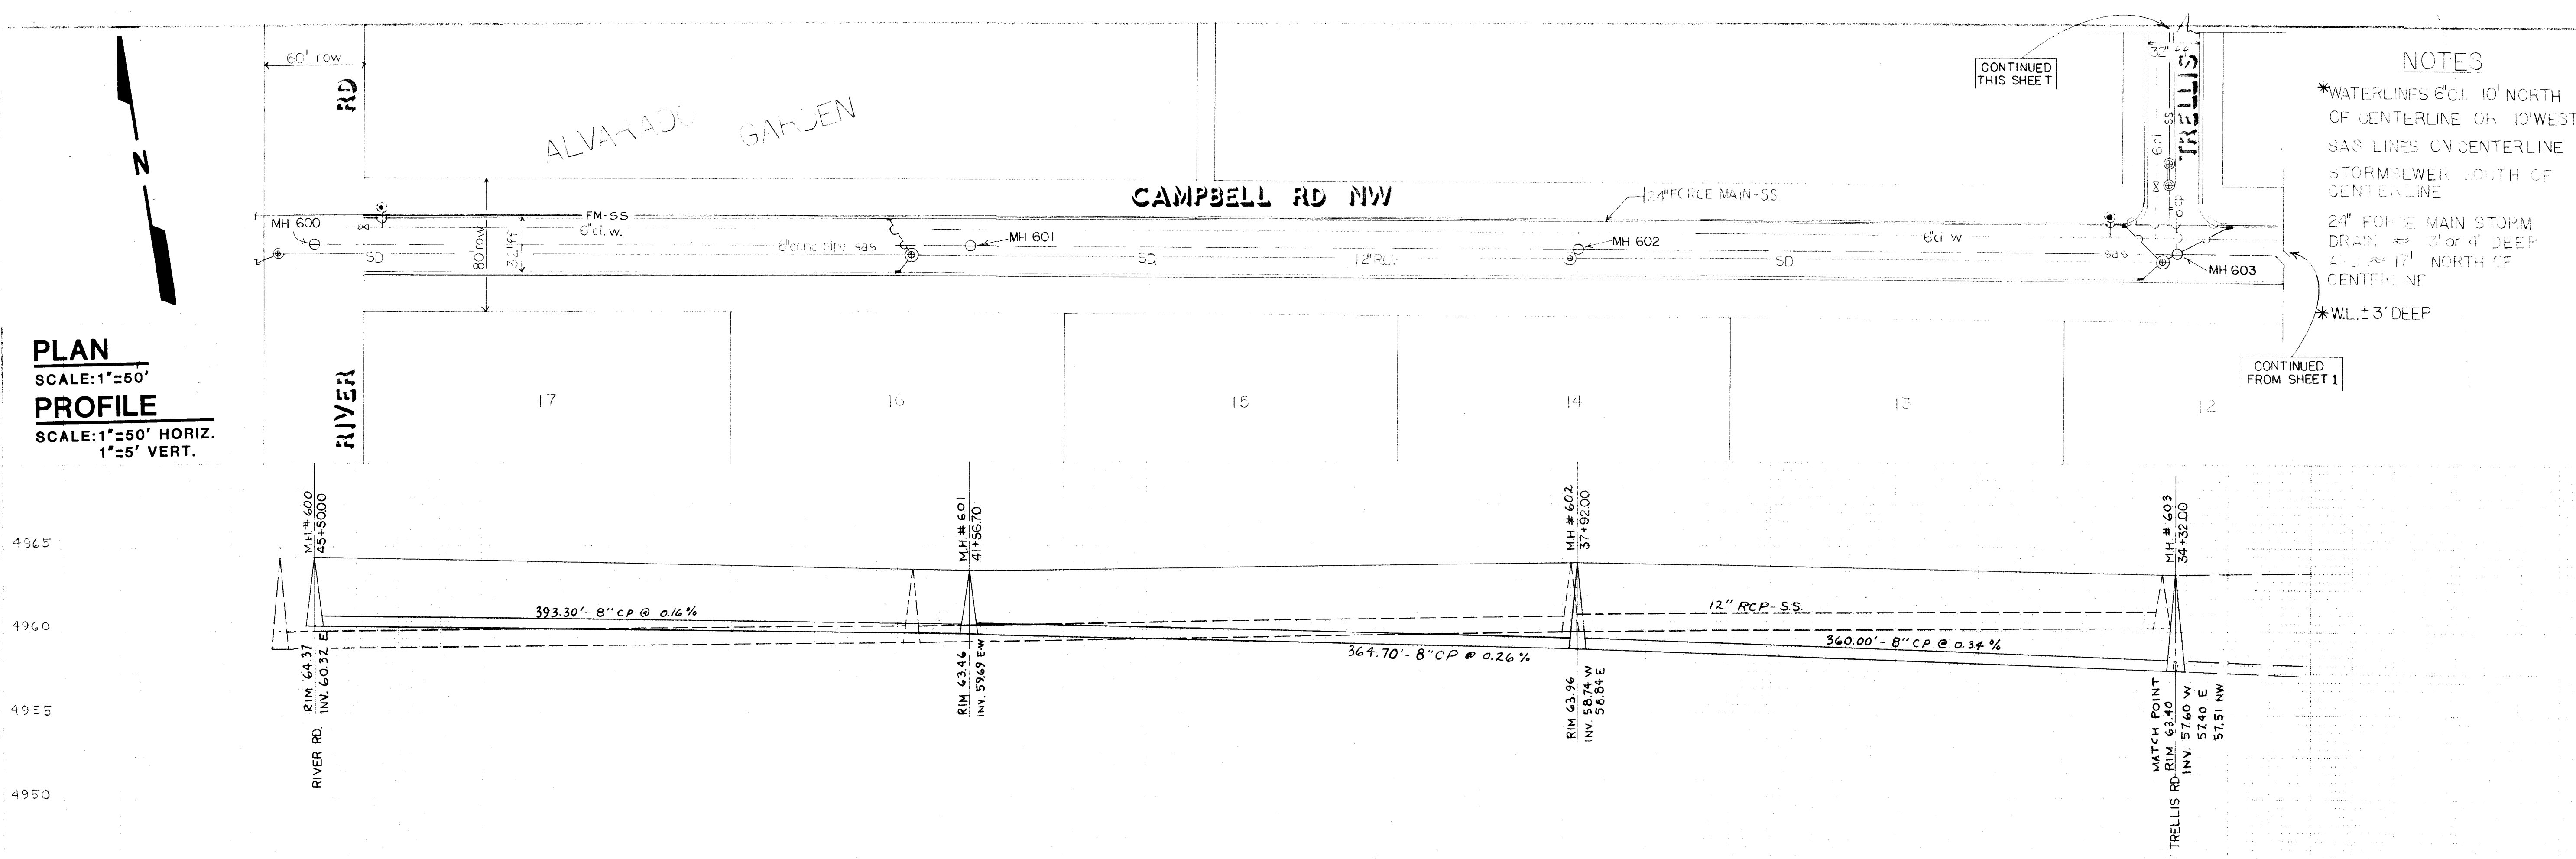

NOTES

- *WATERLINES 6" CL. 10' NORTH OF CENTERLINE OR 10' WEST OF CENTERLINE ON CENTERLINE
- SAS LINES ON CENTERLINE
- STORMSEWER SOUTH OF CENTERLINE
- 24" FORCE MAIN STORM DRAIN 3' or 4' DEEP
- 24" FORCE MAIN STORM DRAIN 17' NORTH OF CENTERLINE
- *WL ± 3' DEEP

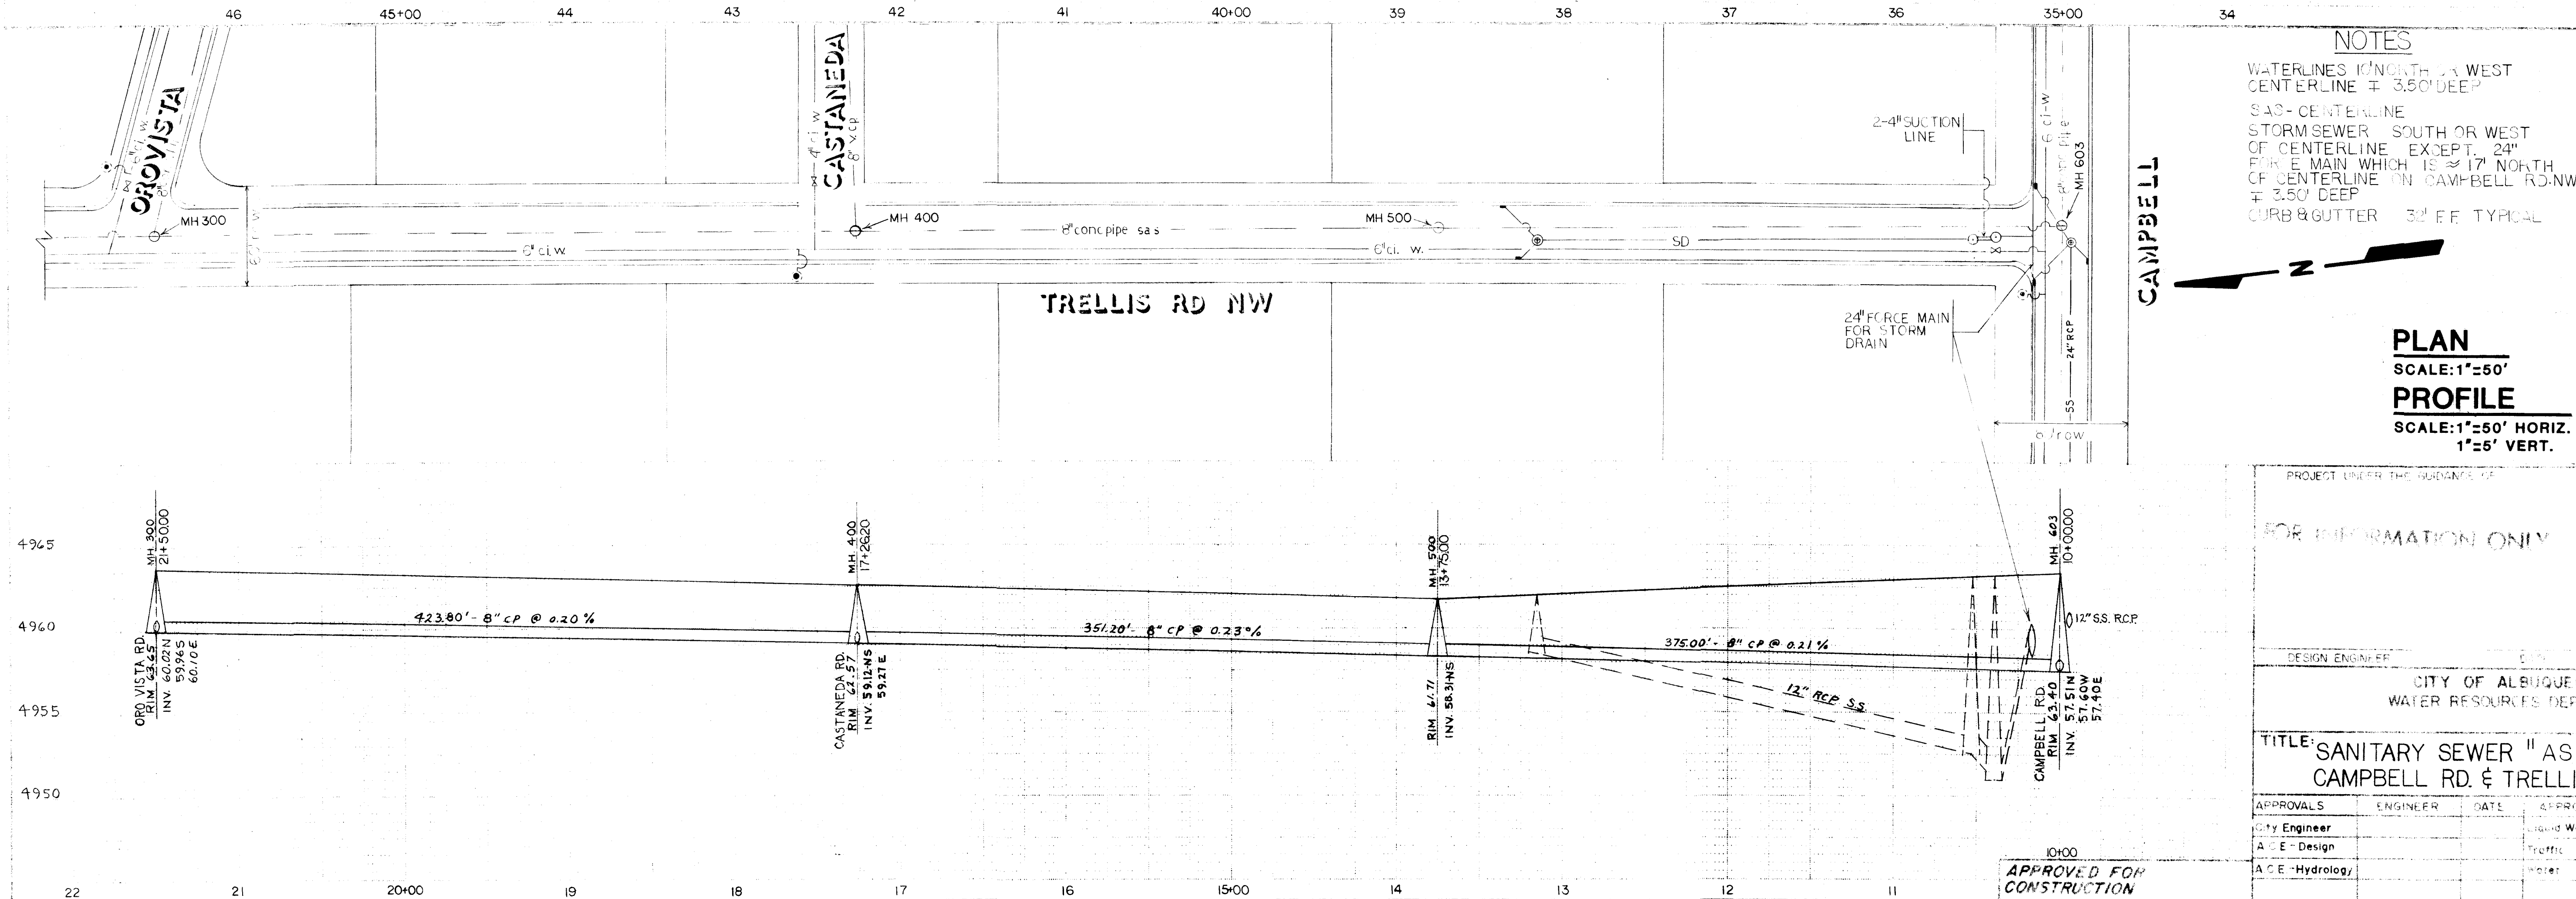

NOTES

- WATERLINES 10' NORTH OR WEST OF CENTERLINE ± 3.50' DEEP
- SAS - CENTERLINE
- STORMSEWER SOUTH OR WEST OF CENTERLINE EXCEPT 24" FORCE MAIN WHICH IS 17' NORTH OF CENTERLINE ON CAMPBELL RD. NW ± 3.50' DEEP
- CURB & GUTTER 30" E.T. TYPICAL

PLAN
SCALE: 1"=50'
PROFILE
SCALE: 1"=50' HORIZ.
1"=5' VERT.

APPROVED FOR CONSTRUCTION

DATE

FOR INFORMATION ONLY

CITY OF ALBUQUERQUE
WATER RESOURCES DEPARTMENT

TITLE: "SANITARY SEWER" AS EXISTING
CAMPBELL RD. & TRELLIS RD. NW.

APPROVALS	ENGINEER	DATE	APPROVALS	DATE
City Engineer			Public Works	
ACE - Design			Traffic	
ACE - Hydrology			Water	

DRAWING NO. SHEET 2 OF 2

07 01 11 01 18 01