
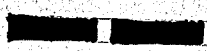


Asphalt Seal Coating '55+56'
~~Asphalt Seal Coating '55+56'~~

CITY OF
ALBUQUERQUE—NEW MEXICO
PLANS
FOR
ASPHALT SEAL COATING
OF
CITY STREETS

-  PATCHED & SEALED 1955
-  PATCHED & SEALED 1956
-  RESURFACED 1956
-  PATCHED ONLY 1956


1	2	3	4	5	6	7	8	9	10	11	12	13	14	15	16	17	18	19	20	21	22	23	24	25	26	27	28	29
10	00	1	0	1	5	5												20										
10	00	1	0	1	5	5												20										

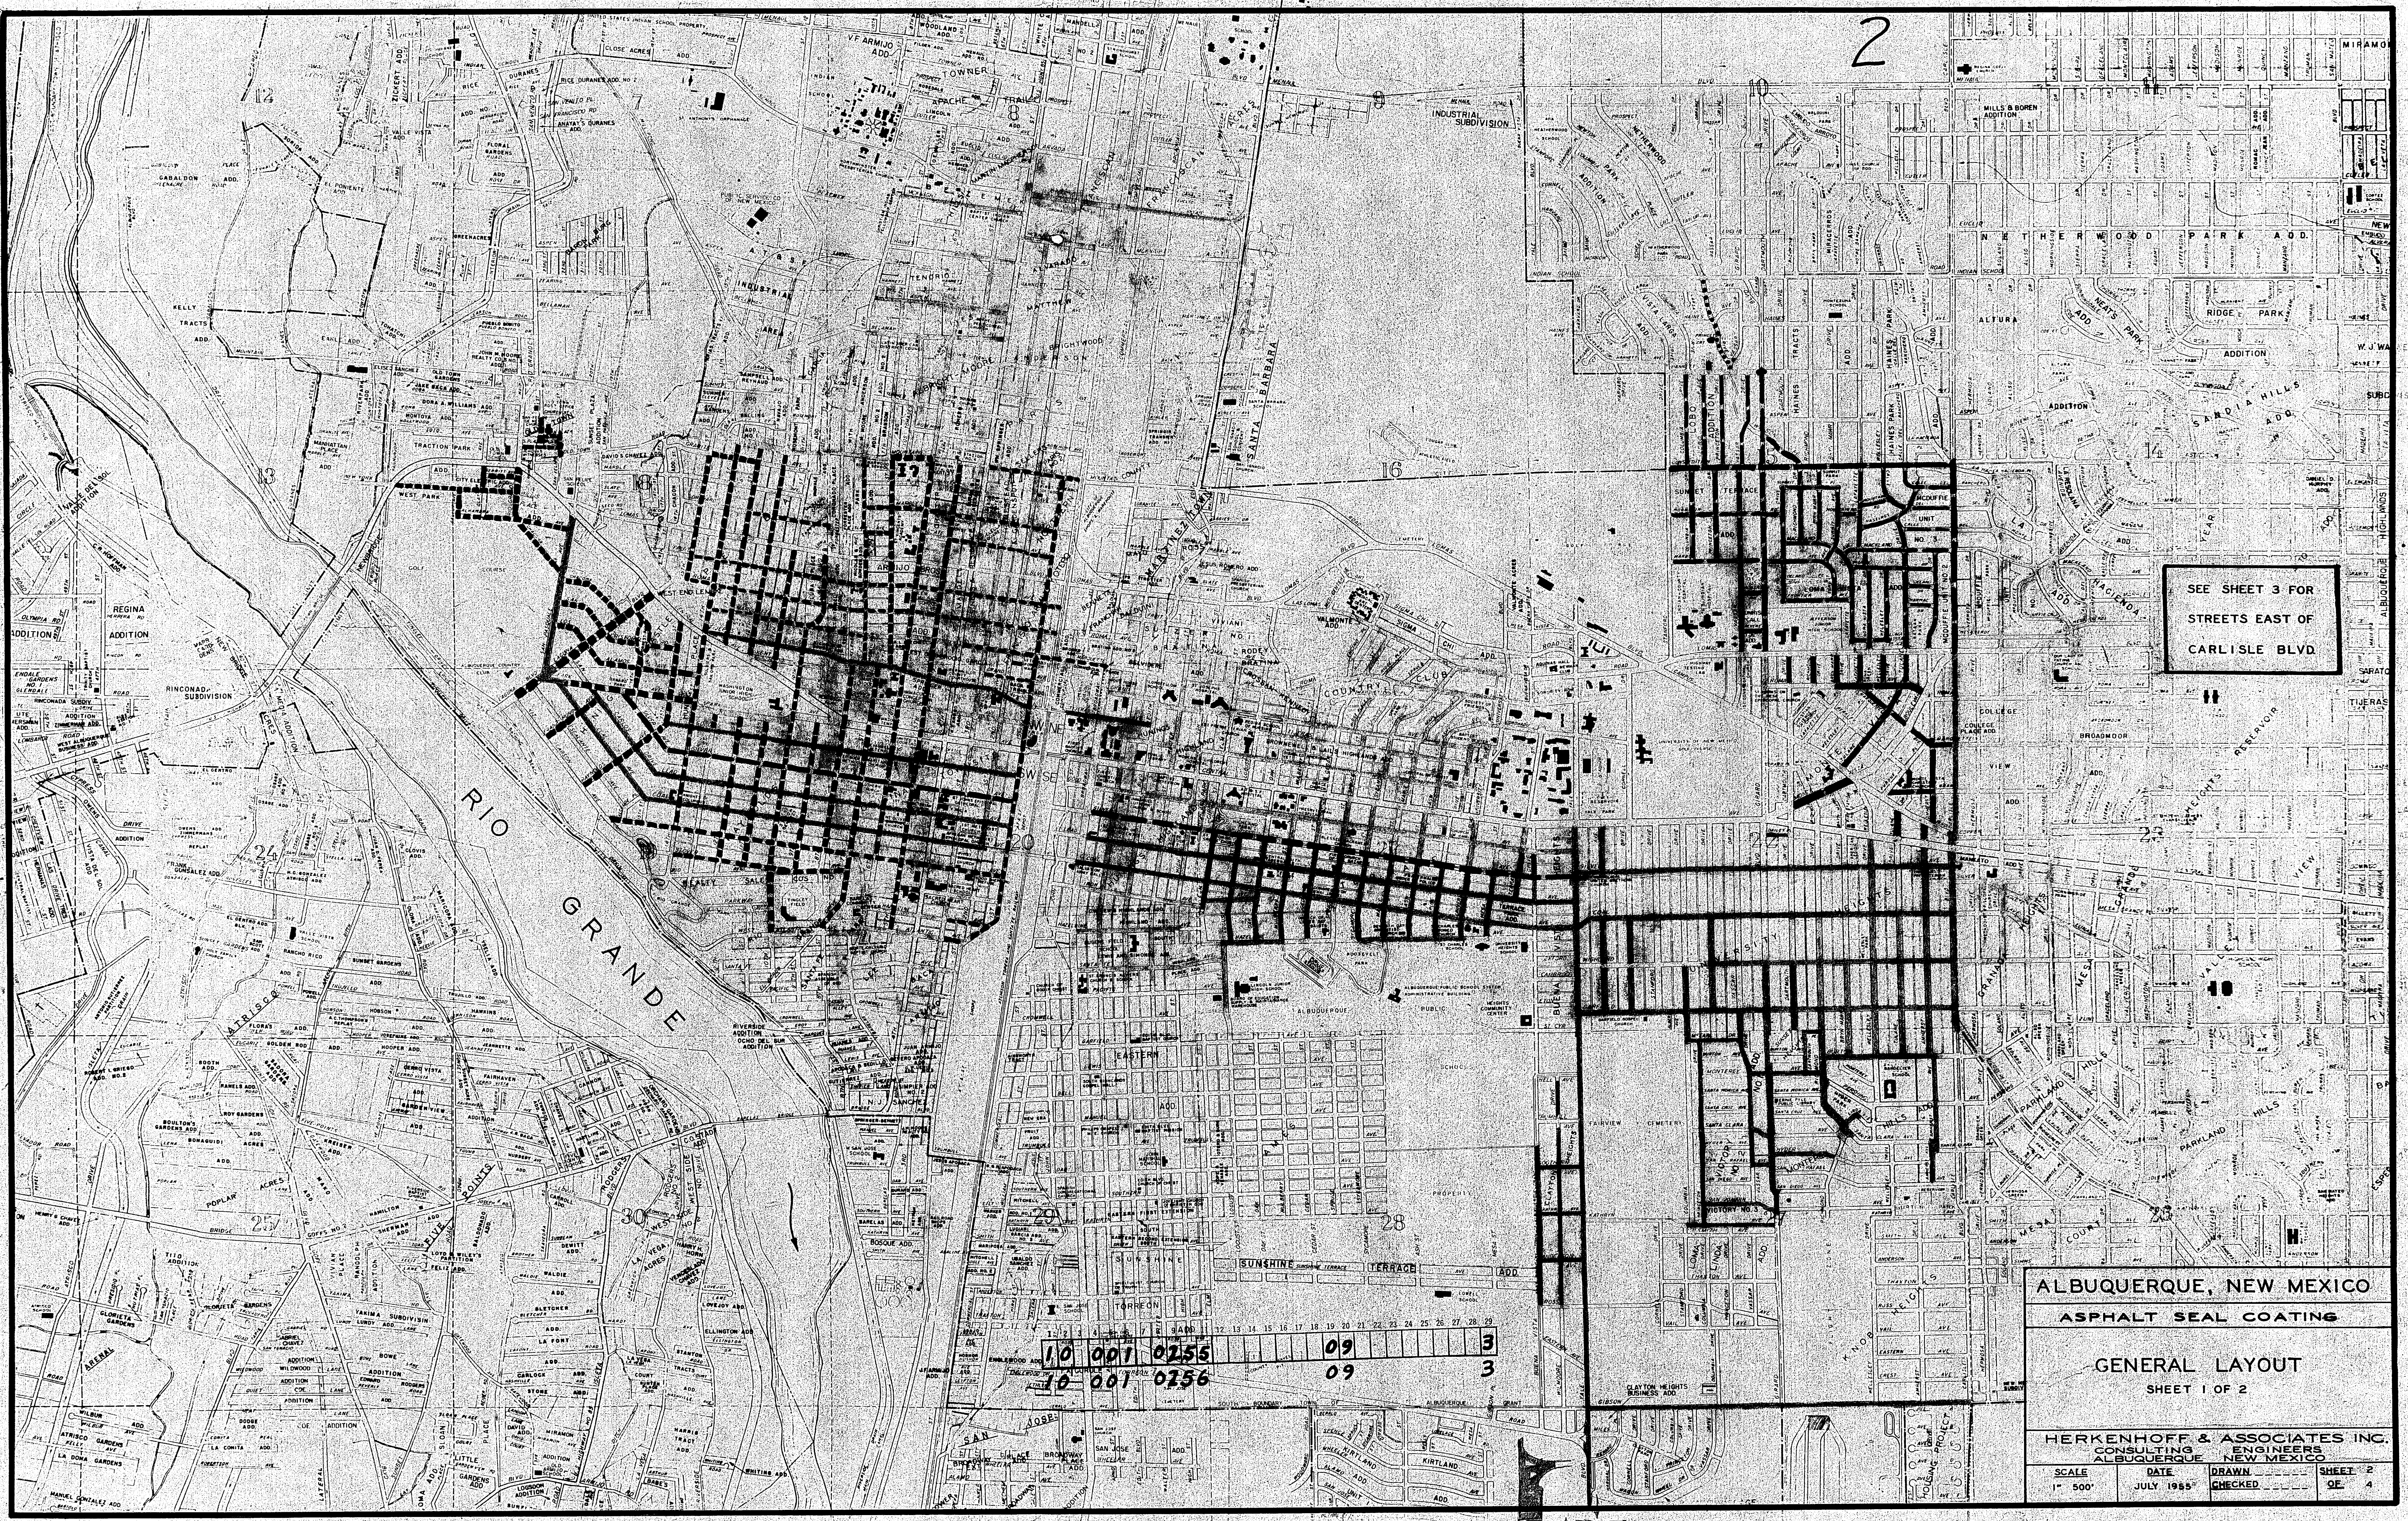

ALBUQUERQUE, NEW MEXICO
ASPHALT SEAL COATING

GENERAL LAYOUT
SHEET 1 OF 2

HERKENHOFF & ASSOCIATES INC. CONSULTING ENGINEERS ALBUQUERQUE, NEW MEXICO		DATE JULY 1955	DRAWN CHECKED	SHEET OF 4
SCALE 1" = 500'				

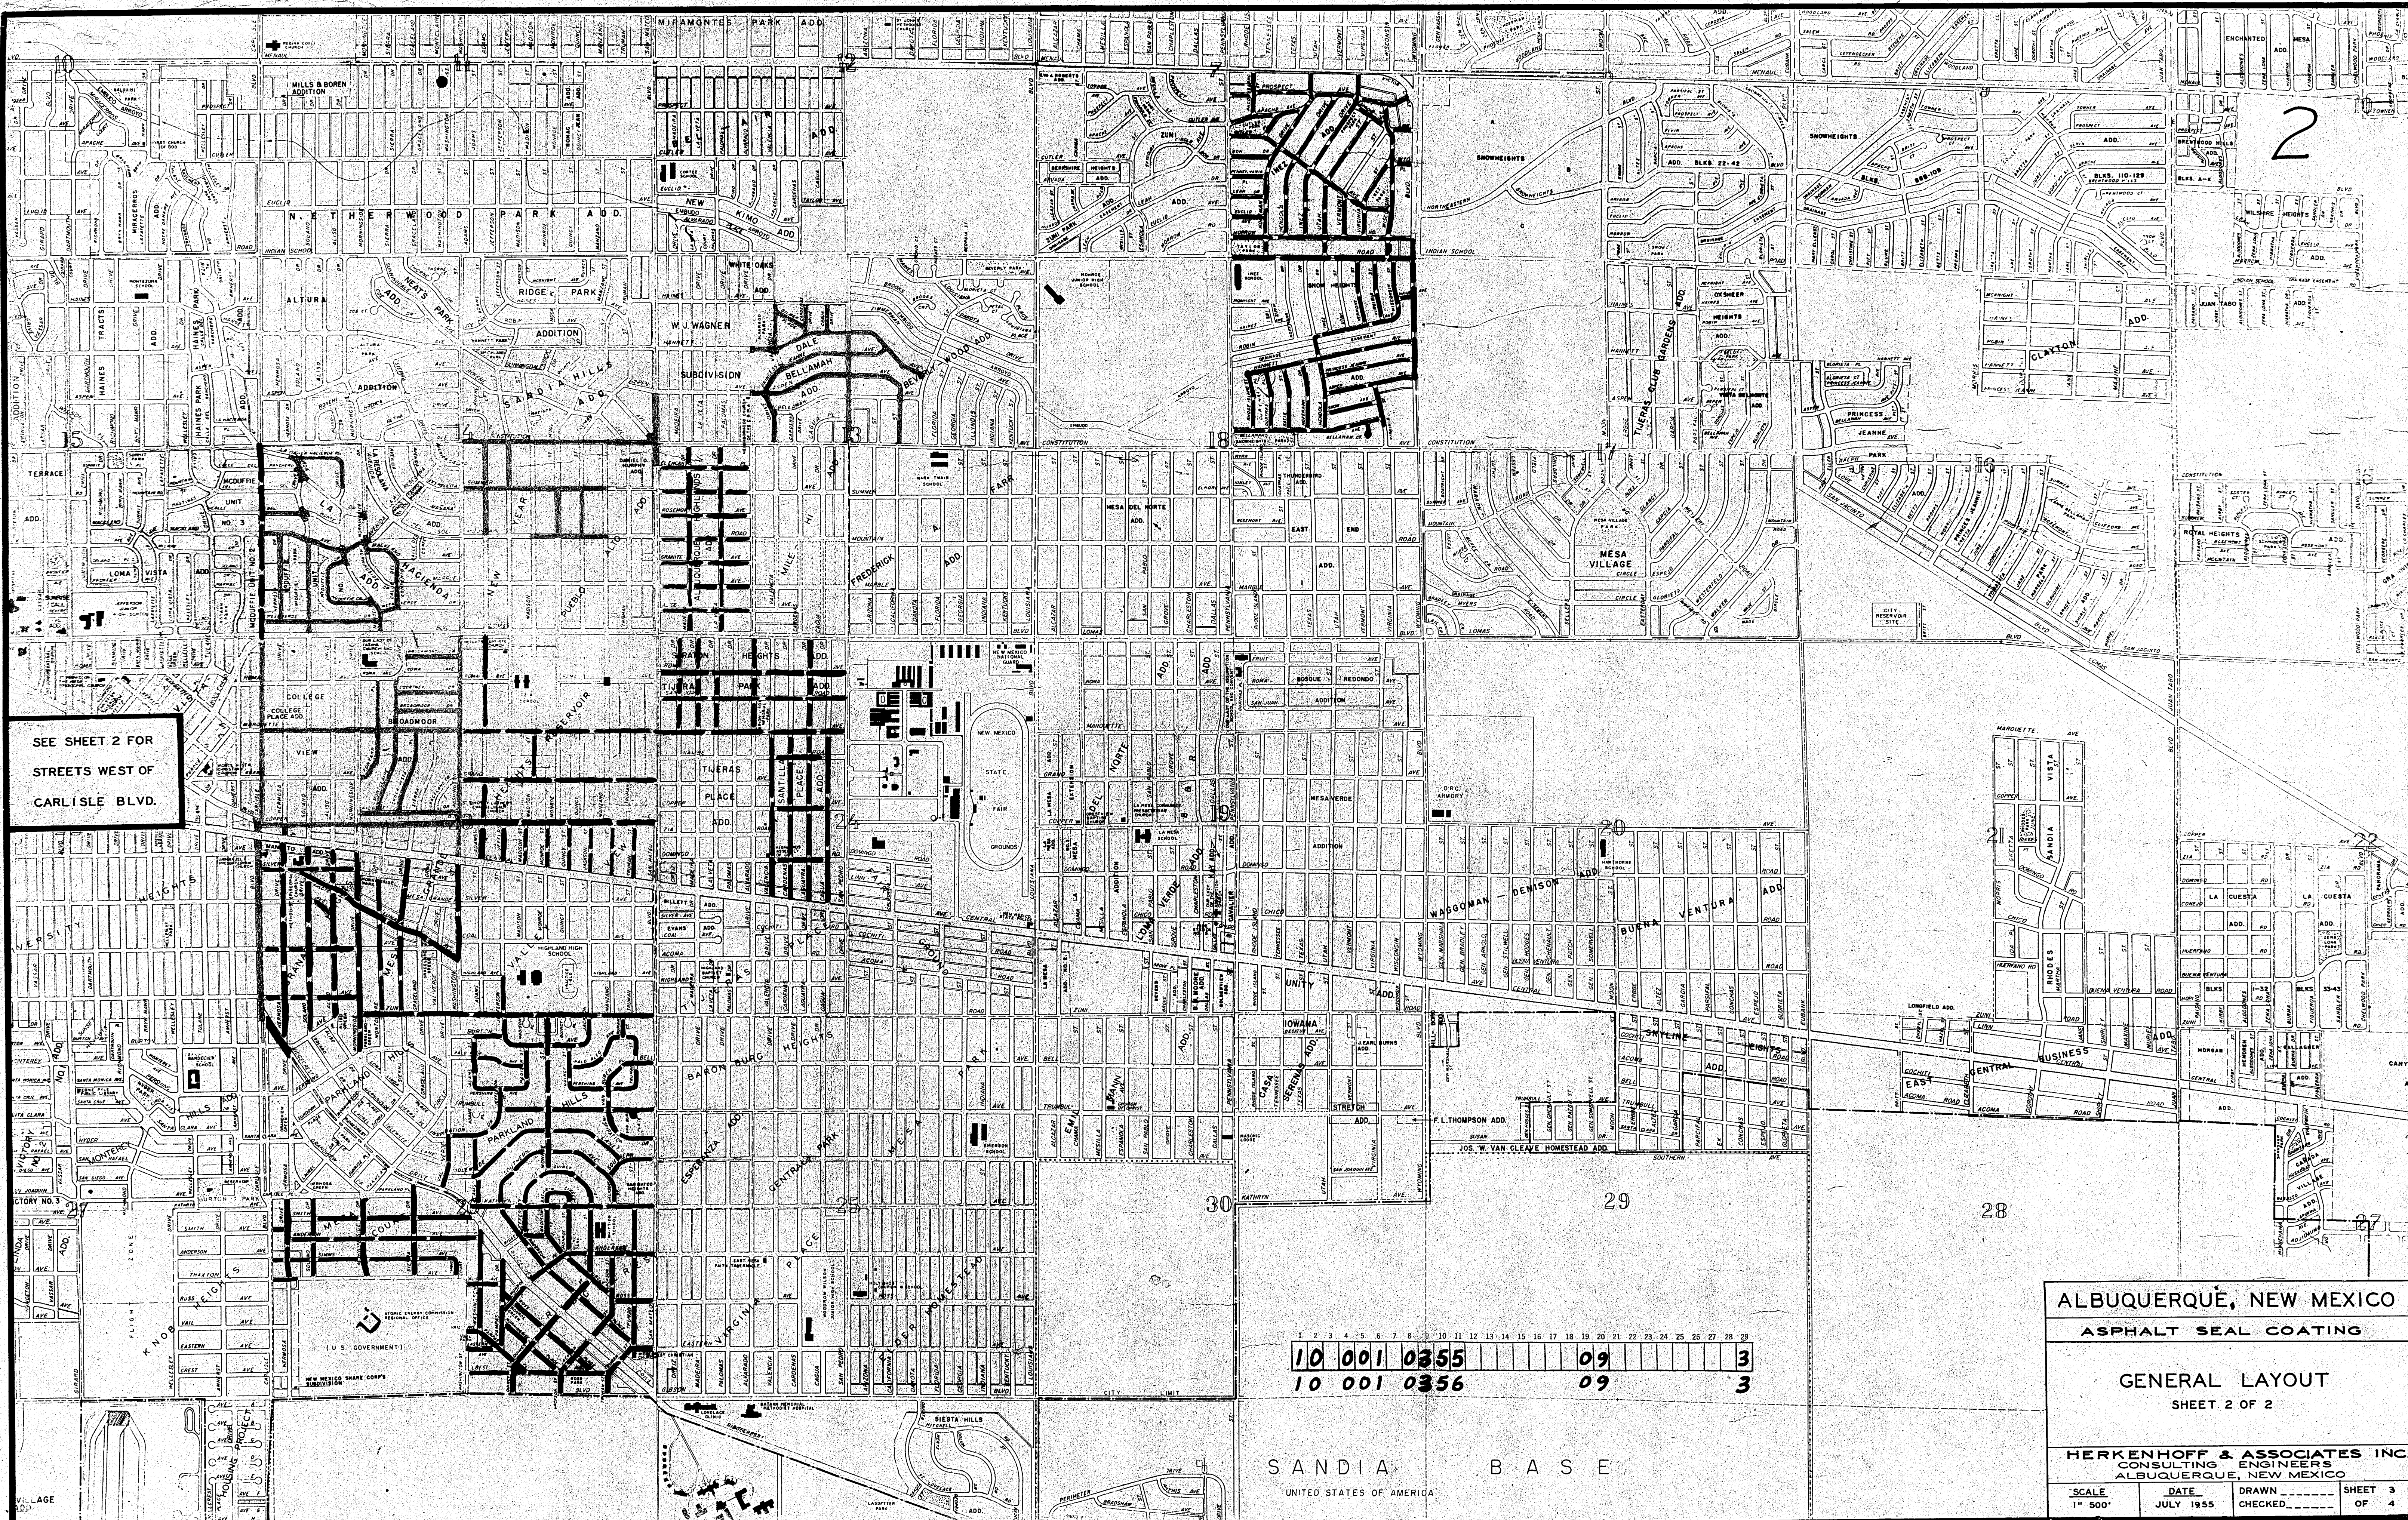

SEE SHEET 2 FOR
STREETS WEST OF
CARLISLE BLVD.

1 2 3 4 5 6 7 8 9 10 11 12 13 14 15 16 17 18 19 20 21 22 23 24 25 26 27 28 29
10 001 0355 09 3
10 001 0356 09 3

SANDIA BASE
UNITED STATES OF AMERICA

ALBUQUERQUE, NEW MEXICO

ASPHALT SEAL COATING

GENERAL LAYOUT


SHEET 2 OF 2

HERKENHOFF & ASSOCIATES INC.


CONSULTING ENGINEERS

ALBUQUERQUE, NEW MEXICO


SCALE	DATE	DRAWN	SHEET
1" = 500'	JULY 1955	CHECKED	3
			OF 4

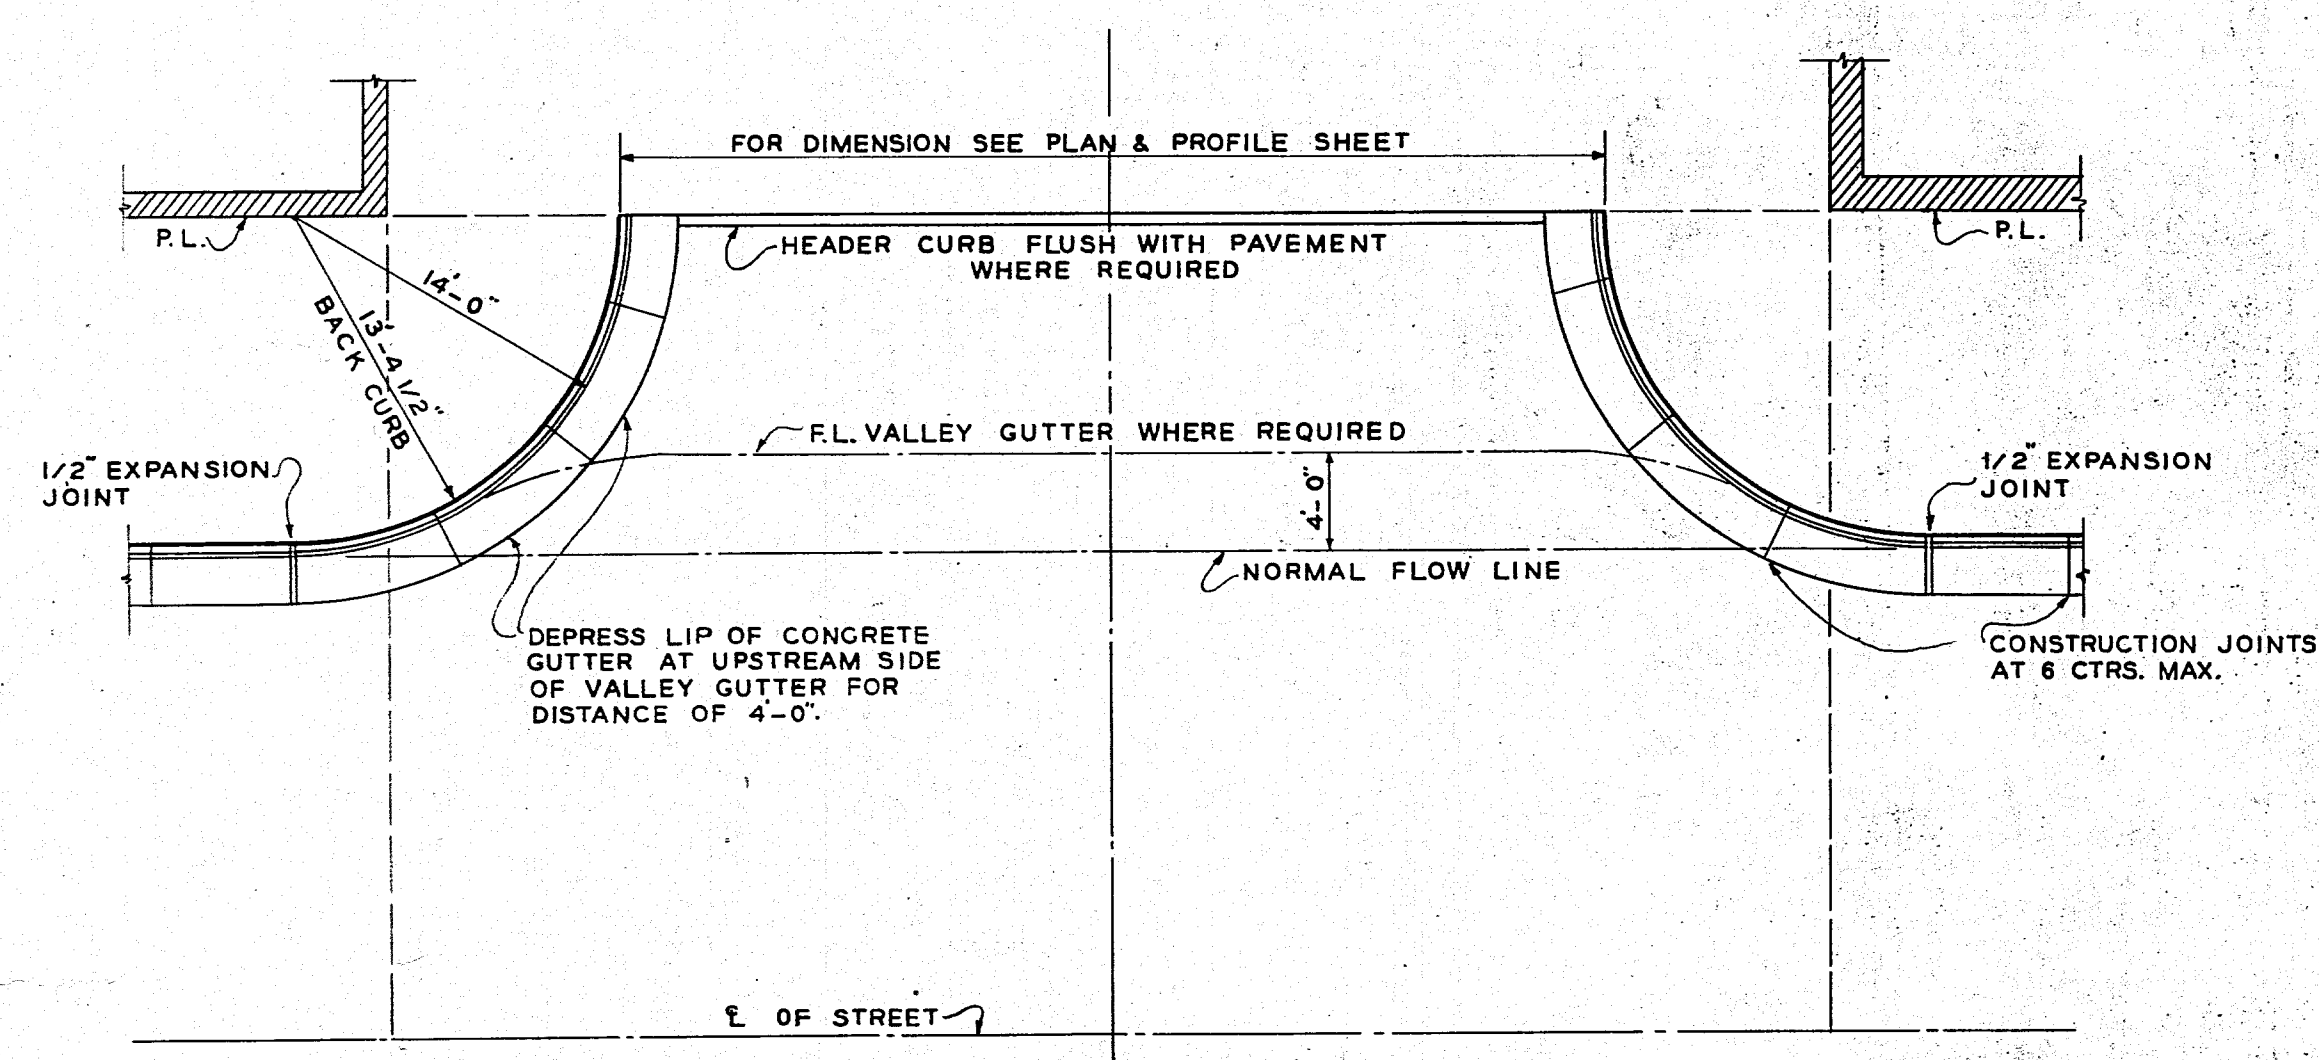


**CURB RETURN
TYPICAL STREET INTERSECTION**
SCALE: 1/8" = 1'-0"

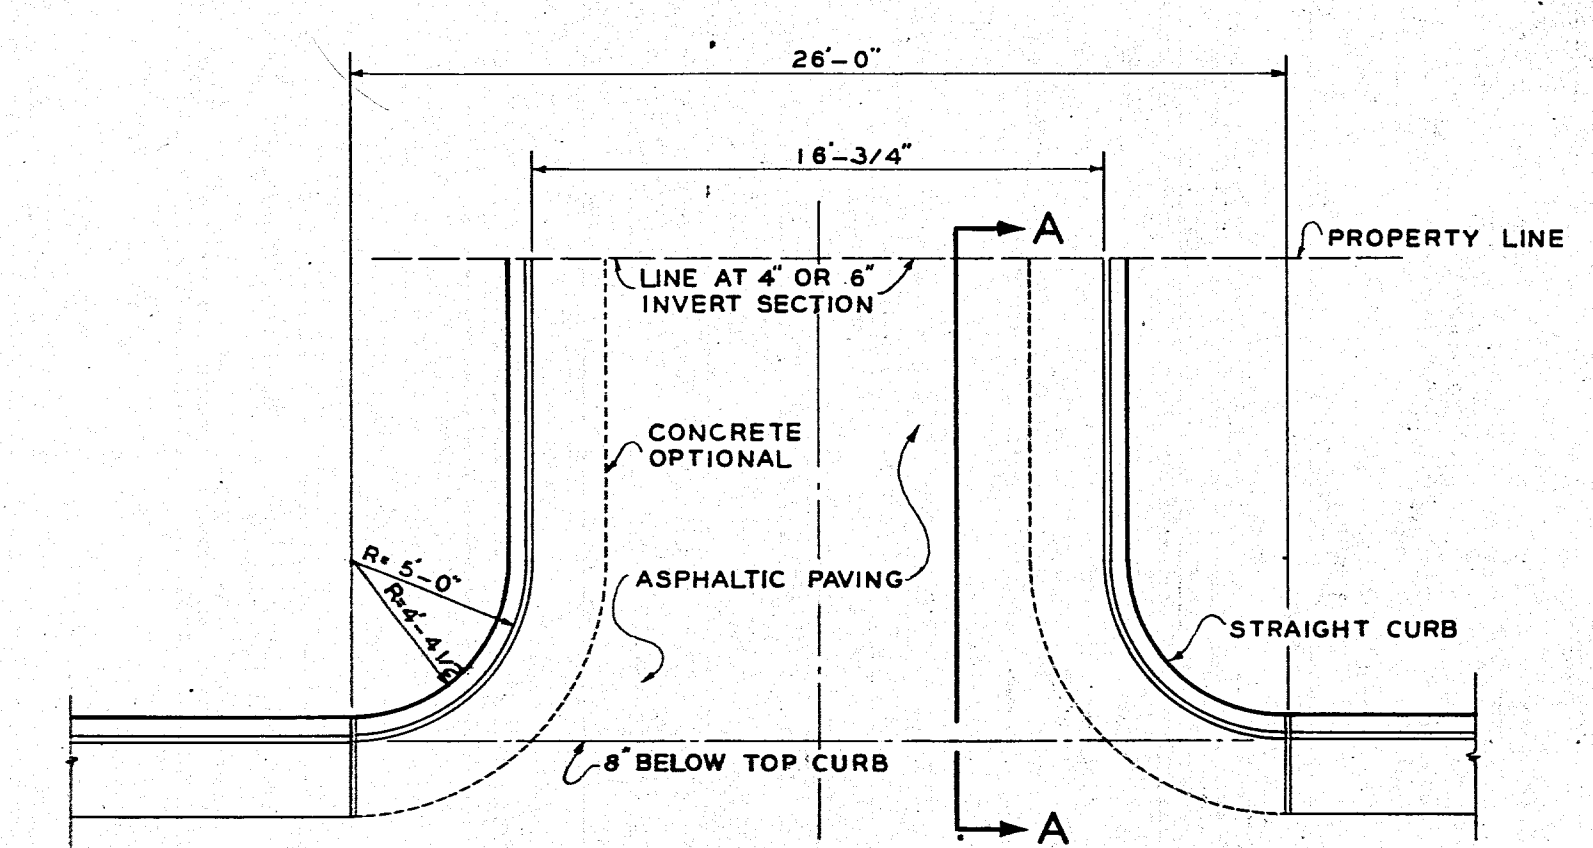


PLAN
3/16" = 1'-0"

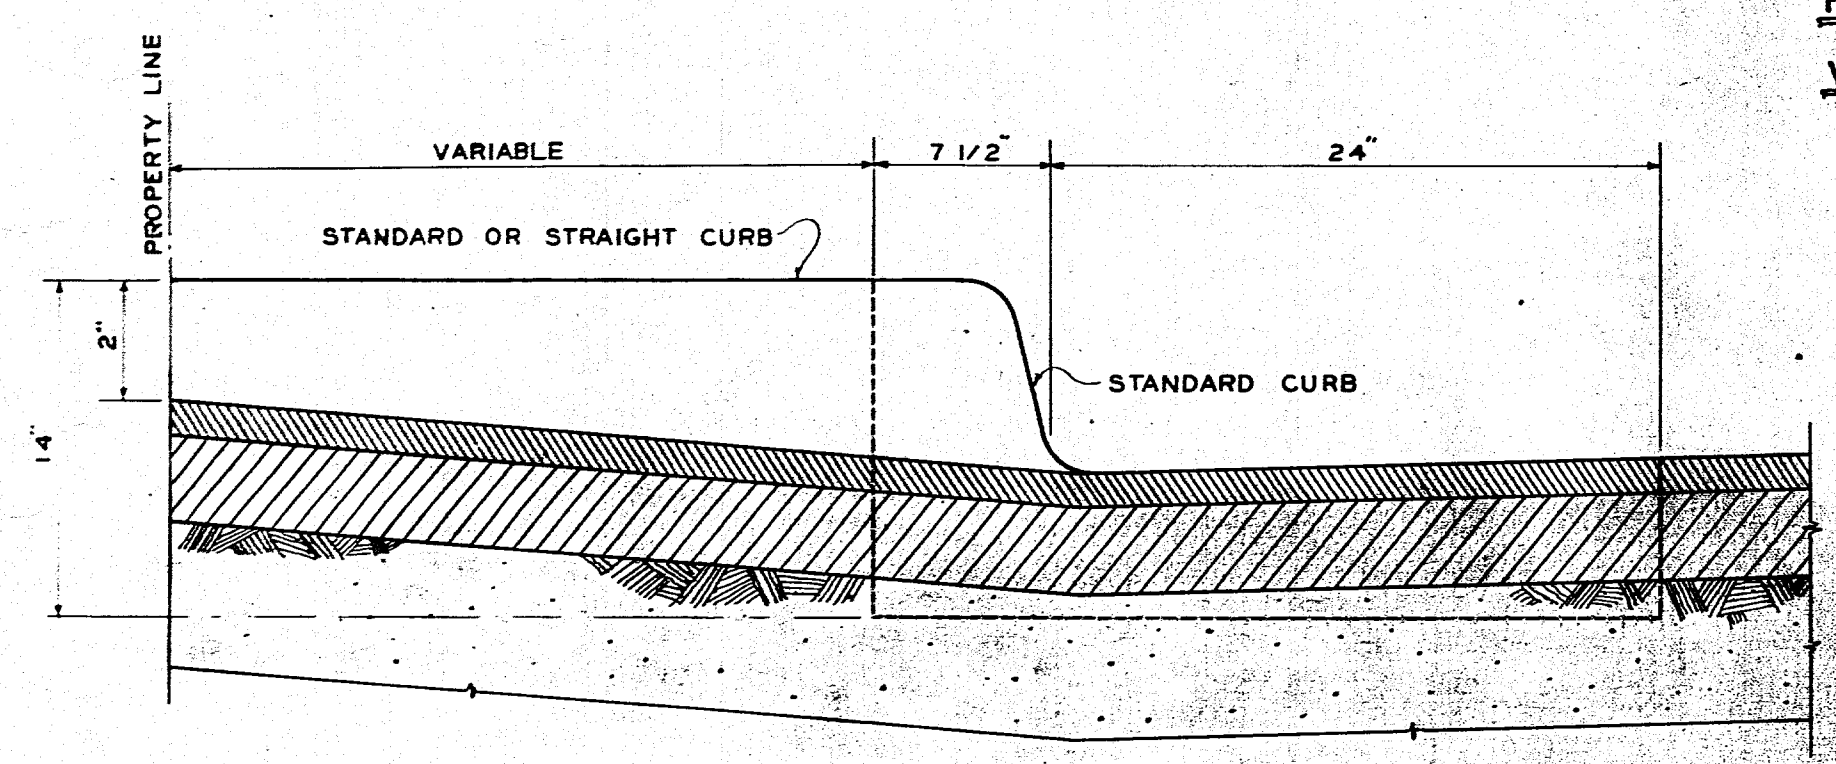


**SECTION A A
DETAIL OF ALLEY RETURN**
SCALE: 1 1/2" = 1'-0"

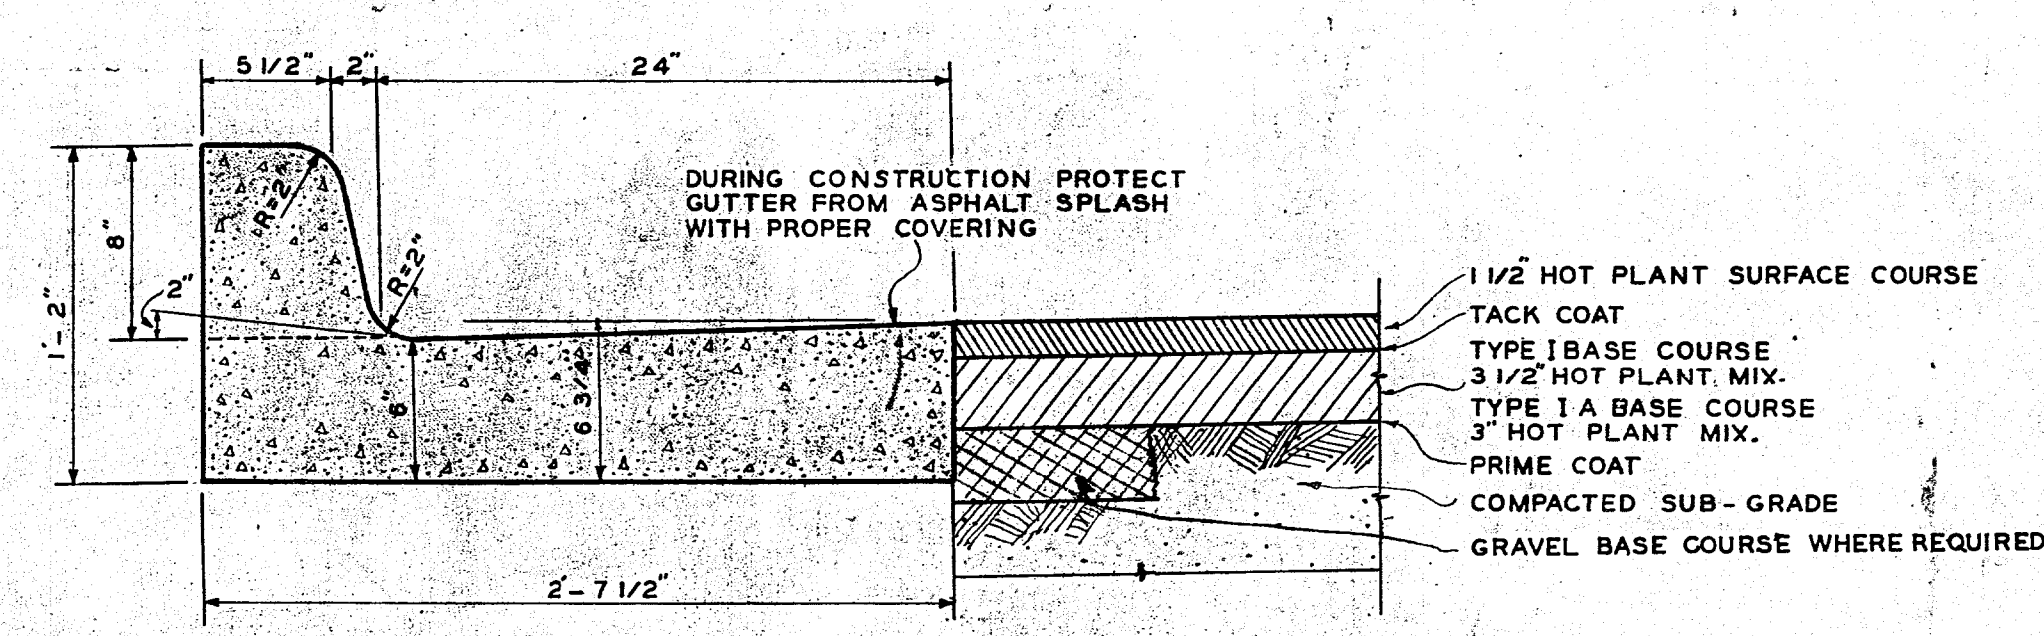


STANDARD CURB
SCALE: 1 1/2" = 1'-0"

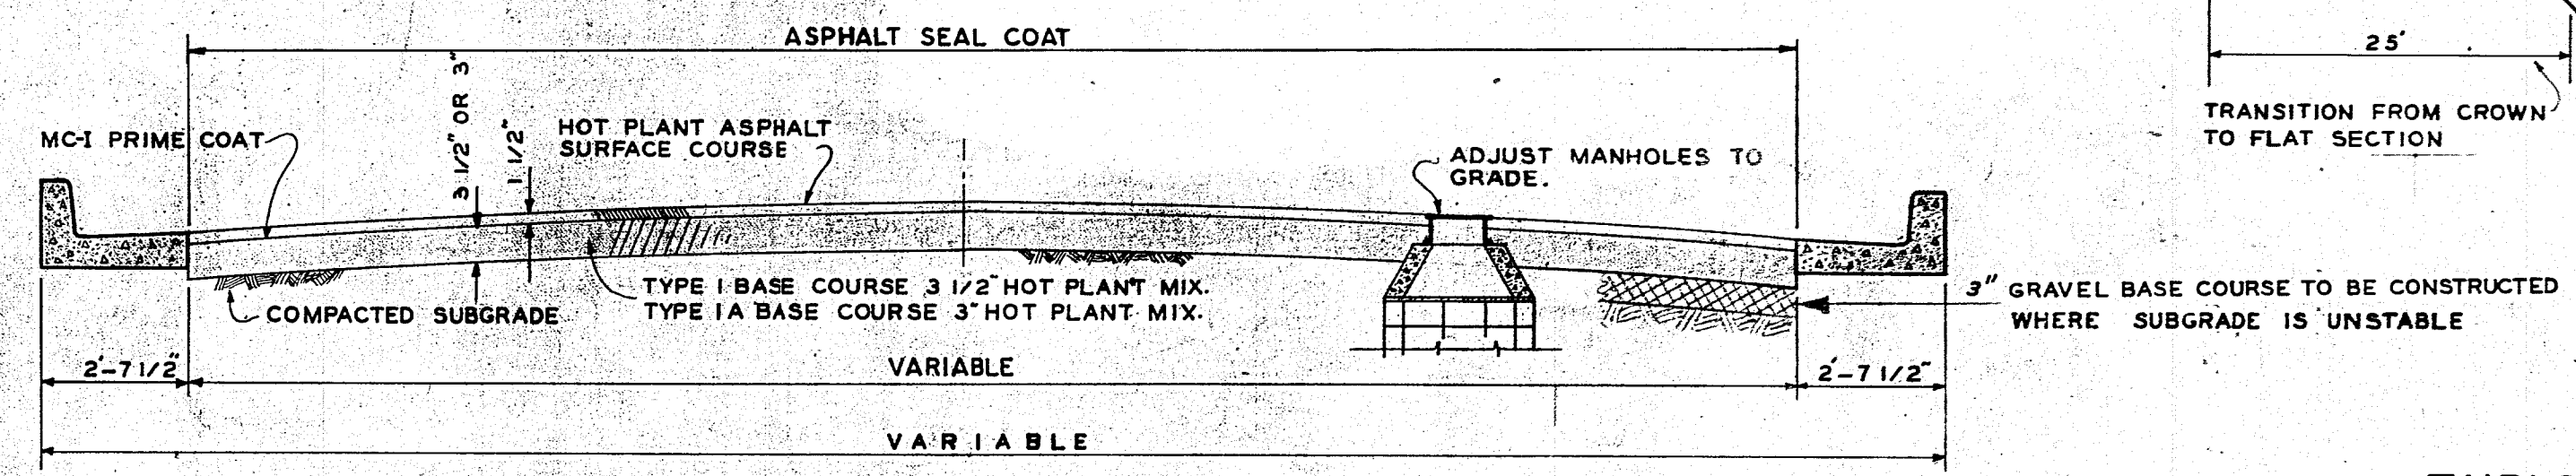


TYPICAL STREET SECTION
NOT TO SCALE

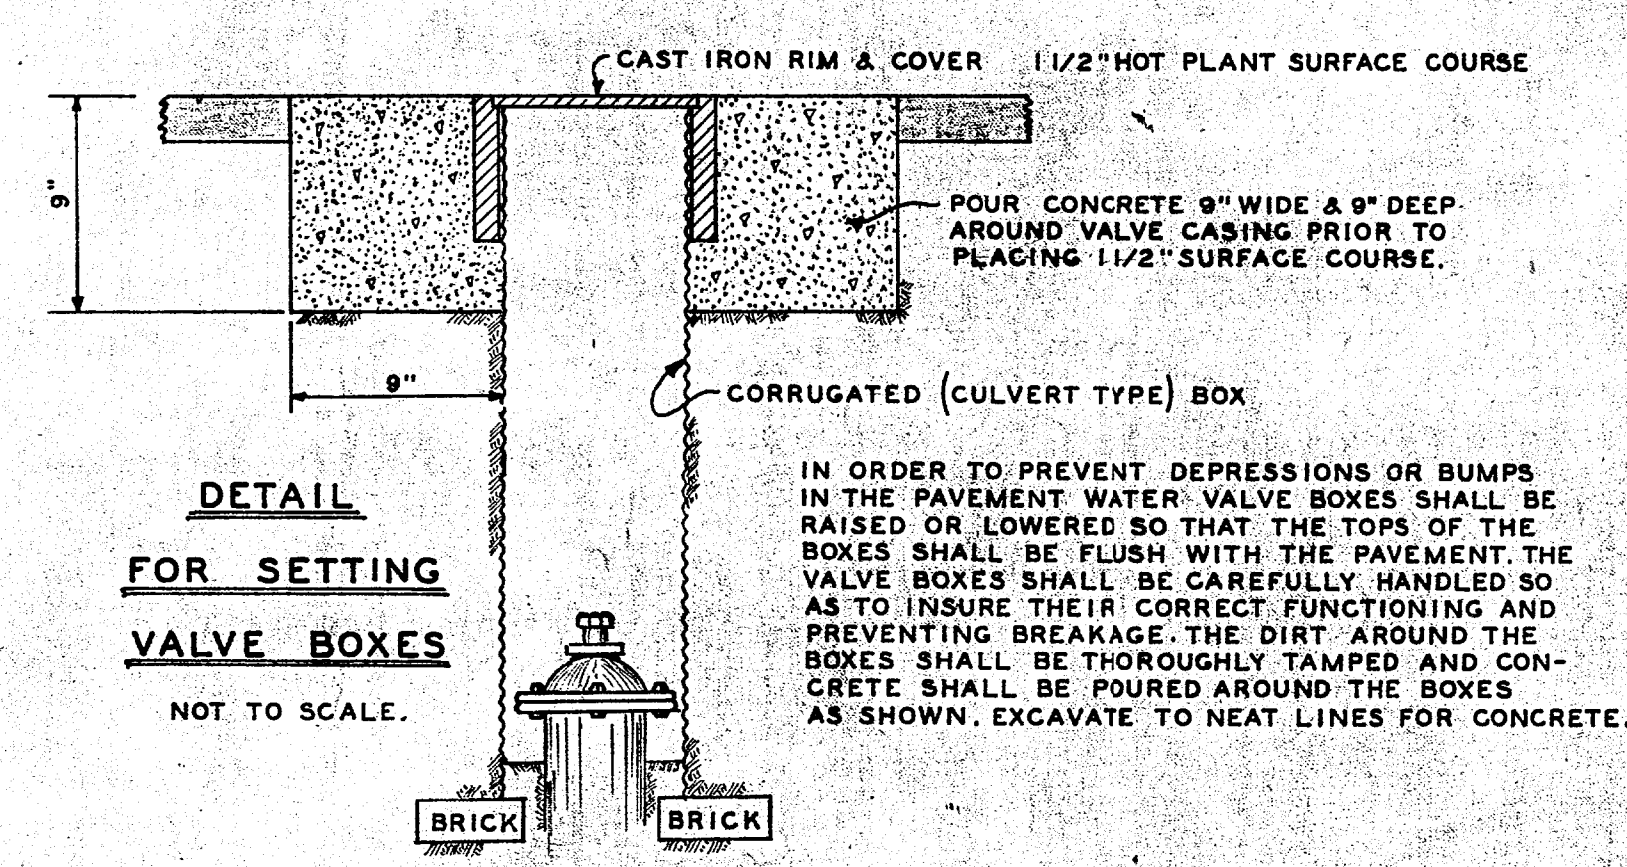


**DETAIL
FOR SETTING
VALVE BOXES**
NOT TO SCALE.

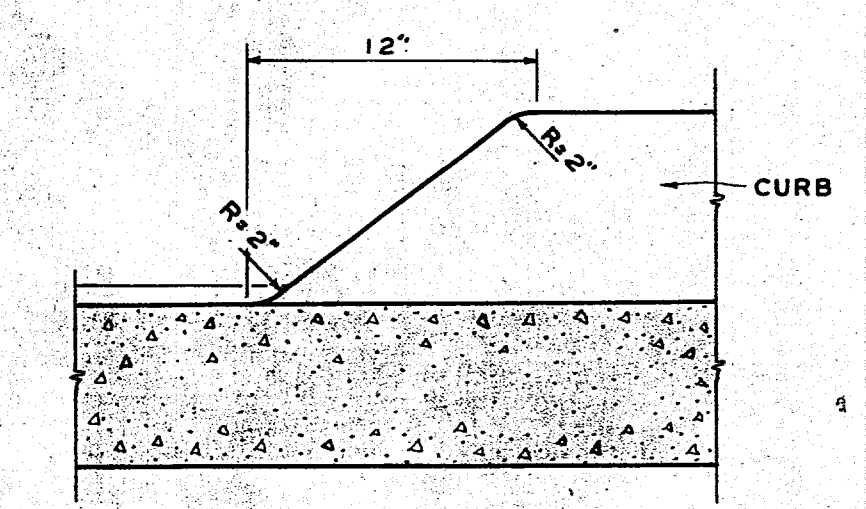


DETAIL B

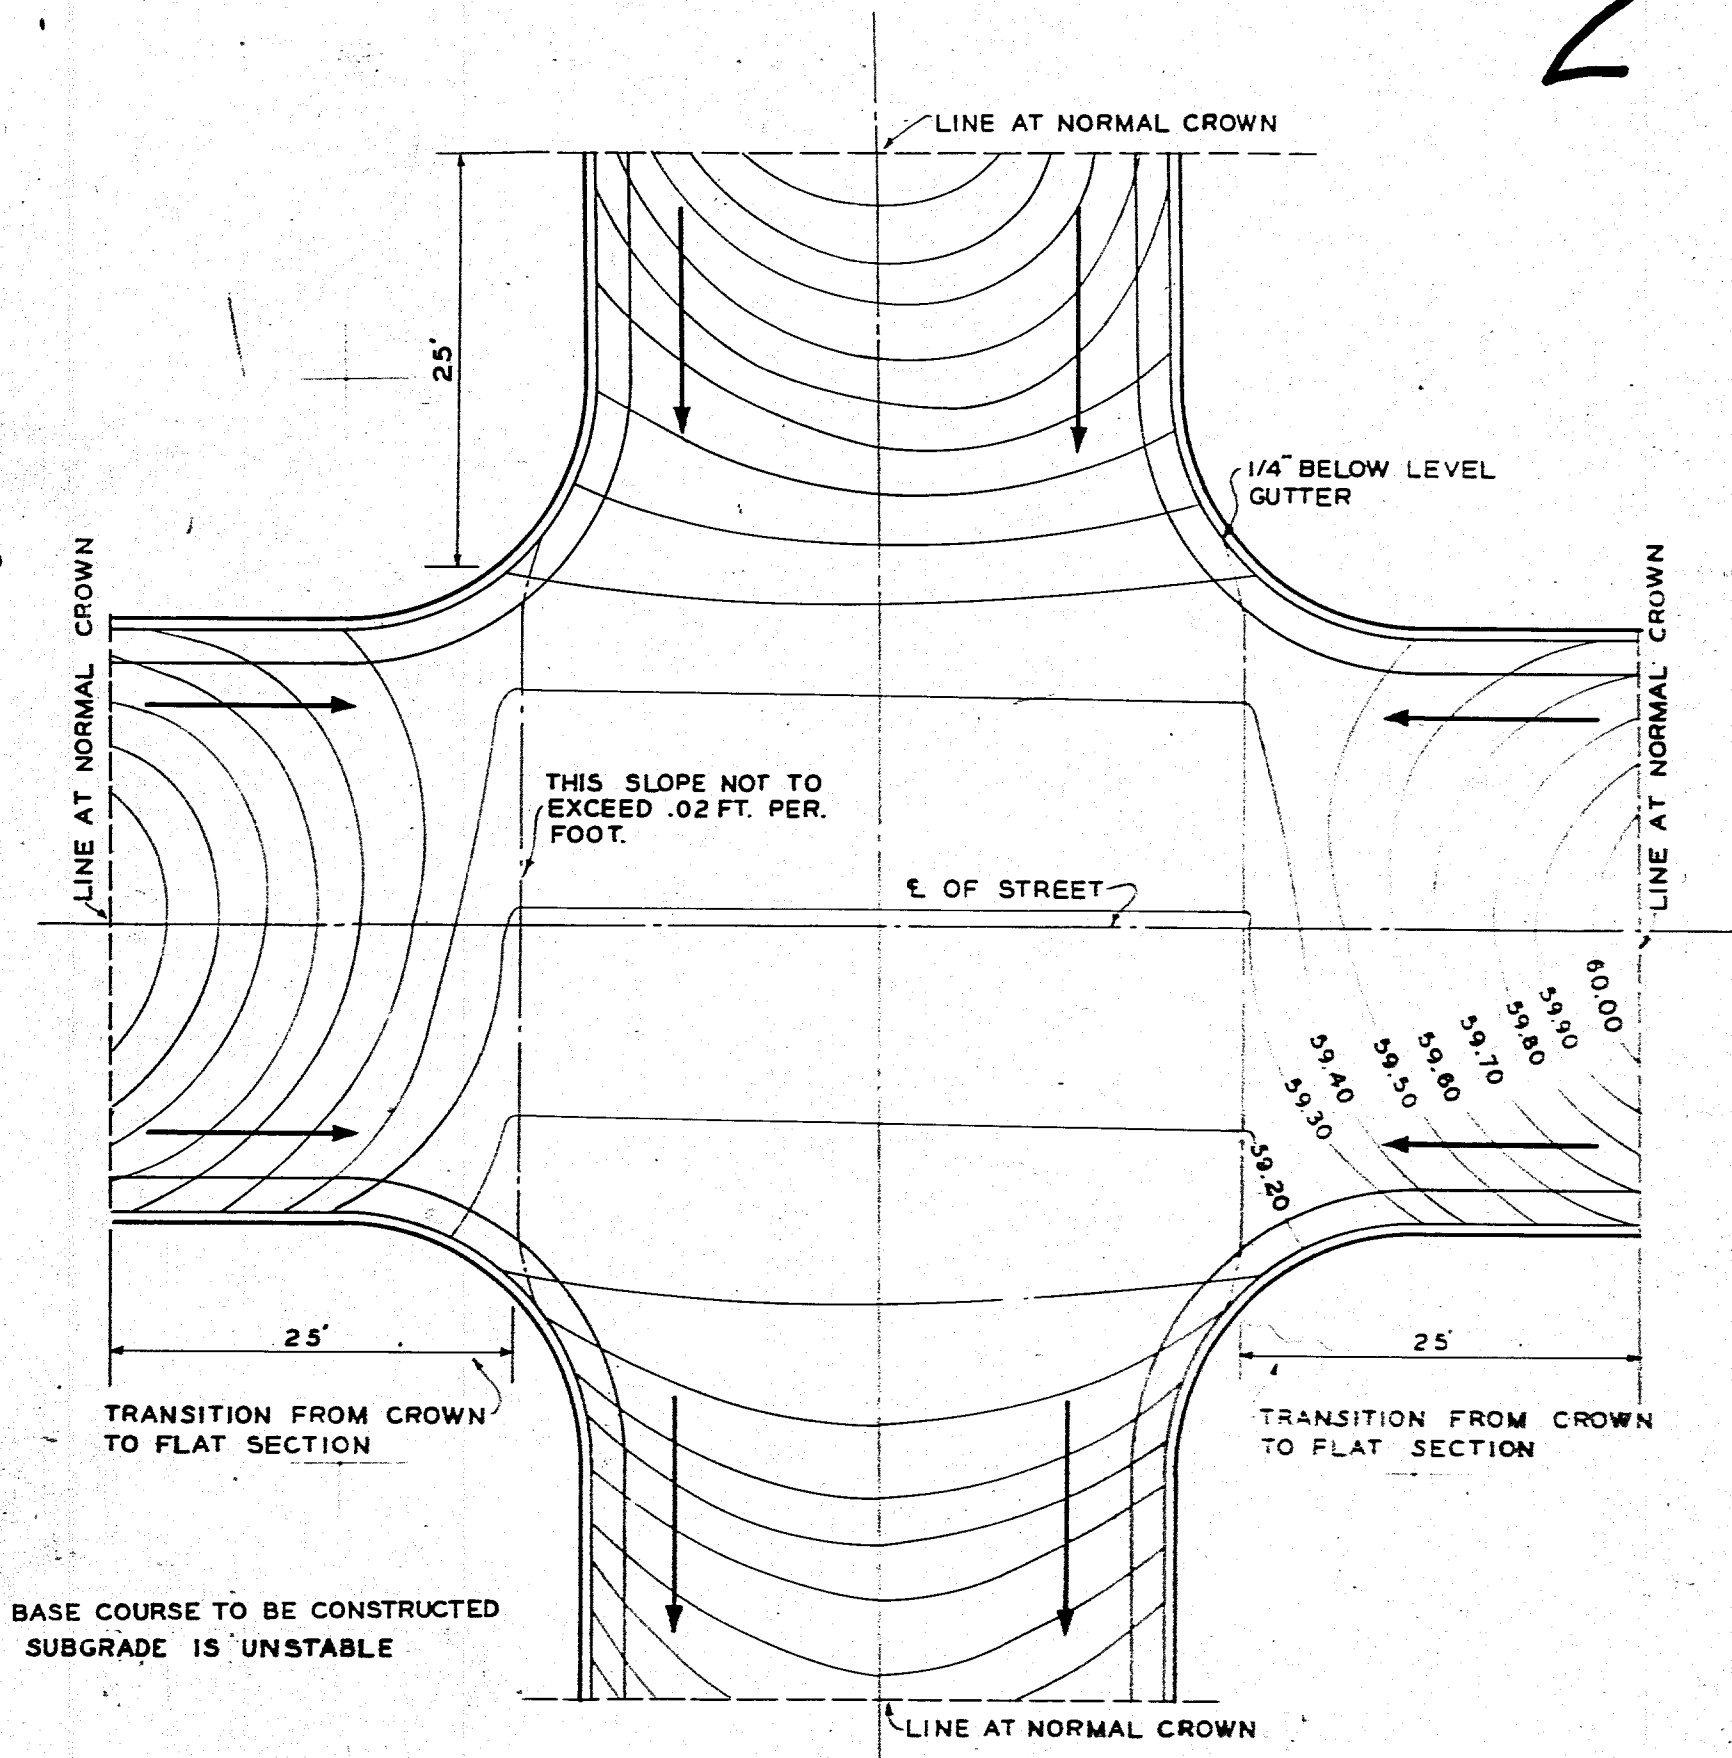


TYPICAL STREET INTERSECTION
SCALE: 3/32" = 1'-0"

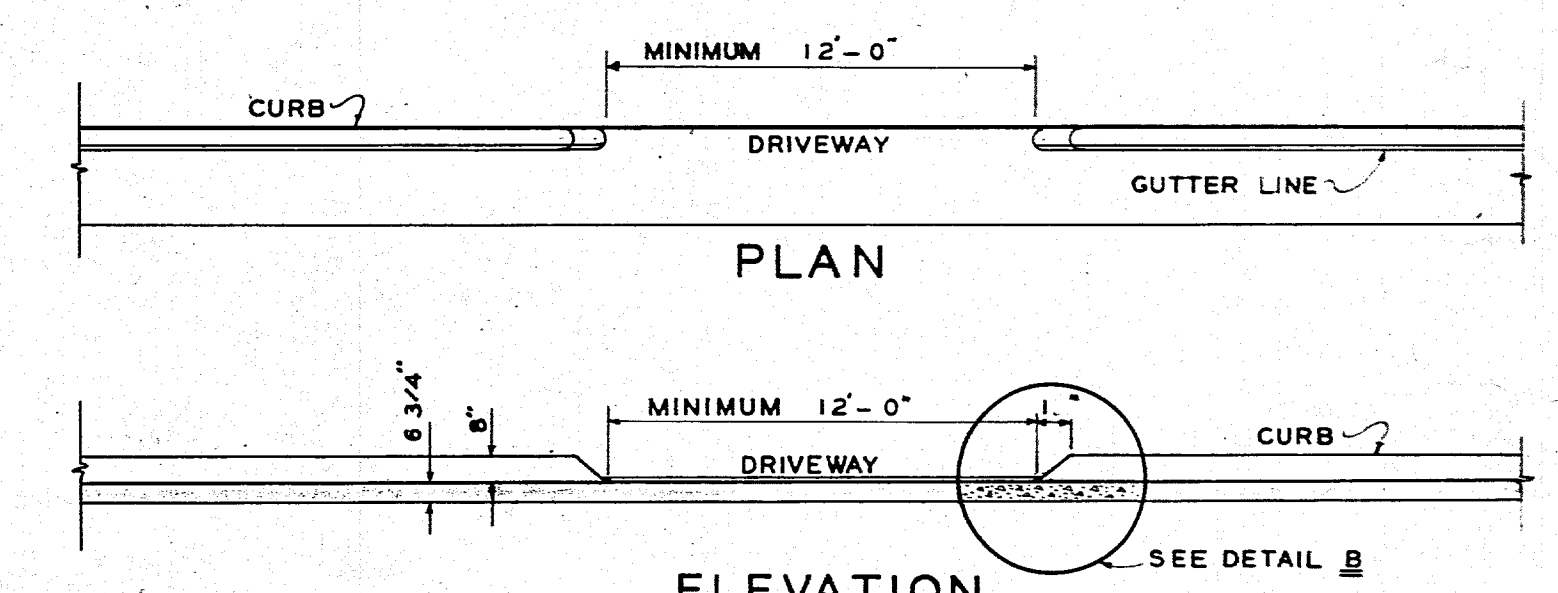

**ELEVATION
RESIDENCE DRIVEWAY**
SCALE: 3/16" = 1'-0"

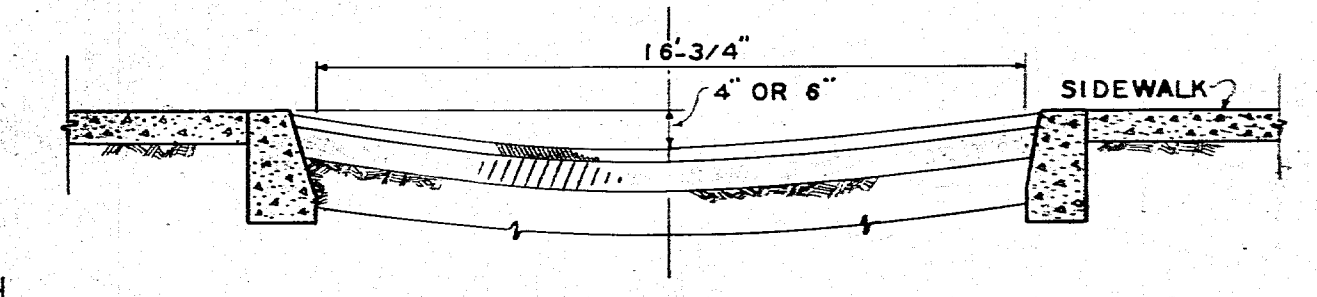


ALLEY SECTION AT S. SIDEWALK
NOT TO SCALE

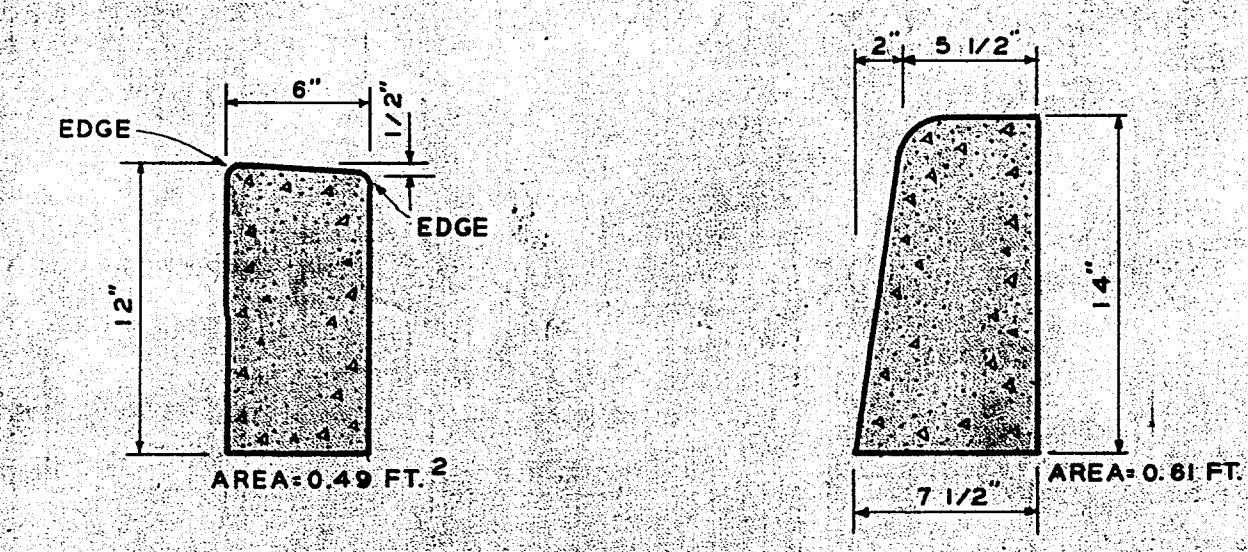

HEADER CURB
SCALE: 1 1/2" = 1'-0"
USE AS SHOWN ON STREET INTERSECTIONS.

STRAIGHT CURB
SCALE: 1 1/2" = 1'-0"
USE ALONG EXISTING PAVEMENTS WHERE SHOWN.

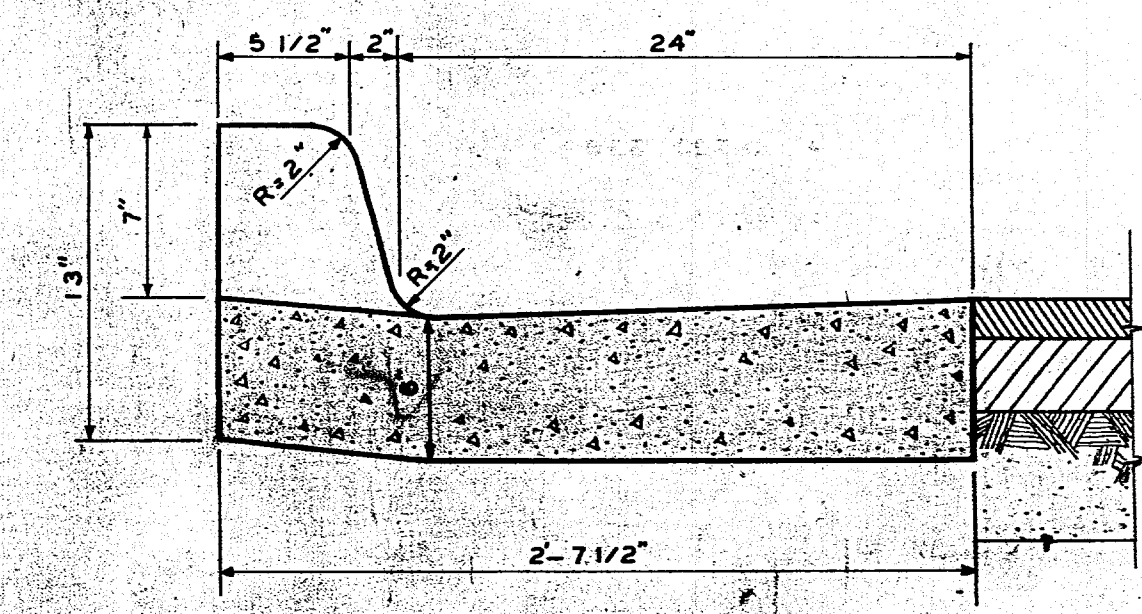

DRIVEWAY DETAIL
SCALE: 1 1/2" = 1'-0"

10 001 0455 10 3
0456

ALBUQUERQUE, NEW MEXICO			
ASPHALT SEAL COATING			
DETAILS			
HERKENHOFF & ASSOCIATES CONSULTING ENGINEERS SANTA FE ALBUQUERQUE			
SCALE AS SHOWN	DATE JULY 1955	DRAWN CHECKED	SHEET 4 OF 4