


CITY OF ALBUQUERQUE · NEW MEXICO

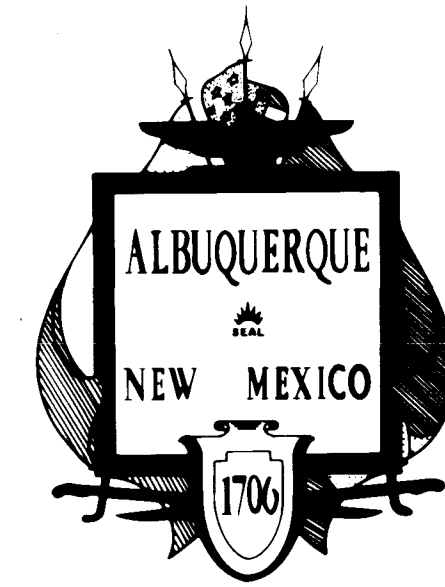

COMMUNITY DEVELOPMENT PROGRAM

PROJECT NUMBER CD-3A

1977 · 1978 STREET & UTILITY IMPROVEMENTS

LOS GRIEGOS · LA MESA

SAWMILL · WEST MESA

JOB NUMBER 77011

SET NUMBER _____

1	2	3	4	5	6	7	8	9	10	11	12
1	0	0	0	1	0	1	8	0			



APPROVAL OF AS BUILT DRAWINGS
ASST. CITY ENGINEER
<i>[Signature]</i>
DATE <u>2-12-80</u>

AS CONSTRUCTED

DATE 2/29/80 BY *[Signature]*



 Scanlon & associates, inc.
Engineers - Planners
albuquerque artesia santa fe

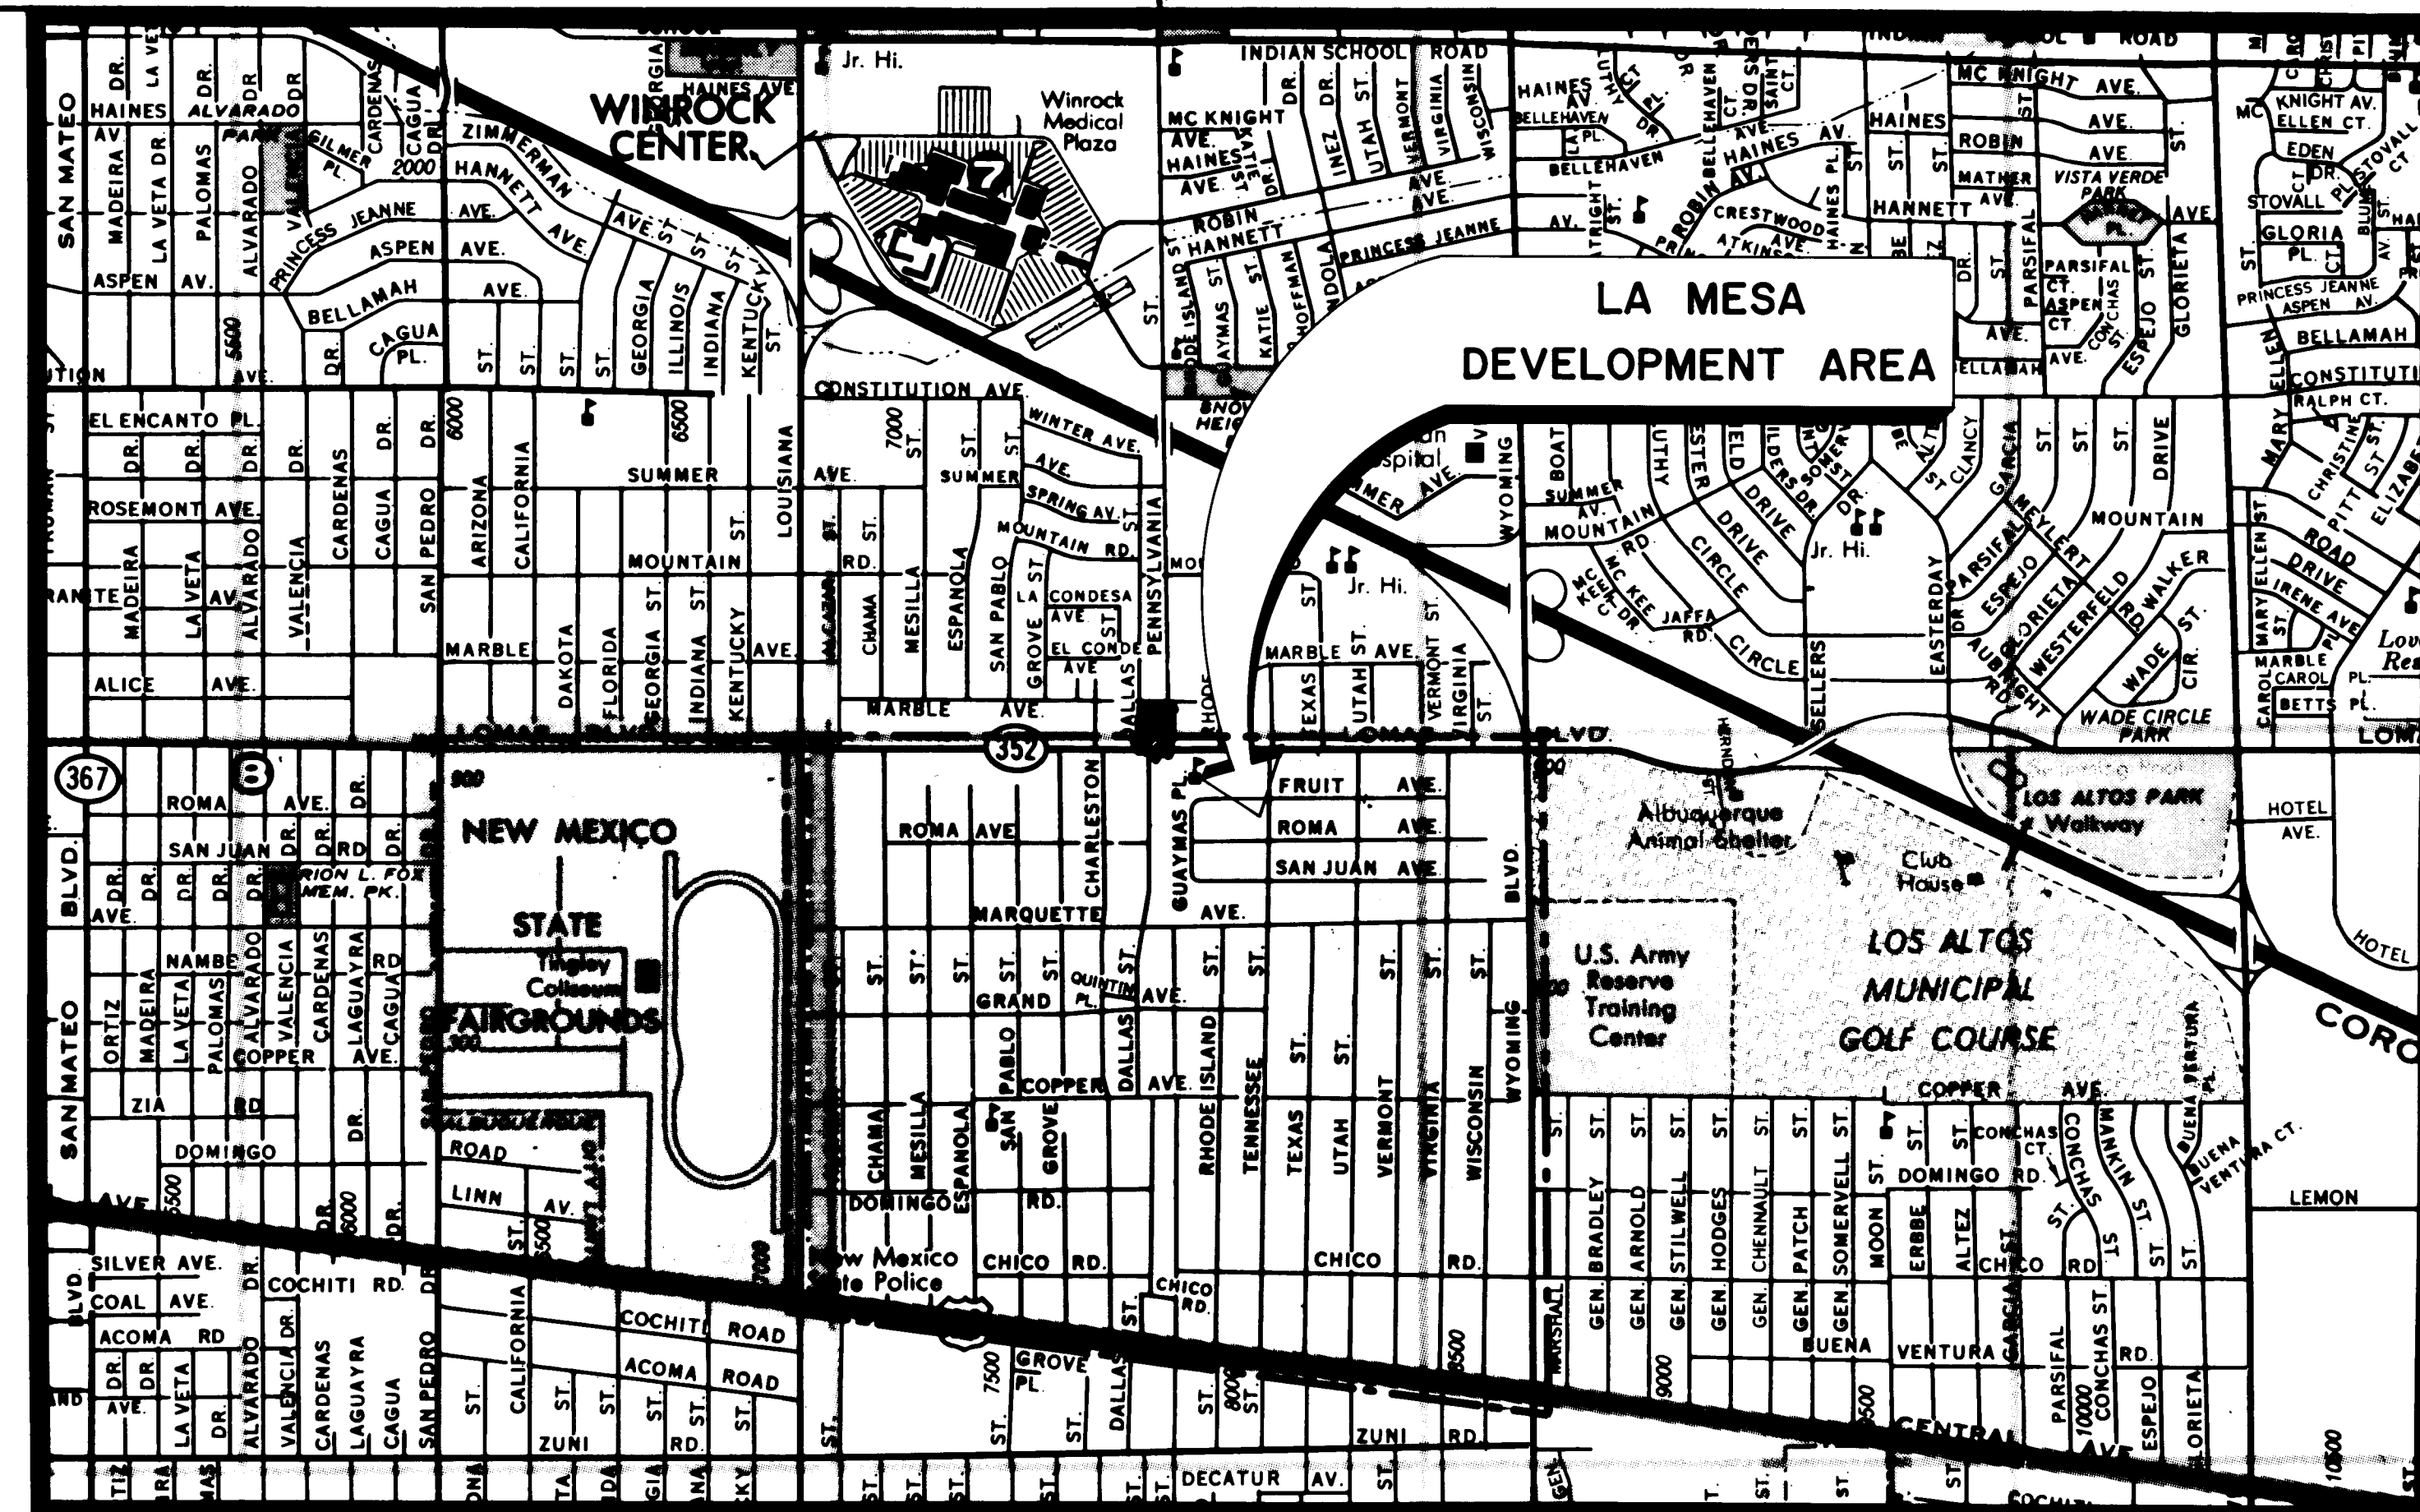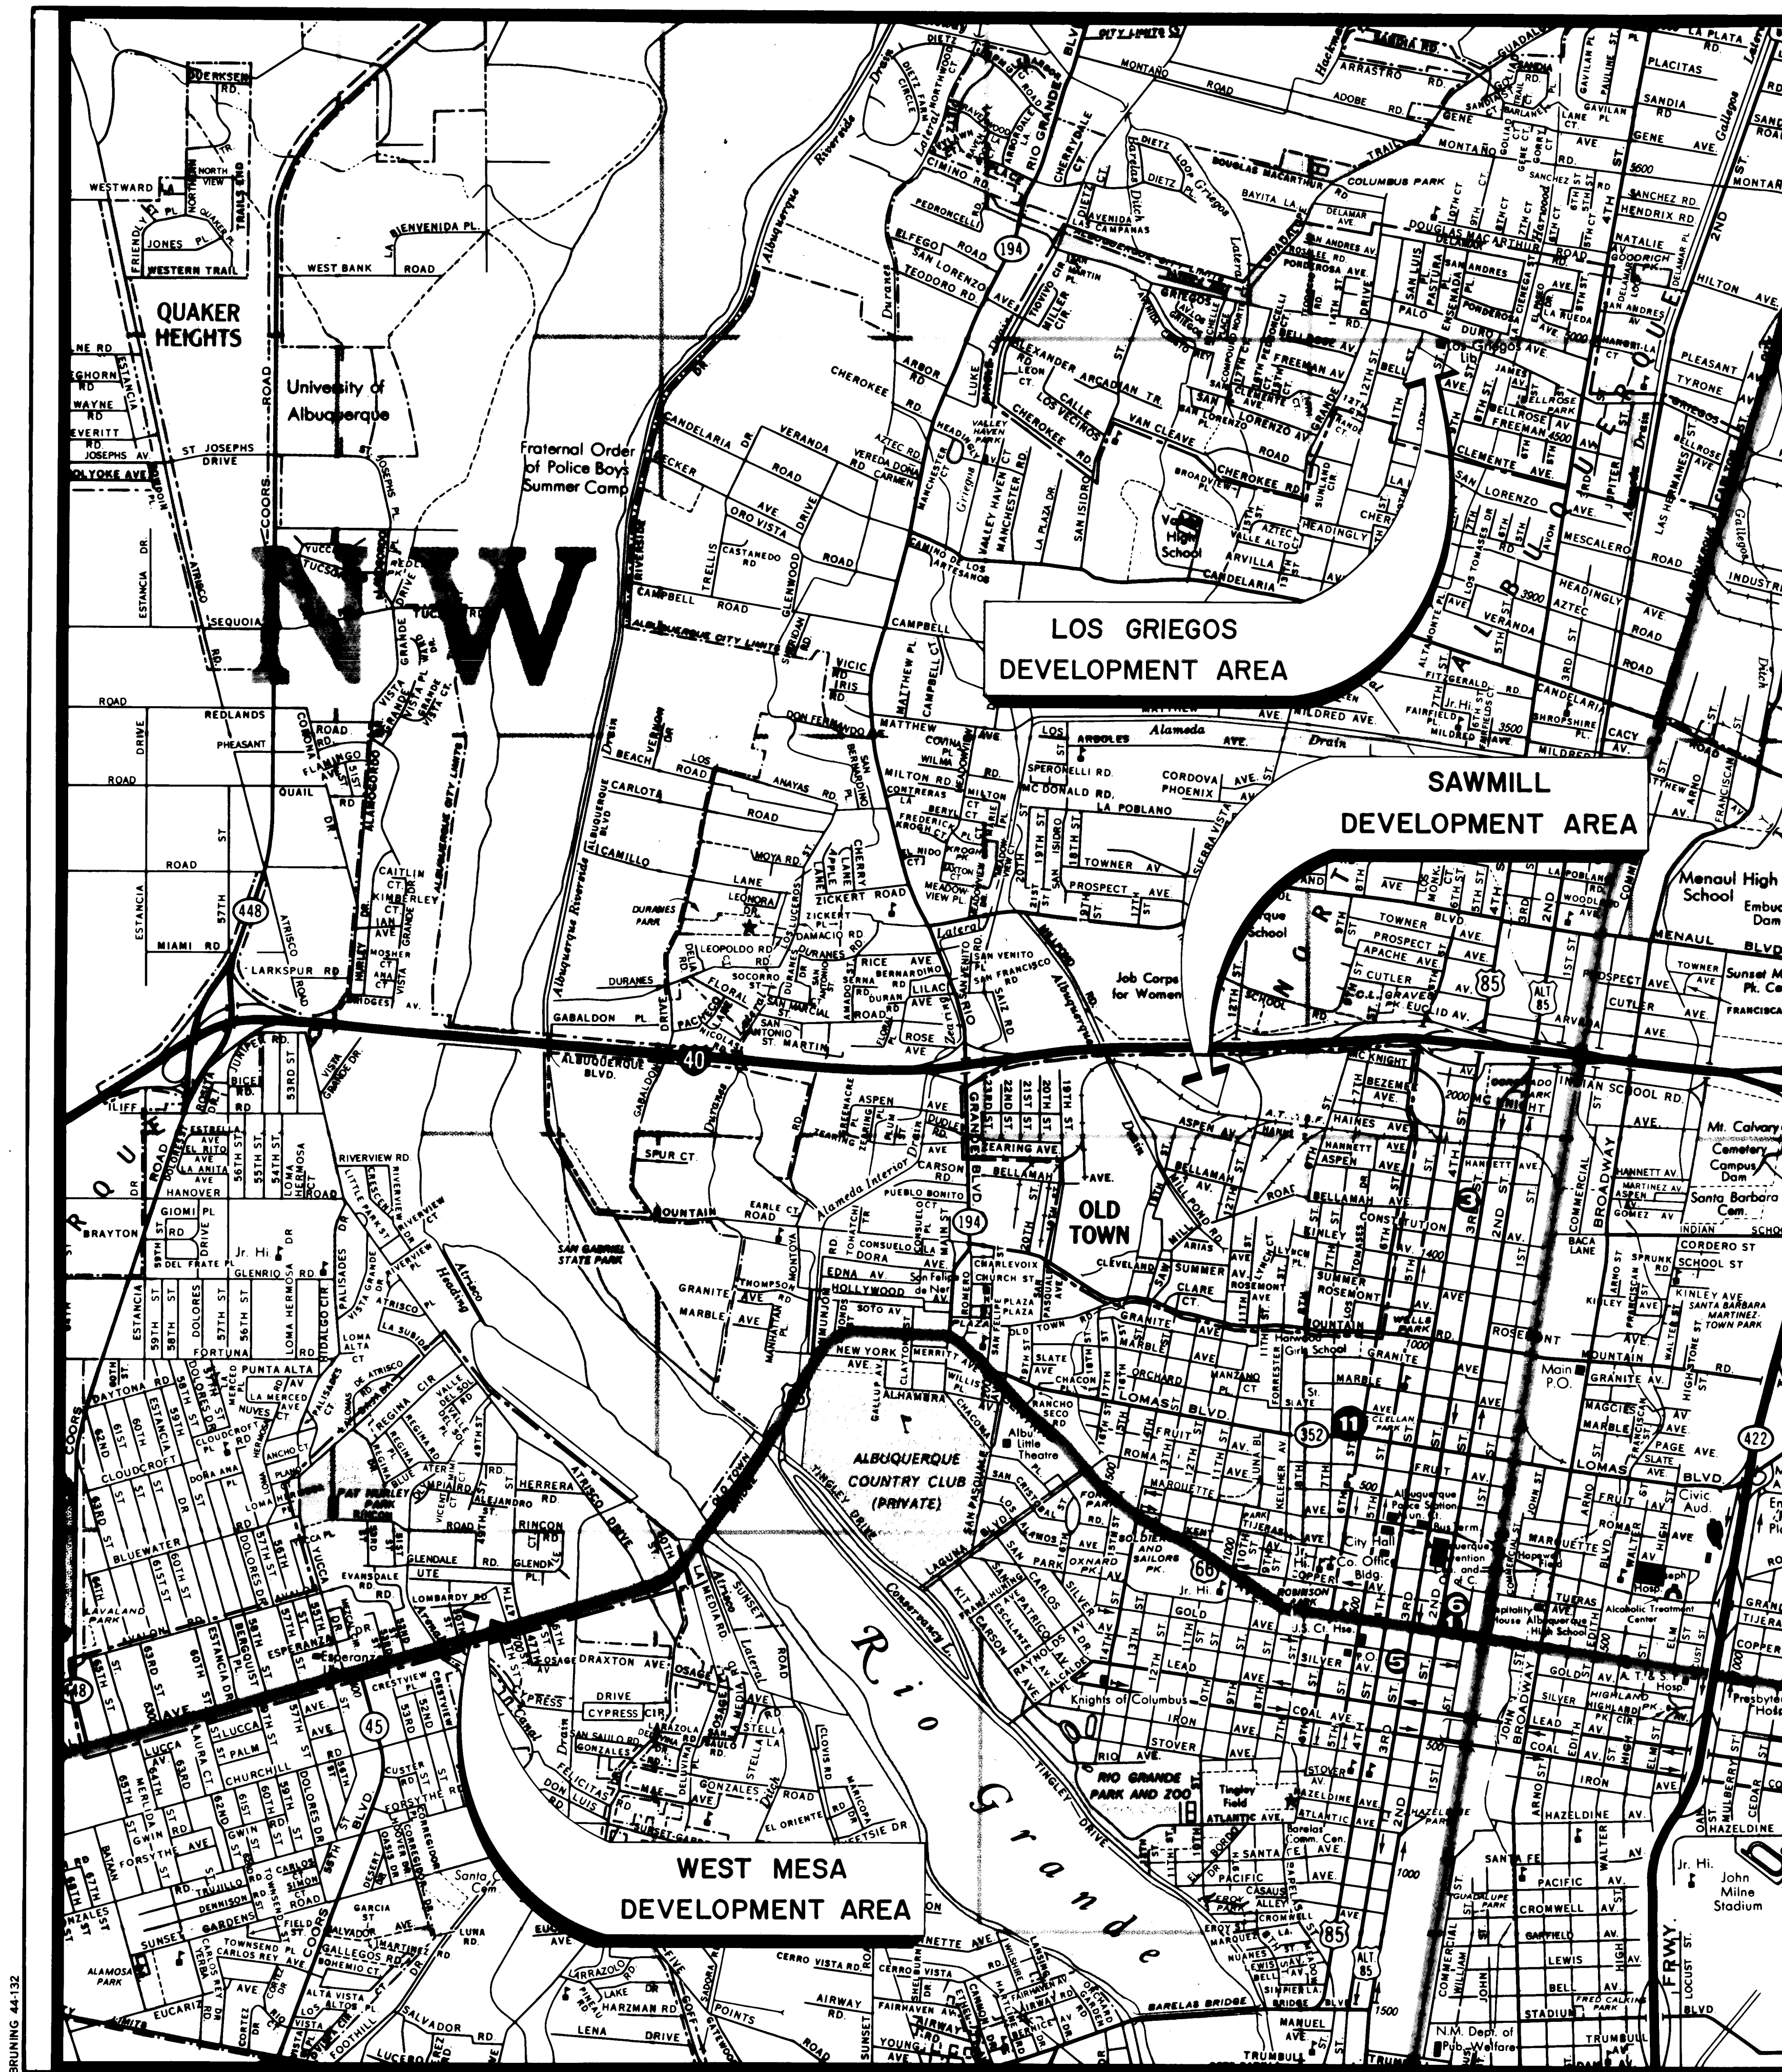

INDEX

SHEET NO.	DESCRIPTION
1	TITLE SHEET
2	LOCATION MAPS & INDEX
3	SITE MAPS
4	GENERAL NOTES & LEGEND
LOS GRIEGOS PLAN & PROFILE SHEET:	
5	ARCADIAN ROAD
SAWMILL PLAN & PROFILE SHEETS:	
6	10th STREET
6	SAWTELLE AVENUE
7	LOS TOMASES DRIVE
8	ALLEY NORTH OF BELLAMAH
WEST MESA PLAN & PROFILE SHEETS:	
9	LOMBARDY ROAD
9	46th STREET
10 - 11	WEST MESA FIRE HYDRANT IMPROVEMENTS
12 - 13	LA MESA FIRE HYDRANT IMPROVEMENTS
14 - 15	WATER LINE IMPROVEMENTS - MARQUETTE AVENUE
16	TYPICAL STREET SECTIONS & DETAILS
17	SUMMARY OF QUANTITIES

10 001 0-80

APPROVAL OF AS BUILT DRAWINGS
ASST. CITY ENGINEER FIELD
[Signature]
DATE 4-11-82

ALBUQUERQUE CD-3A

LOCATION MAPS & INDEX









COMMUNITY DEVELOPMENT PROGRAM

albuquerque	bernalillo	county	new mexico
DATE OCT '78	JOB NO 77011	SCALE AS SHOWN	DRAWN: LH SHEET 2 OF 17

Scanlon & associates, inc.
albuquerque Engineers-Planners santa fe

AS CONSTRUCTED

DATE 2/29/80 BY *[Signature]*

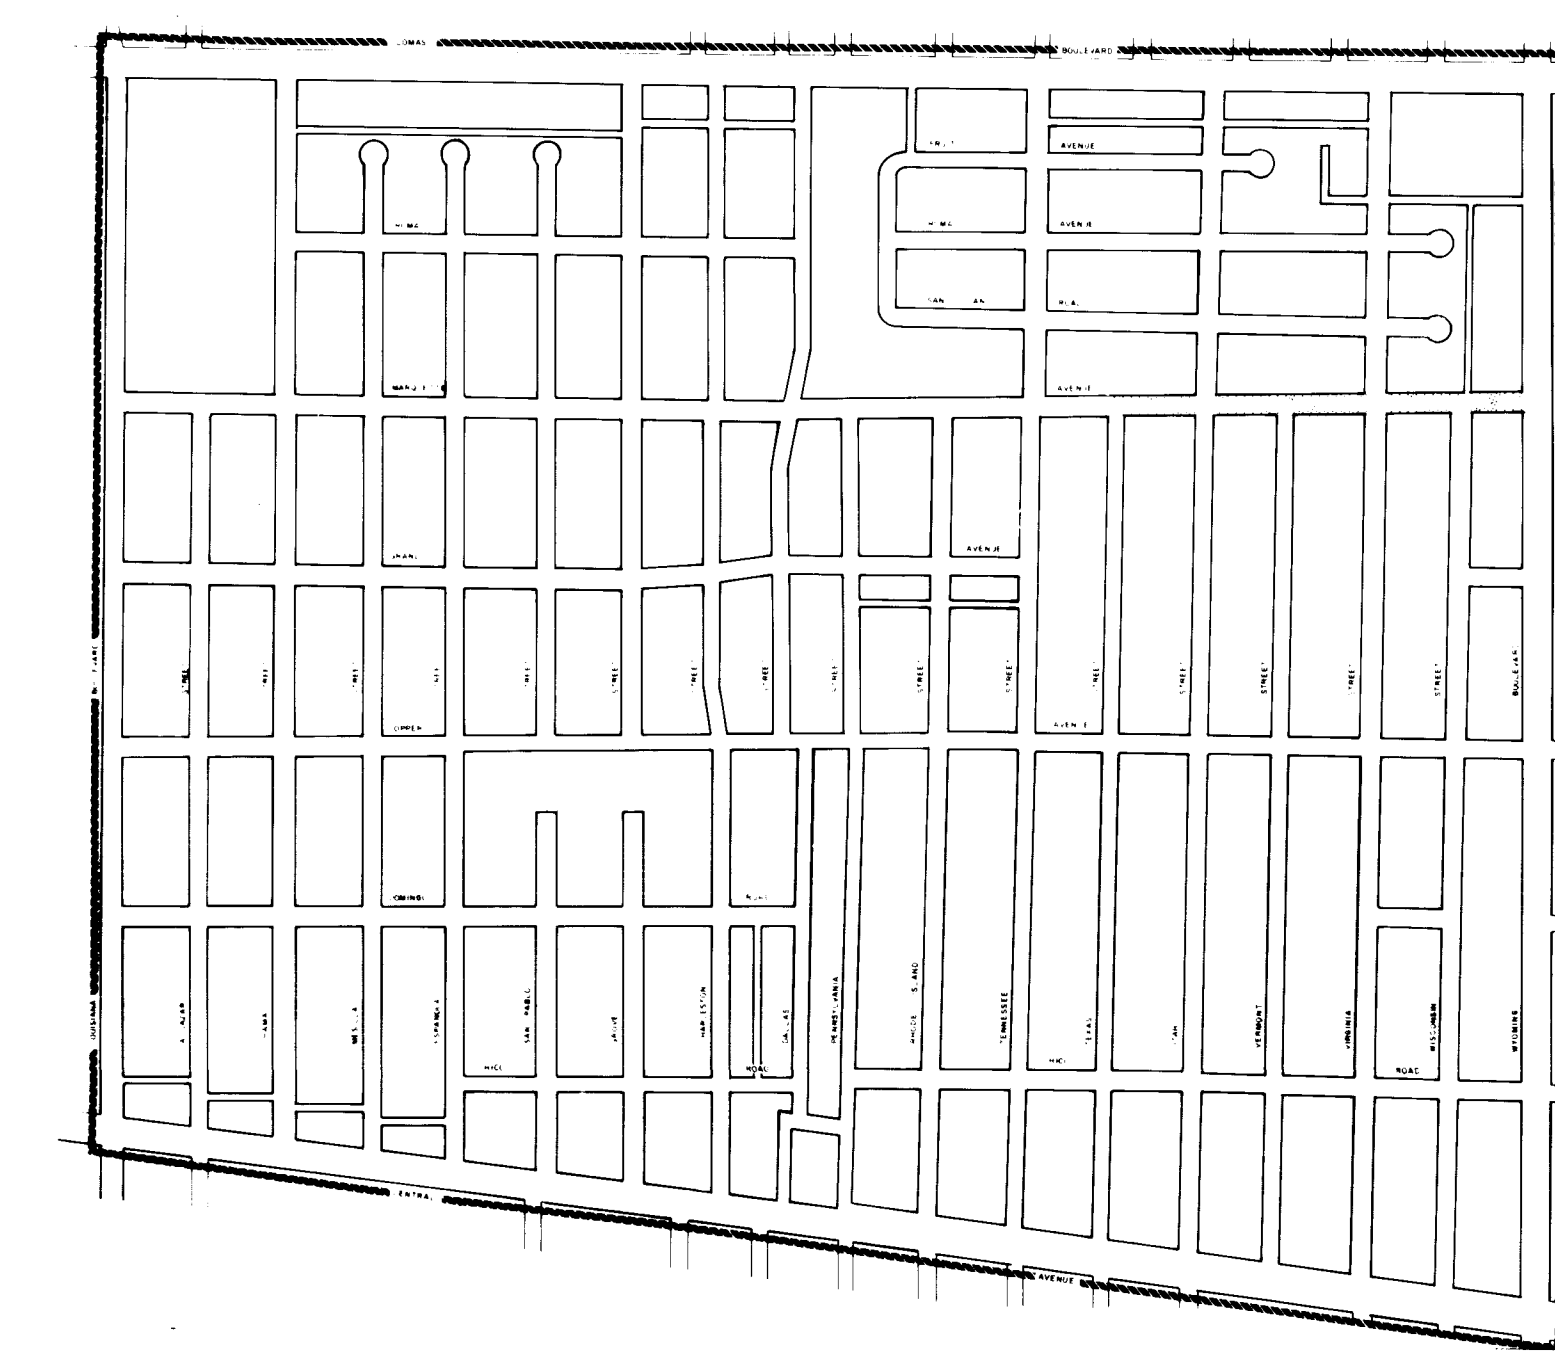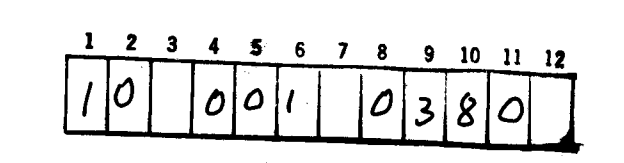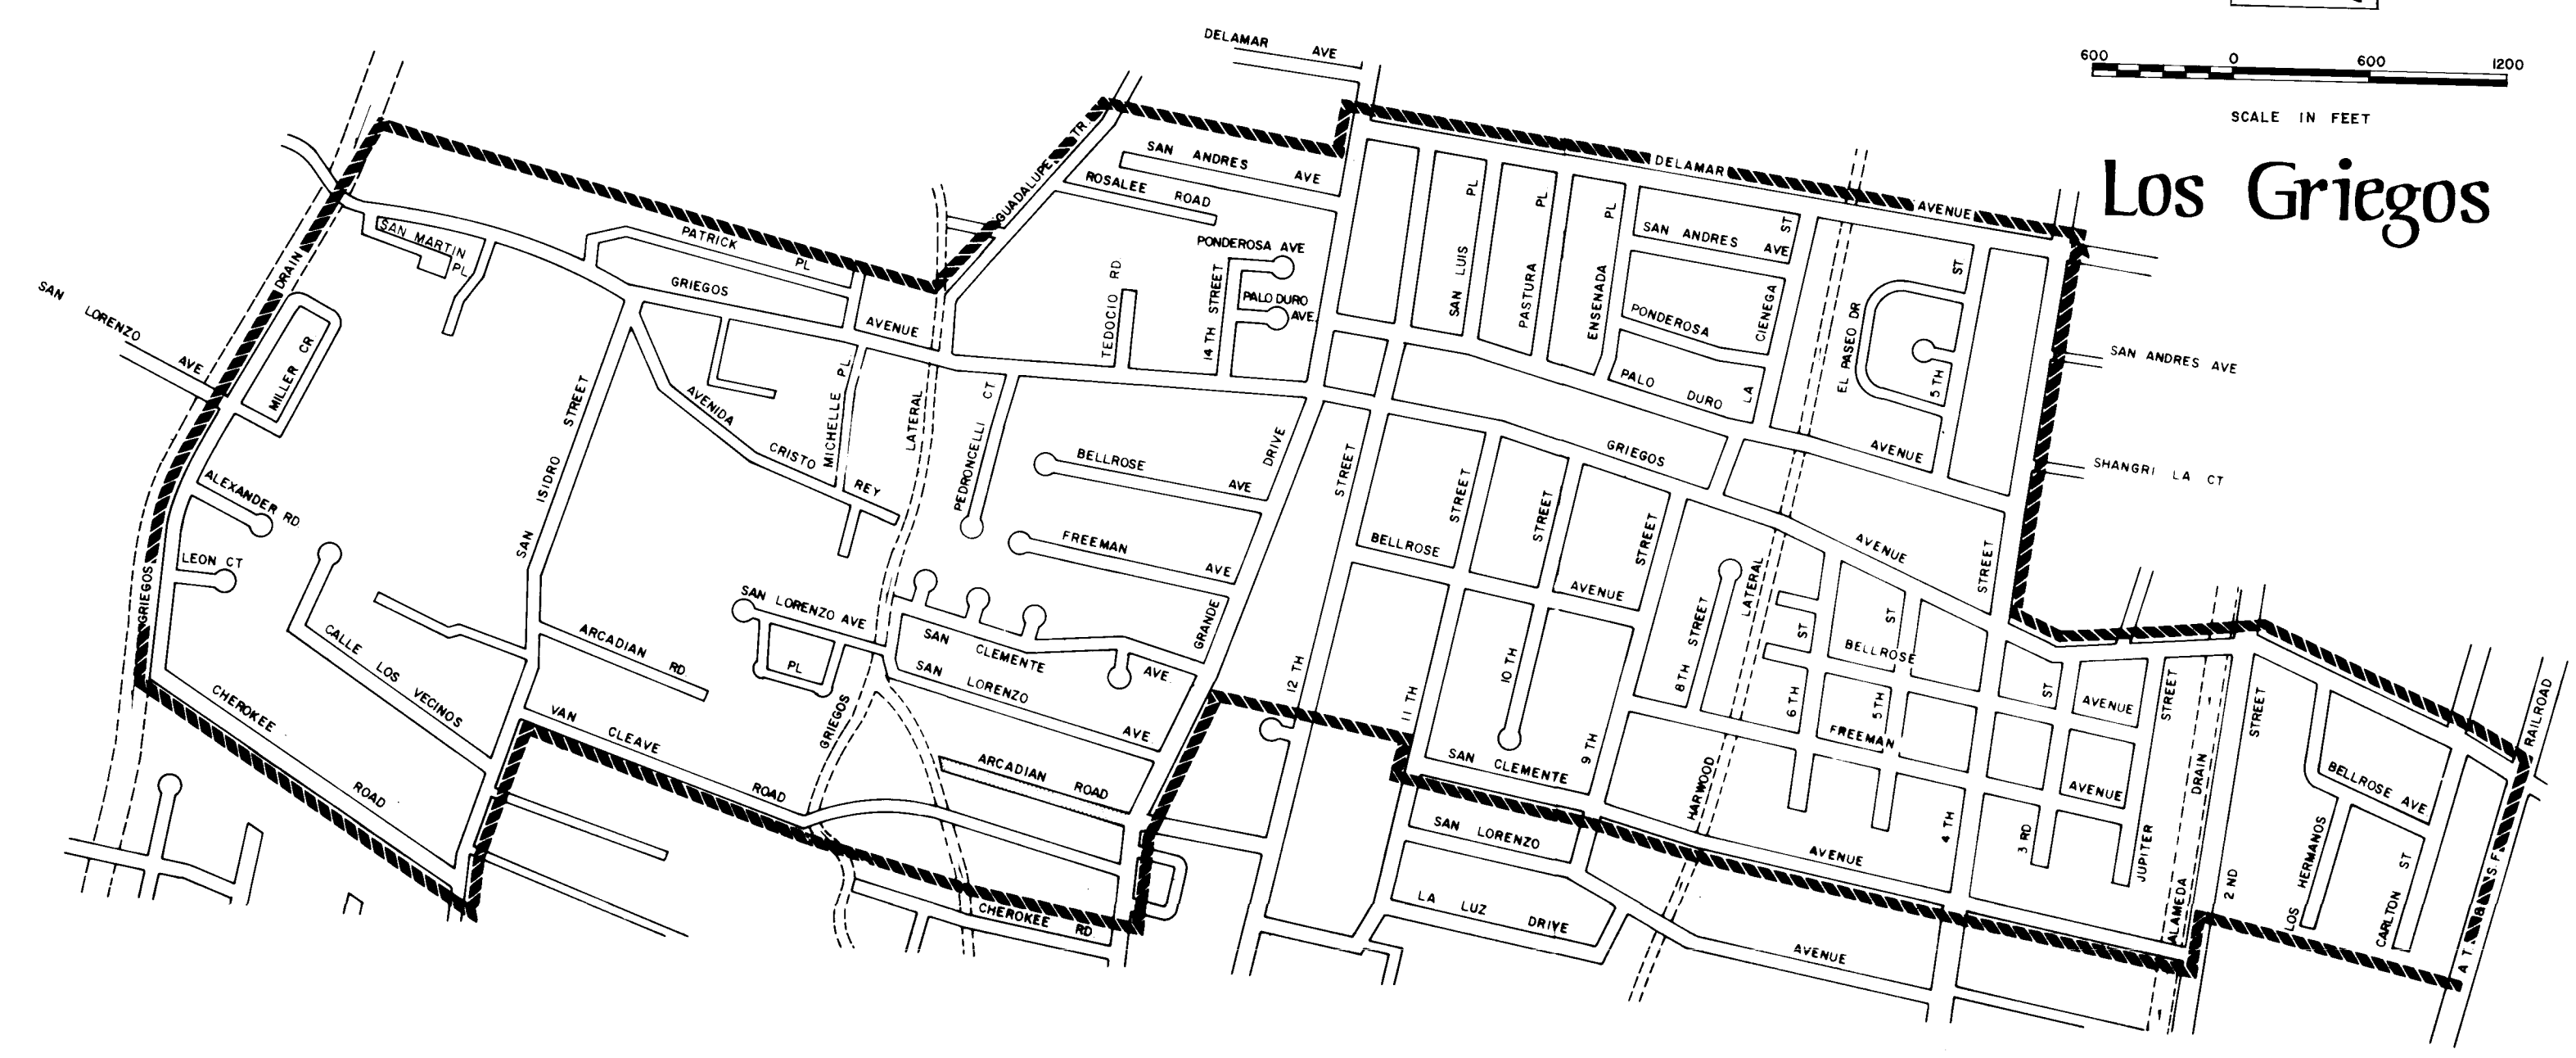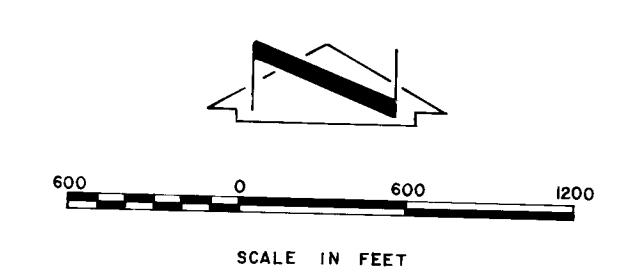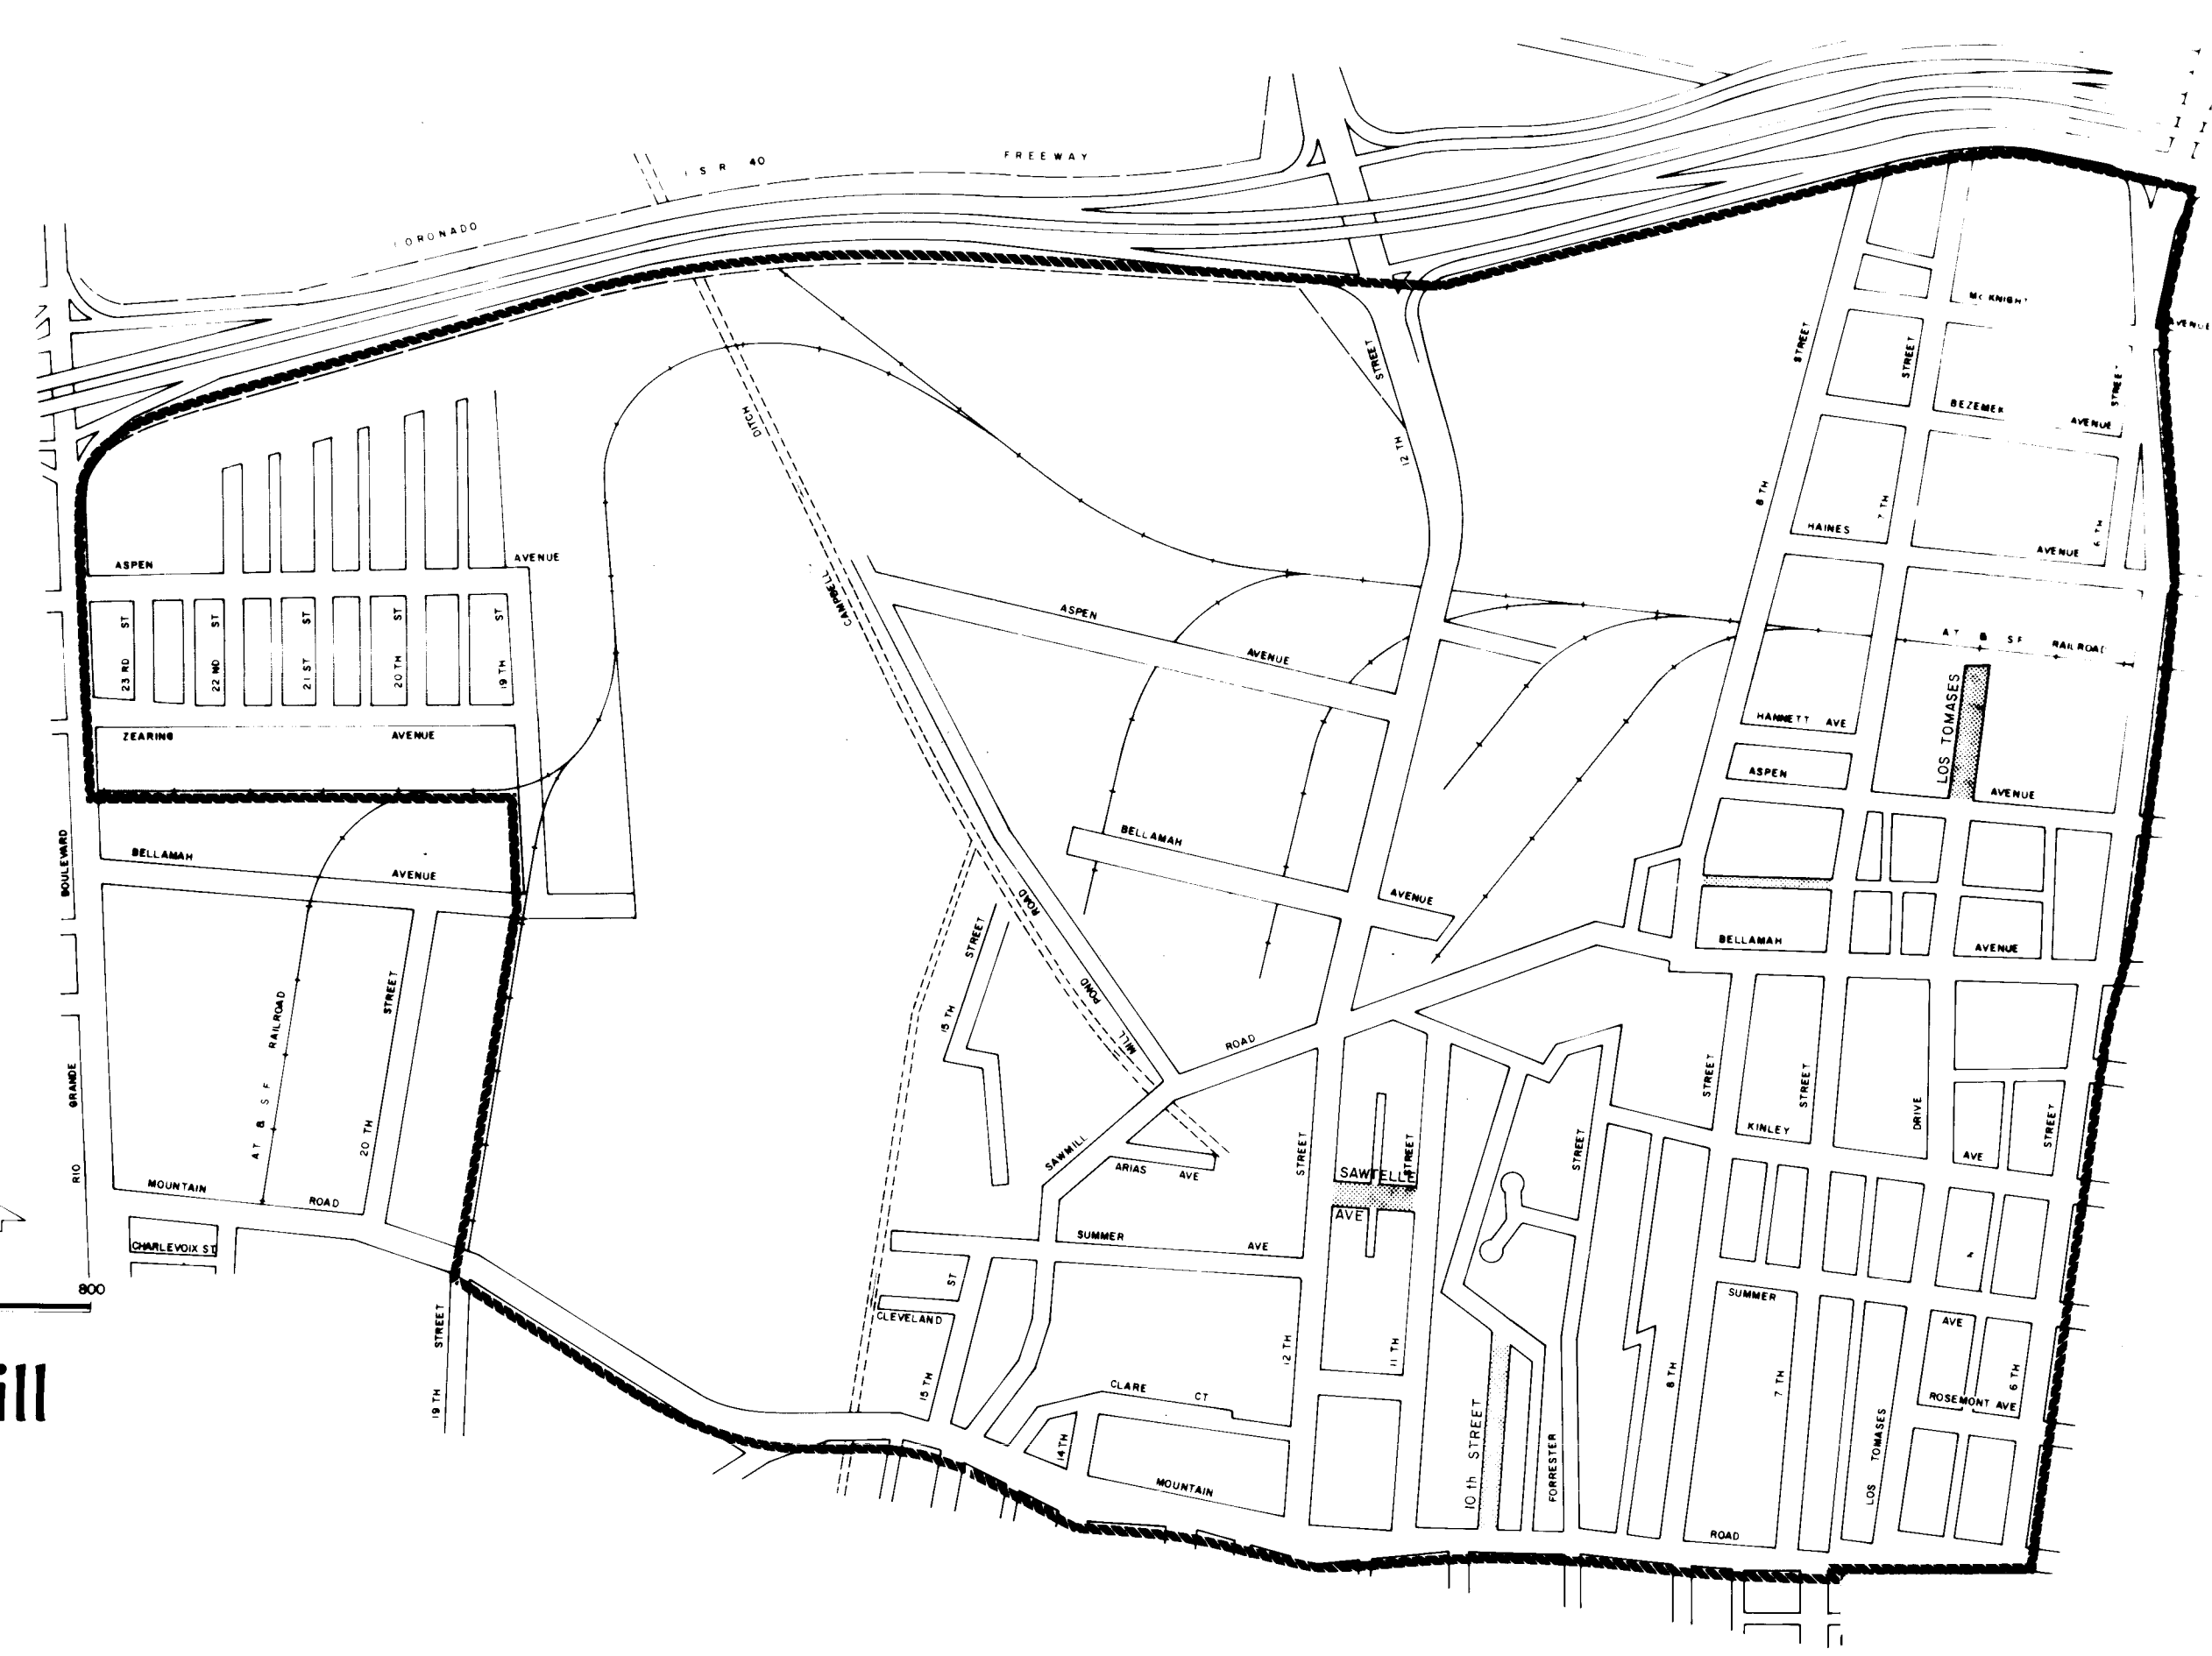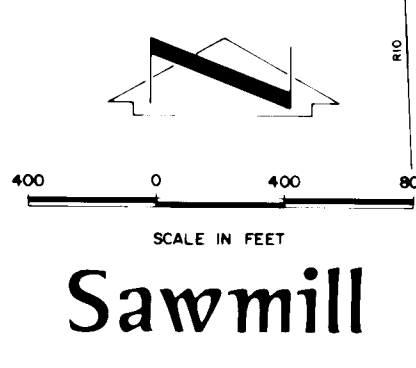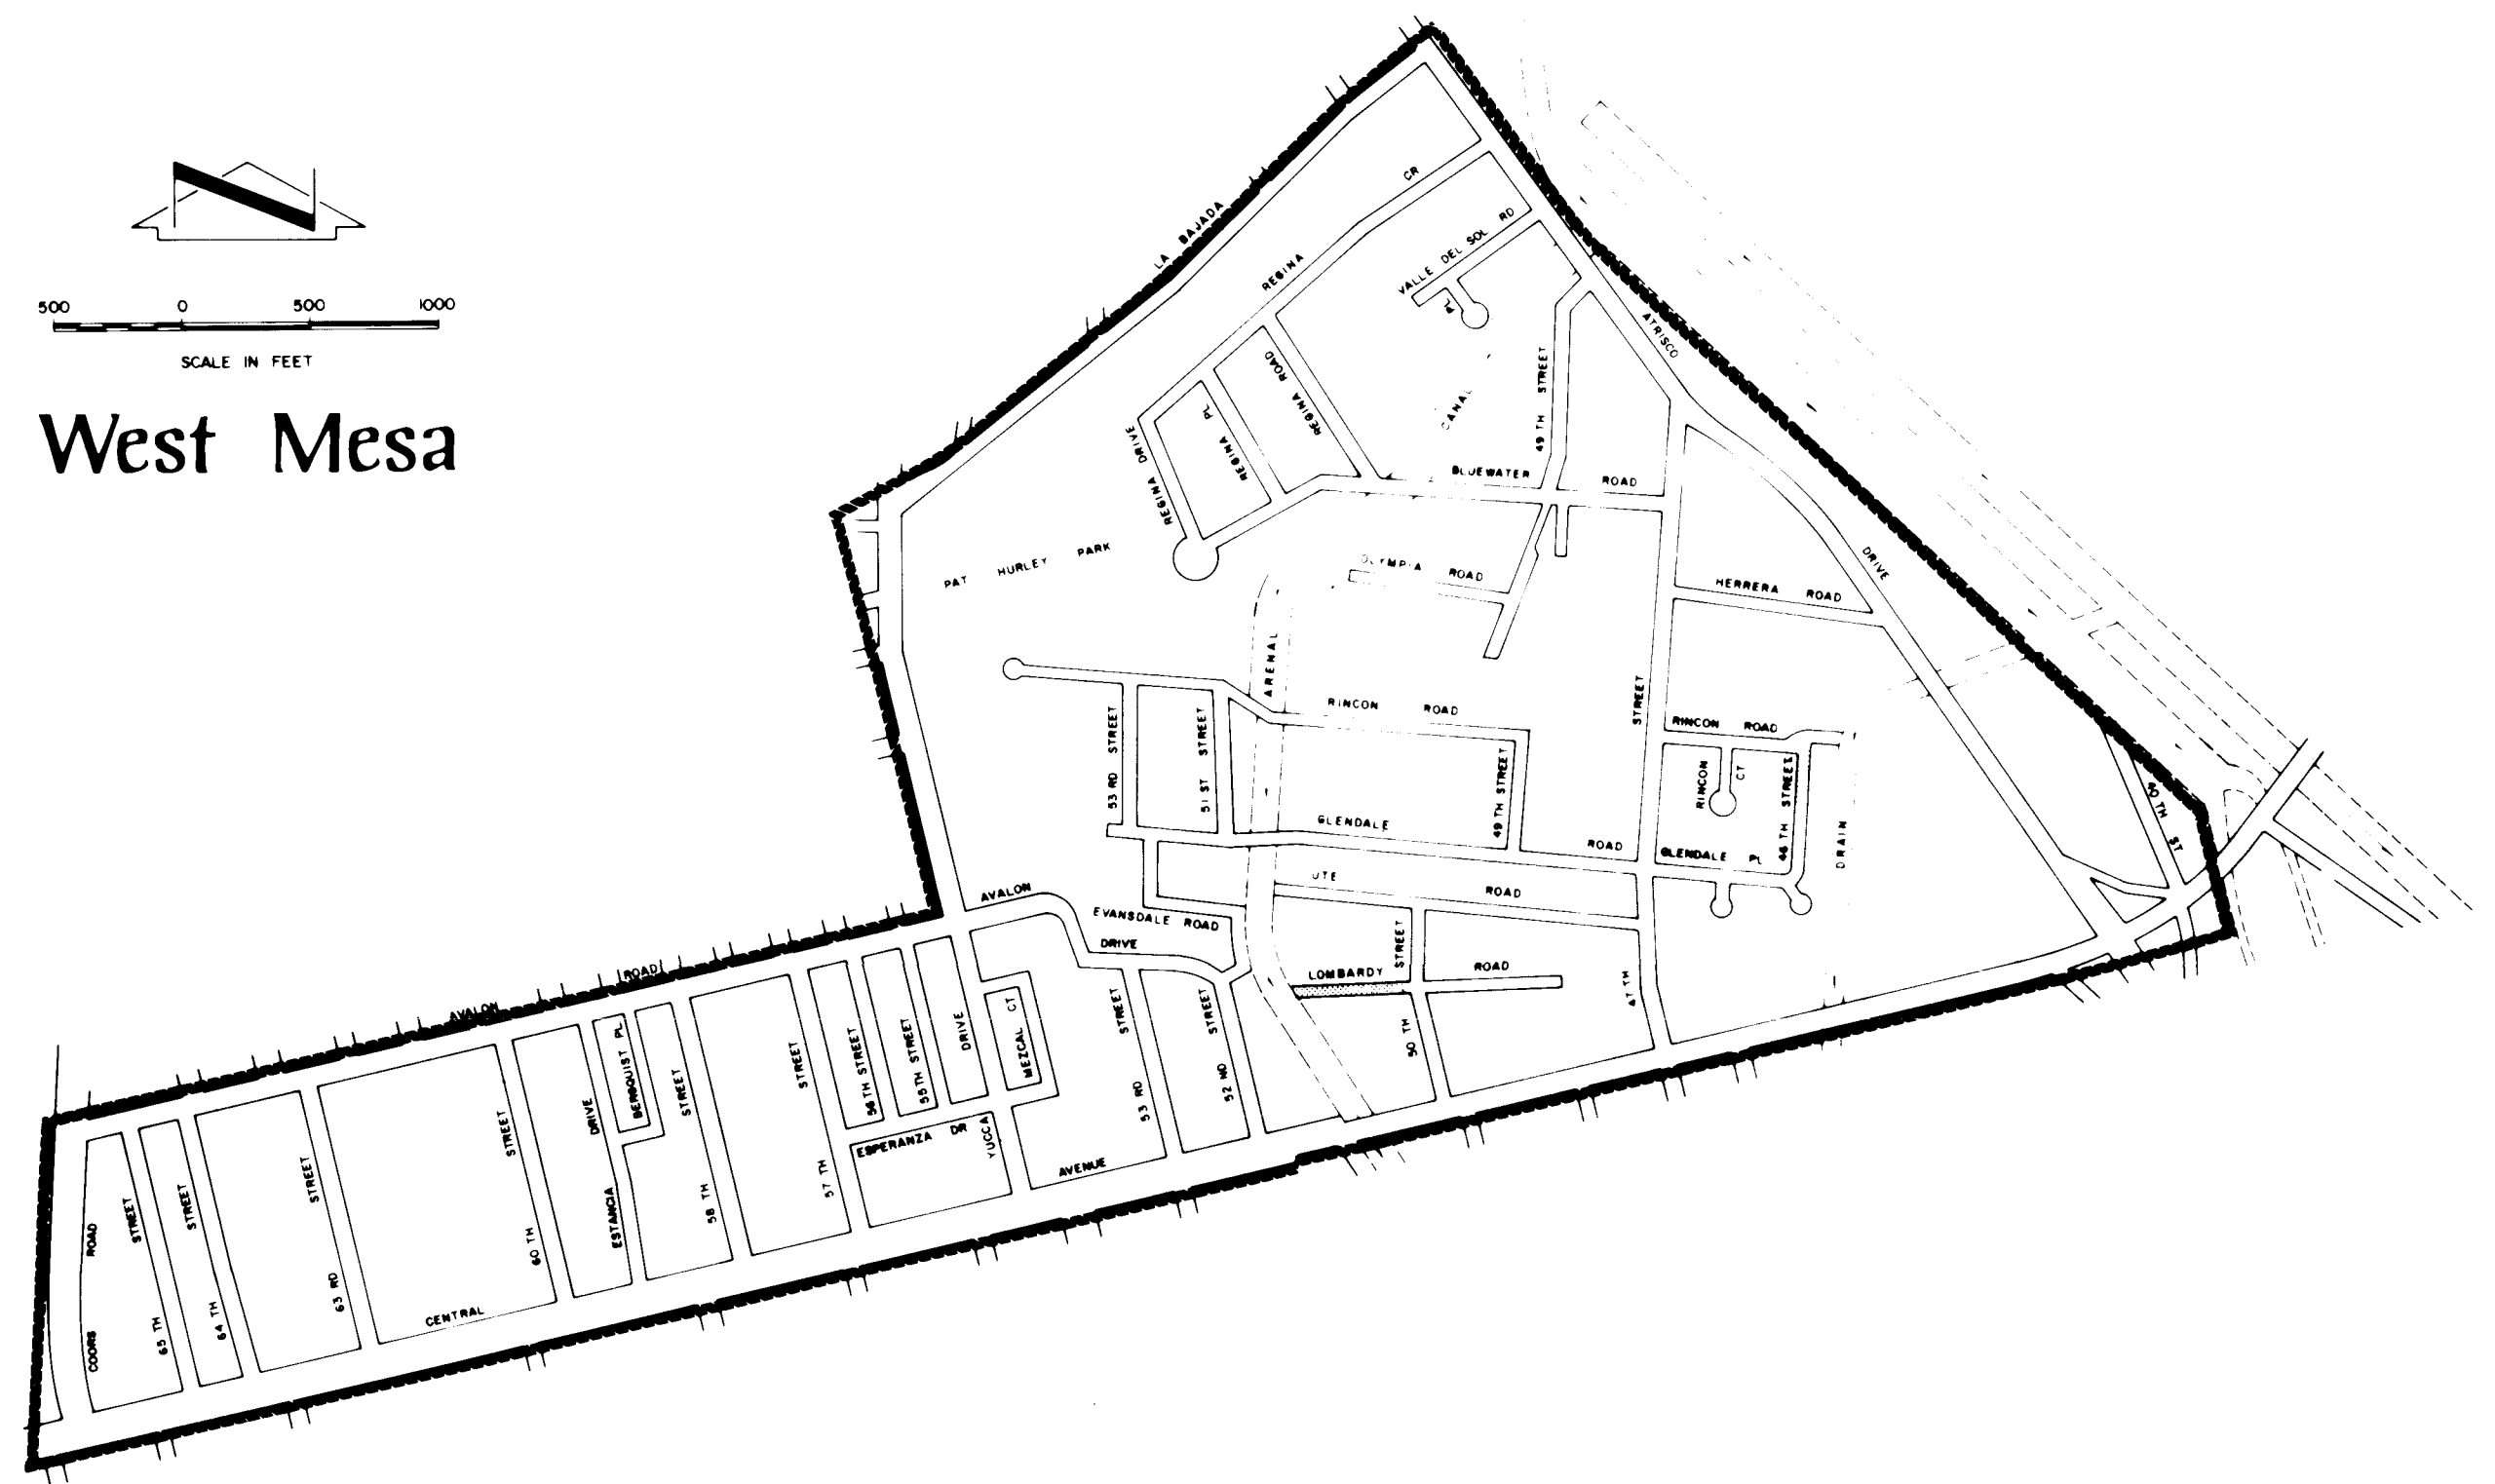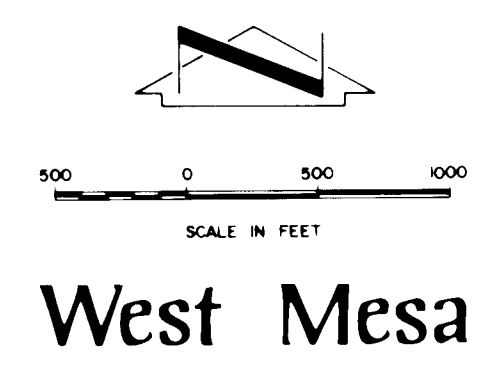

APPROVAL OF AS BUILT DRAWINGS
ASST. CITY ENGINEER - FIELD
[Signature]
DATE 4-12-88

AS CONSTRUCTED
DATE 2/29/80 BY *[Signature]*

ALBUQUERQUE CD-3A				
SITE MAPS				
COMMUNITY DEVELOPMENT PROGRAM				
albuquerque	bernalillo	county	new mexico	
DATE OCT. '78	JOB NO. 77011	SCALE AS SHOWN	DRAWN: LH	SHEET 3
			CHK'D: RL	OF 17
Scanlon & associates, inc. albuquerque Engineers-Planners antesia santa fe				

GENERAL NOTES

1. UTILITY POLES IN CONFLICT WITH THE CONSTRUCTION OF THIS PROJECT ARE TO BE RELOCATED BY OTHERS. THE CONTRACTOR SHALL COORDINATE ANY WORK REQUIRED BY OTHERS IN THE CONSTRUCTION AREA.
2. THE CONTRACTOR SHALL NOTIFY ALL UTILITY COMPANIES WHEN WORKING NEAR THEIR SYSTEMS. CALL 765-1234 REGARDING LOCATION OF UNDERGROUND UTILITY LINES.
3. ALL EXISTING UTILITIES SHOWN HERE WERE TAKEN AS ACCURATELY AS POSSIBLE FROM RECORD DRAWINGS AND SURFACE INDICATIONS. IT SHALL BE THE CONTRACTOR'S RESPONSIBILITY TO PROTECT, MAINTAIN IN SERVICE, AND VERIFY EXACT LOCATIONS OF ALL AFFECTED UTILITIES DURING CONSTRUCTION OF THIS PROJECT.
4. ALL UTILITIES WHICH ARE TO BE ABANDONED UNDER THIS CONTRACT SHALL BE PLUGGED WITH CONCRETE AT EACH END OF THE PORTION TO BE ABANDONED. PAYMENT FOR THIS WORK WILL BE INCIDENTAL TO THE WORK ON THE ADJACENT LINES.
5. CONNECTION OF NEW SEWER LINES TO EXISTING MANHOLES AND PLUGGING OF EXISTING LINES IN MANHOLES SHALL BE INCIDENTAL TO OTHER ITEMS OF WORK.
6. NEW WATER MAINS SHALL HAVE A MINIMUM COVER OF 36".
7. REMOVE ALL VALVE BOXES FROM ABANDONED WATER LINES. PAYMENT WILL BE INCIDENTAL TO THE PAVING COST.
8. ALL ABANDONED VALVE AND METER BOX FRAMES AND COVERS SHALL BE RETURNED TO THE CITY WATER DIVISION WAREHOUSE AND ALL STORM AND SANITARY MANHOLE LIDS AND INLET GRATES, CASTINGS, AND FRAMES NOT REUSED, SHALL BE RETURNED TO THE LIQUID WASTE DIVISION WAREHOUSE.
9. THE CONTRACTOR SHALL BE RESPONSIBLE FOR LOCATING DROP INLETS TO CLEAR DRIVE PADS.
10. FIRE HYDRANTS WHICH ARE TO BE REMOVED AND ARE NOT TO BE RELOCATED SHALL BE RETURNED TO THE CITY WATER DIVISION WAREHOUSE.
11. THE CONTRACTOR SHALL EXPOSE EXISTING WATER LINES AT LOCATIONS WHERE NEW SANITARY SEWER LINES CROSS OR PARALLEL SUCH LINES IN ORDER TO ADEQUATELY ESTABLISH THE PROXIMITY OF WATER AND SEWER LINES. THE COST OF THIS WORK SHALL BE INCIDENTAL TO OTHER ITEMS OF WORK.
12. TEMPORARY RELOCATION OF EXISTING UTILITIES FOR THE CONVENIENCE OF THE CONTRACTOR WILL BE AT HIS OWN EXPENSE.
13. ALL PRIVATE UTILITY MANHOLES AND VALVE BOXES IN CONSTRUCTION AREA TO BE ADJUSTED TO GRADE BY THE CONTRACTOR IN ACCORDANCE WITH UTILITY RECOMMENDATIONS.
14. ALL CITY OWNED UTILITY MANHOLES AND VALVE BOXES IN CONSTRUCTION AREA TO BE ADJUSTED TO GRADE BY THE CONTRACTOR. PAYMENT TO BE MADE UNDER APPROPRIATE BID ITEM. THE GRADE ADJUSTMENT REQUIRED FOR ANY NEW OR RELOCATED ITEMS SHALL BE INCIDENTAL TO THE COST OF THE NEW ITEMS OR THE COST OF RELOCATION.
15. DURING THE CONSTRUCTION PERIOD THE UTMOST CARE SHALL BE TAKEN TO SEE THAT THE INSIDE OF PIPES, FITTINGS AND VALVES ARE FREE FROM ALL FOREIGN MATTER SUCH AS DIRT, ROCKS, STICKS, ETC., AND SHALL BE KEPT CLEAN IN ACCORDANCE WITH THE SPECIFICATIONS.
16. POLICY ON PROXIMITY OF WATER AND SEWER LINES: WHENEVER POSSIBLE, IT IS DESIRABLE TO LAY PARALLEL WATER AND SEWER LINES AT LEAST TEN FEET (10') APART HORIZONTALLY, AND THE WATER LINE SHOULD BE AT A HIGHER ELEVATION THAN THE SEWER. IF THIS IS NOT POSSIBLE, SEPARATE TRENCHES WILL BE REQUIRED IN ALL CASES (THIS SHALL BE EFFECTIVE EVEN THOUGH ONE LINE HAS BEEN INSTALLED PRIOR TO THE OTHERS), AND THE WATER LINE SHALL BE AT LEAST TWO FEET (2') ABOVE THE SEWER. WHEREVER WATER AND SEWER LINES CROSS EACH OTHER, THE WATER LINE SHALL BE AT LEAST THREE FEET (3') ABOVE THE SEWER; OTHERWISE, THE SEWER SHALL BE OF STEEL OR CAST IRON PIPE, OR EQUIVALENT, FOR TEN FEET (10') ON EACH SIDE OF THE WATER LINE.
17. NEW MANHOLES WHICH ARE TO BE INSTALLED WITHIN EXISTING WATER TABLE TO BE COATED ON EXTERIOR TO 2' ABOVE THE WATER TABLE WITH KOPPERS BITUMASTIC SUPER SERVICE BLACK COATING. TWO COATS TO BE APPLIED AT A RATE OF 70 SQUARE FEET PER GALLON PER COAT.
18. PROFILE GRADES ARE AS INDICATED ON TYPICAL CURB & GUTTER DETAILS, SHEET 16 OF 17.
19. CURB RETURN RADII AND STREET WIDTHS ARE TO THE FACE OF THE CURB UNLESS OTHERWISE INDICATED ON THE PLANS.
20. CURB & GUTTER SHOWN AS EXISTING AND NOT TO BE REMOVED UNDER THIS CONTRACT WHICH IS DAMAGED OR DISPLACED BY THE CONTRACTOR OR HIS SUBCONTRACTORS, SHALL BE REPLACED BY THE CONTRACTOR AT HIS EXPENSE.
21. WHEN ABUTTING NEW PAVEMENT TO EXISTING, JUST PRIOR TO REPAVING CUT BACK EXISTING PAVING ON A STRAIGHT LINE AS REQUIRED TO REMOVE ANY BROKEN, RAVELED OR CRACKED PAVING AND MATCH THE NEW PAVING GRADE TO THE EXISTING.
22. WHERE REMOVAL OF EXISTING CURB & GUTTER OR SIDEWALK IS REQUIRED, REMOVE TO THE NEAREST JOINT OR SAW CUT.
23. EXISTING MATERIALS TO BE REMOVED AND PAID FOR ON A UNIT BASIS SHALL BE MEASURED AND THE QUANTITIES APPROVED BY THE ENGINEER BEFORE REMOVAL.
24. THE MAXIMUM ALLOWABLE QUANTITIES FOR PAYMENT FOR REPLACEMENT OF PAVEMENT WHERE WATER, SANITARY SEWER, AND STORM SEWER ARE TO BE INSTALLED UNDER EXISTING PAVEMENT WILL BE COMPUTED IN ACCORDANCE WITH THE SPECIFICATIONS.
25. WHEEL CHAIR RAMPS TO BE CONSTRUCTED AT OR NEAR CURB RETURNS AS SHOWN IN THE PLANS. ALL WORK SHALL BE IN ACCORDANCE WITH THE SPECIFICATIONS. THE EXACT LOCATION OF EACH RAMP SHALL BE DETERMINED IN THE FIELD.
26. WHEN CONSTRUCTION OF A NEW WHEEL CHAIR RAMP IS CALLED FOR AT A LOCATION WHERE CURB & GUTTER EXIST, THE CONTRACTOR SHALL REMOVE AND REPLACE EXISTING IMPROVEMENTS AS REQUIRED TO CONSTRUCT RAMP. PAYMENT FOR THIS WORK WILL BE MADE UNDER APPROPRIATE BID ITEMS.

LEGEND

- NEW CURB & GUTTER
- NEW SIDEWALK
- WHEEL CHAIR RAMP
- PAVING LIMITS
- NEW CONCRETE PAVEMENT
- RIGHT-OF-WAY LINE
- FINISHED FLOOR ELEVATION
- EXISTING SANITARY SEWER MANHOLE
- EXISTING STORM DRAIN MANHOLE
- DROP INLET
- SPOT ELEVATION
- NEW FIRE HYDRANT
- EXISTING WATER METER
- EXISTING WATER VALVE
- EXISTING WATER LINE
- NEW WATER LINE
- EXISTING SANITARY SEWER LINE
- NEW SANITARY SEWER LINE
- EXISTING STORM DRAIN LINE
- NEW STORM DRAIN LINE
- EXISTING TELEPHONE CABLE
- EXISTING GAS LINE
- NEW SANITARY SEWER MANHOLE
- NEW STORM DRAIN MANHOLE
- NEW WATER VALVE
- WATER VALVE STEM ELEVATION
- SECTION NUMBER
- SHEET WHERE SECTION IS SHOWN
- SHEET WHERE SECTION IS CUT

1	2	3	4	5	6	7	8	9	10	11	12
1	0	0	2	1	0	4	8	0			

APPROVAL OF AS BUILT DRAWINGS
ASST. CITY ENGINEER - FIELD
[Signature]
DATE: 4-18-80

AS CONSTRUCTED
DATE 2/29/80 BY *[Signature]*



ALBUQUERQUE		CD - 3A	
GENERAL NOTES & LEGEND			
COMMUNITY DEVELOPMENT PROGRAM			
albuquerque		bernalillo	county new mexico
DATE OCT. '78	JOB NO. 77011	SCALE NO SCALE	DRAWN: LH CHK'D: RL
SHEET 4		OF 17	
Scanlon & associates, inc. albuquerque		Engineers-Planners artesia santa fe	



26' VALLEY SECTION CONCRETE PAVEMENT TYPE B
ARCADIAN ROAD 6-13, 6-14

PLAN
SCALE: 1"=40'

Note: Verify location of existing waterline before starting construction of sanitary sewer line.

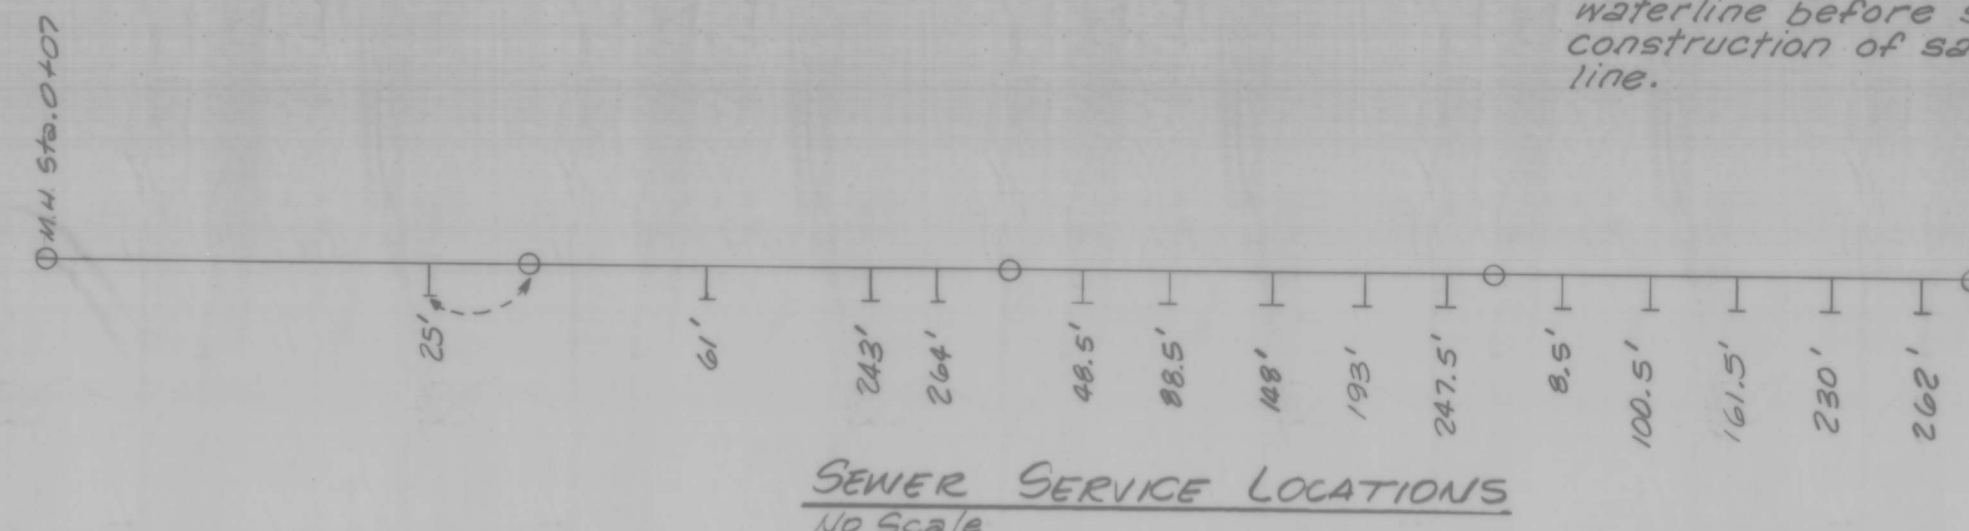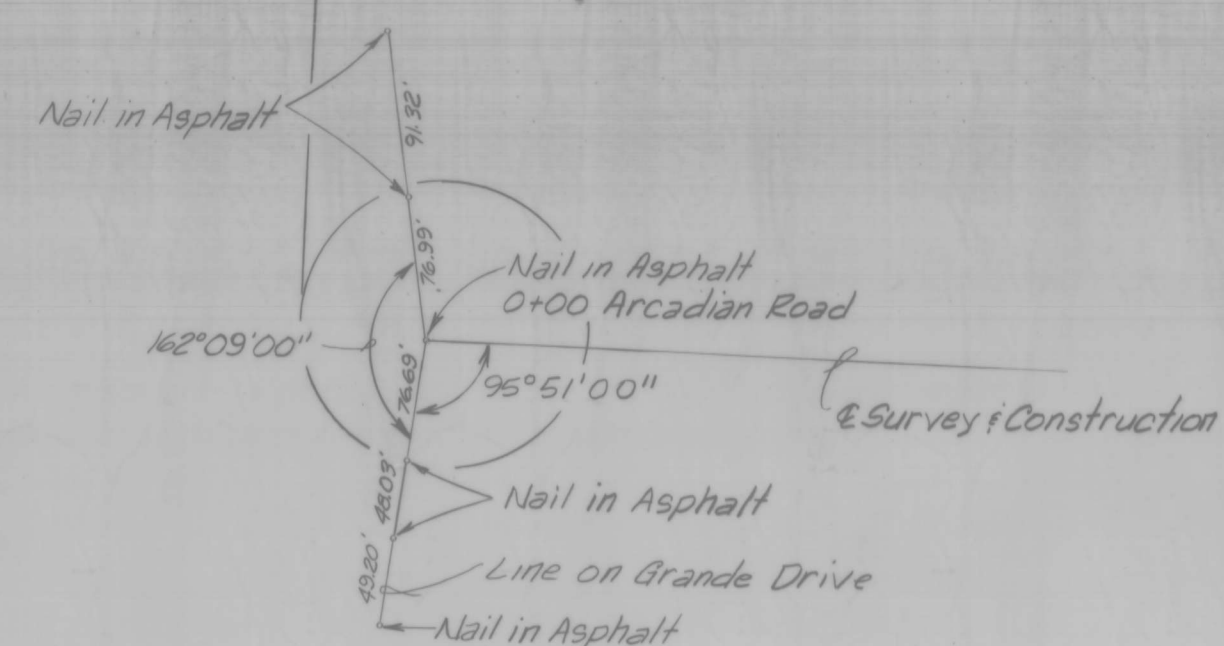

PROFILE
SCALE: 1"=40' HORIZ.
1"= 2' VERT.

APPROVAL OF AS BUILT DRAWINGS
ASST. CITY ENGINEER-FIELD
[Signature]
DATE 4-18-80

AS CONSTRUCTED
DATE 2/29/80 BY *[Signature]*



COMMUNITY DEVELOPMENT PROGRAM
ALBUQUERQUE CD-3A

albuquerque bernalillo county new mexico


LOS GRIEGOS

ARCADIAN ROAD

DATE OCT. '78	JOB NO. 77011	SCALE AS SHOWN	DRAWN: LH	SHEET 5
		CHK'D: RL		OF 17

Scanlon & associates, inc.
albuquerque Engineers-Planners santa fe

SCANNED BY
BY LASON

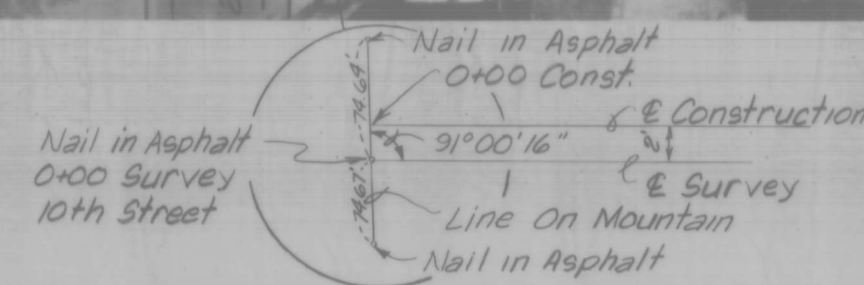

18' VALLEY SECTION 5 1/2' CONCRETE PAVEMENT TYPE A
10th STREET J-13


PLAN
SCALE: 1"=40'

SEWER SERVICE LOCATIONS
No Scale




32' STANDARD SECTION TYPE I PAVEMENT
SAWTELLE AVENUE J-13

PLAN
SCALE: 1"=40'

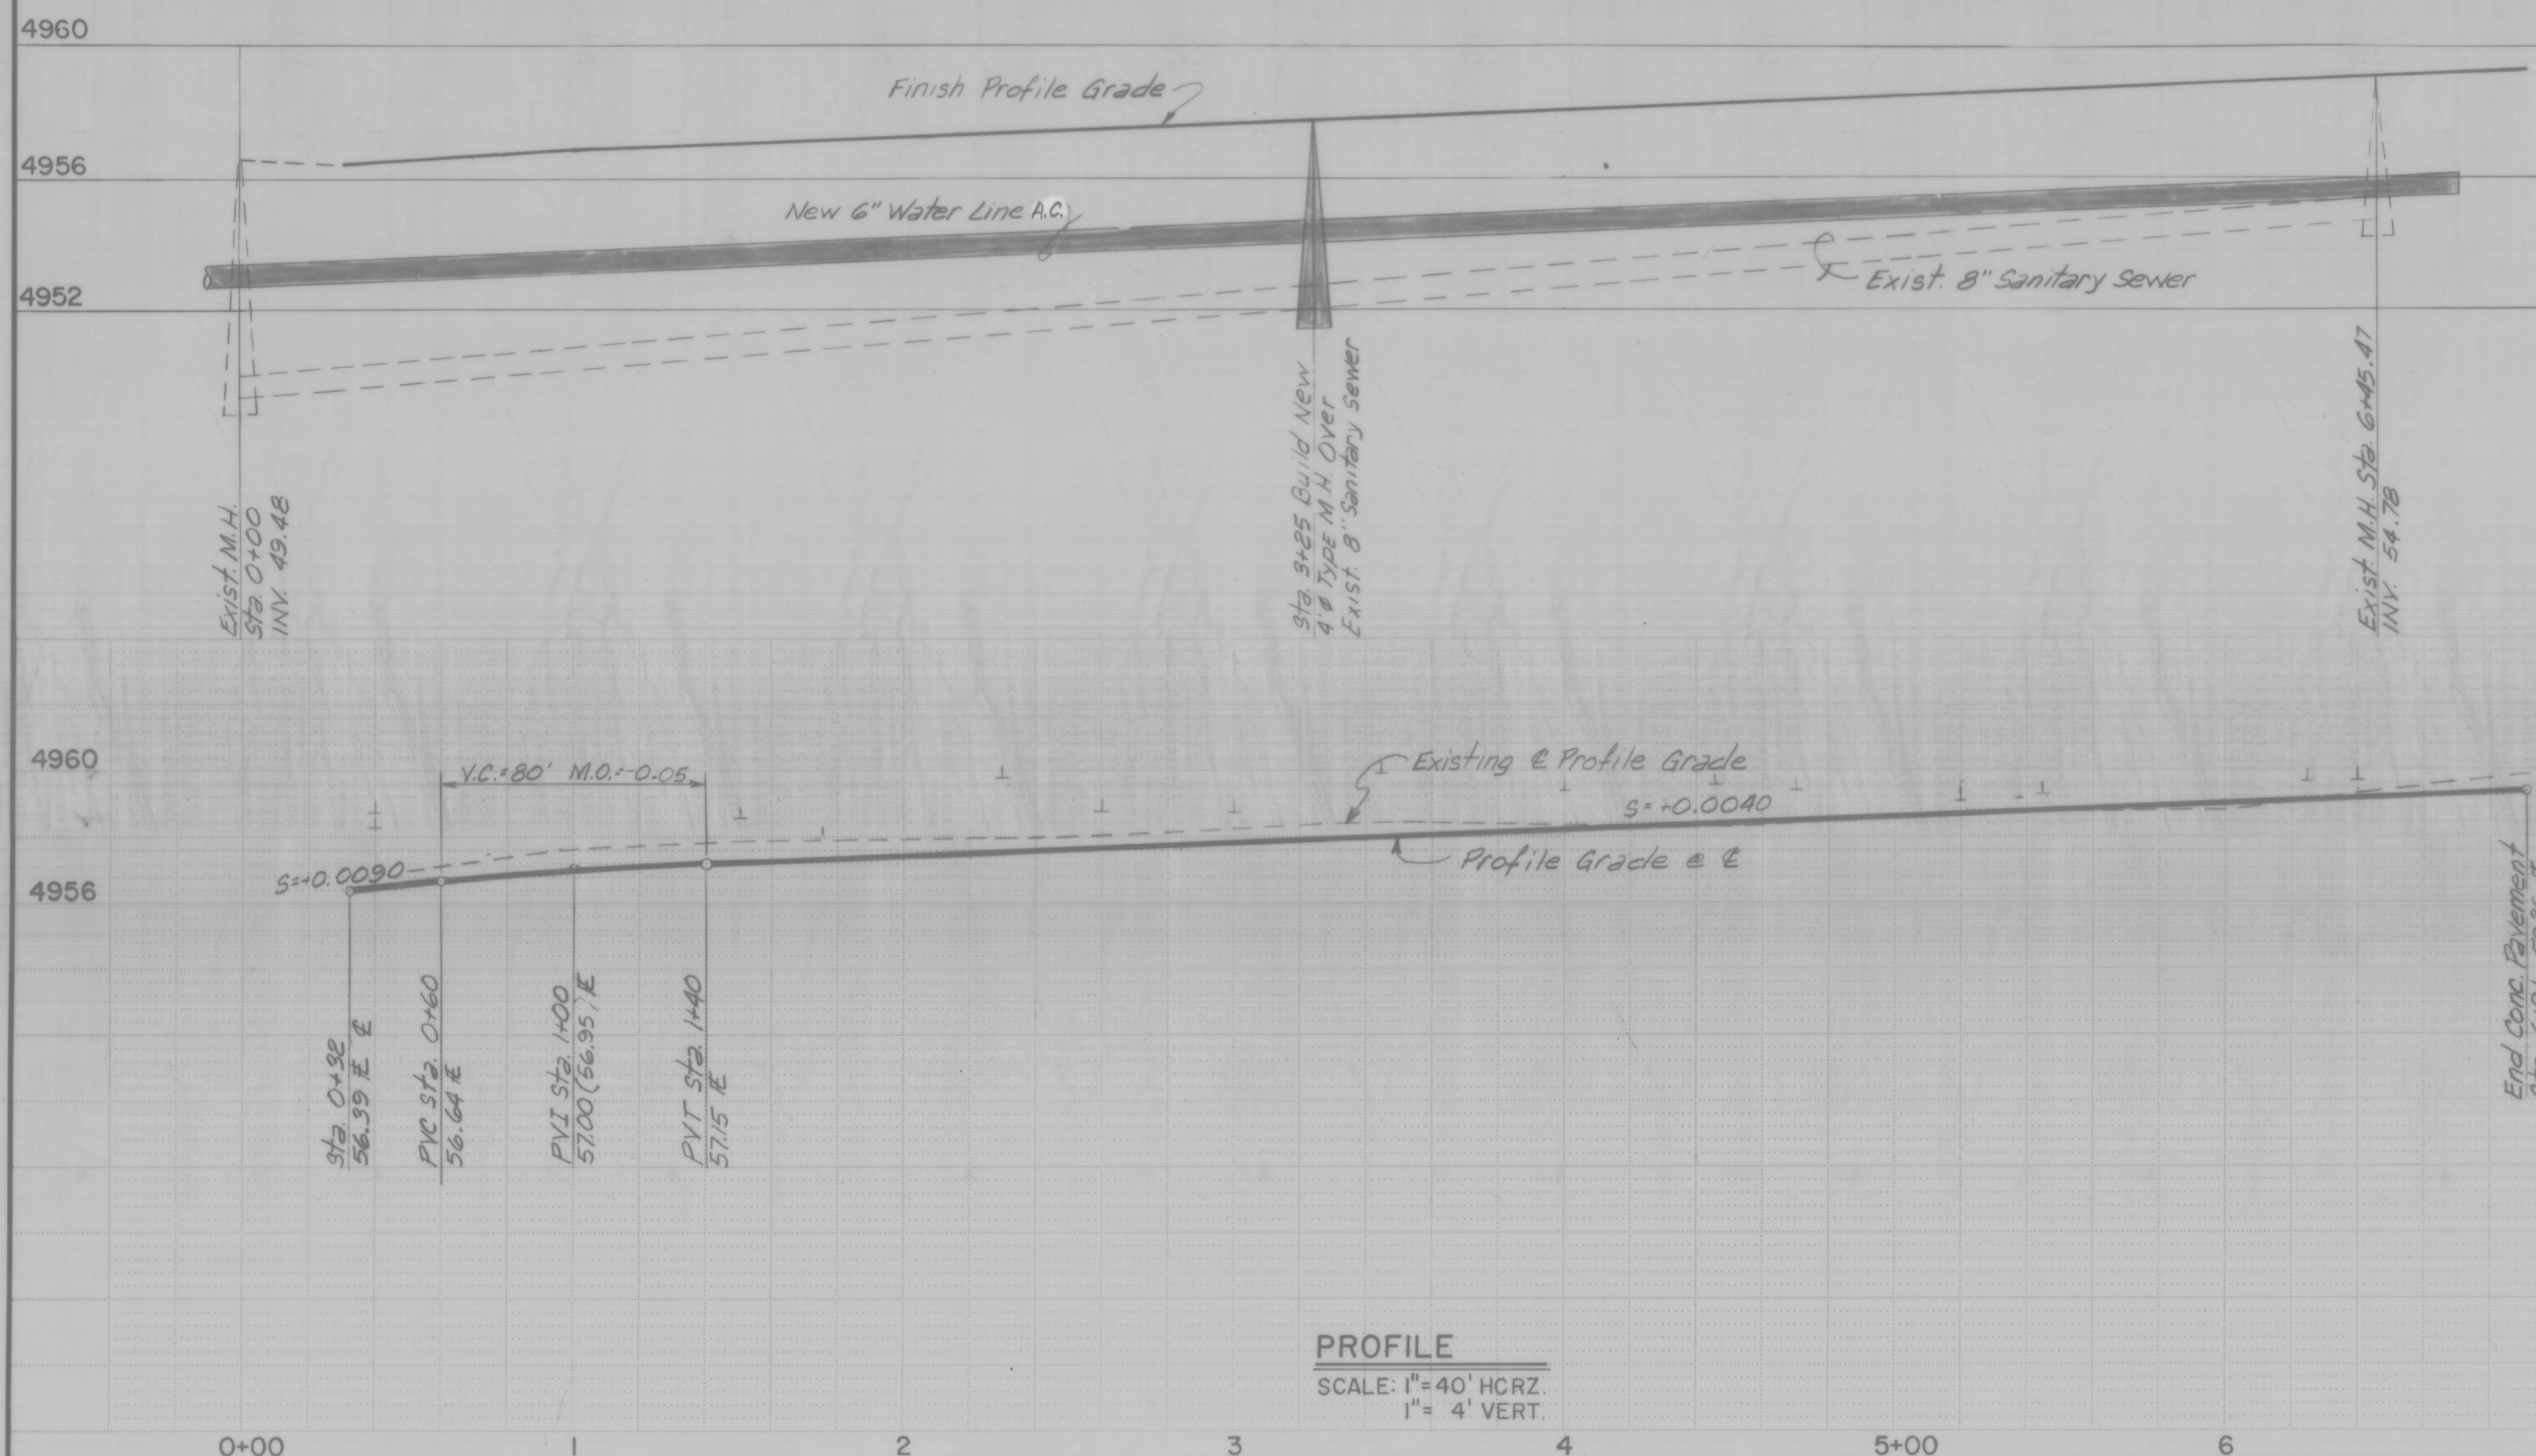

PROFILE
SCALE: 1"=40' HCRZ.
1"=4' VERT.

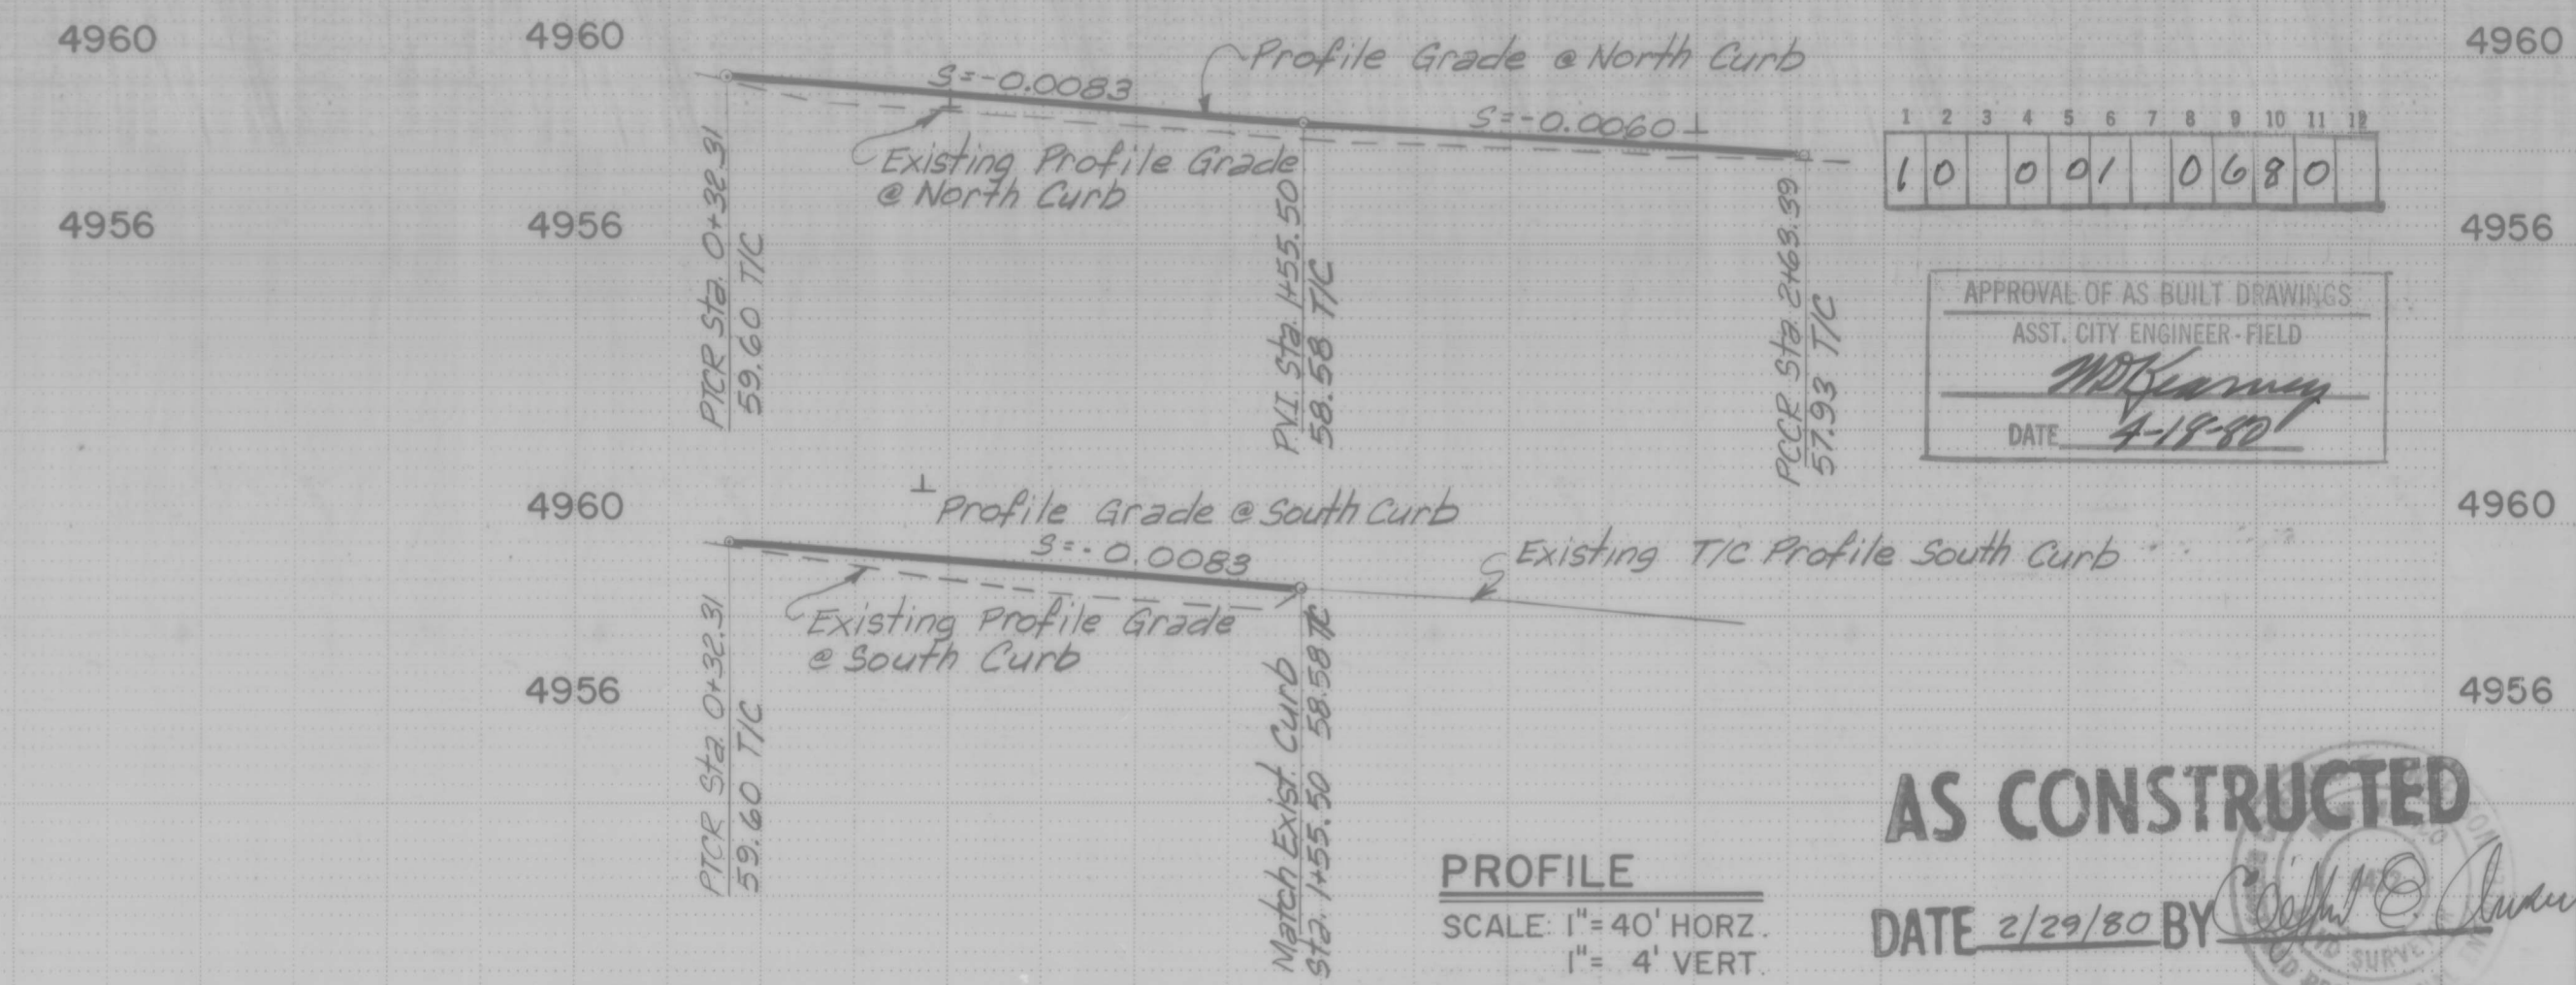

PROFILE
SCALE: 1"=40' HCRZ.
1"=4' VERT.

AS CONSTRUCTED

DATE 2/29/80 BY [Signature]



COMMUNITY DEVELOPMENT PROGRAM
ALBUQUERQUE CD-3A

albuquerque bernalillo county new mexico


SAWMILL

10th STREET - SAWTELLE AVENUE

DATE	JOB NO.	SCALE	DRAWN:	SHEET
OCT. '78	77011	AS SHOWN	AO	6
		CHK'D:	RL	OF 17


Scanlon & associates, inc.
Engineers-Planners
albuquerque artesia santa fe

SCANNED BY
R. LASON

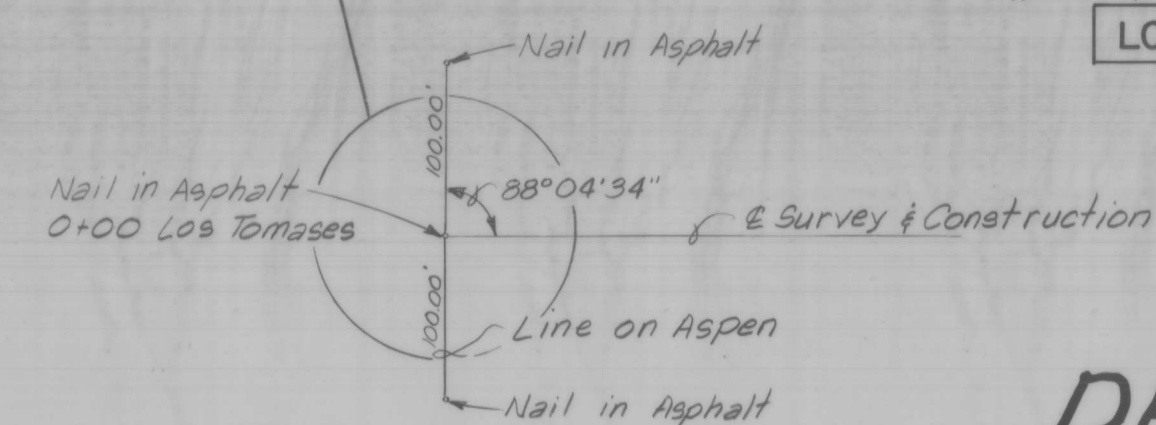

PLAN
SCALE: 1"=40'

DELETED

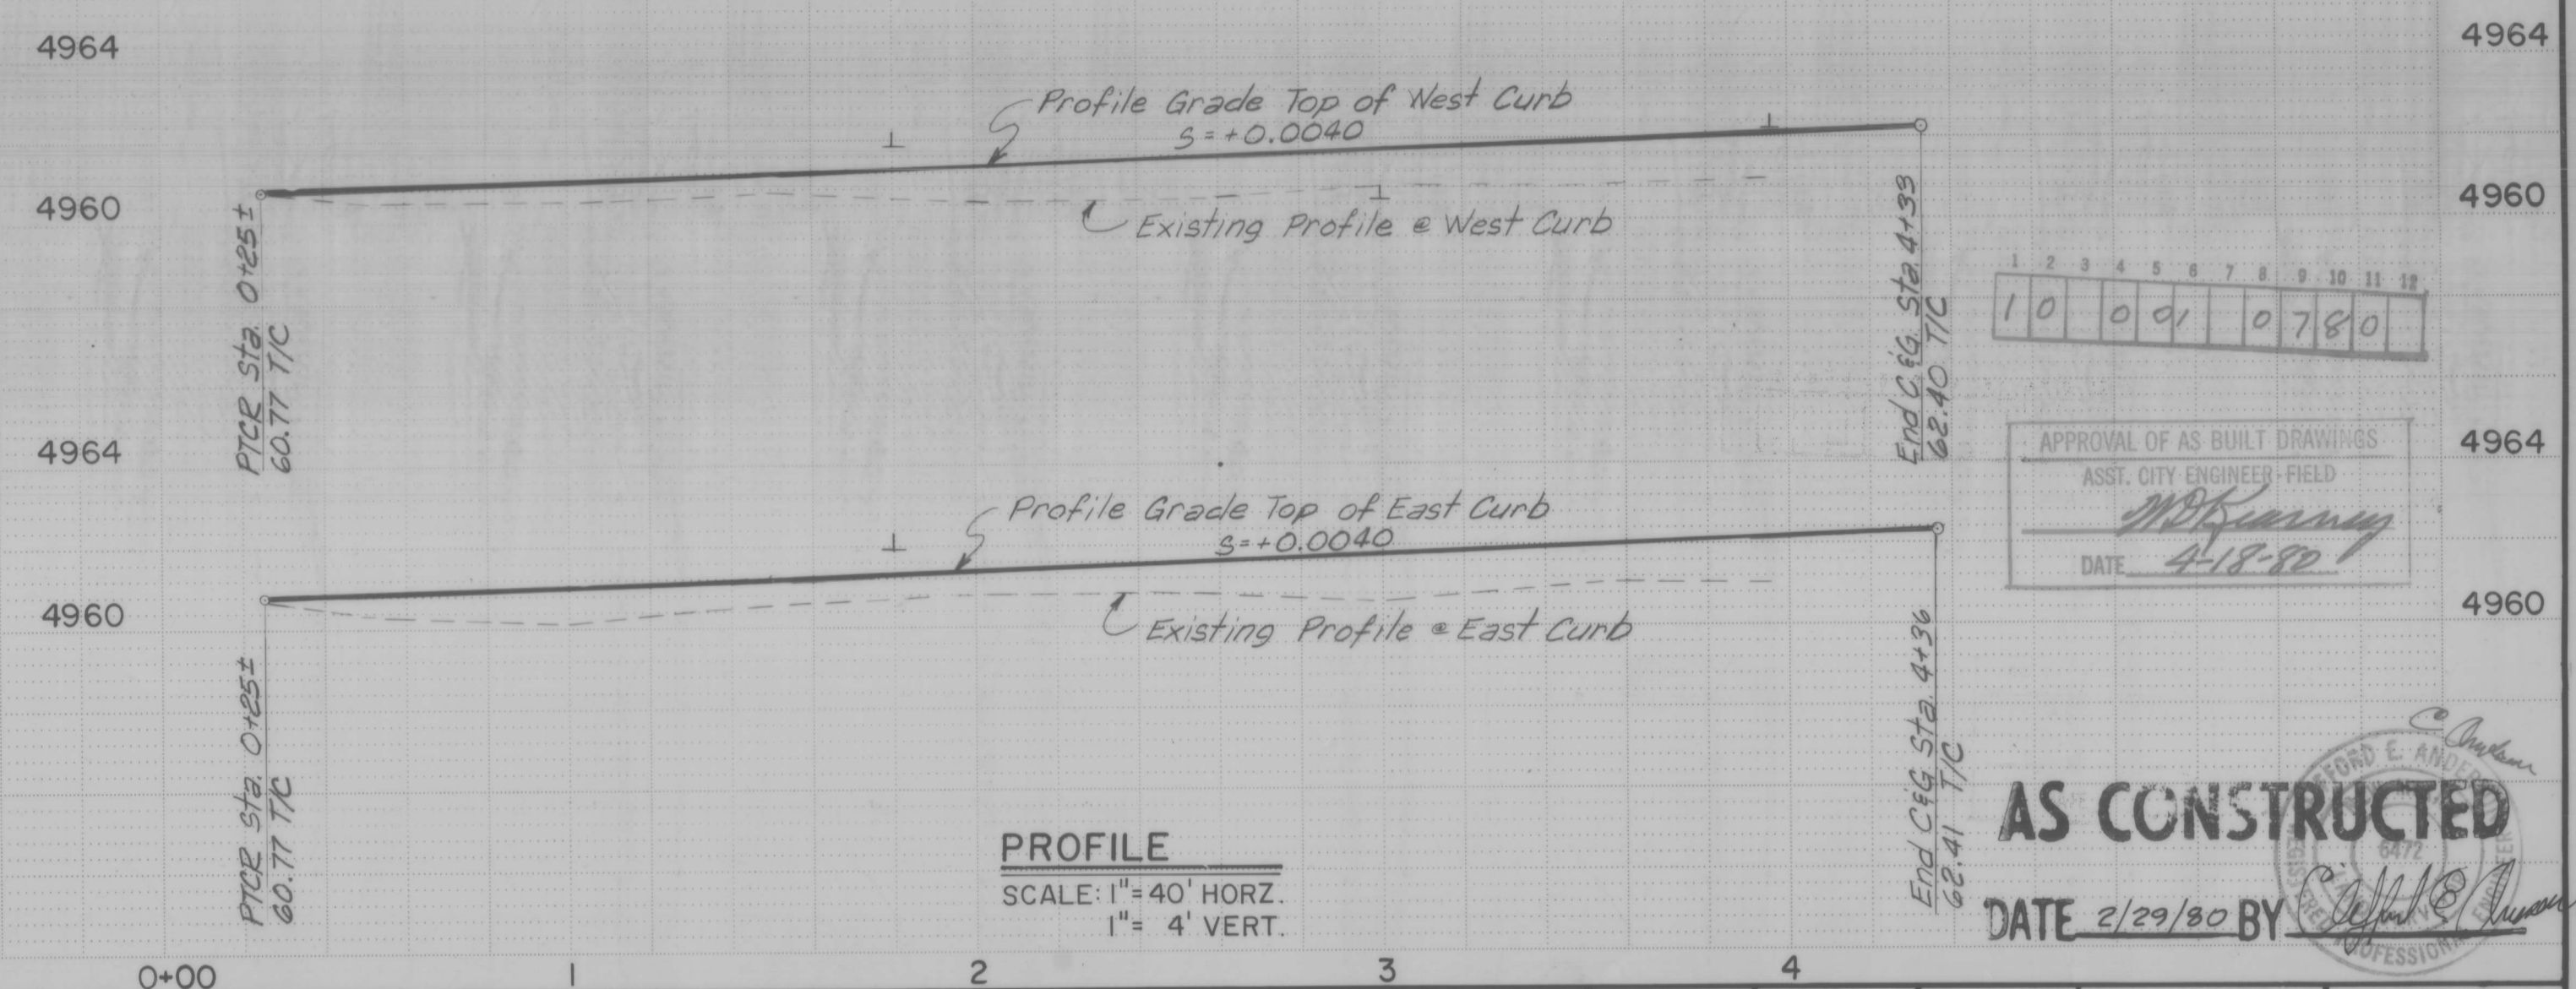

APPROVAL OF AS BUILT DRAWINGS
ASST. CITY ENGINEER - FIELD
[Signature]
DATE 4-18-80

AS CONSTRUCTED
DATE 2/29/80 BY *[Signature]*



COMMUNITY DEVELOPMENT PROGRAM
ALBUQUERQUE CD-3A
albuquerque bernalillo county new mexico

SAWMILL
LOS TOMASES DRIVE

DATE OCT. '78	JOB NO. 77011	SCALE AS SHOWN	DRAWN: AO	SHEET 7
	CHK'D: RL		OF 17	

Scanlon & associates, inc.
albuquerque engineers-planners-architects santa fe

SCANNED BY:
BY LASON

PROFILE	SURVEYED _____	BY _____	DATE _____
	PLOTTED _____		
	GRADES CHECKED _____		
	B. M. : NOTED _____		
	NO. _____		
	STRUCTURE NOTATIONS CH'KD _____		




22' VALLEY SECTION 5 1/2" CONCRETE PAVEMENT TYPE A

LOMBARDY ROAD K-11

PLAN

SCALE: 1" = 40'

SEWER SERVICE LOCATIONS
No Scale

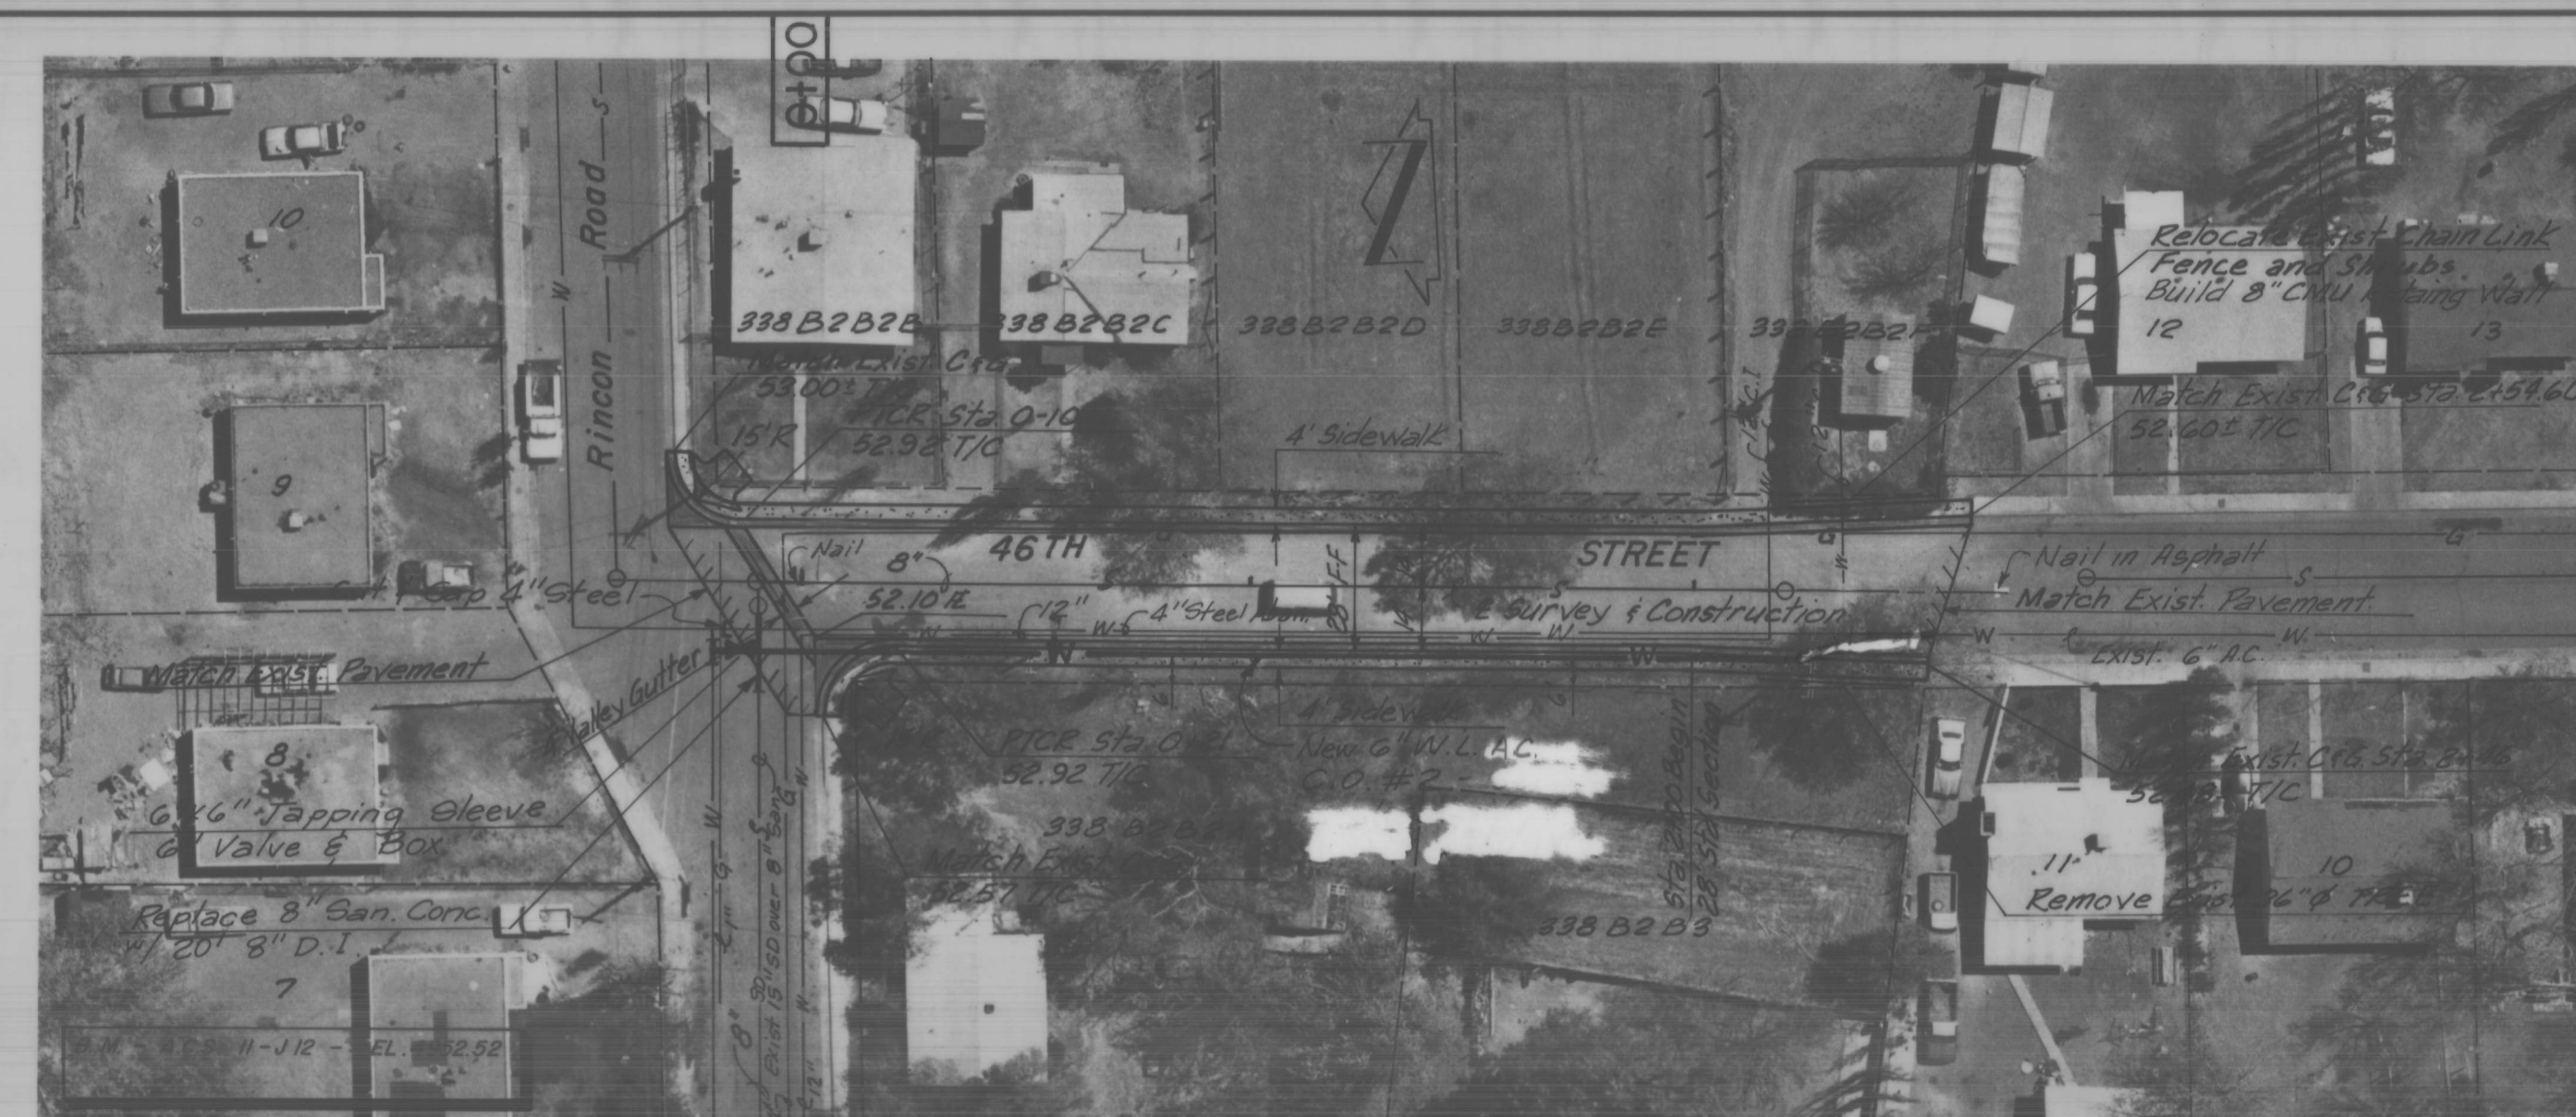




28' STANDARD SECTION TYPE III PAVEMENT

46TH STREET K-12

PLAN


SCALE: 1" = 40'

SEWER SERVICE LOCATIONS
No Scale

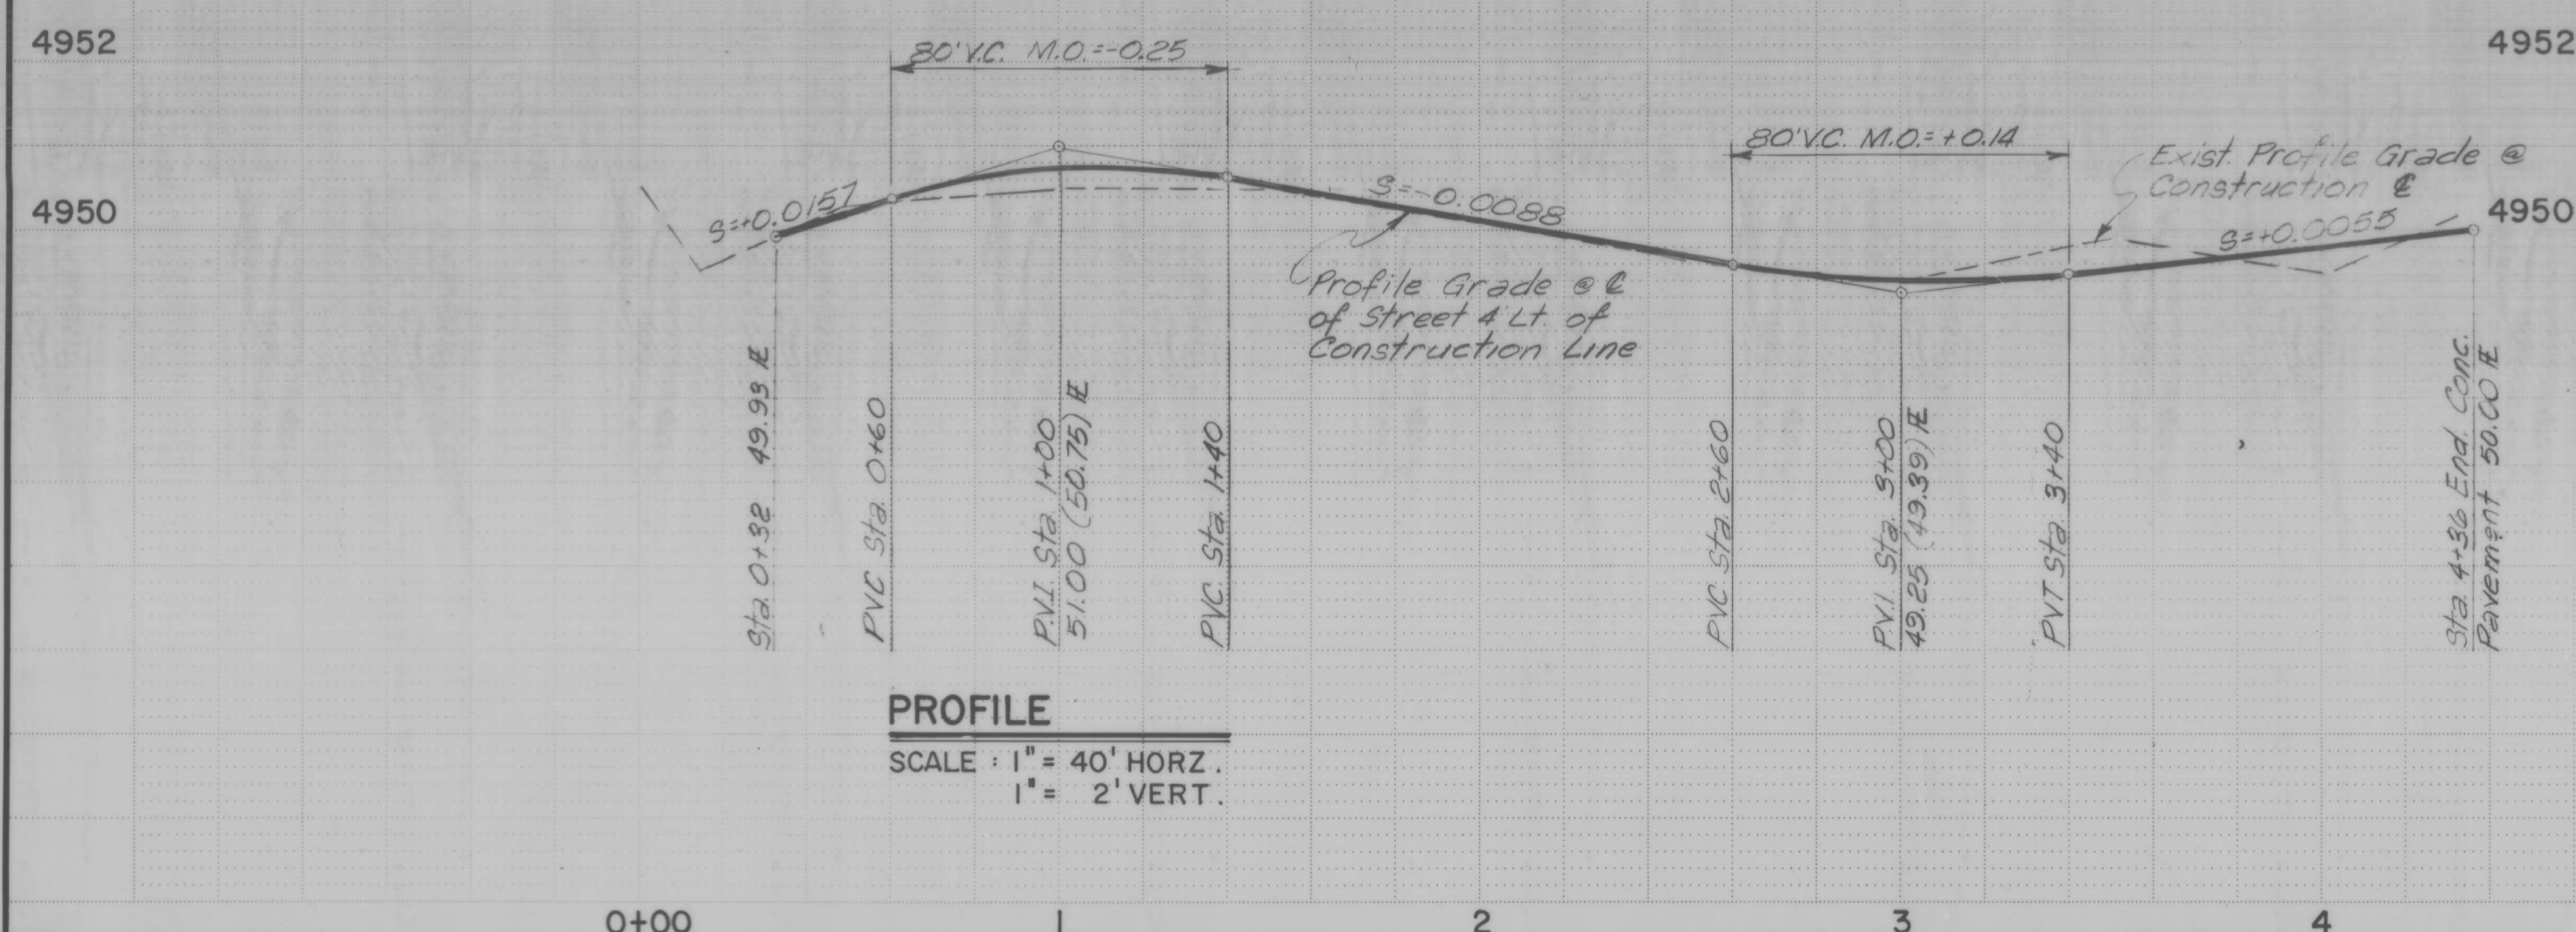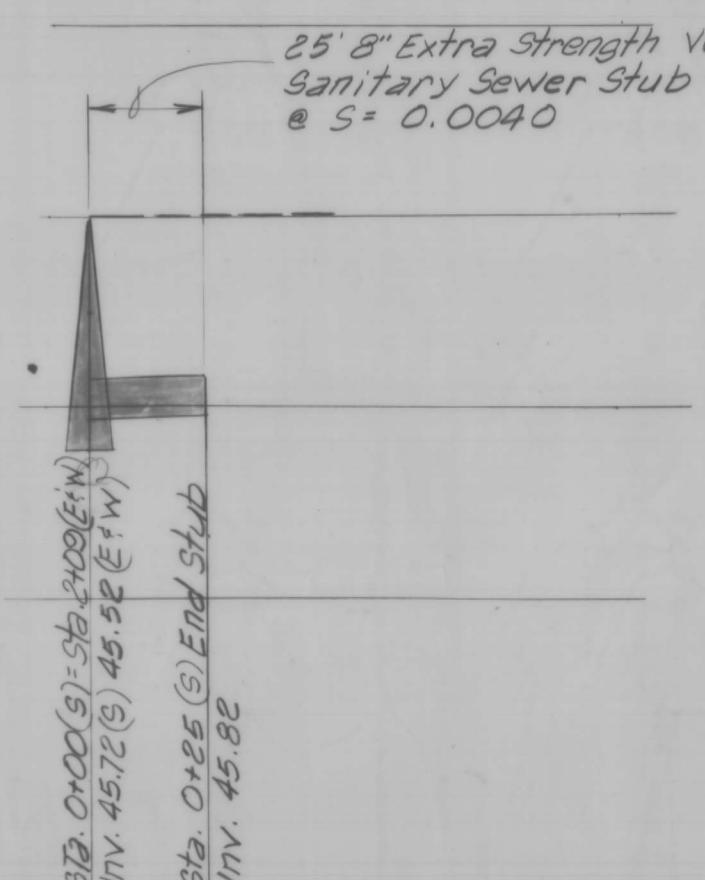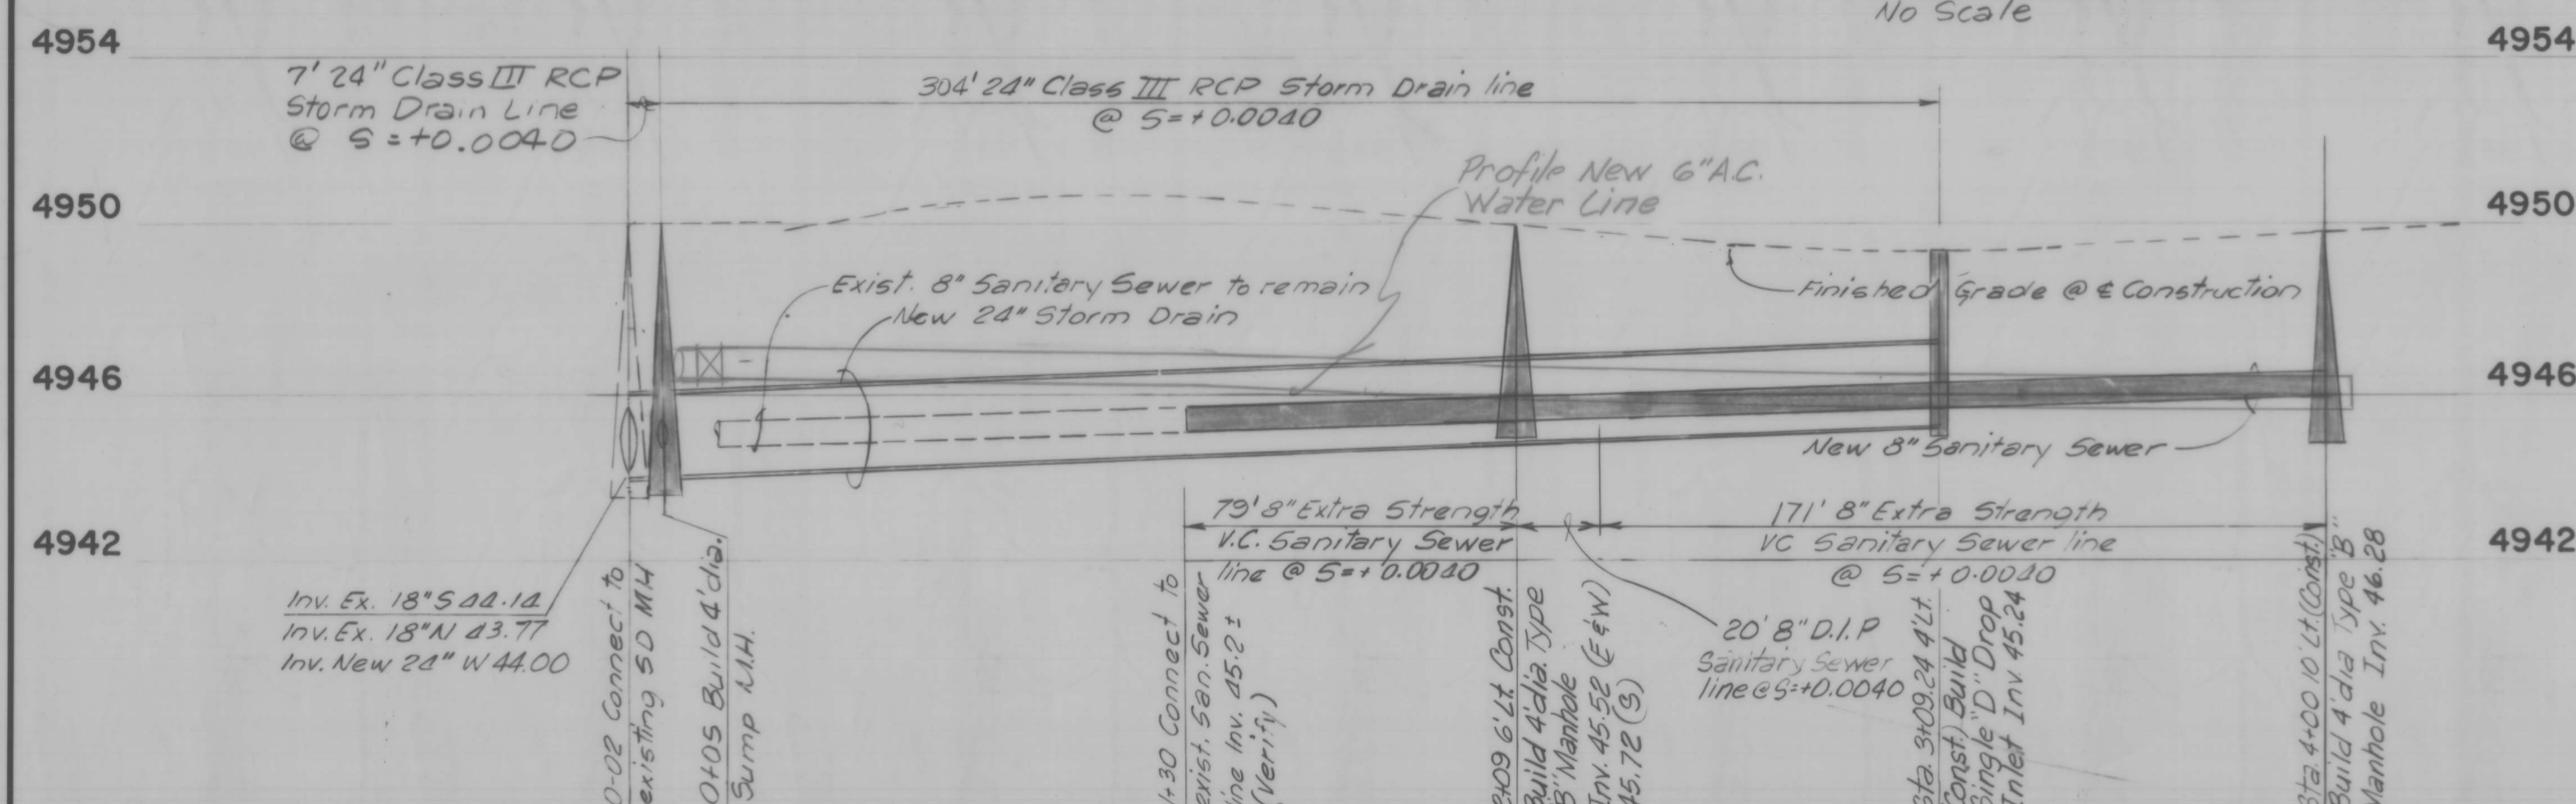

PROFILE

SCALE: 1" = 40' HORZ.
1" = 2' VERT.

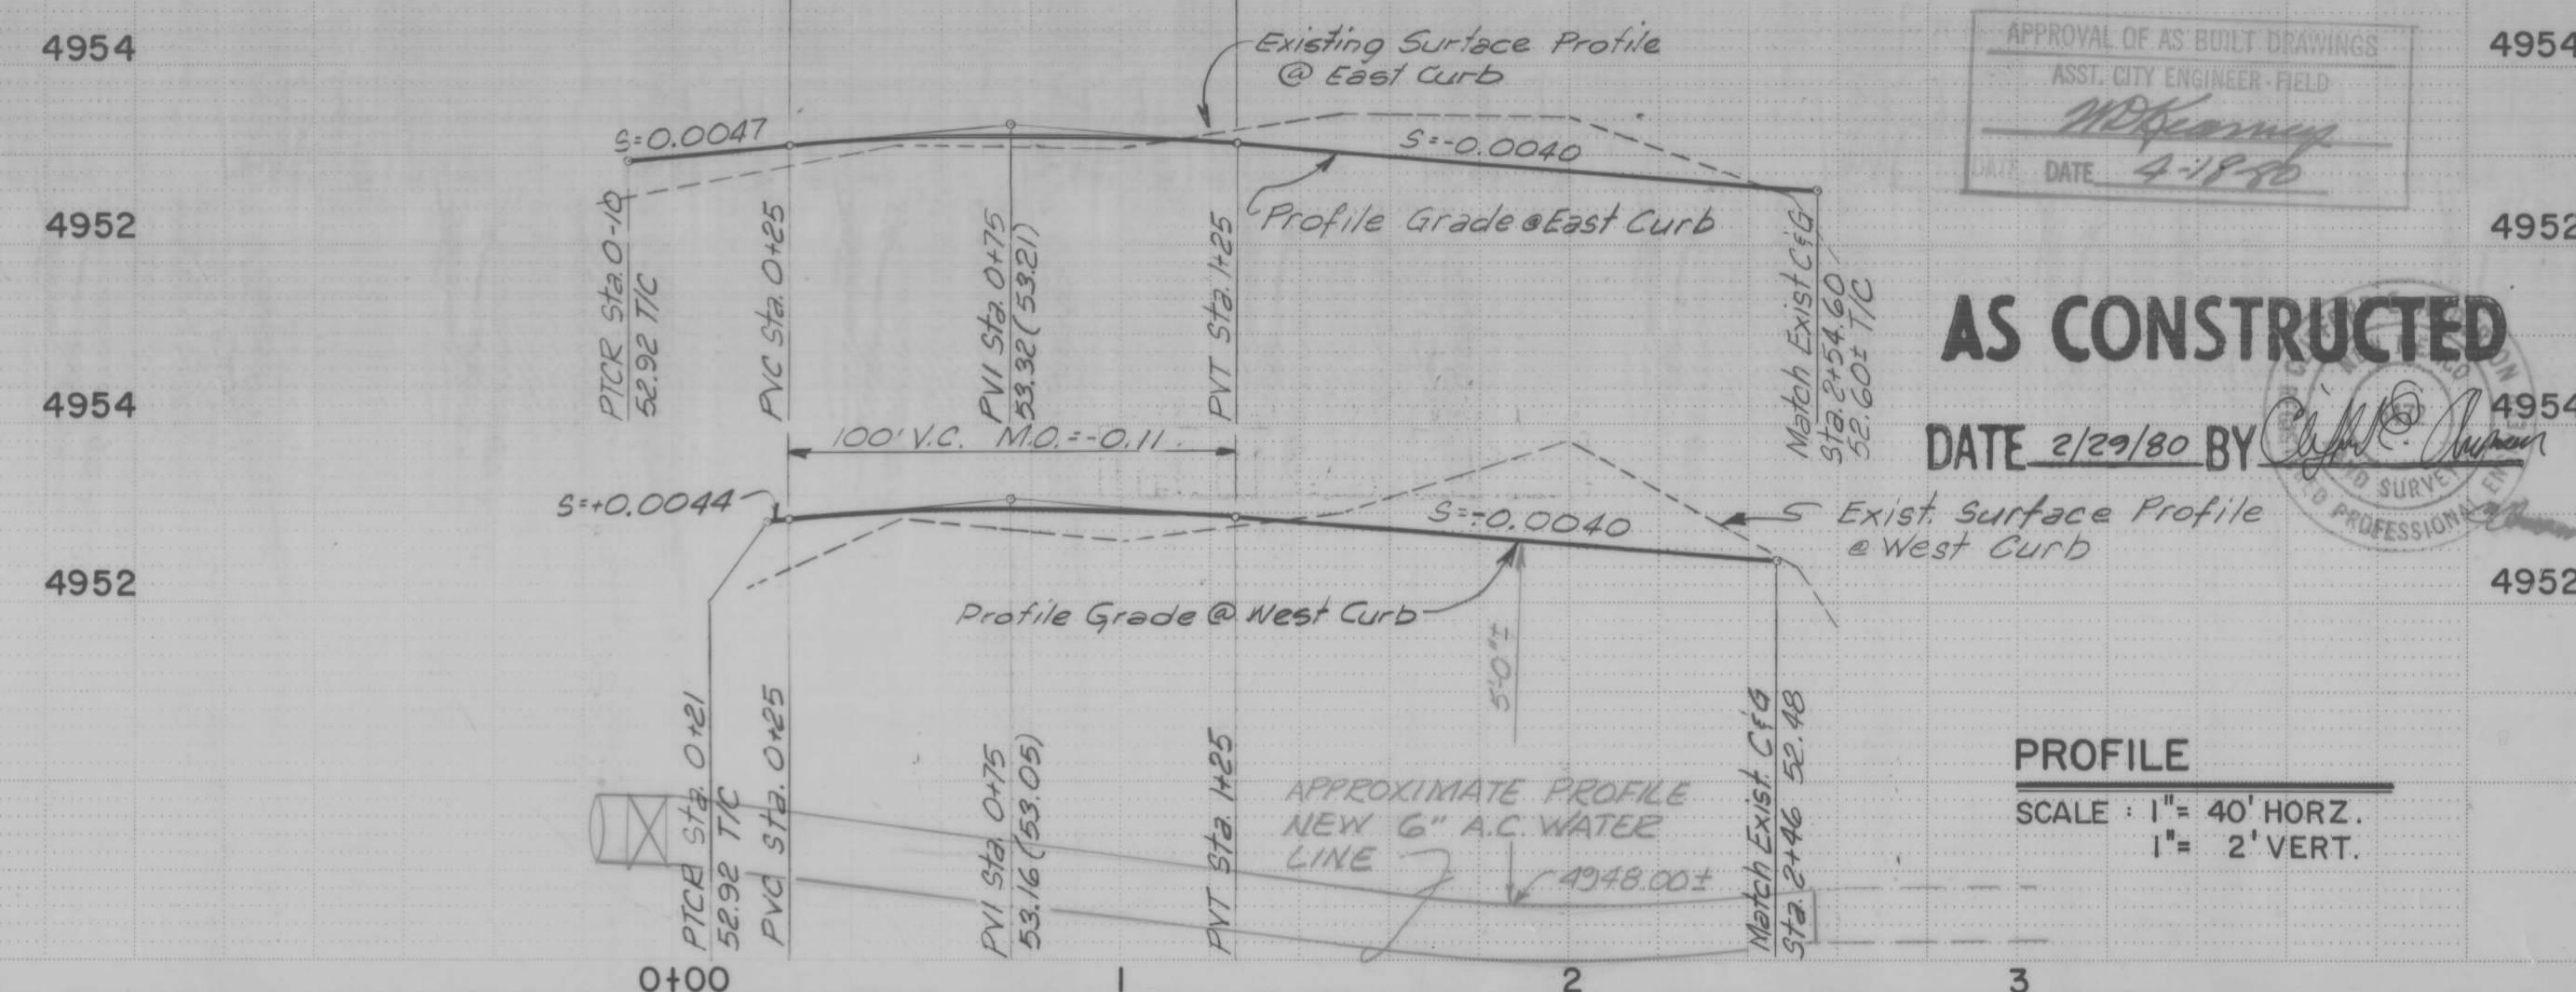

AS CONSTRUCTED

DATE 2/29/80 BY [Signature]

PROFILE

SCALE: 1" = 40' HORZ.
1" = 2' VERT.



COMMUNITY DEVELOPMENT PROGRAM
ALBUQUERQUE CD-3A

albuquerque bernalillo county new mexico

WEST MESA


LOMBARDY ROAD — 46TH STREET

DATE OCT. 78	JOB NO. 77011	SCALE AS SHOWN	DRAWN: V.M. CHK'D: R.L.	SHEET 9 OF 17
-----------------	------------------	-------------------	----------------------------	------------------------

Scanlon & associates, inc.
albuquerque Engineers-Planners santia fe

SCANNED BY LASON

NOTE: "Done By Others" Denotes Fire Hydrants That Were Originally Part of This Contract, But Were Found To Be Existing.

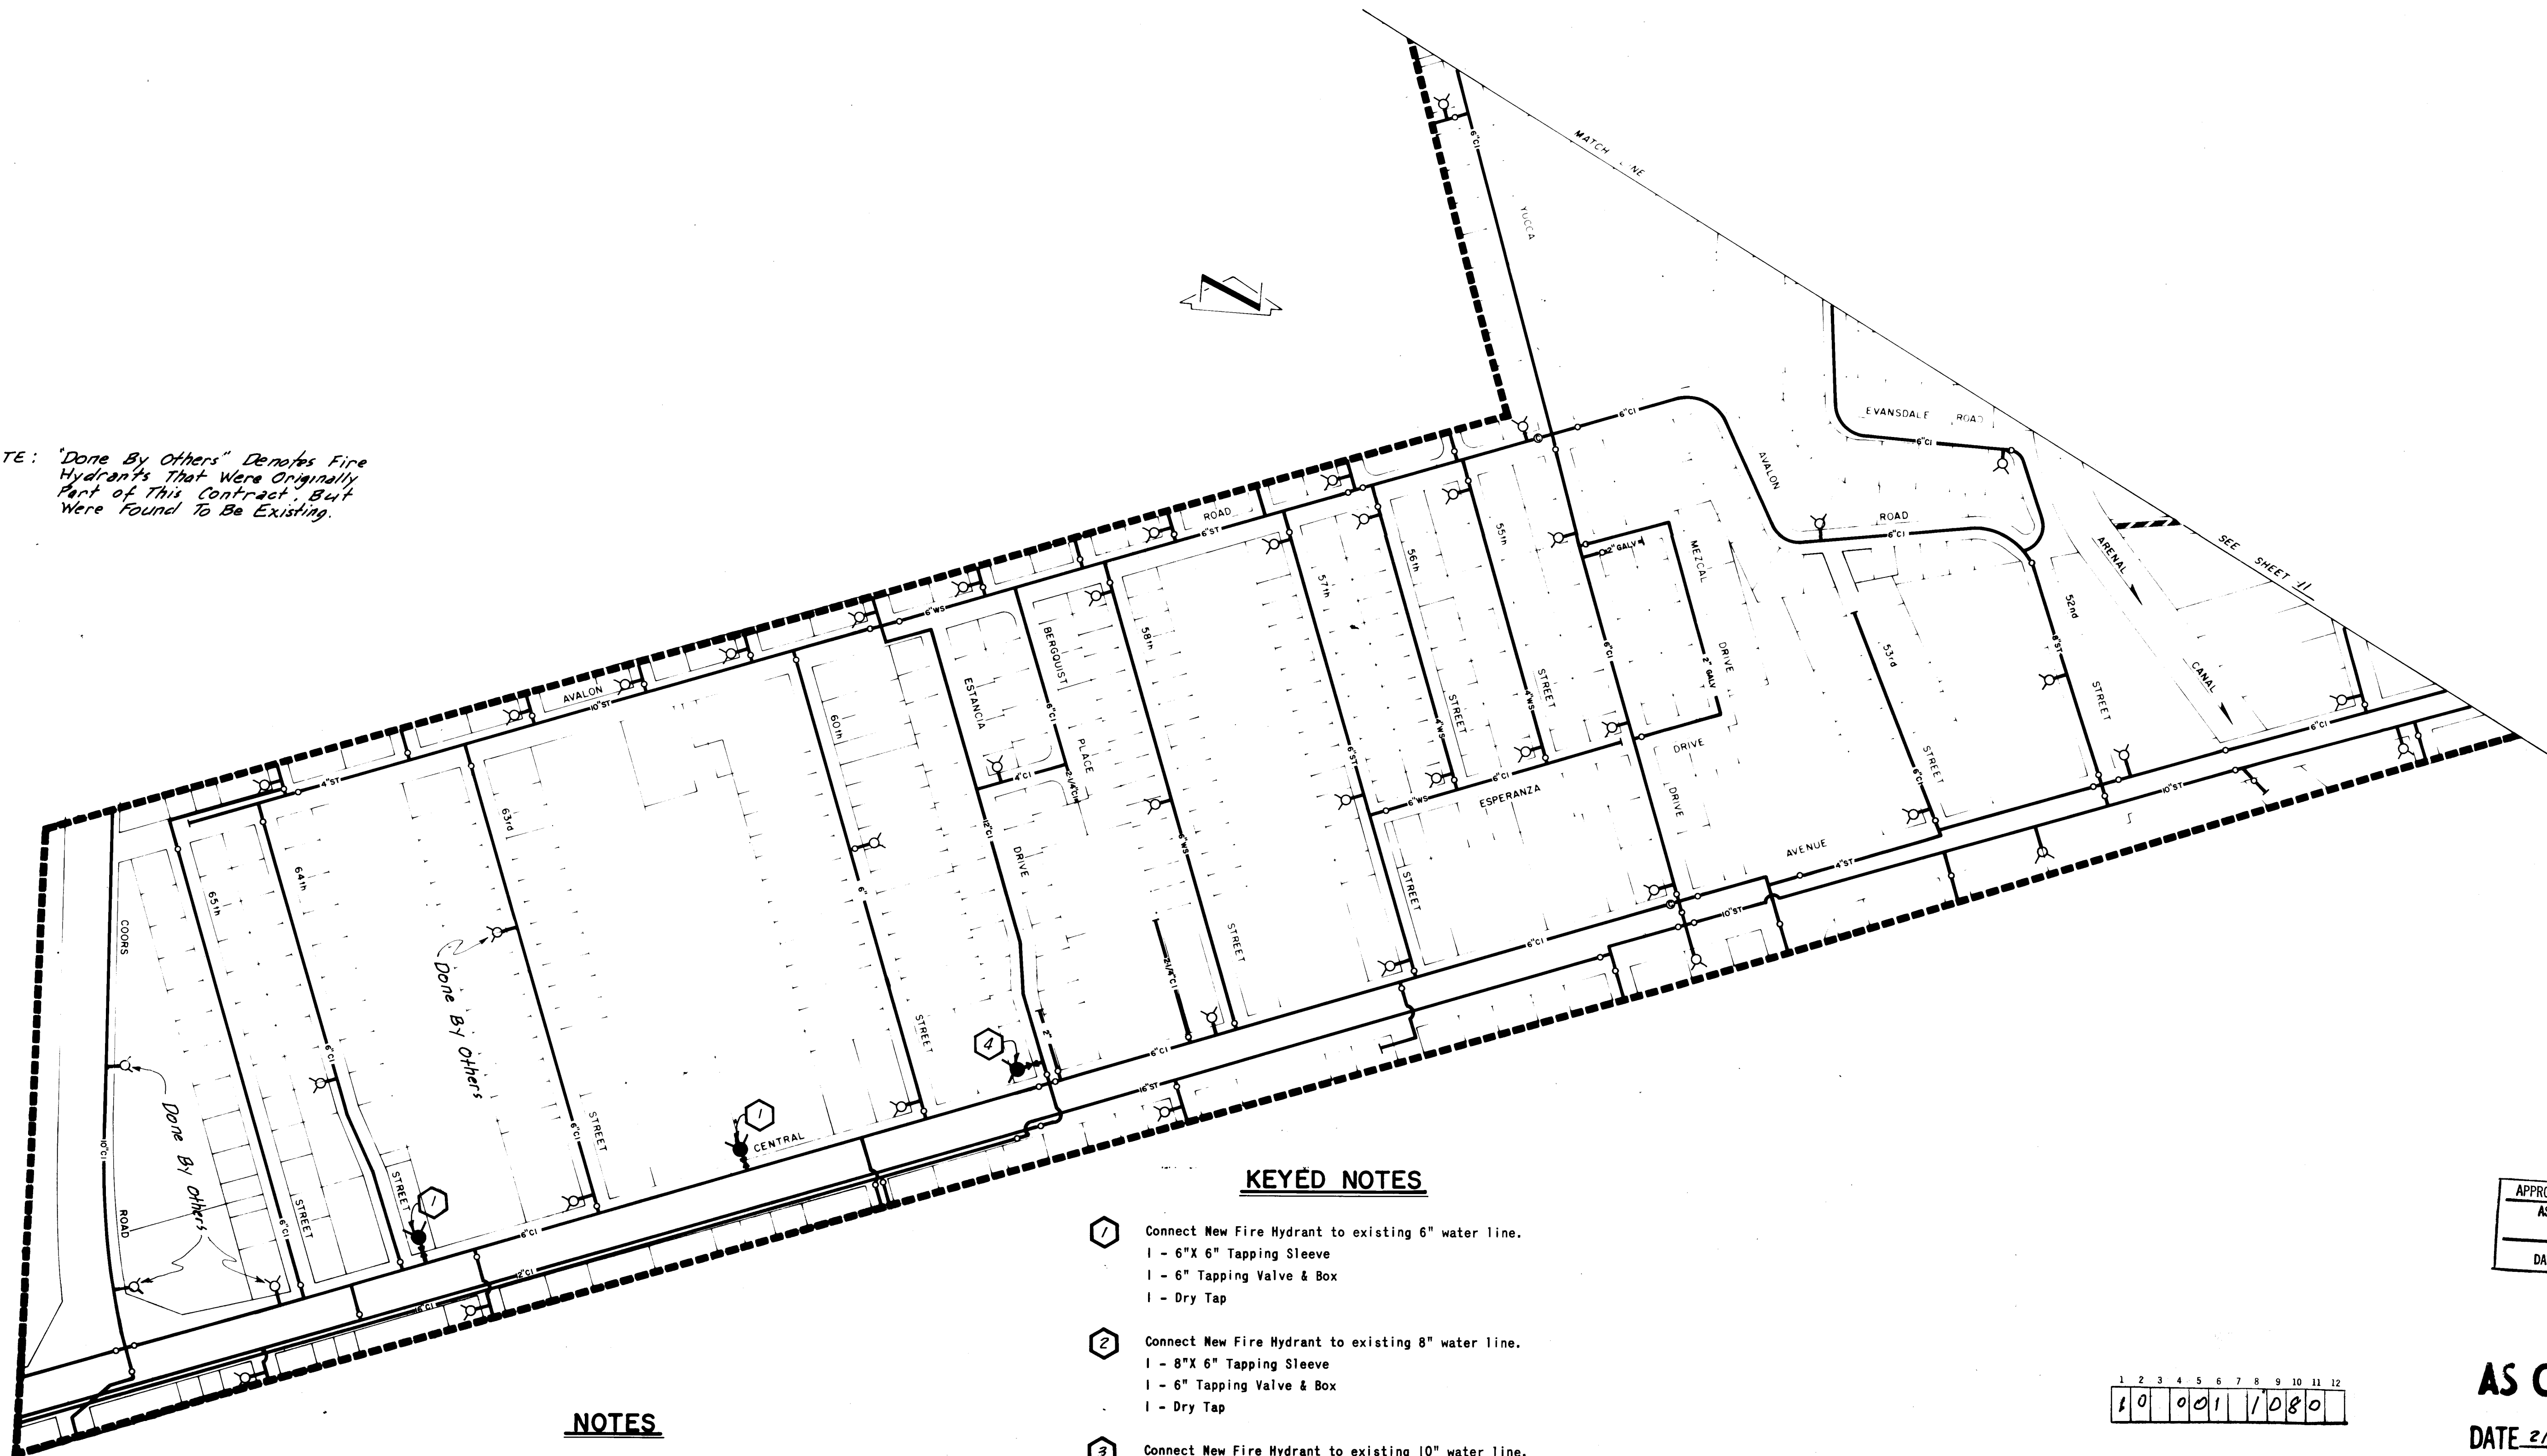

NOTES

1. Payment for installation of New Fire Hydrants shall include fittings, pipe, vertical extensions, removal and replacement of pavement, curb & gutter, sidewalk, trenching, backfilling and all other work required for a complete job (valves and special fittings at main not included).
2. Exact location of New Fire Hydrants to be established in the field by the Engineer.
3. No direct payment for installation of fittings other than those included in the bid form will be made. Cost of other fittings shall be included in price bid for installation of pipe or fire hydrants.

KEYED NOTES

1. Connect New Fire Hydrant to existing 6" water line.
1 - 6"X 6" Tapping Sleeve
1 - 6" Tapping Valve & Box
1 - Dry Tap
2. Connect New Fire Hydrant to existing 8" water line.
1 - 8"X 6" Tapping Sleeve
1 - 6" Tapping Valve & Box
1 - Dry Tap
3. Connect New Fire Hydrant to existing 10" water line.
1 - 10"X 6" Tapping Sleeve
1 - 6" Tapping Valve & Box
1 - Dry Tap
4. Connect New Fire Hydrant to existing 12" water line.
1 - 12"X 6" Tapping Sleeve
1 - 6" Tapping Valve & Box
1 - Dry Tap
5. Connect New Fire Hydrant to existing 6" water line.
1 - 6"X 6" Tee
1 - 6" Coupling

LEGEND

- GATE VALVE
- CLOSED VALVE
- GATE VALVE WITH BYPASS
- WATER LINE
- WELL LINE
- WELL
- EXISTING FIRE HYDRANT
- NEW FIRE HYDRANT
- NEW WATER LINE THIS CONTRACT
- NEW VALVE THIS CONTRACT

APPROVAL OF AS BUILT DRAWINGS
ASST. CITY ENGINEER - FIELD
[Signature]
DATE 4-18-80

AS CONSTRUCTED

DATE 2/29/80 BY *[Signature]*

ALBUQUERQUE CD-3A


WEST MESA FIRE HYDRANT IMPROVEMENTS

COMMUNITY DEVELOPMENT PROGRAM

albuquerque	bernalillo	county	new	mexico
DATE OCT. '78	JOB NO. 77011	SCALE 1"= 200'	DRAWN: RL	SHEET 10 OF 19

Scanlon & associates, inc.
albuquerque Engineers-Planners artesiasanta fe

SCANNED BY
BY LASON

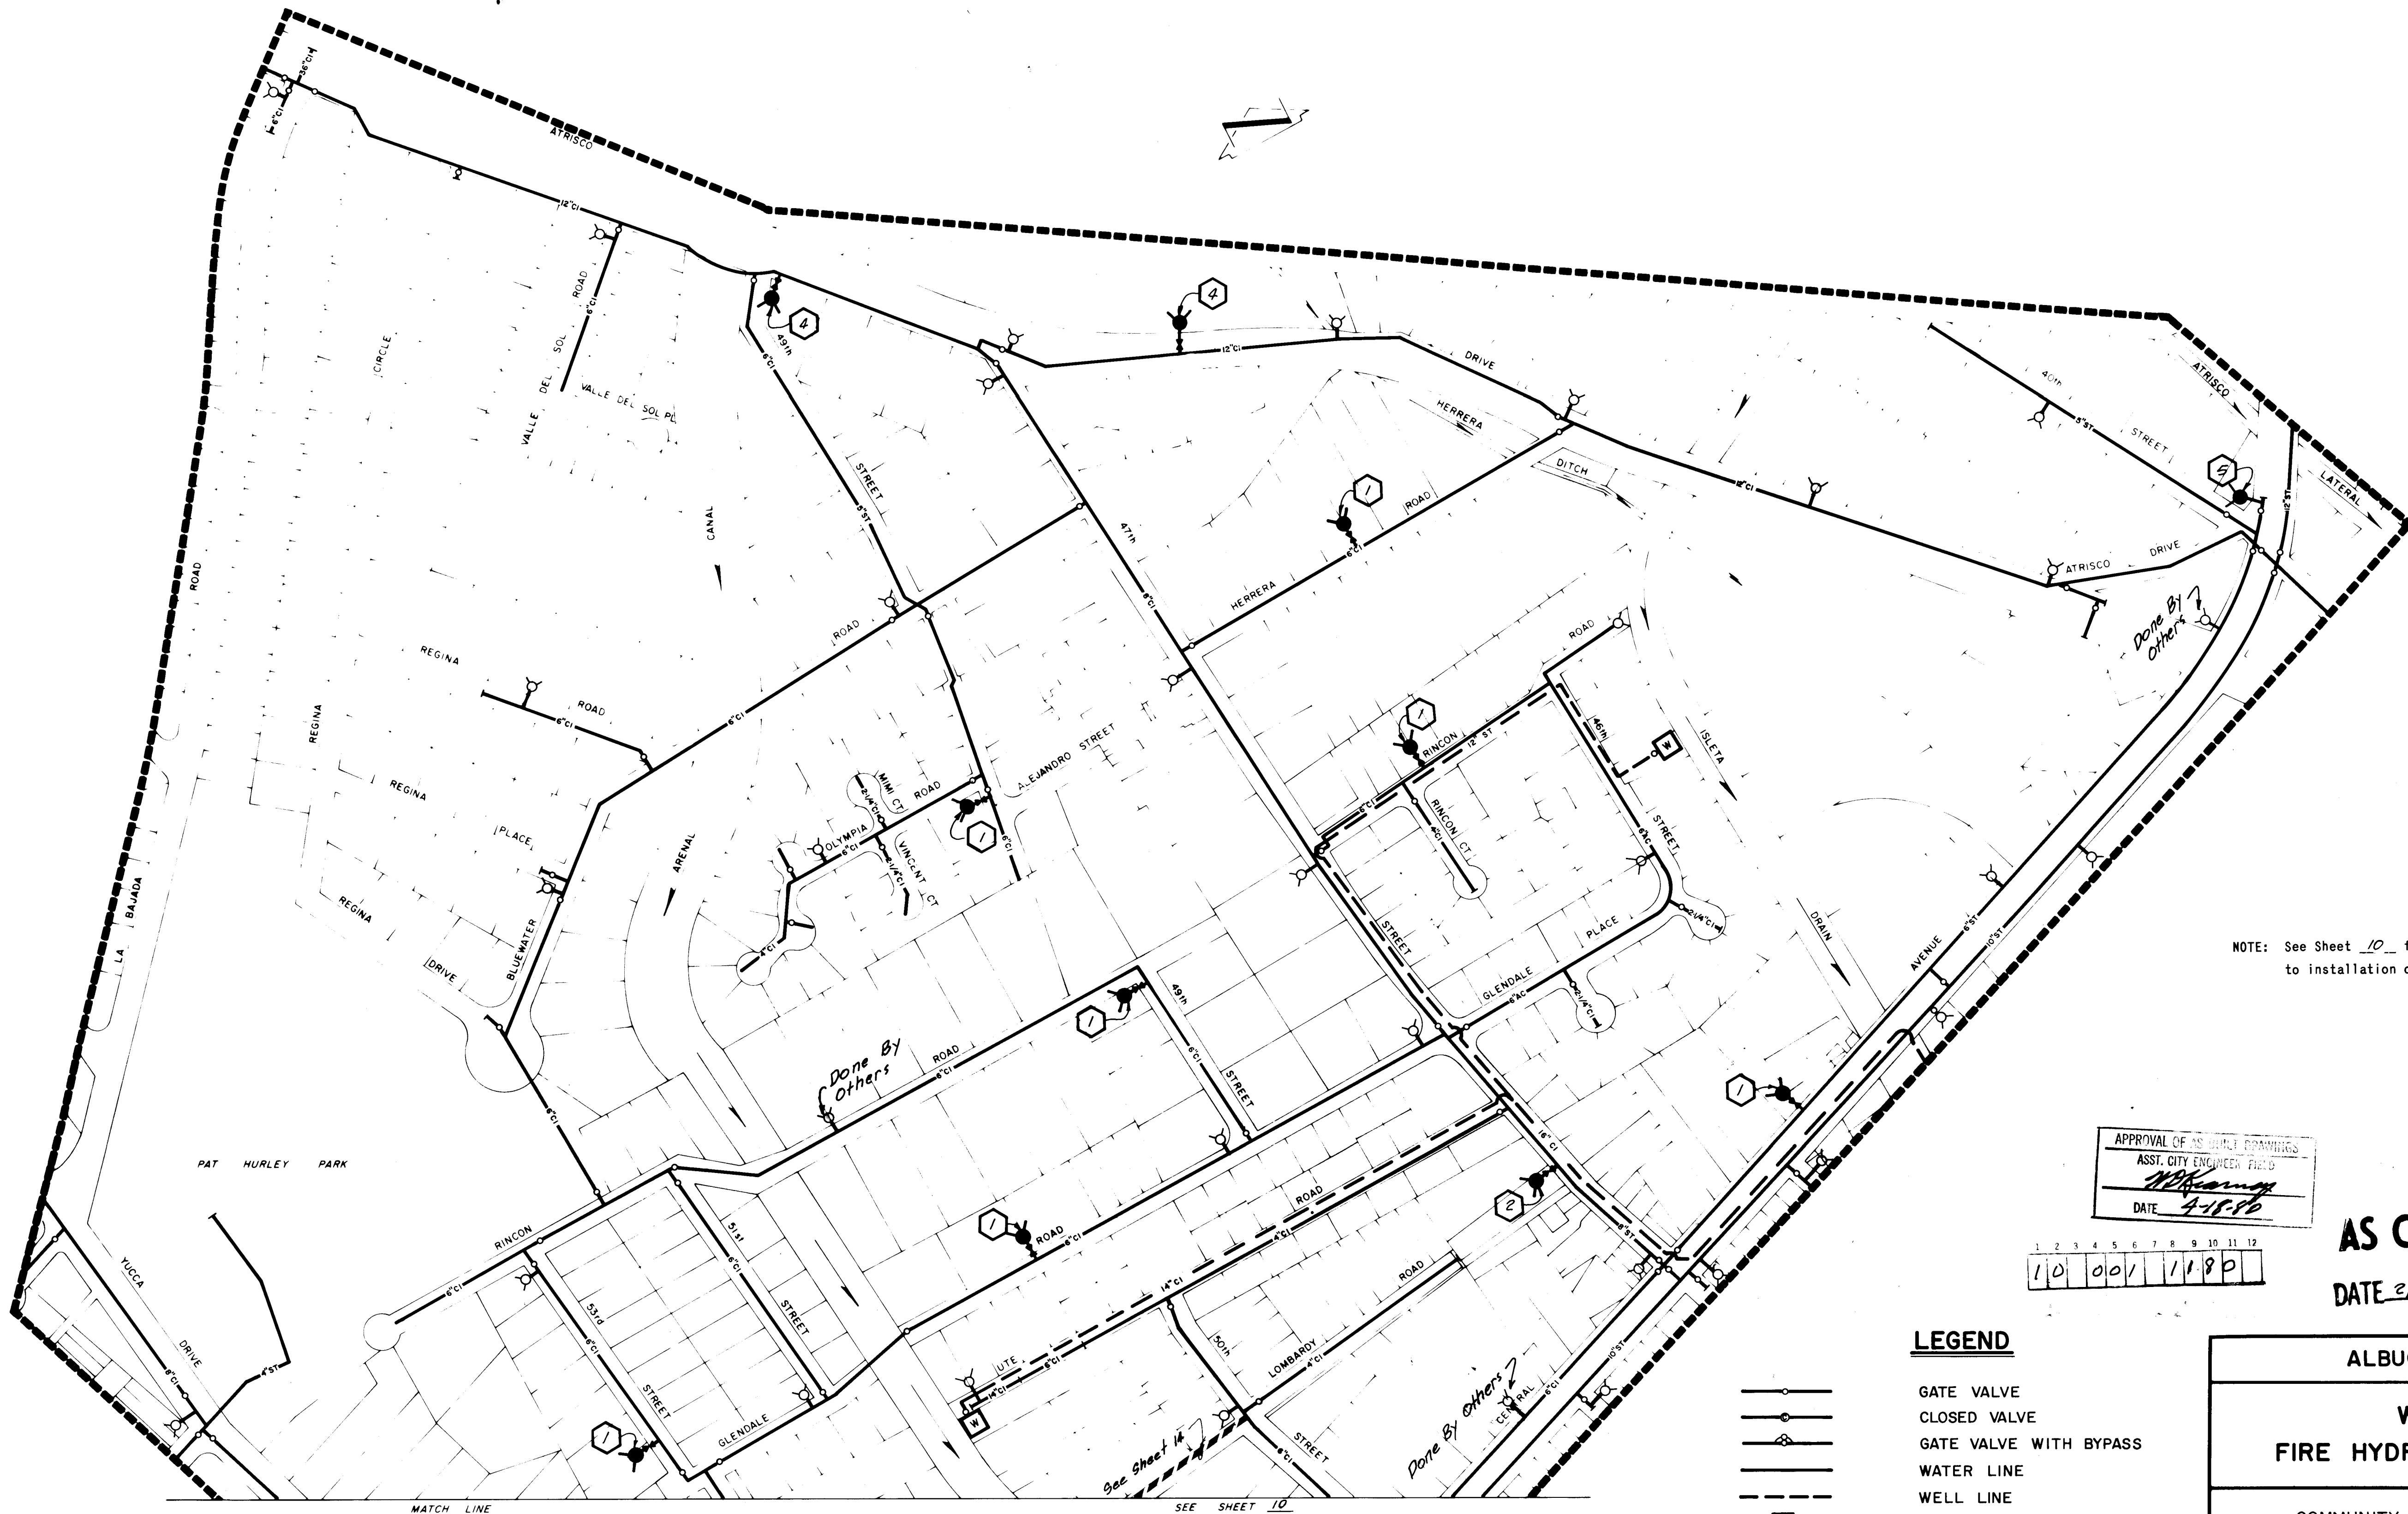

NOTE: See Sheet 10 for notes pertaining to installation of Fire Hydrants.

APPROVAL OF AS BUILT DRAWINGS
 ASST. CITY ENGINEER FIELD
[Signature]
 DATE 4-18-80

1 2 3 4 5 6 7 8 9 10 11 12
 10 00 11 80


AS CONSTRUCTED
 DATE 2/29/80 BY *[Signature]*

LEGEND

- GATE VALVE
- CLOSED VALVE
- GATE VALVE WITH BYPASS
- WATER LINE
- WELL LINE
- WELL
- EXISTING FIRE HYDRANT
- NEW FIRE HYDRANT
- NEW WATER LINE THIS CONTRACT
- NEW VALVE THIS CONTRACT

ALBUQUERQUE CD-3A					
WEST MESA FIRE HYDRANT IMPROVEMENTS					
COMMUNITY DEVELOPMENT PROGRAM					
albuquerque	bernalillo	county	new	mexico	
DATE OCT '78	JOB NO. 77011	SCALE 1"=200'	DRAWN: LH	SHEET 11	OF 19
Scanlon & associates, inc. Engineers-Planners albuquerque artesia santa fe					

SCANNED BY
BY LASON

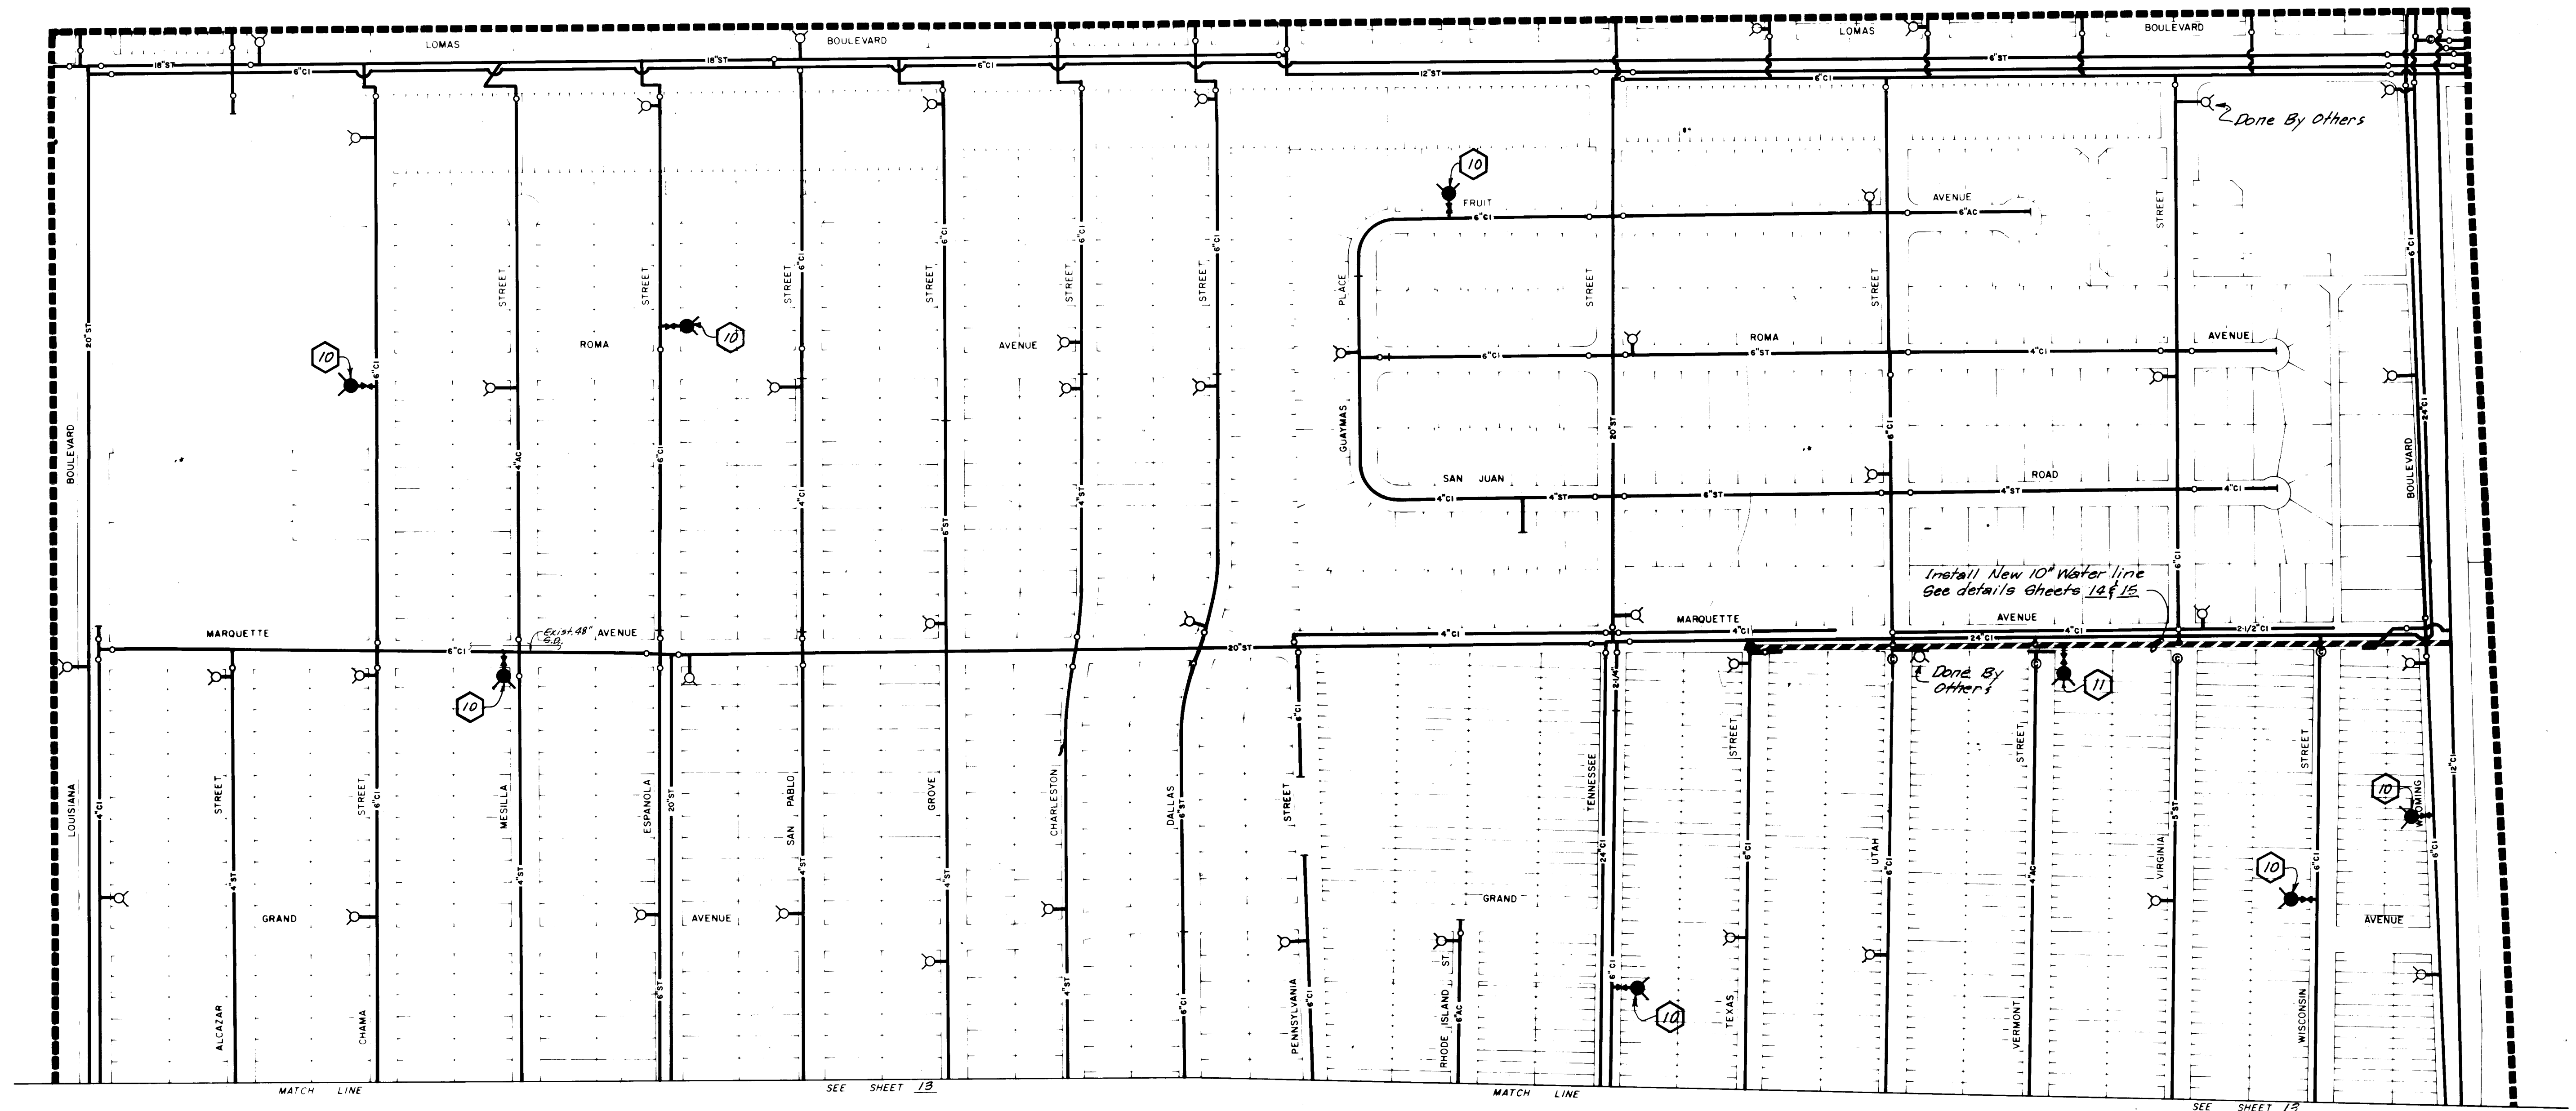


NOTES

1. Payment for installation of New Fire Hydrants shall include fittings, pipe, vertical extensions, removal and replacement of pavement, curb & gutter, sidewalk, trenching, backfilling and all other work required for a complete job (valves and special fittings at main not included).
2. Exact location of New Fire Hydrants to be established in the field by the Engineer.
3. No direct payment for installation of fittings other than those included in the bid form will be made. Cost of other fittings shall be included in price bid for installation of pipe or fire hydrants.


KEYED NOTES

- 10** Connect New Fire Hydrant to existing 6" water line
 1 - 6"X 6" Tapping Sleeve
 1 - 6" Tapping Valve & Box
 1 - Dry Tap
- 11** See Sheet 14 for details of Fire Hydrant installation.
- 12** See Sheet 15 for details of Fire Hydrant installation.
- 13** Connect New Fire Hydrant to existing 10" water line
 1 - 10"X 6" Tapping Sleeve
 1 - 6" Tapping Valve & Box
 1 - Dry Tap
- 14** Connect New Fire Hydrant to existing 20" water line
 1 - 20"X 6" Tapping Sleeve
 1 - 6" Tapping Valve & Box
 1 - Dry Tap
- 15** Install New Fire Hydrant. Extend 6" line to Fire Hydrant Tee
 20' - 6" Water Line
 1 - 6"X 6" Tee
 1 - 6"X 5" Reducer
 1 - 5" Coupling
 1 - Wet Connection
- 16** Connect New Fire Hydrant to existing 5" water line
 4 - 6" 90° Bends
 2 - 6"X 5" Reducers
 1 - 5" Coupling
 1 - Wet Connection

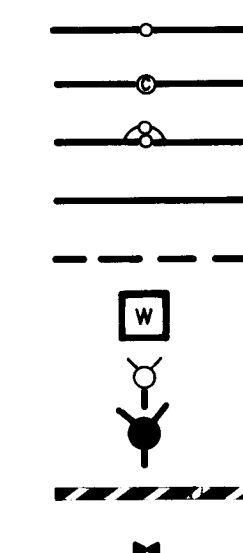

LEGEND

- GATE VALVE
- CLOSED VALVE
- GATE VALVE WITH BYPASS
- WATER LINE
- WELL LINE
- WELL
- EXISTING FIRE HYDRANT
- NEW FIRE HYDRANT
- NEW WATER LINE THIS CONTRACT
- NEW VALVE THIS CONTRACT

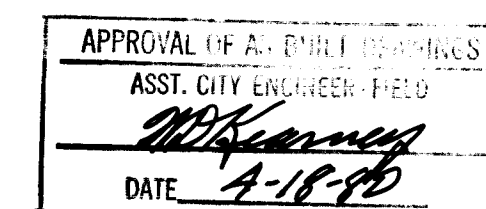

10 001 1280

AS CONSTRUCTED

DATE 2/29/80

ALBUQUERQUE CD-3A


LA MESA FIRE HYDRANT IMPROVEMENTS

COMMUNITY DEVELOPMENT PROGRAM

albuquerque	bernalillo	county	new mexico
DATE OCT. '78	JOB NO. 77011	SCALE 1"=200'	DRAWN: LH CHK'D: RL
			SHEET 12 OF 19


Scanlon & associates, inc.
 engineers-planners
 albuquerque antesia santa fe

12

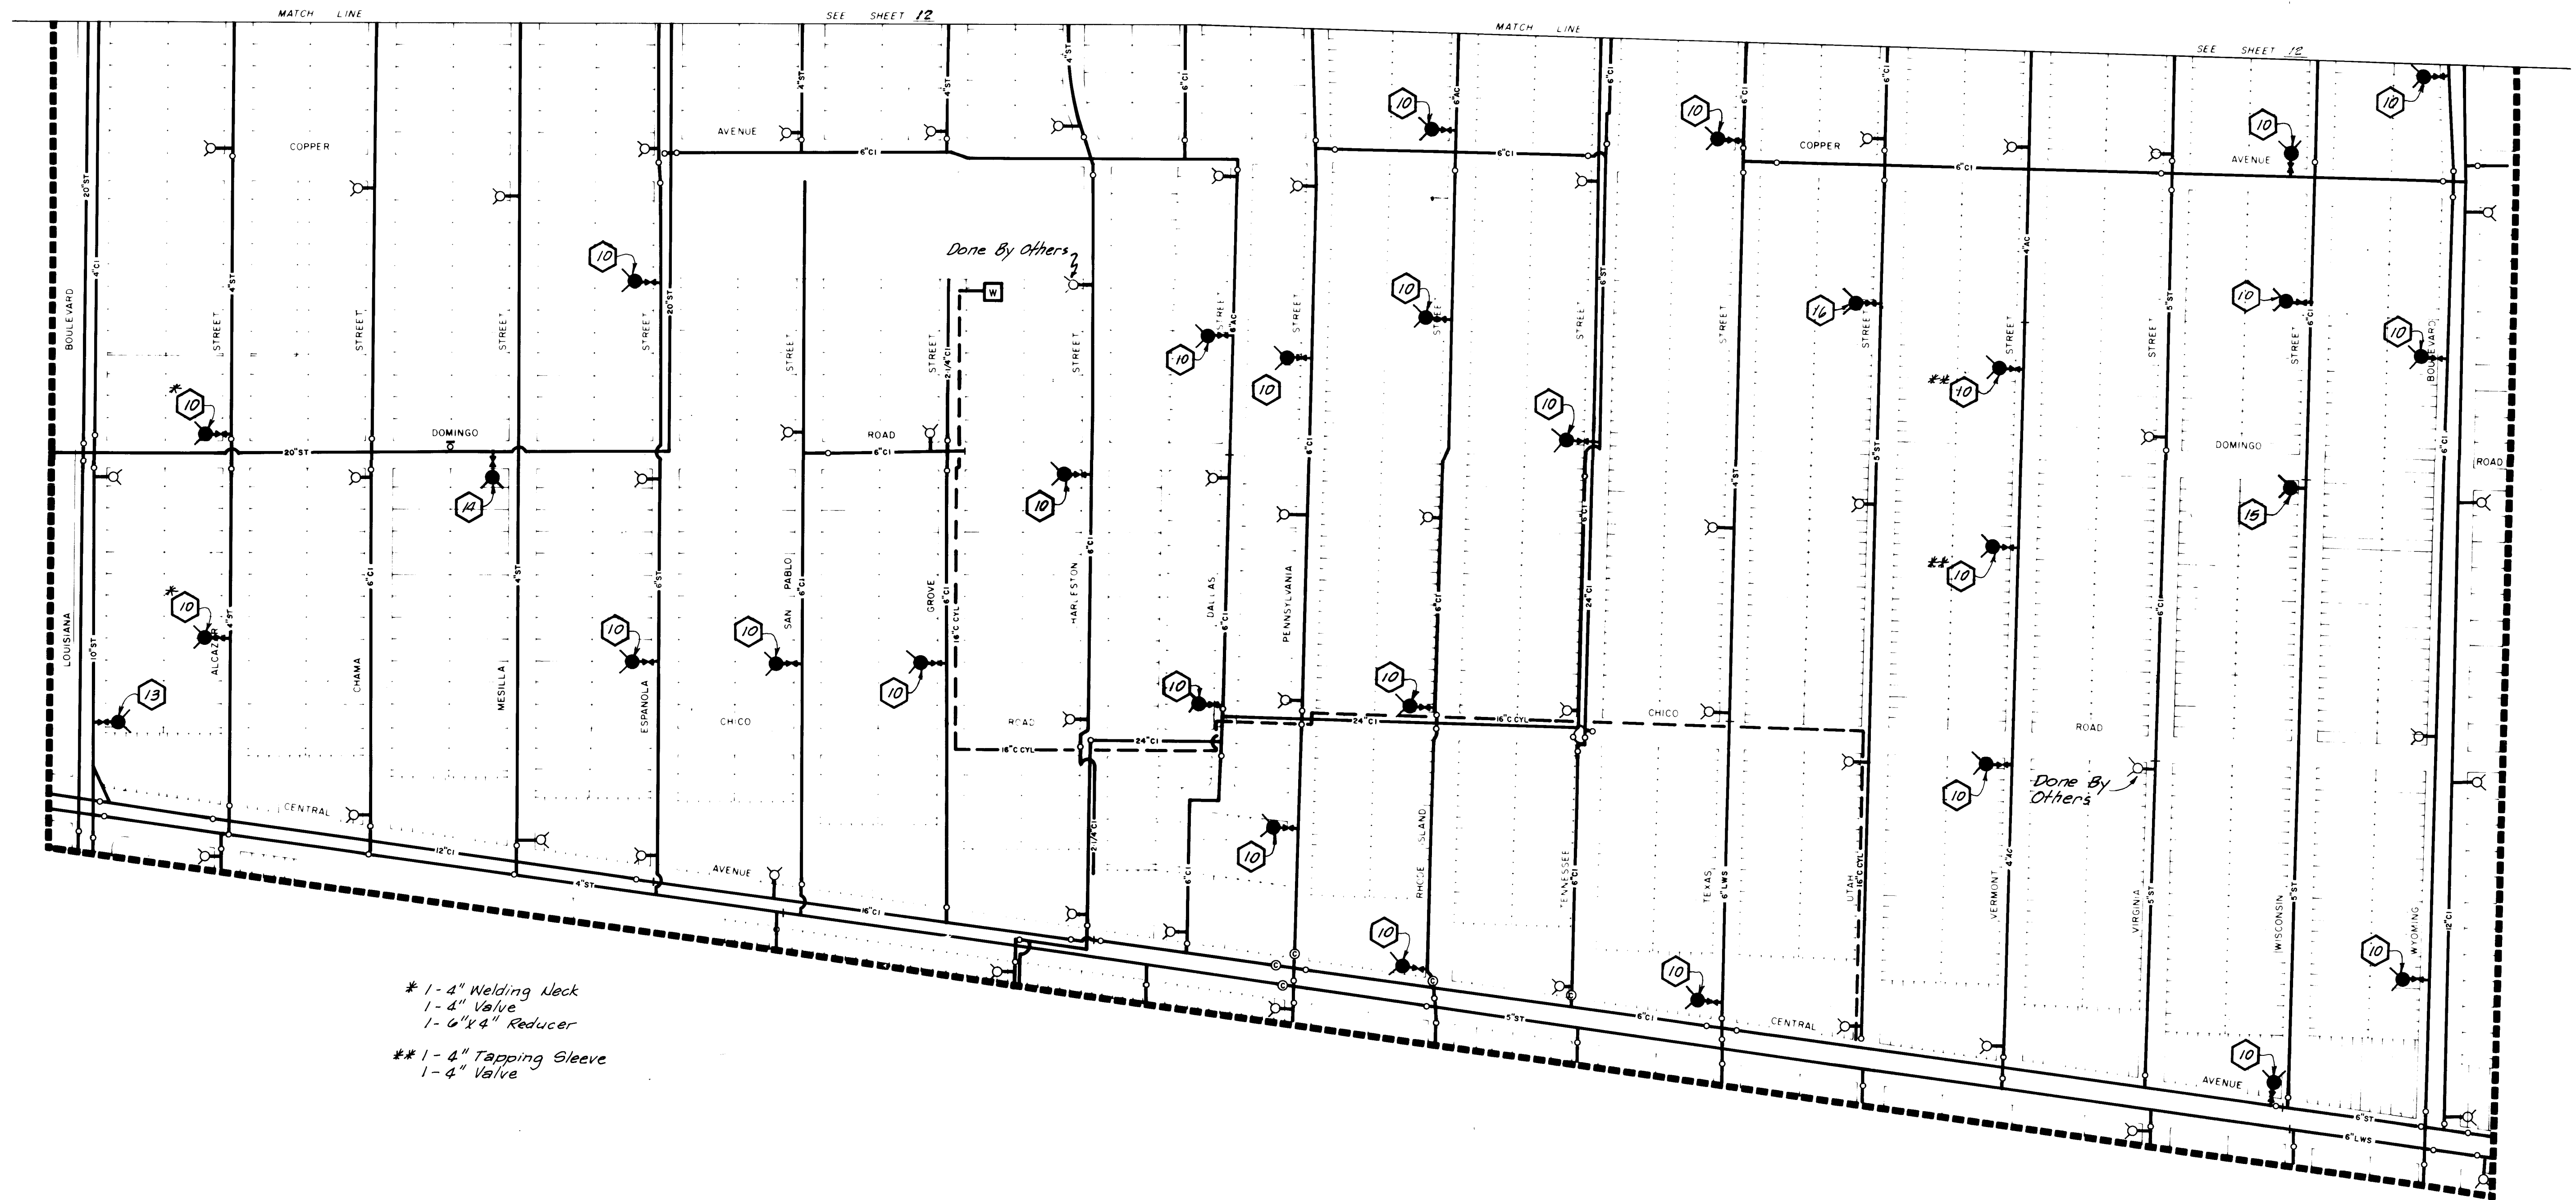

* 1- 4" Welding Neck
 1- 4" Valve
 1- 6"x4" Reducer
 ** 1- 4" Tapping Sleeve
 1- 4" Valve

NOTE: See Sheet 12 for notes pertaining to installation of Fire Hydrants.

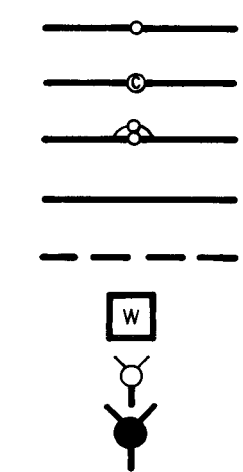

1	2	3	4	5	6	7	8	9	10	11	12
10	0	0	1	1	3	8	0				

APPROVAL OF CITY ENGINEER
 ASST. CITY ENGINEER
 DATE 4-18-80


AS CONSTRUCTED
 DATE 2/29/80 BY [Signature]

ALBUQUERQUE CD-3A					
LA MESA FIRE HYDRANT IMPROVEMENTS					
COMMUNITY DEVELOPMENT PROGRAM					
albuquerque	bernalillo	county	new	mexico	
DATE OCT. '78	JOB NO. 77011	SCALE 1"=200'	DRAWN: LH	SHEET 13	
			CHK'D: RL	OF 19	
Scanlon & associates, inc. Engineers-Planners albuquerque artesia santa fe					

PLAN	DATE	BY	DATE	BY
SURVEYED				
NOTED				
CHECKED				
NO.				

SCANLON AND ASSOCIATES
ENGINEERS PLANNERS


PROFILE	DATE	BY	DATE	BY
SURVEYED				
NOTED				
CHECKED				
NO.				

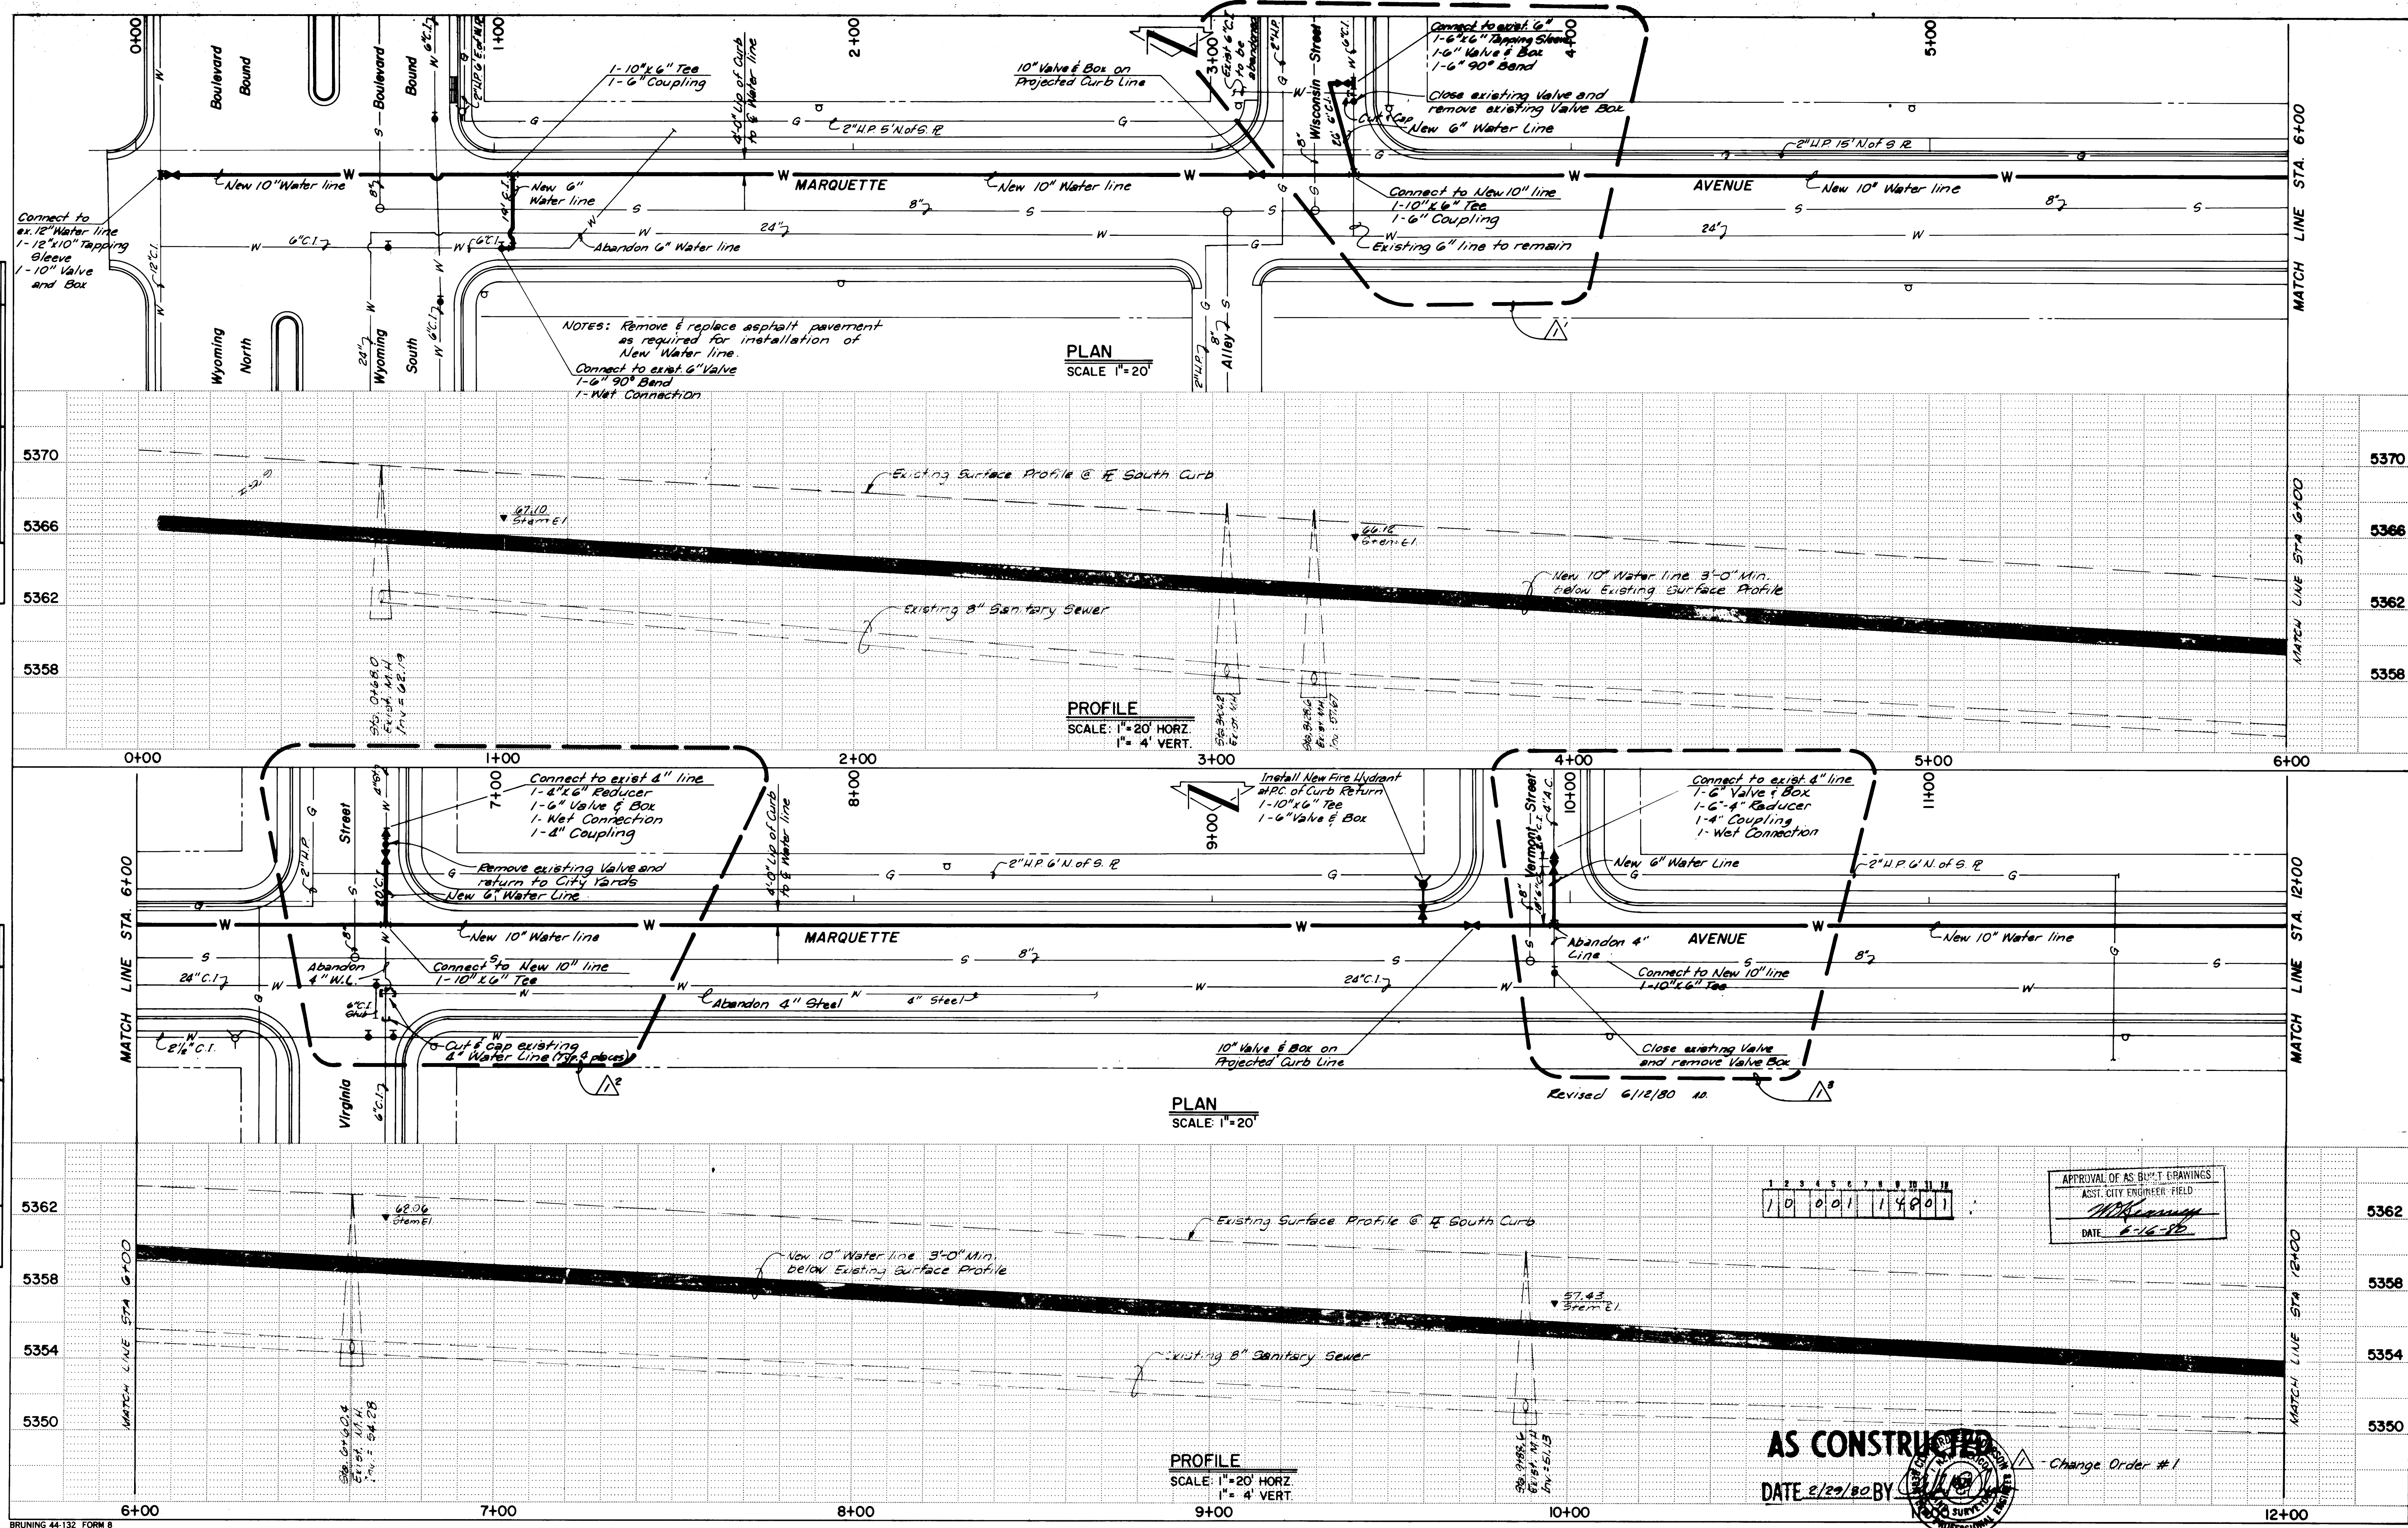

PLAN	DATE	BY	DATE	BY
SURVEYED				
PLOTTED				
ALIGNMENT CHECKED				
NOTE BOOK NO.				

SCANLON AND ASSOCIATES
ENGINEERS PLANNERS

PROFILE	DATE	BY	DATE	BY
SURVEYED				
PLOTTED				
GRADES CHECKED				
STRUCTURE NOTATIONS CHECKED				

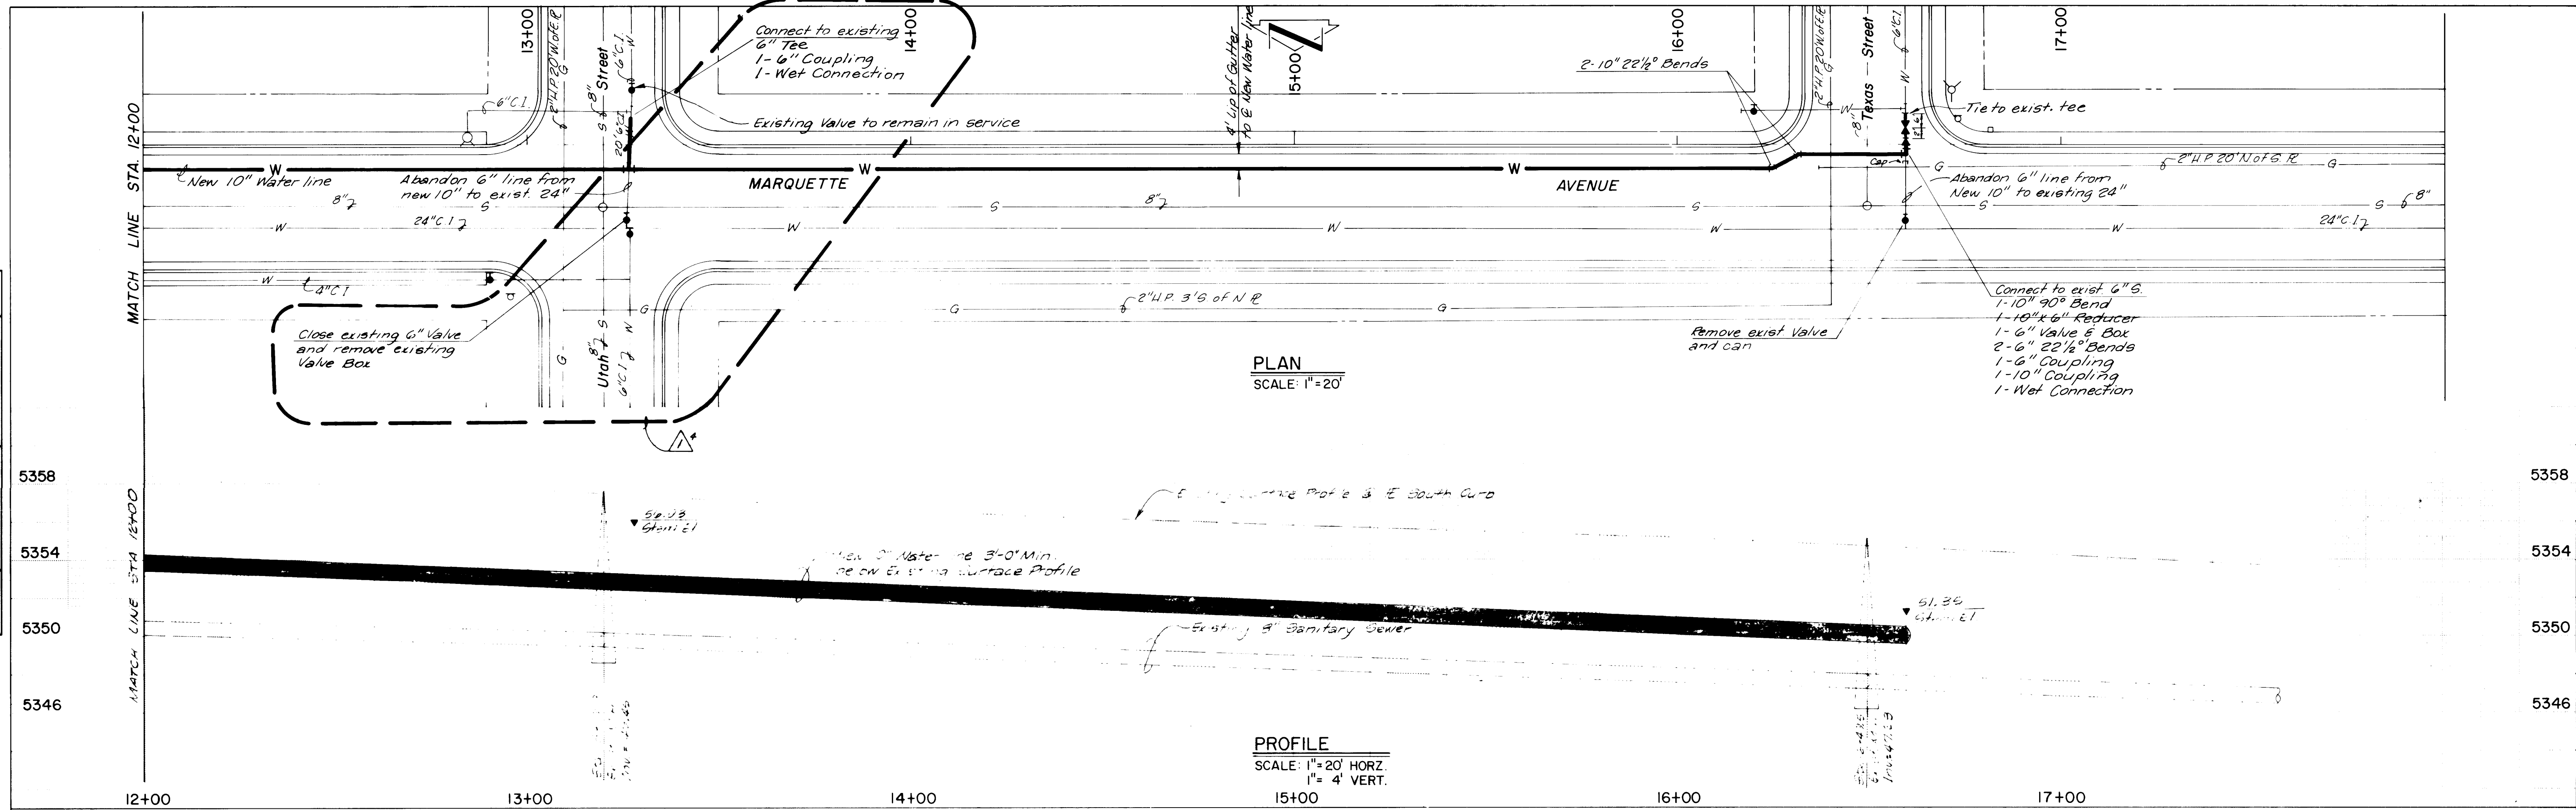

10 001 15801






 





APPROVAL OF A
DATE 2-12-80

10 001 15801





AS CONSTRUCTED

DATE 2/29/80 BY *C. J. Scanlon*



△ - Change Order #1

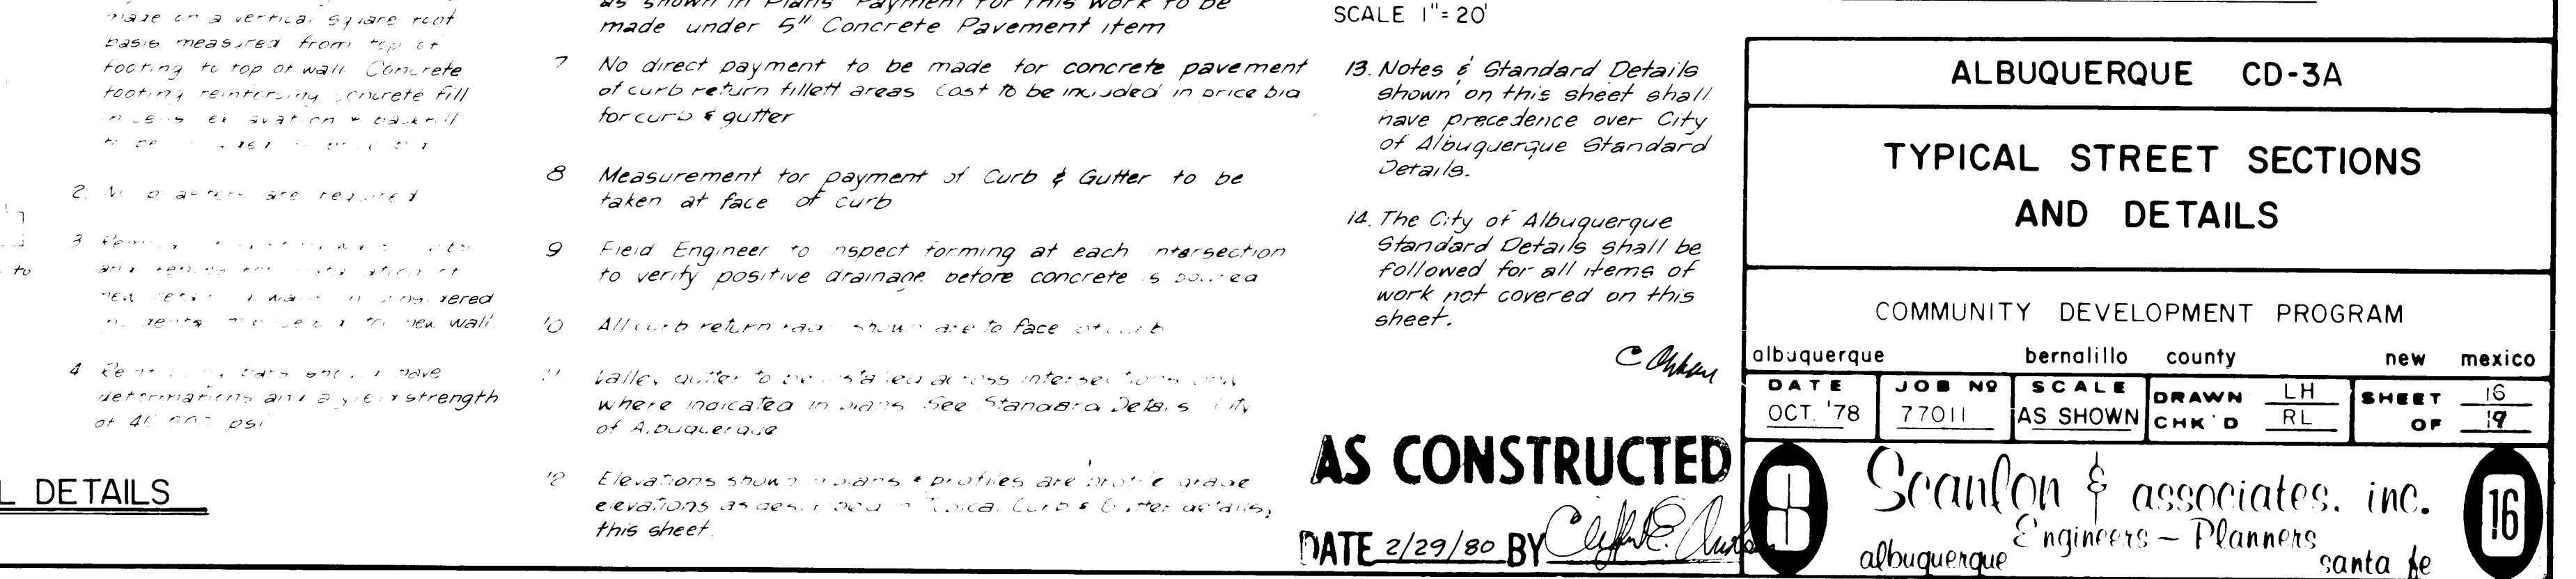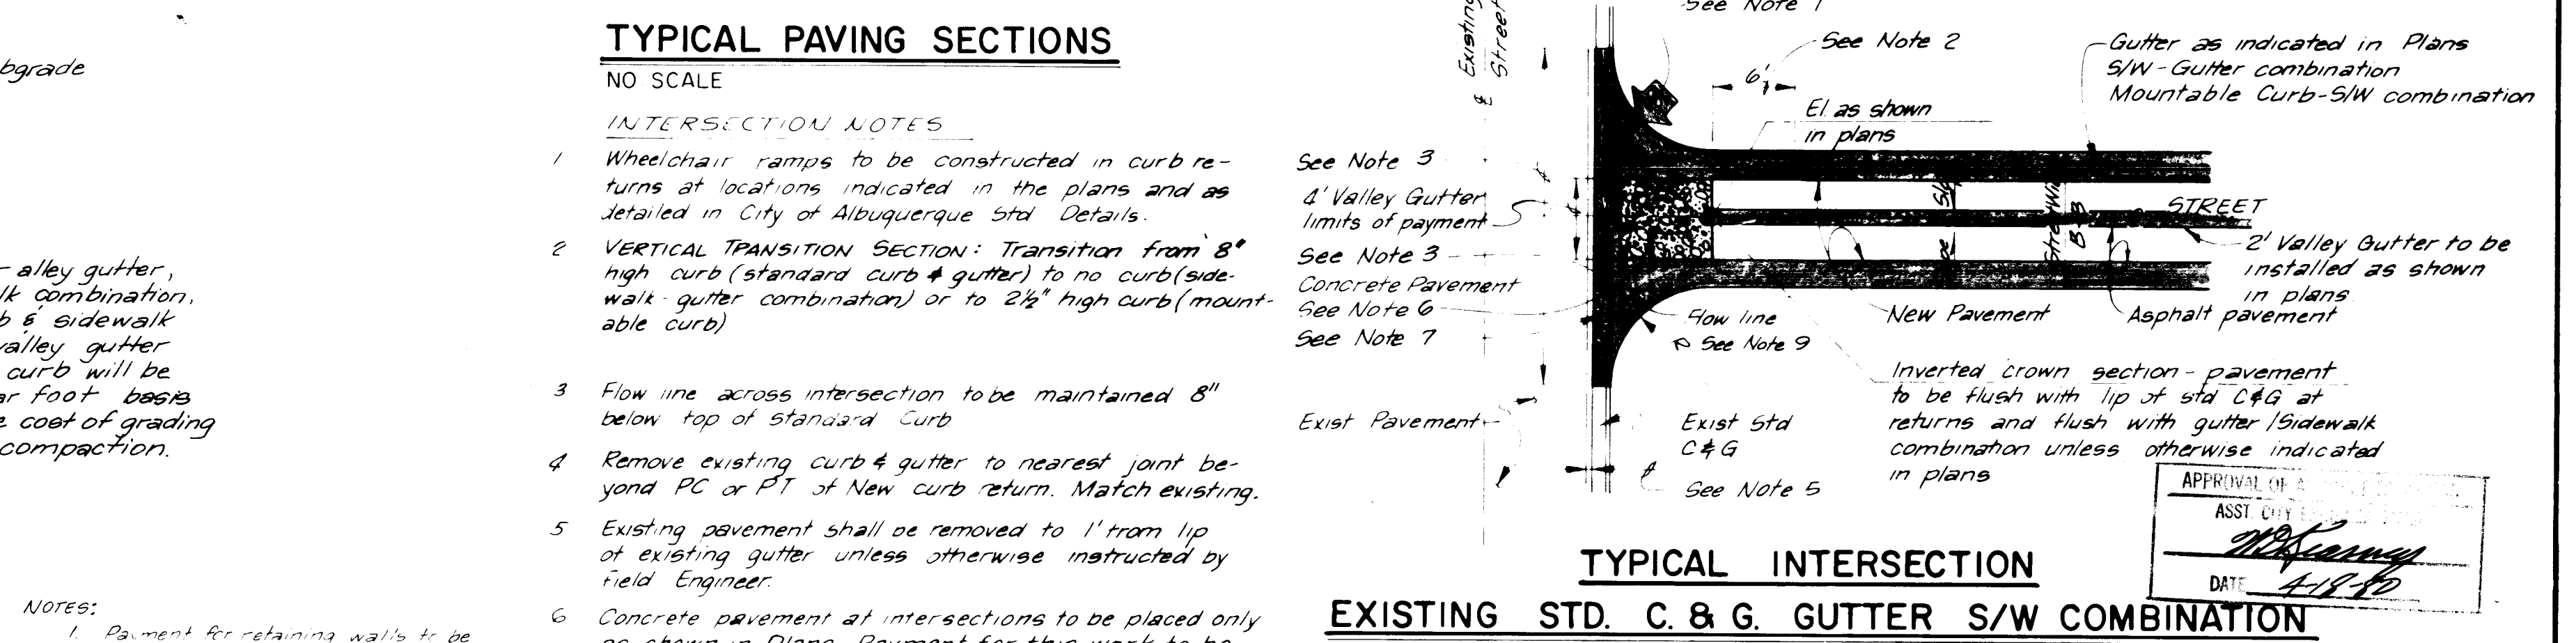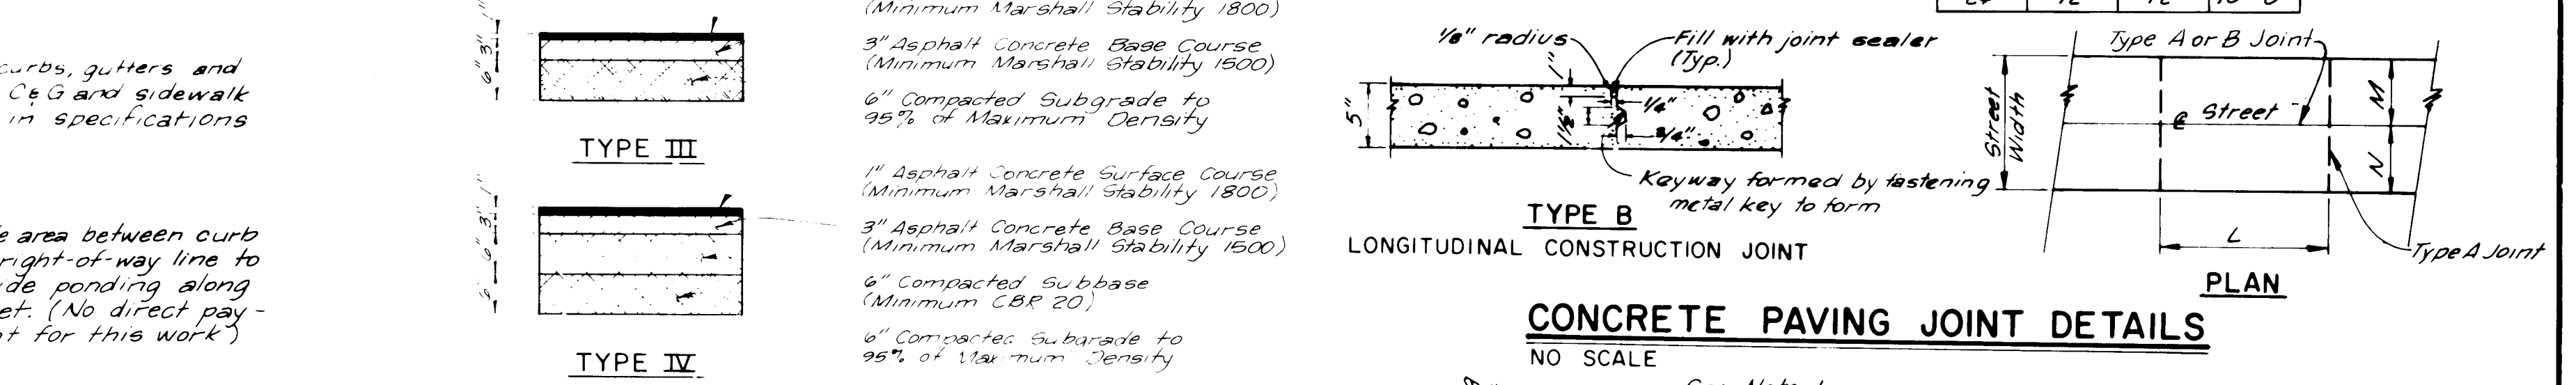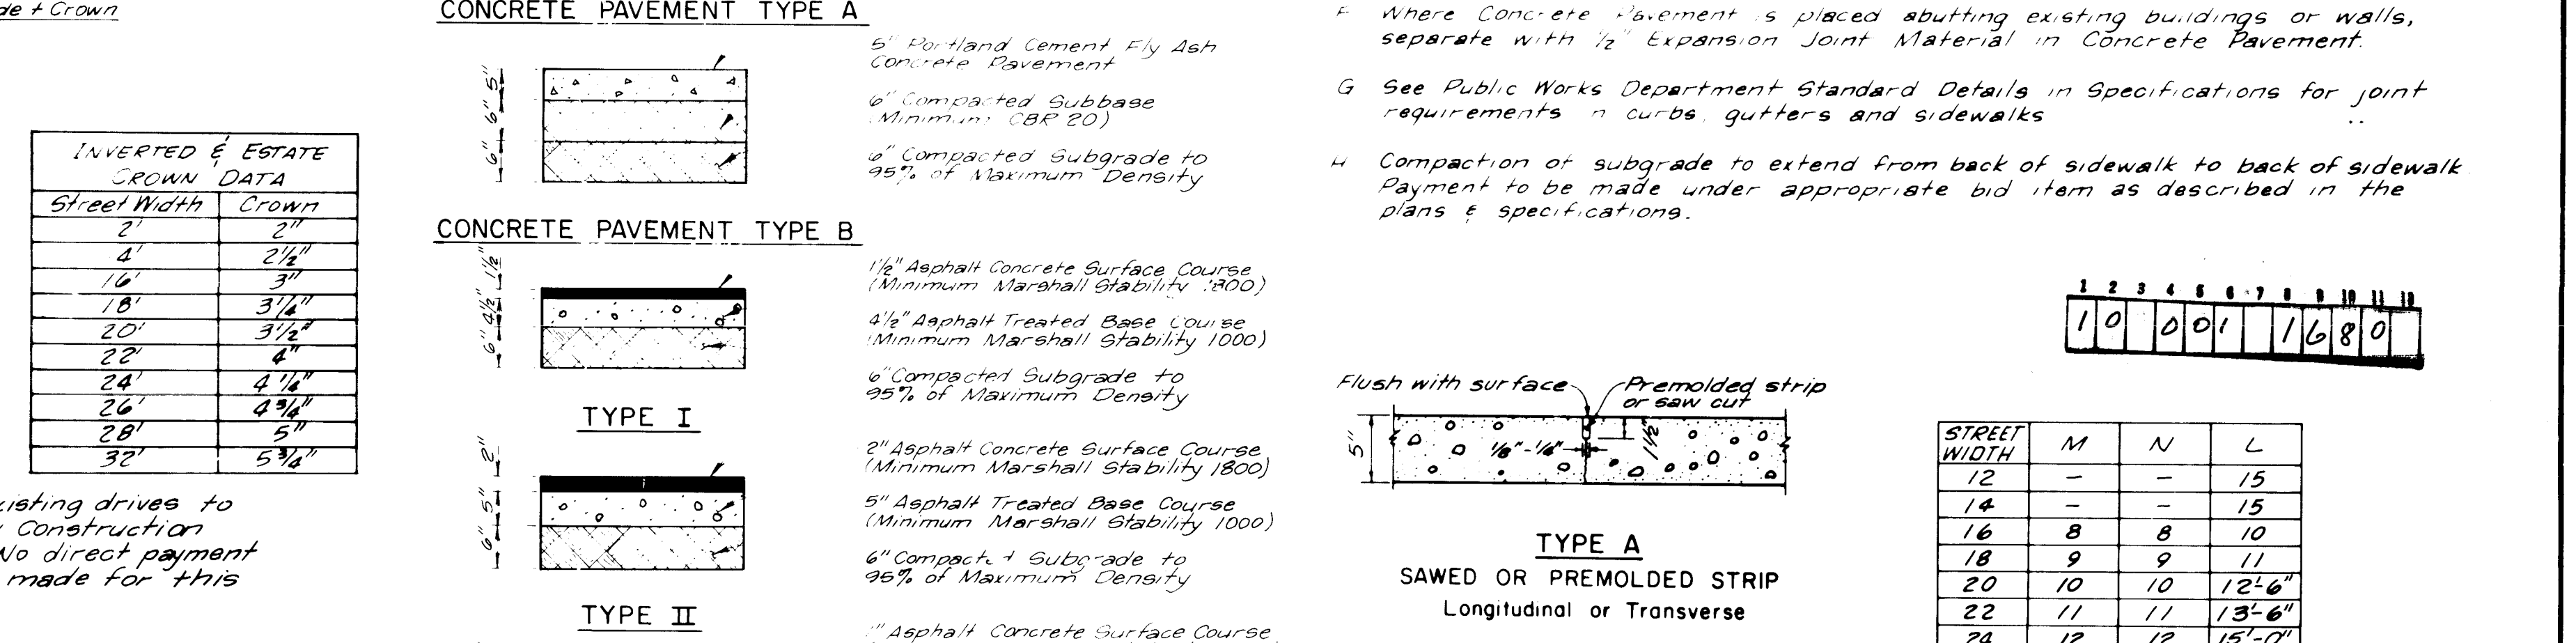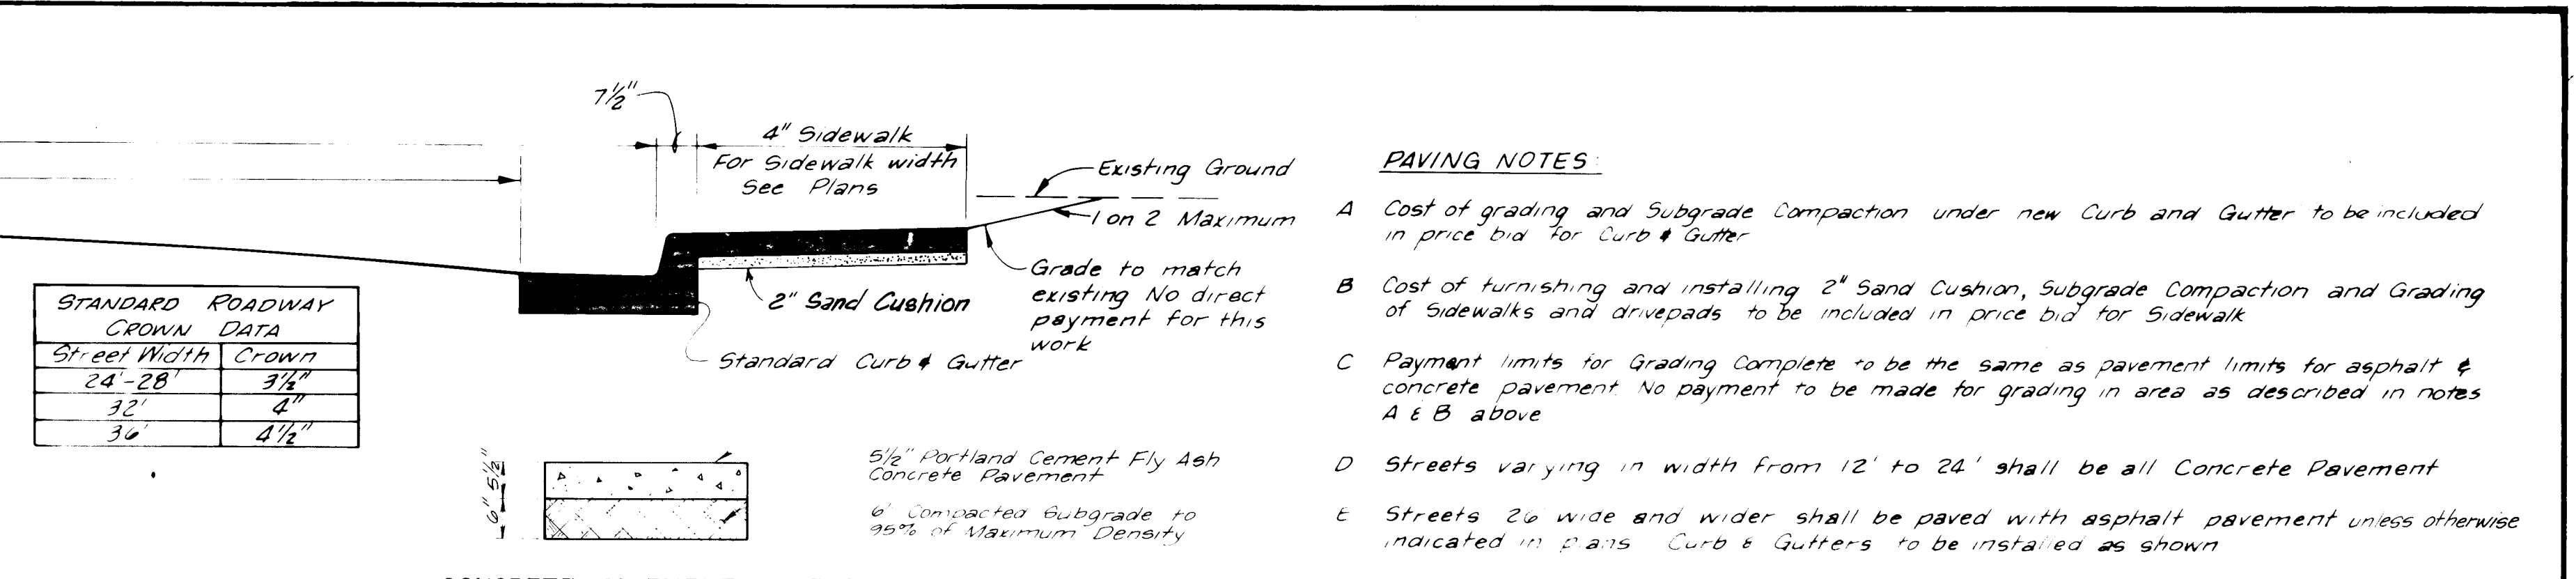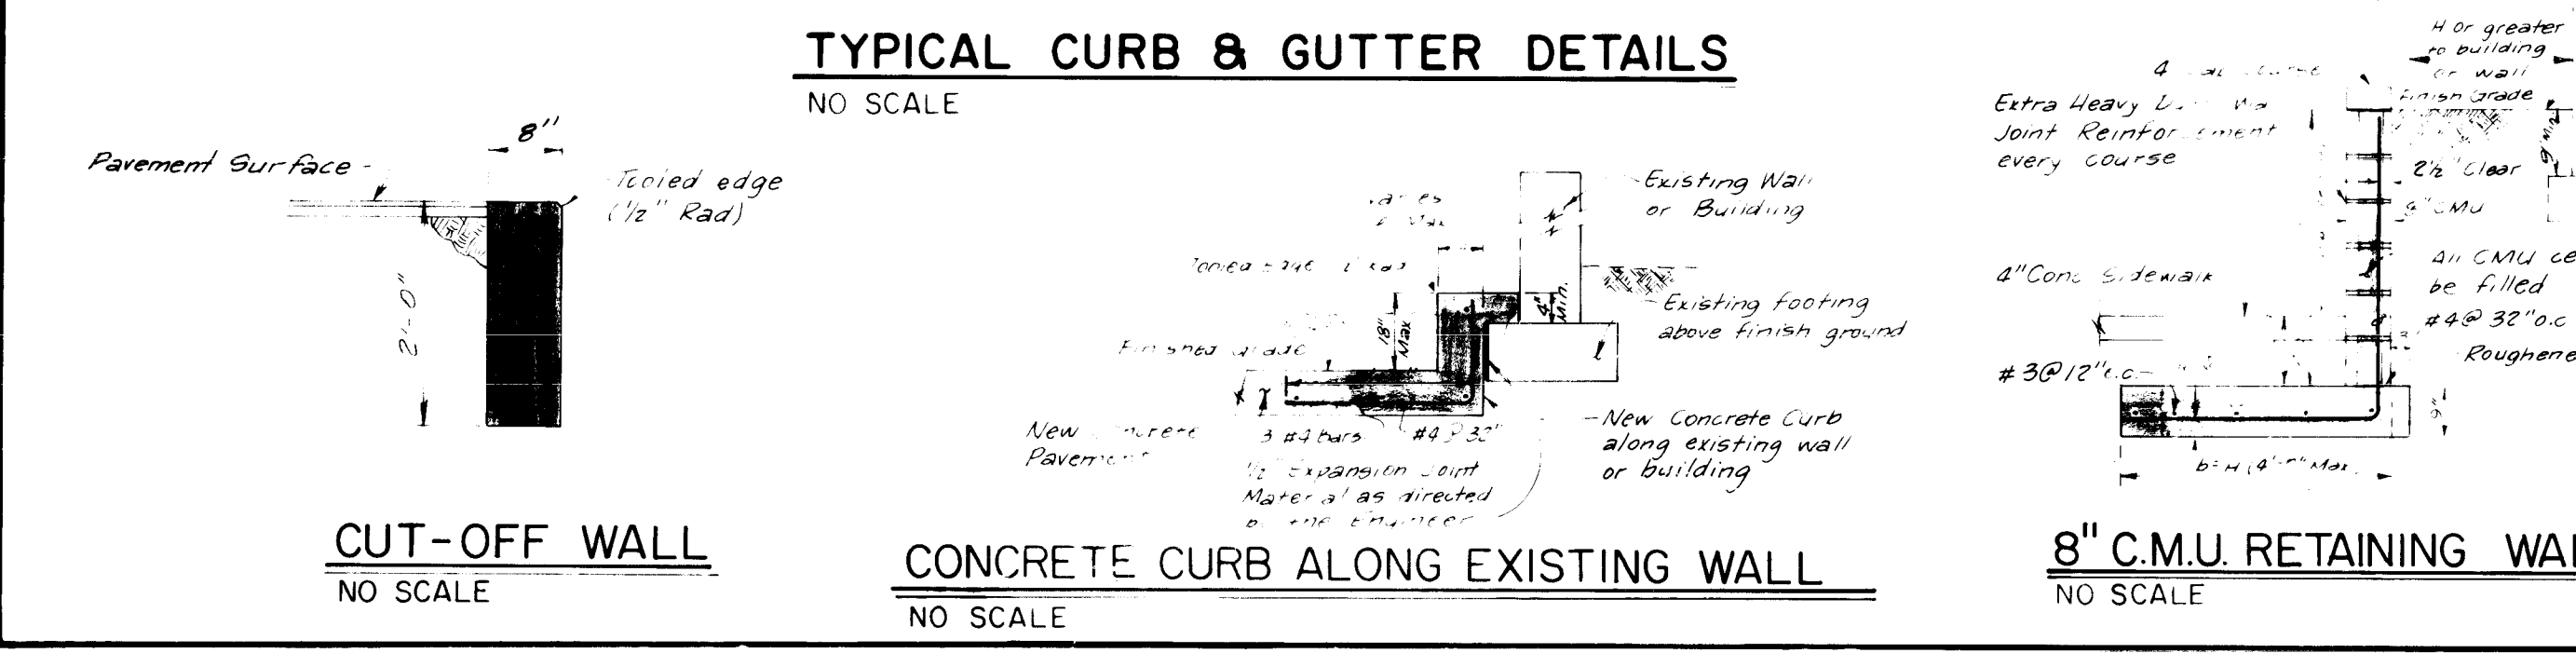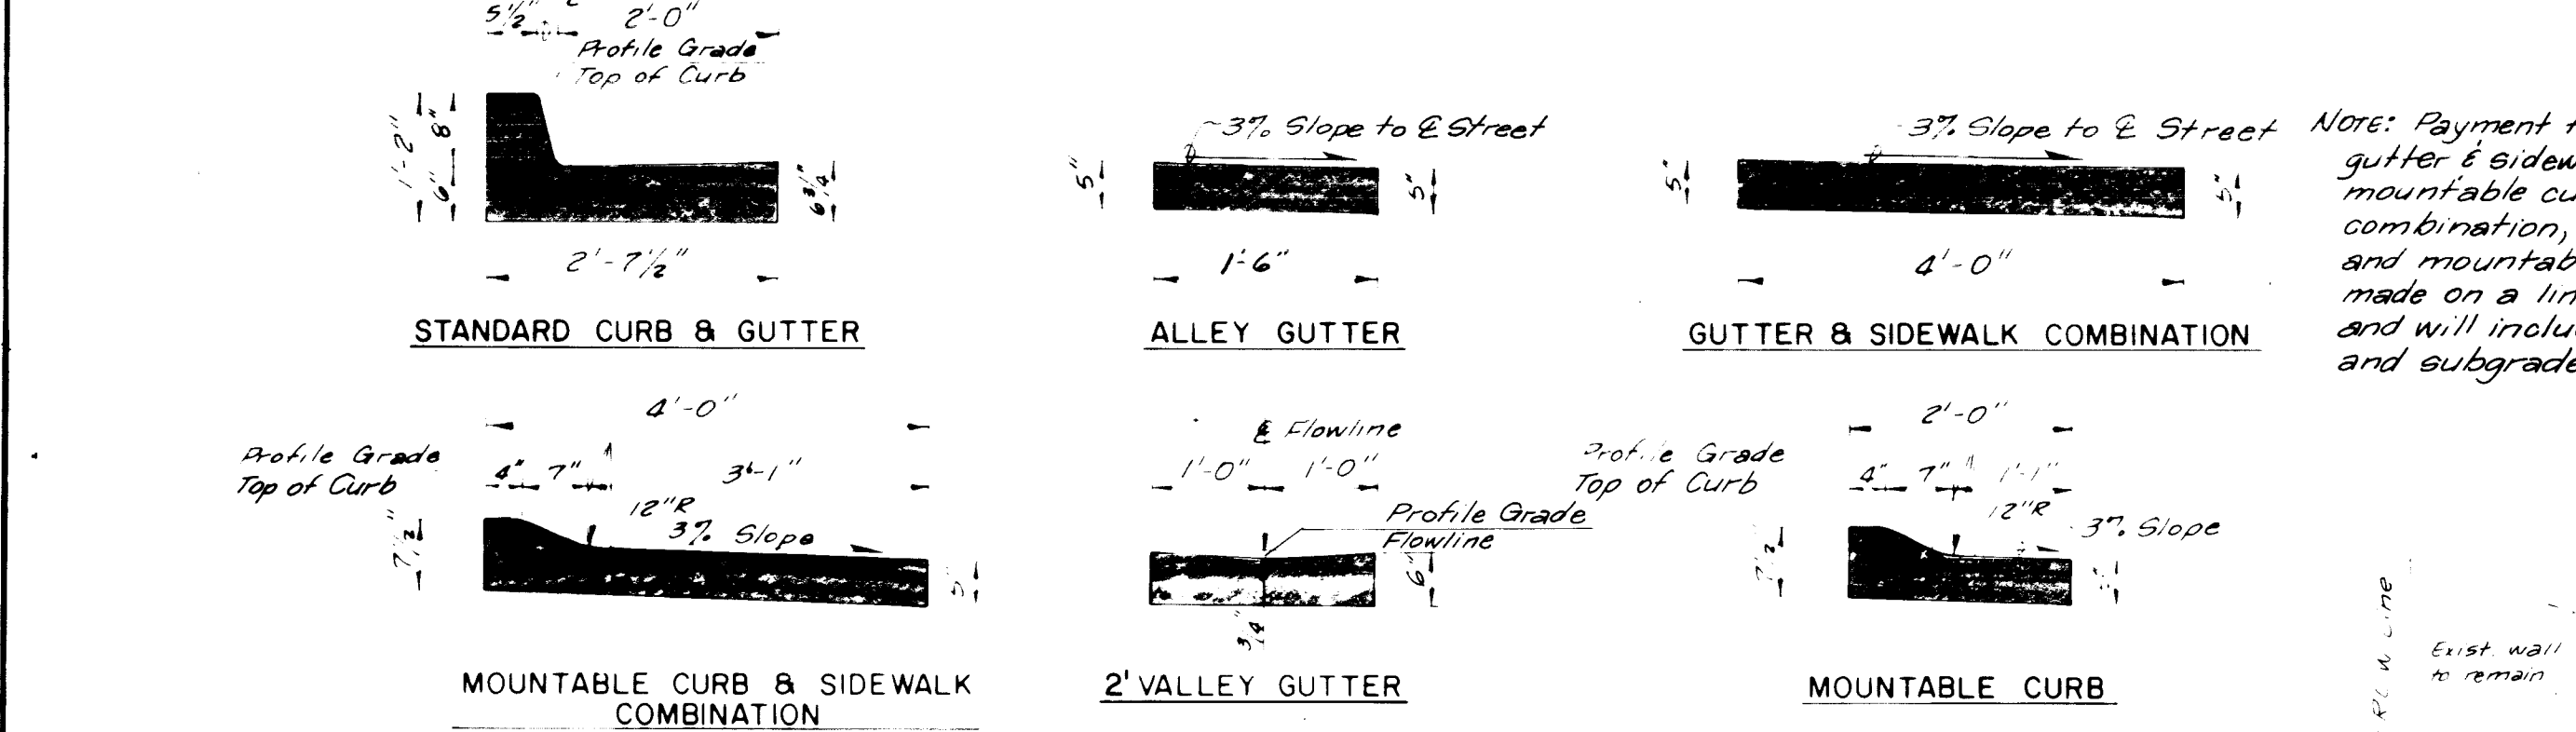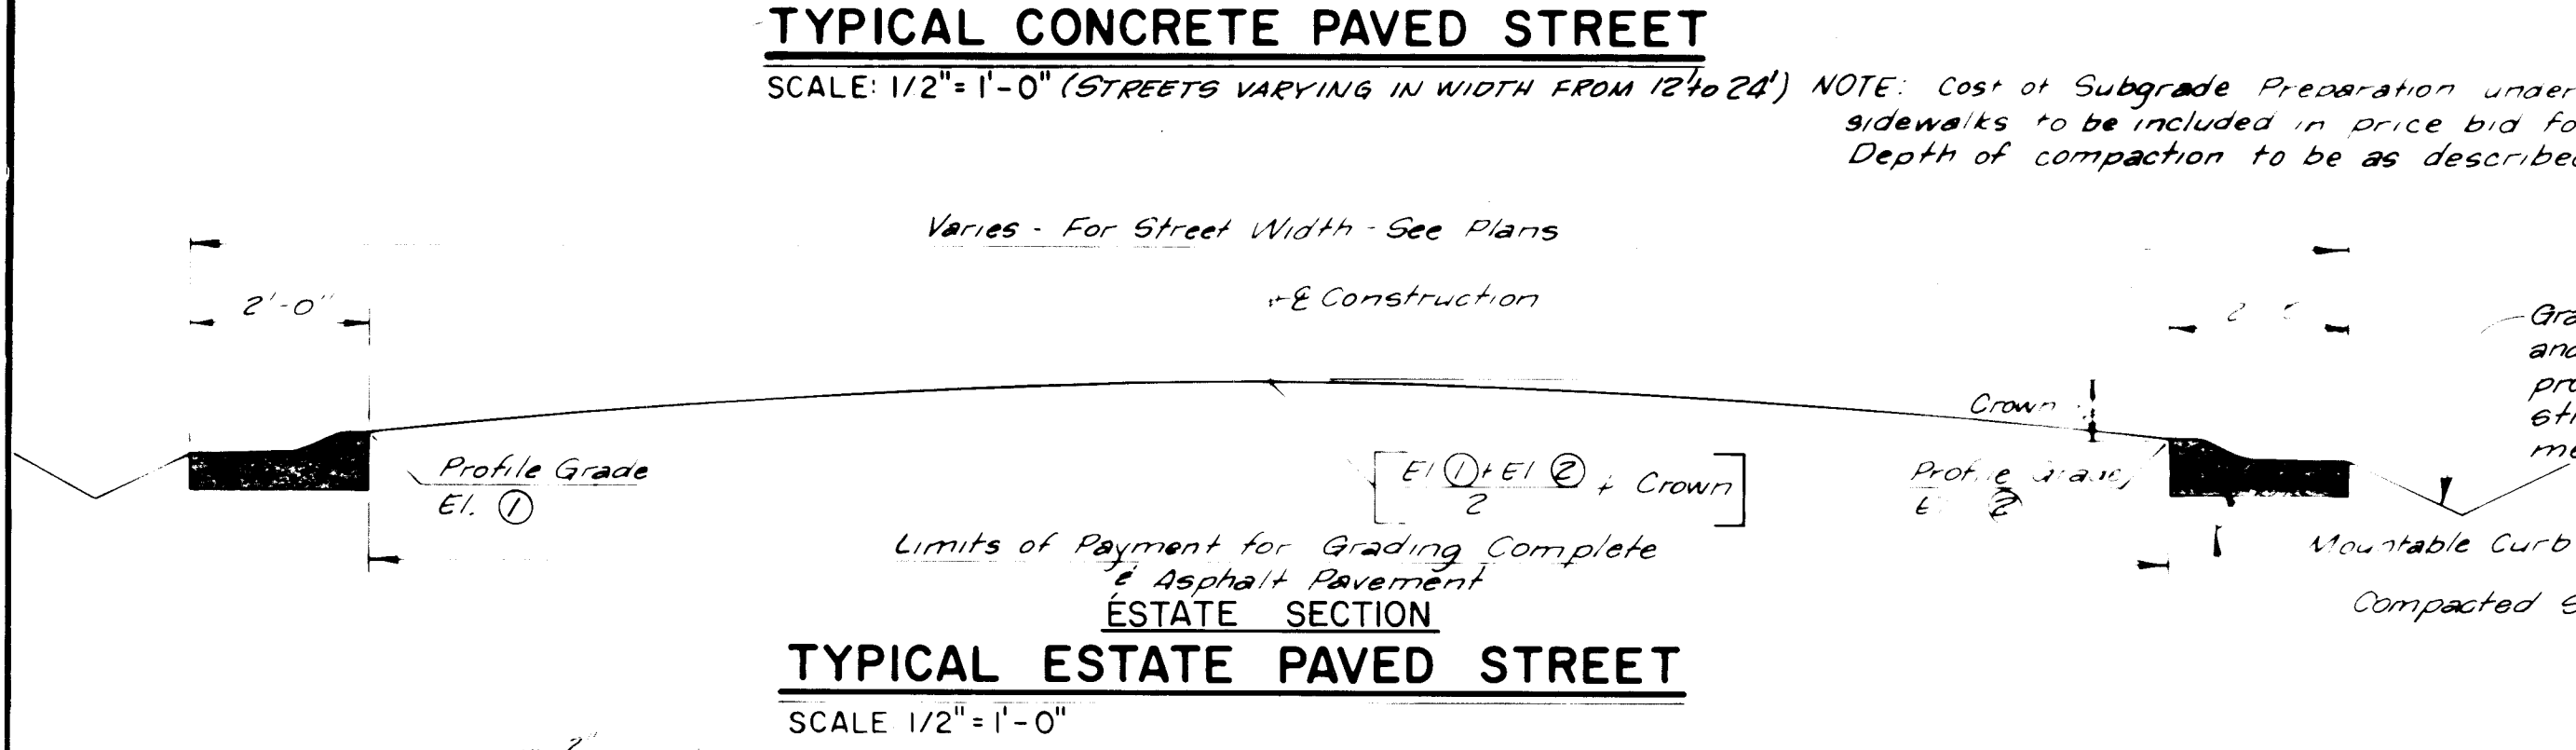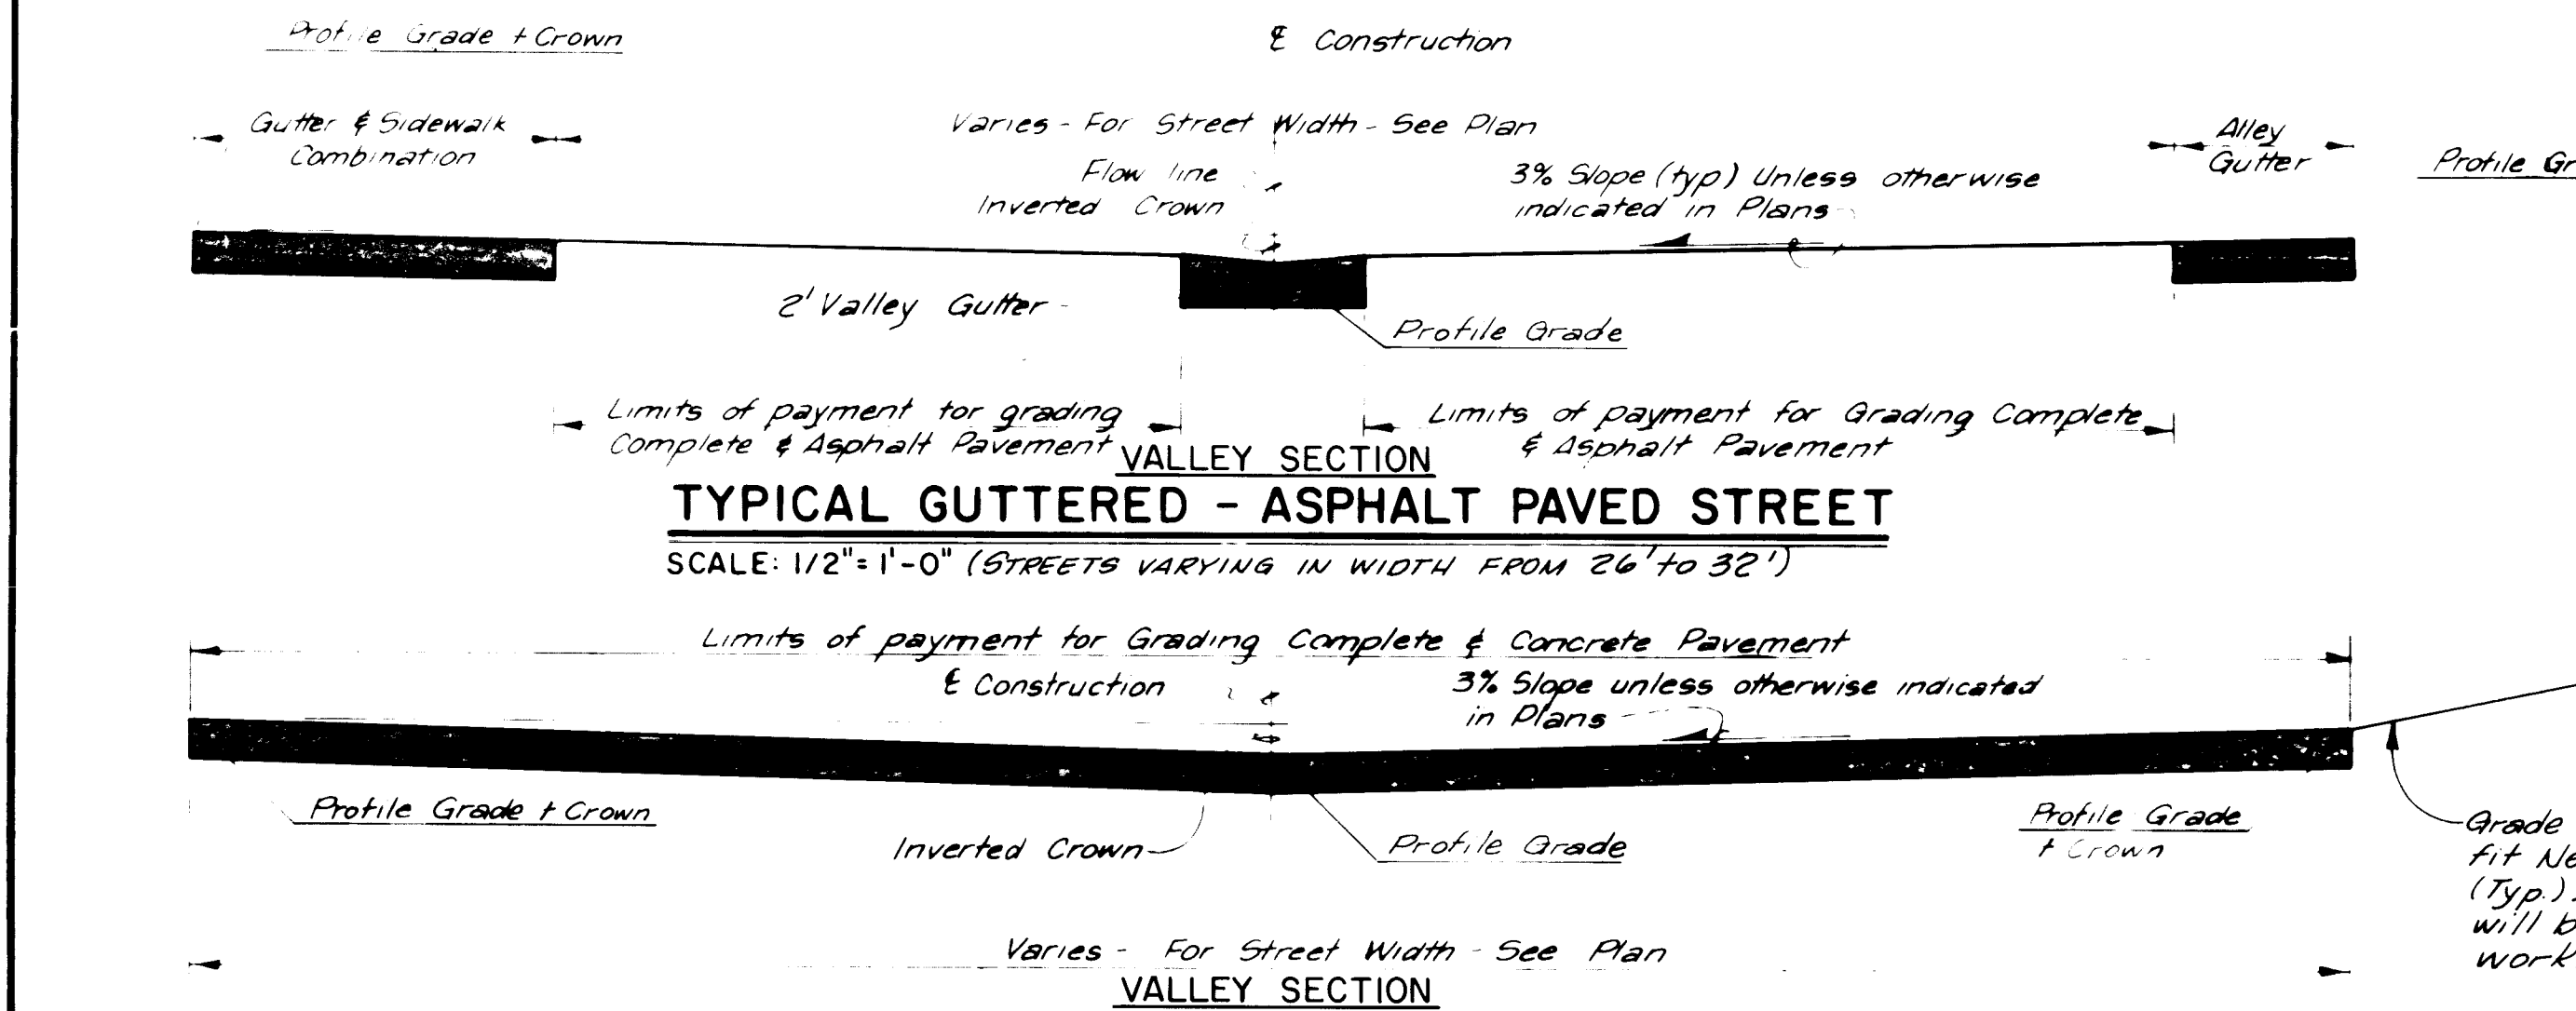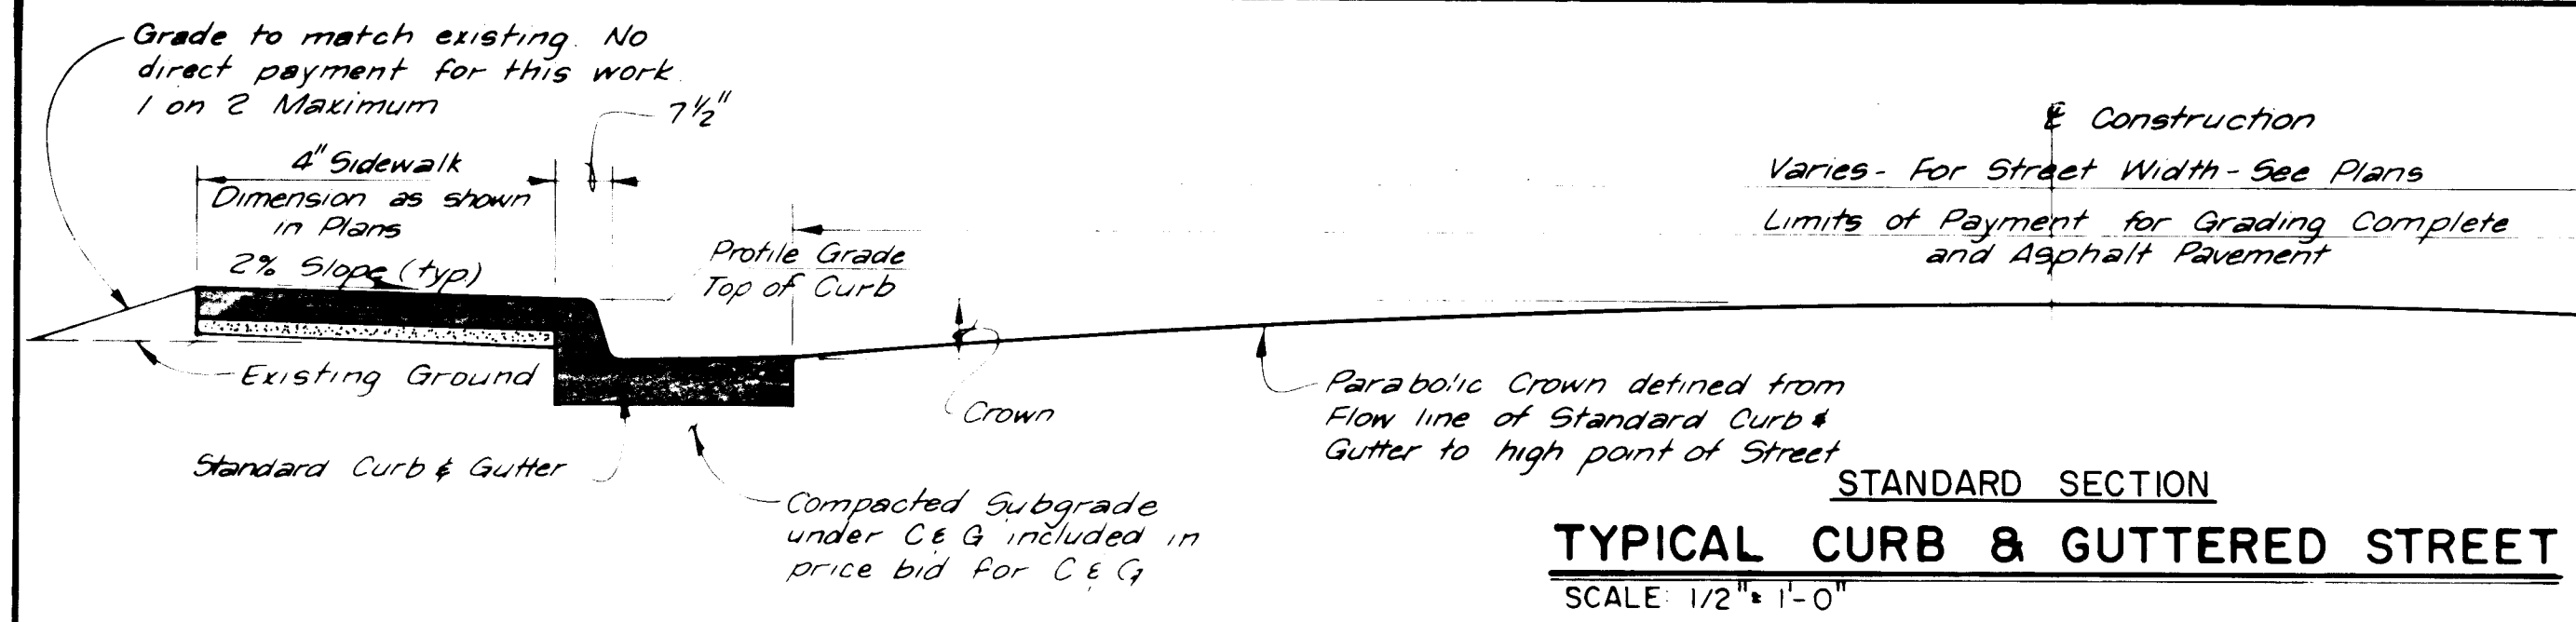


- PAVING NOTES**
- A Cost of grading and Subgrade Compaction under new Curb and Gutter to be included in price bid for Curb & Gutter
 - B Cost of furnishing and installing 2" Sand Cushion, Subgrade Compaction and Grading of Sidewalks and Driveways to be included in price bid for Sidewalk
 - C Payment limits for Grading Complete to be the same as pavement limits for asphalt & concrete pavement. No payment to be made for grading in area as described in notes A & B above.
 - D Streets varying in width from 12' to 24' shall be all Concrete Pavement
 - E Streets 26' wide and wider shall be paved with asphalt pavement unless otherwise indicated in plans. Curb & Gutters to be installed as shown
 - F Where Concrete Pavement is placed abutting existing buildings or walls, separate with 1/2" Expansion Joint Material in Concrete Pavement
 - G See Public Works Department Standard Details in Specifications for joint requirements in curbs, gutters and sidewalks
 - H Compaction of subgrade to extend from back of sidewalk to back of sidewalk. Payment to be made under appropriate bid item as described in the plans & specifications.

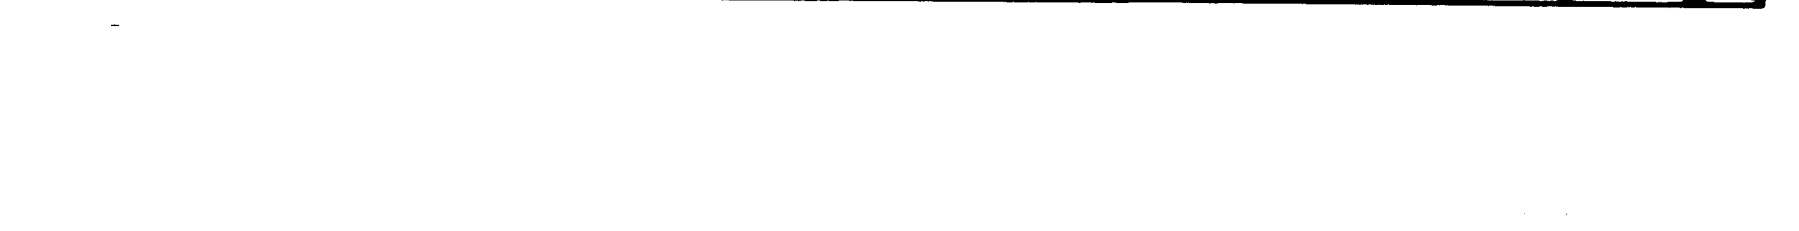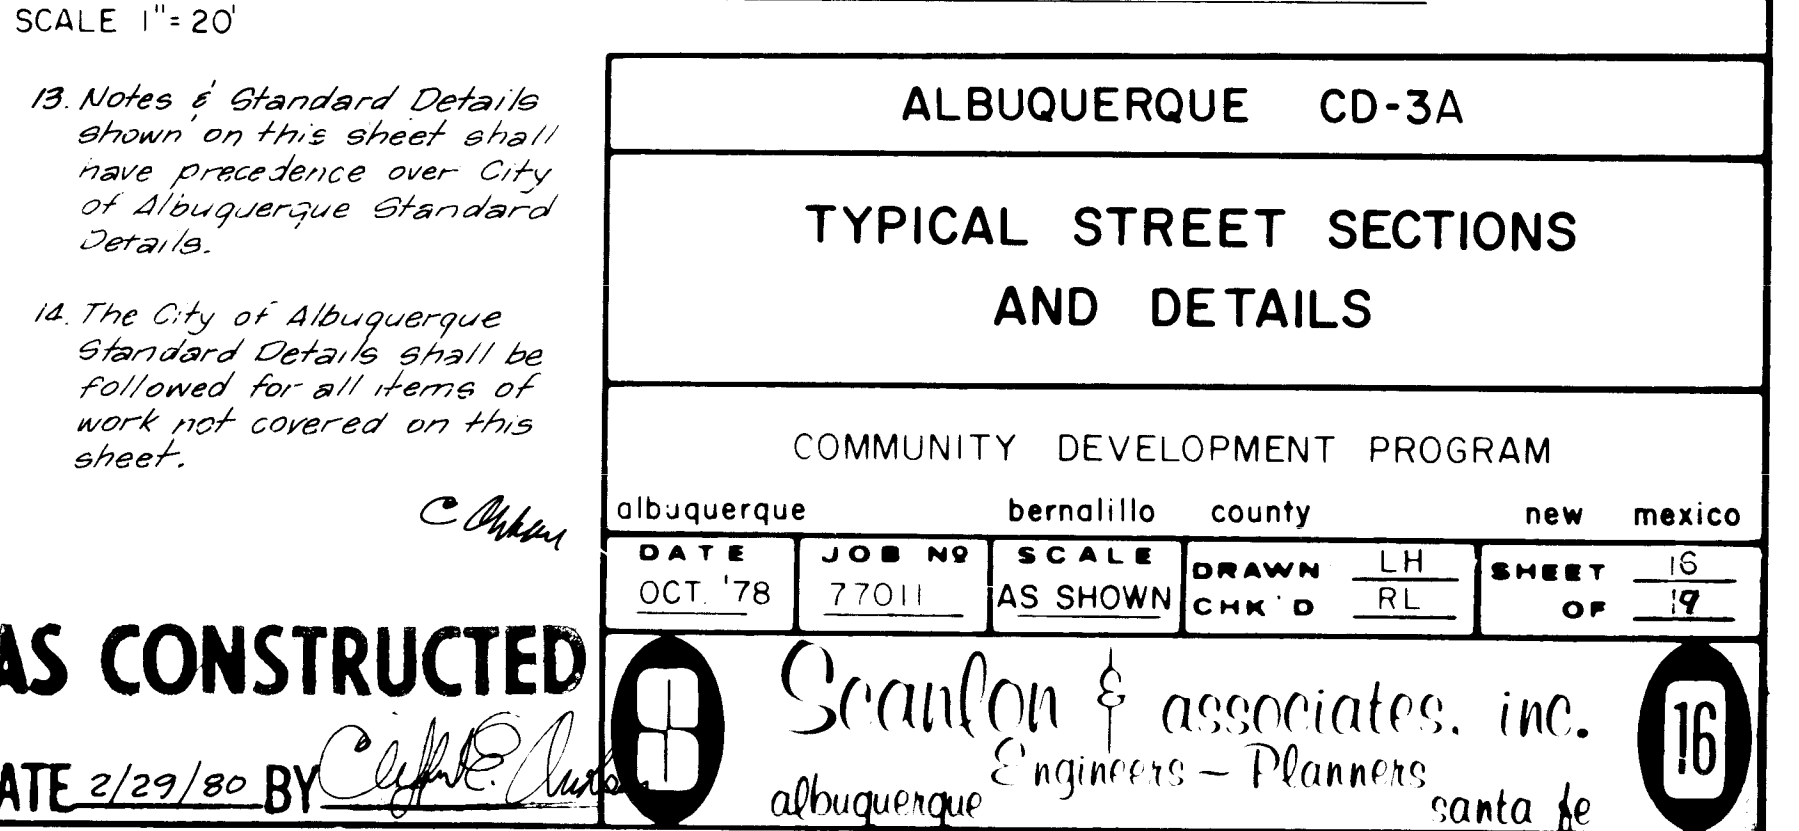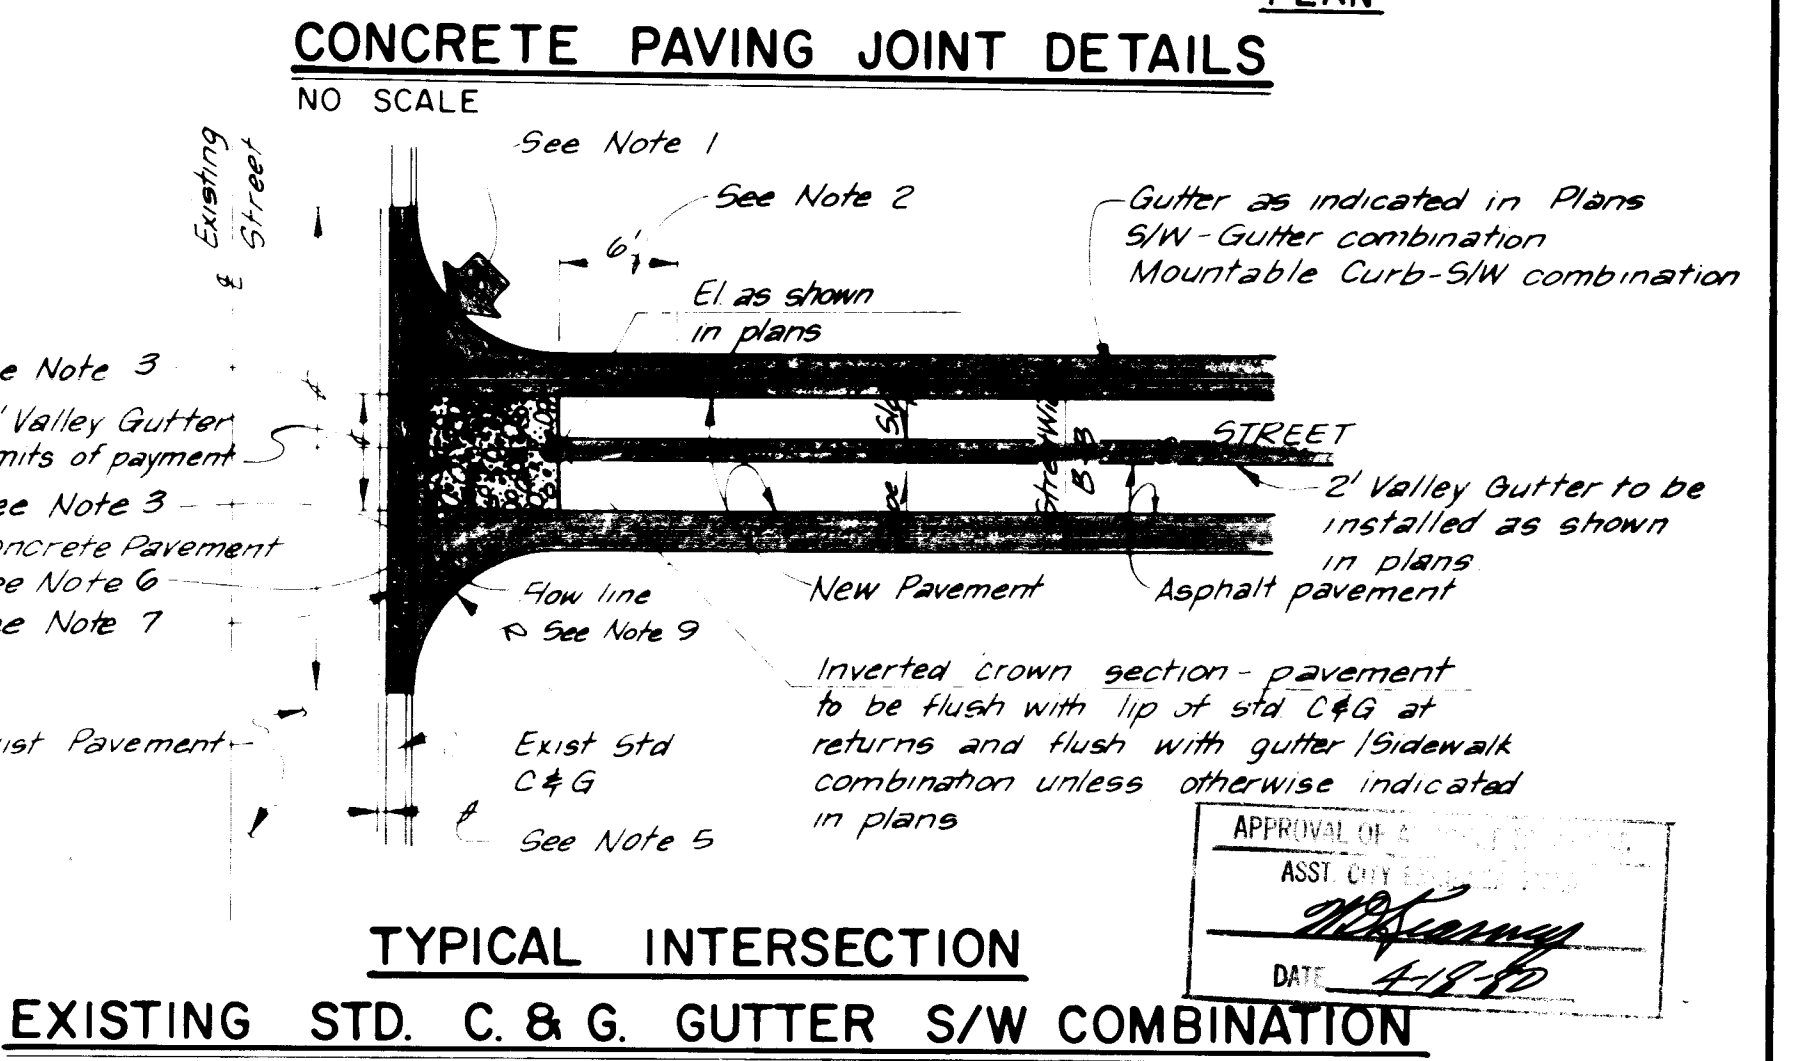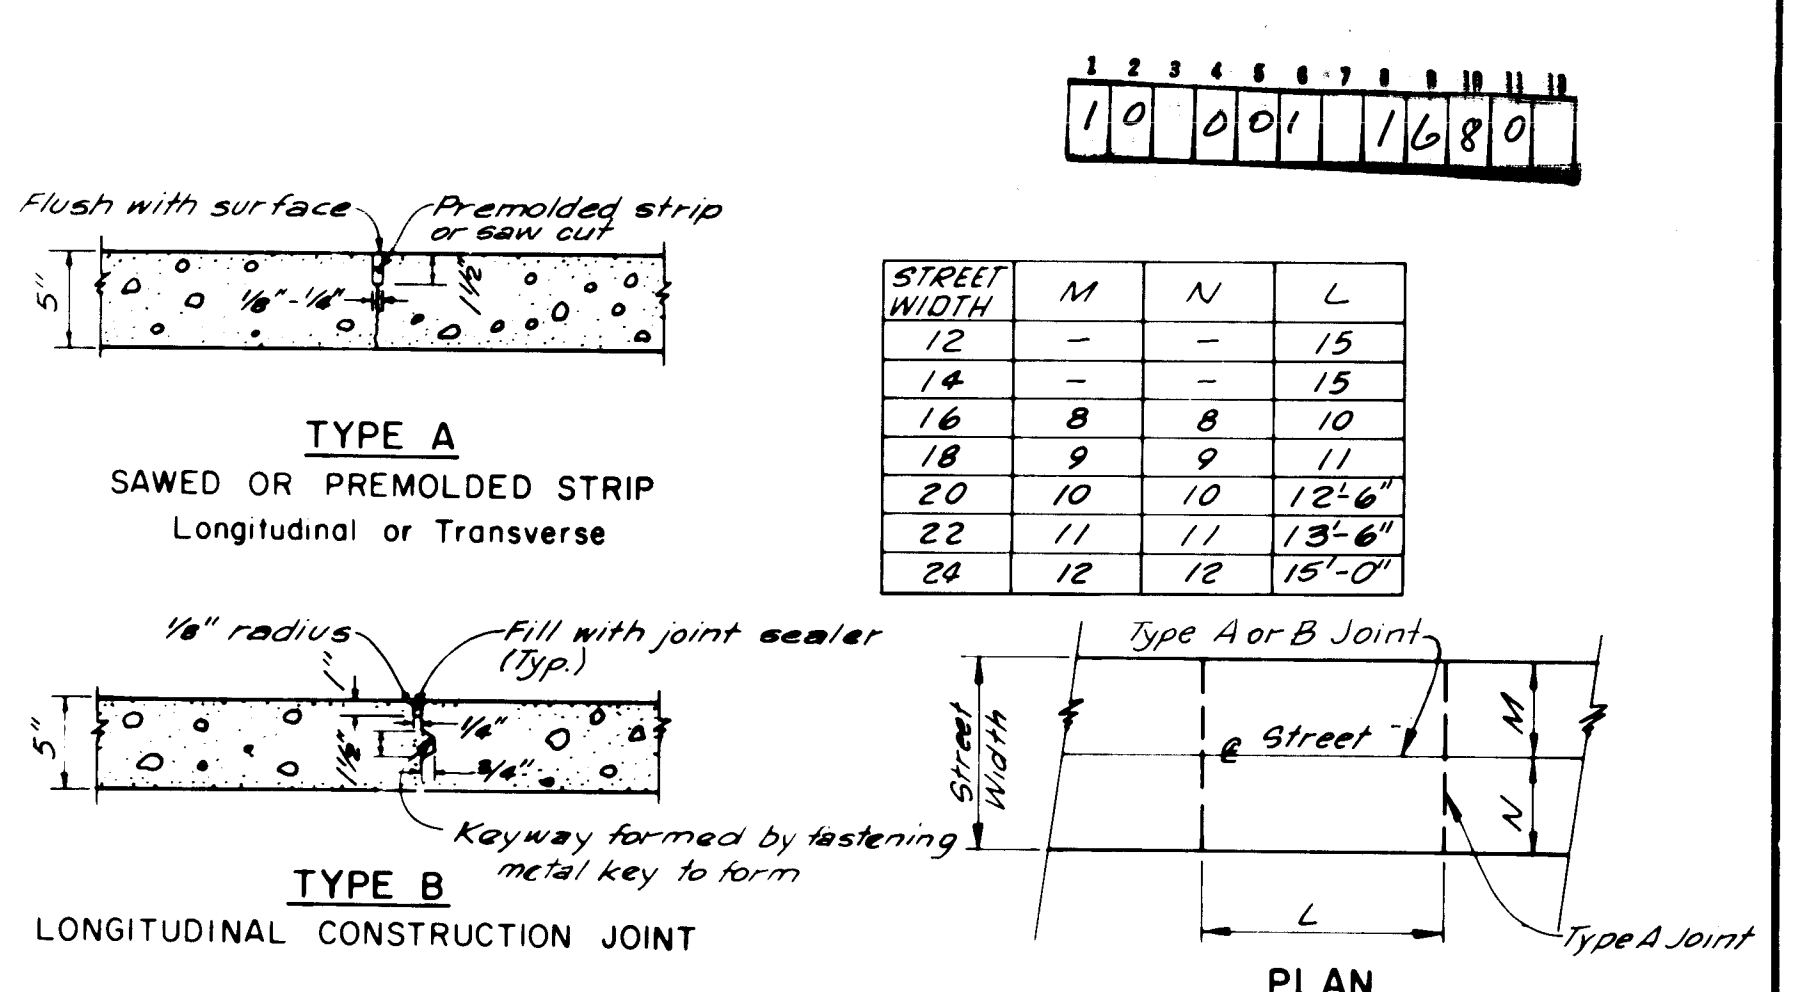

[illegible]

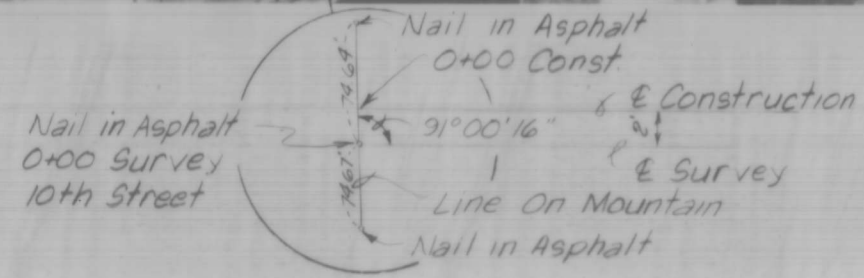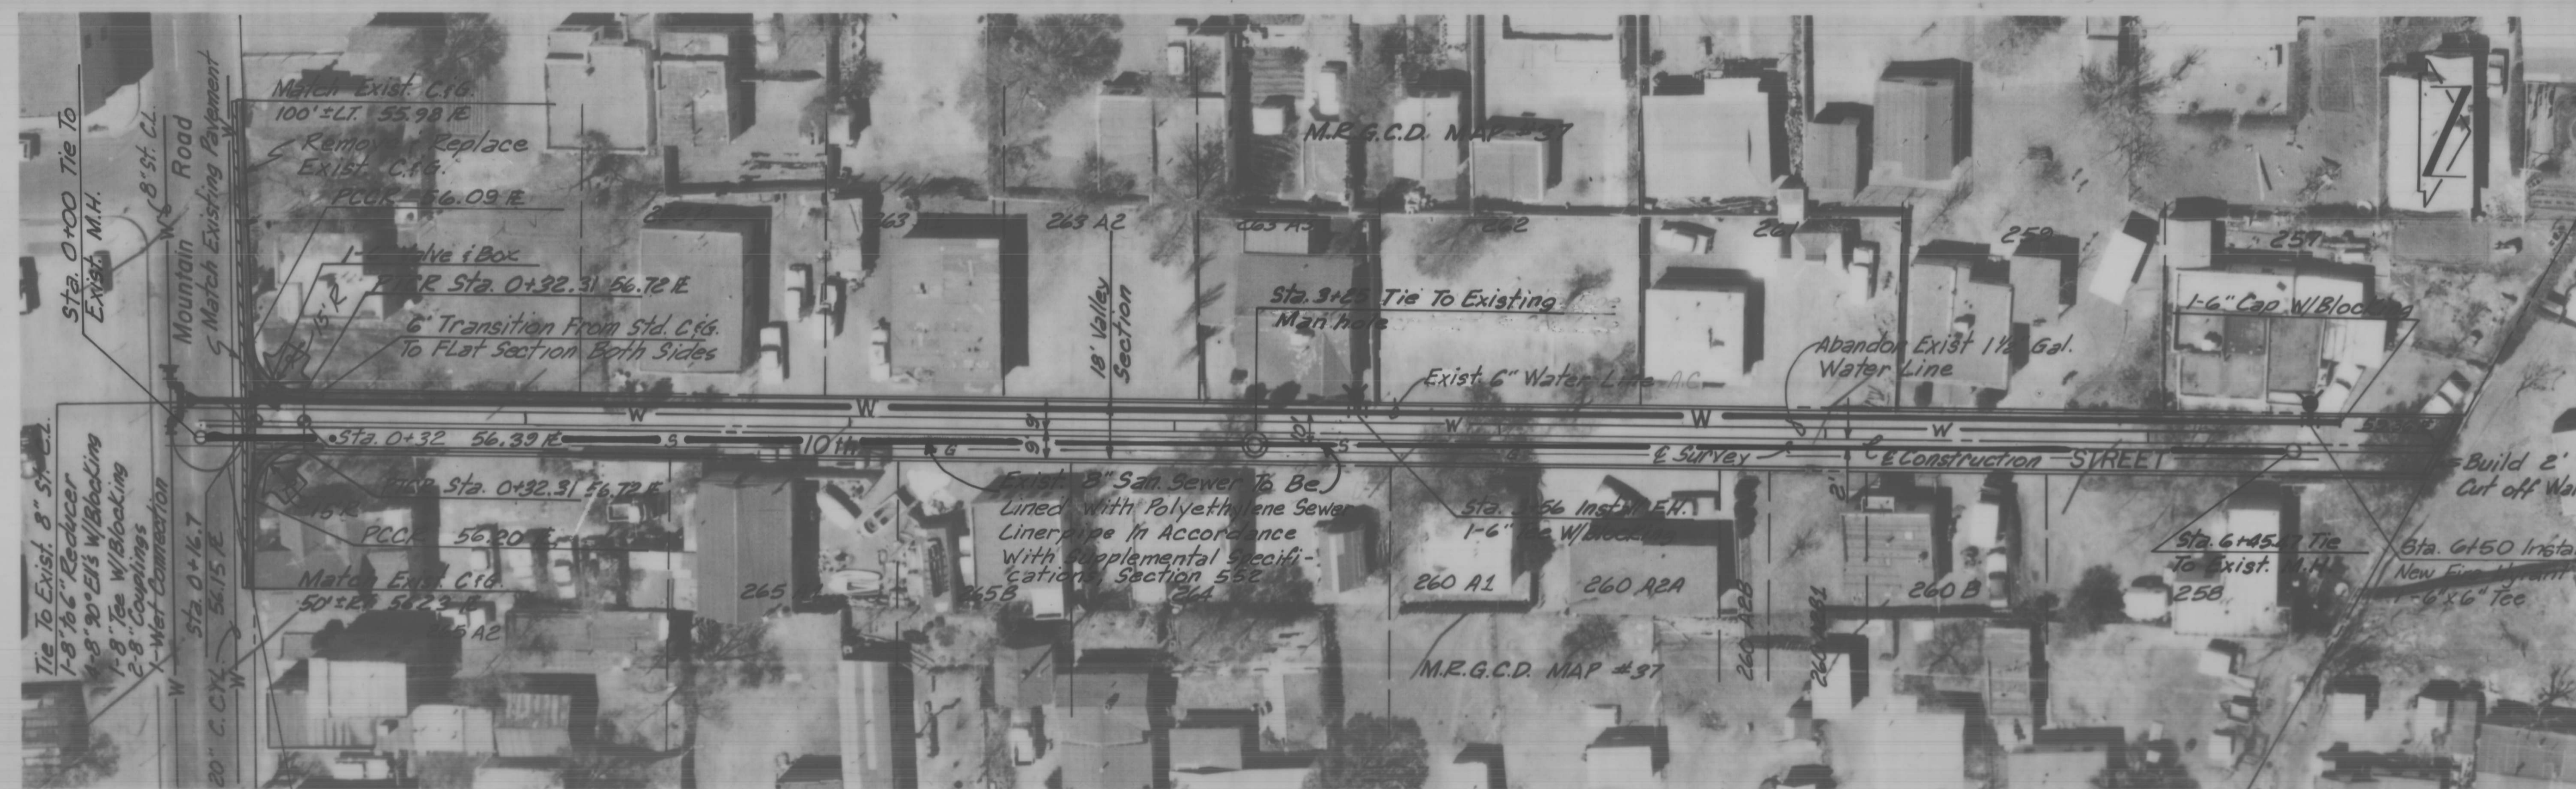


PLAN
SCALE: 1"=40'

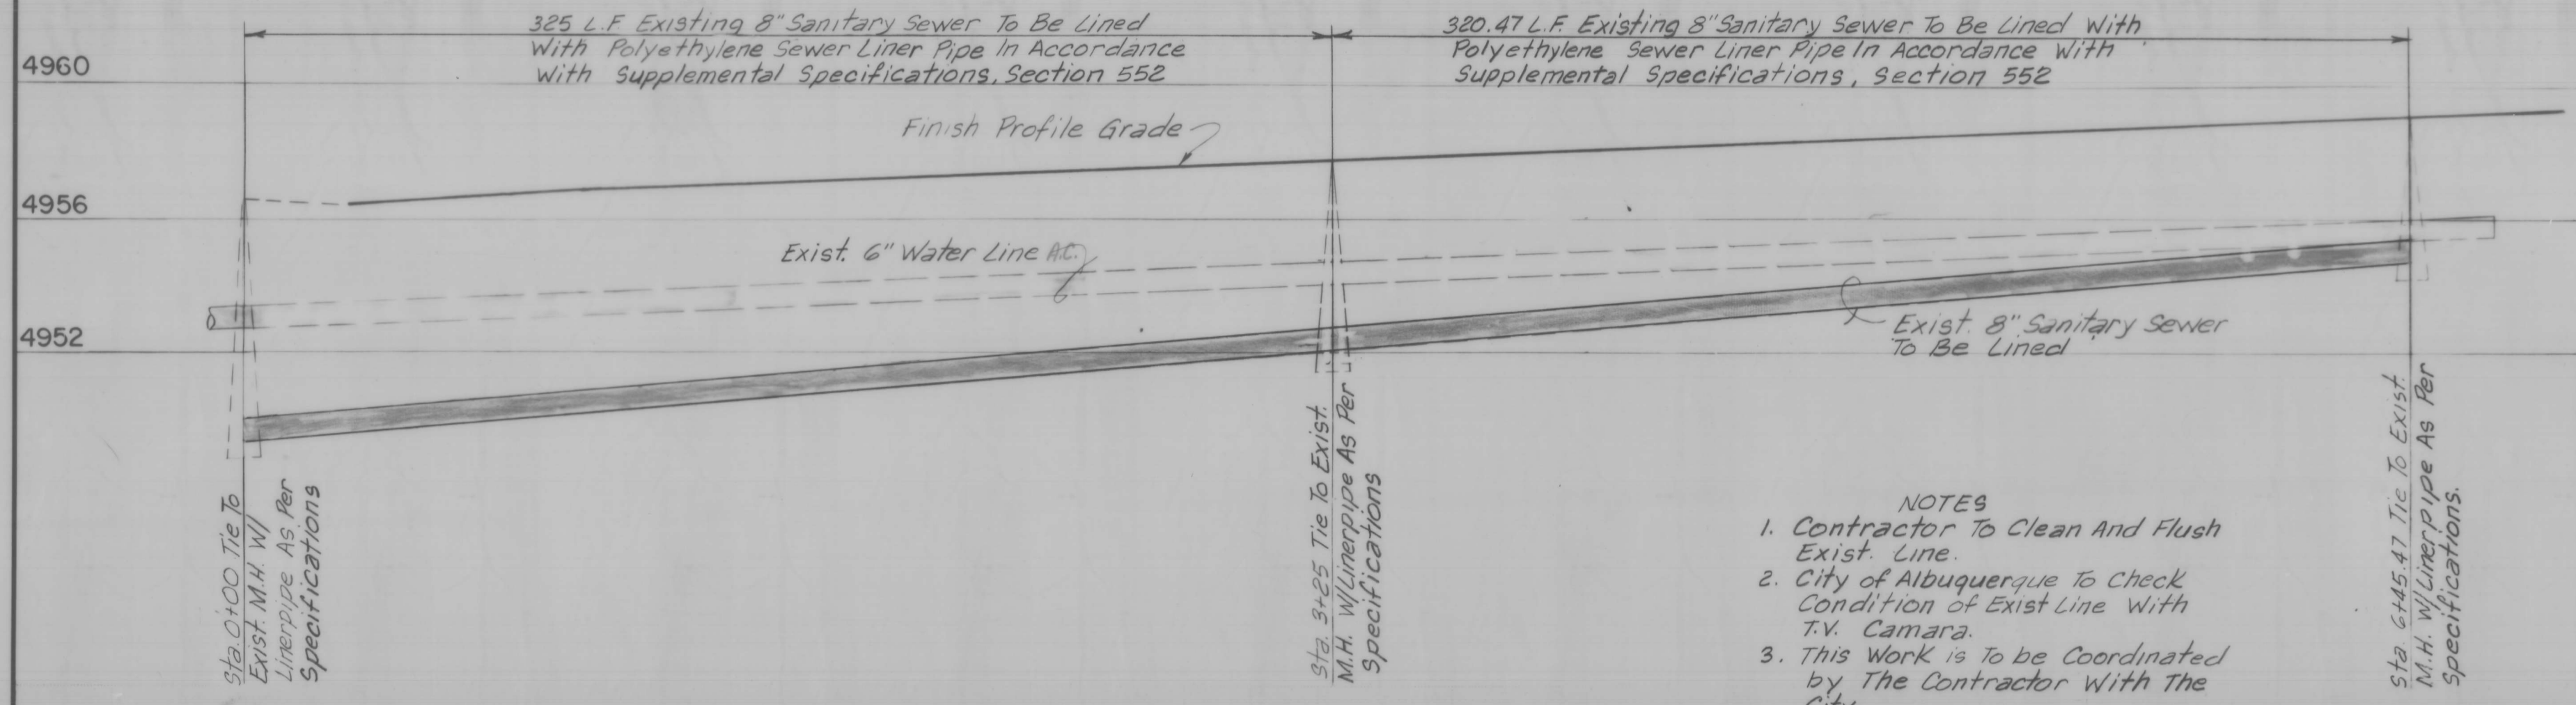


- NOTES
1. Contractor To Clean And Flush Exist. Line.
 2. City of Albuquerque To Check Condition of Exist Line With T.V. Camera.
 3. This Work is to be Coordinated by The Contractor With The City.

PROFILE
SCALE: 1"=40' HCRZ.
1"= 4' VERT.

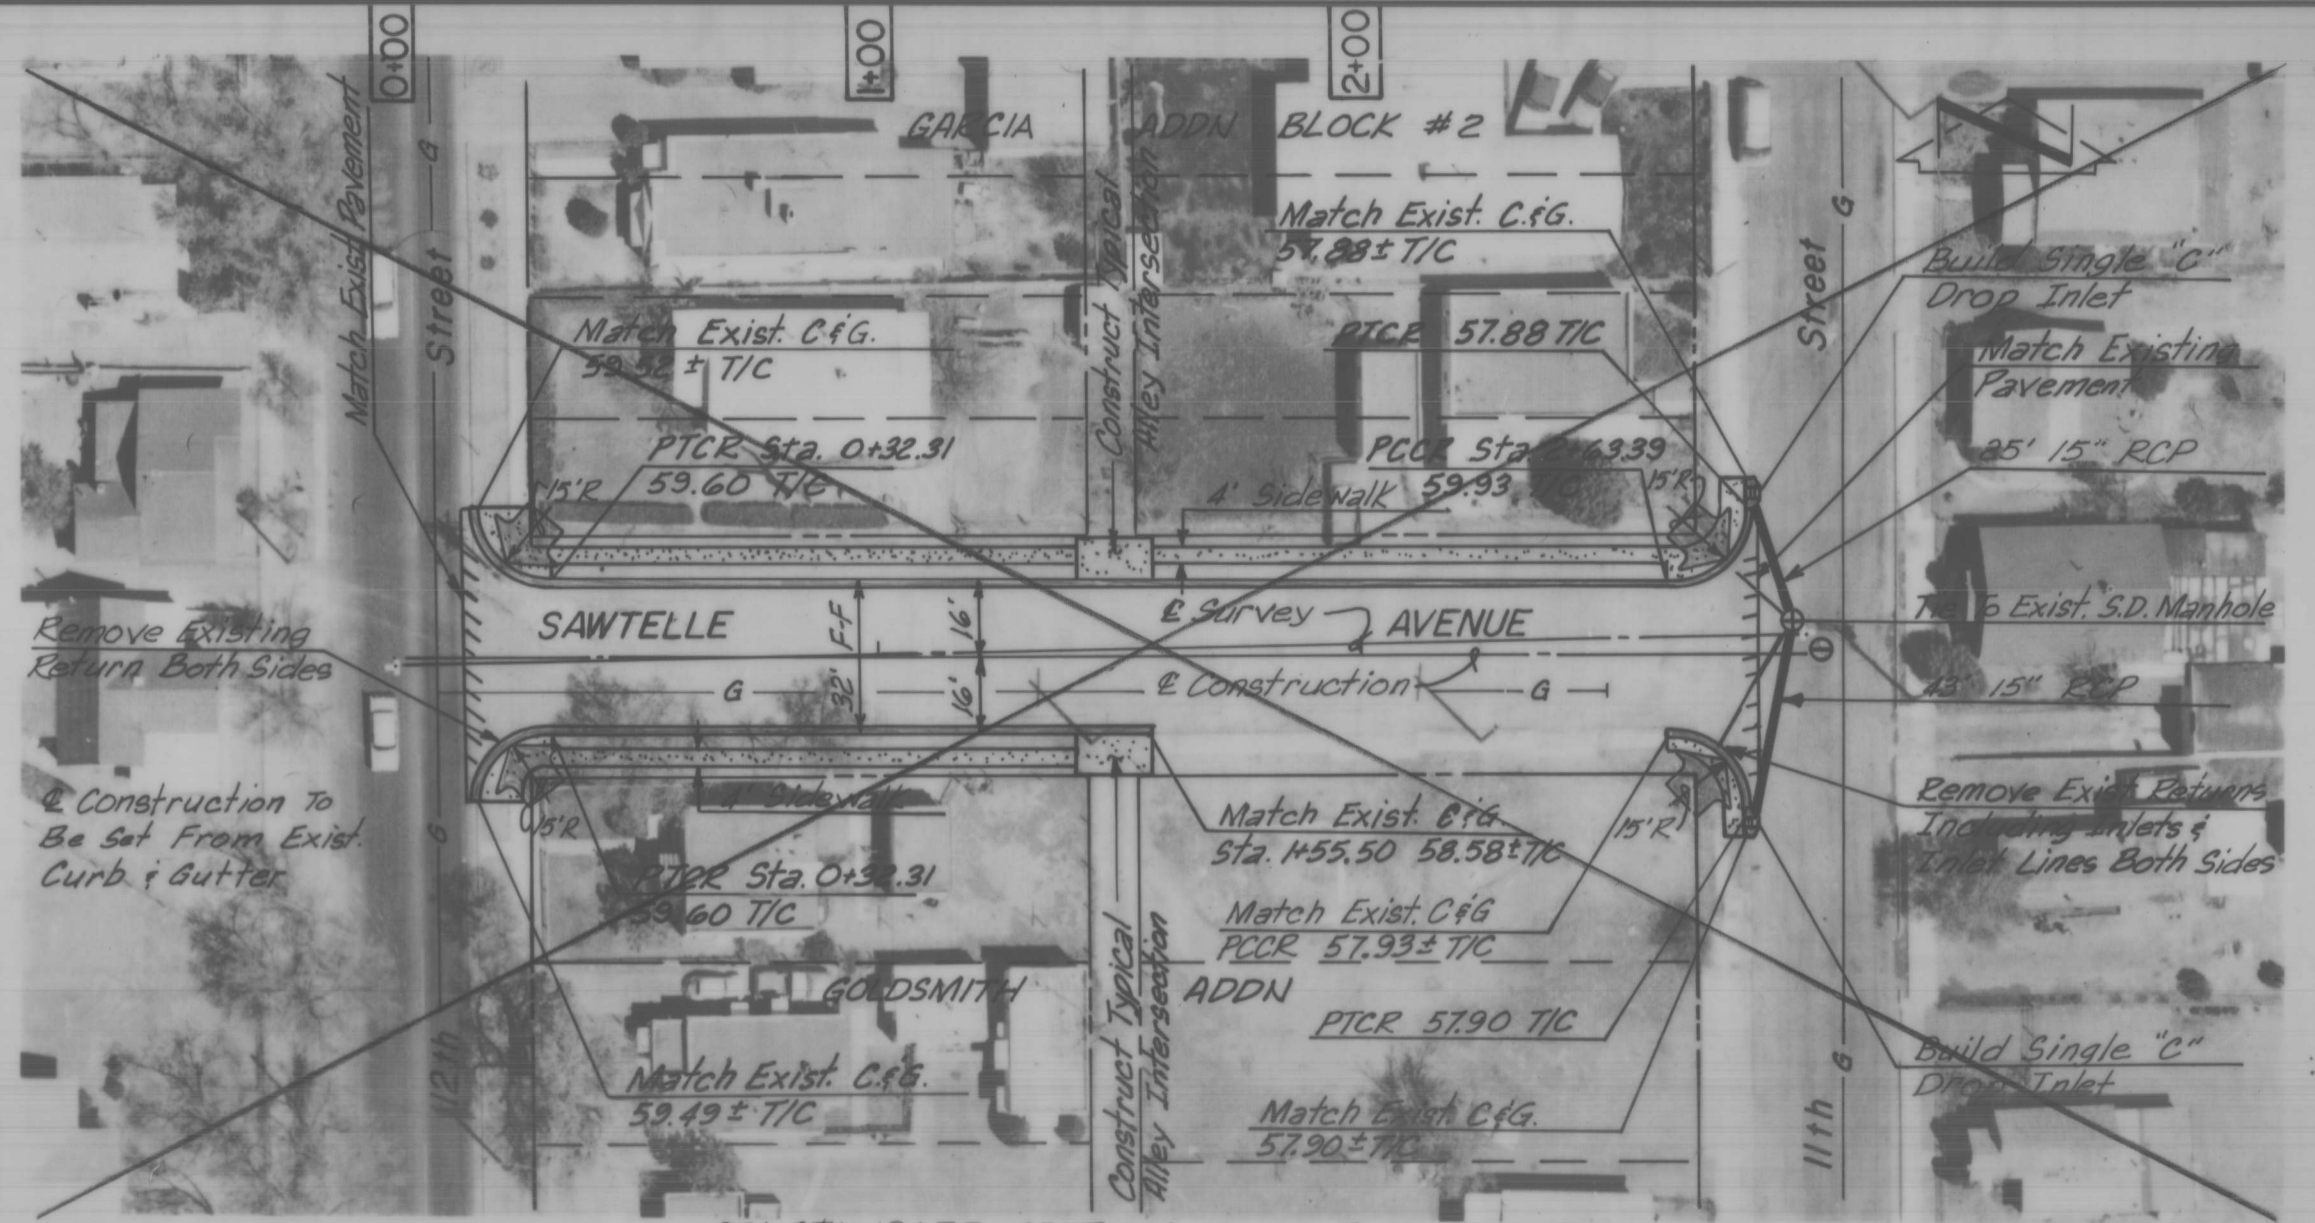

PLAN
SCALE: 1"=40'

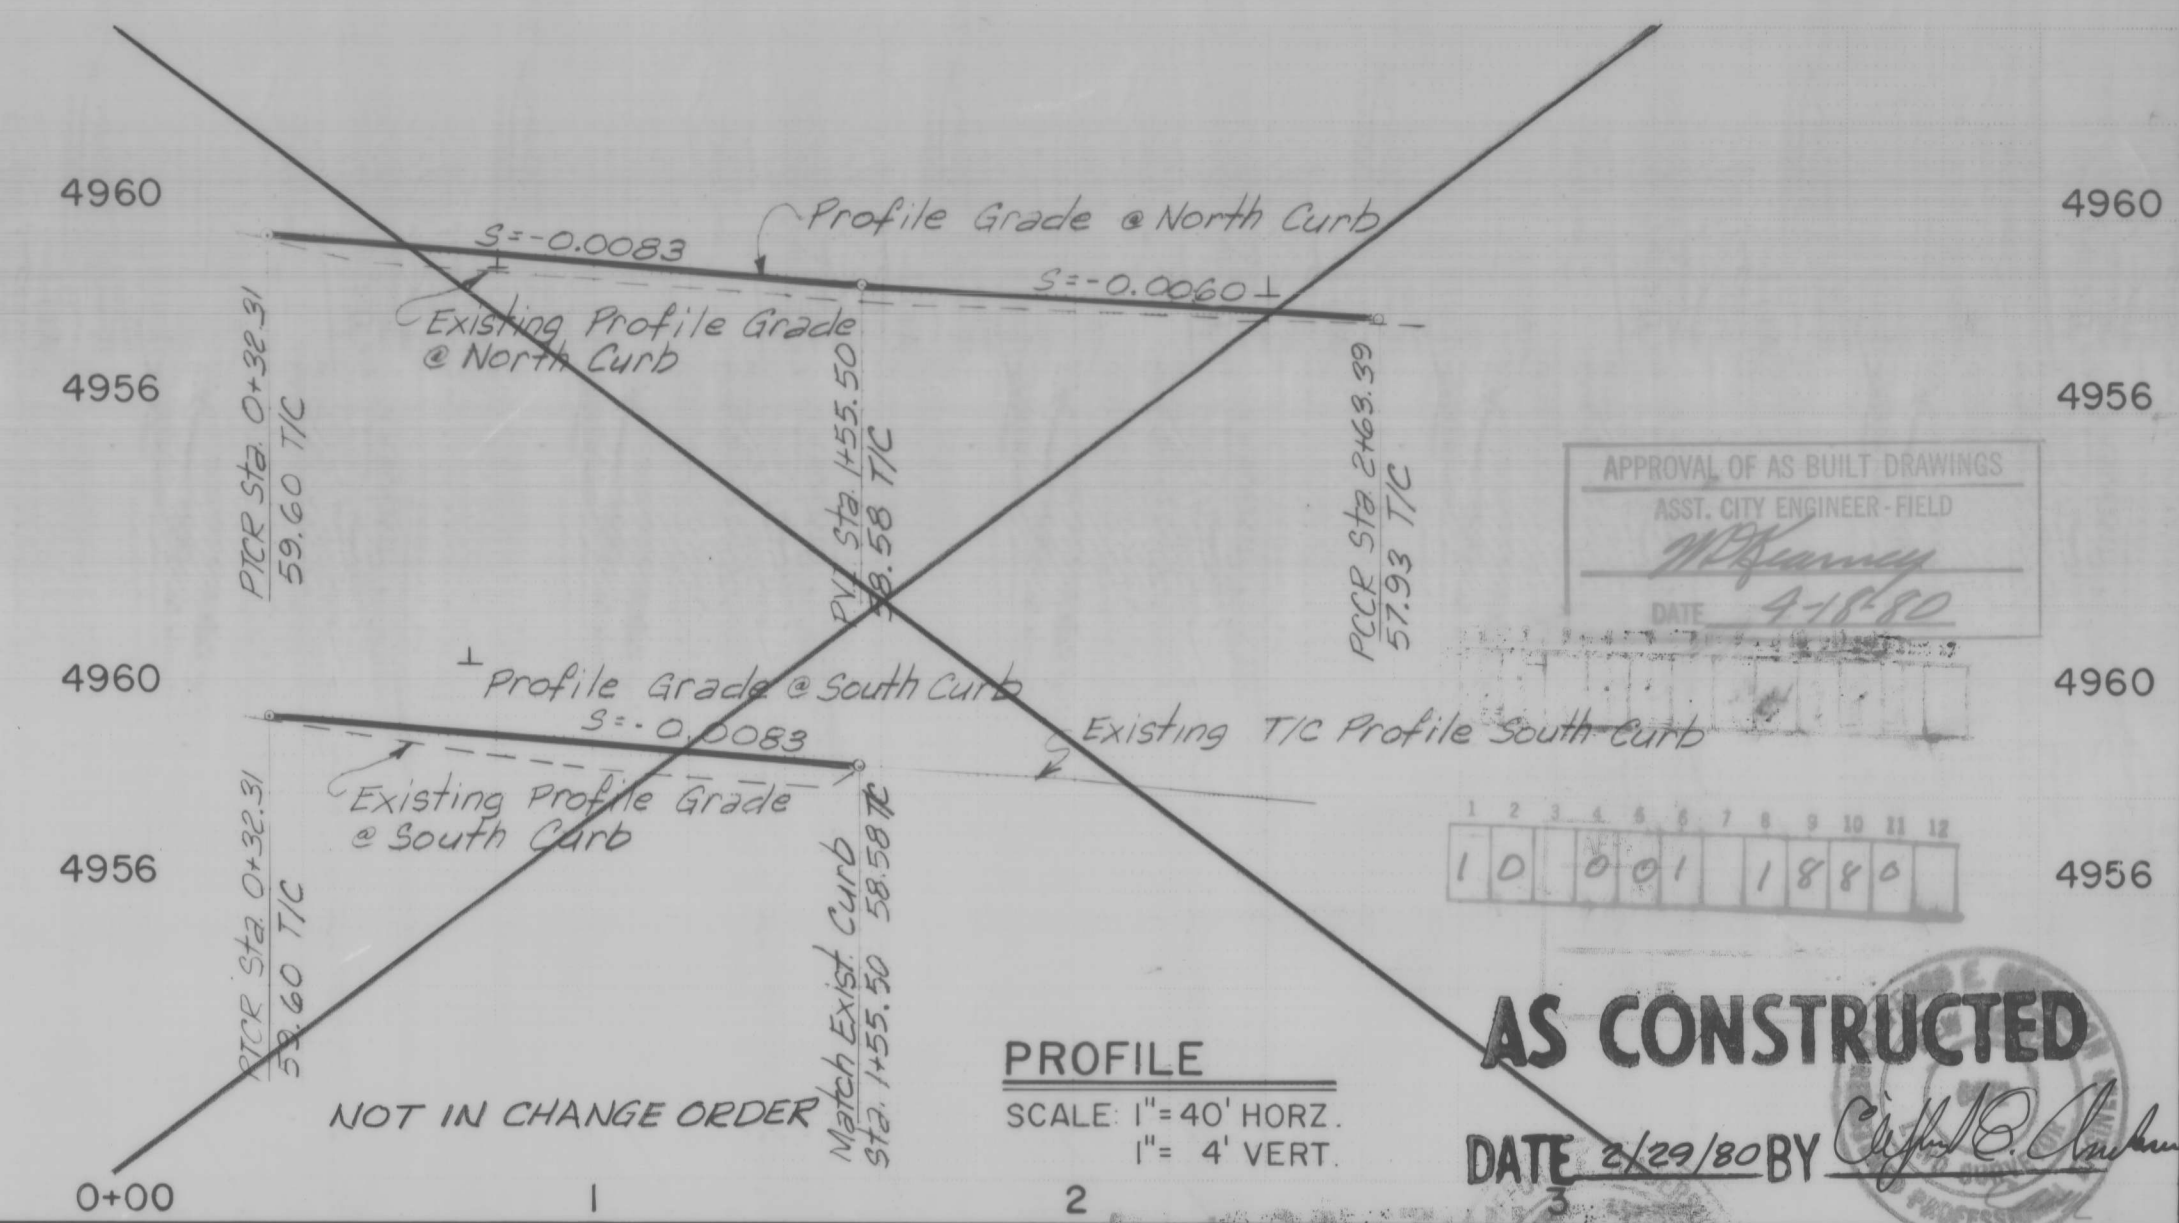

PROFILE
SCALE: 1"=40' HCRZ.
1"= 4' VERT.

APPROVAL OF AS-BUILT DRAWINGS
ASST. CITY ENGINEER - FIELD
DATE 9/18/80

AS CONSTRUCTED
DATE 8/29/80 BY [Signature]

DATE	JOB NO.	SCALE	DRAWN	SHEET
SEPT. 79	77011	AS SHOWN	AO	12
			CHK'D: RL	OF 17

Scanlon & associates, inc.
Engineers-Planners
albuquerque artesia santa fe




COMMUNITY DEVELOPMENT PROGRAM
ALBUQUERQUE CD-3A
albuquerque bernalillo county new mexico

SAWMILL
10th STREET - CHANGE ORDER NO. 3

PLAN	DATE	BY	NO.
CONVISED			
NOTED			
ALIGNMENT CHECKED			
RT. OF WAY CHECKED			


SCANLON AND ASSOCIATES
ENGINEERS PLANNERS

PROFILE	DATE	BY	NO.
CONVISED			
NOTED			
GRADES CHECKED			
STRUCTURE NOTATIONS CHECKED			

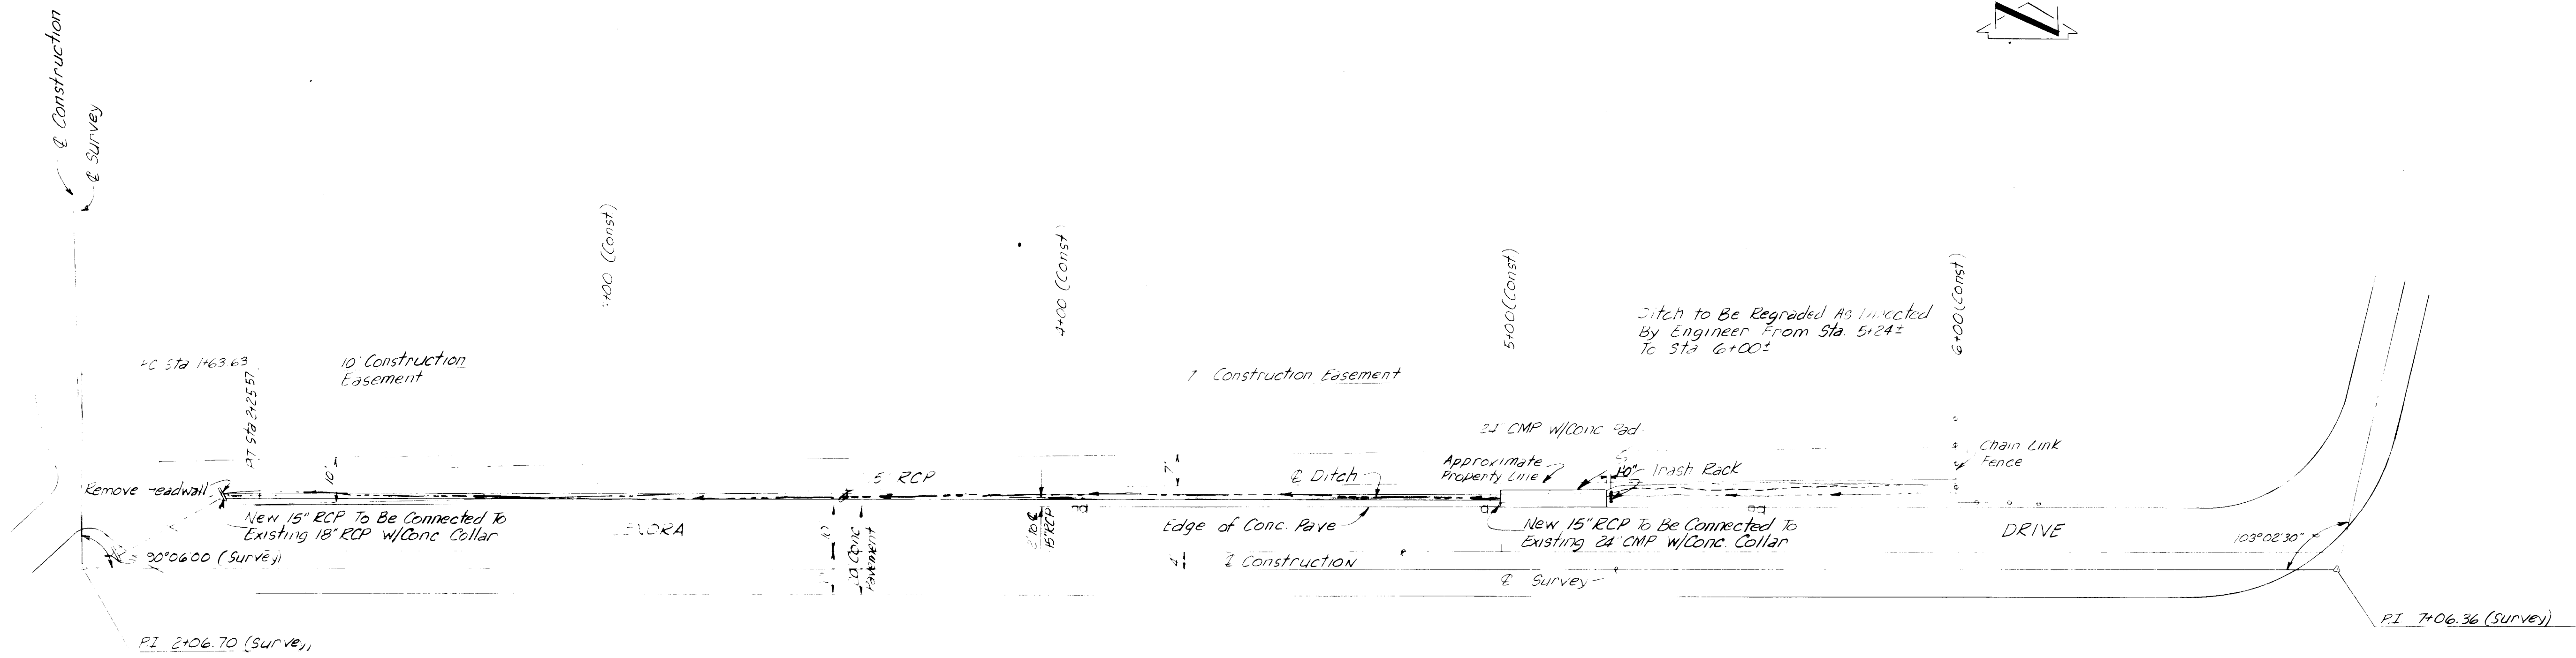

- NOTES
1. Trash Rack To Consist of 4-6 Capped Galvanized Pipes 6" On Center Set In Concrete w/ 2'-0" Bury
 2. All Work To Be Confined Within Construction Easement
 3. New 15" RCP To Have A Minimum of 6" Cover.

PLAN
Scale 1"=20'

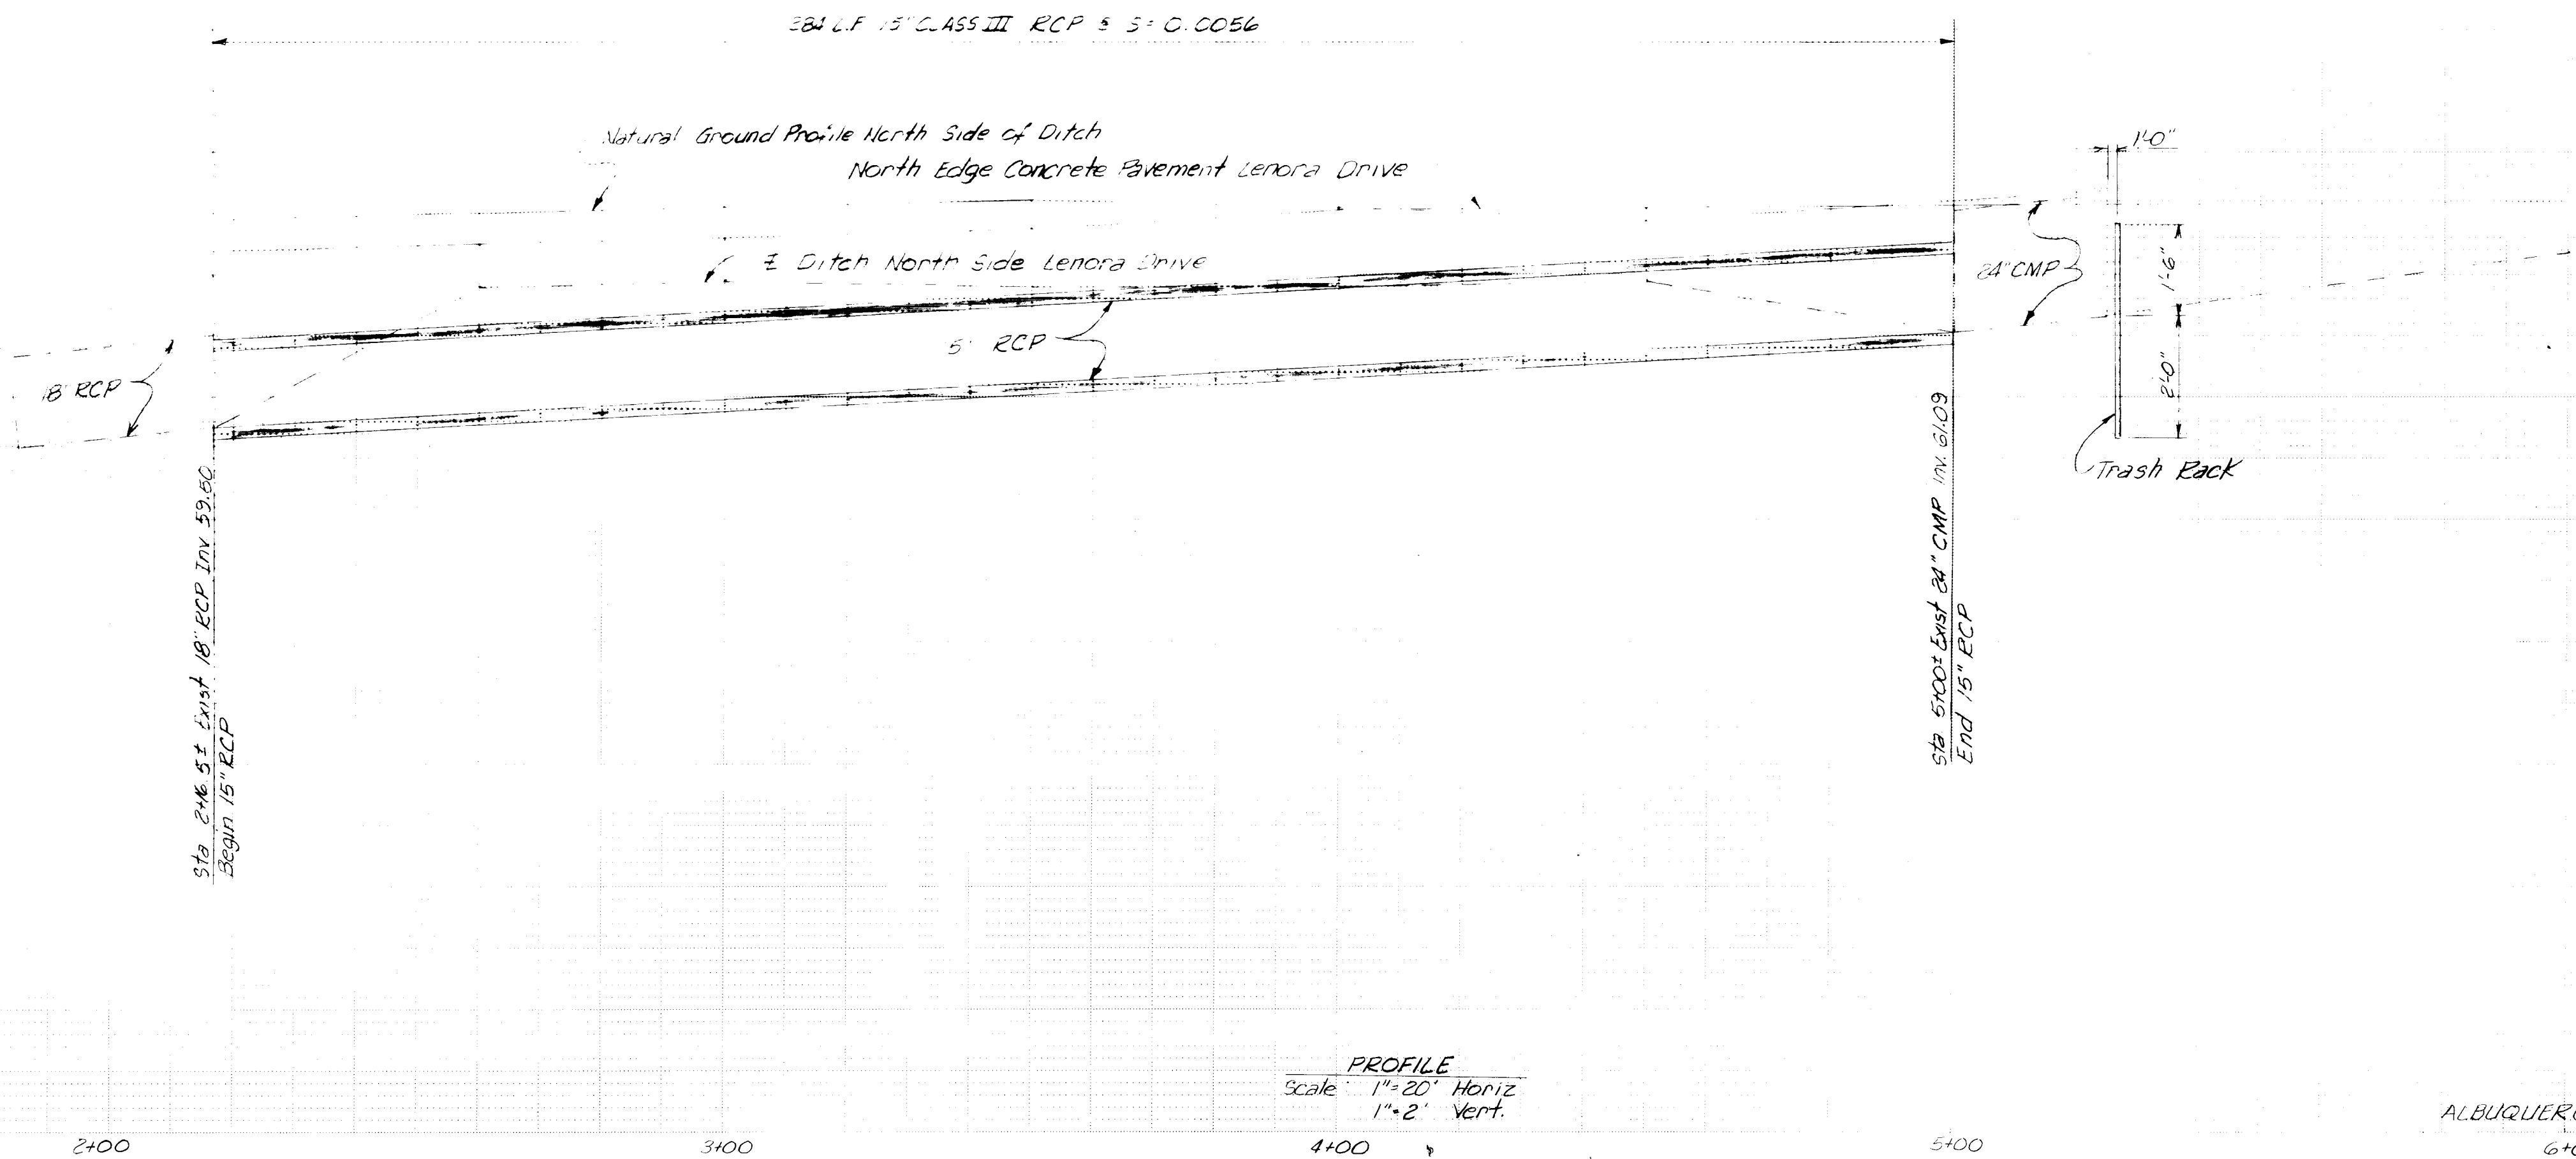

PROFILE
Scale 1"=20' Horiz
1"=2' Vert.

10 001 1980

APPROVAL OF ASST. CITY ENGINEER
DATE 2-18-80



ALBUQUERQUE COMMUNITY DEVELOPMENT PROJECT CD-3A C.O. #4
DATE 2/27/80 SHEET NO. 1