

community development program



albuquerque, new mexico
project number: CD~2

1977-78 street and utility improvements

martineztown / santa barbara

los duranes

san jose / south Broadway

north barelas

SCANNED BY
BY LASON

1 2 3 4 5 6 7 8 9 10 11 12
10 002 01 81

APPROVAL OF AS BUILT DRAWINGS
ASST. CITY ENGINEER - FIELD
<i>[Signature]</i>
DATE 9-22-81


job no. 77005

set no. _____

RECORD DRAWING



scanlon and associates, inc.
engineers - planners
albuquerque santa fe

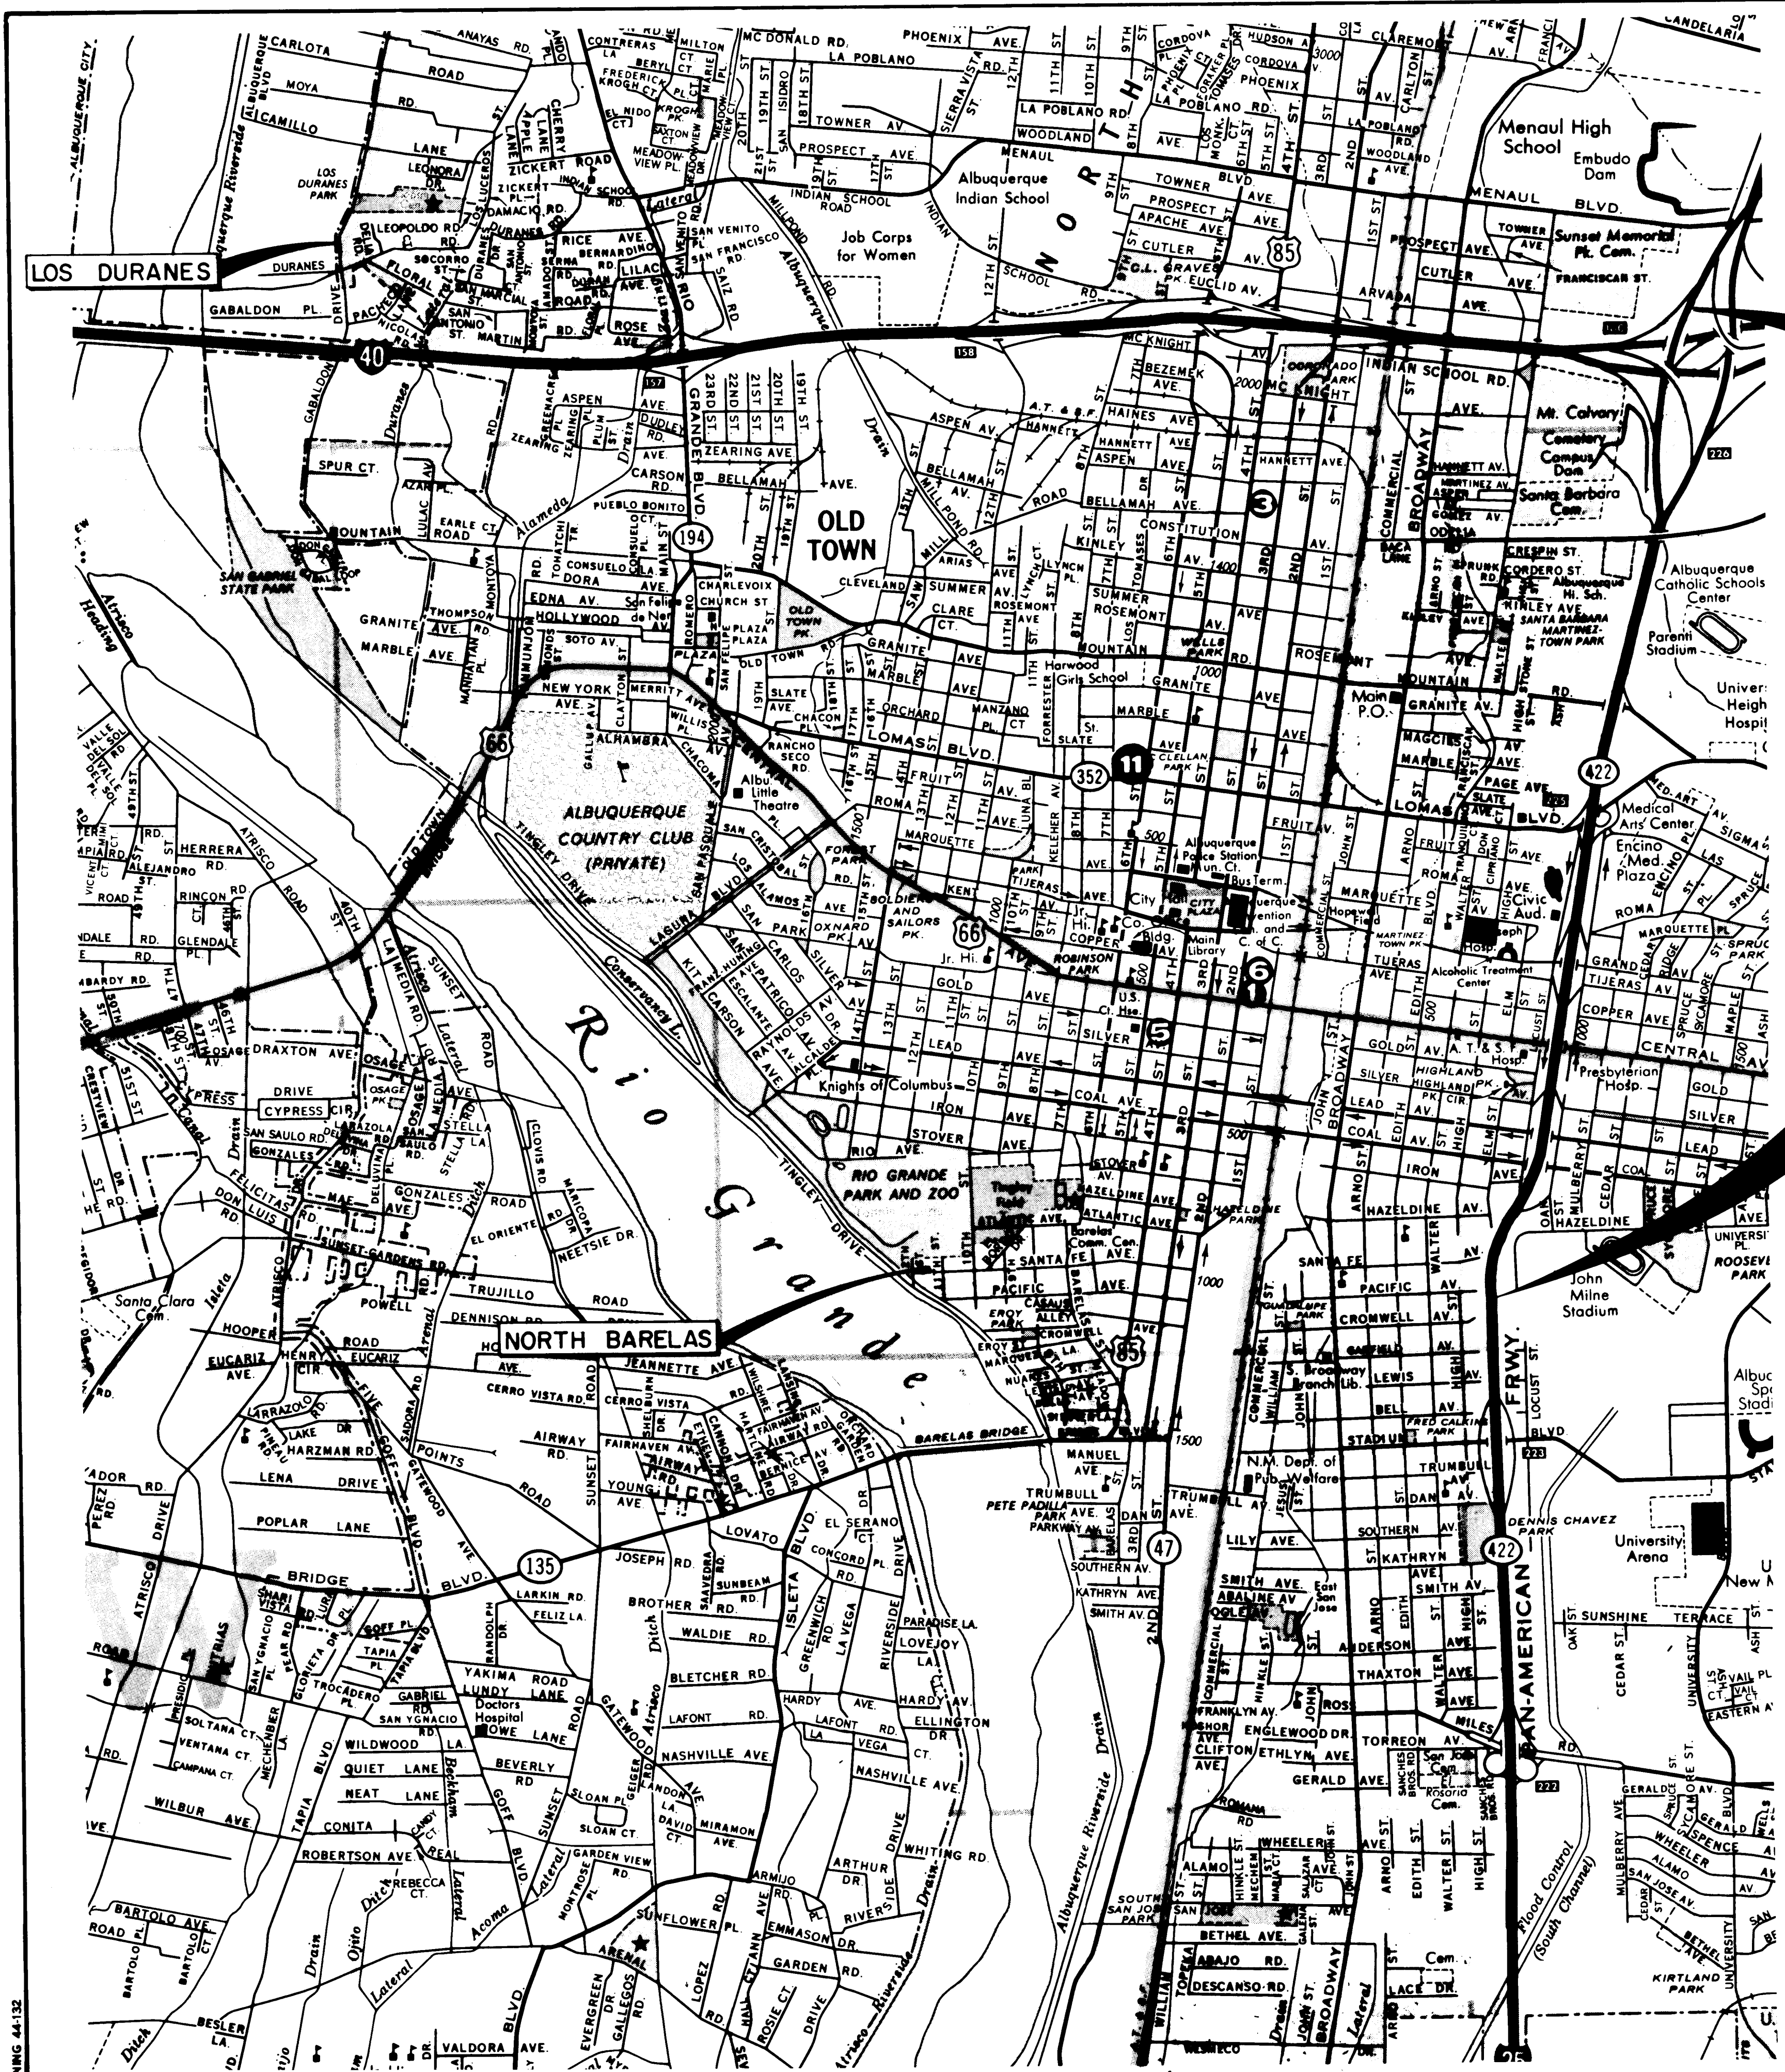


GENERAL INDEX

DESCRIPTION	SHEET NO.
TITLE SHEET	1
LOCATION MAP, LEGEND, GENERAL INDEX	2
SITE MAP - MARTINEZTOWN / SANTA BARBARA, GENERAL NOTES	3
ARNO ST. PAVING	5
ARNO ST. WATER	11
FRANCISCAN ST. PAVING	6
FRANCISCAN ST. WATER	10
GRANITE AVE. PAVING	5
GRANITE AVE. WATER	10, 11
KINLEY AVE. PAVING	6
MARBLE PL. PAVING	7
MARBLE PL. WATER	10
MARBLE PL. DRAINAGE	9
ROSEMONT AVE. PAVING	7
ROSEMONT AVE. WATER	10
STONE ST. PAVING	7
WALTER ST. PAVING	6
WALTER ST. DRAINAGE	9
SITE MAP - SAN JOSE / SOUTH BROADWAY	4
WILLIAM ST. PAVING	8
WHEELER AVE. PAVING	8
ETHLYN AVE. SANITARY SEWER	7
SITE MAP - NORTH BARELAS	4


ALLEY N. OF SANTA FE PAVING	9
STANDARD DETAILS	12
SPECIAL DETAILS	13
QUANTITY SHEET	14

LEGEND

EXISTING SYMBOLS

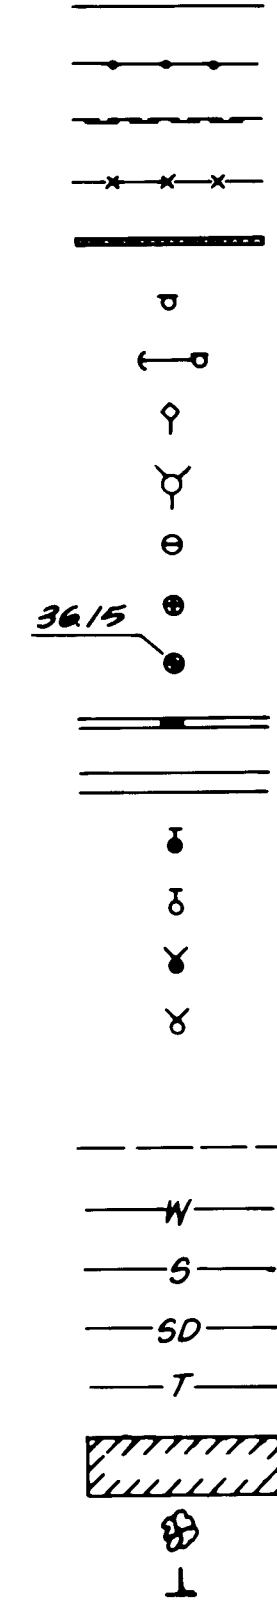

NEW SYMBOLS

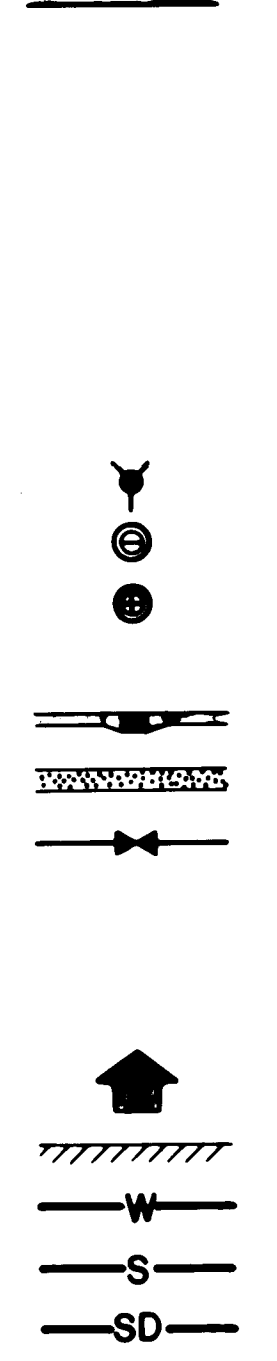


DESCRIPTION


- CURB & GUTTER
- WIRE MESH FENCE
- BOARD FENCE
- WIRE FENCE
- BLOCK OR ROCK WALL
- UTILITY POLE
- GUY WIRE
- SIGN
- FIRE HYDRANT
- SANITARY SEWER MANHOLE
- STORM DRAIN MANHOLE
- SPOT ELEVATION
- DROP INLET
- SIDEWALK
- WATER VALVE
- GAS VALVE
- WATER METER
- GAS METER
- WHEEL CHAIR RAMP
- PAVING LIMITS
- WATER LINE
- SANITARY SEWER LINE
- STORM DRAIN LINE
- TELEPHONE LINE
- BUILDING
- TREE
- FINISHED FLOOR ELEVATION

APPROVAL OF AS-BUILT DRAWINGS
ASST. CITY ENGINEER - FIELD
DATE 7-29-91

RECORD DRAWING

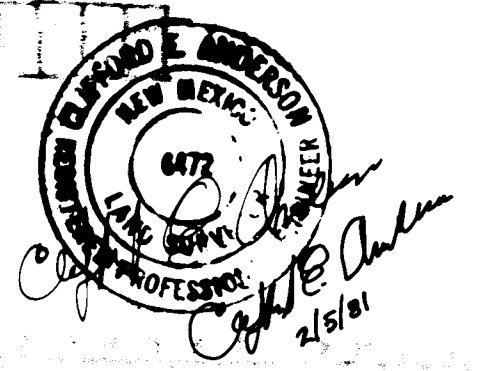

ALBUQUERQUE CD - 2			
LOCATION MAP, LEGEND & GENERAL INDEX			
CITY OF ALBUQUERQUE			
albuquerque	bernalillo	county	new mexico
DATE	JOB NO.	SCALE	DRAWN: V.M. SHEET 2
JUNE - 77	77005	AS SHOWN	CHK'D: R.B. OF 14
Scanlon & associates, inc. albuquerque Engineers-Planners santa fe			

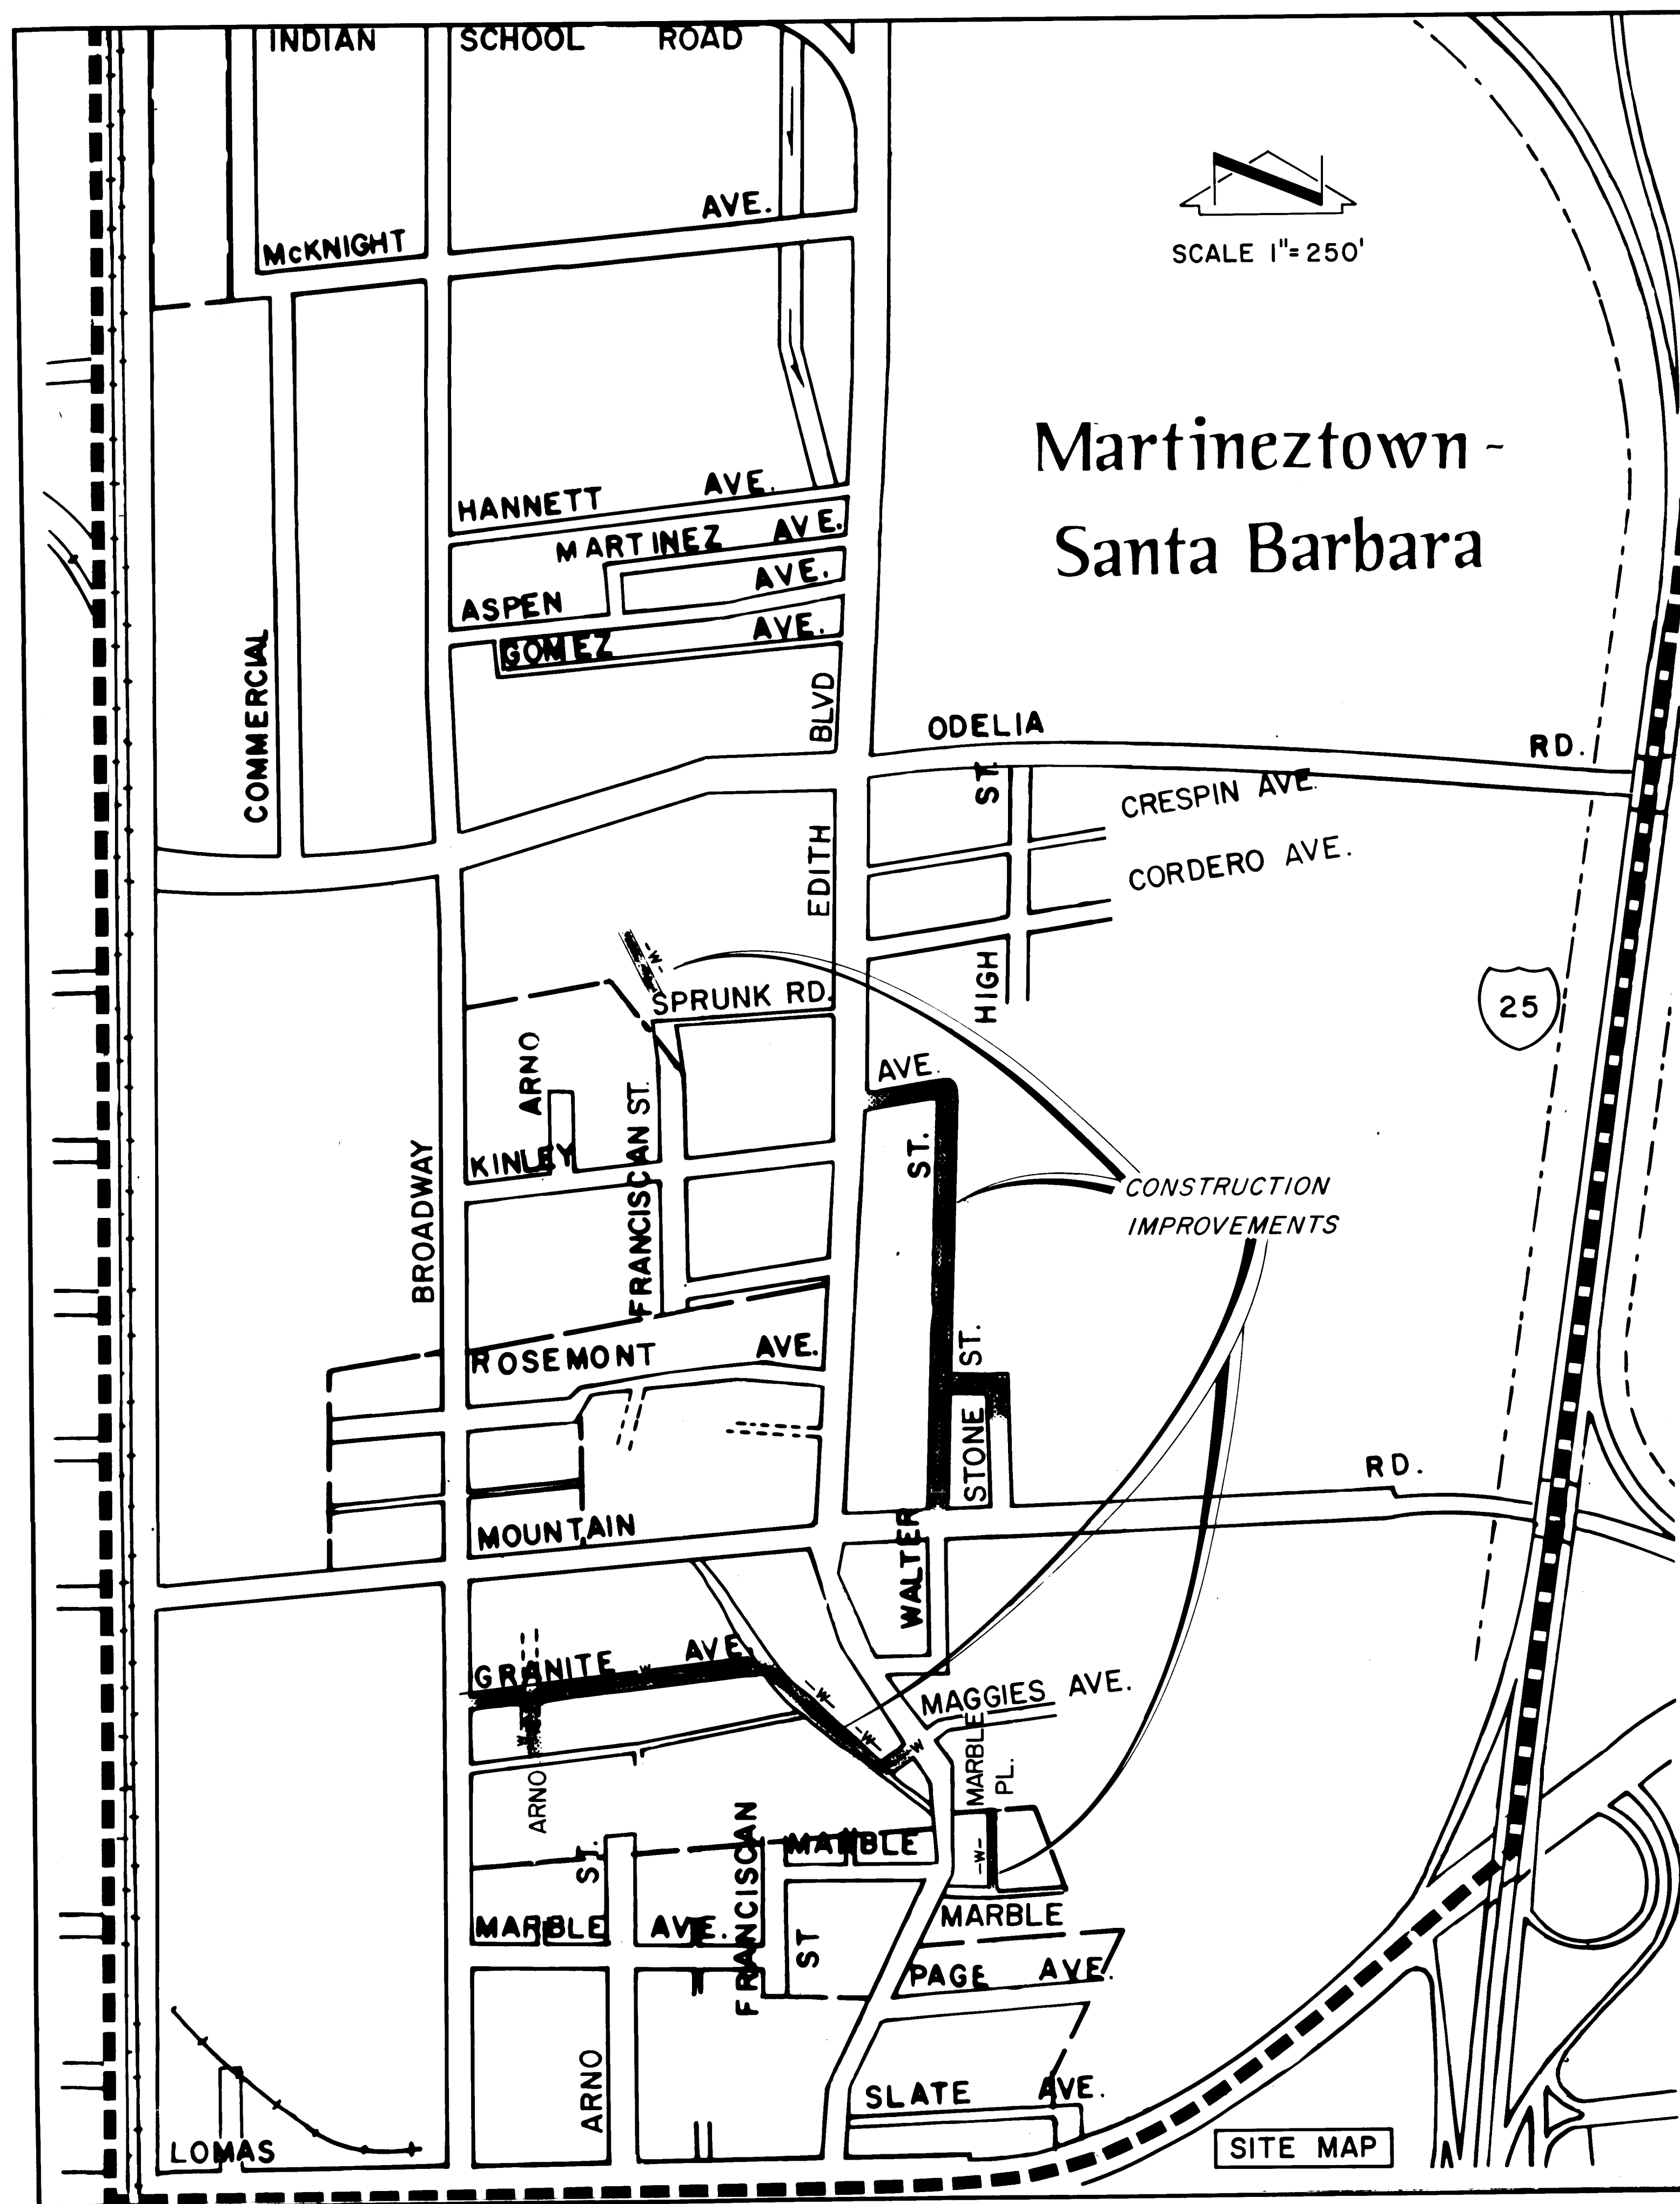

GENERAL NOTES

- UTILITY POLES IN CONFLICT WITH THE CONSTRUCTION OF THIS PROJECT ARE TO BE RELOCATED BY OTHERS. THE CONTRACTOR SHALL COORDINATE ANY WORK REQUIRED BY OTHERS IN THE CONSTRUCTION AREA.
- THE CONTRACTOR SHALL NOTIFY ALL UTILITY COMPANIES WHEN WORKING NEAR THEIR SYSTEMS. CALL 765-1234 REGARDING LOCATION OF UNDERGROUND UTILITY LINES.
- ALL EXISTING UTILITIES SHOWN HERE WERE TAKEN AS ACCURATELY AS POSSIBLE FROM RECORD DRAWINGS AND SURFACE INDICATIONS. IT SHALL BE THE CONTRACTOR'S RESPONSIBILITY TO PROTECT, MAINTAIN IN SERVICE, AND VERIFY EXACT LOCATIONS OF ALL AFFECTED UTILITIES DURING CONSTRUCTION OF THIS PROJECT.
- ALL UTILITIES WHICH ARE TO BE ABANDONED UNDER THIS CONTRACT SHALL BE PLUGGED WITH CONCRETE AT EACH END OF THE PORTION TO BE ABANDONED. PAYMENT FOR THIS WORK WILL BE INCIDENTAL TO THE WORK ON THE ADJACENT LINES.
- CONNECTION OF NEW SEWER LINES TO EXISTING MANHOLES AND PLUGGING OF EXISTING LINES IN MANHOLES SHALL BE INCIDENTAL TO OTHER ITEMS OF WORK.
- NEW WATER MAINS SHALL HAVE A MINIMUM COVER OF 36".
- REMOVE ALL VALVE BOXES FROM ABANDONED WATER LINES. PAYMENT WILL BE INCIDENTAL TO THE PAVING COST.
- ALL ABANDONED VALVE AND METER BOX FRAMES AND COVERS SHALL BE RETURNED TO THE CITY WATER DIVISION WAREHOUSE AND ALL STORM AND SANITARY MANHOLE LIDS AND INLET GRATES, CASTINGS, AND FRAMES NOT REUSED, SHALL BE RETURNED TO THE LIQUID WASTE DIVISION WAREHOUSE.
- THE CONTRACTOR SHALL BE RESPONSIBLE FOR LOCATING DROP INLETS TO CLEAR DRIVE PADS.
- FIRE HYDRANTS WHICH ARE TO BE REMOVED AND ARE NOT TO BE RELOCATED SHALL BE RETURNED TO THE CITY WATER DIVISION WAREHOUSE.
- THE CONTRACTOR SHALL EXPOSE EXISTING WATER LINES AT LOCATIONS WHERE NEW SANITARY SEWER LINES CROSS OR PARALLEL SUCH LINES IN ORDER TO ADEQUATELY ESTABLISH THE PROXIMITY OF WATER AND SEWER LINES. THE COST OF THIS WORK SHALL BE INCIDENTAL TO OTHER ITEMS OF WORK.
- TEMPORARY RELOCATION OF EXISTING UTILITIES FOR THE CONVENIENCE OF THE CONTRACTOR WILL BE AT HIS OWN EXPENSE.
- ALL PRIVATE UTILITY MANHOLES AND VALVE BOXES IN CONSTRUCTION AREA TO BE ADJUSTED TO GRADE BY THE CONTRACTOR. PAYMENT TO BE MADE UNDER APPROPRIATE BID ITEM. THE GRADE ADJUSTMENT REQUIRED FOR ANY NEW OR RELOCATED ITEMS SHALL BE SUBSIDIARY TO THE COST OF THE NEW ITEMS OR THE COST OF RELOCATION.
- DURING THE CONSTRUCTION PERIOD THE UTMOST CARE SHALL BE TAKEN TO SEE THAT THE INSIDE OF PIPES, FITTINGS AND VALVES ARE FREE FROM ALL FOREIGN MATTER SUCH AS DIRT, ROCKS, STICKS, ETC., AND SHALL BE KEPT CLEAN IN ACCORDANCE WITH THE SPECIFICATIONS.
- POLICY ON PROXIMITY OF WATER AND SEWER LINES: WHENEVER POSSIBLE, IT IS DESIRABLE TO LAY PARALLEL WATER AND SEWER LINES AT LEAST TEN FEET (10') APART HORIZONTALLY, AND THE WATER LINE SHOULD BE AT A HIGHER ELEVATION THAN THE SEWER. IF THIS IS NOT POSSIBLE SEPARATE TRENCHES WILL BE REQUIRED IN ALL CASES (THIS SHALL BE EFFECTIVE EVEN THOUGH ONE LINE HAS BEEN INSTALLED PRIOR TO THE OTHERS). AND THE WATER LINE SHALL BE AT LEAST TWO FEET (2') ABOVE THE SEWER. WHEREVER WATER AND SEWER LINES CROSS EACH OTHER, THE WATER LINE SHALL BE AT LEAST THREE FEET (3') ABOVE THE SEWER; OTHERWISE, THE SEWER SHALL BE OF STEEL OR CAST IRON PIPE, OR EQUIVALENT, FOR TEN FEET (10') ON EACH SIDE OF THE WATER LINE.
- NEW MANHOLES WHICH ARE TO BE INSTALLED WITHIN EXISTING WATER TABLE TO BE COATED ON EXTERIOR TO 2' ABOVE THE WATER TABLE WITH KOPPERS BITUMASTIC SUPER SERVICE BLACK COATING. TWO COATS TO BE APPLIED AT A RATE OF 70 SQUARE FEET PER GALLON PER COAT.
- PROFILE GRADES ARE AS INDICATED ON TYPICAL CURB & GUTTER DETAILS, SHEET 12 OF 14.
- CURB RETURN RADIUS AND STREET WIDTHS ARE TO THE FACE OF THE CURB UNLESS OTHERWISE INDICATED ON THE PLANS.
- CURB & GUTTER SHOWN AS EXISTING AND NOT TO BE REMOVED UNDER THIS CONTRACT WHICH IS DAMAGED OR DISPLACED BY THE CONTRACTOR OR HIS SUBCONTRACTORS, SHALL BE REPLACED BY THE CONTRACTOR AT HIS EXPENSE.
- WHEN ABUTTING NEW PAVEMENT TO EXISTING, JUST PRIOR TO REPAVING CUT BACK EXISTING PAVING ON STRAIGHT LINE AS REQUIRED TO REMOVE ANY BROKEN, RAVELED OR CRACKED PAVING AND MATCH THE NEW PAVING GRADE TO THE EXISTING.
- WHERE REMOVAL OF EXISTING CURB & GUTTER OR SIDEWALK IS REQUIRED, REMOVE TO THE NEAREST JOINT OR SAW CUT.
- EXISTING MATERIALS TO BE REMOVED AND PAID FOR ON A UNIT BASIS SHALL BE MEASURED AND THE QUANTITIES APPROVED BY THE ENGINEER BEFORE REMOVAL.
- THE MAXIMUM ALLOWABLE QUANTITIES FOR PAYMENT FOR REPLACEMENT OF PAVEMENT WHERE WATER, SANITARY SEWER, AND STORM SEWER ARE TO BE INSTALLED UNDER EXISTING PAVEMENT WILL BE COMPUTED IN ACCORDANCE WITH THE SPECIFICATIONS.
- WHEEL CHAIR RAMPS TO BE CONSTRUCTED AT OR NEAR CURB RETURNS AS SHOWN IN THE PLANS. ALL WORK SHALL BE IN ACCORDANCE WITH THE SPECIFICATIONS. THE EXACT LOCATION OF EACH RAMP SHALL BE DETERMINED IN THE FIELD.
- WHEN CONSTRUCTION OF A NEW WHEEL CHAIR RAMP IS CALLED FOR AT A LOCATION WHERE CURB & GUTTER EXIST, THE CONTRACTOR SHALL REMOVE AND REPLACE EXISTING IMPROVEMENTS AS REQUIRED TO CONSTRUCT RAMP. PAYMENT FOR THIS WORK WILL BE MADE UNDER APPROPRIATE BID ITEMS.

SHEET LEGEND

- NEW PAVEMENT
- W NEW WATER
- S NEW SANITARY SEWER

RECORD DRAWING

SCANNED BY
BY LASON




ALBUQUERQUE CD - 2

MARTINEZTOWN / SANTA BARBARA
SITE MAP

CITY OF ALBUQUERQUE

albuquerque	bernalillo	county	new mexico
DATE	JUNE 77	JOB NO.	77005
SCALE	AS SHOWN	DRAWN	V. M.
CHK'D	R. B.	SHEET	3
		OF	14

Scanlon & associates, inc.
albuquerque engineers-planners santa fe

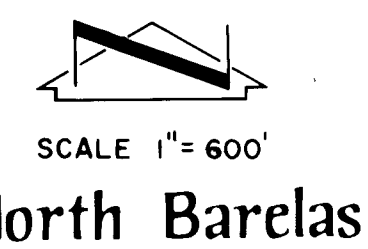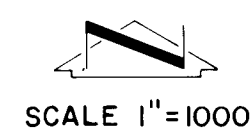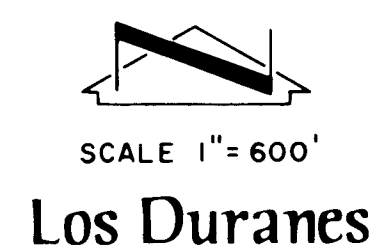

		3		5			8	9	10		12
1	0		0	0	2		0	4	8	1	





APPROVAL OF AS BUILT DRAWINGS
ASST. CITY ENGINEER - FIELD
M. Kearney
DATE 3-29-81

ALBUQUERQUE CD - 2			
SAN JOSE / SOUTH BROADWAY LOS DURANES - NORTH BARELAS SITE MAP			
CITY OF ALBUQUERQUE			
albuquerque	bernalillo	county	new mexico
DATE JUNE 77	JOB NO. 77005	SCALE AS SHOWN	DRAWN: V. M. CHK'D: R. B.
		SHEET OF	4 14



RECORD DRAWING

SCANNED BY
BY IASON



PROFILE	SURVEYED		BY		DATE	
	PLOTTED					
NOTE BOOK	GRADES CHECKED					
NO.	B. M.'S NOTED					
	STRUCTURE NOTAT'NS CH'KD					

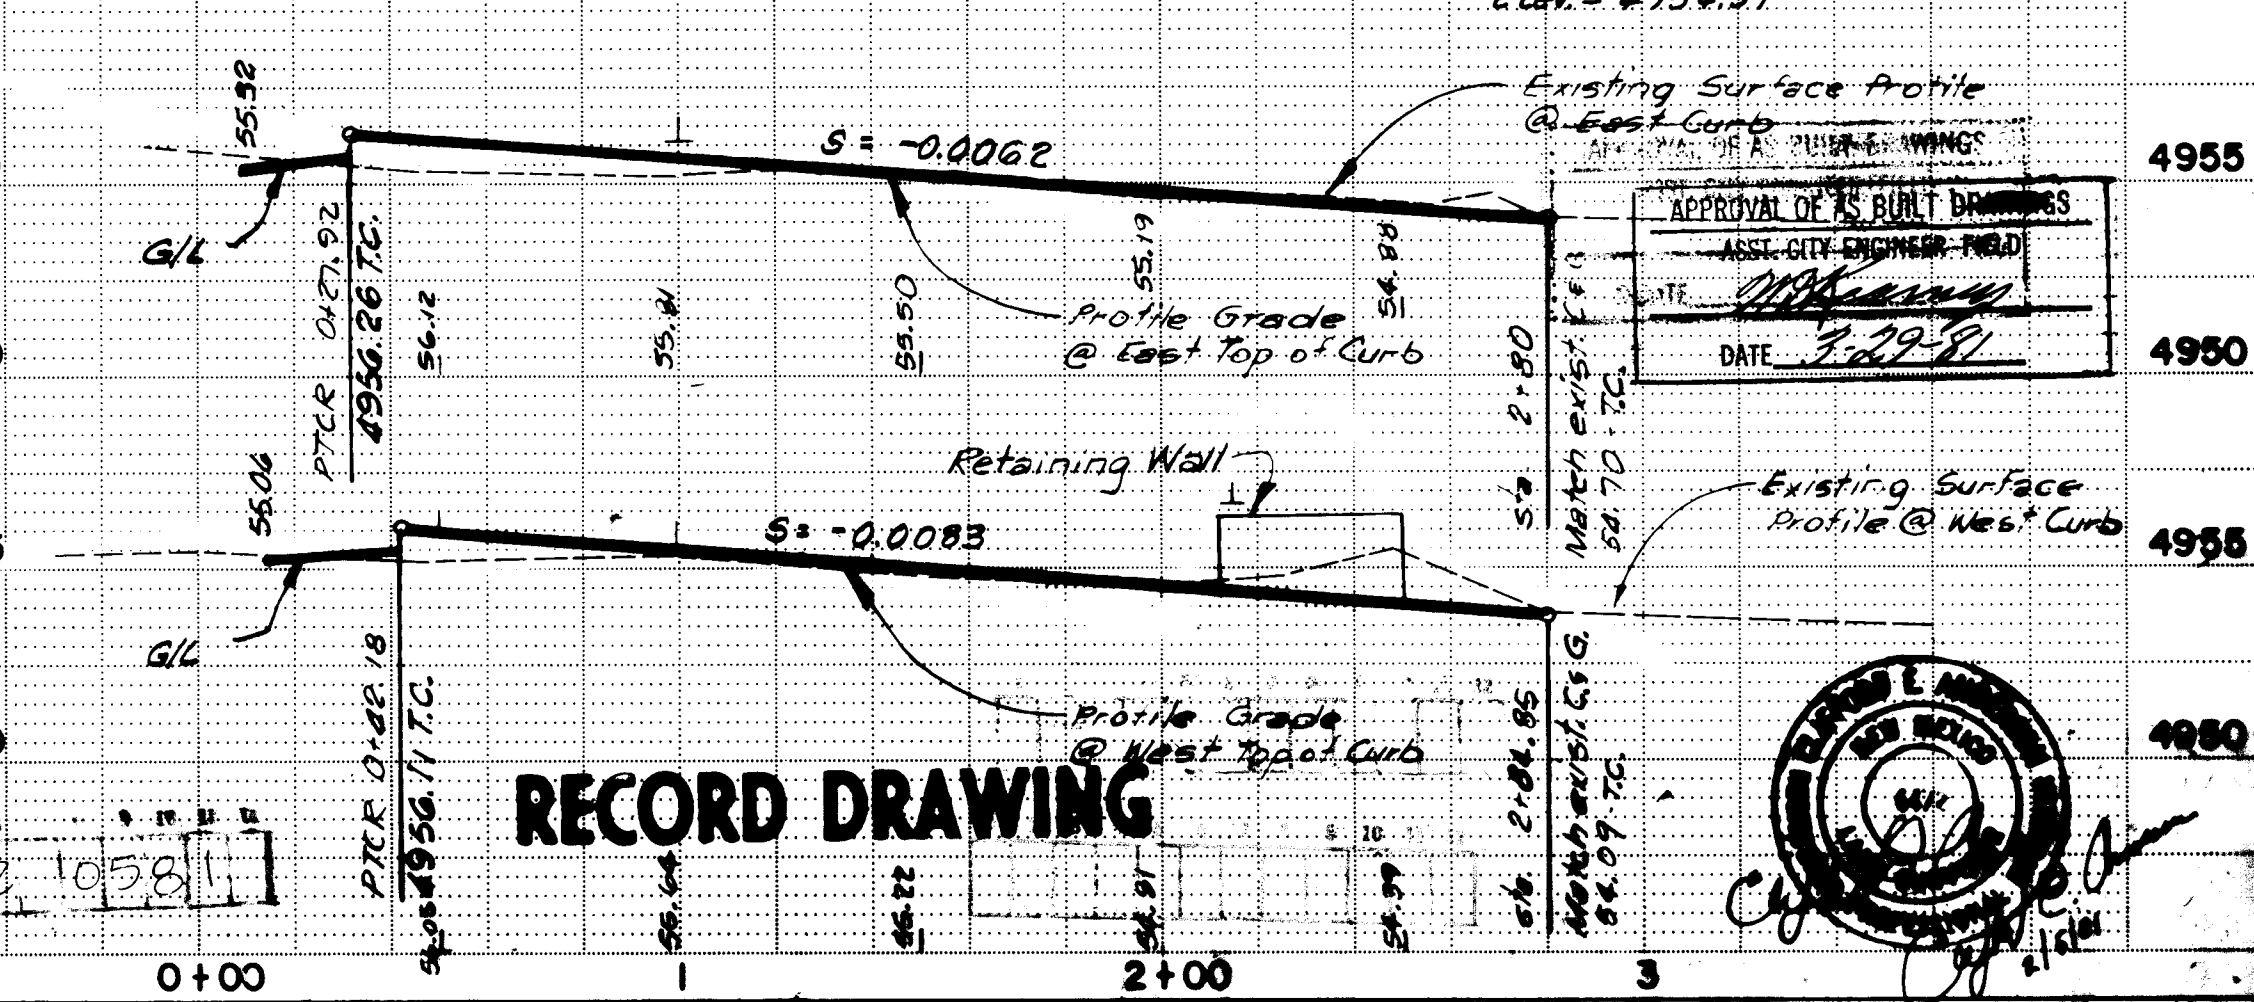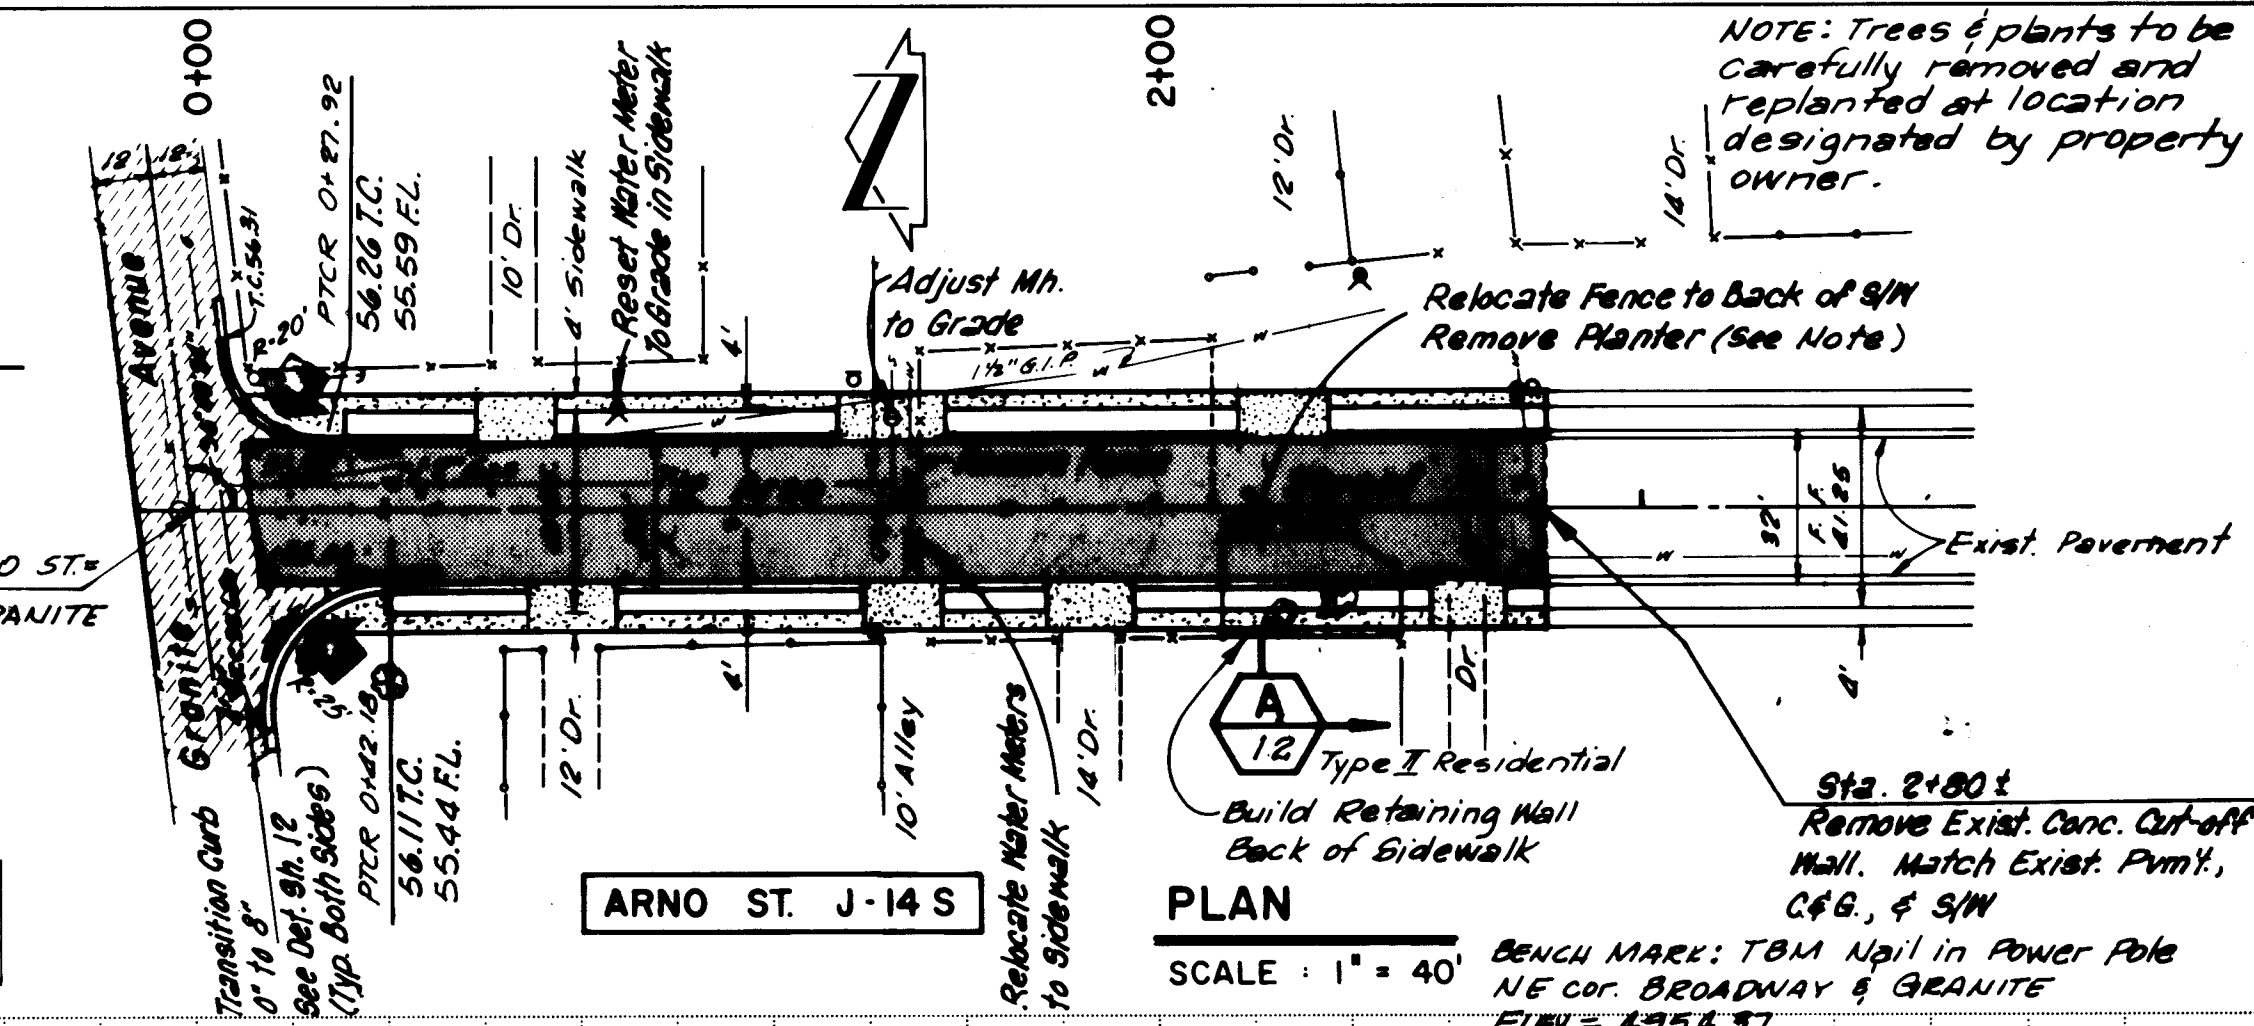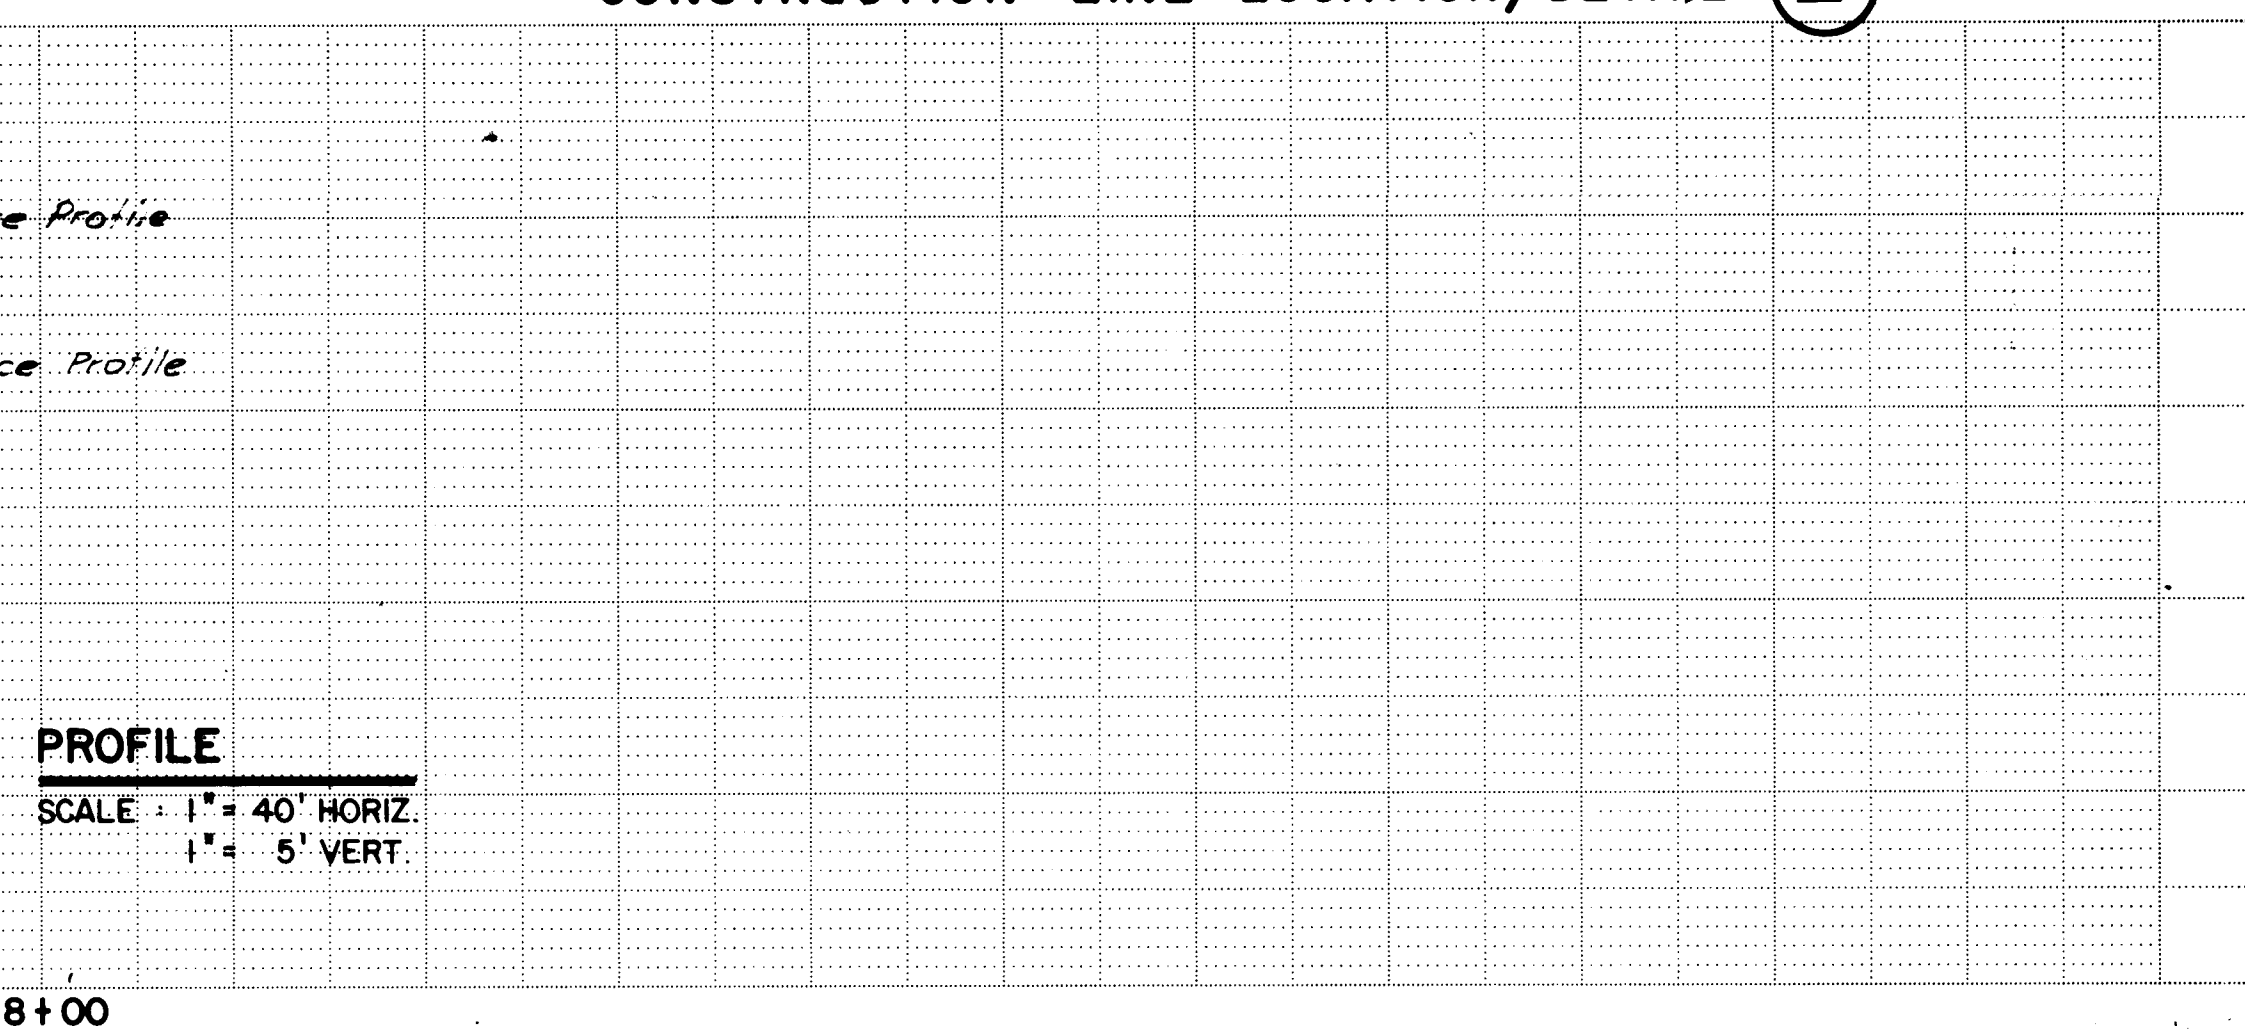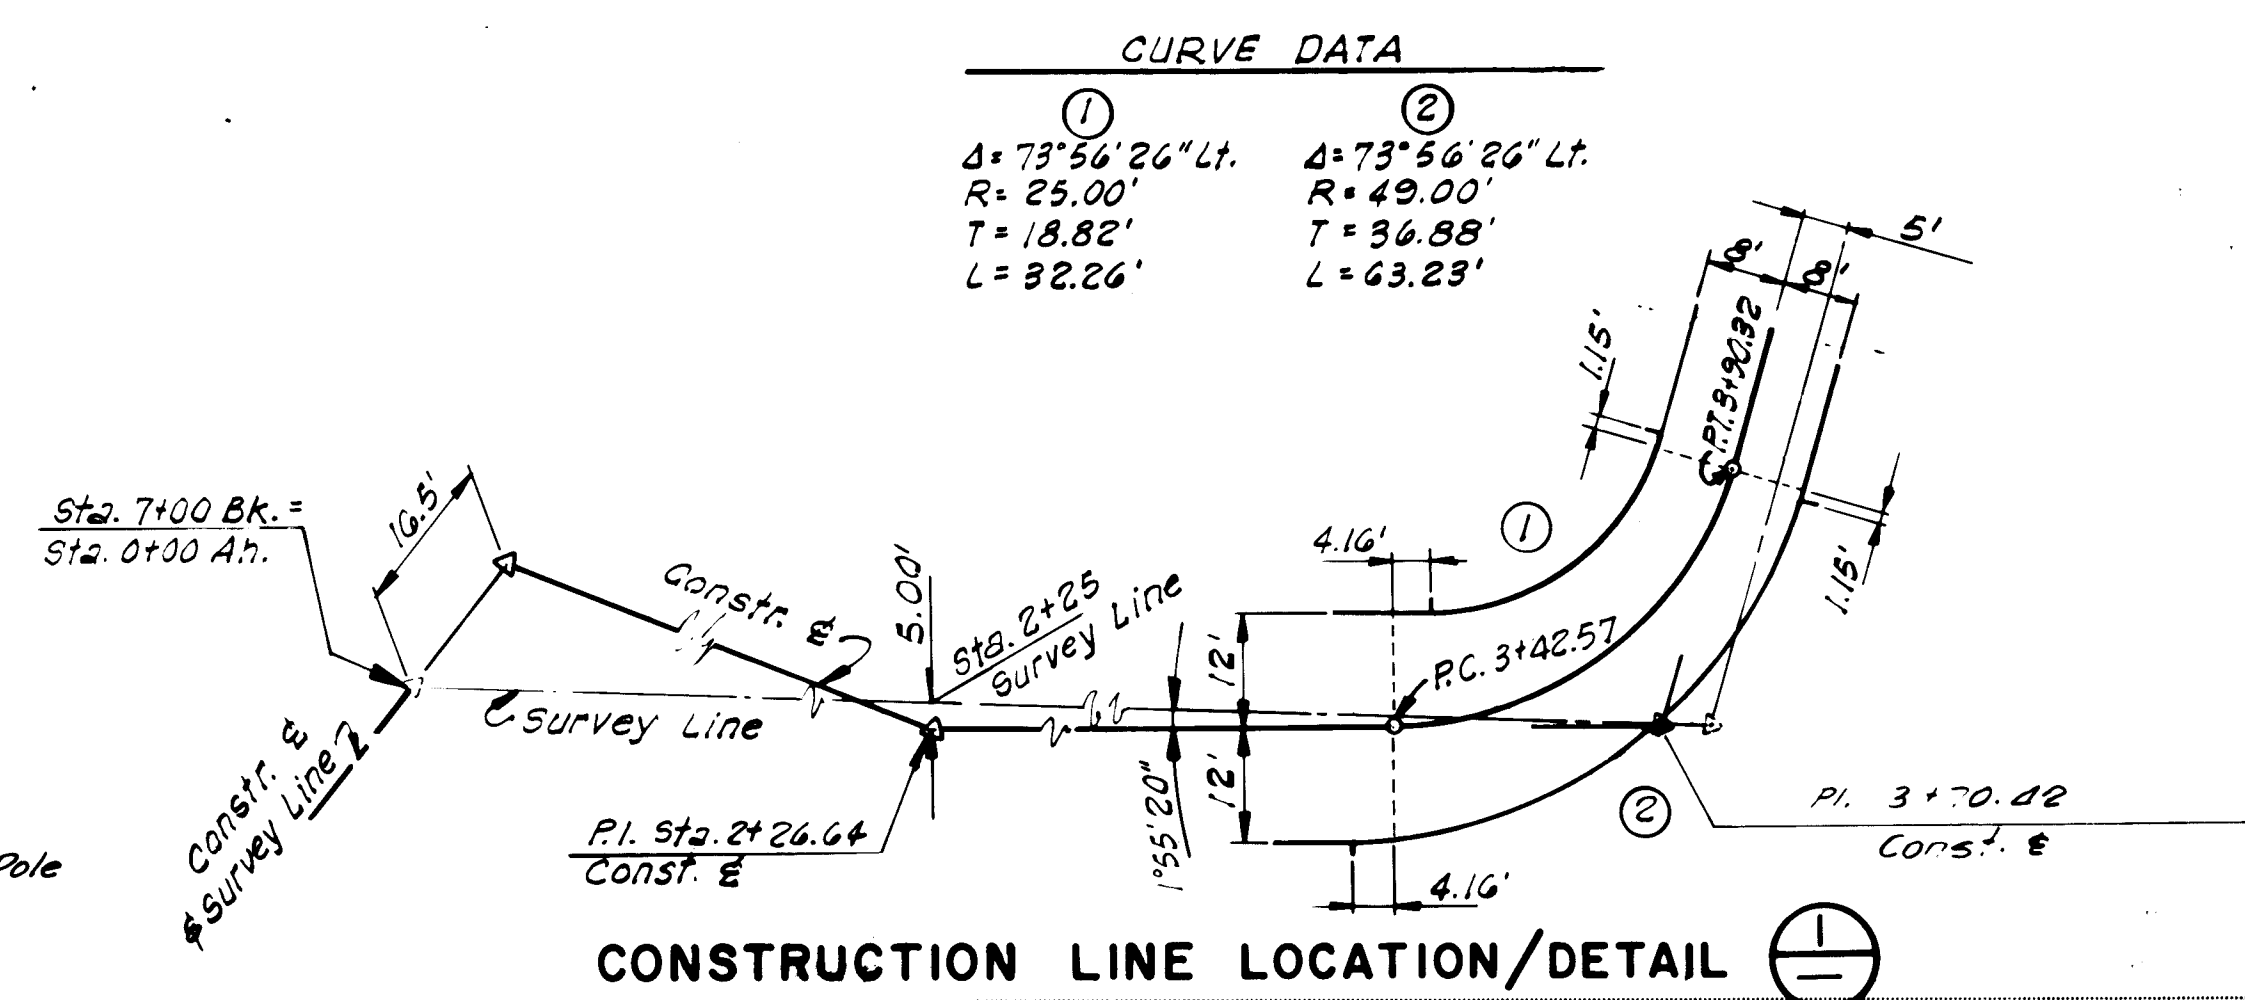

DATE	
BY	
PLAN	
NOTES	
NO.	

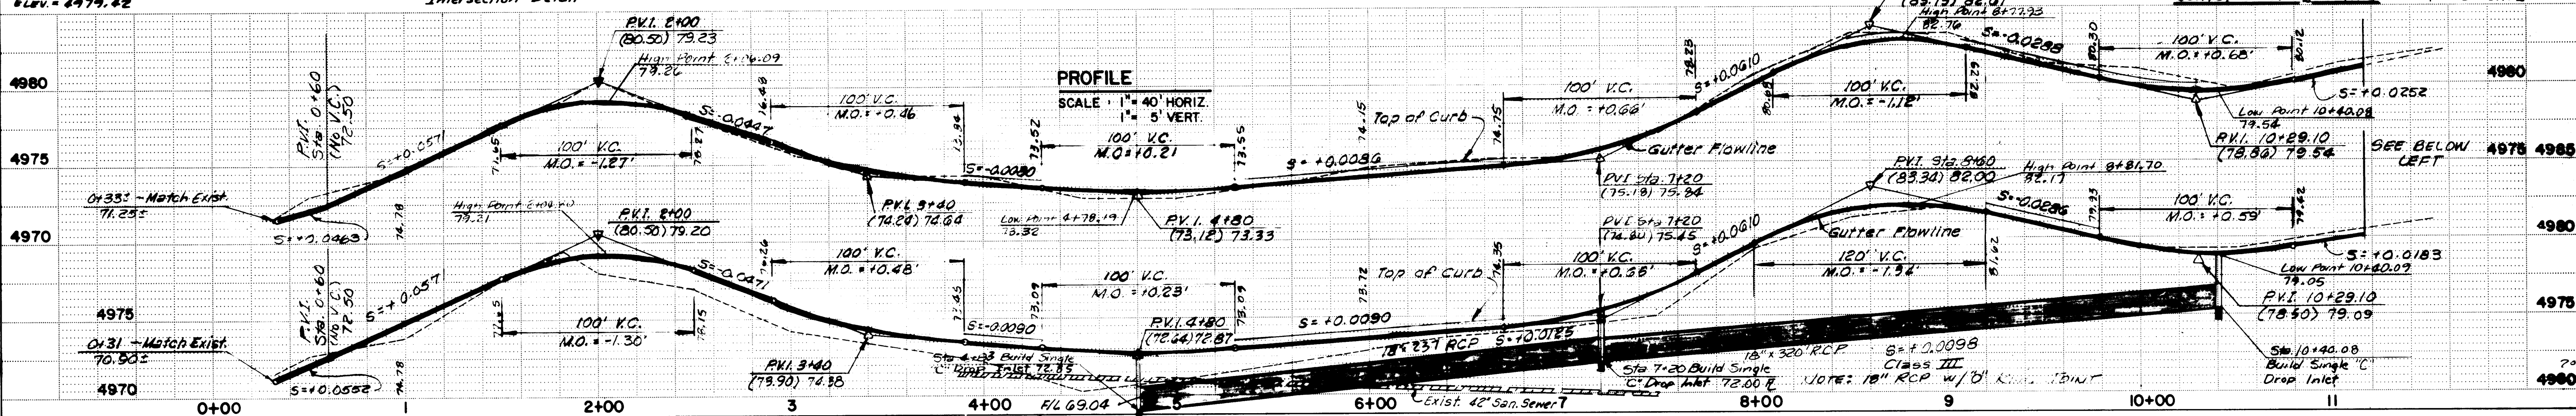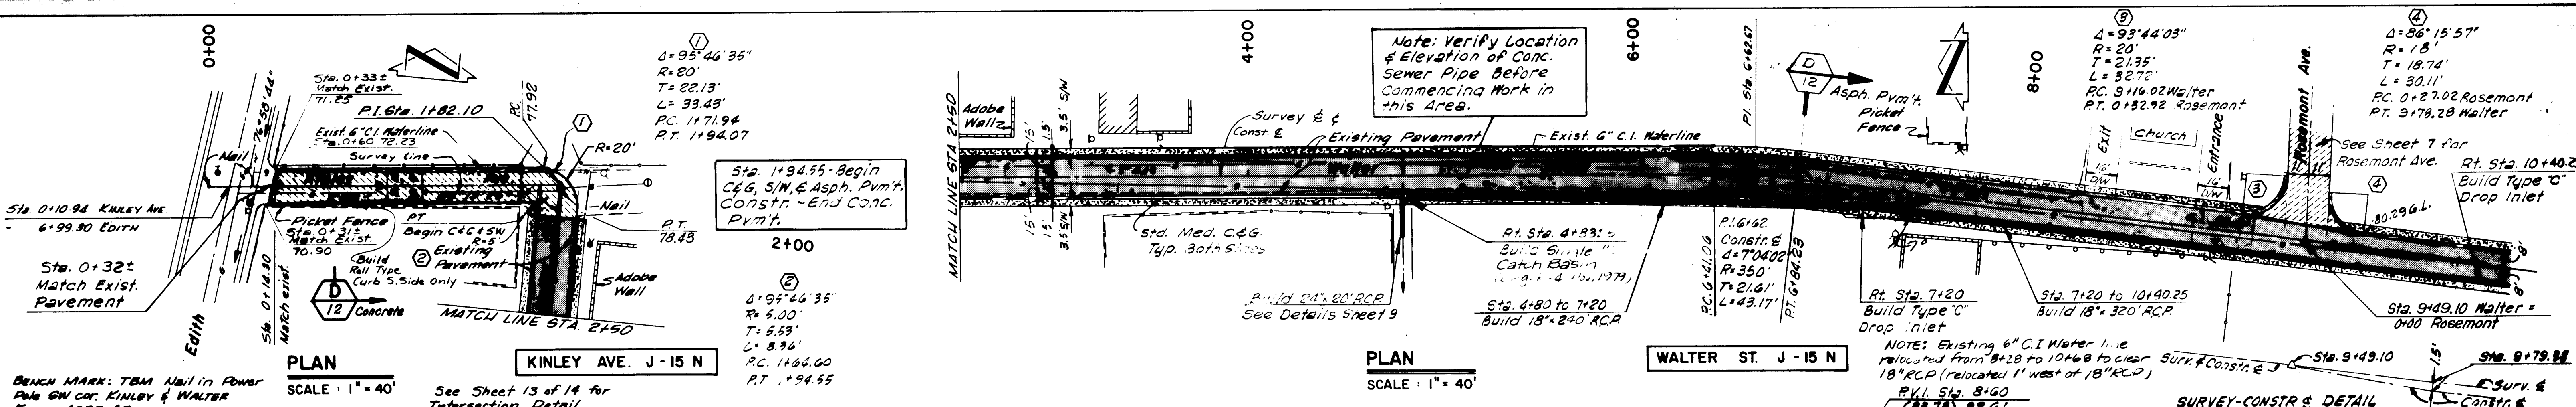

DATE	
BY	
PLAN	
NOTES	
NO.	

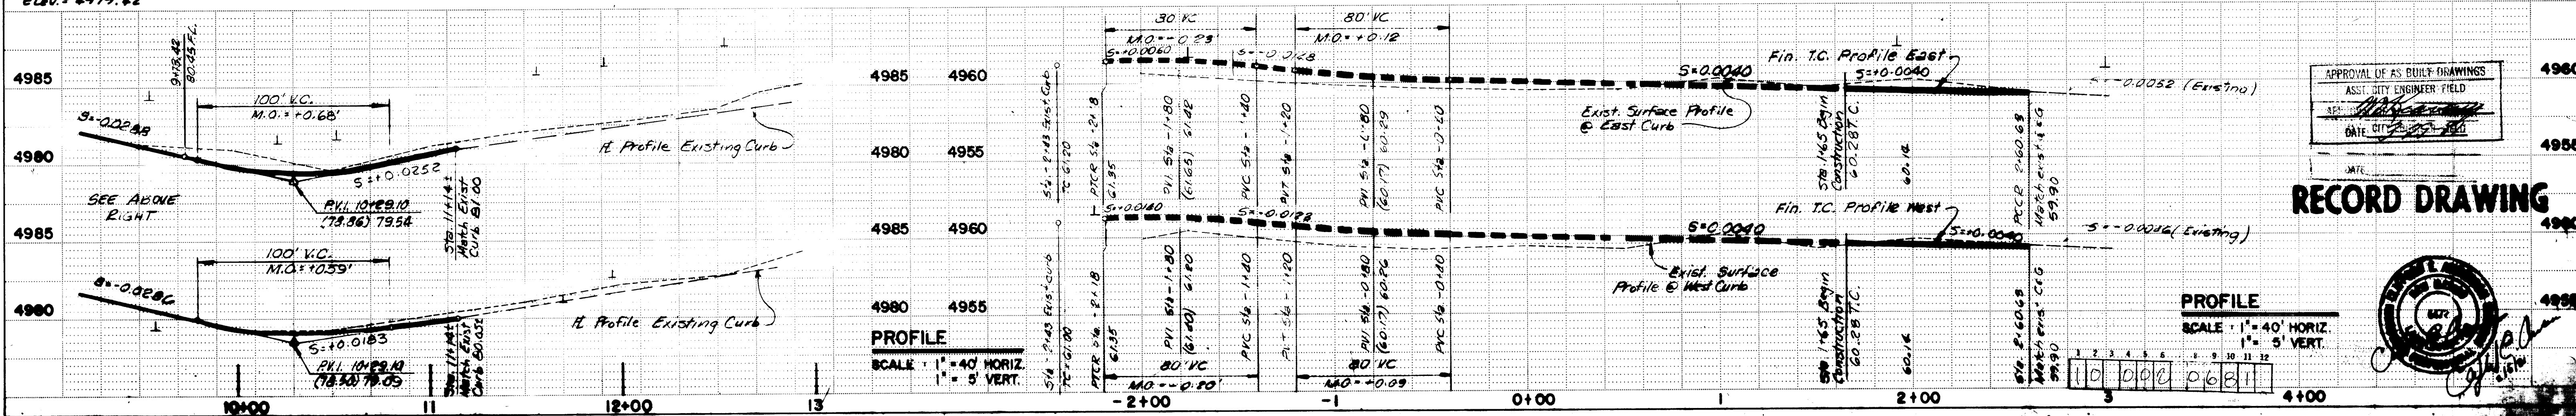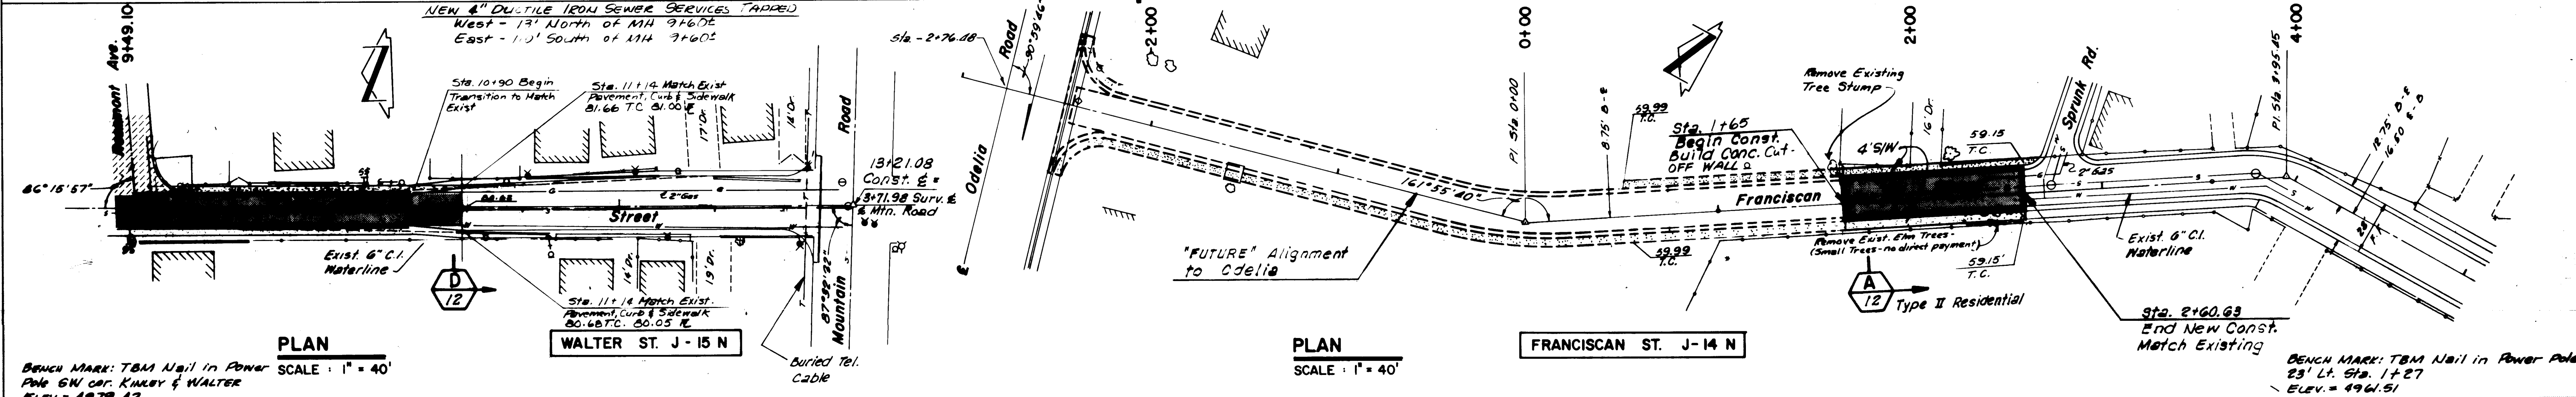

APPROVAL OF AS BUILT DRAWINGS
 ASST. CITY ENGINEER FIELD
 DATE: 11/11/11

RECORD DRAWING




PROFILE		BY	DATE
SURVEYED			
PLOTTED			
NOTE BOOK			
GRADES CHECKED			
B. M.'S. NOTED			
NO.			
STRUCTURE NOTATIONS CH'KD			



PLAN	SURVEYED _____		BY _____	DATE _____
	PLOTTED _____ ALIGNMENT CHECKED _____ RT. OF WAY CHECKED _____			
NOTE BOOK				
NO.				

**SCANLON AND ASSOCIATES
ENGINEERS PLANNERS**













PROFILE		BY	DATE
SURVEYED			
PLOTTED			
GRADES CHECKED			
B. M.: NOTED			
STRUCTURE NOTATIONS CH'KD			

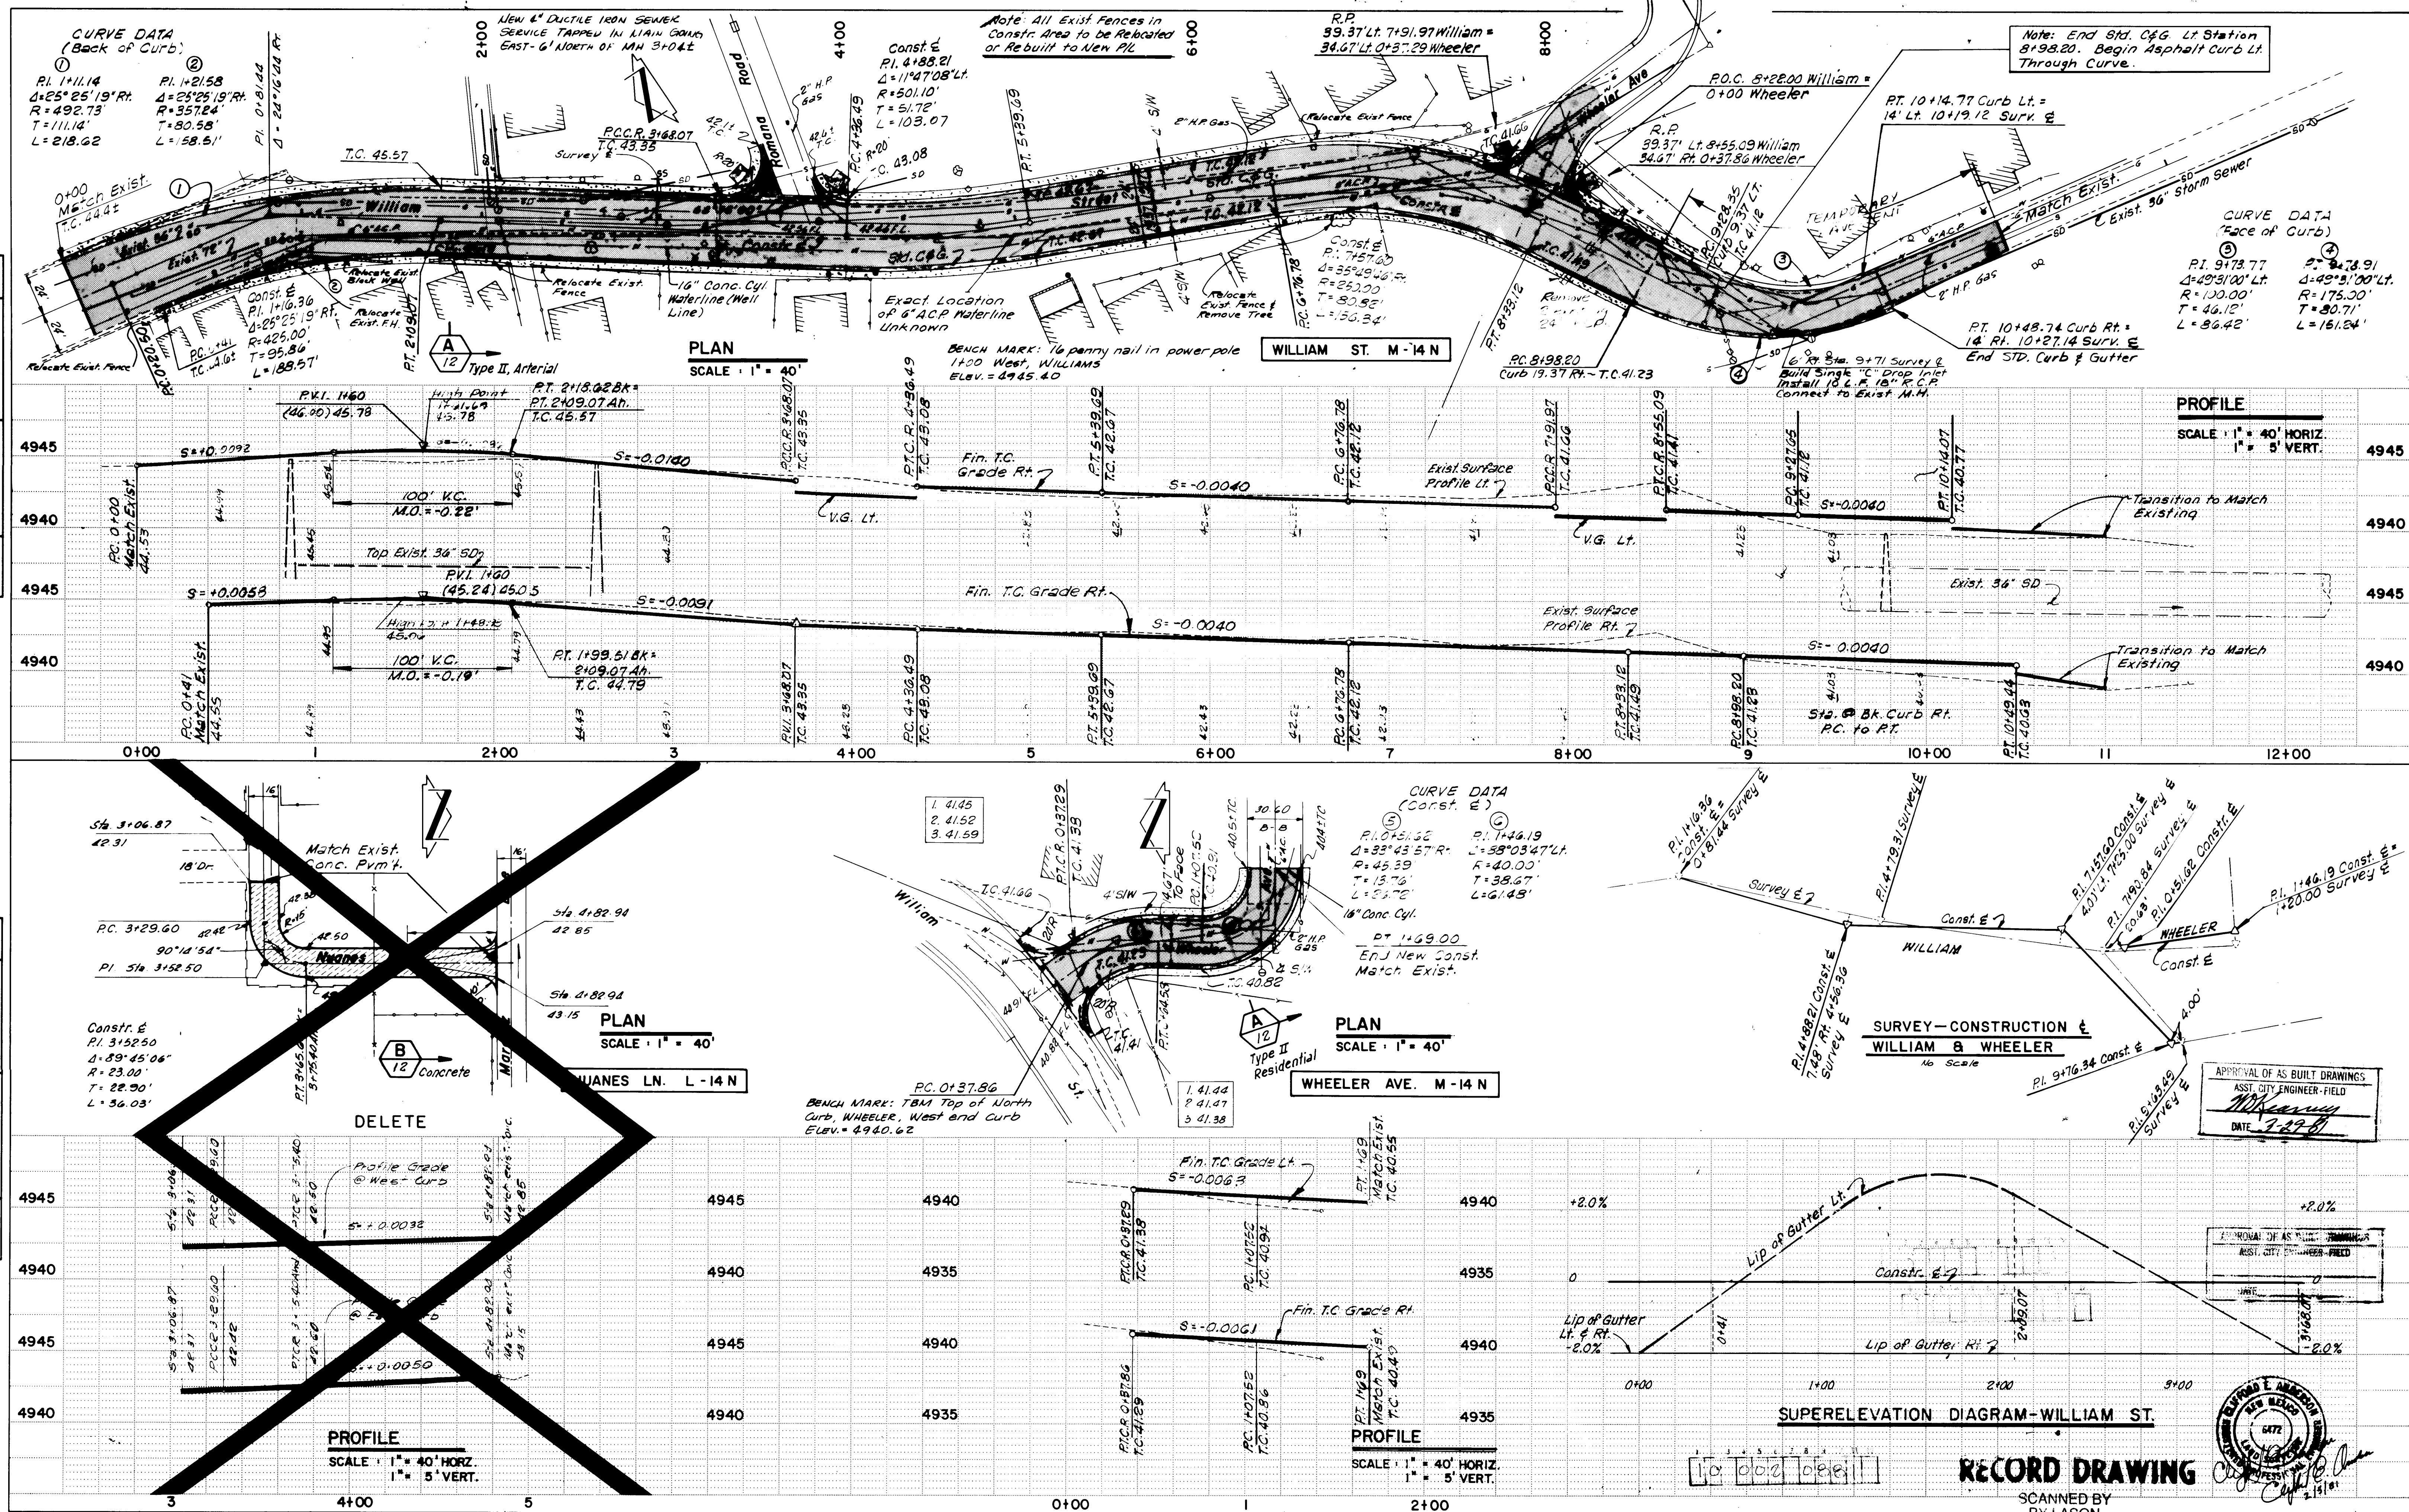


PLAN	DATE	BY
SURVEYED		
ALIGNED		
CHECKED		
NO.		

SCANLON AND ASSOCIATES
ENGINEERS PLANNERS

PROFILE	DATE	BY
SURVEYED		
ALIGNED		
CHECKED		
NO.		

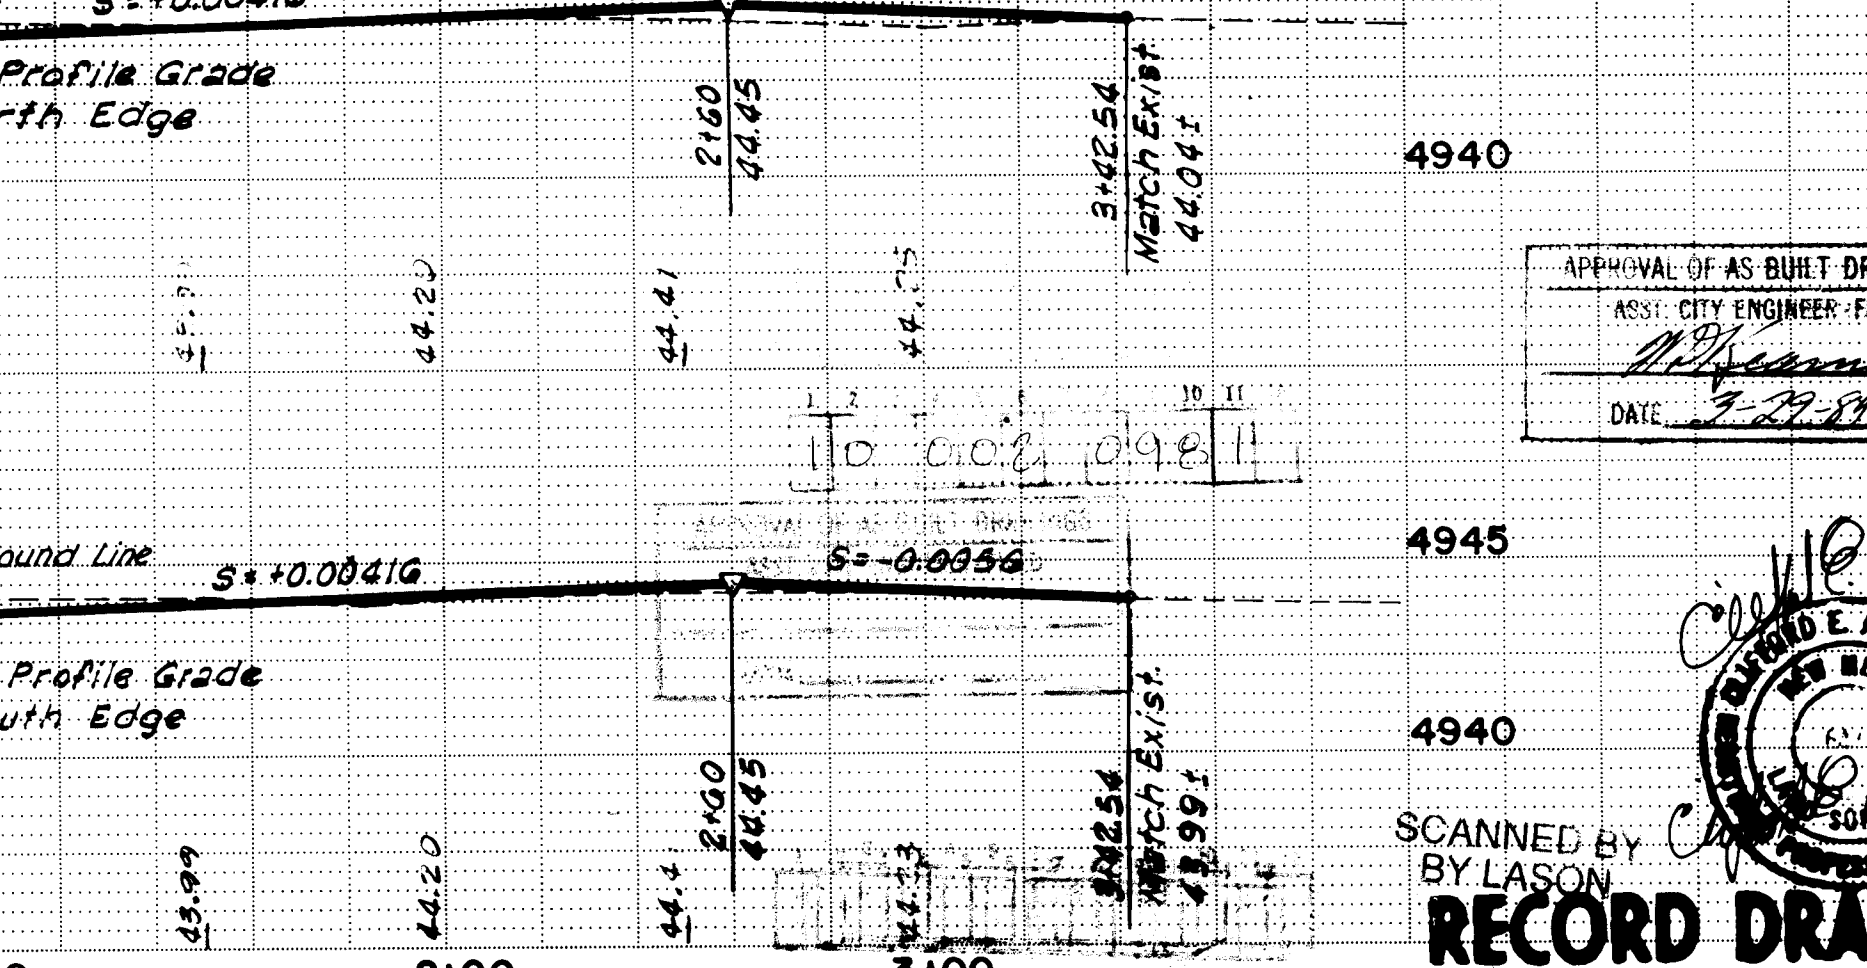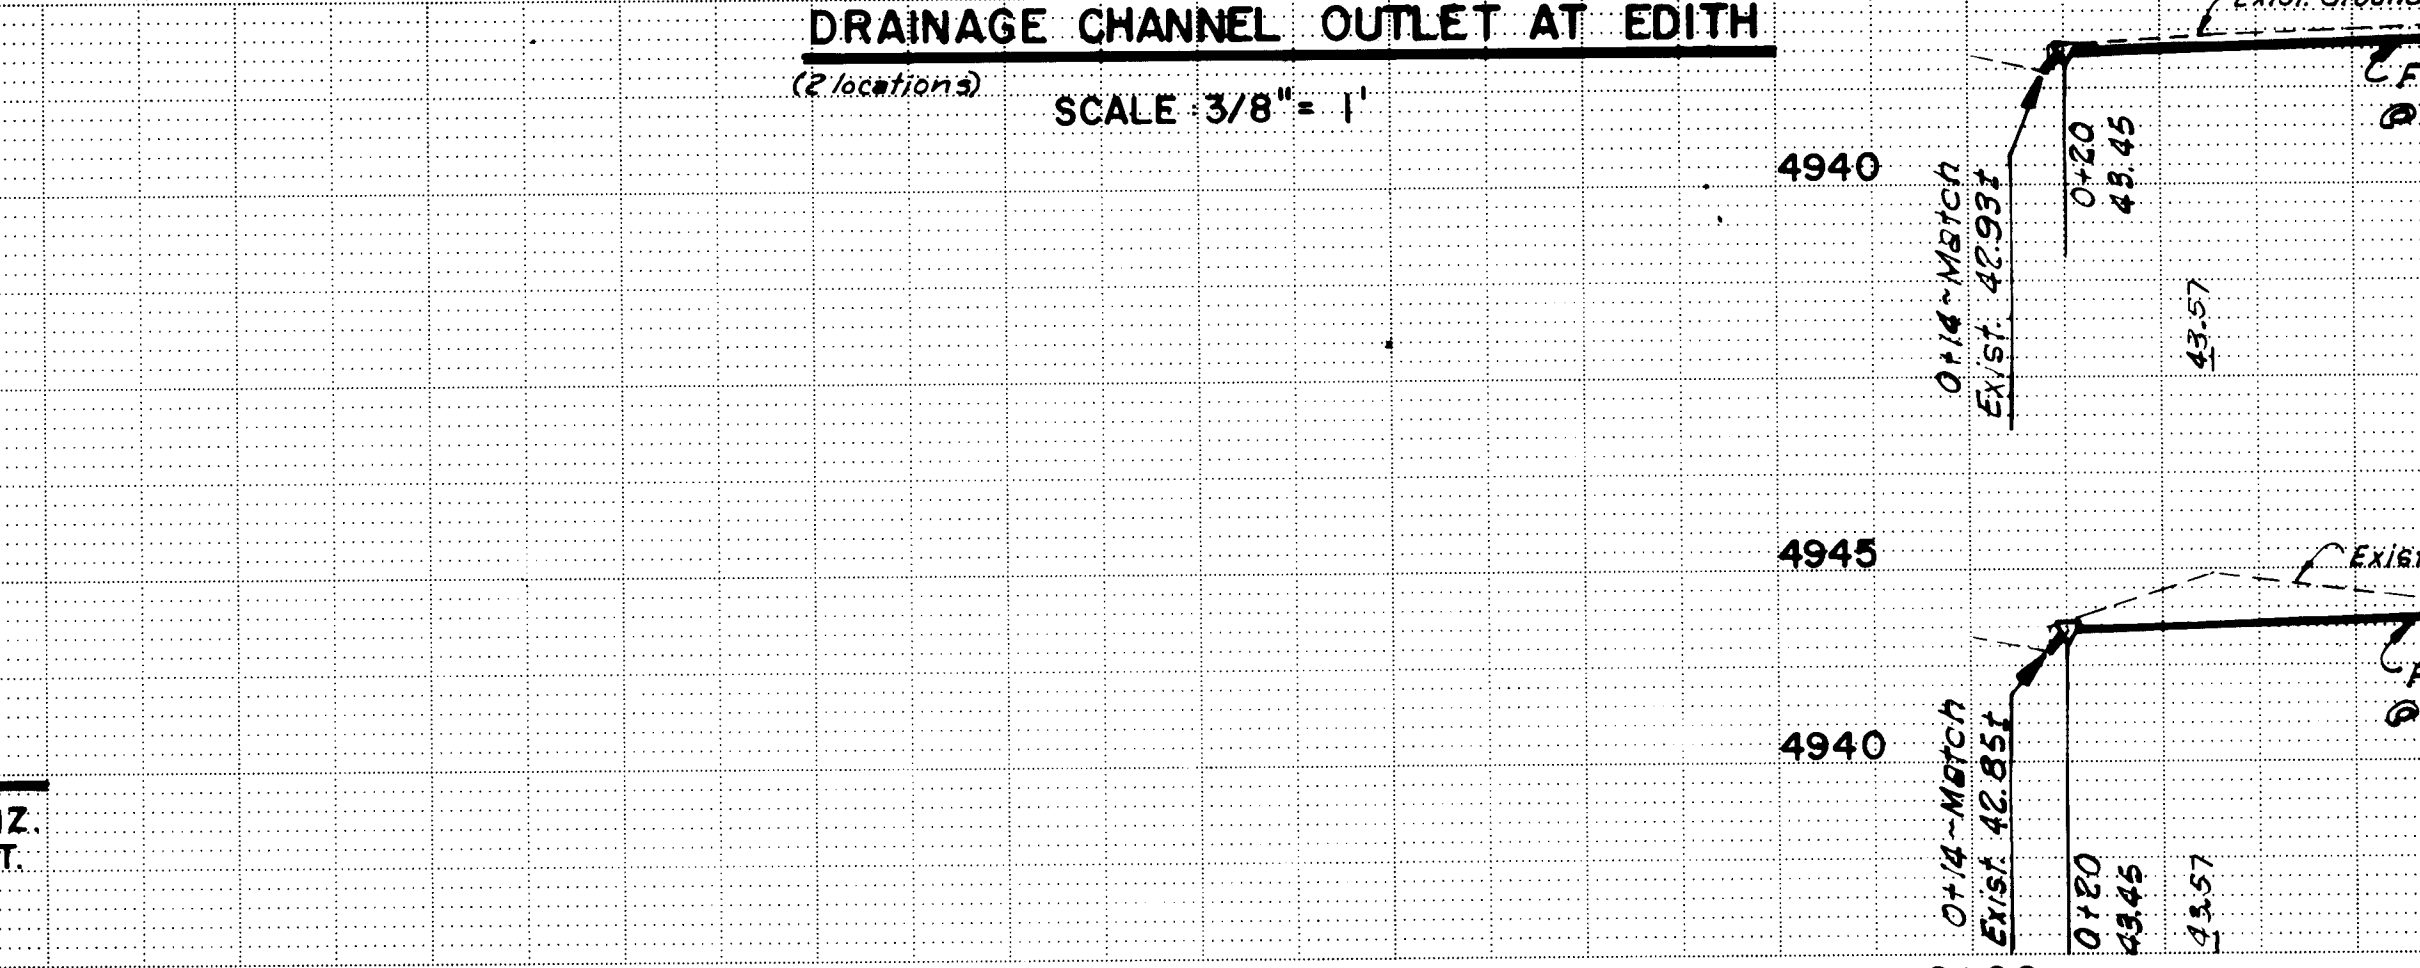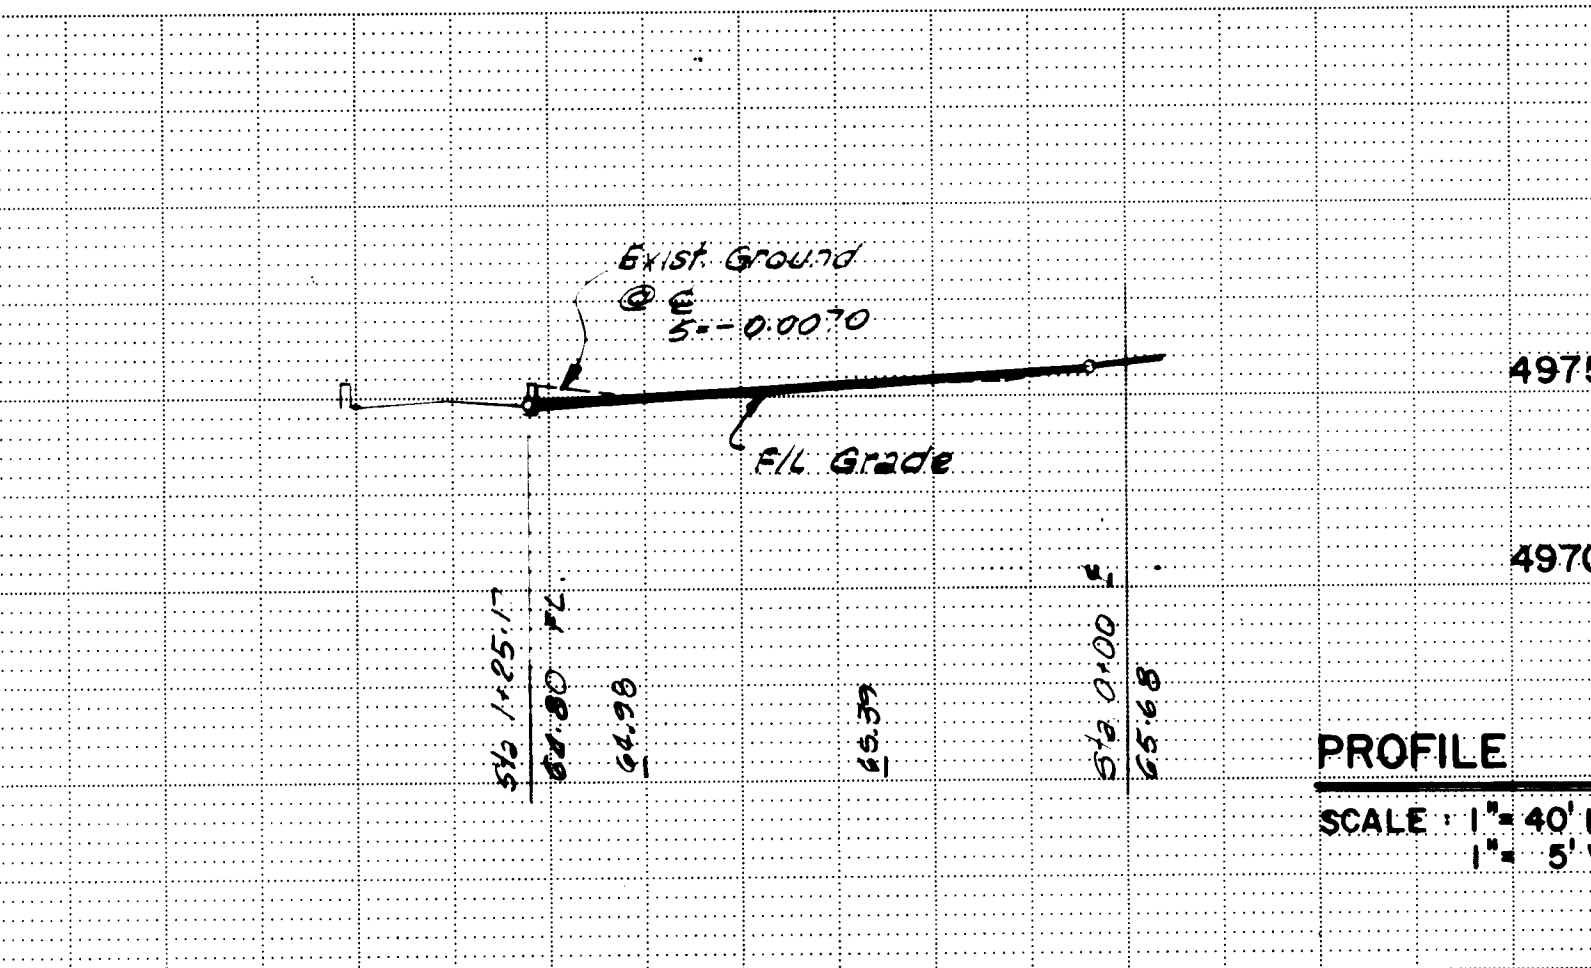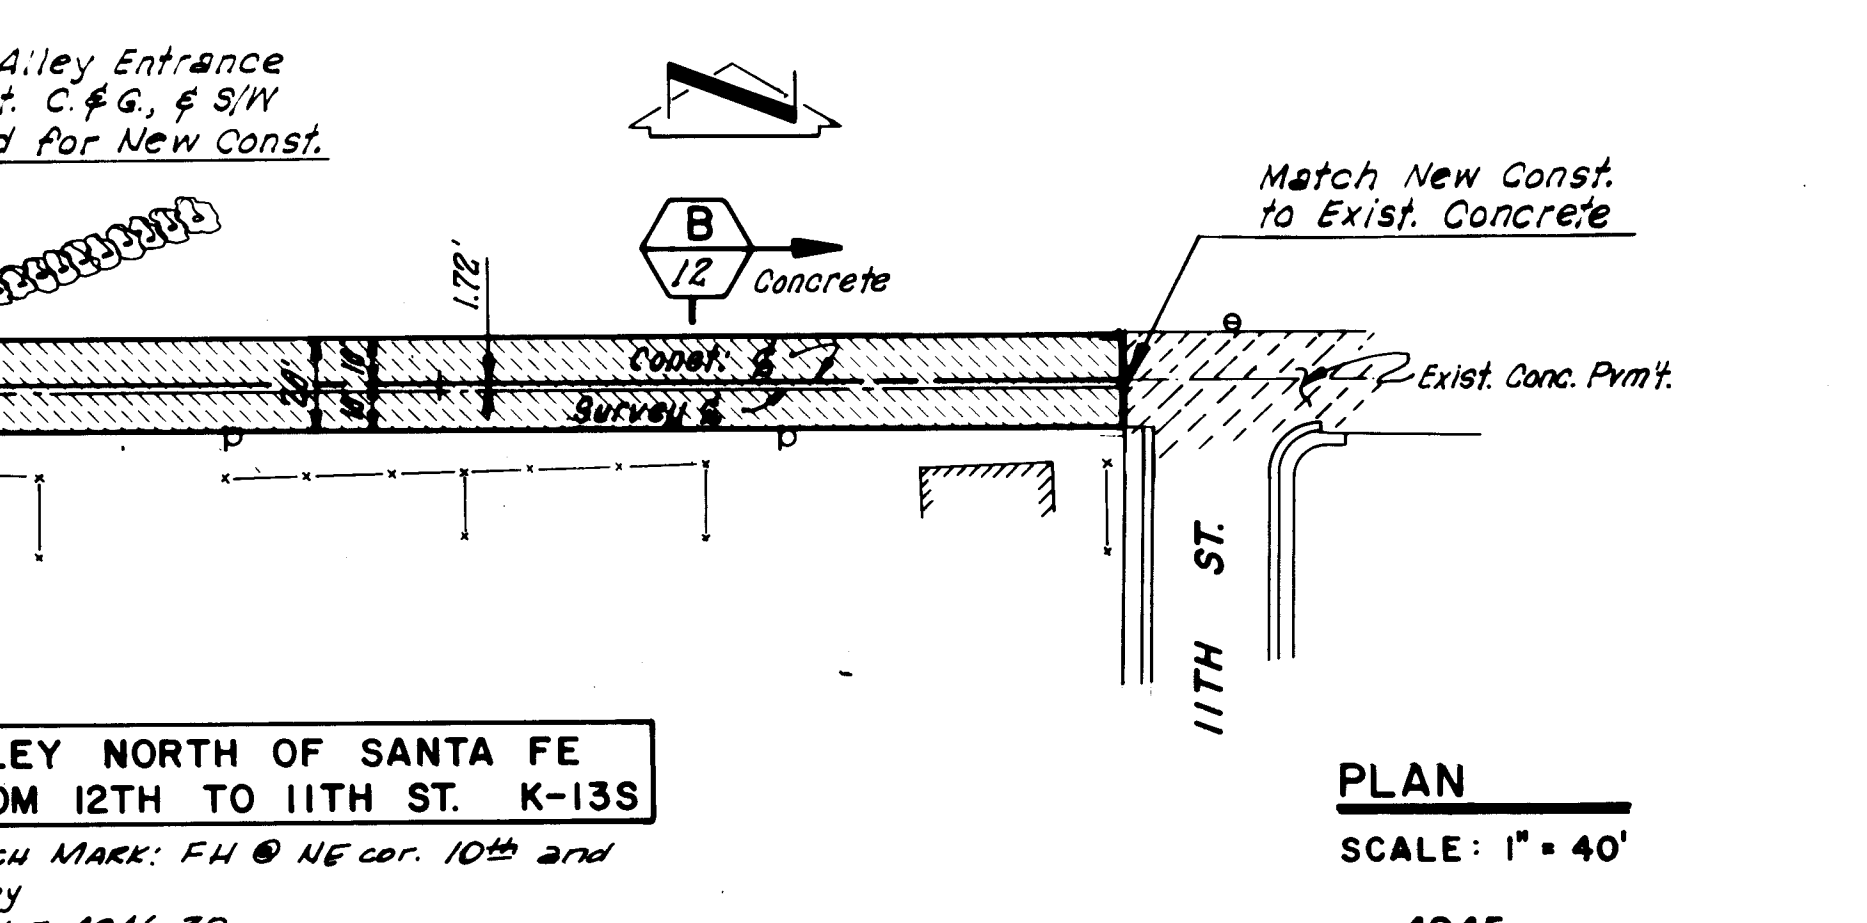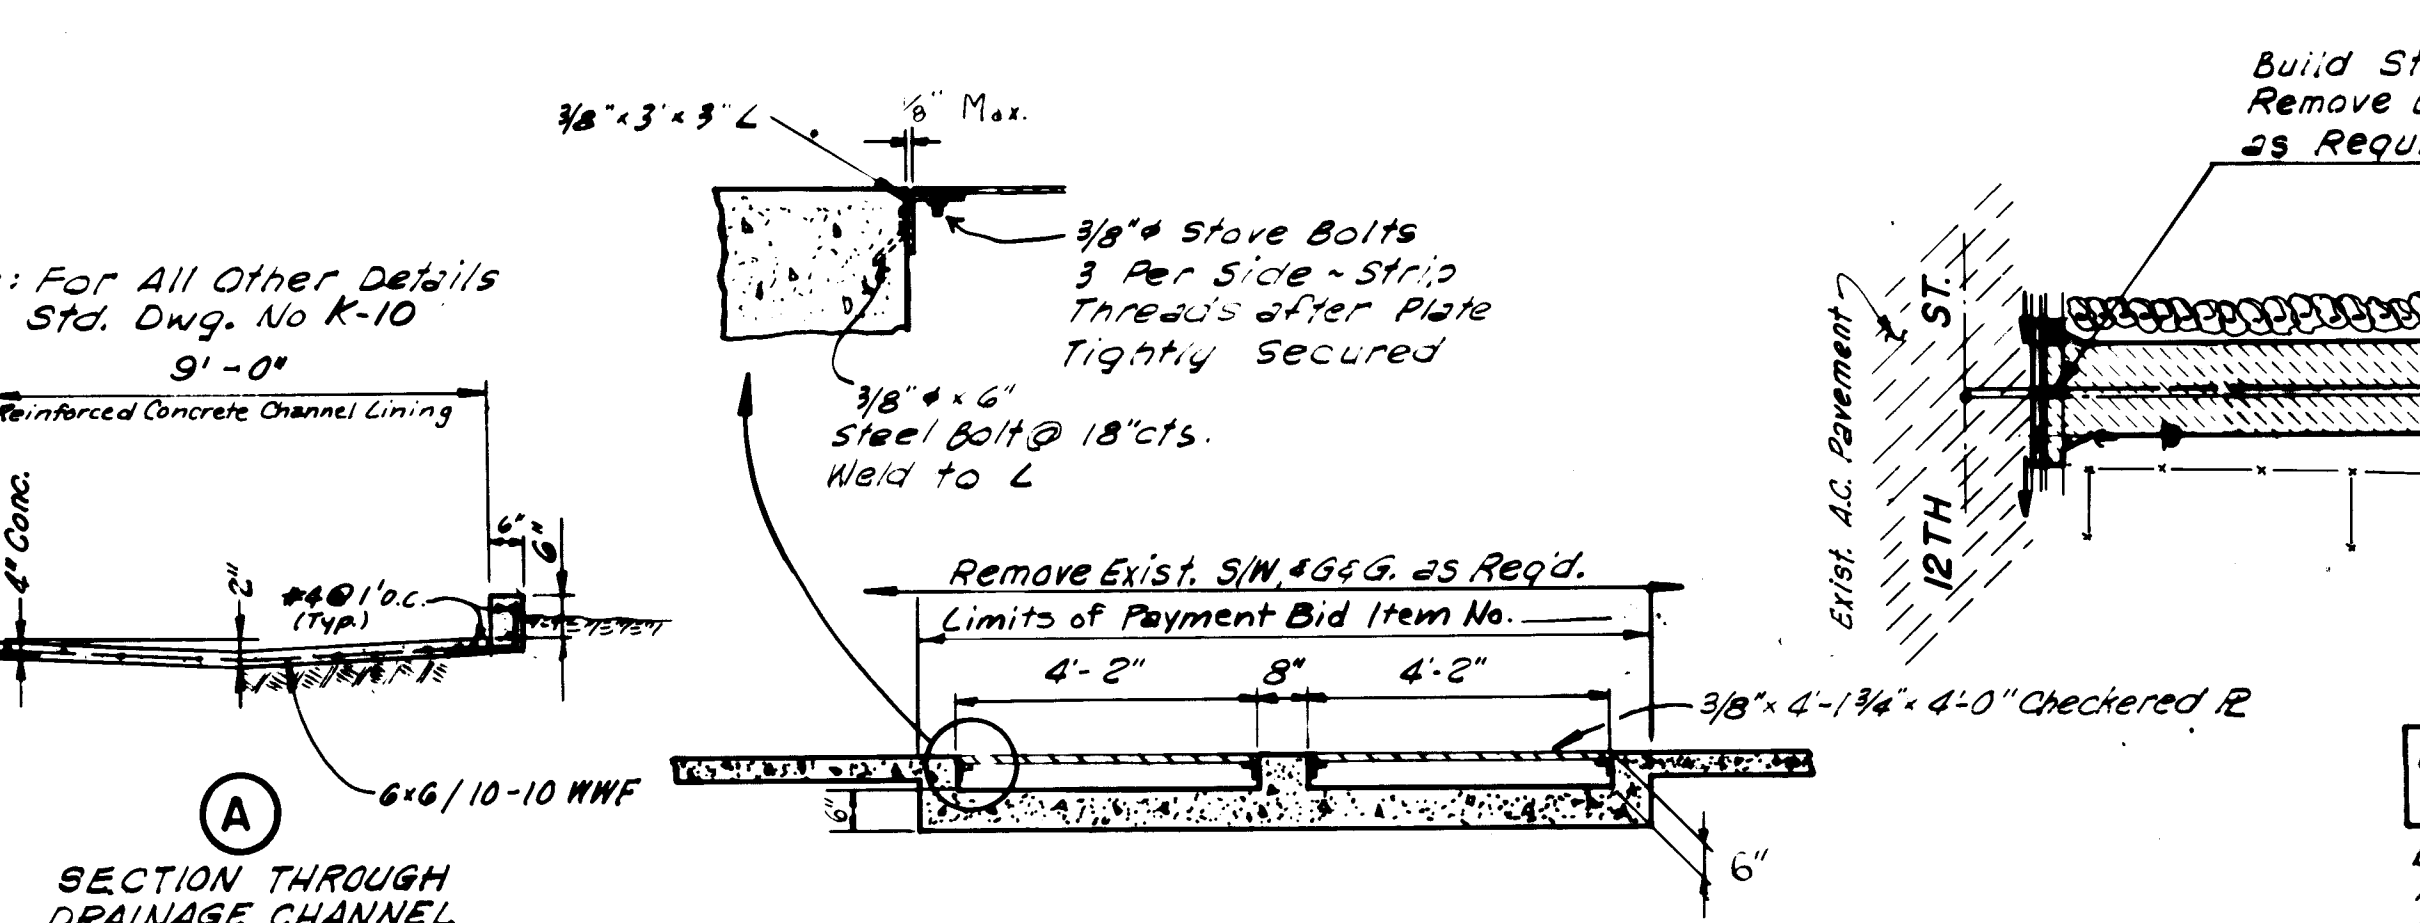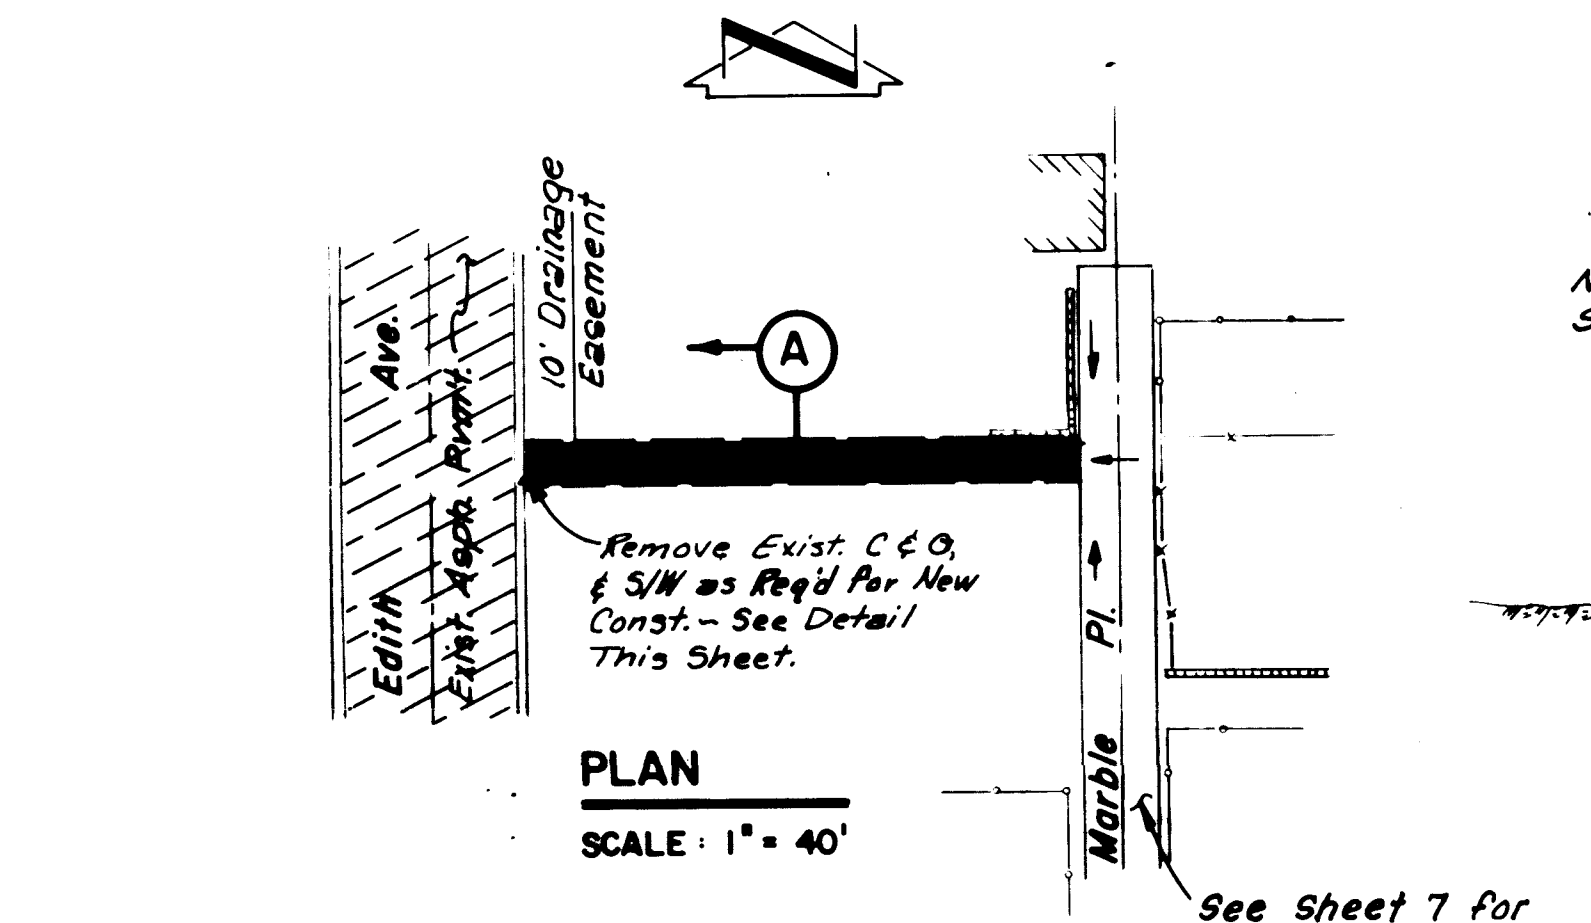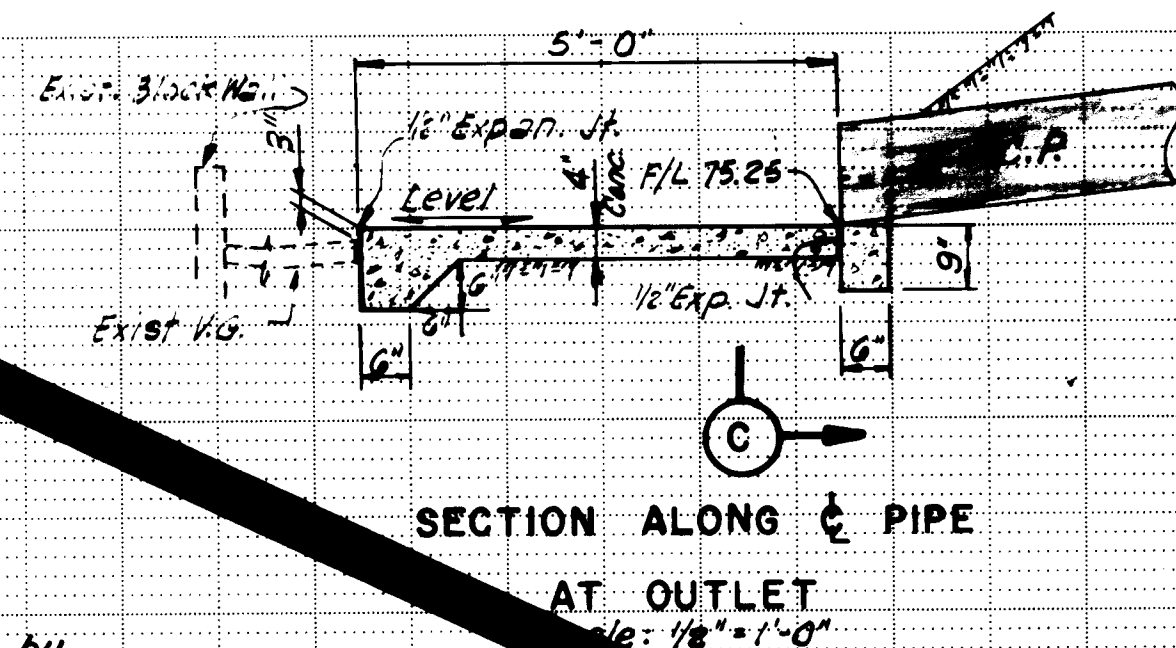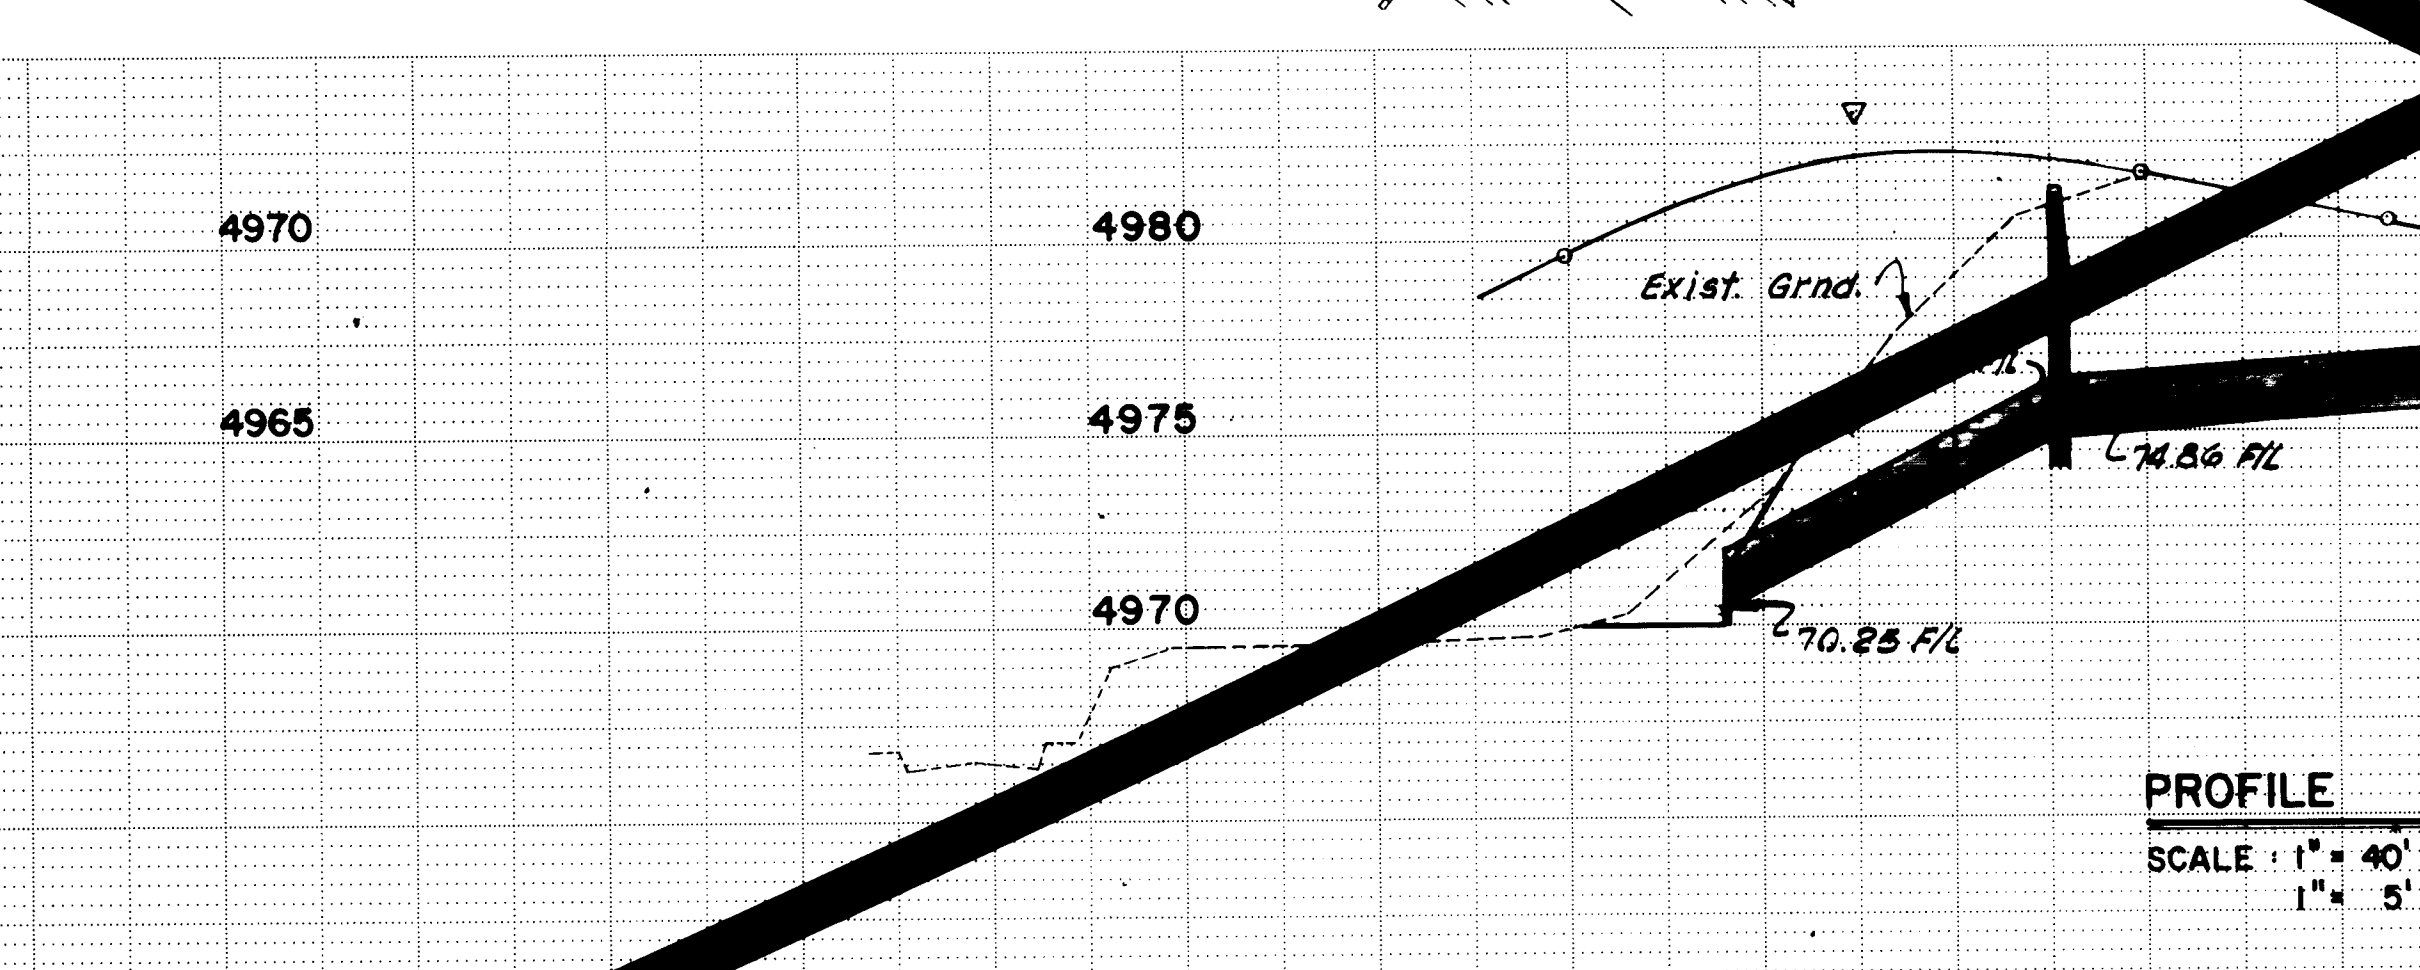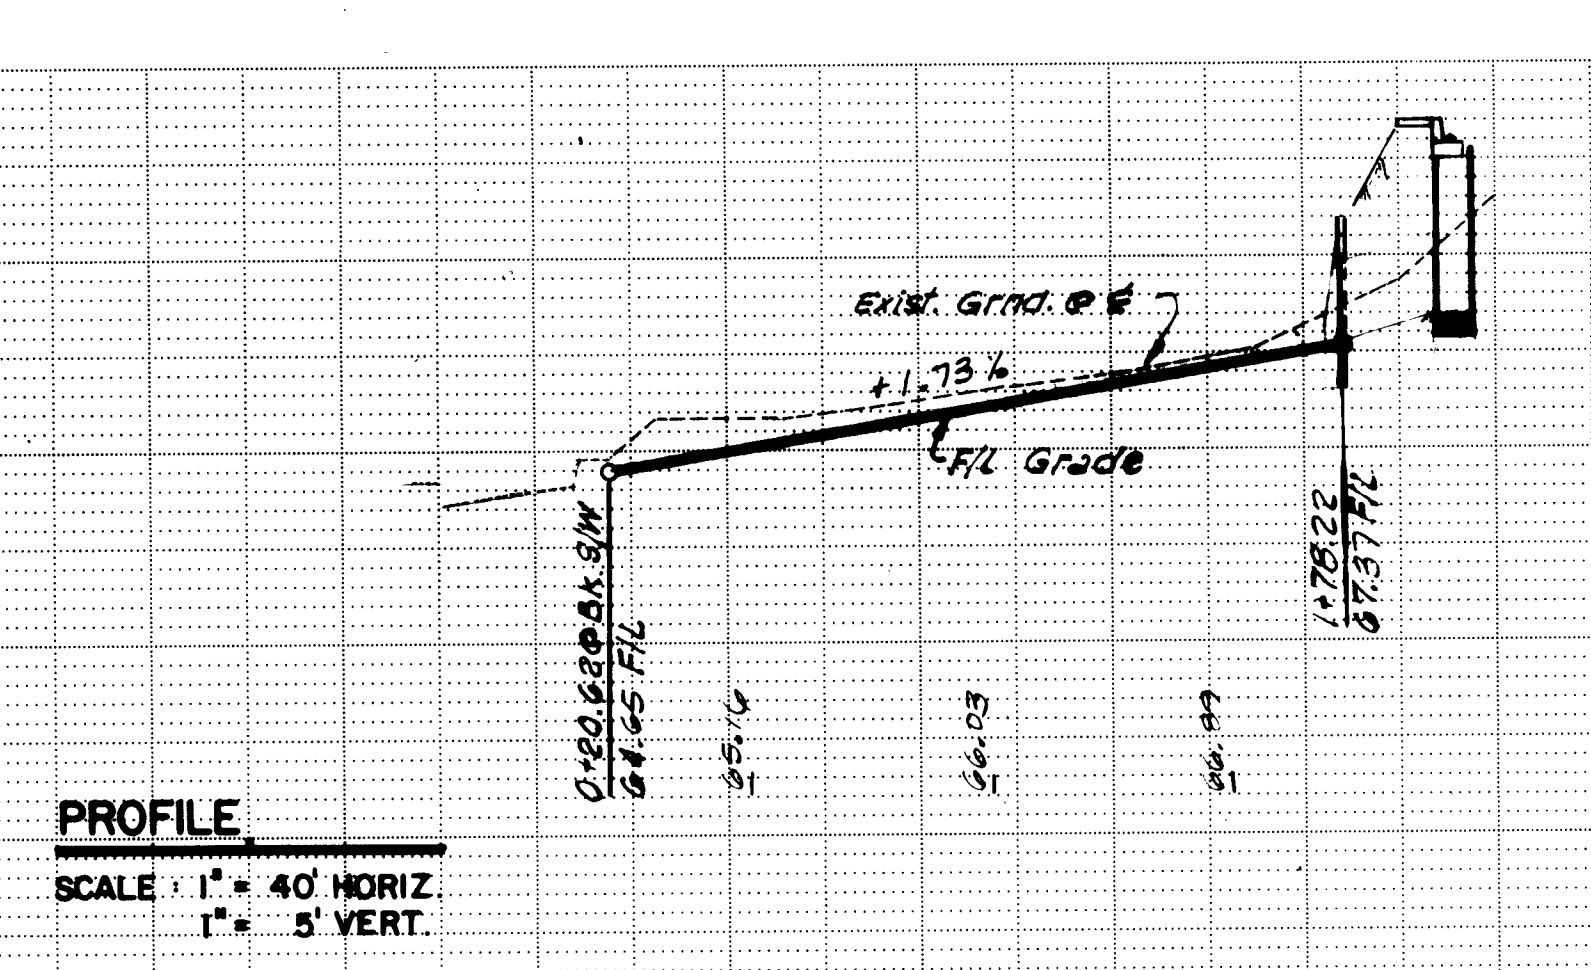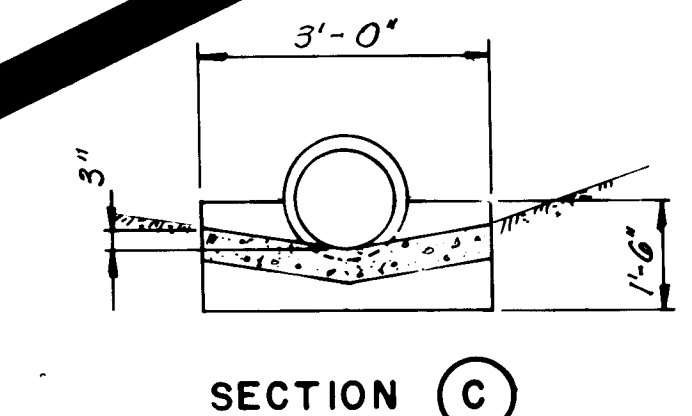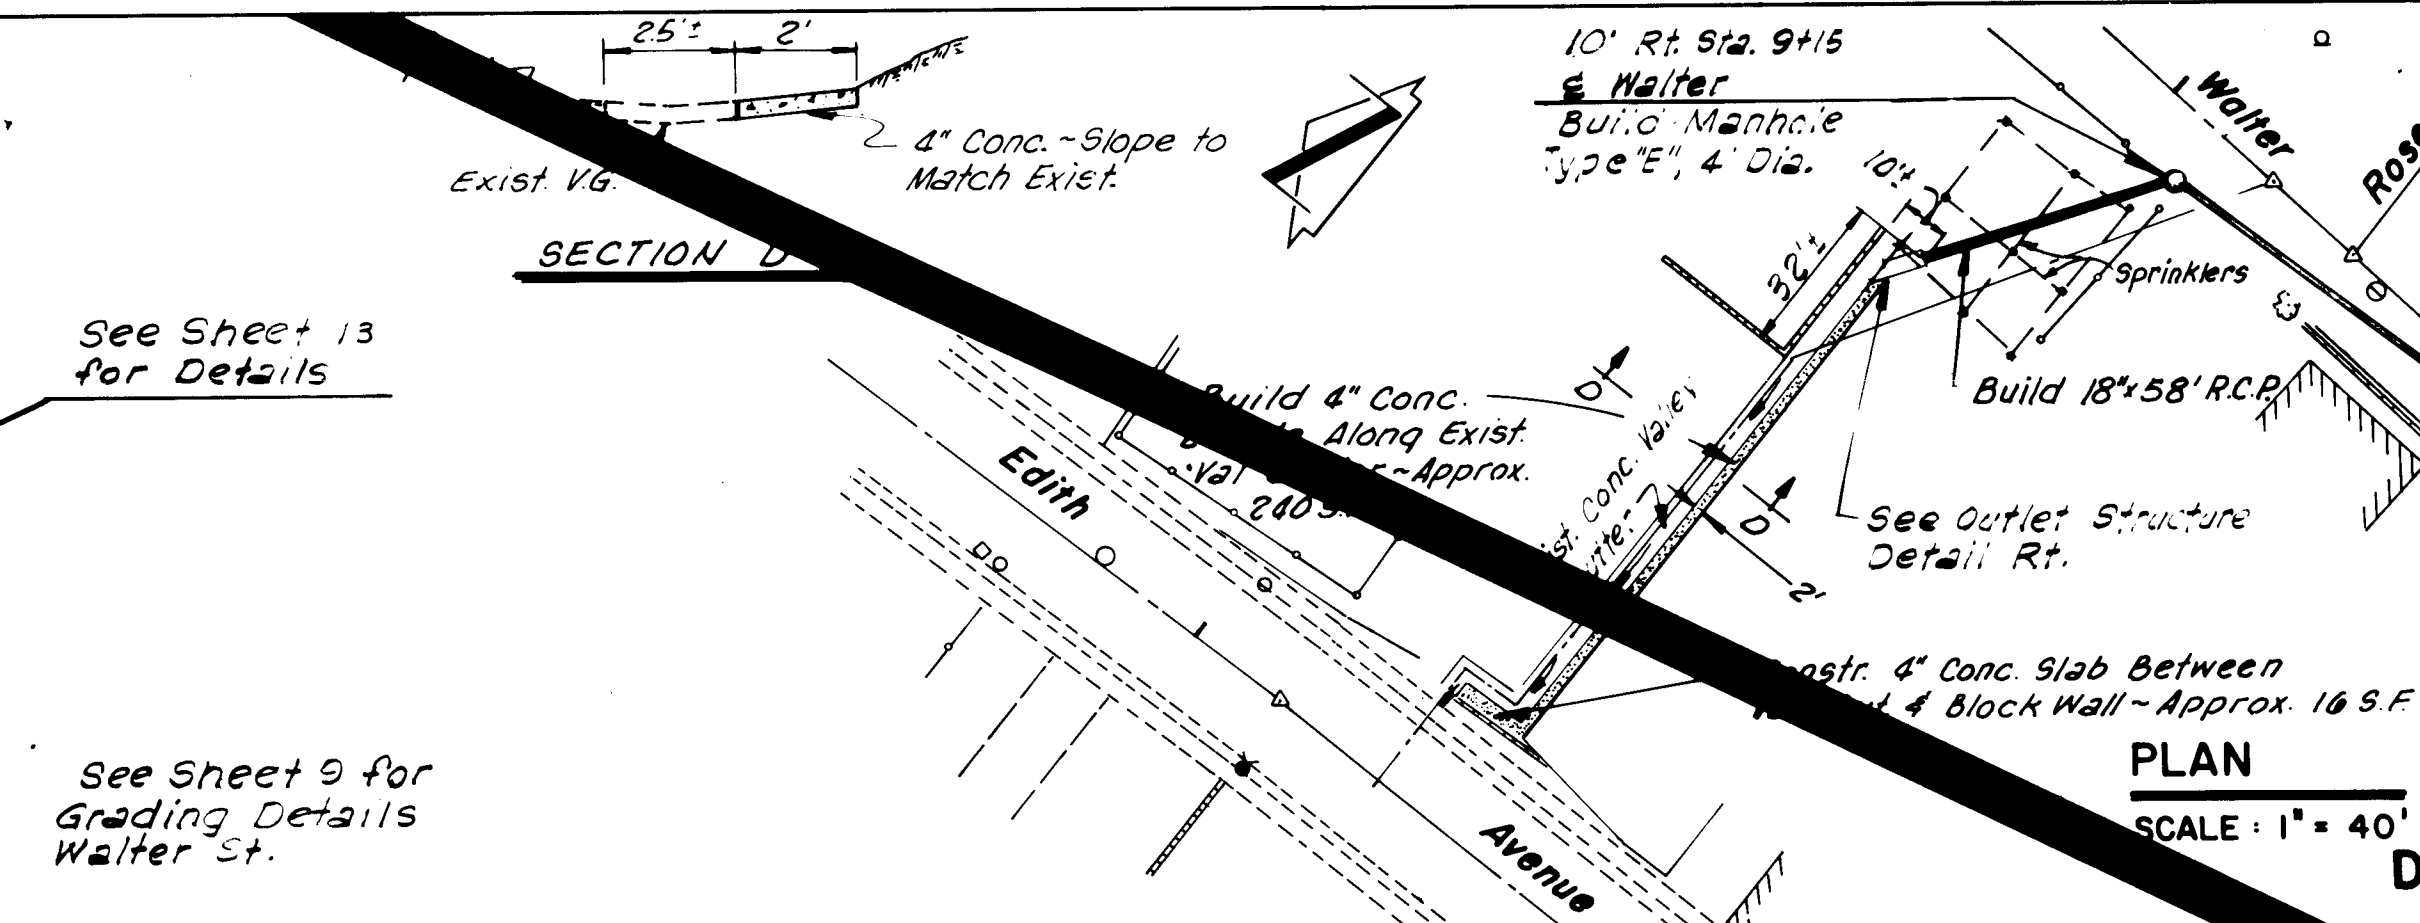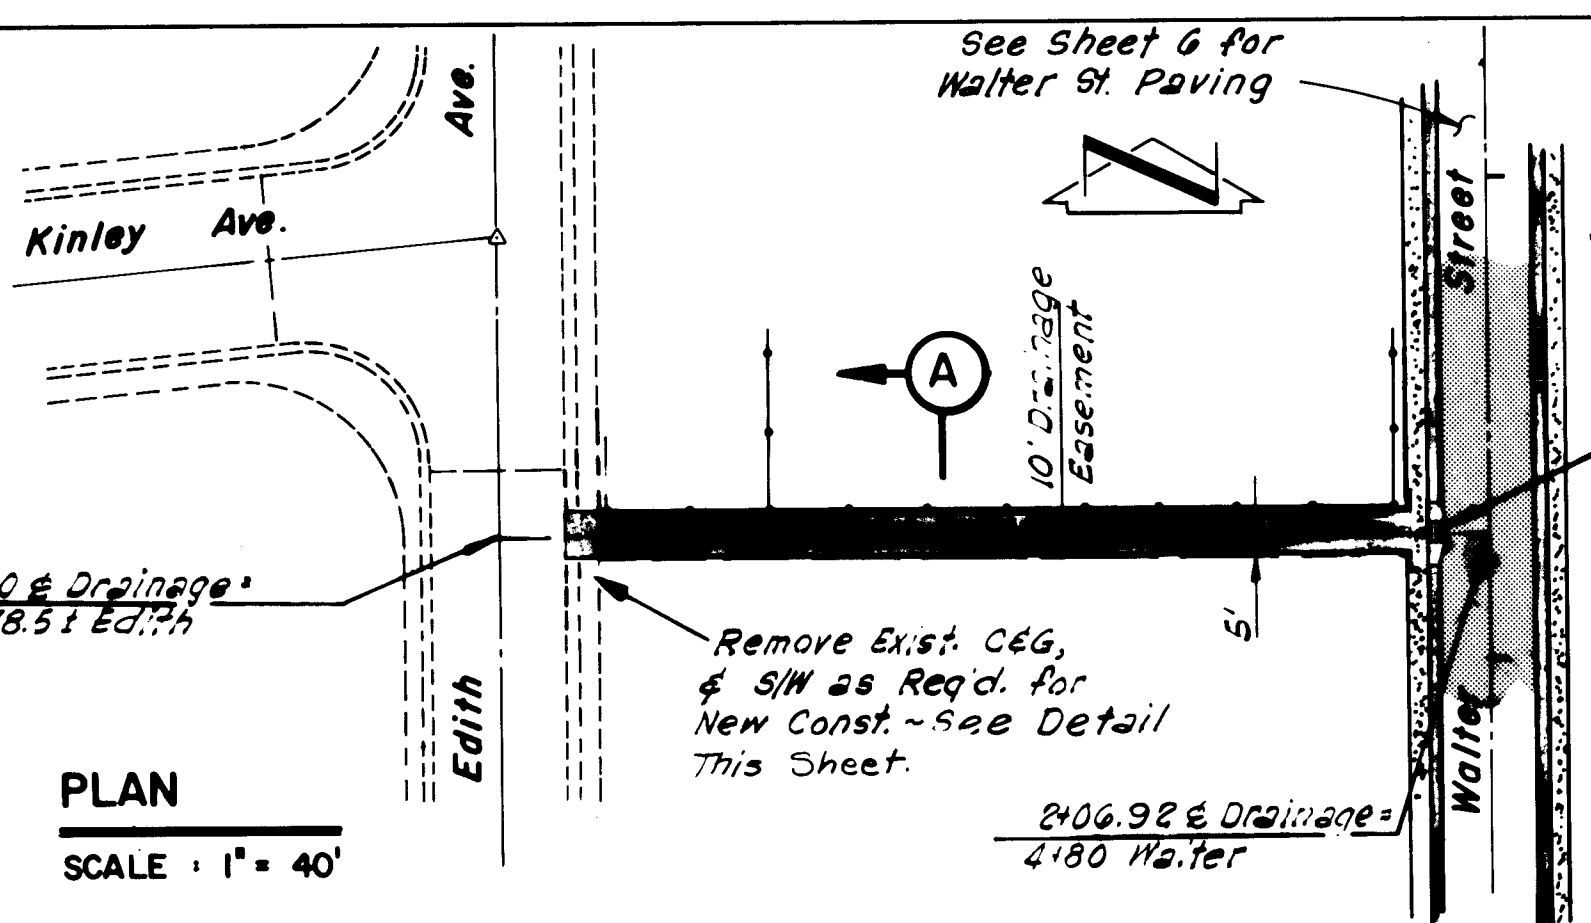

APPROVAL OF AS BUILT DRAWINGS
ASST. CITY ENGINEER - FIELD
DATE 3-29-81

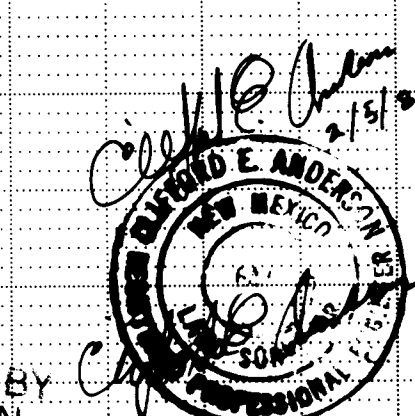



SCANNED BY
BY LASON
RECORD DRAWING

DATE	
BY	
PROJECT	
NO.	
DATE	
BY	
PROJECT	
NO.	

SCANLON AND ASSOCIATES
ENGINEERS PLANNERS

DATE	
BY	
PROJECT	
NO.	
DATE	
BY	
PROJECT	
NO.	

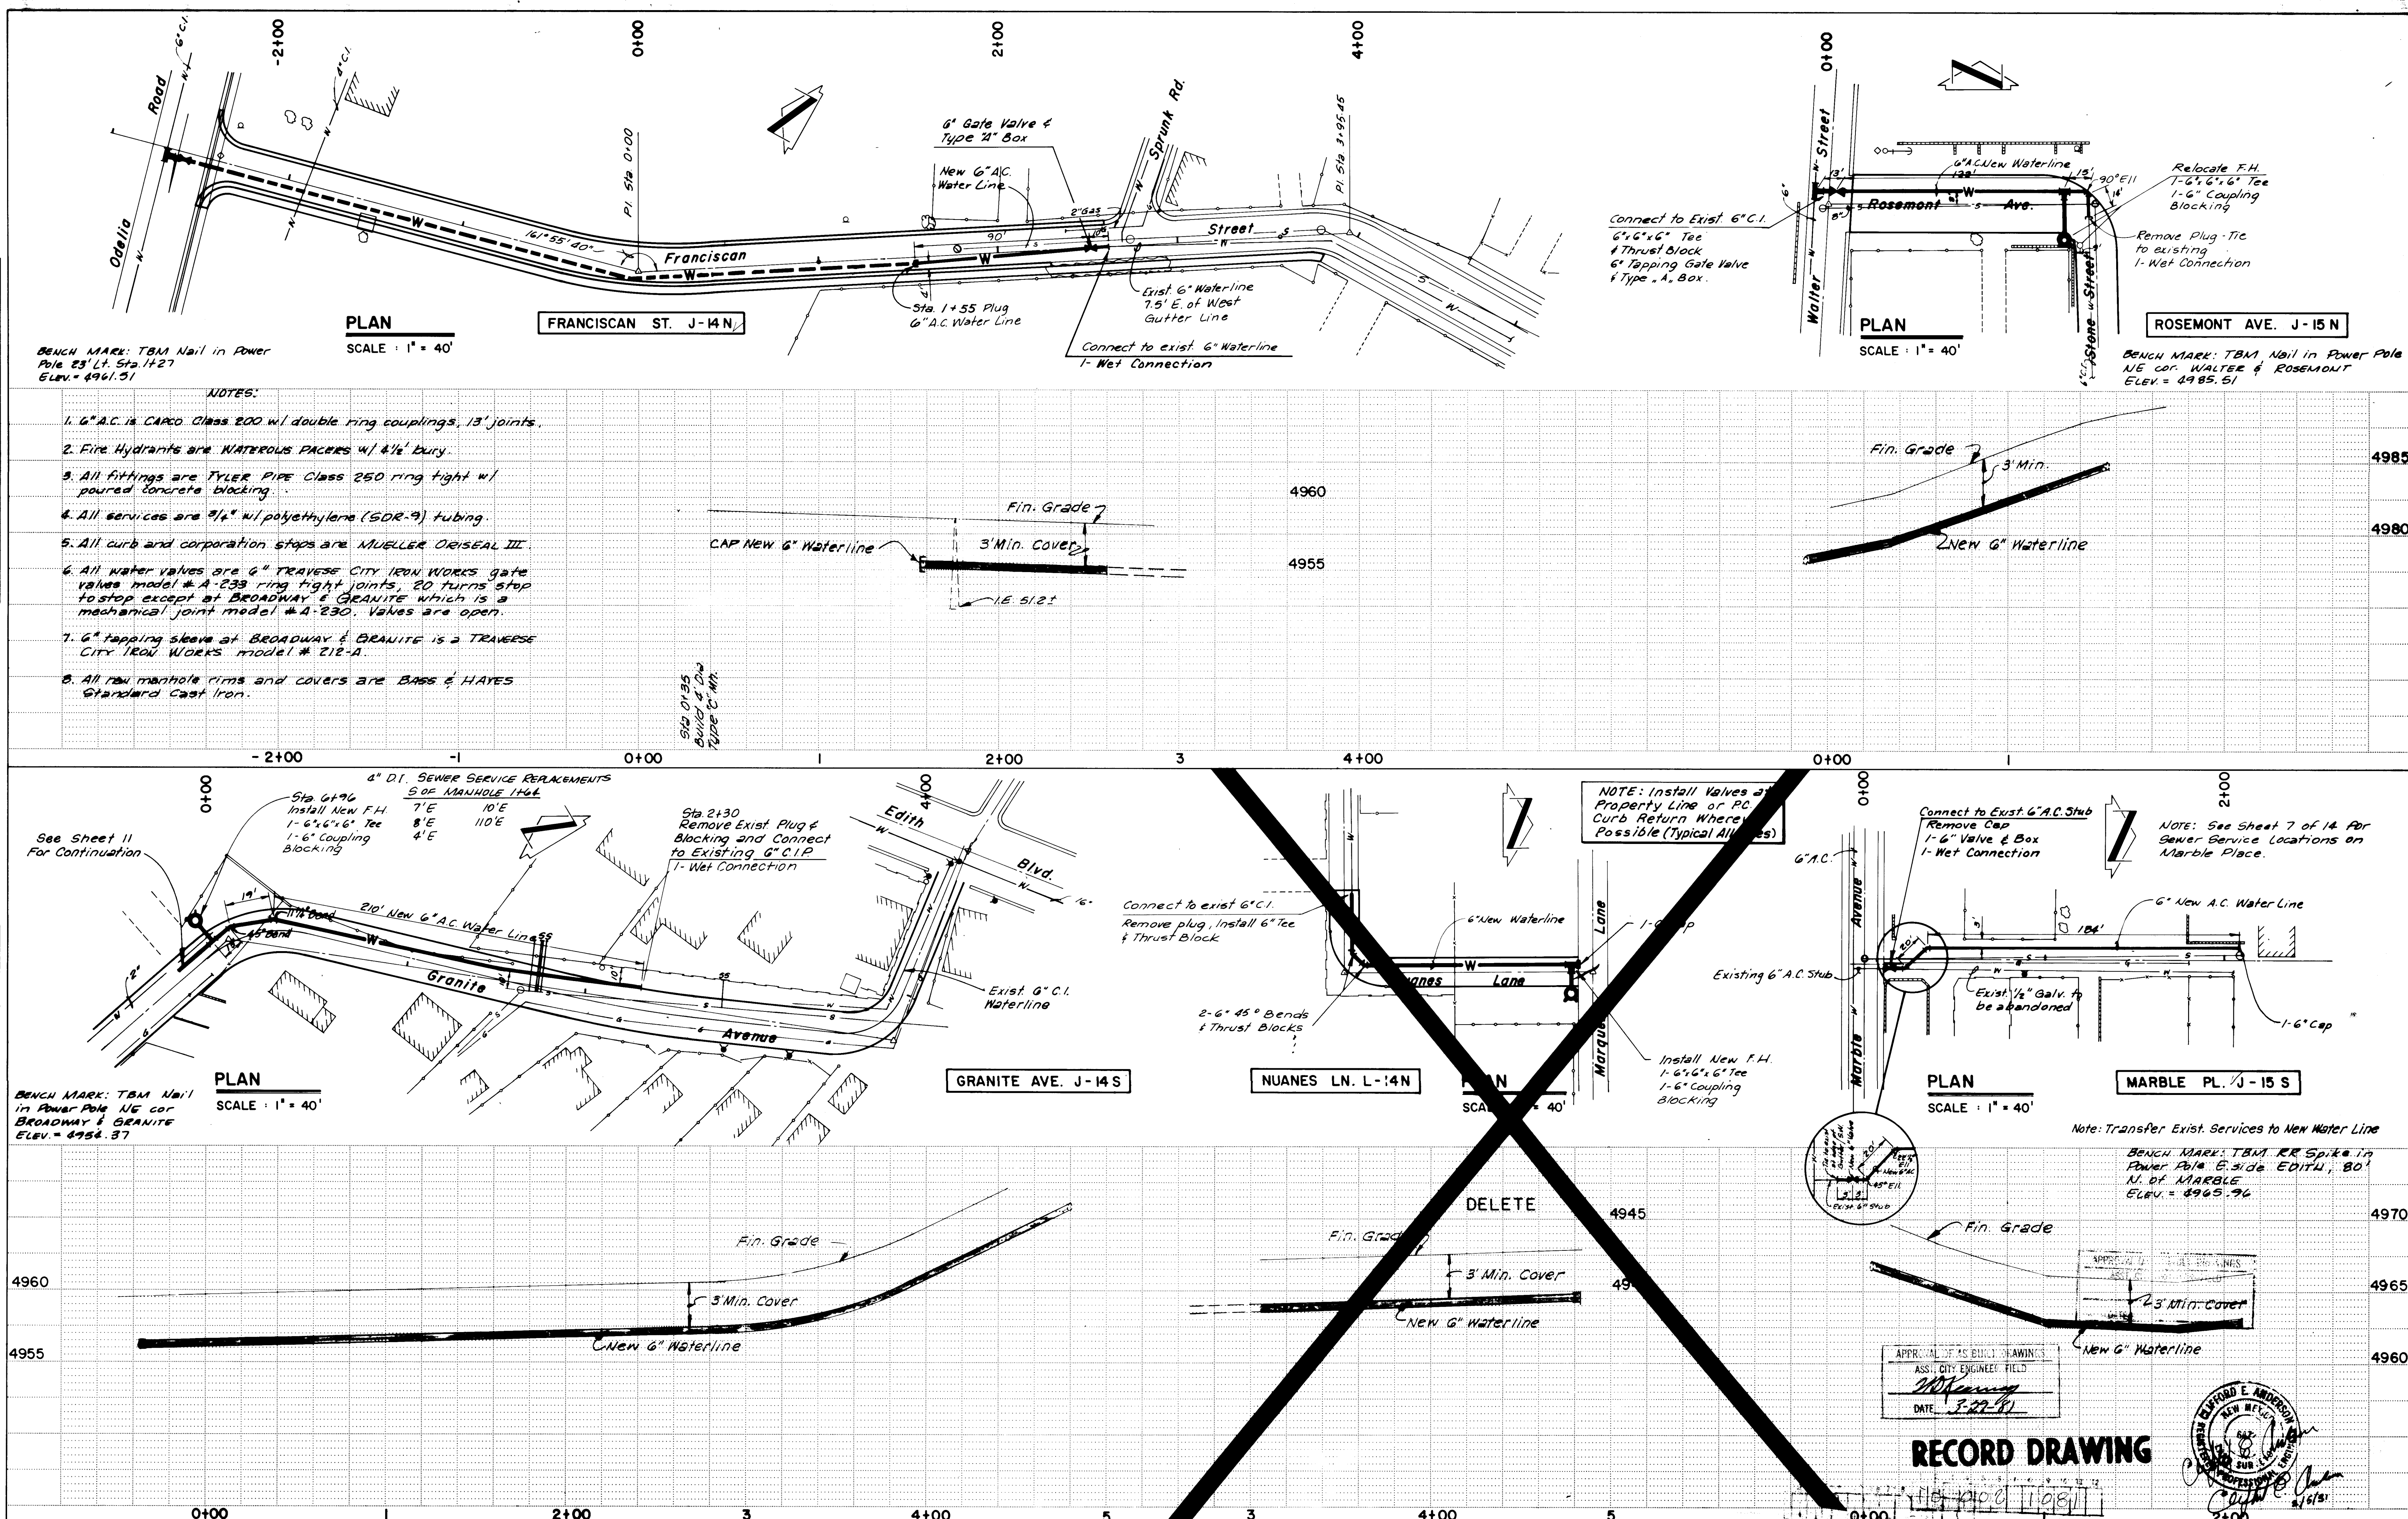

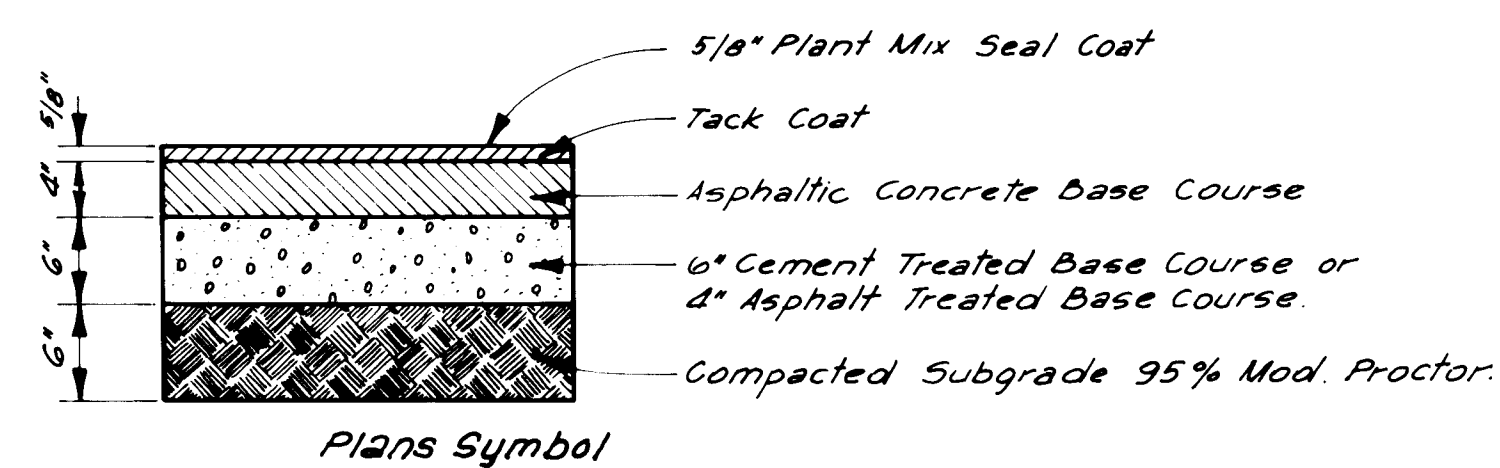

 5, 6, 8

SECTION 

Street	Width	Crown	Pvmt. Section
Franciscan	28'	0 24'	Type II, Residential
Arno	32'	0 32'	Type II, Residential
Wheeler	29.35'	0.29'	Type II, Residential
William	38.75'	0.39'	Type II Arterial

SECTION

Street	Width	Crown
Granite	16' / 24'	0.25 / 0.33
Kinley	18'	0.25'
Rosemont	22'	0.33'
Stone	22'	0.33'


3500 Air Entrained Concrete with Fly Ash

Compacted Subgrade 95% Mod. Proctor


Plan Symbol

CONCRETE PAVEMENT *Marble Pl., Granite, Kinley, Rosemont, Alley N. of Santa Fe, Stone*

TYPE II RESIDENTIAL - Franciscan - Arno - Wheeler - Walter

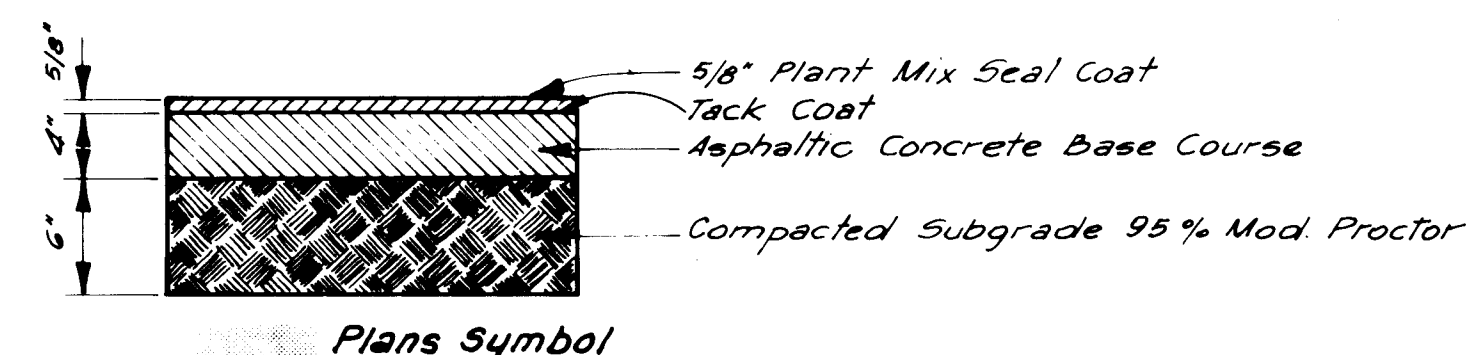


NO SCALE

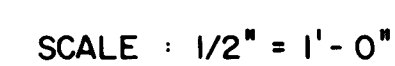


 5, 6, 7, 8

SCALE : $1/2" = 1' - 0"$

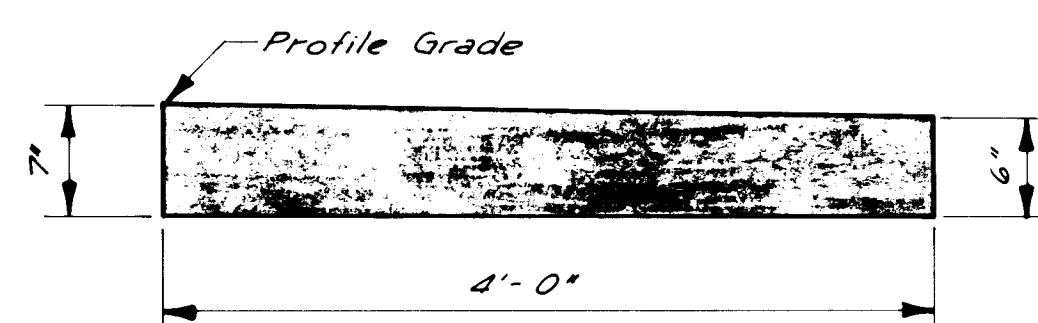


GUTTER & SIDEWALK COMBINATION

SCALE : $1'' = 1' - 0''$

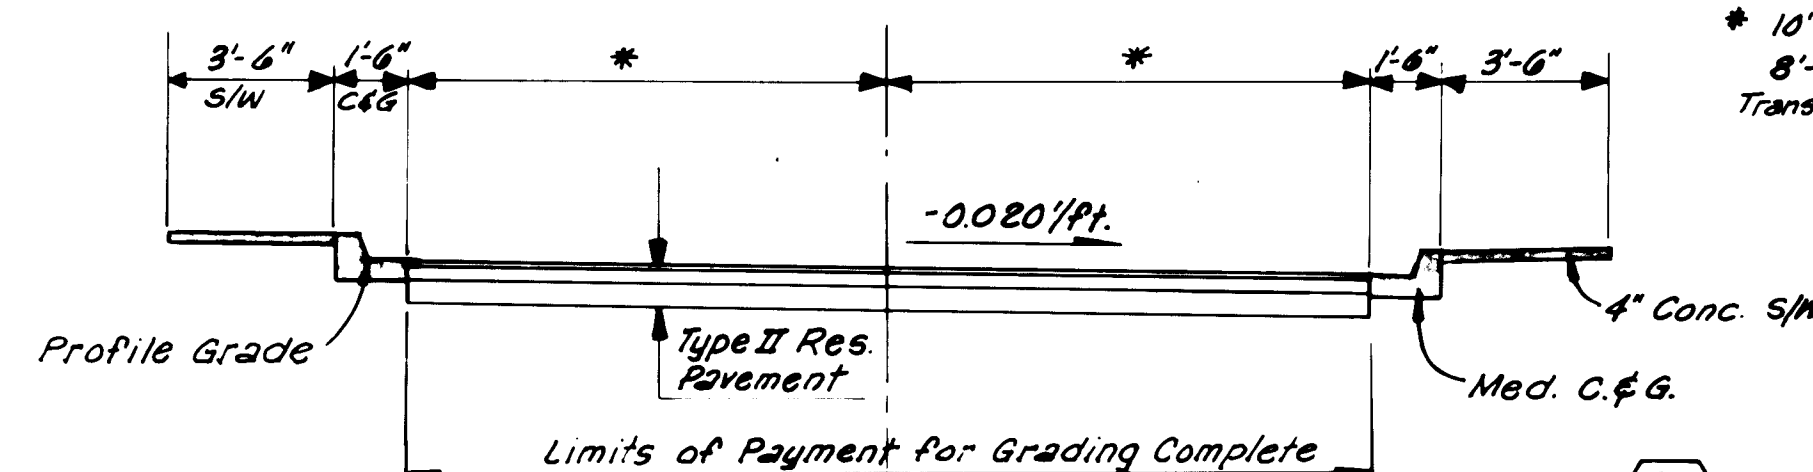

NO SCALE

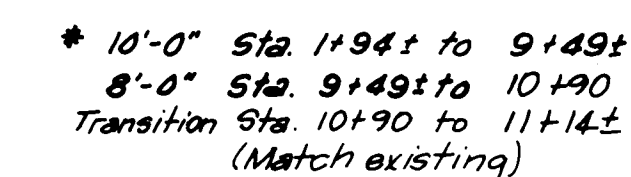

PLACEMENT OF 5/8" SEAL COAT
NO SCALE

ALBUQUERQUE CD - 2

STANDARD DETAILS


CITY OF ALBUQUERQUE

albuquerque		bernalillo county		new mexico	
DATE JUNE - 77	JOB NO. 77005	SCALE AS SHOWN	DRAWN: V. M. CHK'D: R. B.	SHEET 12	OF 14


 **Scanlon & associates, inc.**
Engineers ~ Planners
albuquerque artesia santa fe

SCANNED BY
BY LASON


RECORD DRAWING

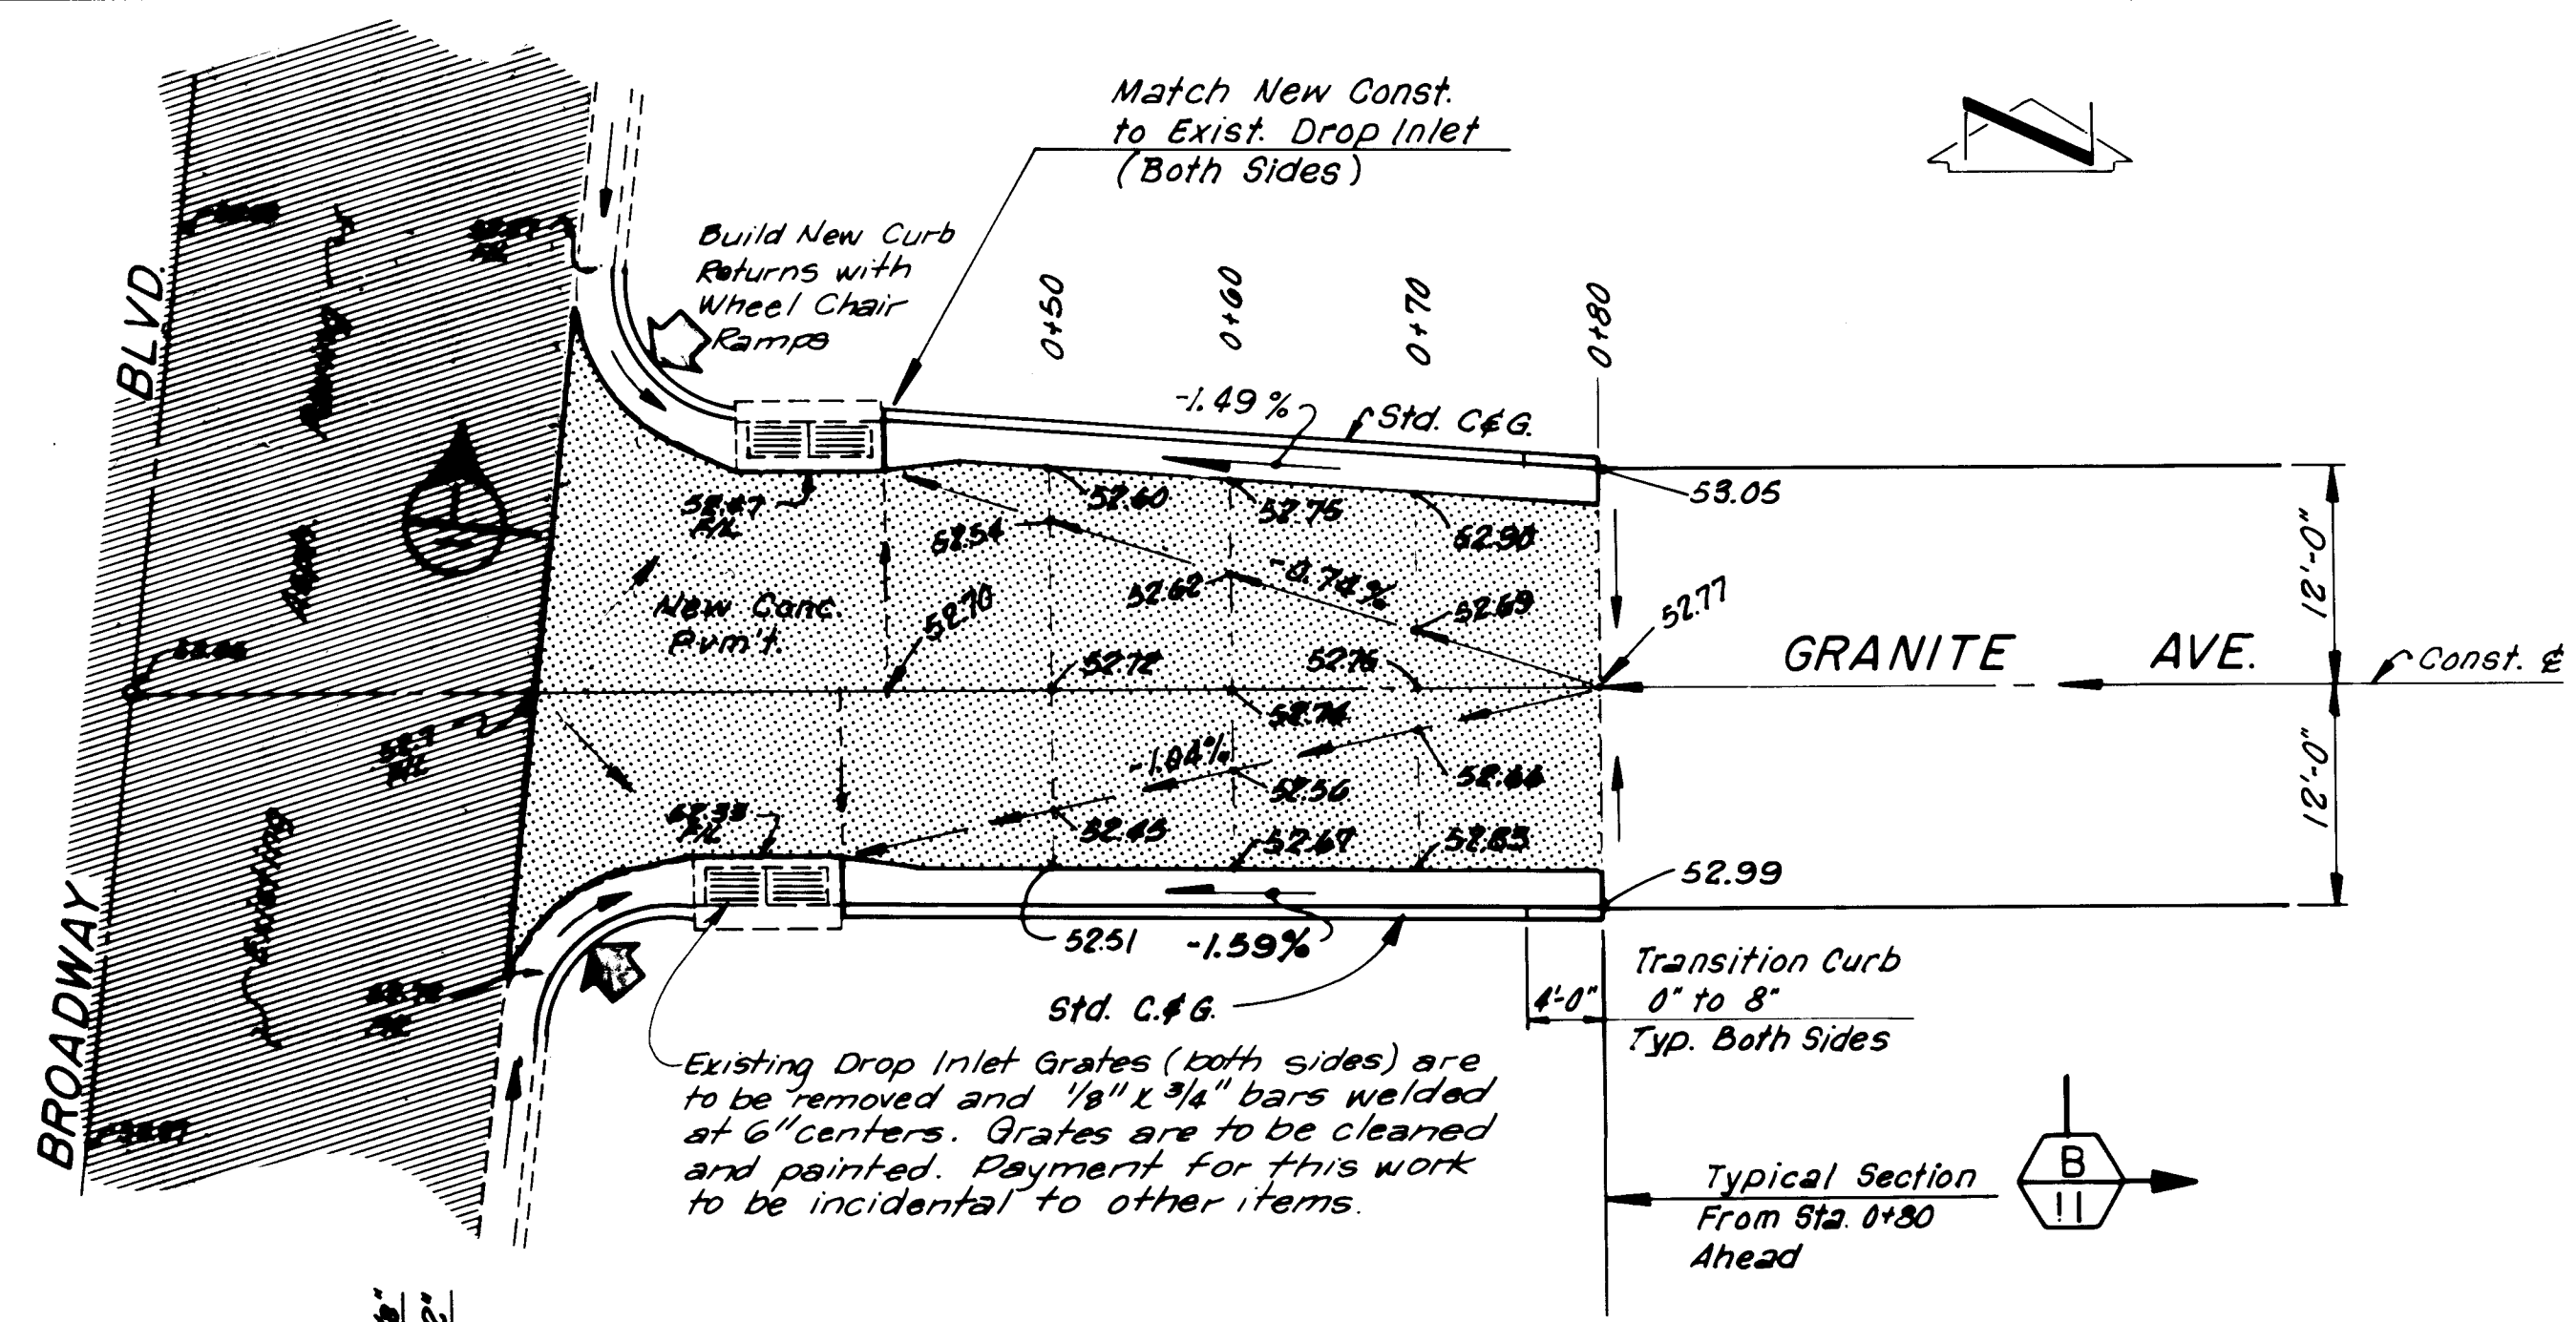


BROADWAY & GRANITE INTERSECTION — PLAN
Scale: 1" = 10'-0"

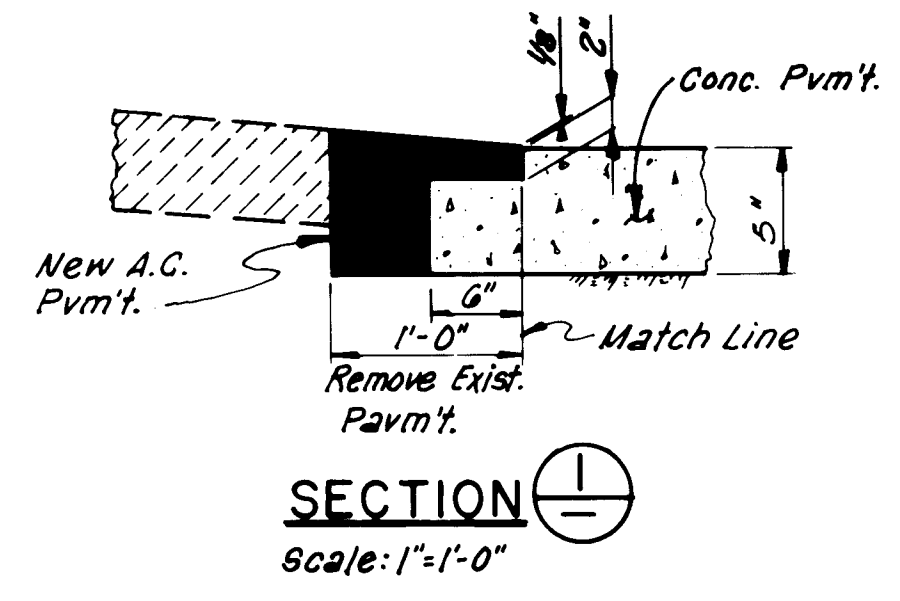

SECTION 1
Scale: 1" = 1'-0"

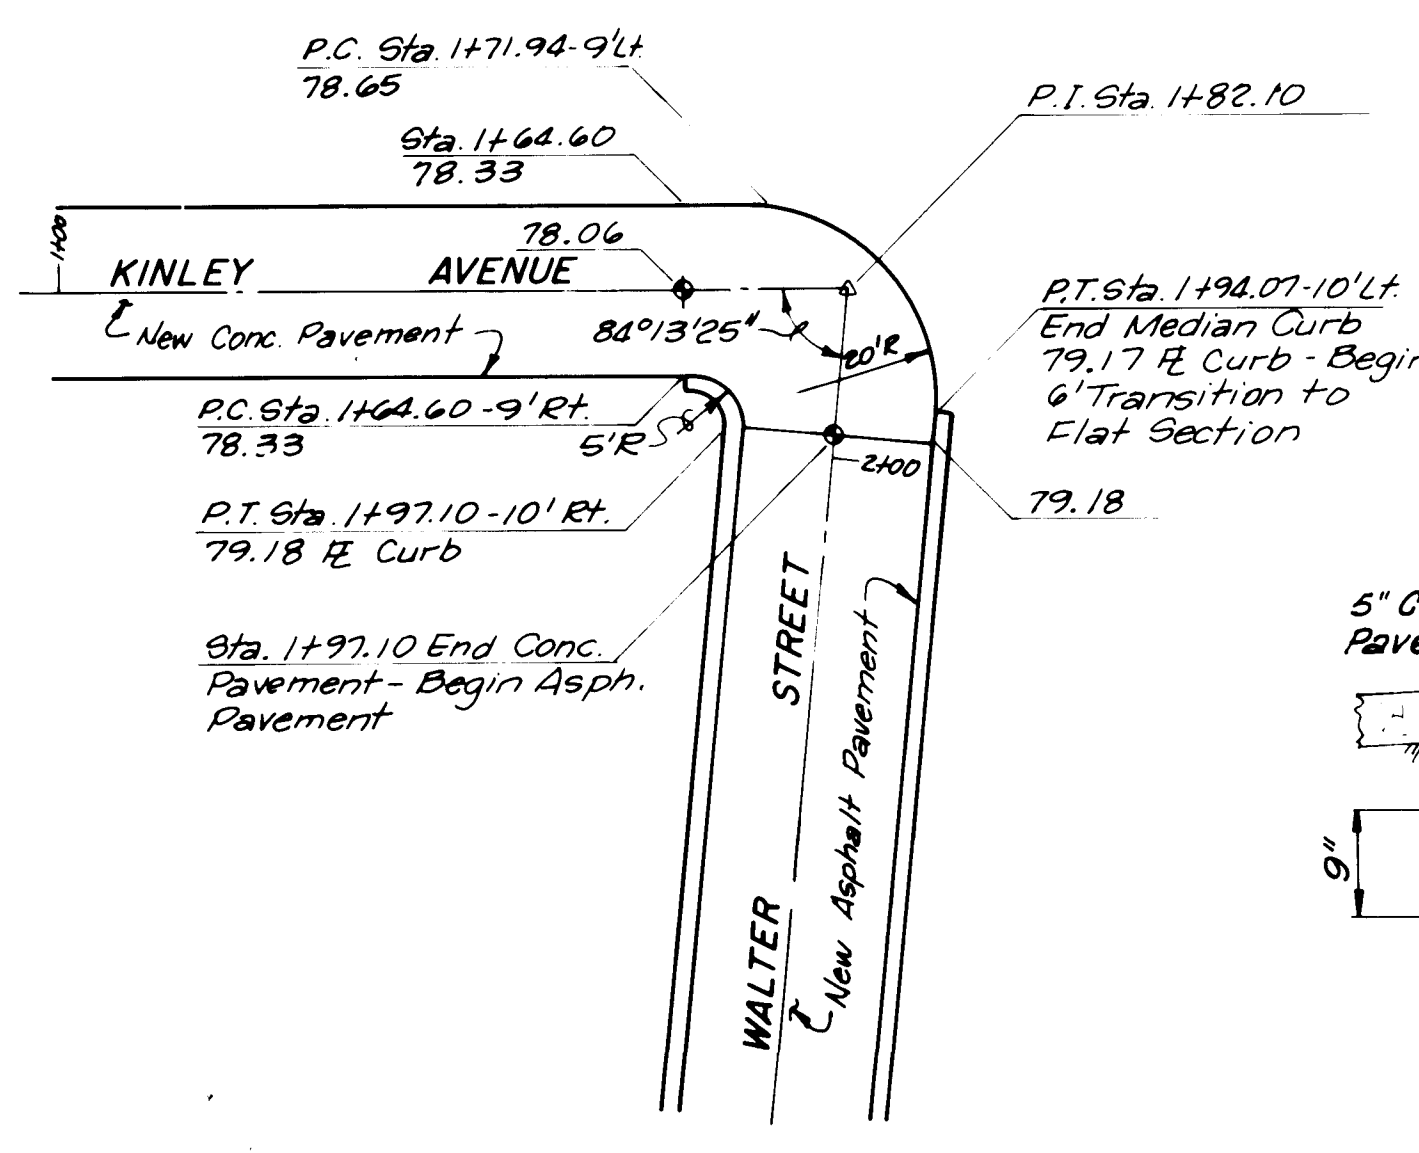


KINLEY & WALTER INTERSECTION — PLAN

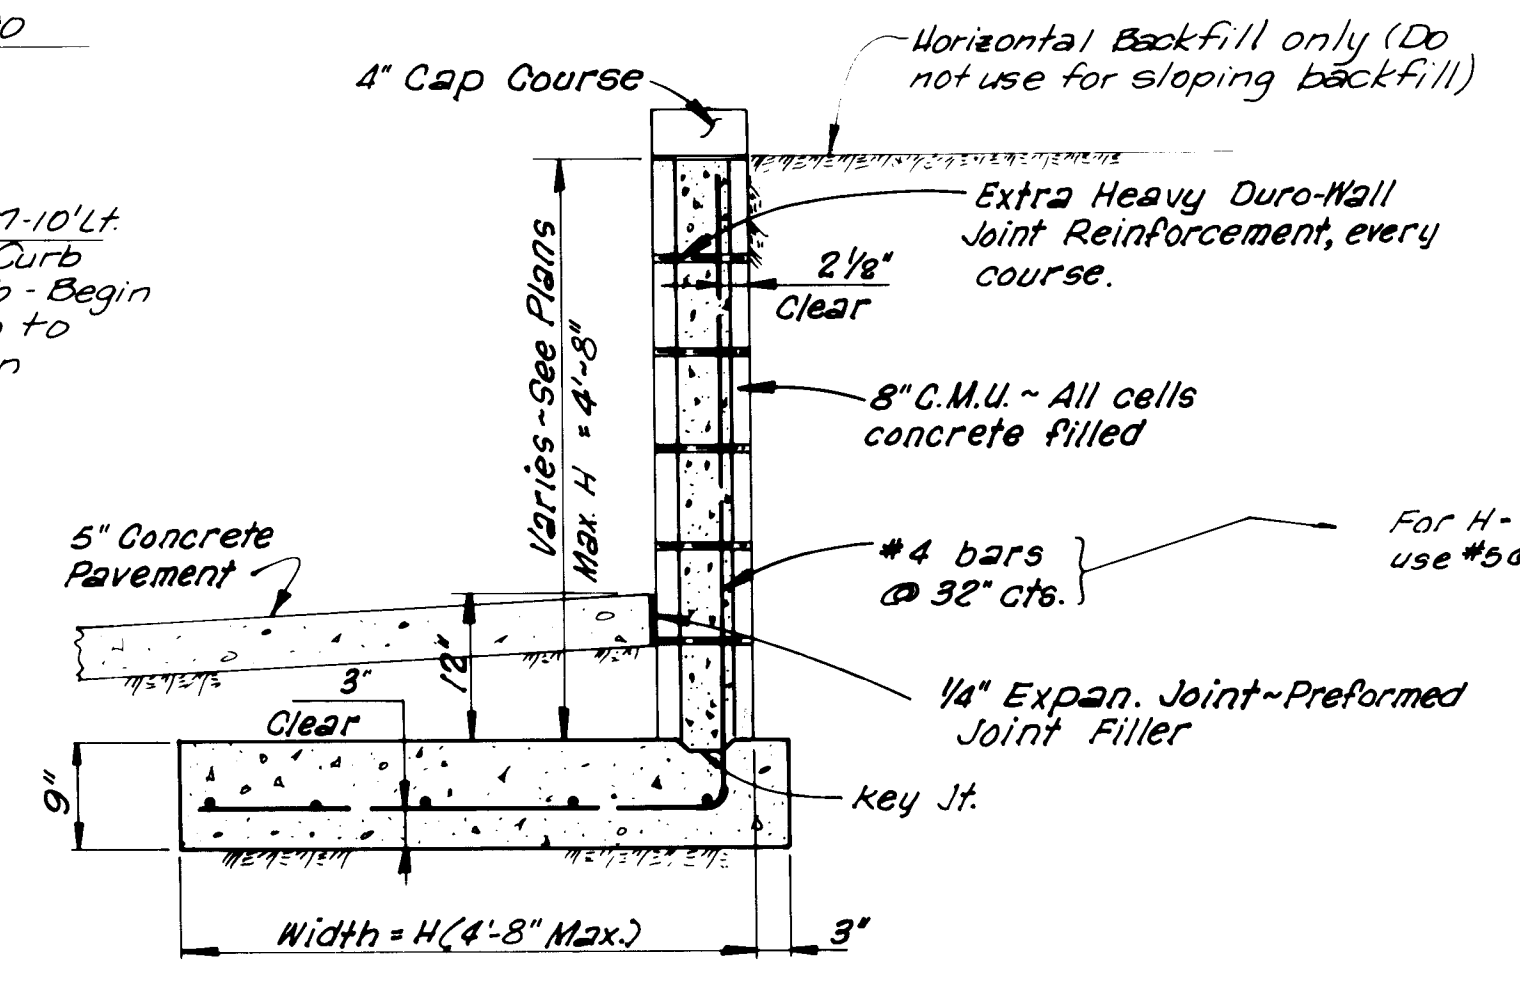


RETAINING WALL SECTION
No Scale


- GENERAL NOTES:**
1. Reinforcing bars should have deformations and a yield strength of 40,000 p.s.i.
 2. Pilasters are not required.
 3. Concrete footing, reinforcing, concrete fill in cells, excavation and backfill to be included in bid price.

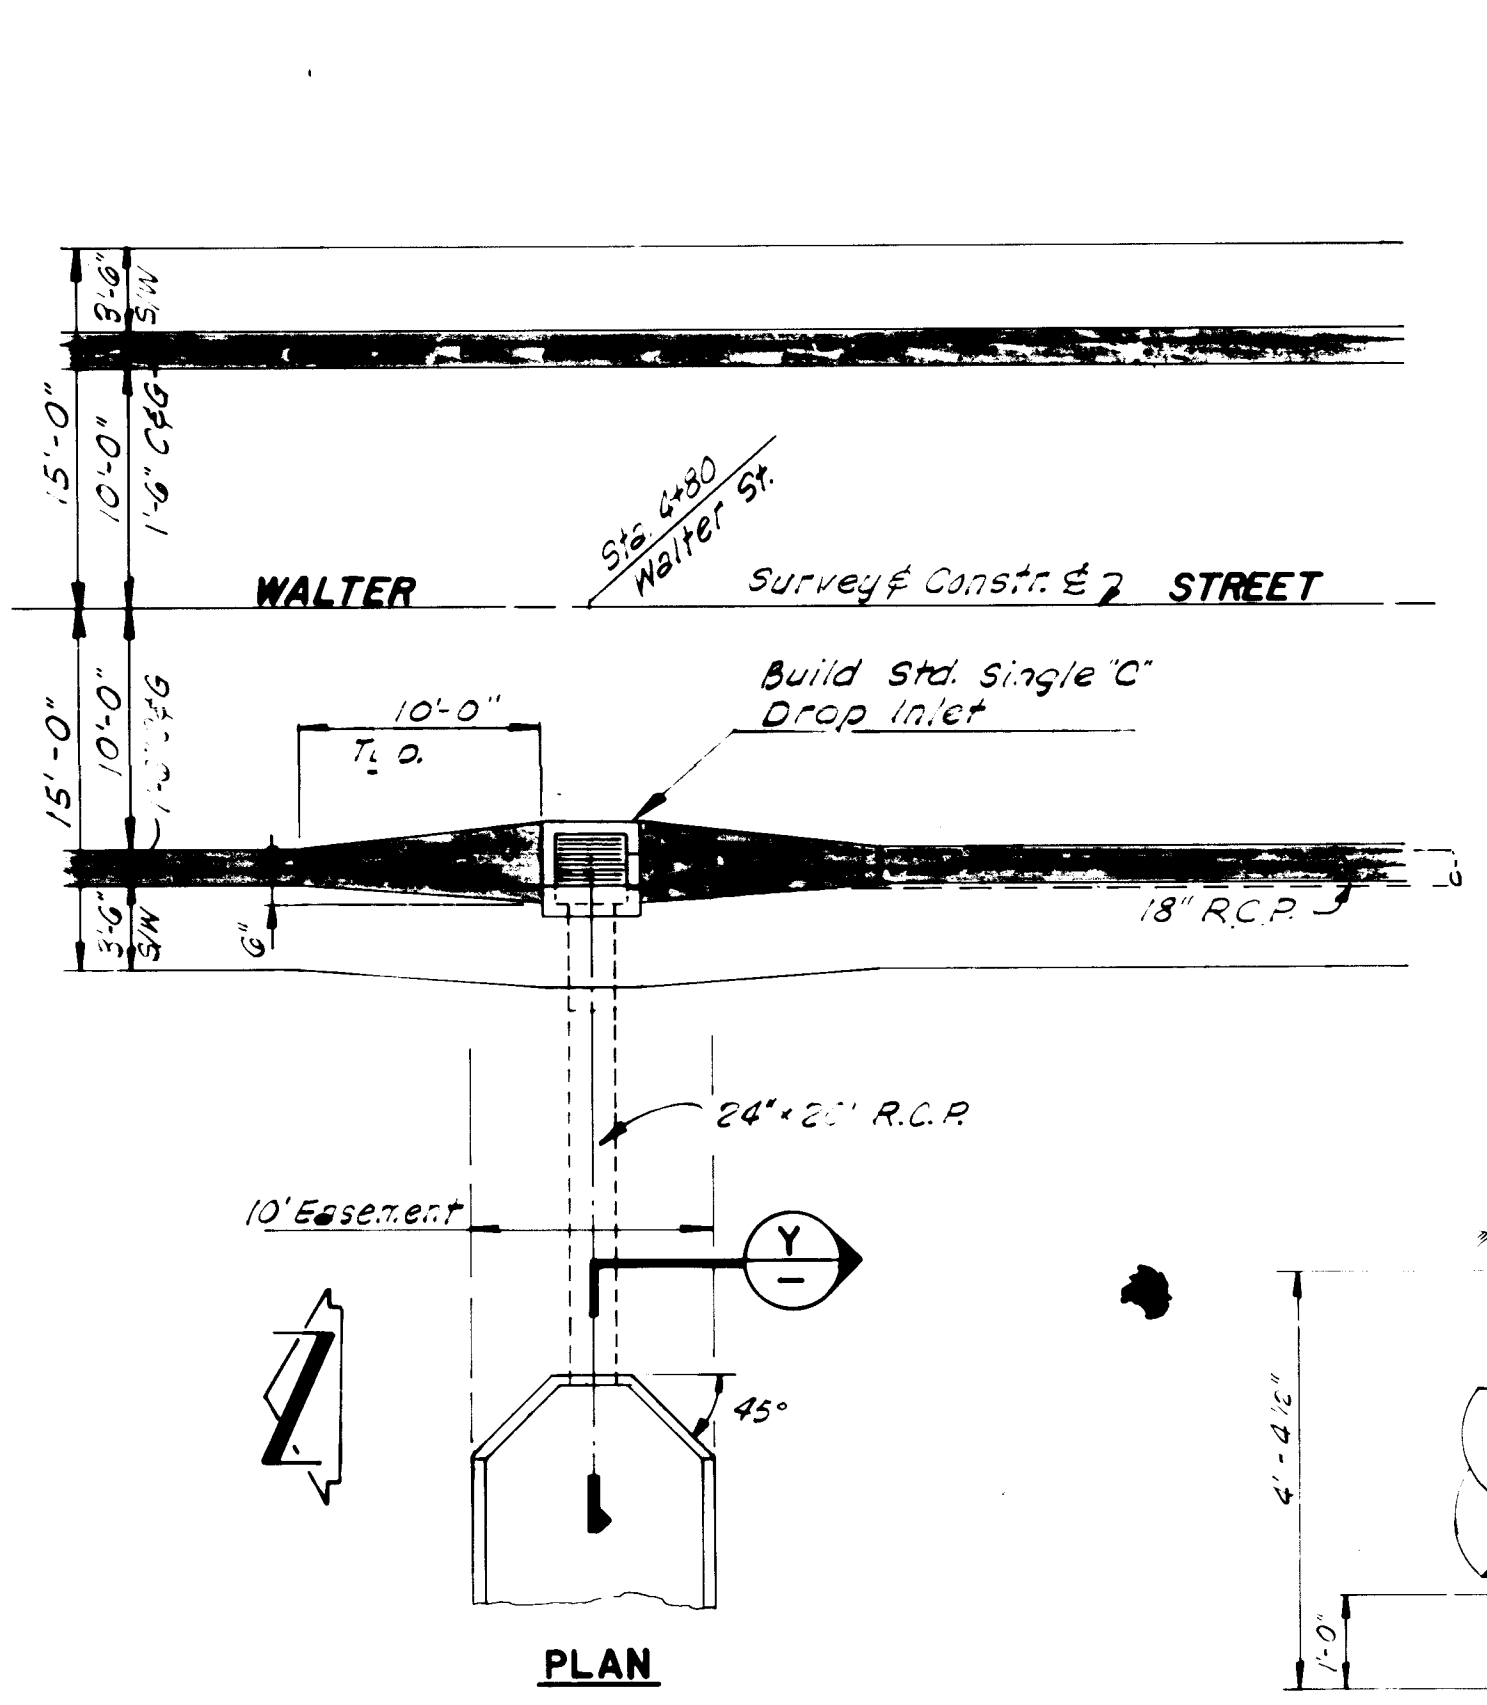


WALTER STREET-DRAINAGE CHANNEL INLET DETAILS

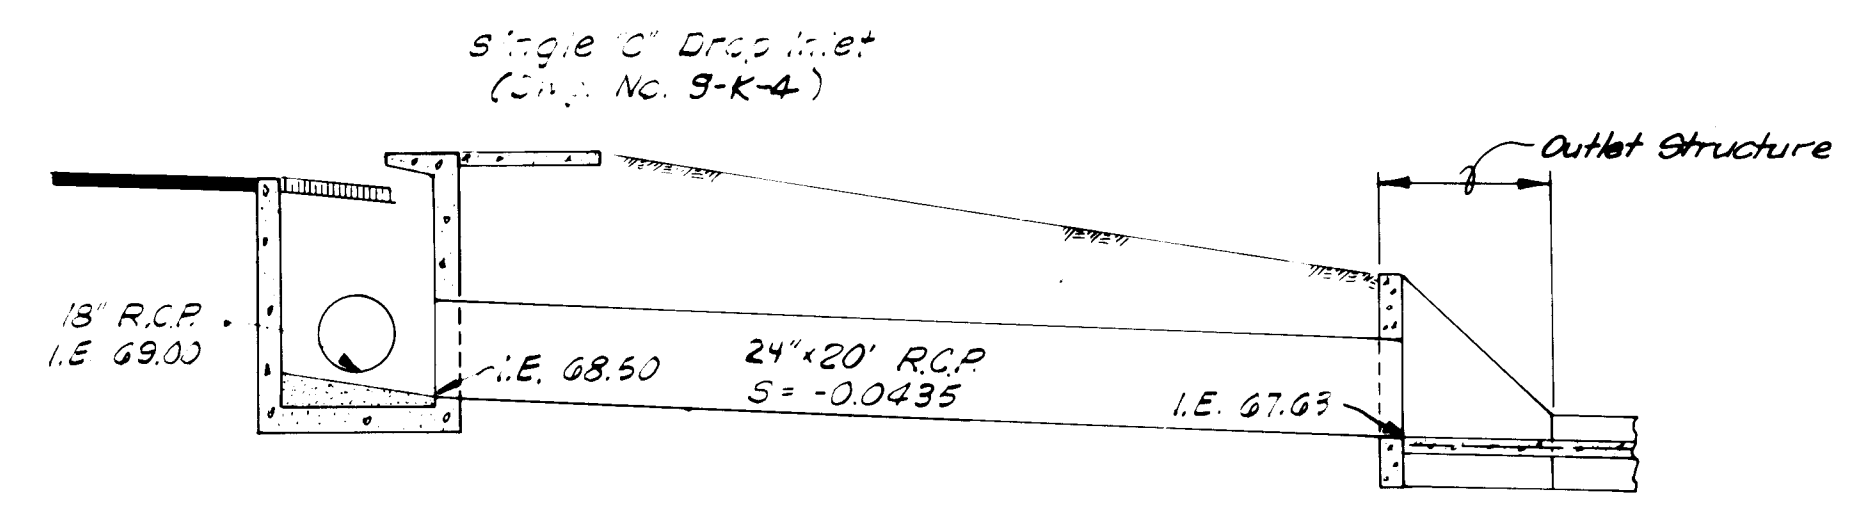

SECTION ALONG C. OF 24" PIPE

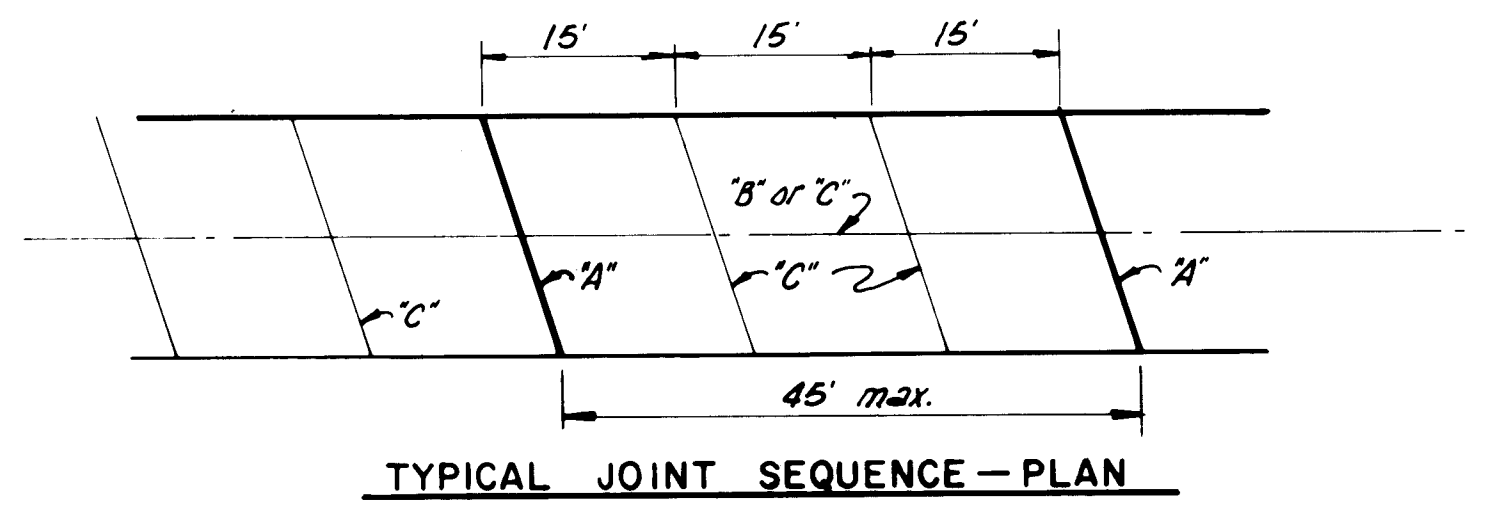

TYPICAL JOINT SEQUENCE — PLAN

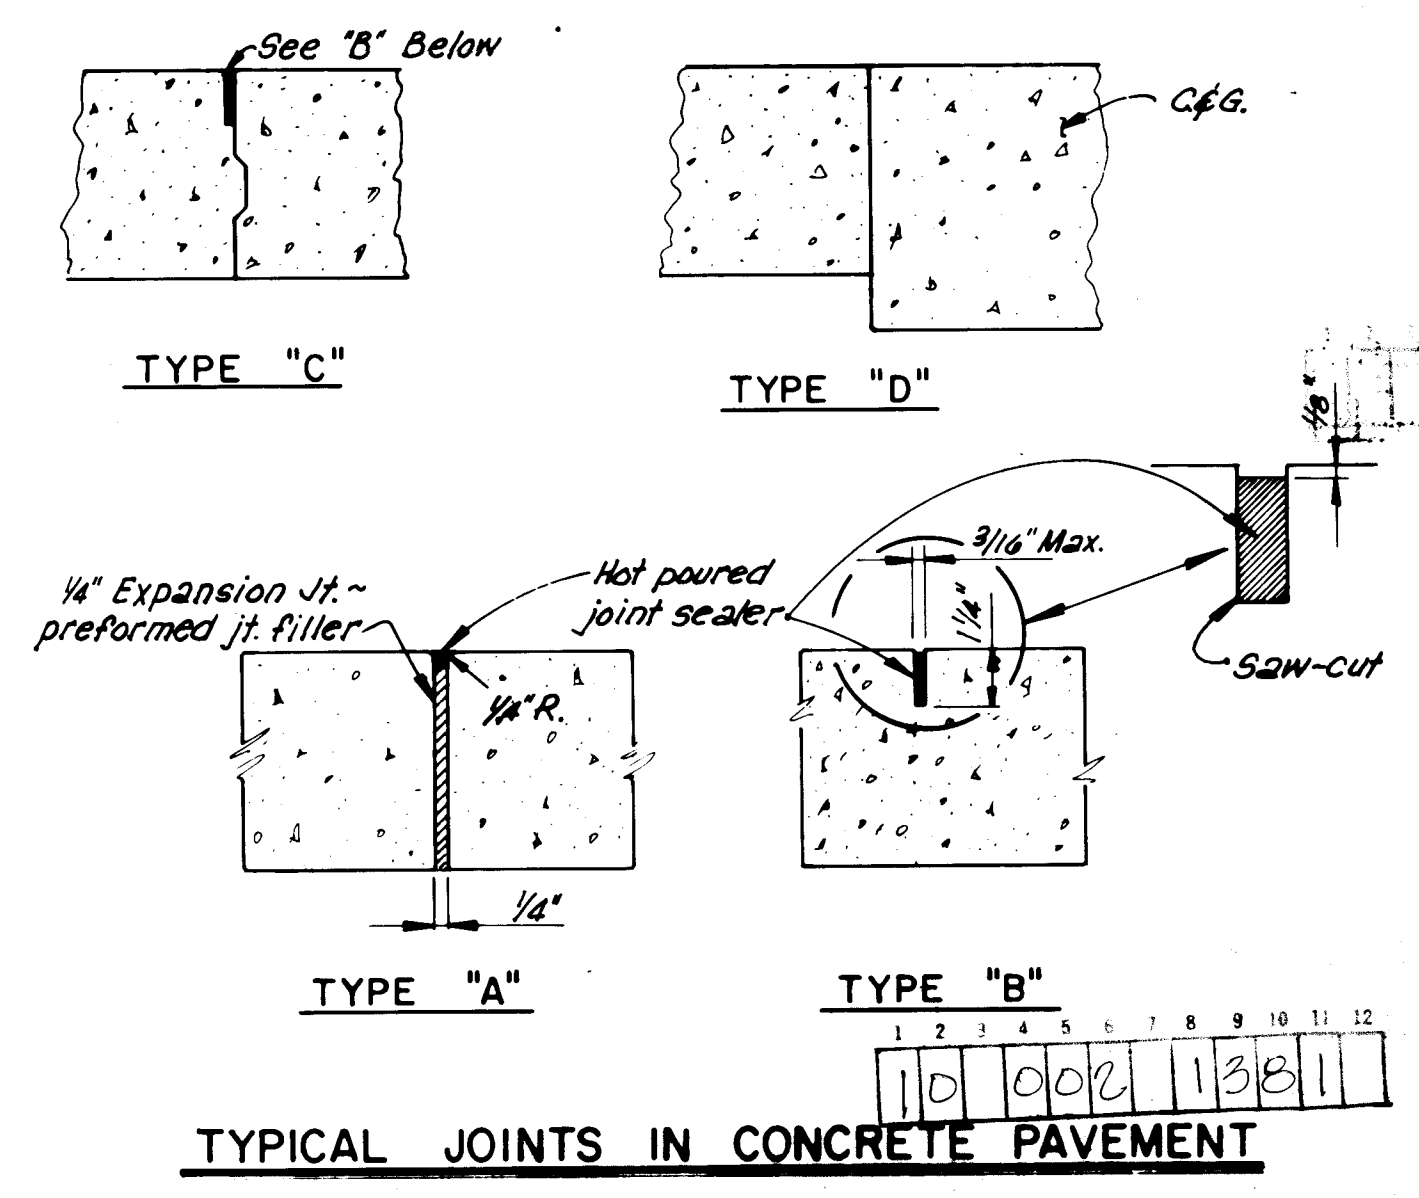

TYPICAL JOINTS IN CONCRETE PAVEMENT


APPROVED FOR AS BUILT DRAWING
ASSIST. CITY ENGINEER - FIELD
DATE: 3-22-81




RECORD DRAWING

ALBUQUERQUE CD-2			
SPECIAL DETAILS			
CITY OF ALBUQUERQUE			
bernadillo	county	new mexico	
DATE 2-78	JOB NO. 77005	SCALE as shown	DRAWN: r.b. SHEET 13 OF 14
Scanlon & associates, inc. Engineers - Planners albuquerque artesia santa fe			

ITEM NO	DESCRIPTION	UNIT	PROJECT TOTAL		ARNO STREET		FRANCISCAN STREET		GRANITE AVENUE		MARBLE PLACE		KINLEY & WALTER		ROSEMONT & STONE		WILLIAM STREET		WHEELER AVENUE		ETHLYN AVENUE				ALLEY N. OF SANTA FE		DRAINAGE EDITH-MARBLE		DRAINAGE EDITH-WALTER	
			ESTIMATE	FINAL	ESTIMATE	FINAL	ESTIMATE	FINAL	ESTIMATE	FINAL	ESTIMATE	FINAL	ESTIMATE	FINAL	ESTIMATE	FINAL	ESTIMATE	FINAL	ESTIMATE	FINAL	ESTIMATE	FINAL	ESTIMATE	FINAL	ESTIMATE	FINAL	ESTIMATE	FINAL	ESTIMATE	FINAL
	PAVING																													
1	GRADING COMPLETE	SY	12950	12553	920	830	250	218	3000	2937	330	316	2450	2499	720	678	4100	3926	400	422					750	727				
2	TYPE II ARTERIAL PAVEMENT	SY	4100	3886													4100	3886												
3	TYPE II RESIDENTIAL PAVEMENT	SY	3670	3574	920	830	250	218					2100	2094				40	400	422										
4	5" CONCRETE PAVEMENT	SY	5250	4980					3100	2937	330	316	350	320	720	678			40	400	422				750	727				
5	CITY STANDARD PAVEMENT PATCH	SY	100	24	10	0			20	20			10	0			50	0	10	0						4				
6	STANDARD CURB & GUTTER	LF	3210	3085	600	557	200	192	85	111			12	18			2000	1107	325	354						32				
7	2'- 6" MOUNTABLE CURB ROLL TYPE	LF	250	209							220	207	30	0																
8	4' GUTTER/SIDEWALK COMB., 4' VALLEY GUTTER	LF	50	219						49			32				50	138												
9	4" CONCRETE SIDEWALK, RAMPS & 6" DRIVEPADS	SY	2360	2033	345	338	50	38		8			900	711			890	735	150	147					15	4	10	1		
10	4" REINFORCED CONCRETE CHANNEL LINING	SY	265	293																						110	110	155	170	
11	REMOVE & DISPOSE OF ASPHALT PAVEMENT	SY	6300	5606					75	0		2	2600	2463			5125	2741	500	400										
12	REMOVE & DISPOSE OF CONCRETE SIDEWALK	SY	275	73									120	0			150	70							15	0	10	1	2	
13	REMOVE & DISPOSE OF CURB & GUTTER ANY TYPE	LF	610	332	35	0			25	0			200	0			270	392	40	0					30	0	10	12	18	
14	RELOCATE OR BUILD NEW WOOD FENCE	LF	190	60					100	0							40	60												
15	RELOCATE OR BUILD NEW MASONRY FENCE	LF	225	53					115	0			60	0			50	53												
16	RELOCATE OR BUILD NEW CHAIN LINK FENCE	LF	415	582	40	34	30	28	125	363			70	0			150	157												
17	RELOCATE OR BUILD NEW WIRE FENCE	LF	305	53	30	30	100	23					100	0			75	0												
18	REGRADE EXIST. MANHOLE - EXIST. FRAME & COVER	EA	21	22	1	1	1	1	2	2	1	1	3	3	1	1	12	13												
19	REGRADE EXIST. MANHOLE - NEW FRAME & COVER	EA	6	7					1	1							4	6	1	0										
20	REGRADE EXISTING VALVE BOX	EA	11	5					1	0			4	0			5	4	1	1										
21	8" CMU RETAINING WALL	VSF	1110	1035	75	48			960	980			75	0				7												
22	2'-0" CUT-OFF WALL	LF	730	324			25	25	165	183																30		510	0	
23	6" CLASS II CRUSHED AGGREGATE BASE COURSE	SY	1200	718										211							1200	707								
24	1'-6" STANDARD MEDIAN CURB & GUTTER	LF	1875	1855									875	1855																
25	REMOVE EXISTING PLANTER (215 ARNO)	EA	1	1	1	1																								
26	EMPTY & REMOVE EXISTING CESSPOOL (STONE ST.)	EA	1	1		1									1	0														
27	EXTRUDED ASPHALT CURB - INCLUDES TACK COAT	LF	135	0													135	0												
28	DRAINAGE CHANNEL OUTLET ON EDITH	EA	2	2								1	1	1	1															
	WATER																													
29	FURNISH & INSTALL NEW 6" WATER LINE	LF	1880	1232	325	332	110	100	1065	212	210	210			170	164														
30	FURNISH & INSTALL 6" WATER VALVE	EA	4	2	2	2	1	0		2	1	1																		
31	FURNISH & INSTALL 6" TAPPING GATE VALVE	EA	3	1					1	1					2	0														
32	FURNISH & INSTALL WATER VALVE BOX	EA	7	2	2	2	1	1	1	1	1	1			2	1														
33	FURNISH & INSTALL SIDEWALK TYPE METER BOX	EA	27	36	5	8	2	0					6	12			13	15	1	1										
34	FURNISH & INSTALL DRIVEWAY TYPE METER BOX	EA	37	39	2	3	1	1	14	23	3	4	2	1	4	3	5	3		1					1	0				
35	REPLACE OR INSTALL NEW WATER SERVICE LINE	EA	33	43	6	11	2	1	10	18	3	4	2	6	2	1	8	2												
36	METER RELOCATION, ANY TYPE	EA	25	31	1	0			4	5			6	6	2	2	10	16	1	2					1	0				
37	WATER SERVICE ABANDONMENT	EA	5	4					1	2		1	2				2	1												
38	LOWERING AND/OR RELOCATION OF 6"-8" WATER LINE	LF	300	240									100	240			200	0												
39	INSTALL NEW FIRE HYDRANT	EA	2	2	1	1			1	1																				
40	RELOCATE EXISTING FIRE HYDRANT	EA	2	3										1	1	1	1	1												
41	WET CONNECTION	EA	4	1	1	0	1	0	1	2	1	0		6		6														
42	BACKFILL & COMPACT PRIVATE UTILITY TRENCH	LF	300	0					100	0			100	0			100	0												
43	6" TAPPING SLEEVE ON 10" AND SMALLER	EA	3	9					1	9					2	8														
	SEWER																													
44	FURNISH & INSTALL 8" DUCTILE IRON SEWER LINE	LF	481	457																481	457									
45	FURNISH & INSTALL 18" DIA. CLASS III RCP	LF	566	561													6	4									560	557		
46	TRENCHING & BACKFILLING FOR 8" SEWER LINE	LF	481	457																481	457									
47	TRENCHING & BACKFILLING FOR 18" SD LINES	LF	566	561													6	4									560	557		
48	REPLACE OR INSTALL NEW SEWER SERVICE LINE	EA	43	28	2	0	2	0	10	11	2	2	6	2	3	0	10	1			7	12			1	0				
49	ABANDON EXISTING SANITARY SEWER SERVICE LINE	EA	5	0					2	0			1	0			2	0												
50	BUILD 4' DIA. MANHOLE 0 - 6' DEPTH	EA	4	4	1	1														3	3							0		
51	EXTRA DEPTH FOR 4' DIA. MANHOLE	VF	5	2		1														5	1							0		
52	SINGLE "C" DROP INLET	EA	4	4													1	1									5	2		
53	OUTLET STRUCTURE COMPLETE ON WALTER	LS	65	65																							65			
	LANDSCAPING																													
54	FURNISH & INSTALL REPLACEMENT TREE	EA	3	1					1								2	1												
55	RELOCATE EXISTING TREE	EA	5	1	2	1			1	0							2	0												
56	REMOVE & DISPOSE OF EXISTING TREE	EA	6	6			1	3	3	0							2	3												

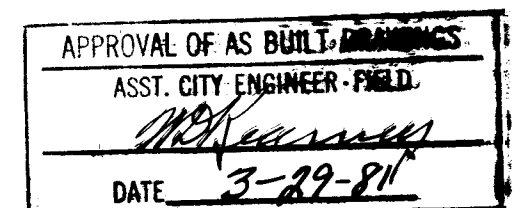

RECORD DRAWING

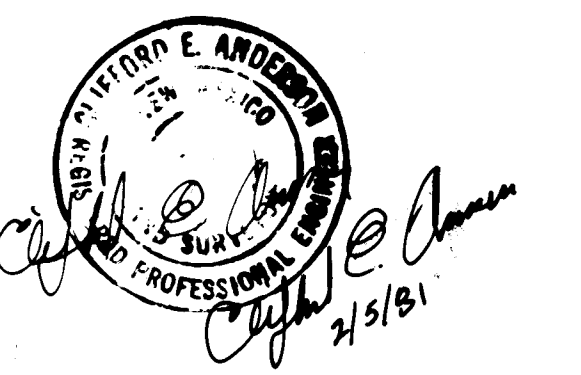

1 2 3 4 5 6 7 8 9 10 11 12
10 10 0 0 1 4 8 1 1

Quantities 11/24/80 Revised 12/11/80

ALBUQUERQUE CD-2

SUMMARY OF QUANTITIES

CITY OF ALBUQUERQUE

bernalillo county new mexico

DATE 4-78	JOB NO. 77005	SCALE N.A.	DRAWN: L.H. CHK'D: R.B.	SHEET 14 OF 14
--------------	------------------	---------------	----------------------------------	-------------------------

Scanlon & associates, inc.
albuquerque engineers-planners artesia santa fe

SCANNED BY
BY LASON