
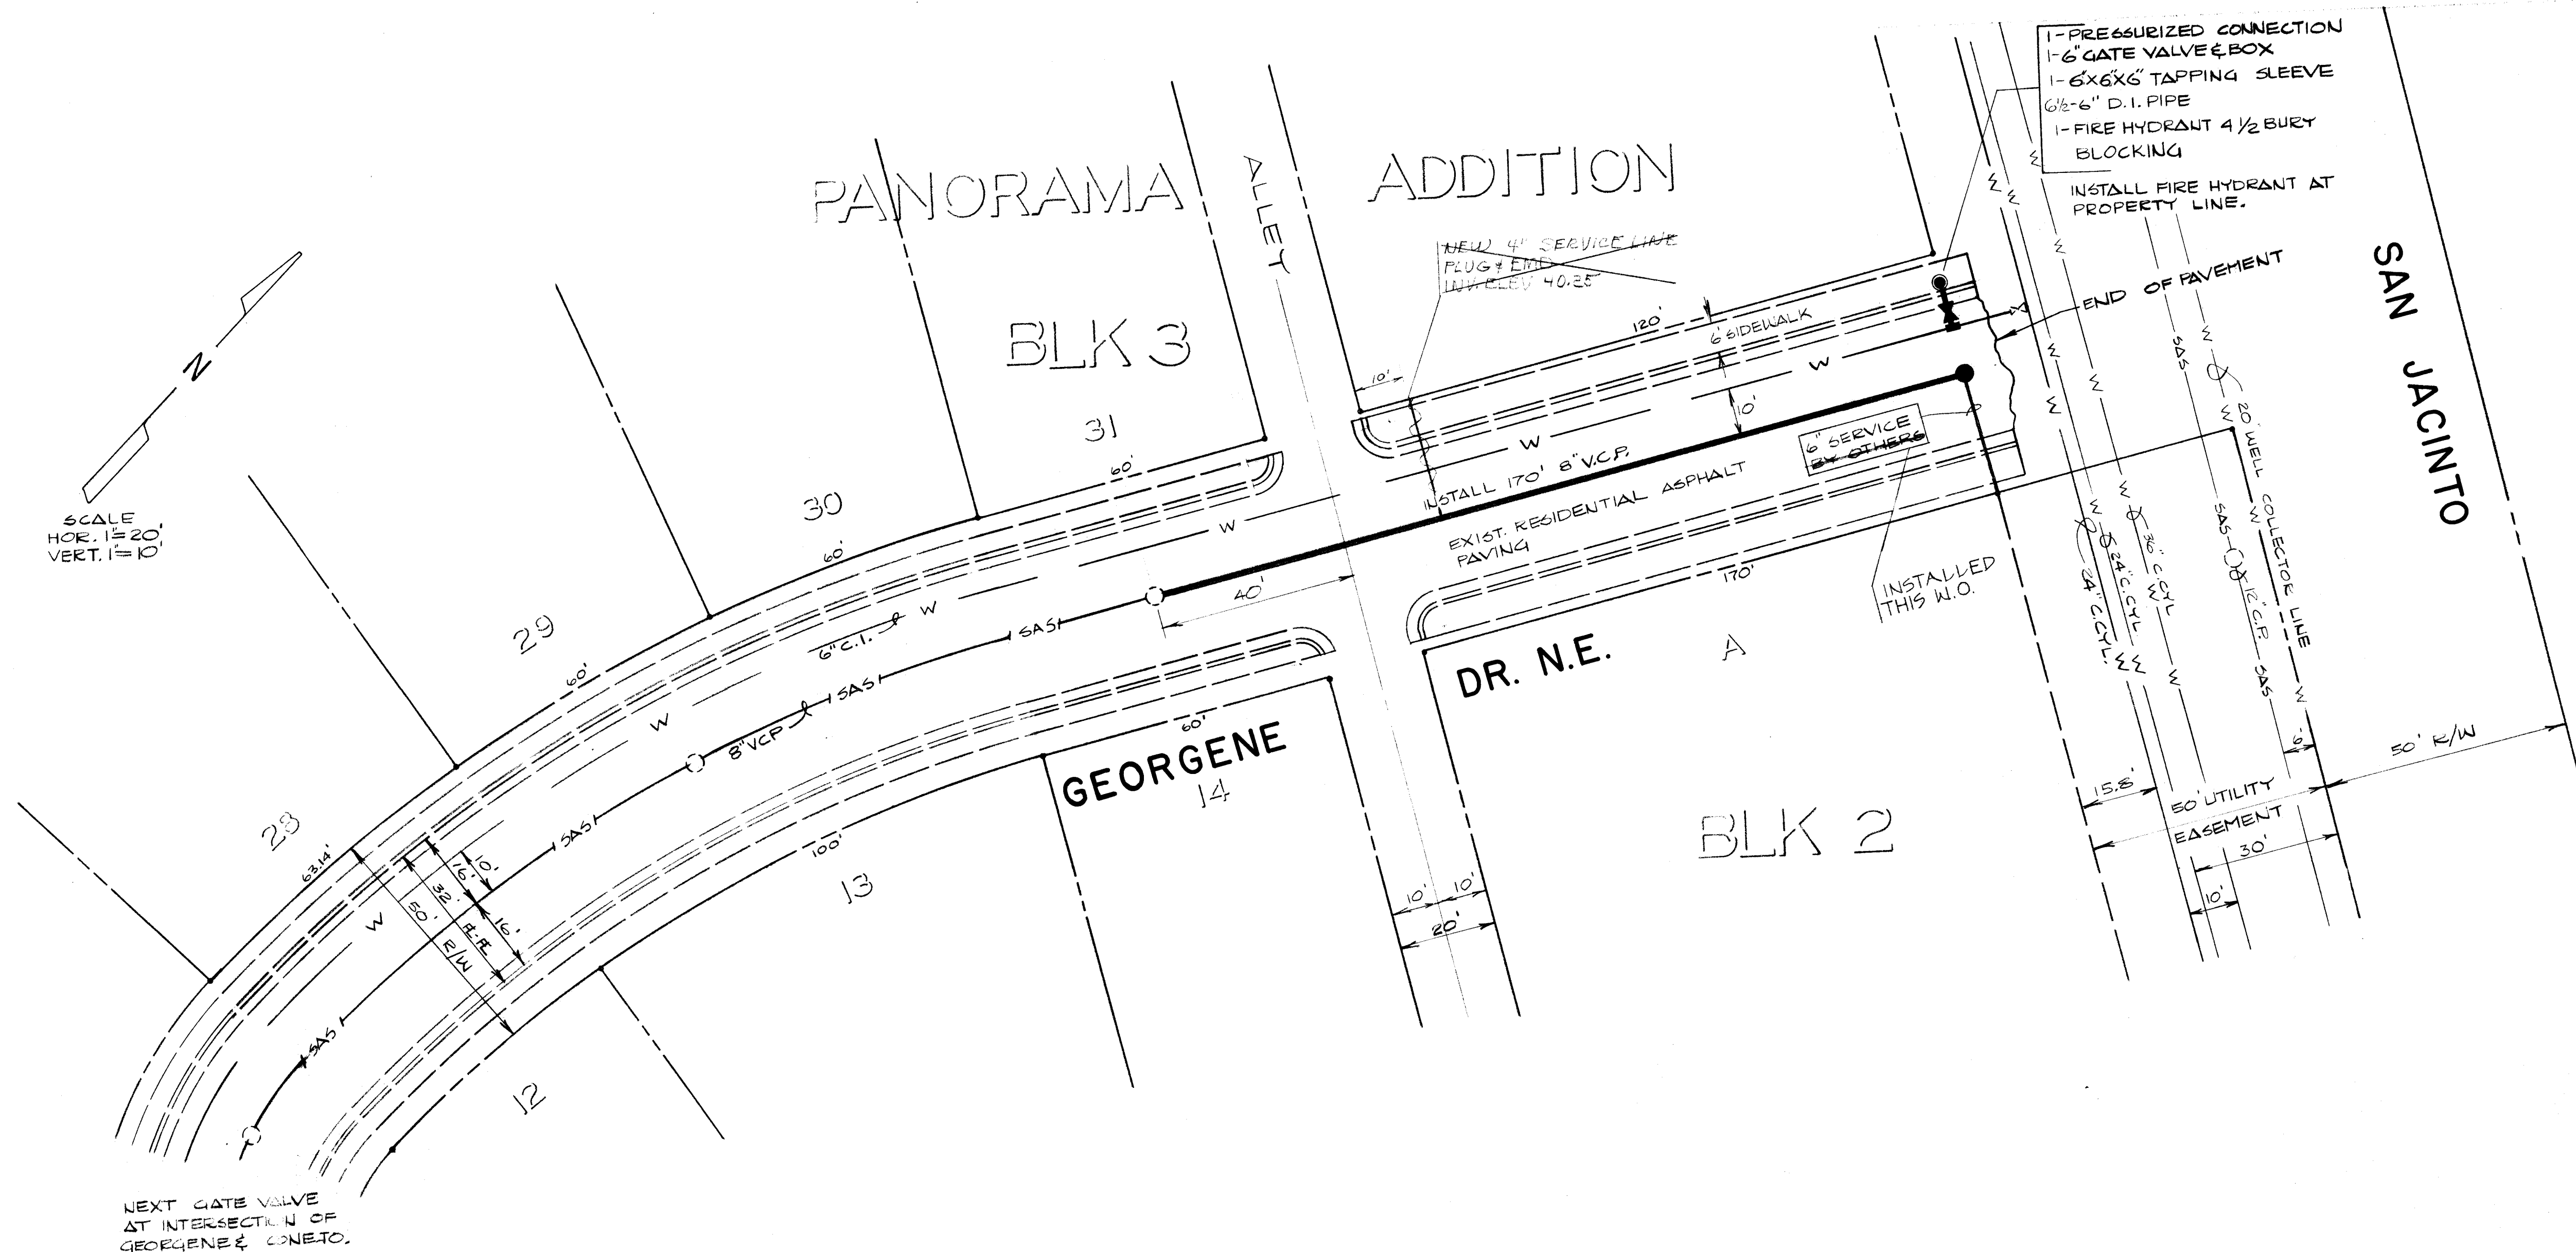


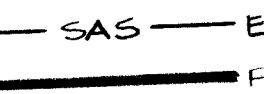

LEGEND:


- 
 — SAS — EXIST. SANITARY SEWER
 PROP. SANITARY SEWER
 EXIST. MAN HOLE
 PROP. MAN HOLE
 EXIST. CURB & GUTTER
 — W — EXIST. WATER LINE

NOTE: ALL WATER PIPE IS P.I.
ALL SAS IS 8" V.C.P.

4-K-22 ELEV. 5637.90

P.S-ZI M. GONZALES
C. LYCERO
C. ANGEL

P. FISCHER

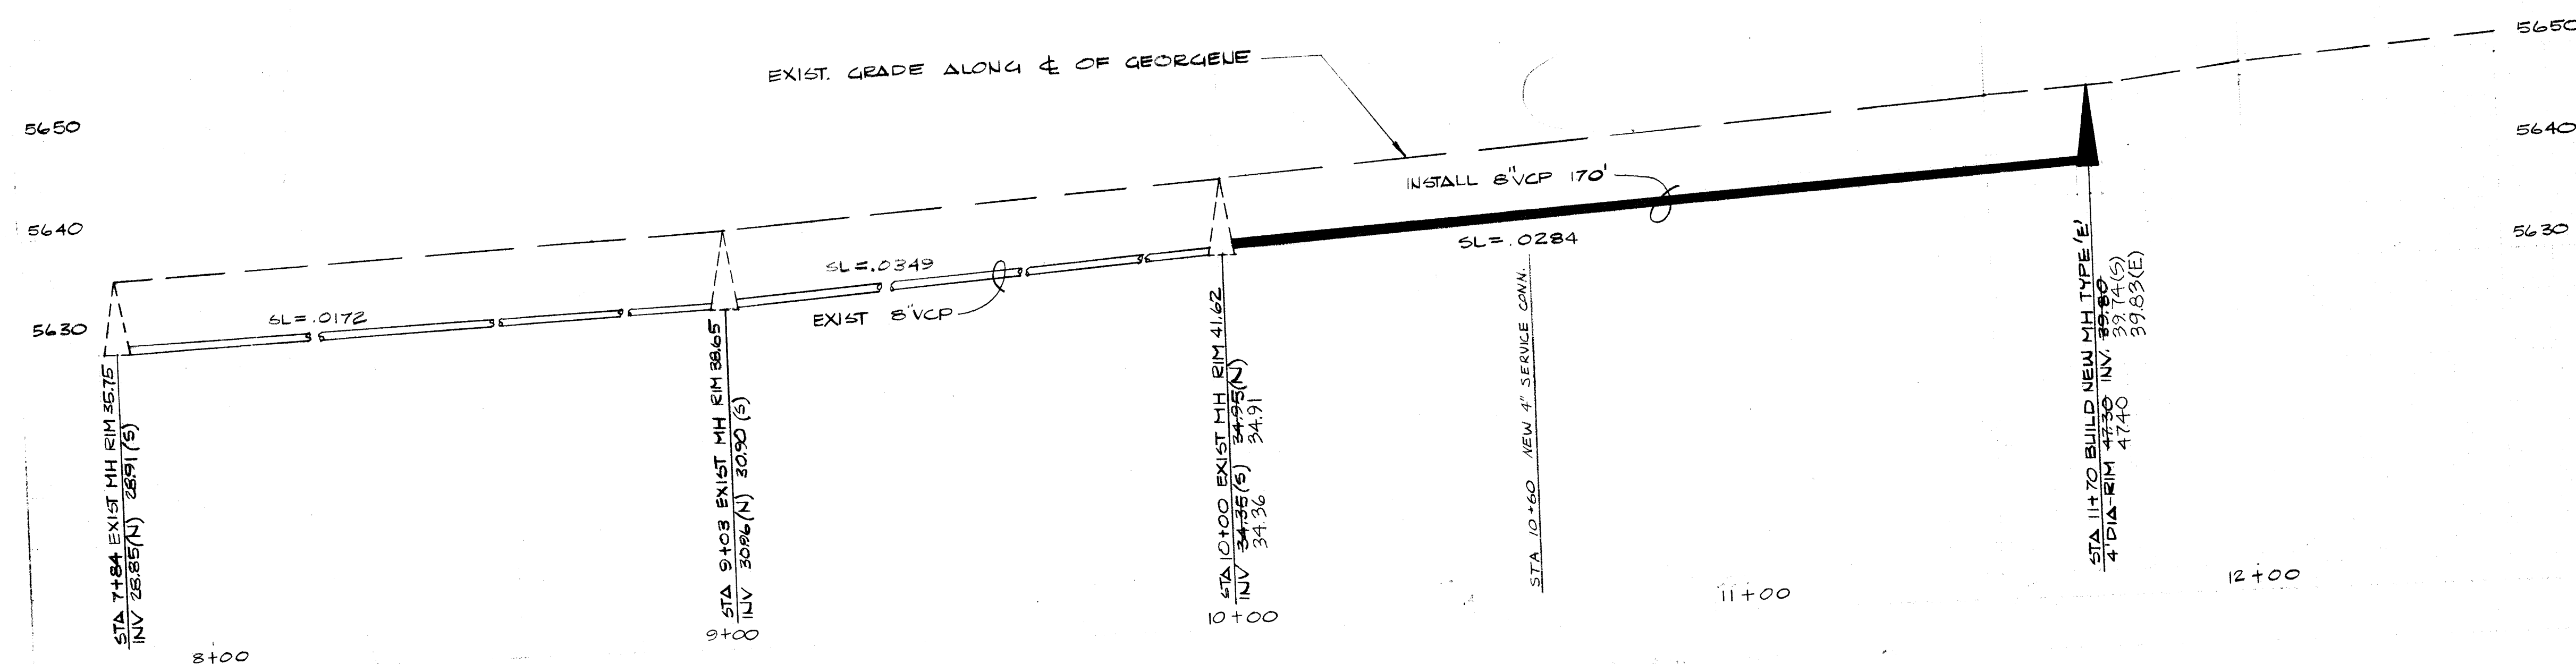

26.	1	0	0	2	0	1	8
-----	---	---	---	---	---	---	---

APPROVAL OF AS BUILT DRAWING:
ASST. CITY ENGINEER-FIELD
[Signature]
DATE 11-9-81

SANITARY SEWER EXTENSION ON GEORGENE DR. N.E.
AT SAN JACINTO, & FIRE HYDRANT.

P7. *R. S. Kelly* 3/3/87
J. R. Kelly 23 Feb

D Monahan 2/25/81
K Monahan 2/25/81

1002

K-22

12 12