
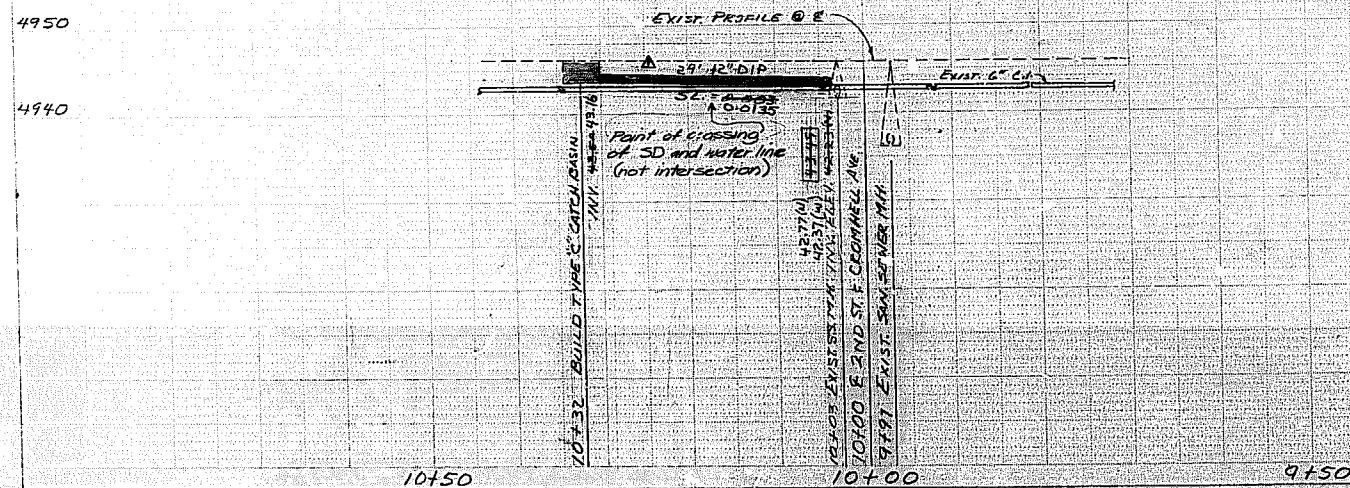


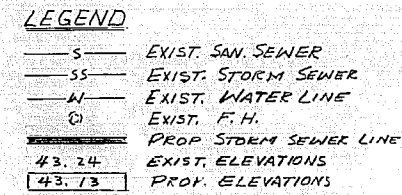

1	2	3	4	5	6	7	8	9	10	11	12
2	0		1	0	0	3	0	2	8	2	

RECEIVED
FBI - NEW YORK
JAN 27 1982
5-27-82

CITY OF ALBUQUERQUE
MUNICIPAL DEVELOPMENT DEPARTMENT
ENGINEERING DIVISION

TITLE: 2ND & CROMWELL S.W.
CATCH BASIN REPLACEMENT

APPROVALS	ENGINEER	DATE	APPROVALS	ENGINEER	DATE
City Engineer	<i>[Signature]</i>	4/10/81	Liquid Waste	<i>[Signature]</i>	4/2/81
A.C.E. - Design Svt.	<i>[Signature]</i>	3/24/81	Traffic		
A.C.E. - Hydrology	<i>[Signature]</i>	4/1/81	Water	<i>[Signature]</i>	4/2/81

DRAWING NO.	1003	MAP NO.	K-14	SHEET	2	OF	2
-------------	------	---------	------	-------	---	----	---

AS BUILT INFORMATION
NORTH
EAST
SOUTH
WEST
FCC AT 108.9°
DRAWING:
CORRECTED BY
MICRO-FILM INFORMATION
DATE
BY
7

DEATH MARKS

10-K-14 SQ. CUT SOUTH SIDE OF DRIVEWAY W. OF
2ND ST. FRONT OF HOUSE NO. 1207
ELEV. 4945.95

ENGINEER'S SEAL	SURVEY INFORMATION	
	NO. BY	DATE
	1008	1-29-81
	M. GONZALES	

Δ	8-24-81	Change 5" RCT Pipe to 12" DI	L.C.
NO	DATE	REMARKS	BY
<i>REVISIONS</i>			
DESIGN			
DESIGNED BY	S. MIRANDA	CHECKED BY	DATE
DRAWN BY	T. SANCHEZ	CHECKED BY	DATE

