

CITY OF ALBUQUERQUE, NEW MEXICO

INDEX

DESCRIPTION	SHEET NO.
COVER SHEET	1
GENERAL NOTES, LEGEND & ABBREVIATIONS	2
SEQUENCE OF CONSTRUCTION	3 - 4
PLAN & PROFILE - LINES B & E	5
PLAN & PROFILE - LINES F & G	6
PLAN & PROFILE - LINE H	7 - 8
TRAFFIC CONTROL	9 - 10

STEEL WATER LINE REPLACEMENT

PHASE IA


LASON 1-505-344-9404
BEST COPY AVAILABLE

CENTRAL AVENUE

PINE STREET TO UNIVERSITY BOULEVARD

Set Number _____


Job Number 79038

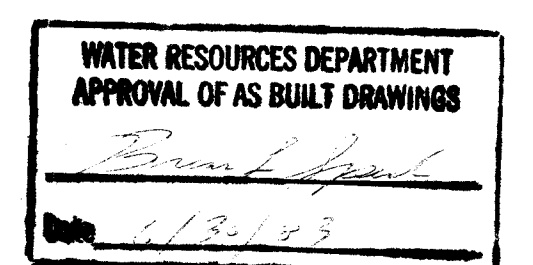

26 1/10/19 9/18/3

Richard S. Hall 1/13/81
City Engineer

David R. Brosnan
Project Engineer

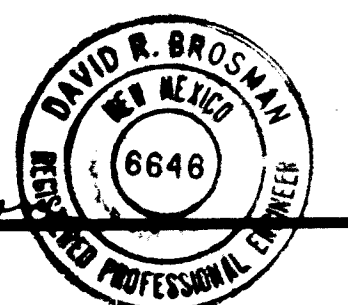

RECORD DRAWING



SCANLON ASSOCIATES
CONSULTING ENGINEERS

1010

LEGEND


CURB AND GUTTER
LAYDOWN CURB, DRIVE PAD
SIDEWALK
MASONRY WALL
TREE
PARKING METER
BENCH MARK
GAS VALVE
WATER METER (EXISTING)
CATCH BASIN
STREET LIGHT, LUMINAIRE
PULL BOX
PEDESTAL POLE WITH SIGNAL
UTILITY POLE
FIRE HYDRANT (EXISTING)
STORM DRAIN MANHOLE
WATER VALVE
SANITARY SEWER MANHOLE
ELECTRIC MANHOLE
TELEPHONE MANHOLE
GAS METER
TELEPHONE BOOTH
SIGN
NEW WATER VALVE
NEW REDUCER
NEW CAP OR PLUG
LAYDOWN VALVE
SURVEY LINE
RIGHT - OF - WAY
EXISTING WATER LINE
EXISTING GAS LINE
EXISTING STORM DRAIN
EXISTING SANITARY SEWER
EXISTING TRAFFIC CONTROL
EXISTING TELEPHONE
NEW WATER LINE
SOIL BORING

NOTE: SHADED AREAS INDICATE WHERE THE ENGINEER HAS EXCAVATED LINES TO VERIFY LOCATIONS.

NEW FIRE HYDRANT
NEW WATER METER

ABBREVIATIONS

BFV BUTTERFLY VALVE
BOC BACK OF CURB
CCP CONCRETE STEEL CYLINDER PIPE
C & G CURB AND GUTTER
CI OR CIP CAST IRON PIPE
CL CENTER LINE
CMP CORRUGATED METAL PIPE
DI DUCTILE IRON PIPE
E ELECTRICAL
ELEV. ELEVATION
EXIST. EXISTING
G GAS
GV GATE VALVE
H.P. HIGH PRESSURE
I.E. INVERT ELEVATION
INV. INVERT
LT. LEFT
RCP REINFORCED CONCRETE PIPE
RT. RIGHT
R/W RIGHT - OF - WAY
S SEWER
SD STORM DRAIN
SL SURVEY LINE
STA. STATION
STL. STEEL
T TELEPHONE
T.C. TRAFFIC CONTROL
T.S. TRAFFIC SIGNAL
VCP VITRIFIED CLAY PIPE
VPI VERTICAL POINT OF INTERSECTION
W WATER LINE
W.L. WATER LINE
W.S. WATER SERVICE

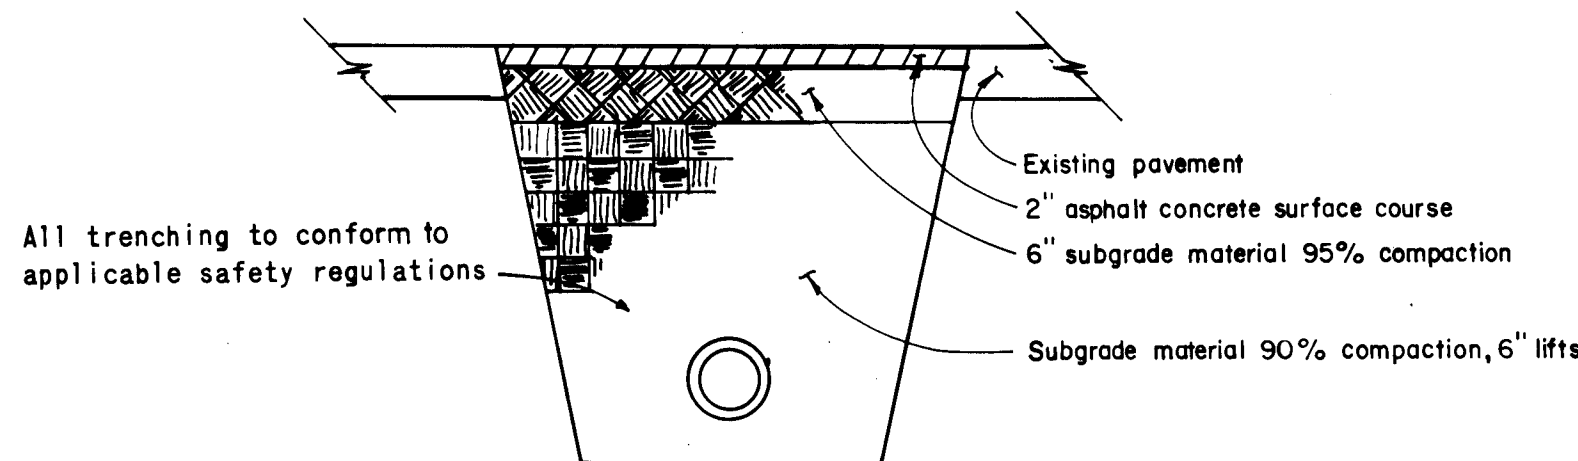


TYPICAL TRENCH DETAIL

(Temporary paving patch to be used for this project)

GENERAL NOTES

- The Contractor shall notify all utility companies when working near their systems and shall have the utility companies locate utilities prior to excavation. Call 765-1234 regarding location of utility lines. Utility companies shall be given 48 hours advanced notice for line locations.
- All existing utilities shown herein were taken as accurately as possible from record drawings and surface indications. It shall be the Contractor's responsibility to protect, maintain in service and verify exact locations of all affected utilities during construction of this project. Not all service lines are shown. Contractor to locate all service lines in advance and give proper notice before shutting off of service. See paragraph 18.3 of the Supplemental General Conditions. Disruption of service shall be for the minimum time possible.
- Temporary relocation of utilities for the Contractor's convenience shall be at his own expense.
- Butterfly Valve installation - All butterfly valves shall be installed in accordance with the standard drawing (in specification) except when attached between two fittings such as an elbow and a reducer. In that case the flange-plain end spool and restrained flexible coupling shall adjoin the next connecting fitting. The spool and restrained flexible coupling may not be called out on the drawings but are a requirement of the butterfly valve installation. The spool and restrained flexible coupling will be provided as an incidental item to the valve installation.
- Existing materials to be removed and paid for on a unit basis shall be measured and quantities approved by the Engineer before removal. Payment for paving, curb and gutter, sidewalks and drive-way pads will be paid for as called for in the specifications.
- Payment for extra depth of trenching will be based on either direct field measurements by the Engineer or by centerline staking of the line by the Engineer at the Engineer's option. Measurement and calculations of depths will be based on depth to the invert of the pipe. No extra payment will be allowed for over excavating even where sand bedding is required.
- Normally closed valves shall have welded valve covers in order to prevent tampering. After acceptance of the lines, the covers shall be tack welded closed. This shall be an incidental item of the valve box installation.
- The sewer line construction called for herein shall be accomplished in a manner that does not interrupt sewer service. All equipment, labor, and material necessary to accomplish this goal shall be at the Contractor's expense and shall be paid for as per the unit items in the proposal. All new sewer lines shall be laid on same grade as existing.
- Special attention is called to the sequence of construction of the project, traffic control requirements and liquidated damages. The Contractor shall meet all requirements of the specifications and plans concerning these items. The cost necessary to meet the sequence of construction and traffic control requirements will be paid as unit price items and will not be subject to extra compensation regardless of the length of time the project takes.
- The Contractor shall be fully responsible for notifying and working with the owners of other utilities and shall be solely responsible for coordinating his activities with those of the utility owners.
- The Contractor shall perform all necessary exploratory excavations prior to submittal of associated shop drawings and well in advance of ordering pipe material. The pipeline has been laid out to maintain uniform upward sloping grades west to east as much as possible and avoid conflicts. Some existing line elevations have been field verified (shown on drawings in shaded areas) and the remaining line elevations are from recorded drawings. It is desired to maintain the upward west to east slope. The Engineer will consider regrading the line to avoid conflicts uncovered in the field but these conflicts should be resolved prior to shop drawing submittals. All exploratory excavation and work shall be at the Contractor's cost and incidental to other items. If adequate exploratory work is not accomplished ahead of shop drawing submittals, the Contractor shall assume all extra cost (including fittings and piping changes) necessary for relaying the line to avoid unexpected conflicts.
- The Contractor shall provide one electronic marker complete in place at each blind outlet or dead end of pipe and at each valve location. The marker shall be considered an incidental item as part of other payment items. The marker shall be installed in accordance with the manufacturer's instructions in regards to minimum clearance. The marker shall be immediately north of valves on north - south lines and immediately west of valves on east - west lines.
- Remove all valve boxes and valves from abandoned water lines (as an incidental item and not subject to separate payment). All salvageable boxes and valves shall be delivered to the Water Resources Department stripped of any attached pipe.
- Curb and gutter or pavement shown as existing and not to be removed under this contract which is damaged or displaced by the contractor or his subcontractors, shall be replaced by the Contractor at his expense. What is an allowable removal is covered in the specifications. However, in this regard, the plans shall take precedence over the specifications and any curbs, gutters or pavements shown specifically on the plans as not to be disturbed shall not be removed even if contrary to the specifications.
- The maximum allowable quantities for payment for replacement of pavement due to installation and removal of water and sewer lines shall be computed in accordance with the specifications.
- Thrust blocking will not be paid for separately and shall be considered as an incidental to other work.
- Each line to be abandoned will be cut and capped or plugged with a watertight fitting and encased at the end of the line with concrete. This shall be an incidental item to other work and the Contractor shall not be paid separately for it.
- See specifications for boring logs. (SC-1 through SC-4)
- The overhead street lighting circuits in the area have voltages in excess of 5000 volts. Ten feet (10') of clearance between these lines and any equipment shall be maintained. If it is necessary to come closer than 10', or to work directly under these lines, P.N.M. shall be given 48 hours notice by the Contractor and the Contractor shall assume all coordination responsibilities to insure power is off before working near any lines.
- Pavement Replacement: This project area will soon have a concrete intersection (construction to begin in May). Pavement replacement will not be in accordance with the Standard City Specifications, but in accordance with the details contained herein for temporary pavement replacement.
- Pipe Material: Lines 6" to 12" Diameter - Asbestos Cement Class 200 or Ductile Iron Thickness Class 50.
Lines 14" Diameter - Ductile Iron Thickness Class 50 or Concrete Cylinder design pressure of 200 psi.
Lines 16" Diameter or Greater - Ductile Iron Thickness Class 50 or Concrete Cylinder design pressure of 150 psi.
- Sewer line replacement to be with Class 50 Ductile Iron watertight joints. Concrete encase connections to existing.
- Contractor shall support and block all existing utilities when new water lines must be installed beneath existing lines. The exact method of support for existing lines must be approved in advance by the Engineer. Any damage to existing utilities shall be the responsibility of the Contractor and no extra compensation shall be allowed to replace or repair existing utilities.
- The Contractor shall have the option of rigid joints or thrust blocking. No extra reimbursement shall be allowed for either. Rigid joints of concrete cylinder pipe shall be in accordance with the City's Standard Detail.

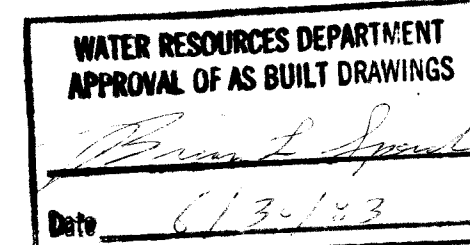


PLANS PREPARED UNDER THE DIRECTION OF DAVID R. BROSMAN CITY ENGINEER 6246 APPROVED FOR CONSTRUCTION Richard S. [Signature] CITY ENGINEER DATE 11/13/10			CITY OF ALBUQUERQUE DEPARTMENT OF WATER RESOURCES TITLE: STEEL WATER LINE REPLACEMENT - PHASE 1A GENERAL NOTES, LEGEND, ABBREVIATIONS		
APPROVALS	ENGINEER	DATE	APPROVALS	ENGINEER	DATE
City Engineer			Liquid Waste	[Signature]	11/16/10
A.C.E. - Design			Traffic	[Signature]	11/16/10
A.C.E. - Hydrology			Water	[Signature]	11/16/10
DRAWING NO. 1010			SHEET 2 OF 10		

LASON 1-505-344-9404
BEST COPY AVAILABLE

RECORD DRAWING

AS BUILT INFORMATION		BENCH MARKS		SURVEY INFORMATION		REFERENCES		REVISIONS	
CONTRACTOR	Kent Nowlin Const. Inc.	WORK STARTED BY	Stanley F. [Signature]	DATE	4/18/10	MAP NO.		W.O. NO.	
ACCEPTED BY	City	DATE	11/16/10	NO.		EST NO.		BY	
FIELD LOCATION BY	City	DATE		NO.				REMARKS	
DRAWINGS CORRECTED BY	Stanley F. [Signature]	DATE	10/10/10	NO.				DESIGN	
RECORDED BY		DATE		NO.				DATE	11/16/10
		DATE		NO.				DATE	11/16/10
		DATE		NO.				DATE	11/16/10

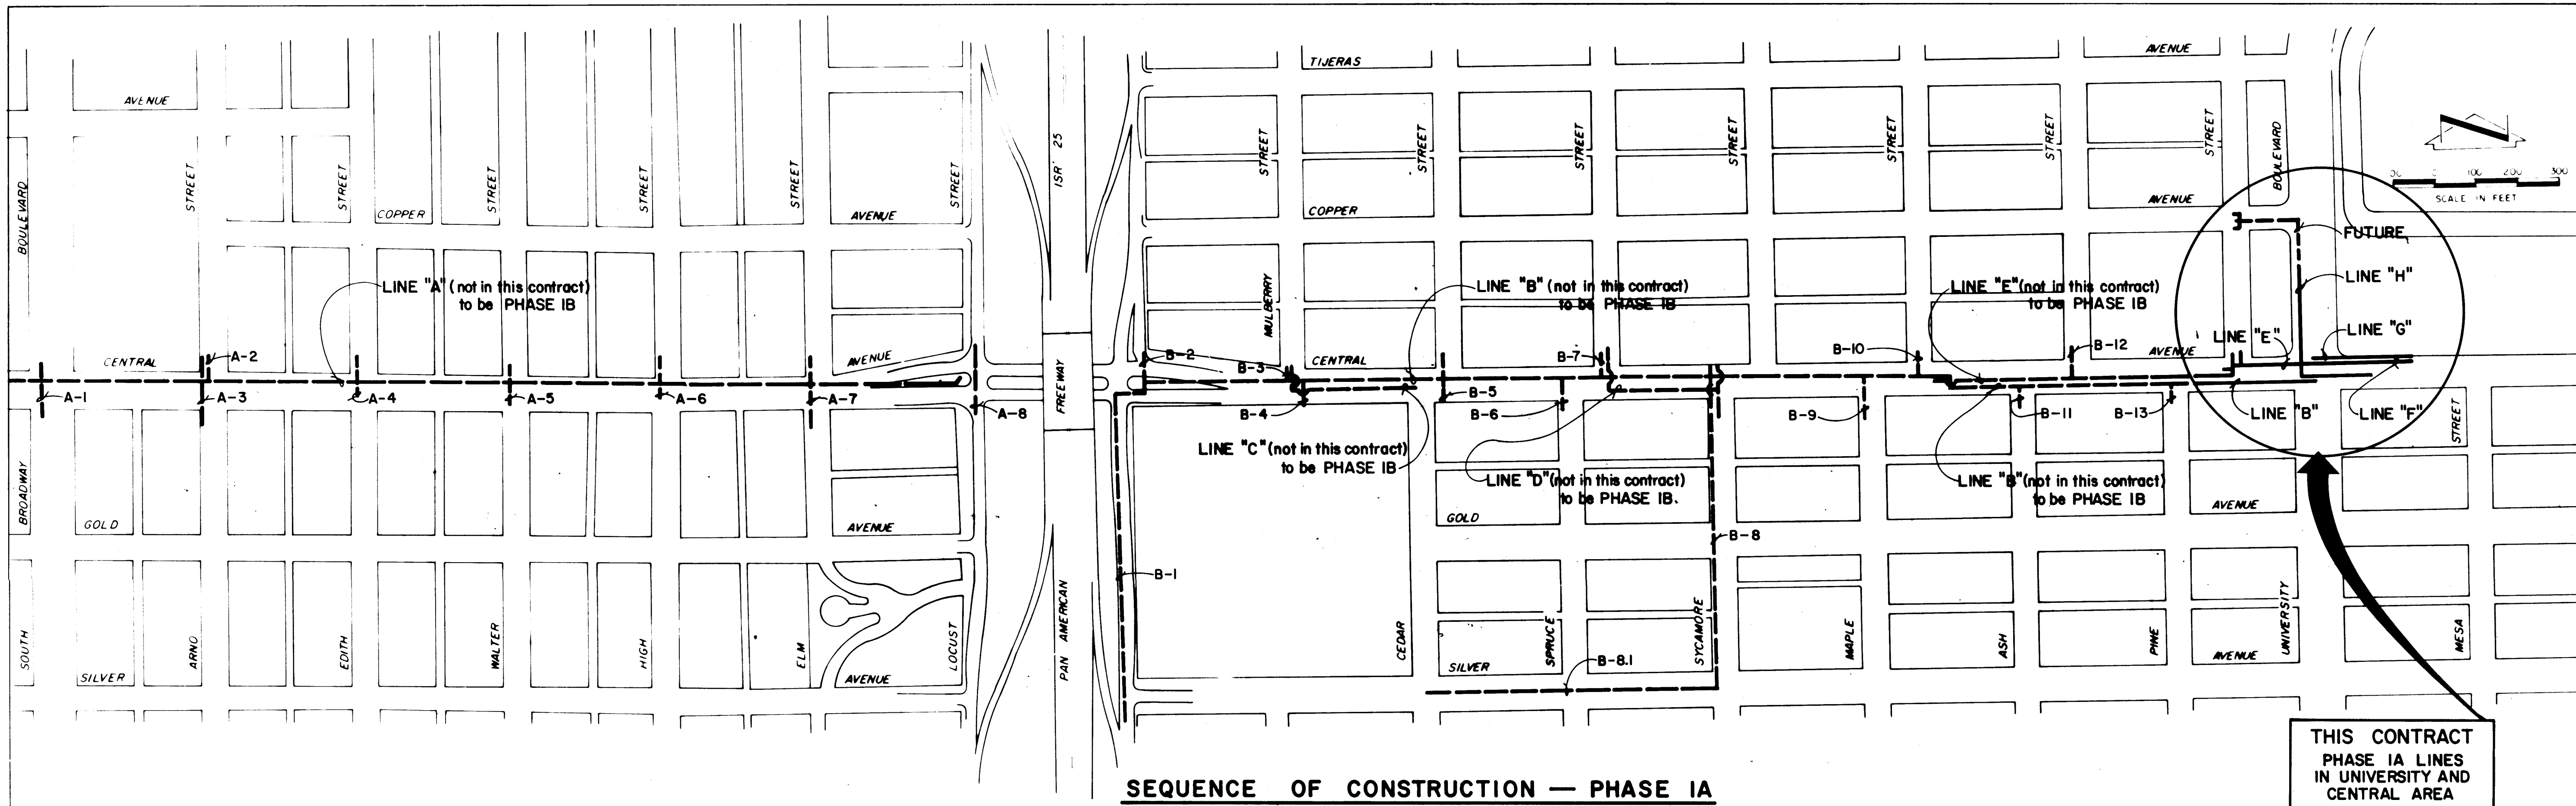

SEQUENCE OF CONSTRUCTION — PHASE IA

NOTES:

- See Sequence of Construction Sheet 4.
- See Traffic Control Plan Sheets 9 and 10.
- Contractor shall maintain traffic control at all times.
- Contractor shall be responsible for temporarily restraining all unfinished but partially used lines or valves. Any blocking or restraining needed for this purpose shall be considered an incidental item with no separate payment allowed.
- Any variance from the sequence indicated here must be approved in writing in advance by the City of Albuquerque. Any proposed changes to the sequence must be submitted in writing. Any proposed sequences must be submitted in detail and be complete from beginning to end of each line (i.e., not a partial sequence). The sequence must be based on minimum interruption of service.

STEP 1

- Construct portions of lines "E", "F", "H", (0+00 to 2+70⁺) and "G" as shown on Sheet 4.
These lines can be constructed in any reasonable order.
Do not connect to existing lines.
- Construct line "B" from station 25+80 to station 28+70⁺. Do not connect yet.
- Stub out line "B-14" with valve but do not connect to existing lines.
- Pressure tap the existing 10" steel line (verify size) in middle of intersection.
Construct temporary bypass line around 20" C.C.P.

STEP 2

- Connect line "B" and line "G". This needs to be carefully coordinated with the City. Shut down time on 20" line shall be minimized. Contractor shall work continuously until this process is completed. Reactivate 20" line as soon as possible.
A. During this time, the temporary bypass on the 10" line will be used to keep the 10" line in service.
- When ready, deactivate the 10" line east of University and connect line "G-1". This should be accomplished in the minimum time possible and be carefully coordinated with the City. Reactivate as soon as possible. Note: transfer the service connections between University and line "G-1". This will be done on a Sunday or at night. Note: line "G-1" must be completed and activated before beginning line "F-1".
- Deactivate the 14" water line and the 2 - 16" water lines on Central. Coordinate with City.
- Construct the remaining portions of line "F". Construct lines "F-1" and "F-2" making all necessary connections.
- Reactivate the 16" line and use line "F-2". Keep valve on line "F" at station 1+12 closed.



STEP 3

- Deactivate the 22" steel line. Coordinate with the City.
- Construct the remainder of line "E" including "E-1", "E-2" and "E-3". Remove existing 22" and 16" lines where conflicting. Construct in minimum time possible. Activate line "E" as soon as possible including lines "E-1", "E-2" and "E-3".
- Deactivate 10" steel line west of University. Extend line "B-14" and connect line "B-14" to existing line and to hydrant. This is to be carefully coordinated with the City (i.e., this line is important to Presbyterian Hospital). It is essential that the shut down on the existing line be minimal. Activate line "B" and "B-14". This connection will have to be done in the middle of the night.
- Remove temporary bypass line and 10" line connections to the 20" C.C.P. blind flange valves at the 20" C.C.P.

STEP 4

- Make exploratory excavations at 36" and 22" lines (Note: these exploratory excavations can be accomplished before this step).
- There is some uncertainty as to what exists at the end of the existing 36" line. As noted on the drawings additional valving and connections may be needed.
- Complete line "H" from station 2+70⁺ to end of line.


1 2 3 4 5 6 7 8 9 10 11 12
26 1 0 1 0 0 3 8 3

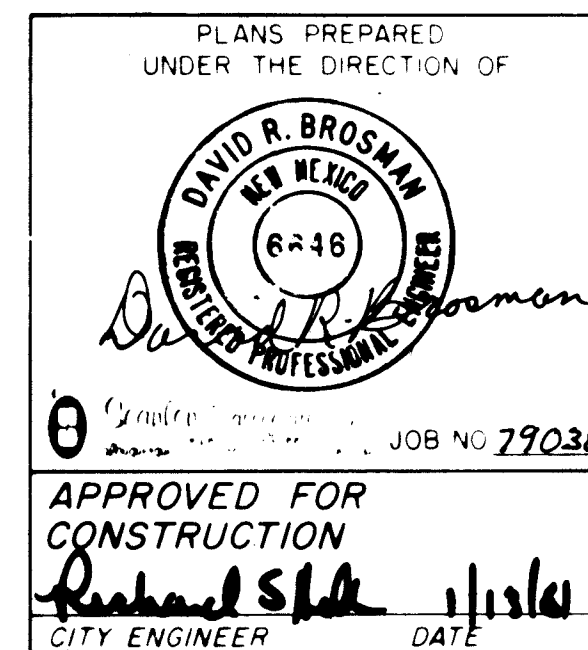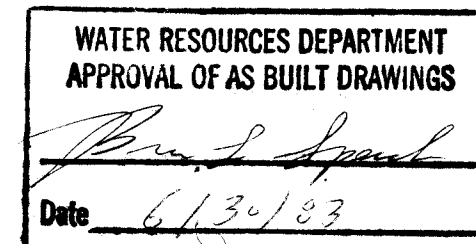


RECORD DRAWING

CITY OF ALBUQUERQUE DEPARTMENT OF WATER RESOURCES					
TITLE: STEEL WATER LINE REPLACEMENT — PHASE IA NOTES ON SEQUENCE OF CONSTRUCTION & GENERAL SITE PLAN					
APPROVALS	ENGINEER	DATE	APPROVALS	ENGINEER	DATE
City Engineer			Liquid Waste	W. H. H. J.	1/15/84
A.C.E. - Design			Traffic	W. H. H. J.	1/15/84
A.C.E. - Hydrology			Water	W. H. H. J.	1/15/84
DRAWING NO. 1010			SHEET 3 OF 10		


AS BUILT INFORMATION		BENCH MARKS		SURVEY INFORMATION		REFERENCES		FIELD NOTES	
DATE	4/81	DATE	4/81	DATE	4/81	DATE	4/81	DATE	4/81
BY	Scanlon Assoc.	BY	Scanlon Assoc.	BY	Scanlon Assoc.	BY	Scanlon Assoc.	BY	Scanlon Assoc.
DATE	1/7/81	DATE	1/7/81	DATE	1/7/81	DATE	1/7/81	DATE	1/7/81
BY	Scanlon Assoc.	BY	Scanlon Assoc.	BY	Scanlon Assoc.	BY	Scanlon Assoc.	BY	Scanlon Assoc.
DATE	1/7/81	DATE	1/7/81	DATE	1/7/81	DATE	1/7/81	DATE	1/7/81
BY	Scanlon Assoc.	BY	Scanlon Assoc.	BY	Scanlon Assoc.	BY	Scanlon Assoc.	BY	Scanlon Assoc.

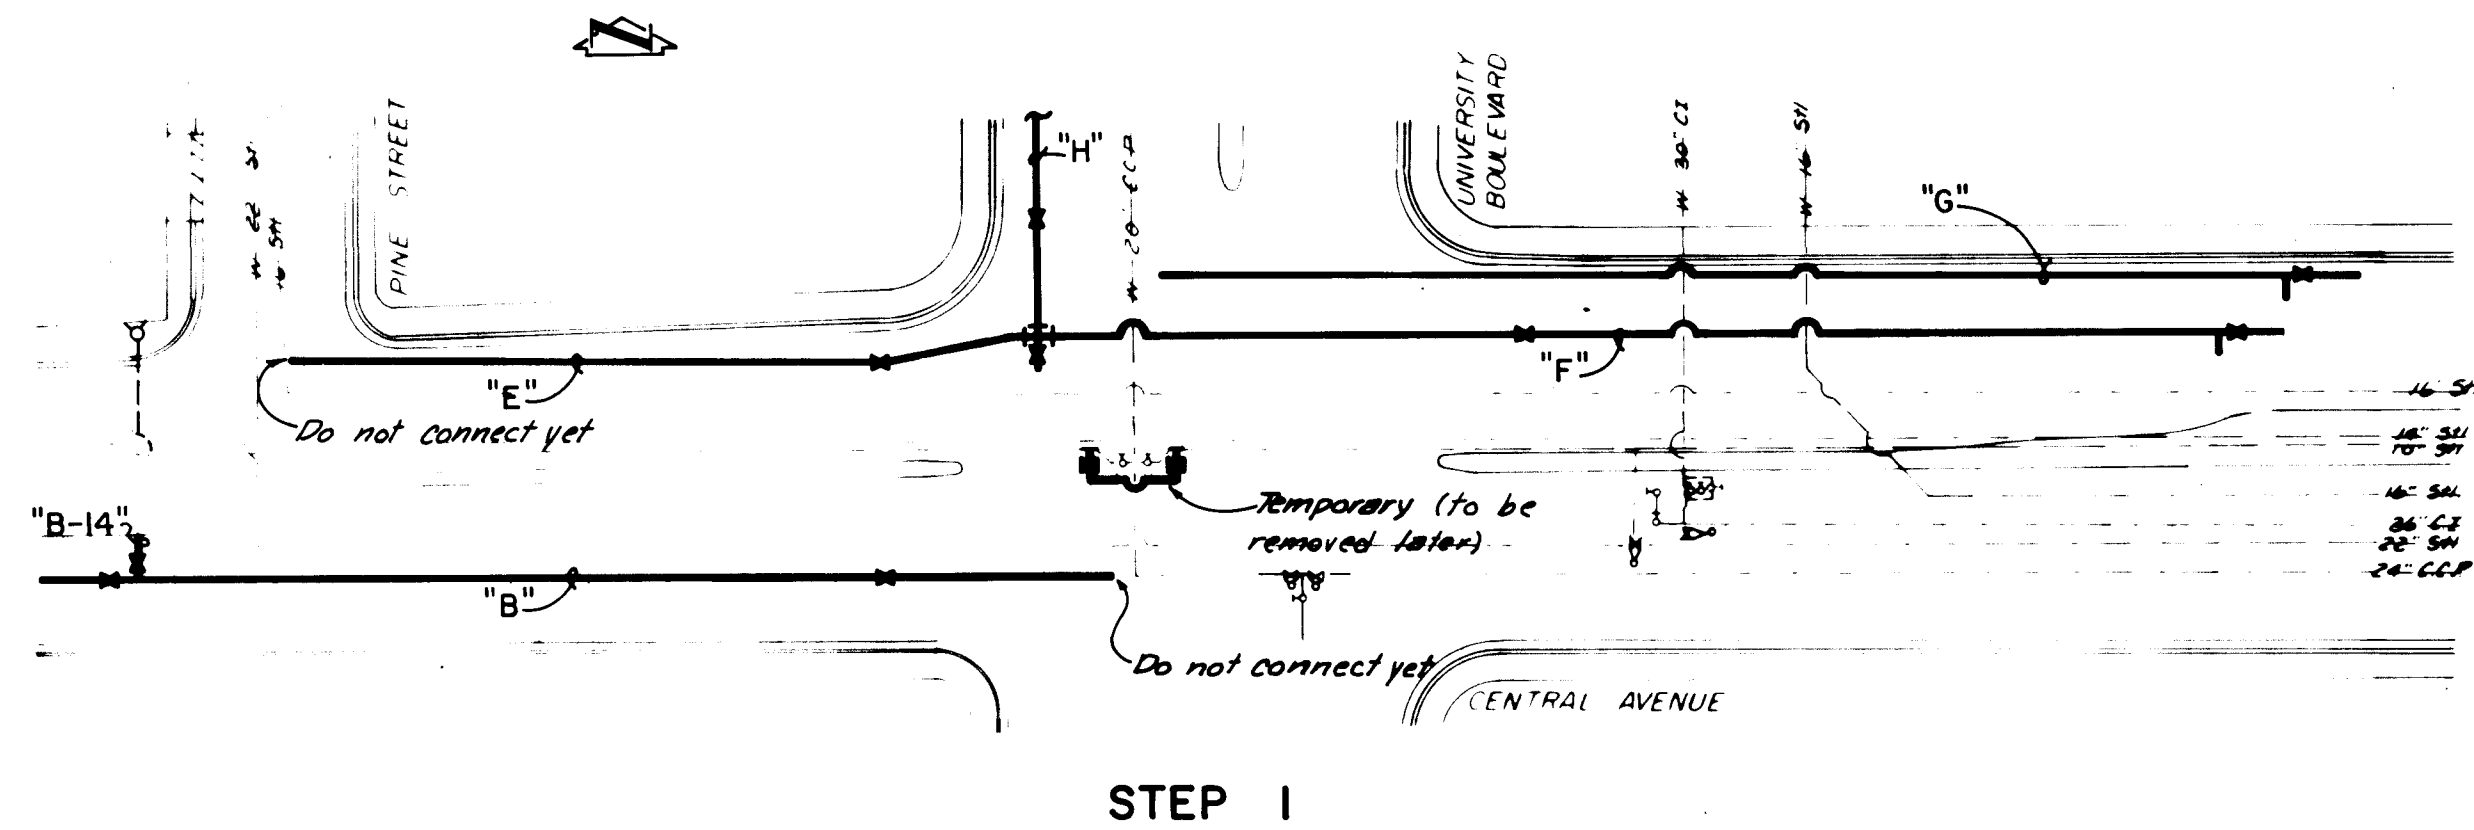


STEP 1

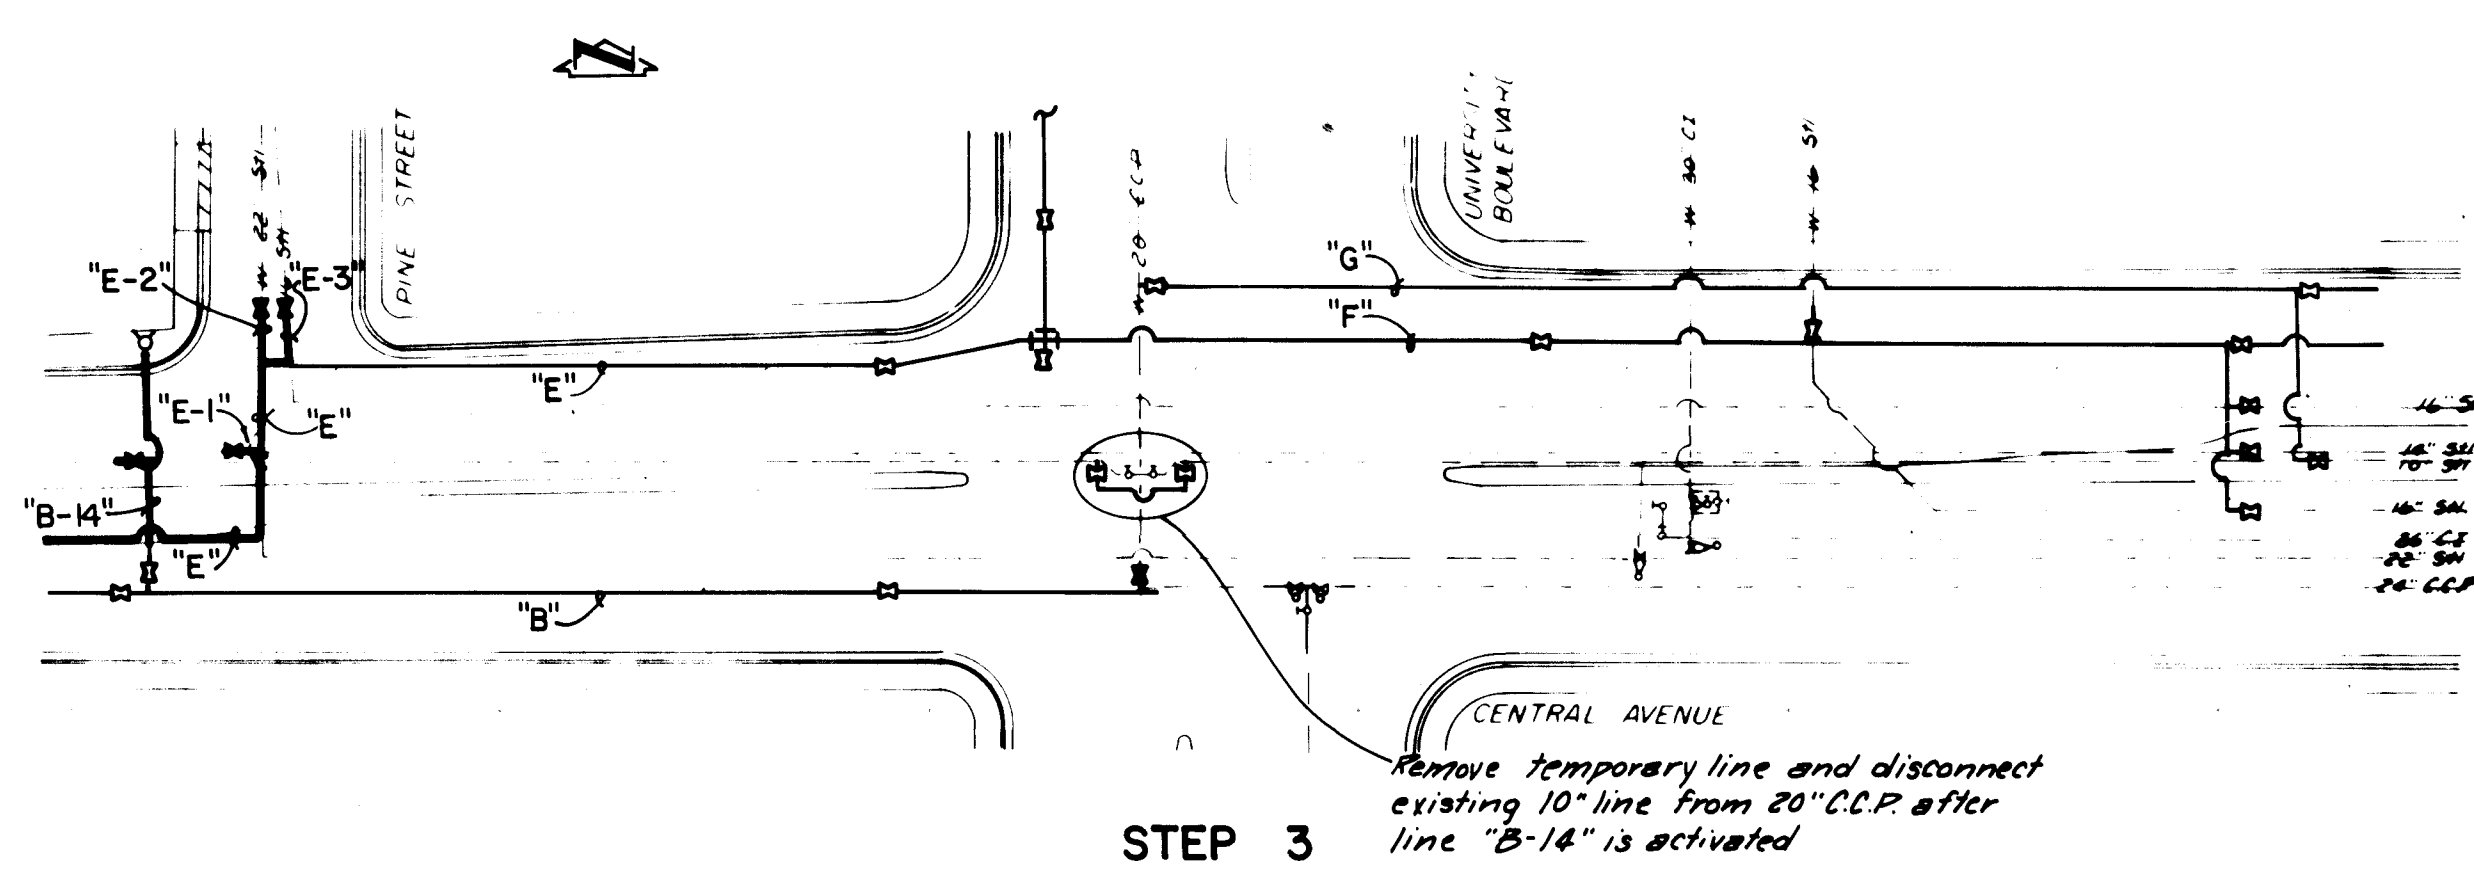


STEP 3

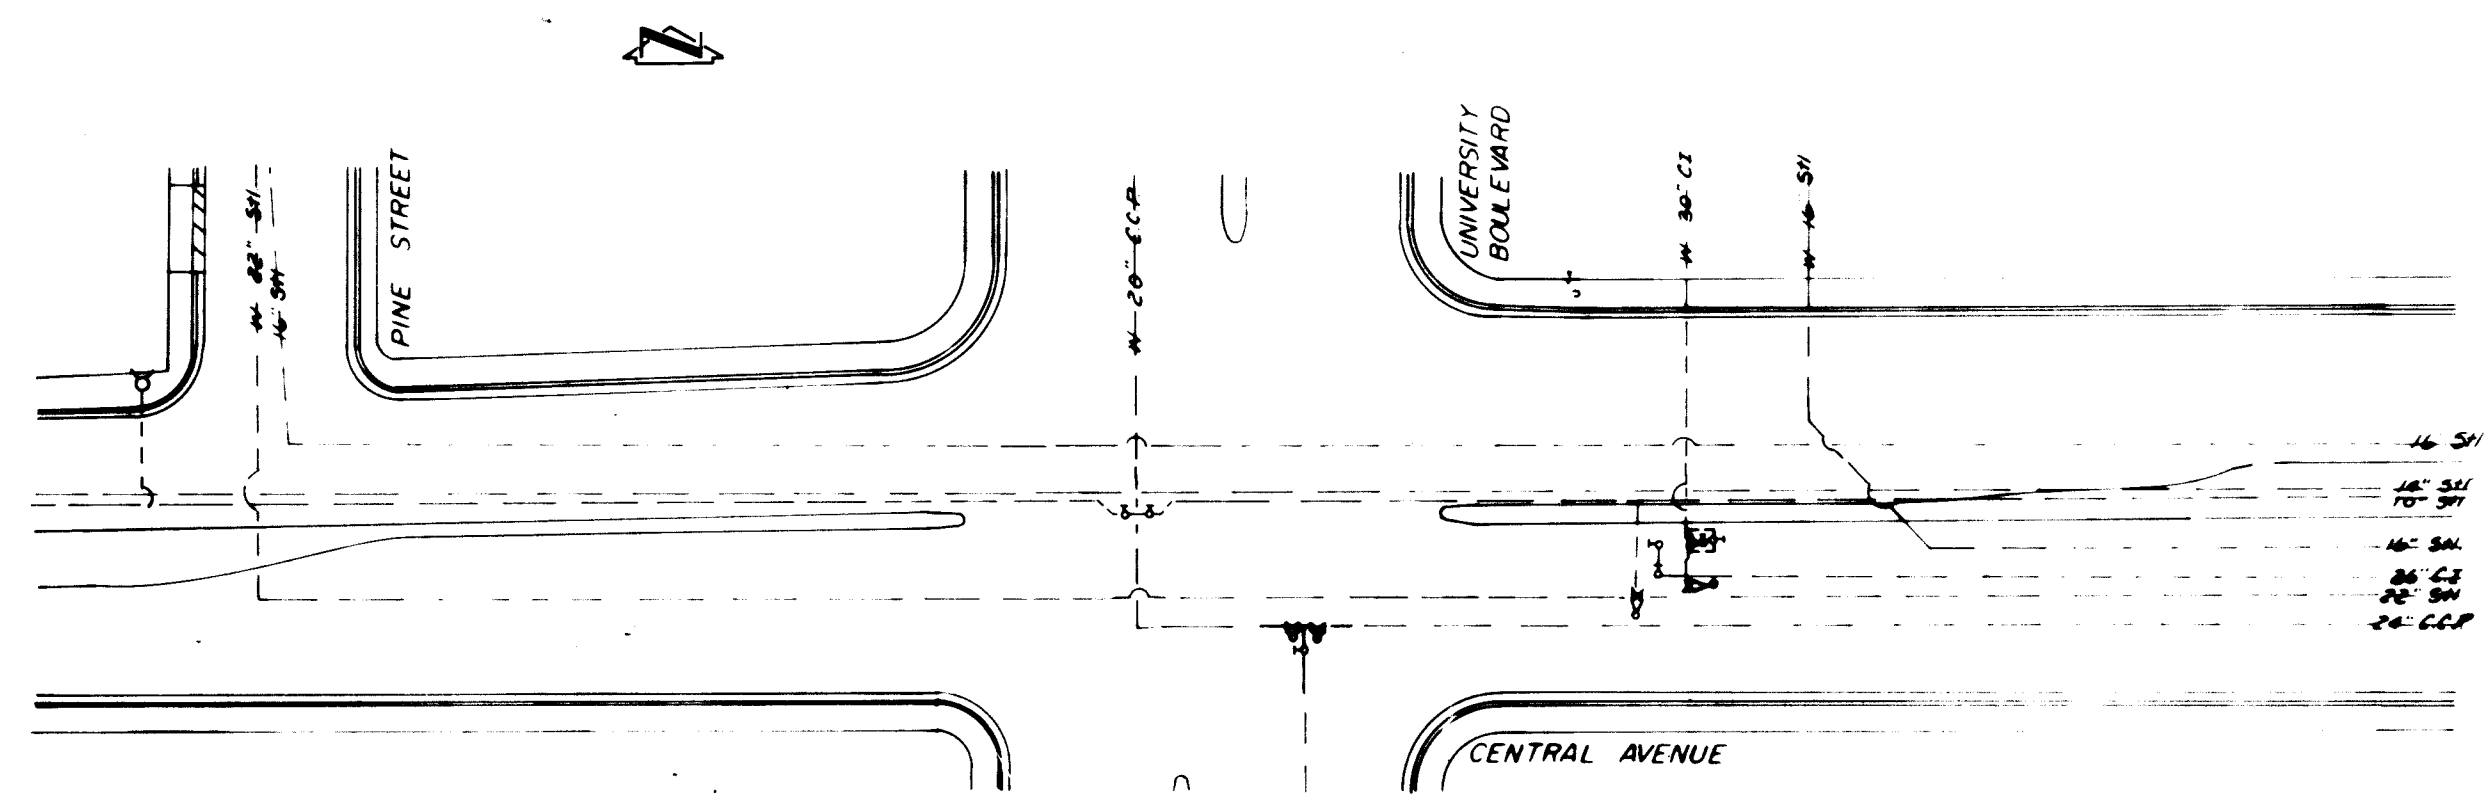

EXISTING WATER LINES

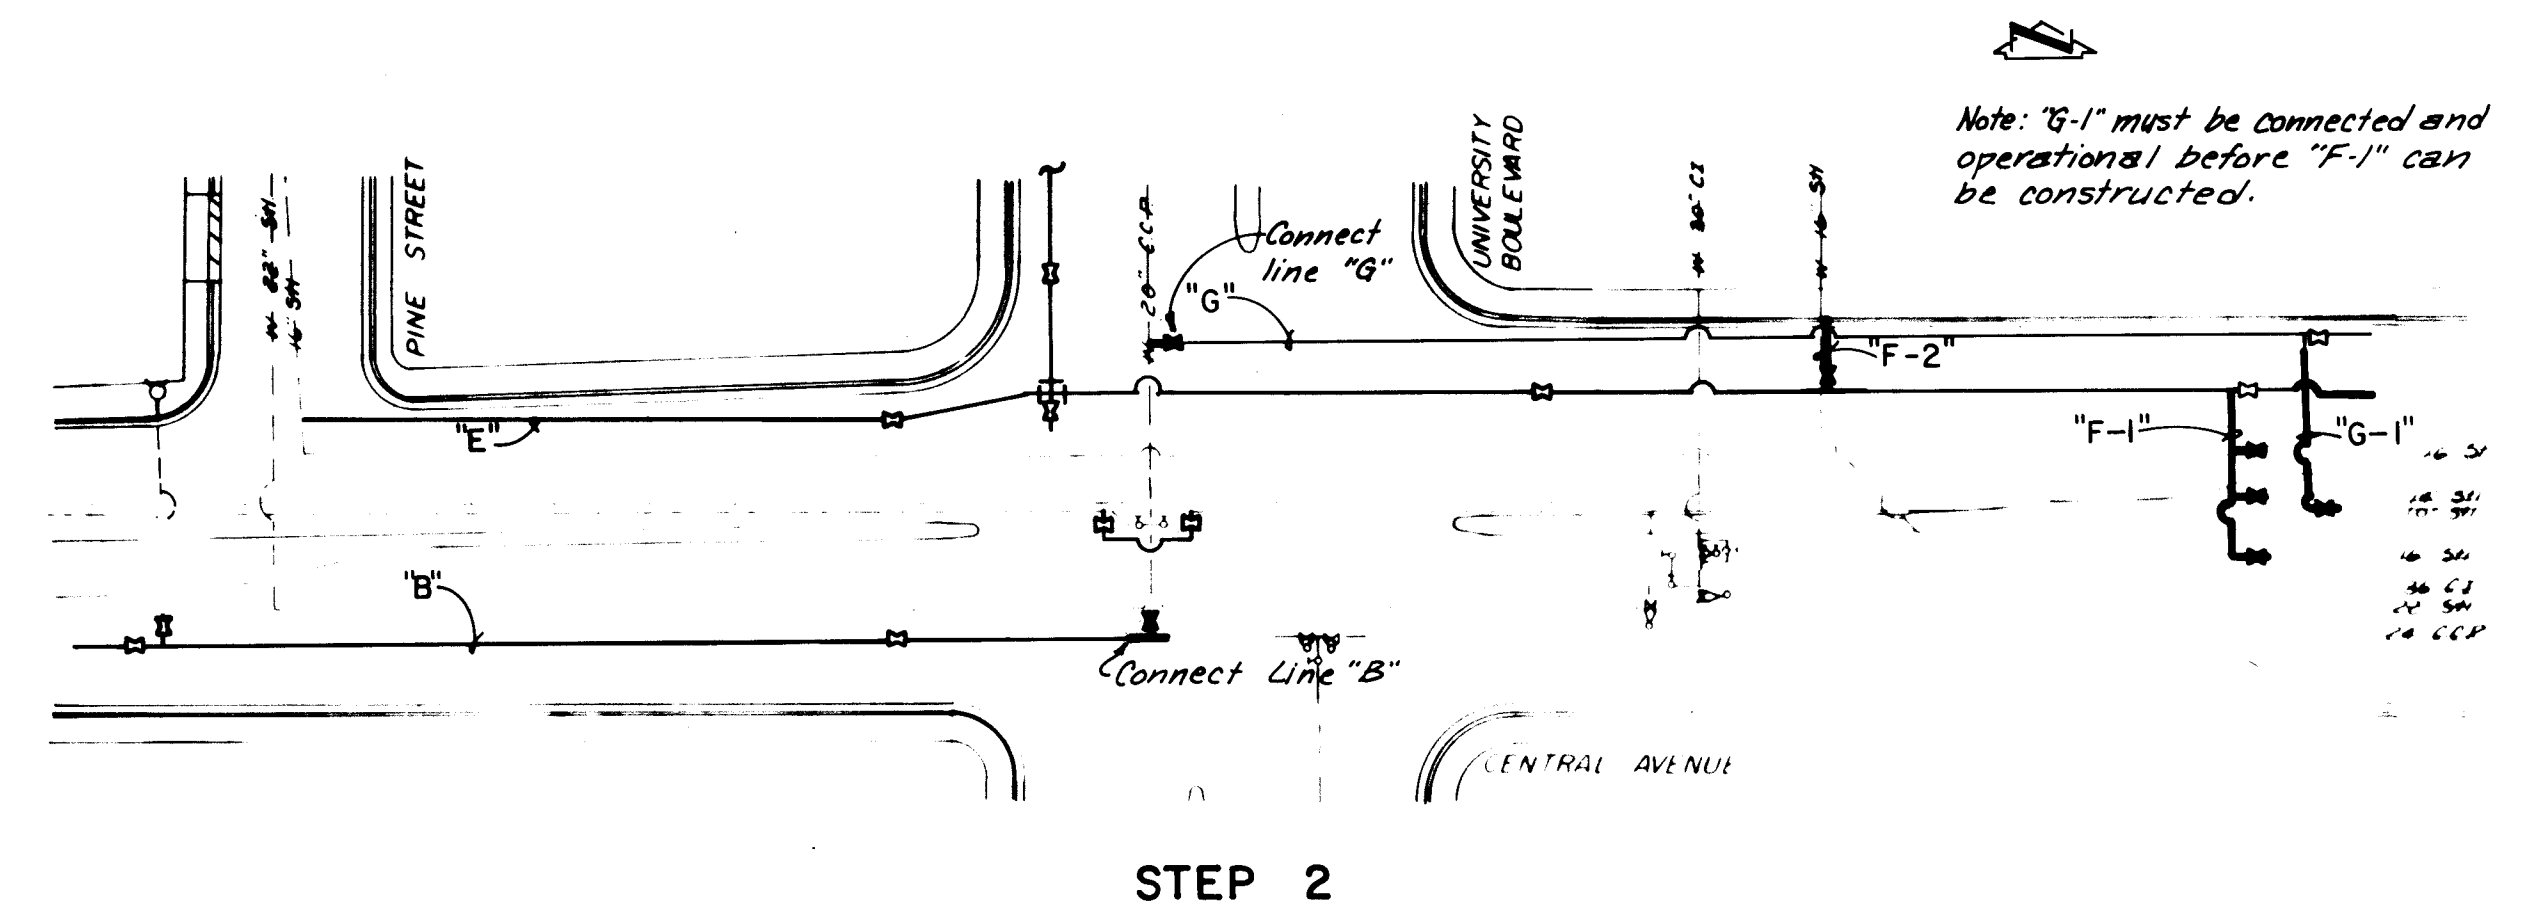

STEP 2

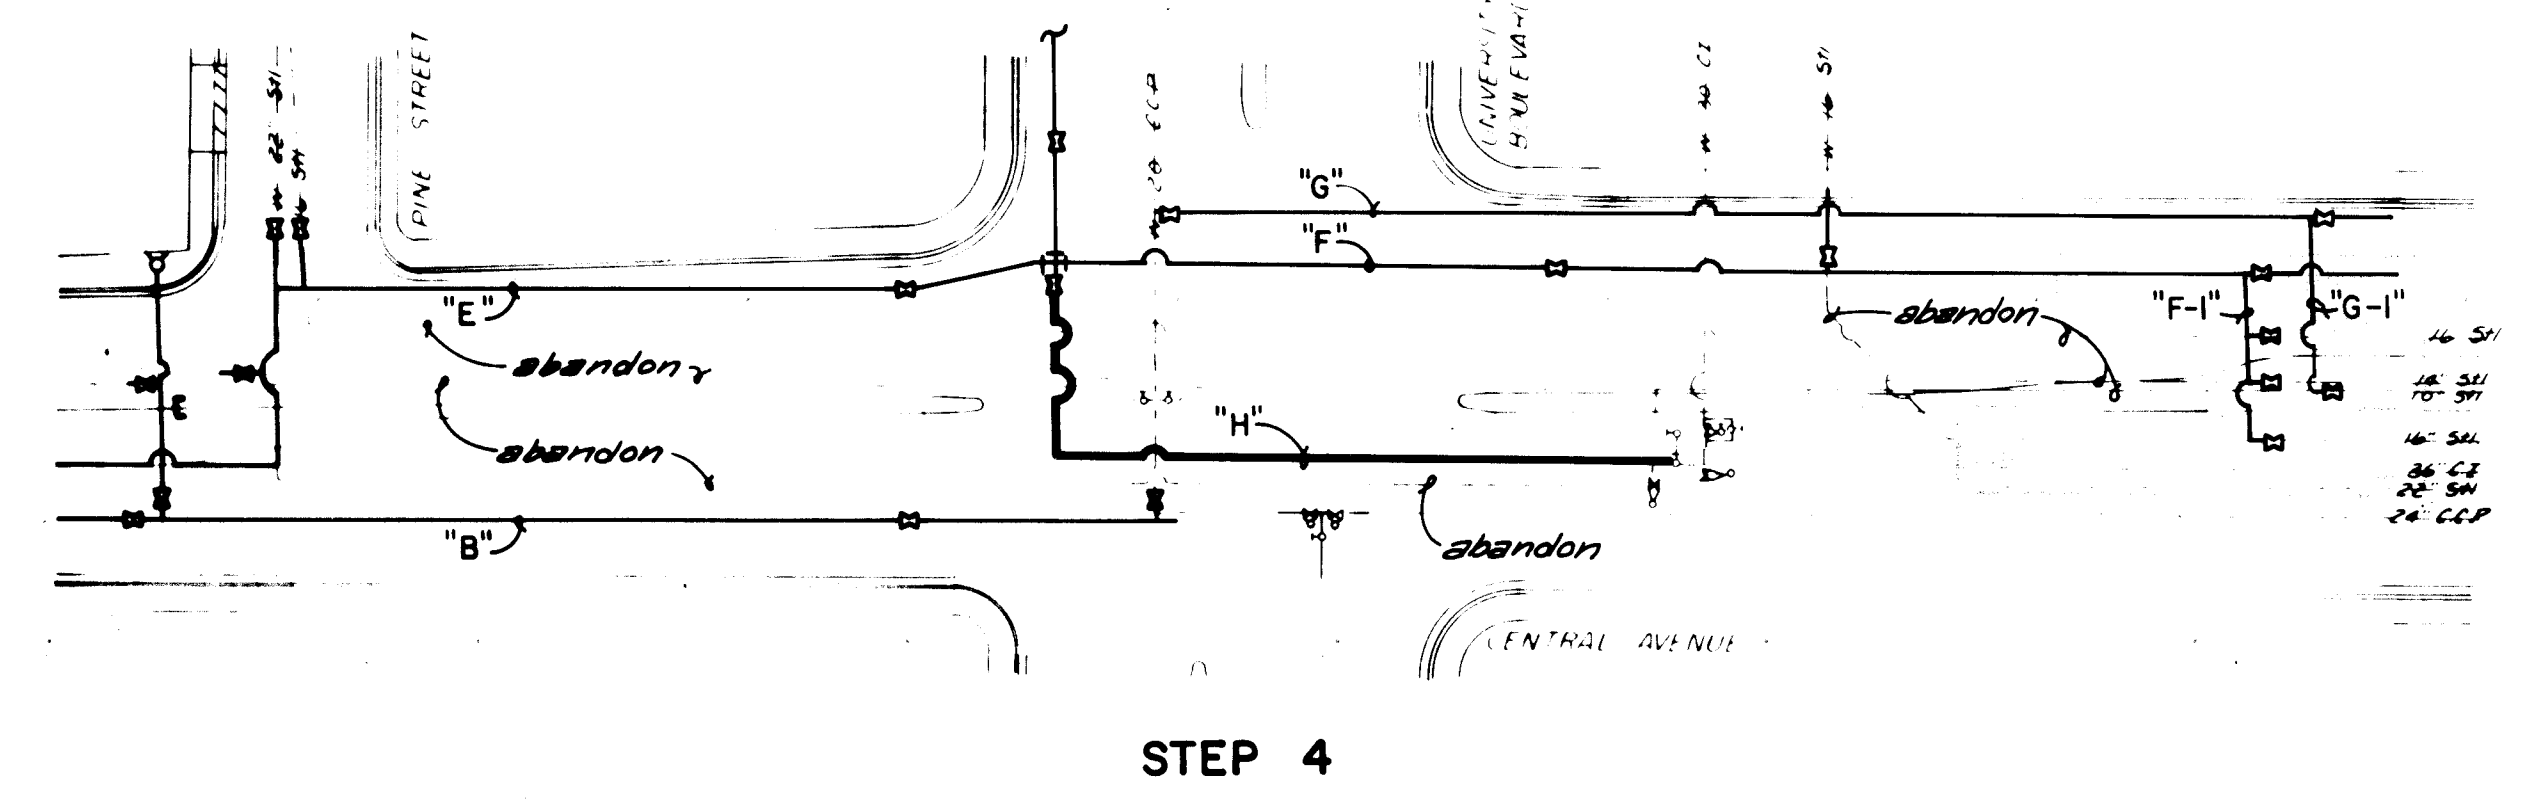


STEP 4

LEGEND

- EXISTING WATER LINE
- PROPOSED WATER LINE
- PROPOSED WATER LINE - INSTALLED IN PREVIOUS SEQUENCE


NOTE: Other utilities are not shown. 26, 10, 10, 10, 10, 10

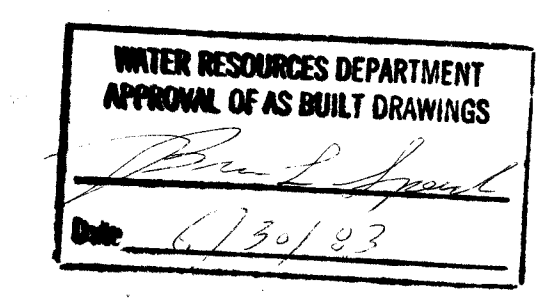

RECORD DRAWING


PLANS PREPARED UNDER THE DIRECTION OF			CITY OF ALBUQUERQUE		
			DEPARTMENT OF WATER RESOURCES		
TITLE: STEEL WATER LINE REPLACEMENT - PHASE 1A					
CONSTRUCTION SEQUENCE - CENTRAL AVENUE & UNIVERSITY BOULEVARD					
APPROVALS	ENGINEER	DATE	APPROVALS	ENGINEER	DATE
City Engineer			Liquid Waste	<i>[Signature]</i>	1/16/91
A.C.E. - Design			Traffic	<i>[Signature]</i>	1/16/91
A.C.E. - Hydrology			Water	<i>[Signature]</i>	1/16/91
APPROVED FOR CONSTRUCTION			DRAWING NO. 1010		
 CITY ENGINEER			SHEET 4 OF 10		

AS BUILT INFORMATION		BENCH MARKS		SURVEY INFORMATION		REFERENCES		REVISIONS		DESIGN	
NO.	DATE	NO.	DATE	MAP NO.	EST NO.	W.O. NO.	BY	NO.	DATE	NO.	DATE
1	1/1/81							1	1/1/81	1	1/1/81
2	1/1/81							2	1/1/81	2	1/1/81
3	1/1/81							3	1/1/81	3	1/1/81
4	1/1/81							4	1/1/81	4	1/1/81
5	1/1/81							5	1/1/81	5	1/1/81
6	1/1/81							6	1/1/81	6	1/1/81
7	1/1/81							7	1/1/81	7	1/1/81
8	1/1/81							8	1/1/81	8	1/1/81
9	1/1/81							9	1/1/81	9	1/1/81
10	1/1/81							10	1/1/81	10	1/1/81

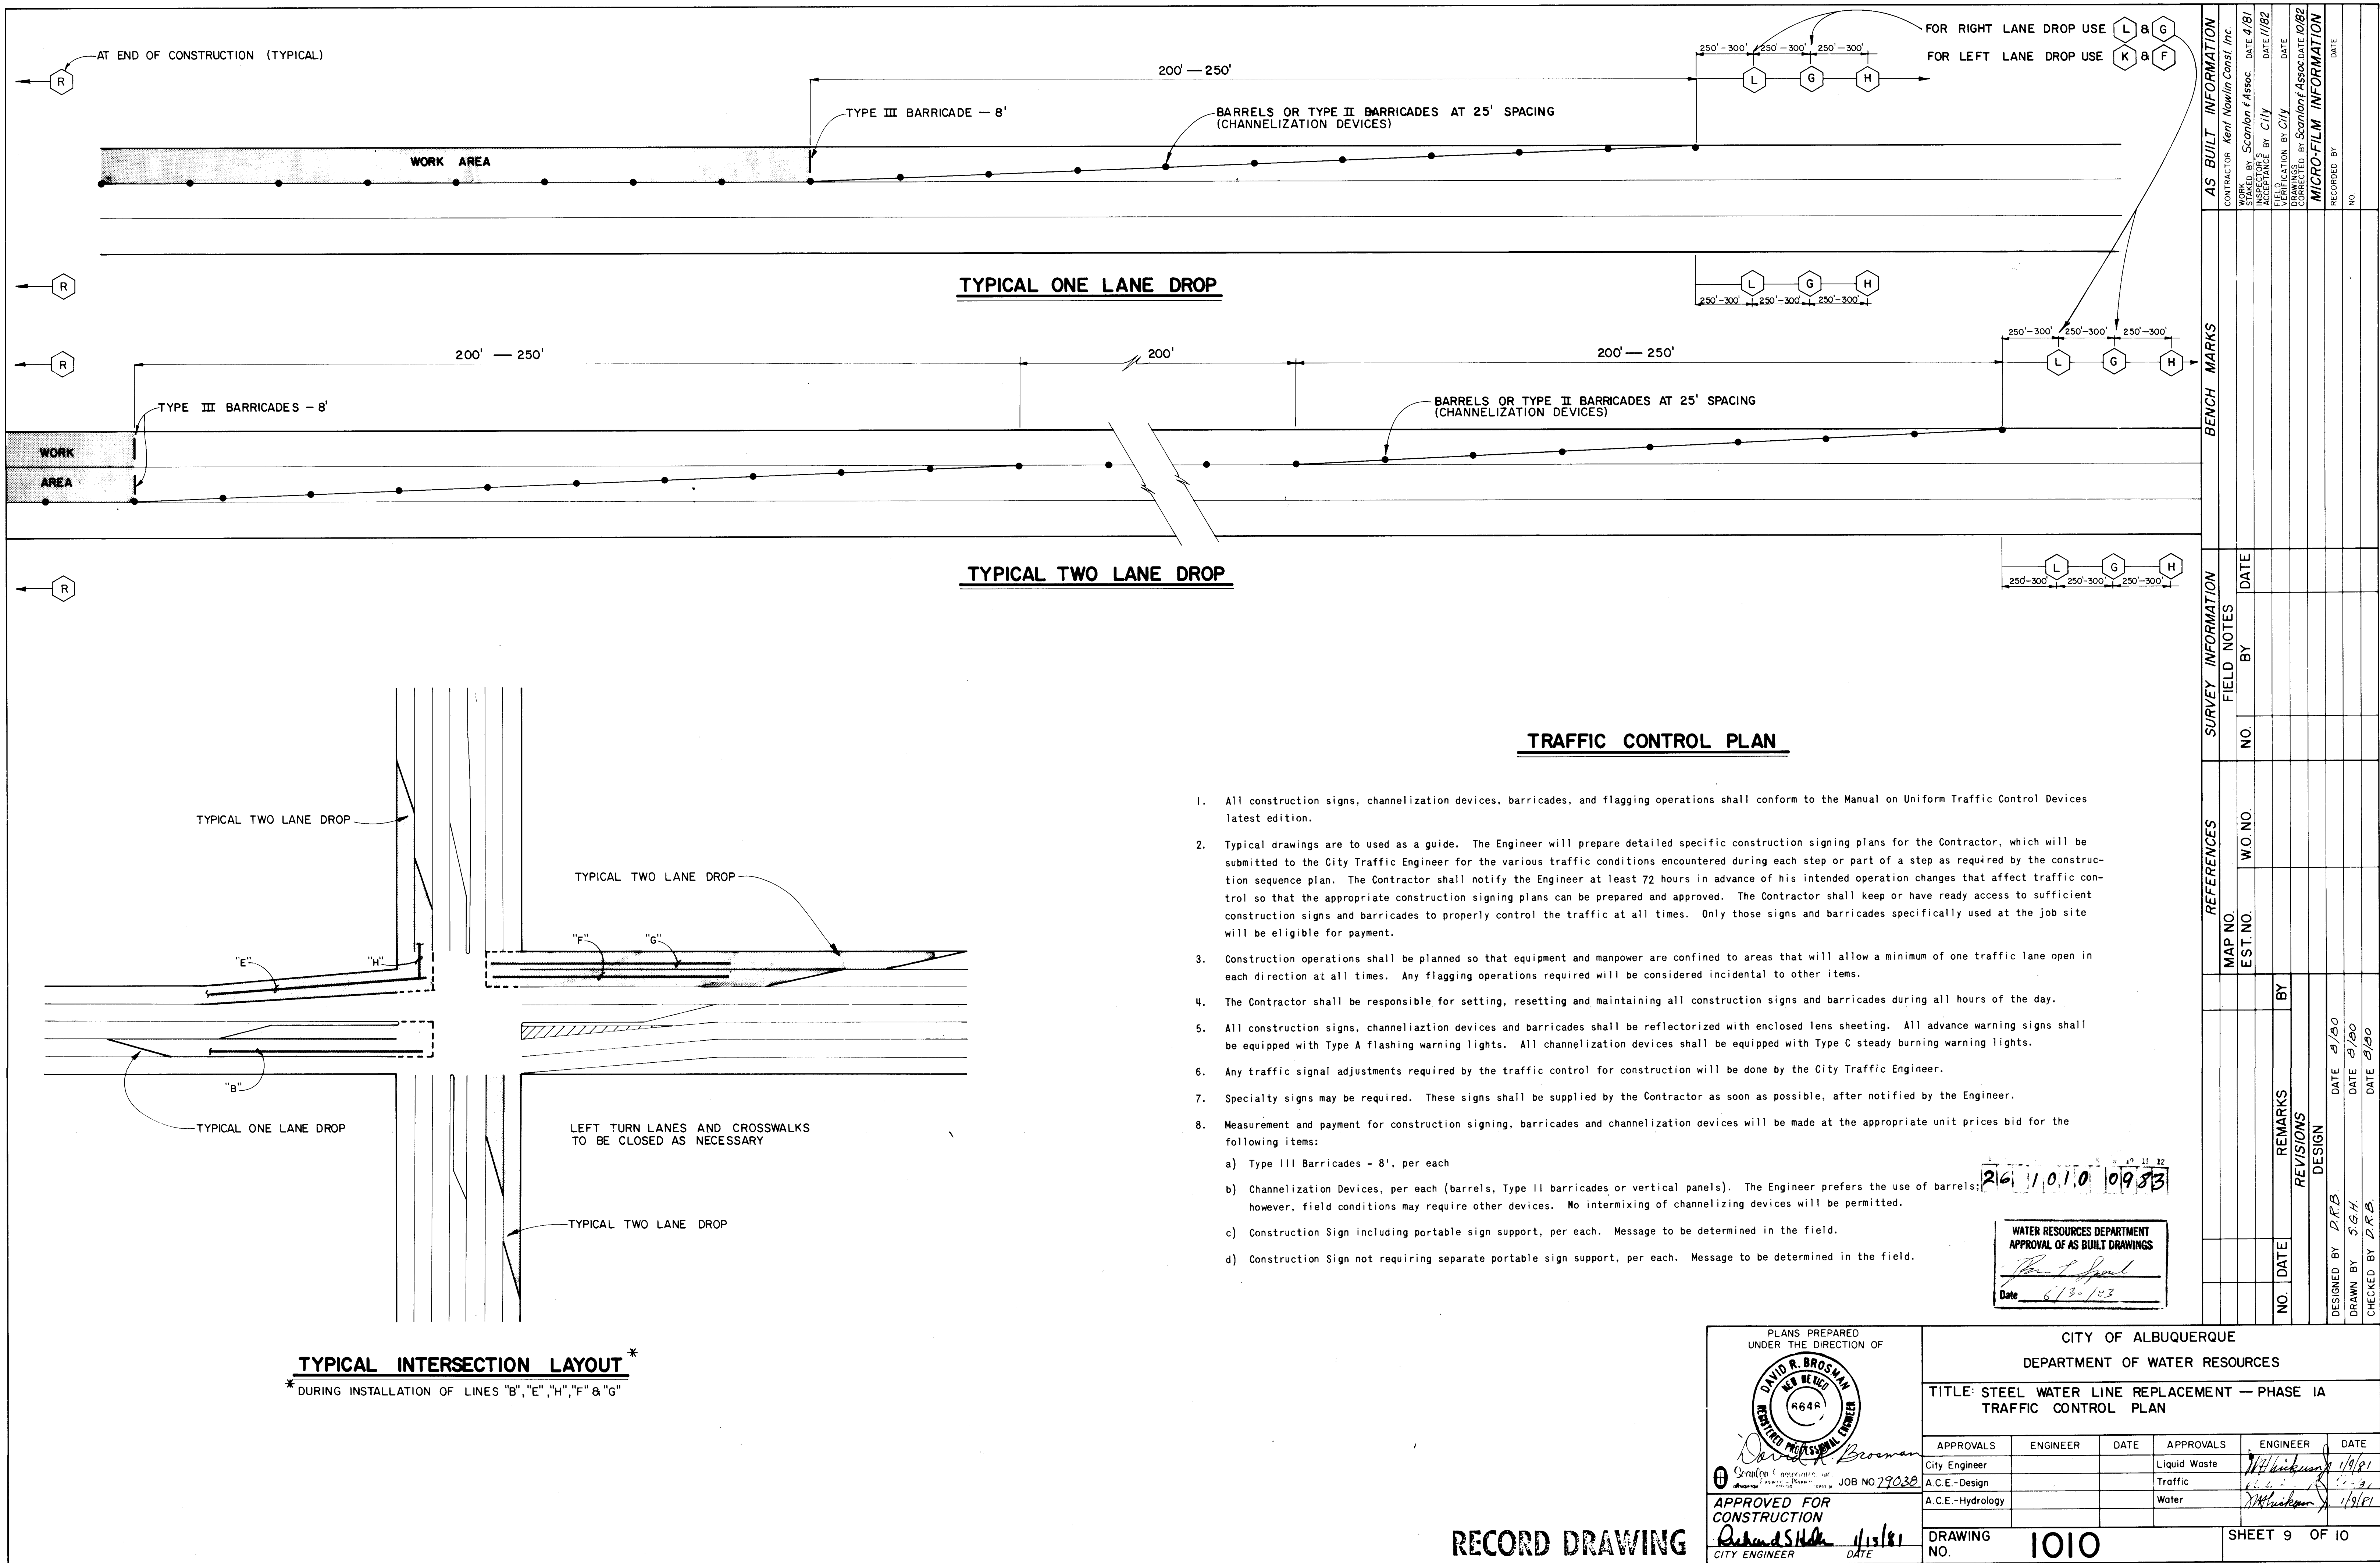

PLAN	DATE	BY
SURVEYED		
PLOTTED		
CHECKED		
DATE		
NO.		

PROFILE	DATE	BY
SURVEYED		
PLOTTED		
CHECKED		
DATE		
NO.		

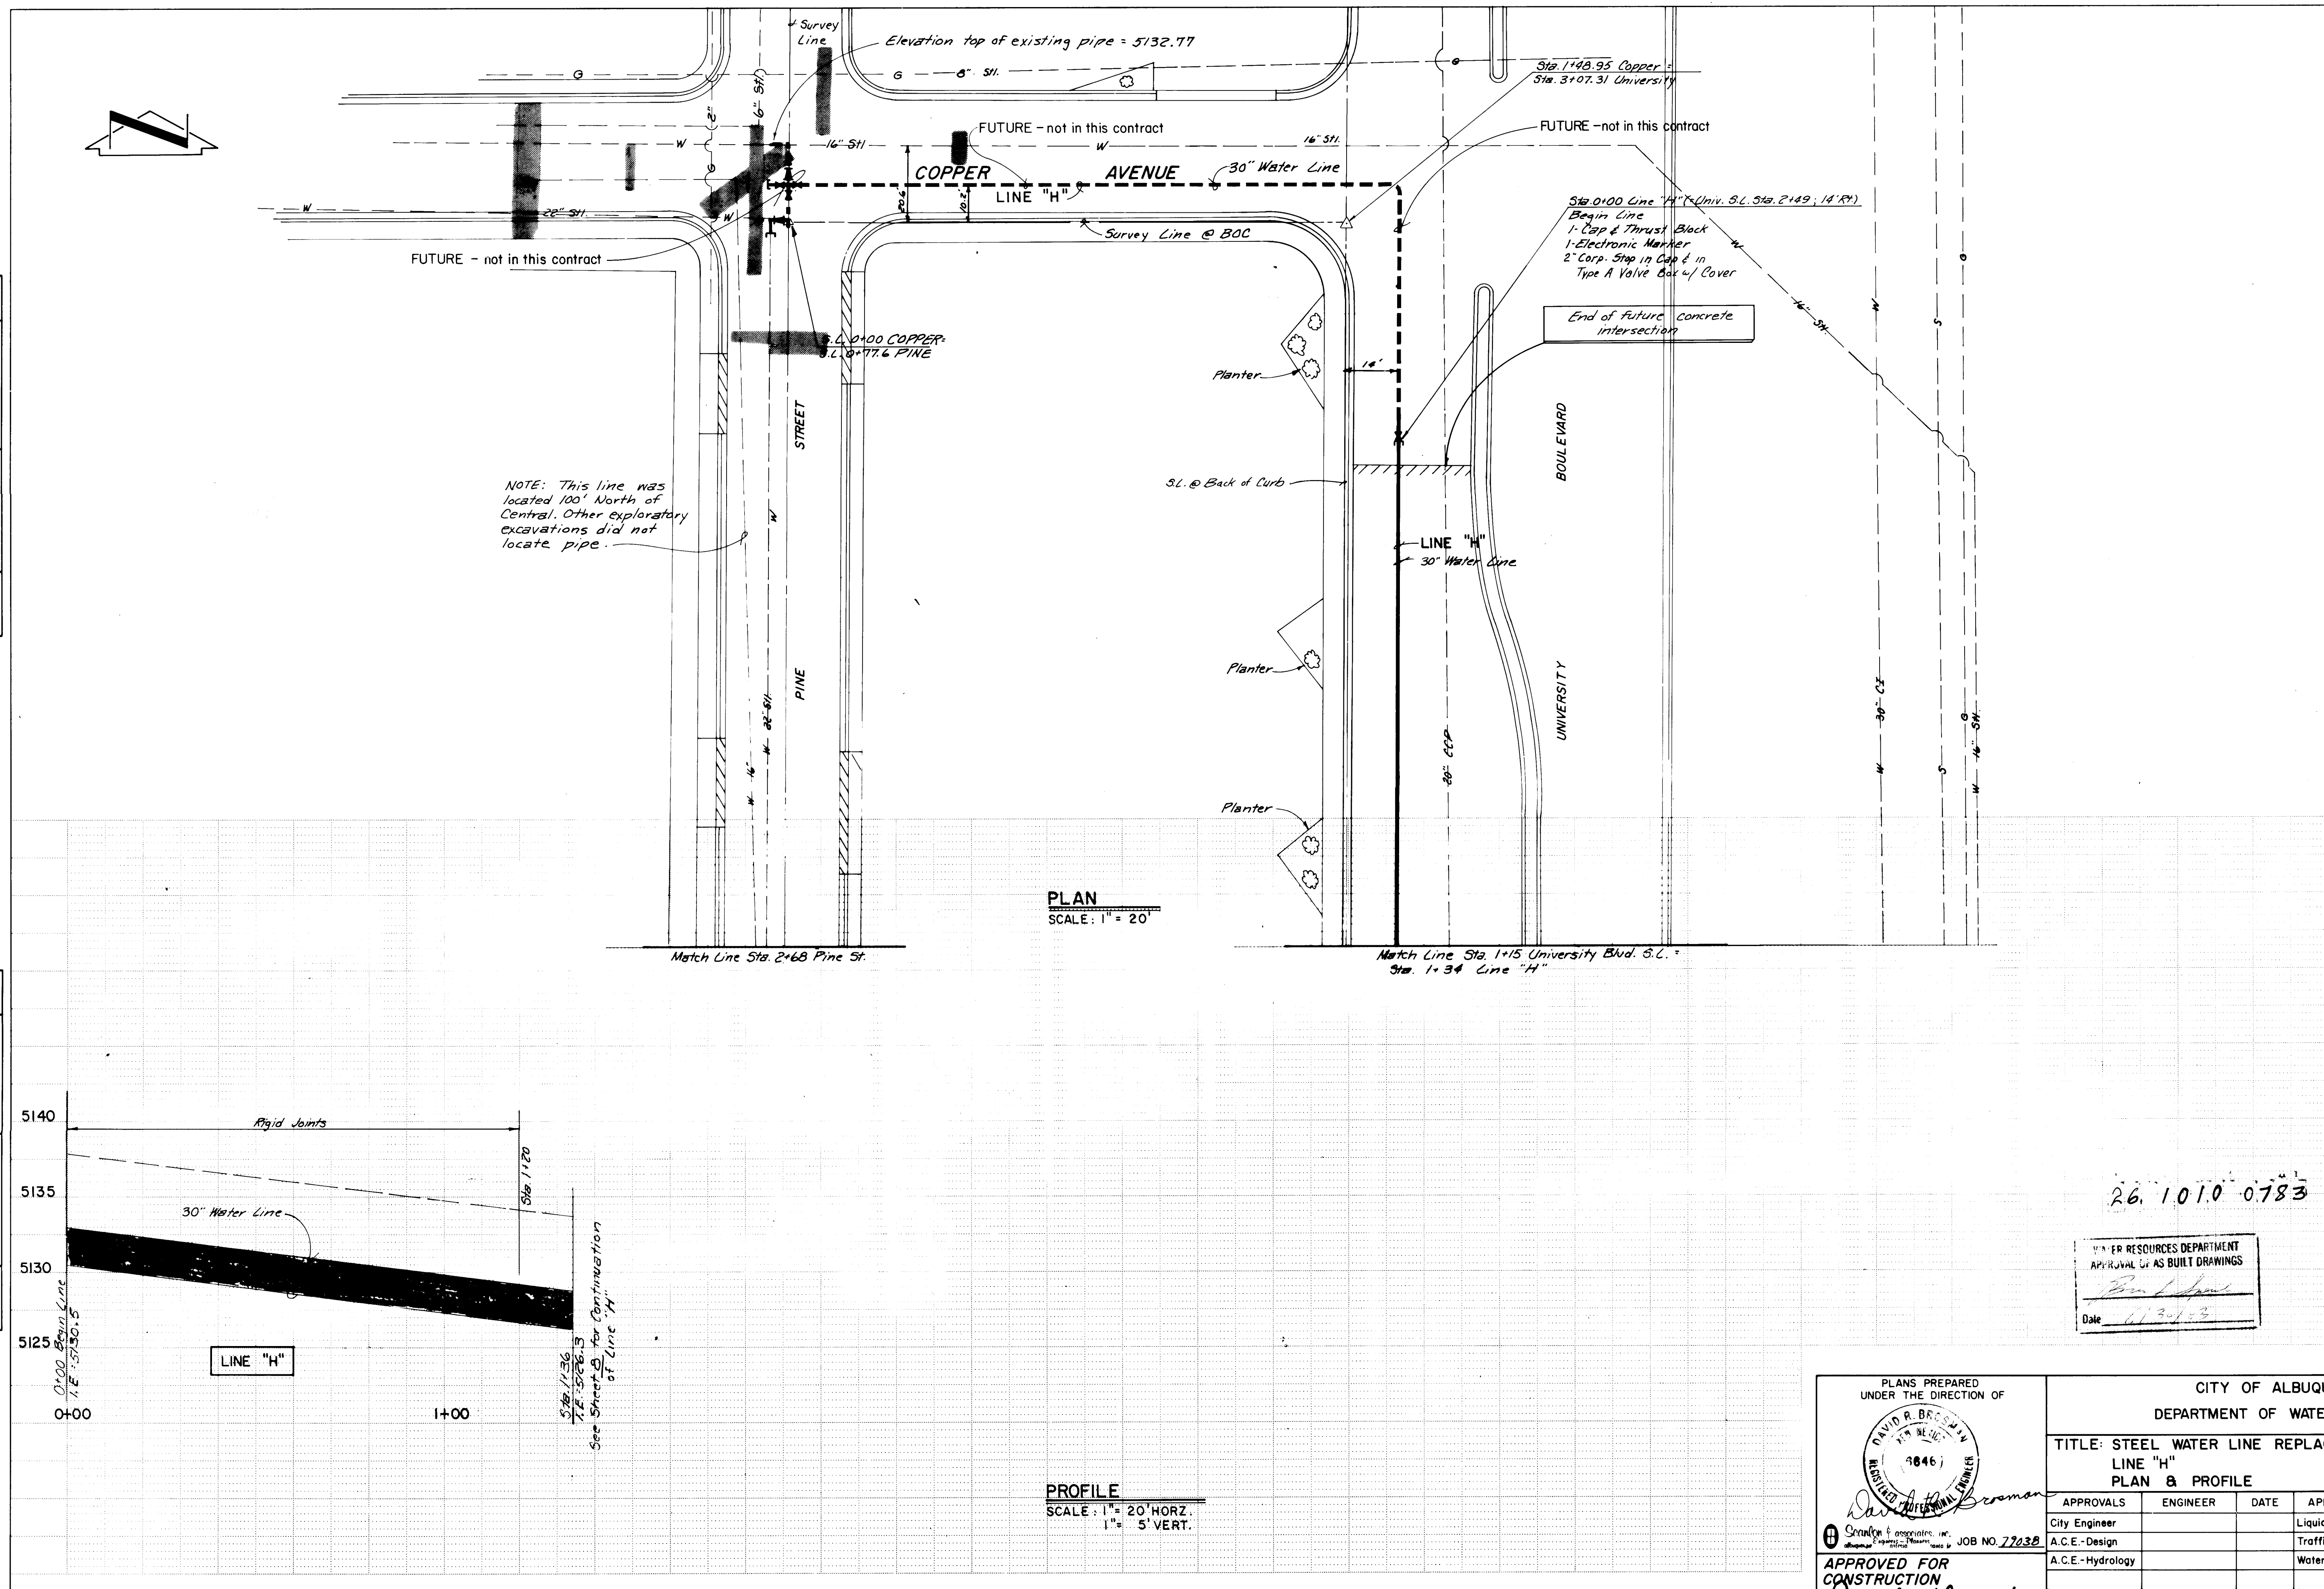

26.1010-0783


WATER RESOURCES DEPARTMENT
APPROVAL OF AS BUILT DRAWINGS
Date 11/30/83

PLANS PREPARED UNDER THE DIRECTION OF		CITY OF ALBUQUERQUE	
DAVID R. BRENNAN REGISTERED PROFESSIONAL ENGINEER 3846		DEPARTMENT OF WATER RESOURCES	
TITLE: STEEL WATER LINE REPLACEMENT - PHASE 1A			
LINE "H"			
PLAN & PROFILE			
APPROVALS	ENGINEER	DATE	APPROVALS
City Engineer			Liquid Waste
A.C.E.-Design			Traffic
A.C.E.-Hydrology			Water
APPROVED FOR CONSTRUCTION		ENGINEER	
Richard S. Hill 1/18/84		DATE 1/18/84	
CITY ENGINEER		DATE 1/18/84	
DRAWING NO. 1010		SHEET 7 OF 10	

AS BUILT INFORMATION	BENCH MARKS	SURVEY INFORMATION	REFERENCES	REVISIONS	DESIGN
CONTRACTOR: Kent Nowlin Const. Inc.	5-115 ACS Brass Disk set in median, 21.2' south of & on the west bound lane of Central and 77.5' east of University	FIELD NOTES: NO. 72038, BY Scanlon & Associates, DATE 11/79	MAP NO. K-152, EST. NO. 11/79	NO. DATE	DESIGNED BY: D.R.B., DATE: 8/80
WORKED BY: Scanlon & Associates, DATE: 4/81	Central and 77.5' east of University			REVISIONS	DRAWN BY: S.G.H., DATE: 8/80
INSPECTOR'S ACCEPTANCE BY CITY, DATE: 1/78	Elevation = 5134.24			BY	CHECKED BY: D.R.B., DATE: 8/80
VERIFICATION BY CITY, DATE:					
DRAWING NO. 1010					
RECORDED BY:					
NO.					

PLAN	DATE	BY	NO.
SURVEYED			
ALIGNED			
CHECKED			
RT. OF WAY CHECKED			

PROFILE	DATE	BY	NO.
SURVEYED			
PLOTTED			
CHECKED			
STRUCTURE NOTATIONS OK'D			

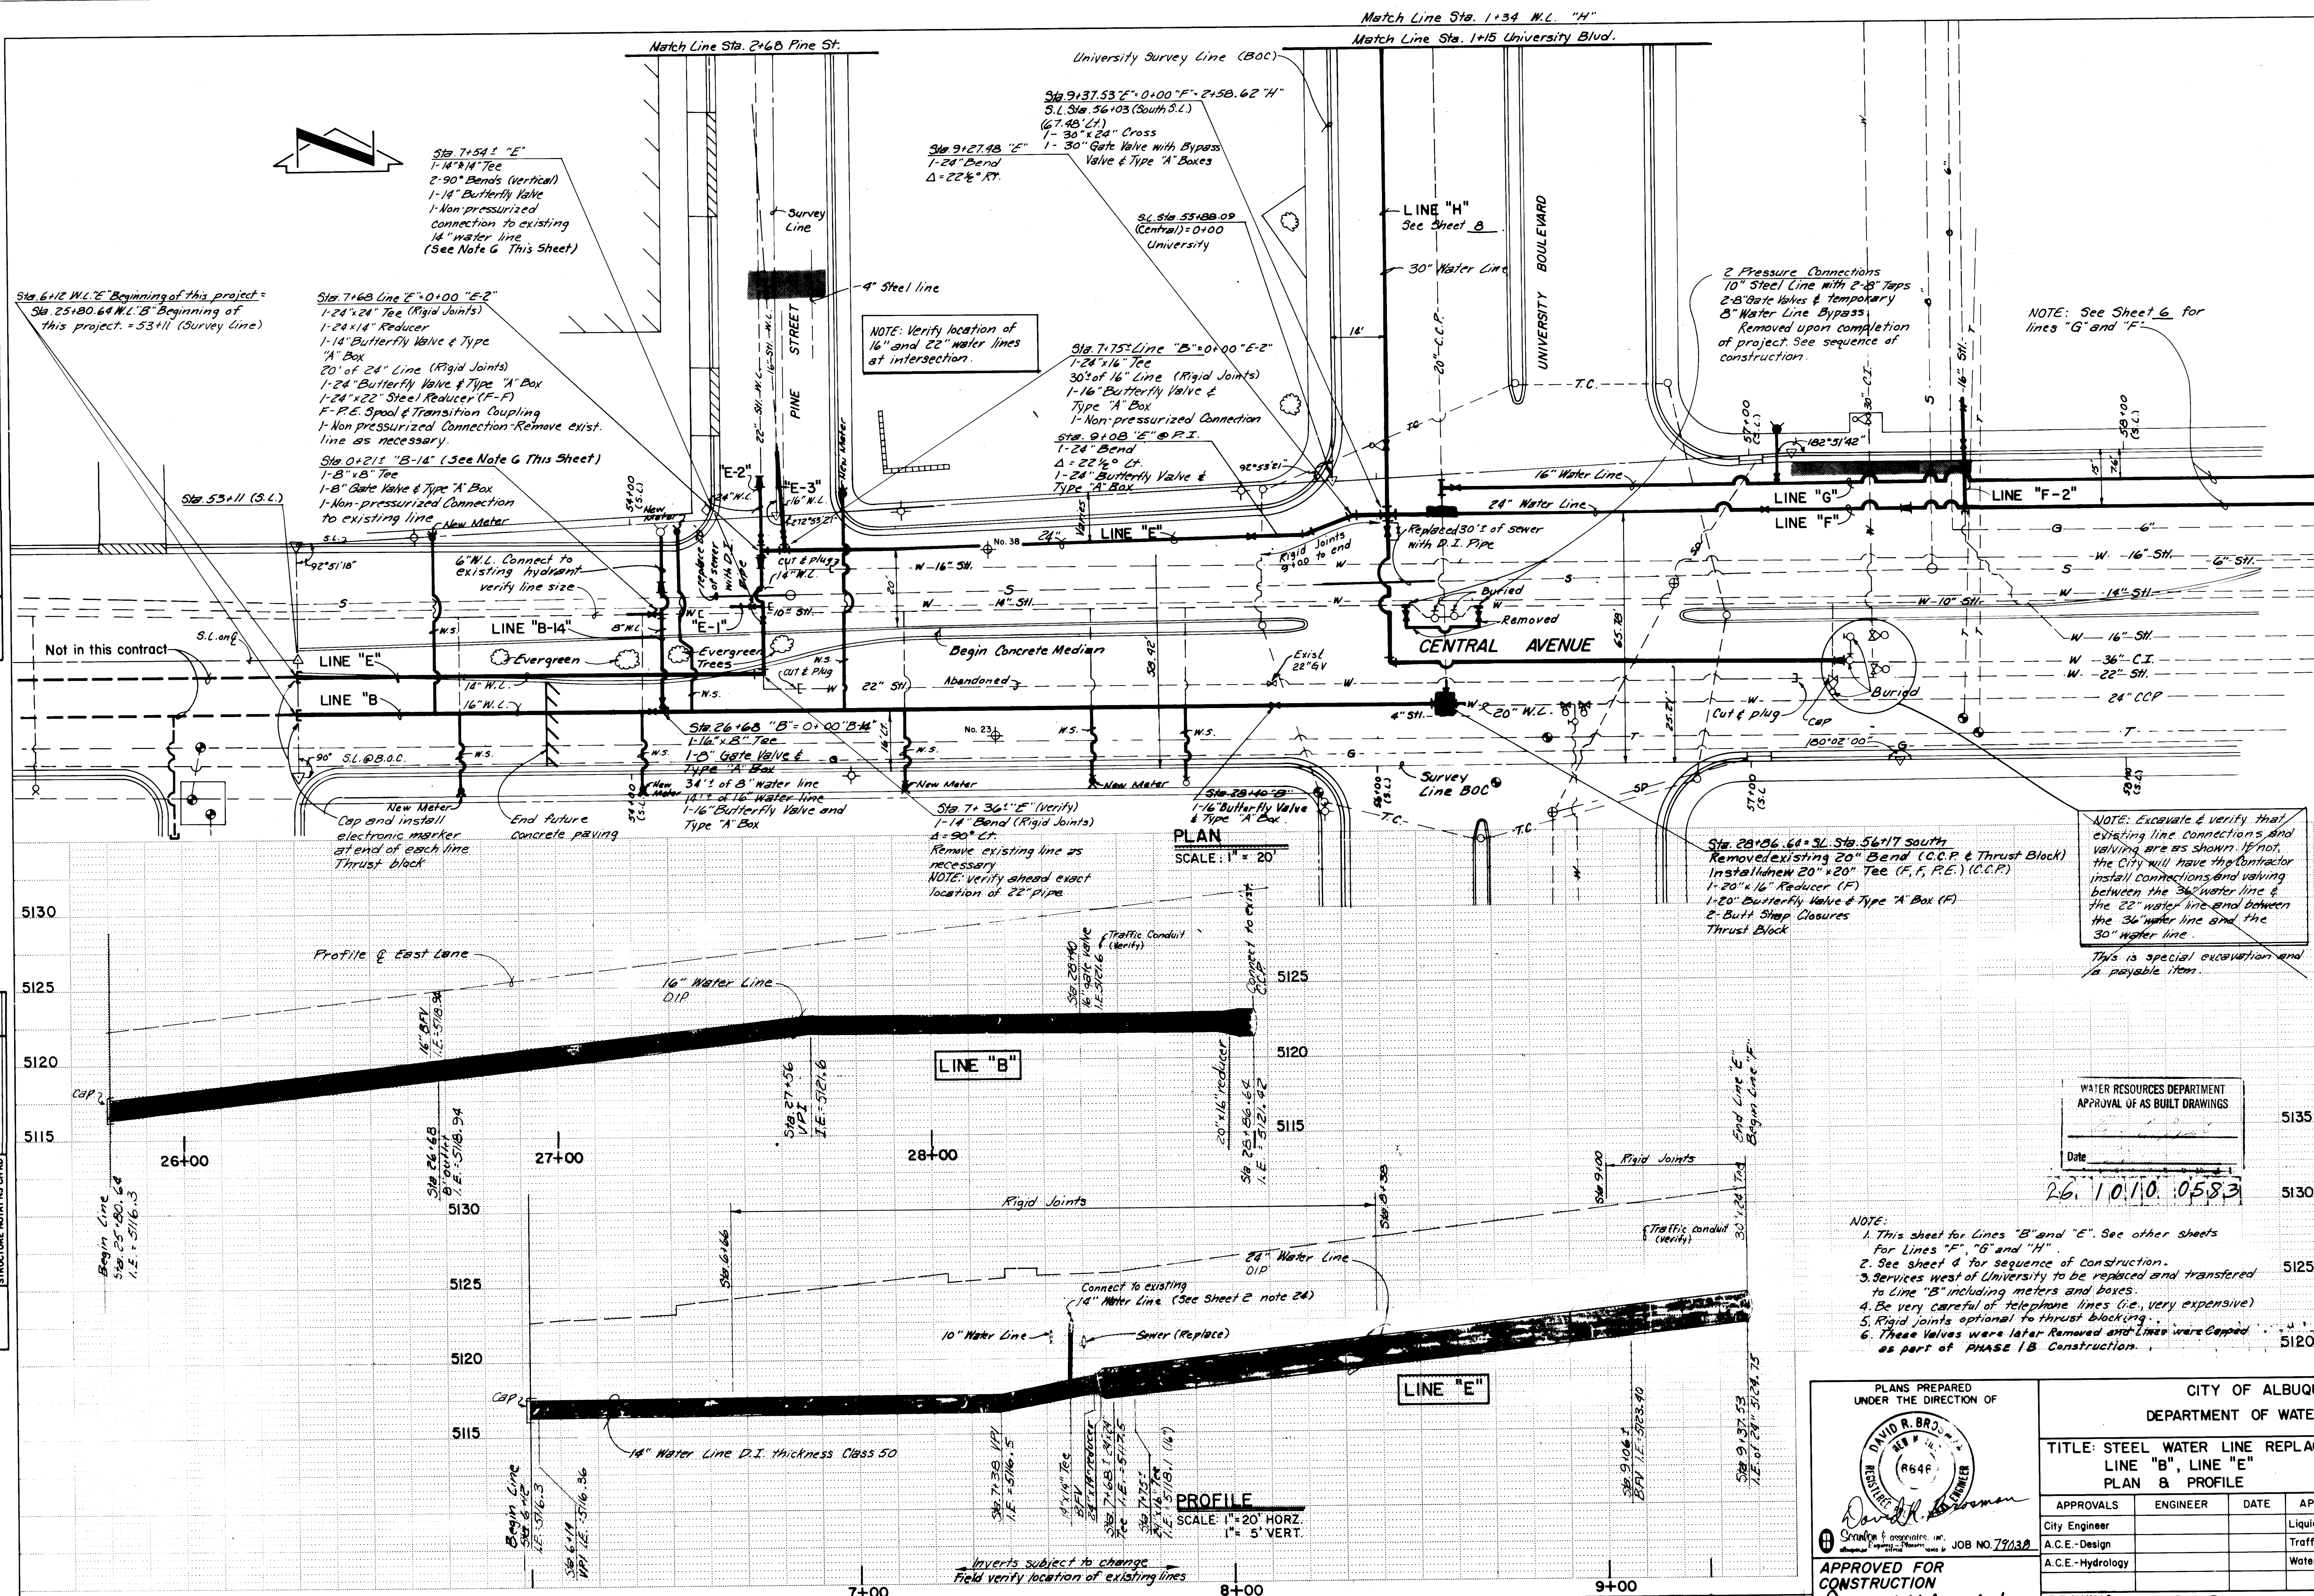

PLANS PREPARED UNDER THE DIRECTION OF

DAVID R. BROWN
CITY ENGINEER

APPROVED FOR CONSTRUCTION
Richard Shih
CITY ENGINEER



CITY OF ALBUQUERQUE
DEPARTMENT OF WATER RESOURCES

**TITLE: STEEL WATER LINE REPLACEMENT - PHASE 1A
LINE "B", LINE "E"
PLAN & PROFILE**

APPROVALS	ENGINEER	DATE	APPROVALS	ENGINEER
City Engineer			Liquid Waste	<i>W. H. ...</i>
A.C.E. - Design			Traffic	<i>N.A.</i>
A.C.E. - Hydrology			Water	<i>W. H. ...</i>

DRAWING NO. **1010**

SHEET 5 OF 5

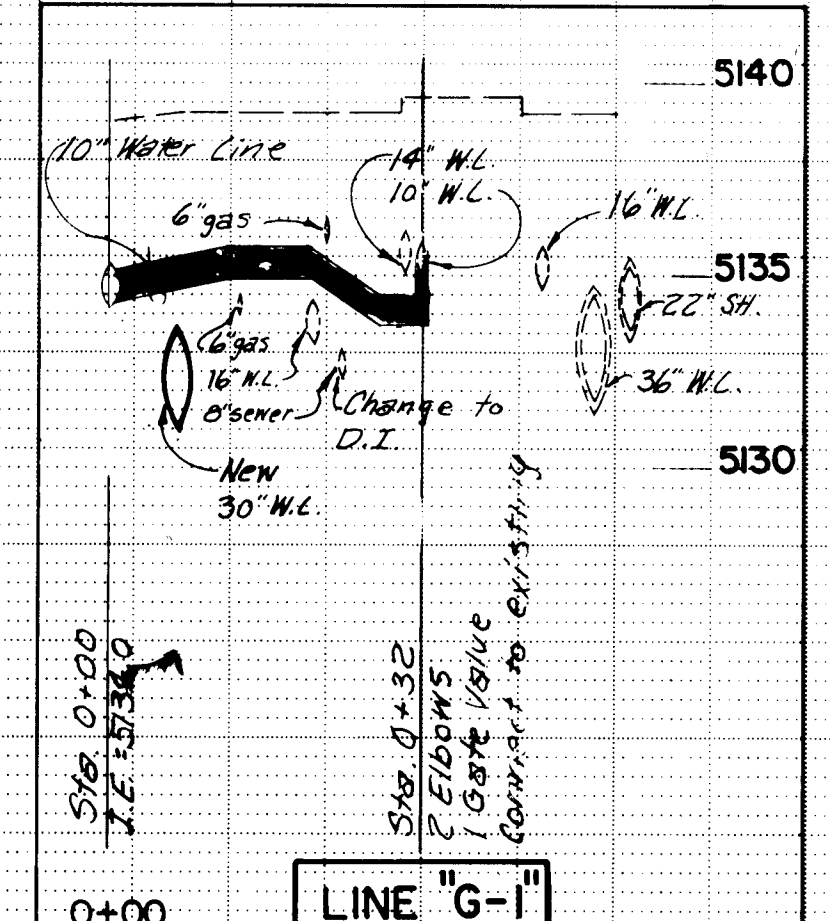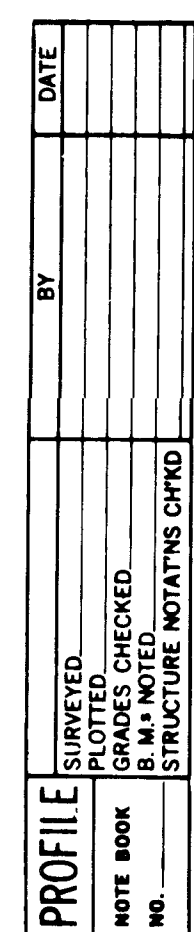

PLANS PREPARED
UNDER THE DIRECTION OF

DAVID R. BRIDGES
MEMBER
NATIONAL BOARD OF
1946
REGISTERED PROFESSIONAL ENGINEER

David R. Bridges

© Copyright © 1996 by the American Society of Mechanical Engineers
All rights reserved. No part of this publication may be reproduced, stored in a retrieval system, or transmitted, in any form or by any means, electronic, mechanical, photocopying, recording, or by any information storage and retrieval system, without permission in writing from the American Society of Mechanical Engineers.

APPROVED FOR
CONSTRUCTION

Richard S. Niles 1/14/61

CITY ENGINEER DATE

CITY OF ALBUQUERQUE					
DEPARTMENT OF WATER RESOURCES					
TITLE: STEEL WATER LINE REPLACEMENT - PHASE 1A LINE "F", LINE "F-I", LINE "G", LINE "G-I" PLAN & PROFILE					
APPROVALS	ENGINEER	DATE	APPROVALS	ENGINEER	DATE
City Engineer			Liquid Waste	<i>[Signature]</i>	1/9/87
A.C.E. - Design			Traffic	<i>[Signature]</i>	
A.C.E. - Hydrology			Water	<i>[Signature]</i>	1/9/87
DRAWING NO. 1010			SHEET 6 OF 10		

[illegible]

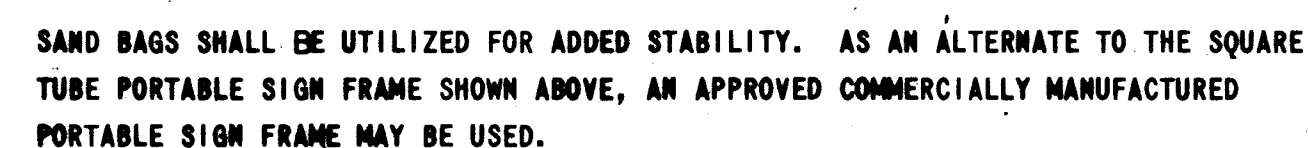


Diagram illustrating three types of bollards:

- Square tubing or flanged channel post:** A bollard with a diameter of 6" and a 45° angle.
- Double:** A bollard with a height of 24".
- Single:** A bollard with a height of 42".

PANELS TO BE 0.060 MINIMUM, 6061-T6 OR 5052-H38 ALUMINUM ALLOY MOUNTED ON 1/2" MINIMUM SQUARE STEEL TUBING POST OR 1.38"/ft. MINIMUM FLANGED CHANNEL POST. STRIPES SHALL SLANT DOWNWARD AT 45° TOWARD THE SIDE WHICH TRAFFIC IS TO PASS. FOR TEMPORARY INSTALLATION THE POST MAY BE SET TO 3 ft. BELOW GROUND OR THE PANELS MAY BE MOUNTED ON STANCHIONS.


Diagram illustrating the cross-section of a three-rail track. The top rail is 1'-6" high. The middle and bottom rails are 1'-6" apart. The total height of the track structure is 5'-0". The total width of the track structure is 8'-0".

48"

**STREET
CLOSED**


30"

Mount on Type III
Barricade




48"

18"

DETOUR 

Mount on Type II Barricade



A diagram of a diamond interchange. The main diamond-shaped sign contains a black arrow pointing straight up, which then curves 90 degrees to the right. The sign is labeled with "48'" on its right side. Below the diamond is a rectangular speed limit sign with the text "XX MPH". The rectangular sign is labeled with "24'" on its right side and "24'" at its bottom.

A diagram of a diamond interchange. A diamond-shaped sign with a black arrow pointing up and to the right is shown. The sign is labeled with "48'" on the top and right sides. Below the diamond is a rectangular sign with the text "XX MPH" and "24'" on the right side.

A diagram of a diamond interchange. The main diamond-shaped sign is 48" wide and 48" high, featuring a black arrow pointing diagonally upwards and to the right. Below it is a rectangular speed limit sign, 24" wide, with the text "XX MPH".



60"
END
CONSTRUCTION 24"

Diagram illustrating sandbags for added stability. The setup shows a vertical post secured by three sandbags. The dimensions are specified as follows:

- Distance between the top two sandbags: 1'5"
- Distance between the middle and bottom sandbags: 1'8"
- Total height of the sandbag stack: 5' minimum
- Base width: 6' or 8'

TYPE III BARRICADE FRAMING AND SUPPORTS SHALL BE 2" x 2"
MINIMUM - 12 GAUGE SQUARE METAL TUBING OR DRIVEDOWN POSTS

RAIL SHALL BE 1/2" MINIMUM 5 PLY SIGN GRADE
PLYWOOD OR 2" x 8" S4S QUALITY WOOD. ON
TYPES "I" AND "II", METAL RAILS, IF USED
MUST BE LIGHT WEIGHT MATERIAL, COMMENSURATE
WITH STRUCTURAL SOUNDNESS. STRIPES SHALL
SLANT DOWNWARD AT 45° TOWARD THE SIDE WHICH
TRAFFIC IS TO PASS.


		REFERENCES		SURVEY INFORMATION		BENCH MARKS		AS BUILT INFORMATION	
		MAP NO		FIELD NOTES				CONTRACTOR	
		EST NO		W/O NO		NO		BY	
		DATE		REMARKS		BY		DATE	
DESIGN									
DESIGNED BY <i>D.R.B.</i> DATE <i>8/80</i>									
DRAWN BY <i>S.G.H.</i> DATE <i>8/80</i>									
CHECKED BY <i>D.P.A.</i> DATE <i>1/80</i>									
REVISIONS									
DRAWINGS CORRECTED BY <i>Scarlioni & Assoc.</i> DATE <i>10/82</i>									
MICRO-FILM INFORMATION									
RECORDED BY									
DATE									
NO									

1	2	3	4	5	6	7	8	9	10	11
2	6		1	0	1	0		1	0	8

**WATER RESOURCES DEPARTMENT
APPROVAL OF AS BUILT DRAWING**

Date 6/30/20

PLANS PREPARED
UNDER THE DIRECTION OF



David R. Beerman
Professional Engineer
No. 9944
State of New Mexico

David R. Beerman
CITY ENGINEER
DATE 1/18/81

CITY OF ALBUQUERQUE

DEPARTMENT OF WATER RESOURCES

TITLE: STEEL WATER LINE REPLACEMENT — PHASE 1A
TYPICAL CONSTRUCTION SIGNING

APPROVALS	ENGINEER	DATE	APPROVALS	ENGINEER	DATE
City Engineer			Liquid Waste	<i>[Signature]</i>	<u>1/18/81</u>
A C E - Design			Traffic	<i>[Signature]</i>	<u>1/18/81</u>
A C E - Hydrology			Water	<i>[Signature]</i>	<u>1/18/81</u>
DRAWING NO. 1010			SHEET 10 OF 10		