

PLAN	SURVEYED	DATE
	NOTE BOOK	BY
	ALIGNED	
	CHECKED	

PROFILE	SURVEYED	DATE
	NOTE BOOK	BY
	ALIGNED	
	CHECKED	

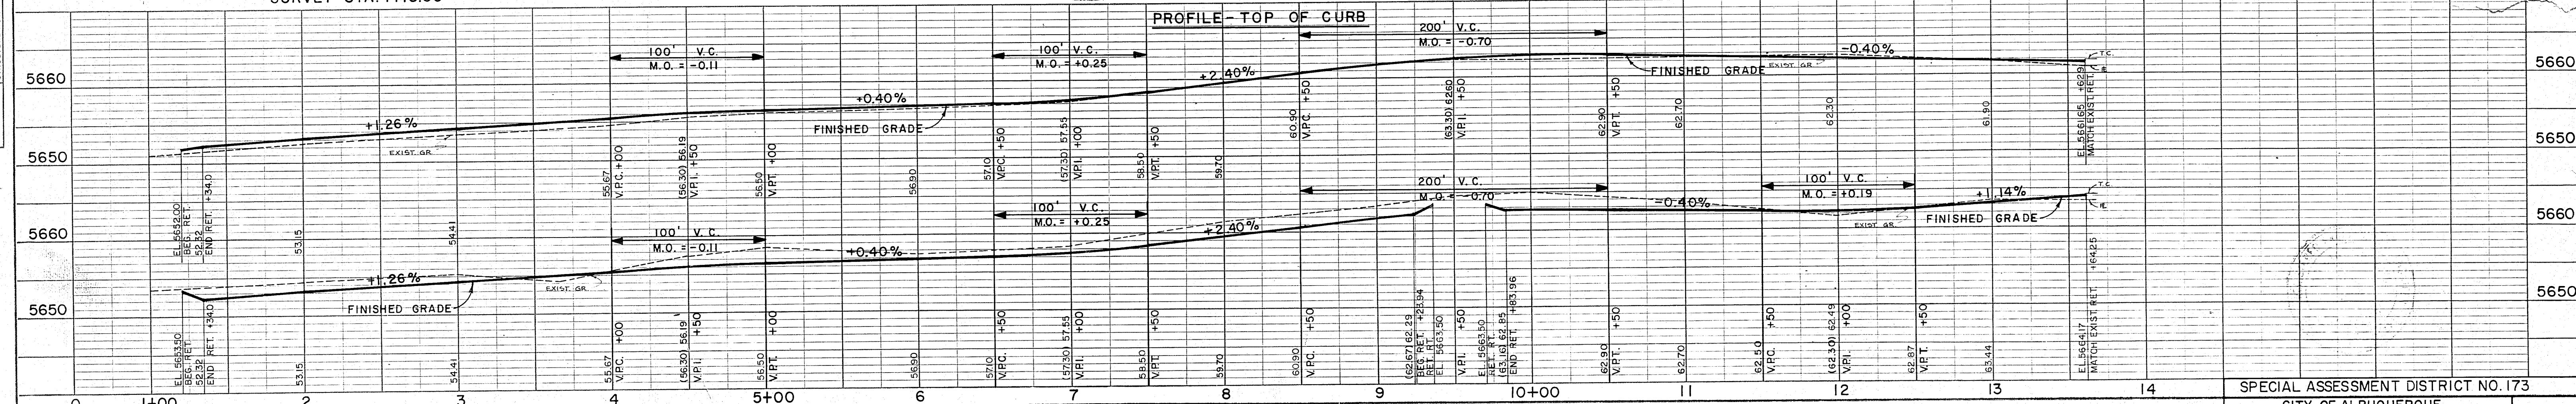
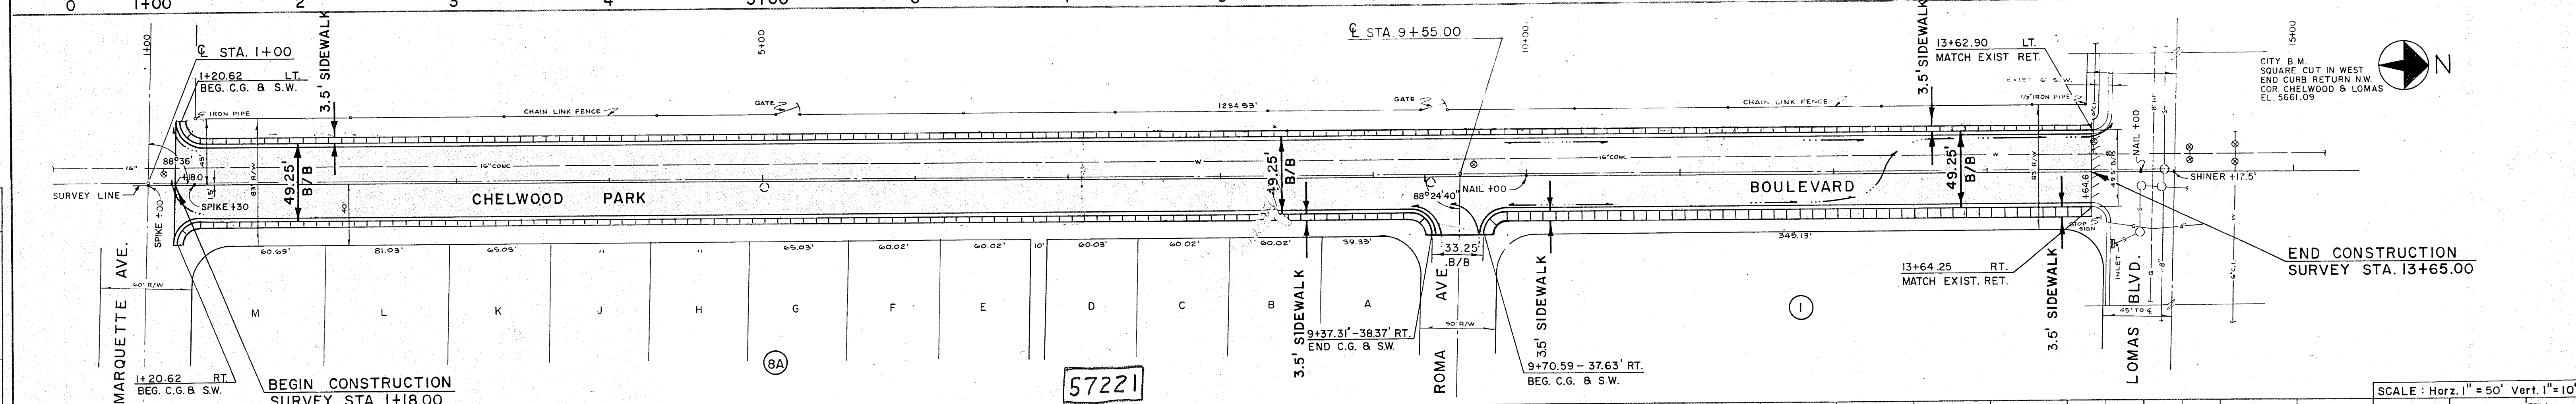
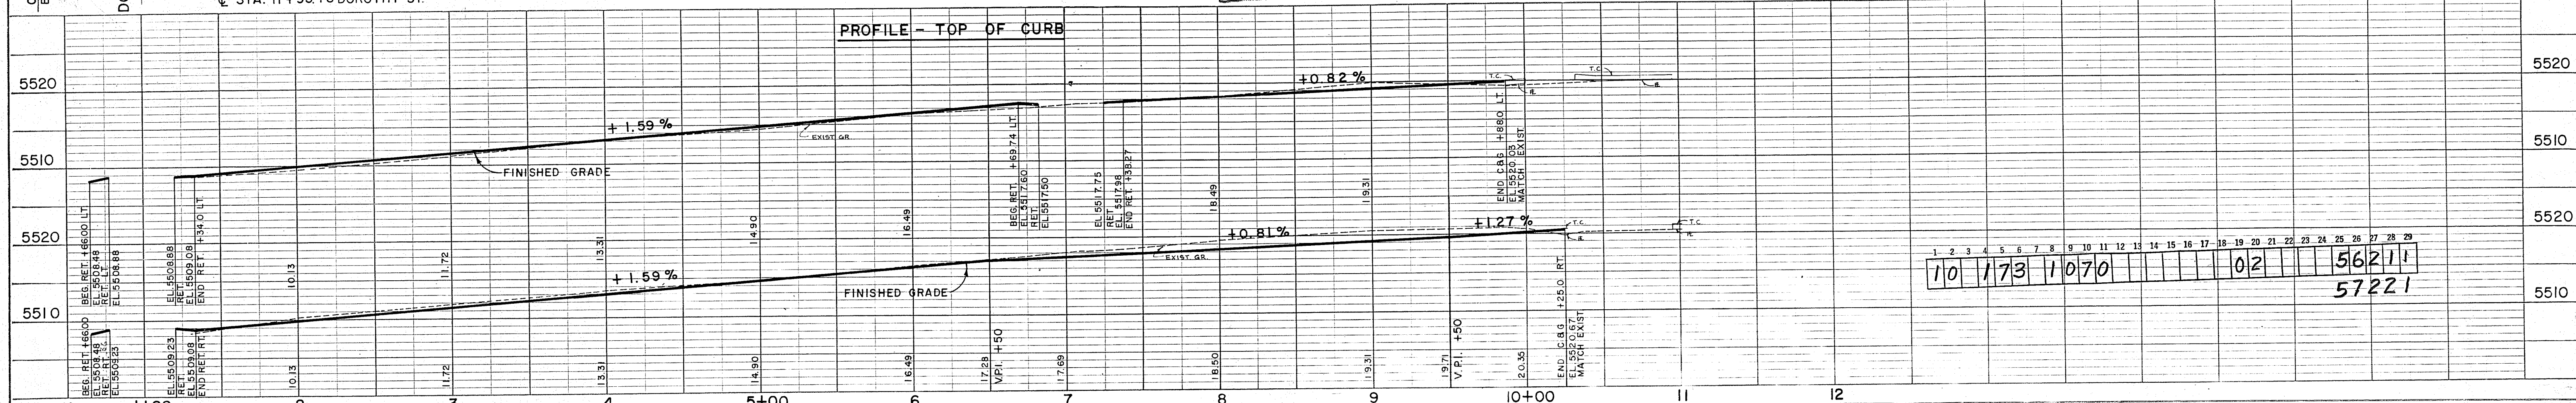
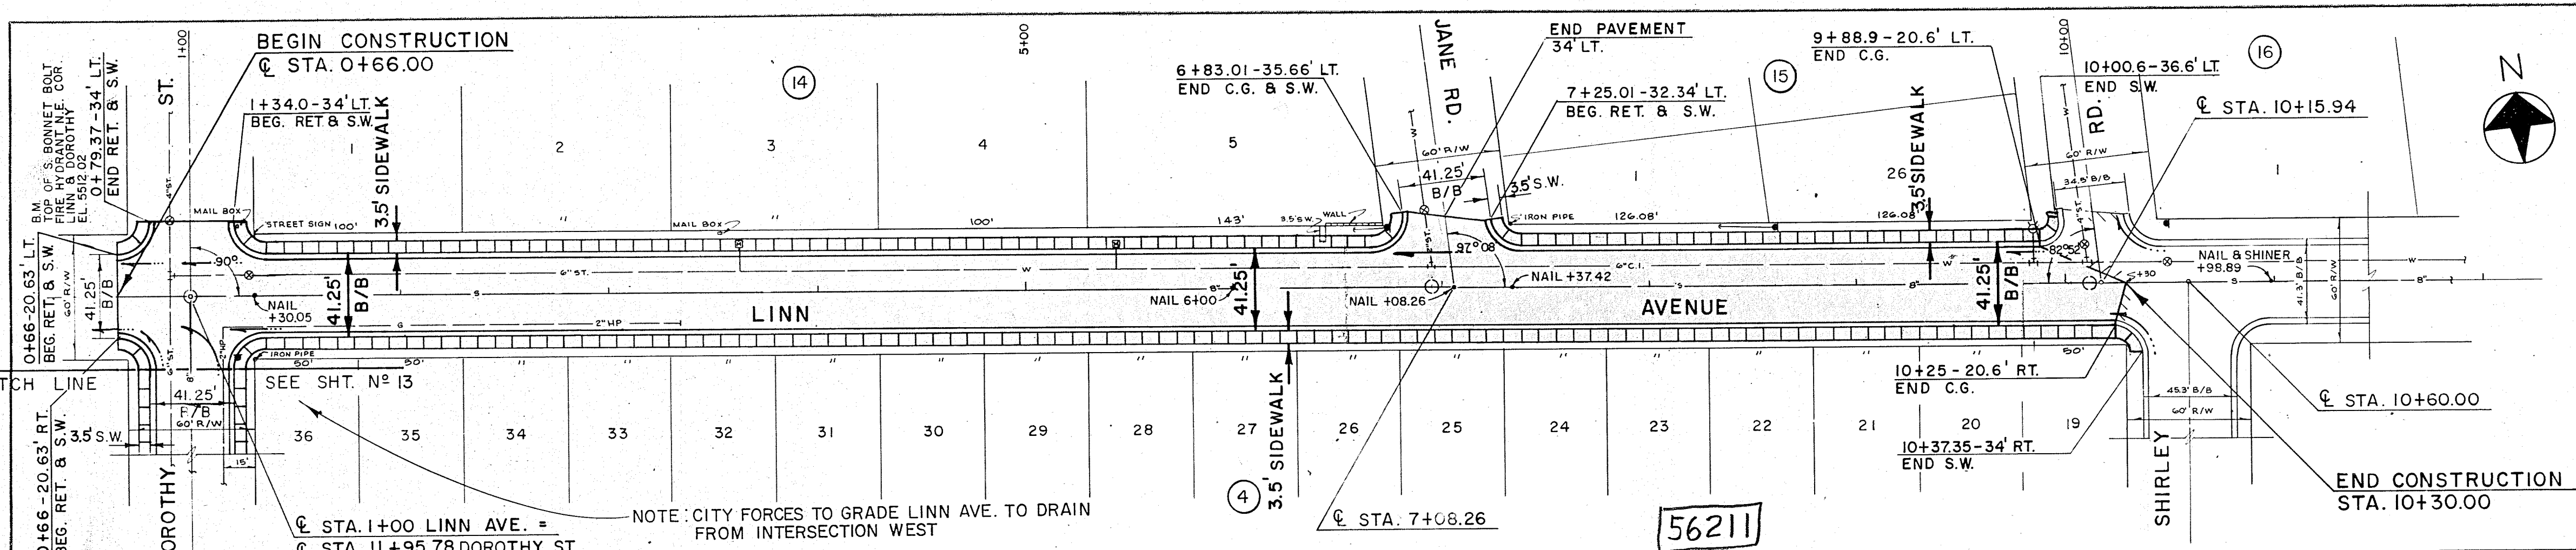


PLATE 2-PLAN-PROFILE O.P.R.R.E.
MADE AND PRINTED IN U.S.A.
CHARLES BRUNING COMPANY

AS BUILT DRAWING

PLAN	DATE	
	BY	
NO.	SURVEYED	
	NOTE BOOK	

PROFILE	DATE	
	BY	
NO.	SURVEYED	
	NOTE BOOK	

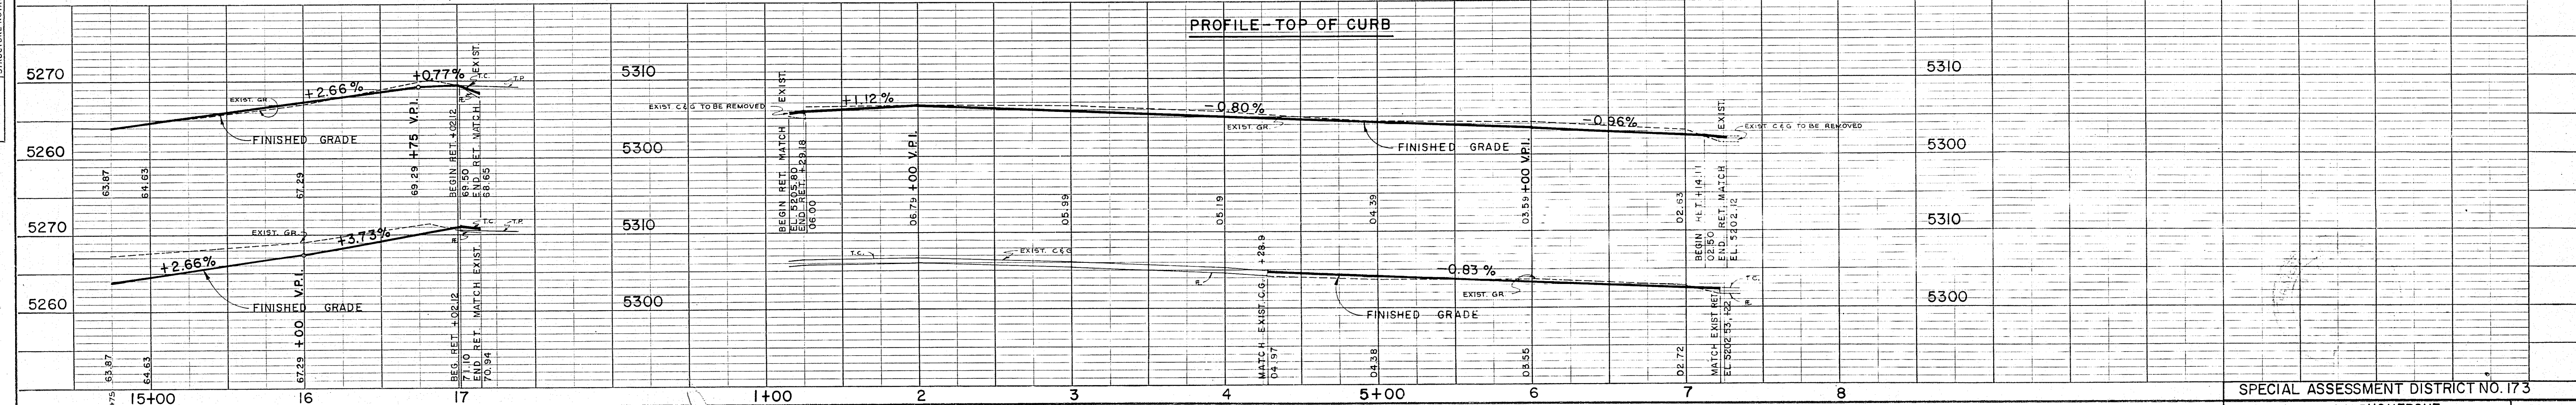
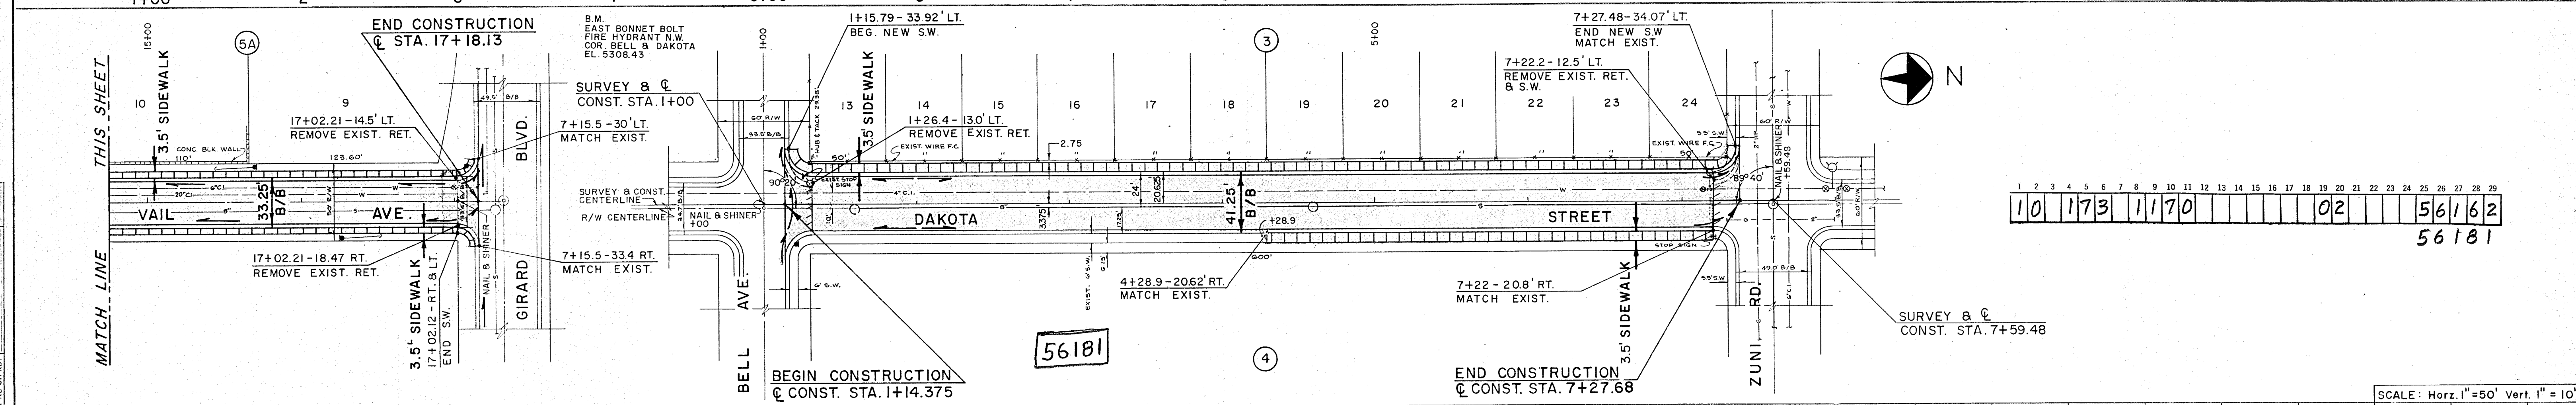
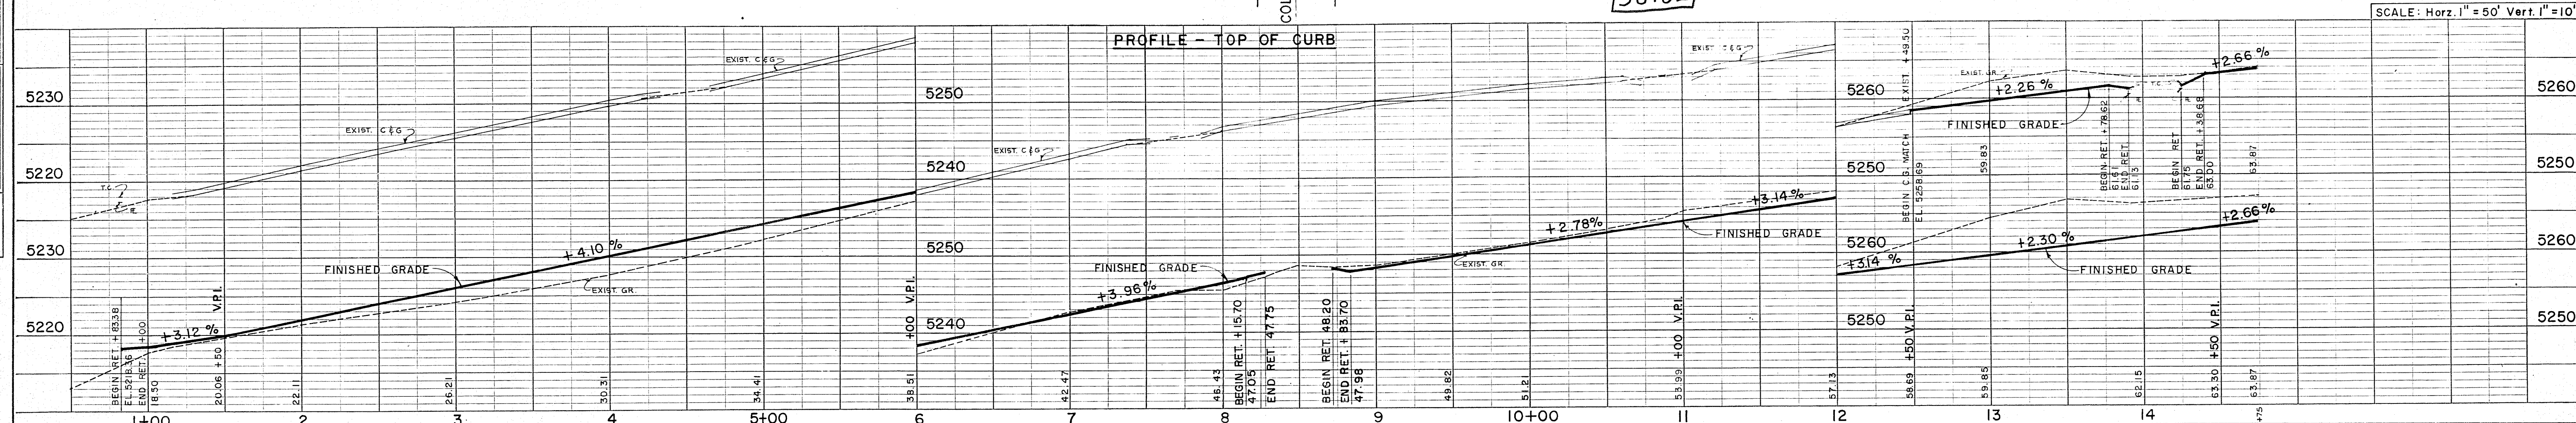
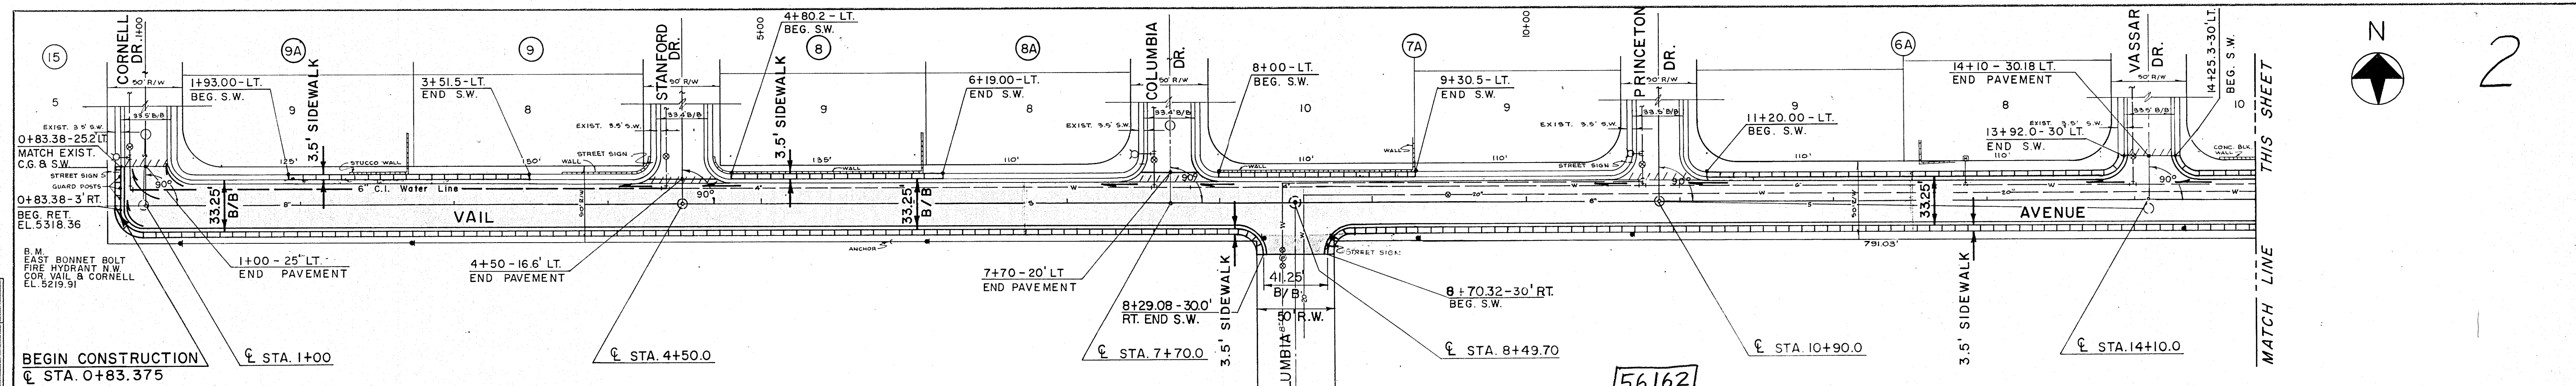


PLATE 2-PLAN-PROFILE O.P.R.R.E.
MADE AND PRINTED IN U.S.A.
CHARLES BRUNING COMPANY

REVISED JULY 8, 1970

AS BUILT DRAWING

PLAN	DATE	BY
SURVISED.		
NOTE BOOK		
ALIGNMENT CHECKED		
RT. OF WAY CHECKED		
NO.		

PROFILE	DATE	BY
SURVISED.		
NOTE BOOK		
GRADES CHECKED		
B. M. NOTED		
STRUCTURE NOTATION CHKD.		
NO.		

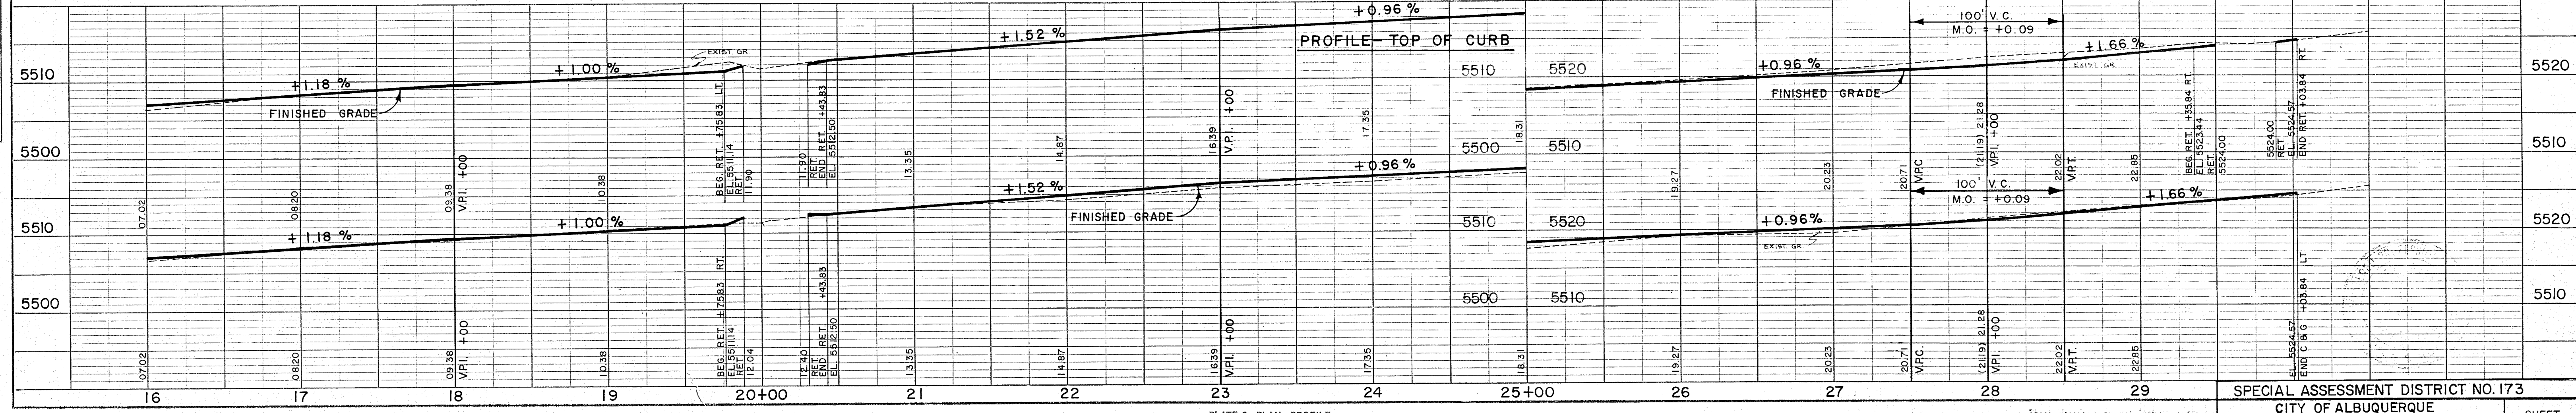
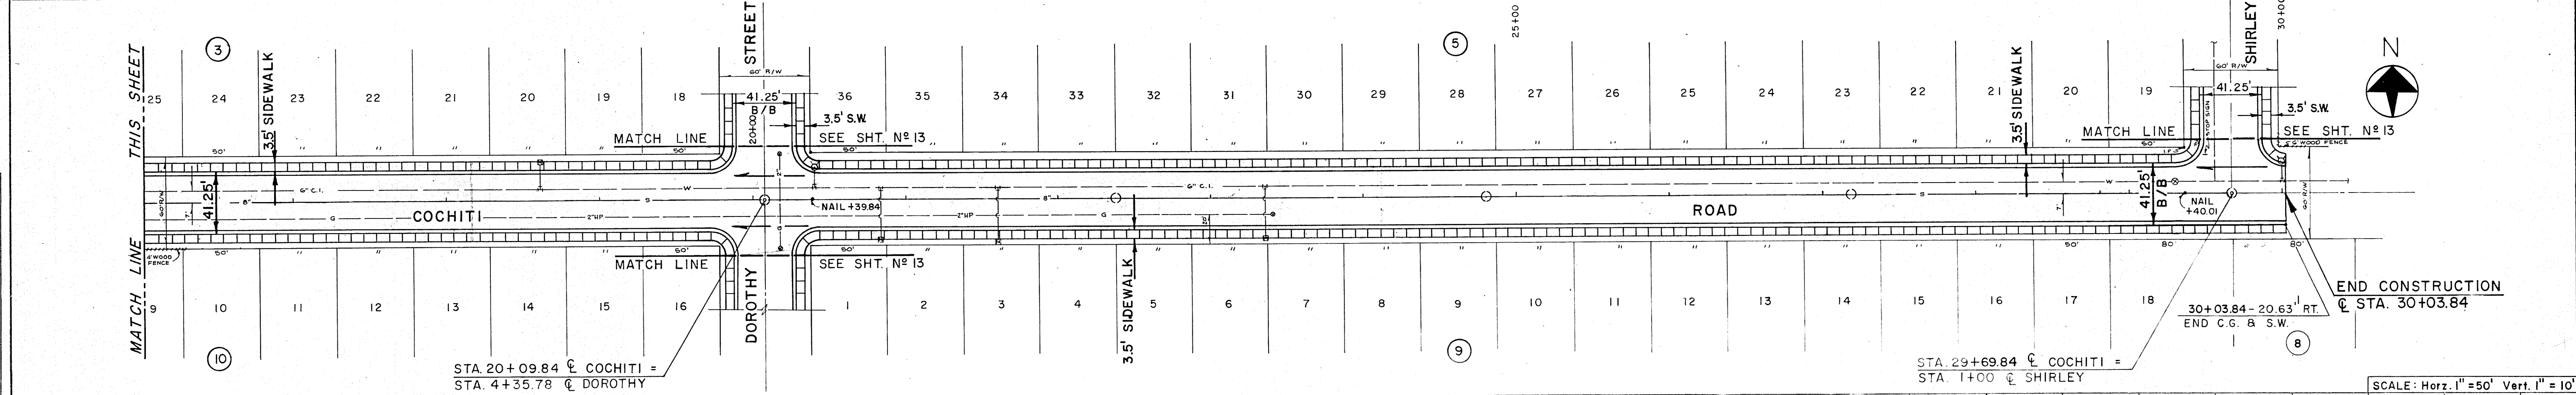
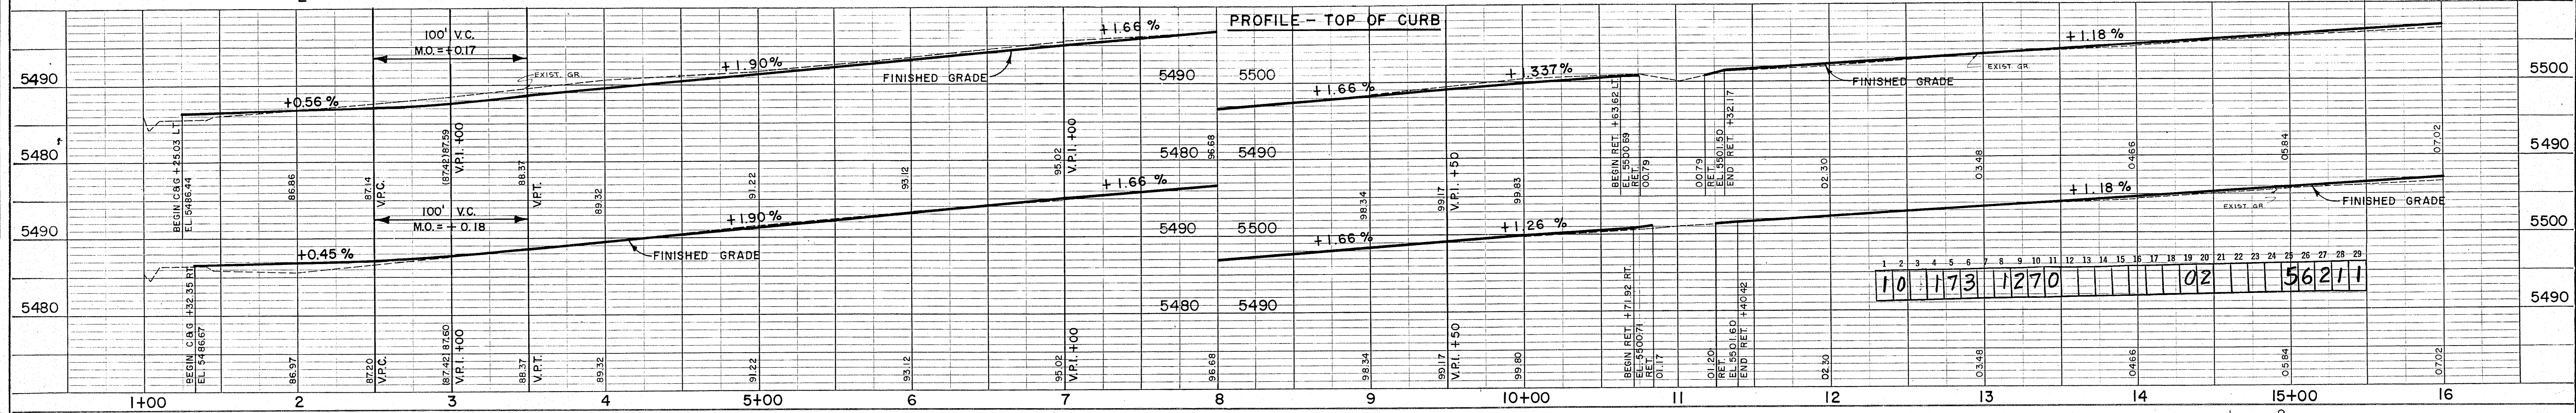
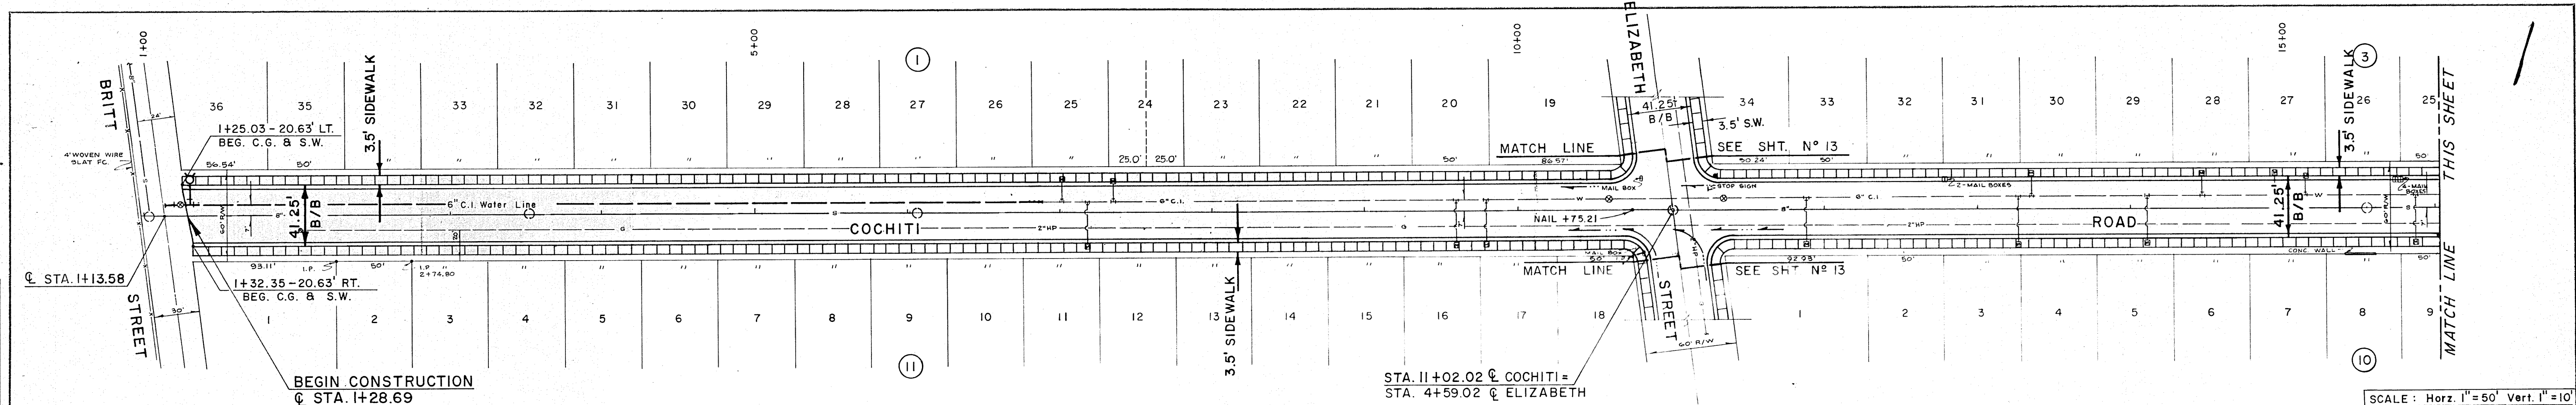


PLATE 2-PLAN-PROFILE D. P. R. R. E.
MADE AND PRINTED IN U.S.A.
CHARLES BRUNING COMPANY

AS BUILT DRAWING

These drawings are not to be used for any other purpose than the construction of the project shown on the drawings.

SPECIAL ASSESSMENT DISTRICT NO. 173	
CITY OF ALBUQUERQUE	
PAVING PLAN & PROFILE	
COCHITI RD. (Britt To Shirley)	
SHEET	12 OF

PLAN	DATE	BY
SURVEYED		
NOTED		
NO. OF WAY CHECKED		

PROFILE	DATE	BY
SURVEYED		
NOTED		
NO. OF WAY CHECKED		

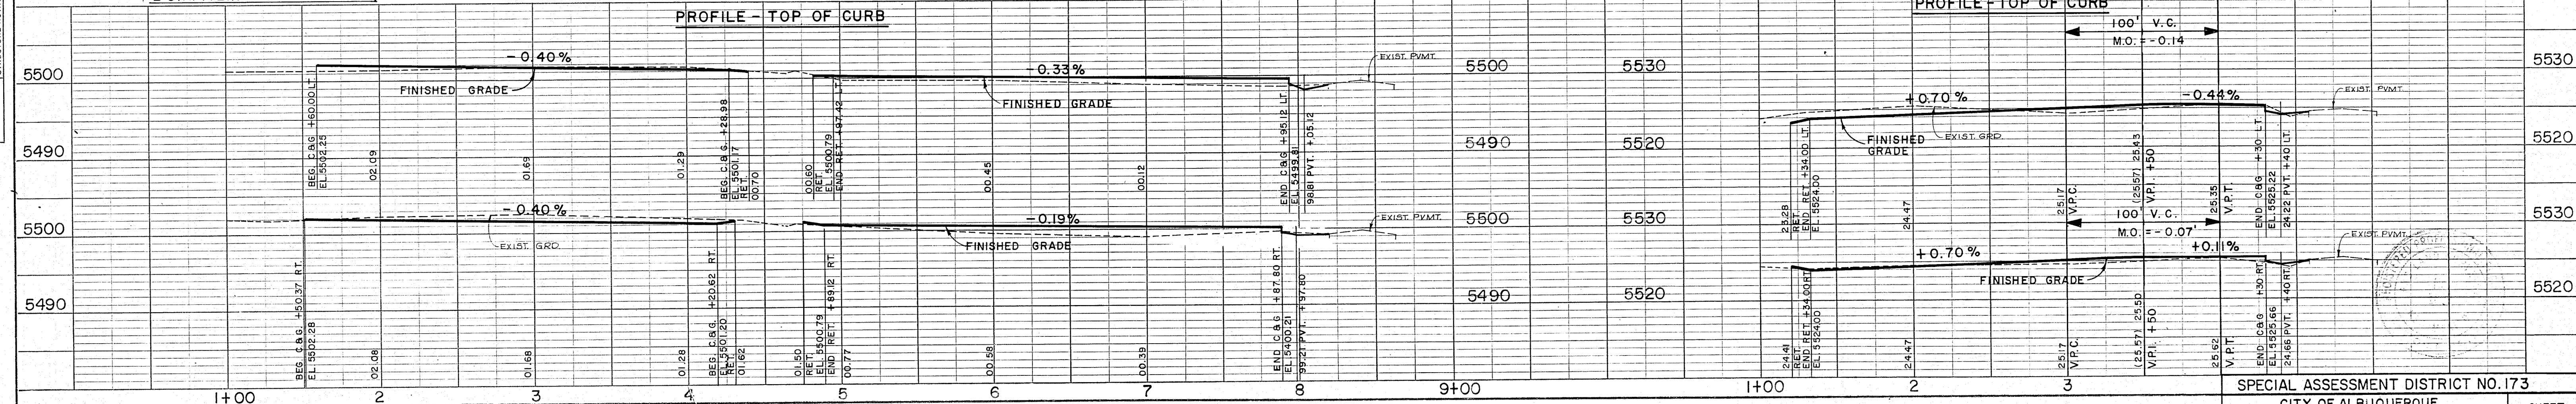
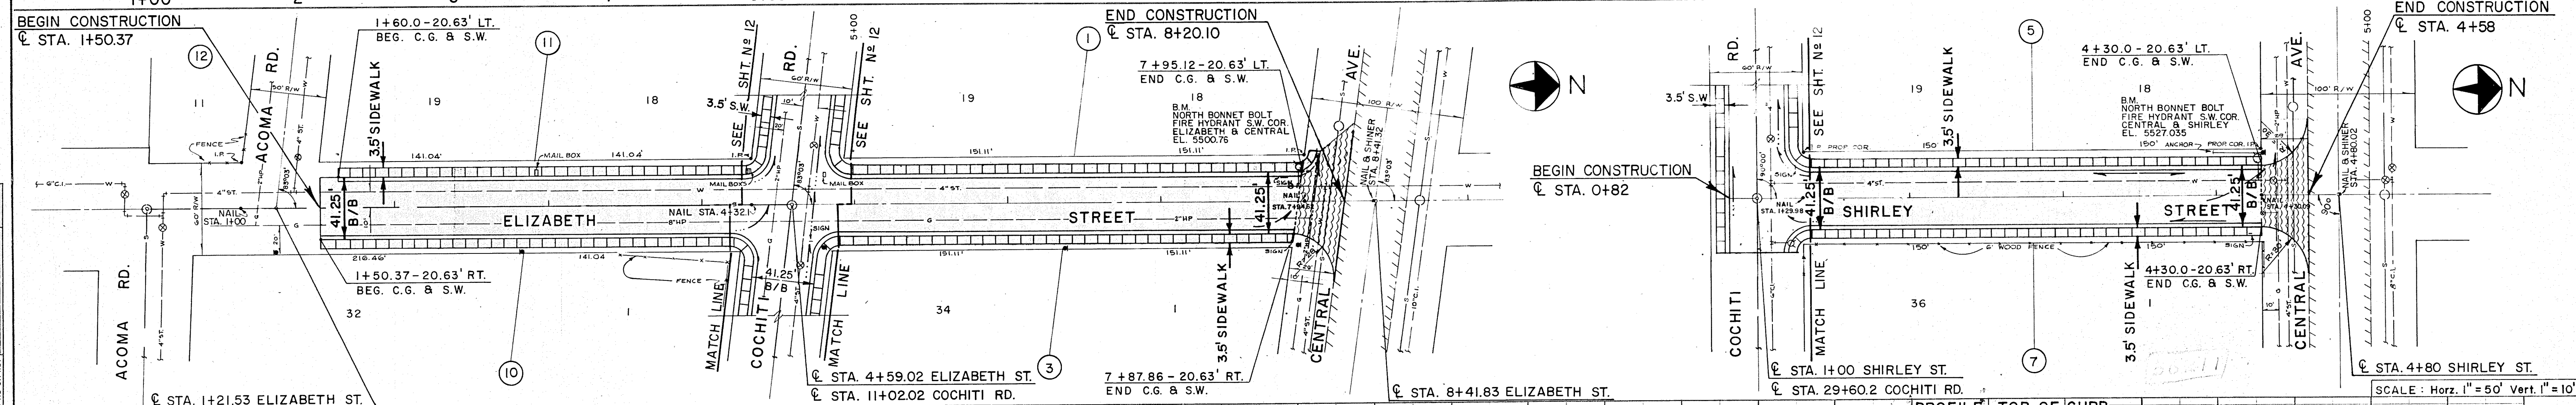
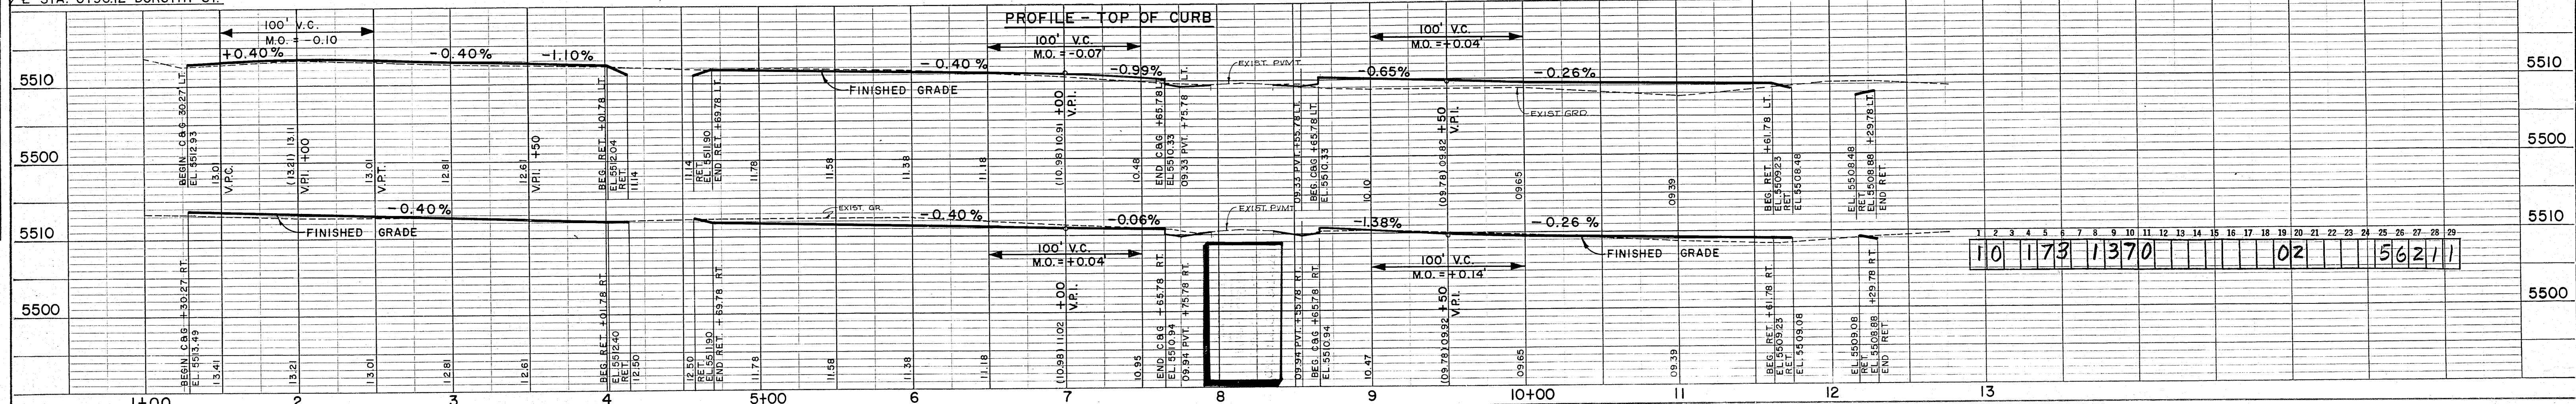
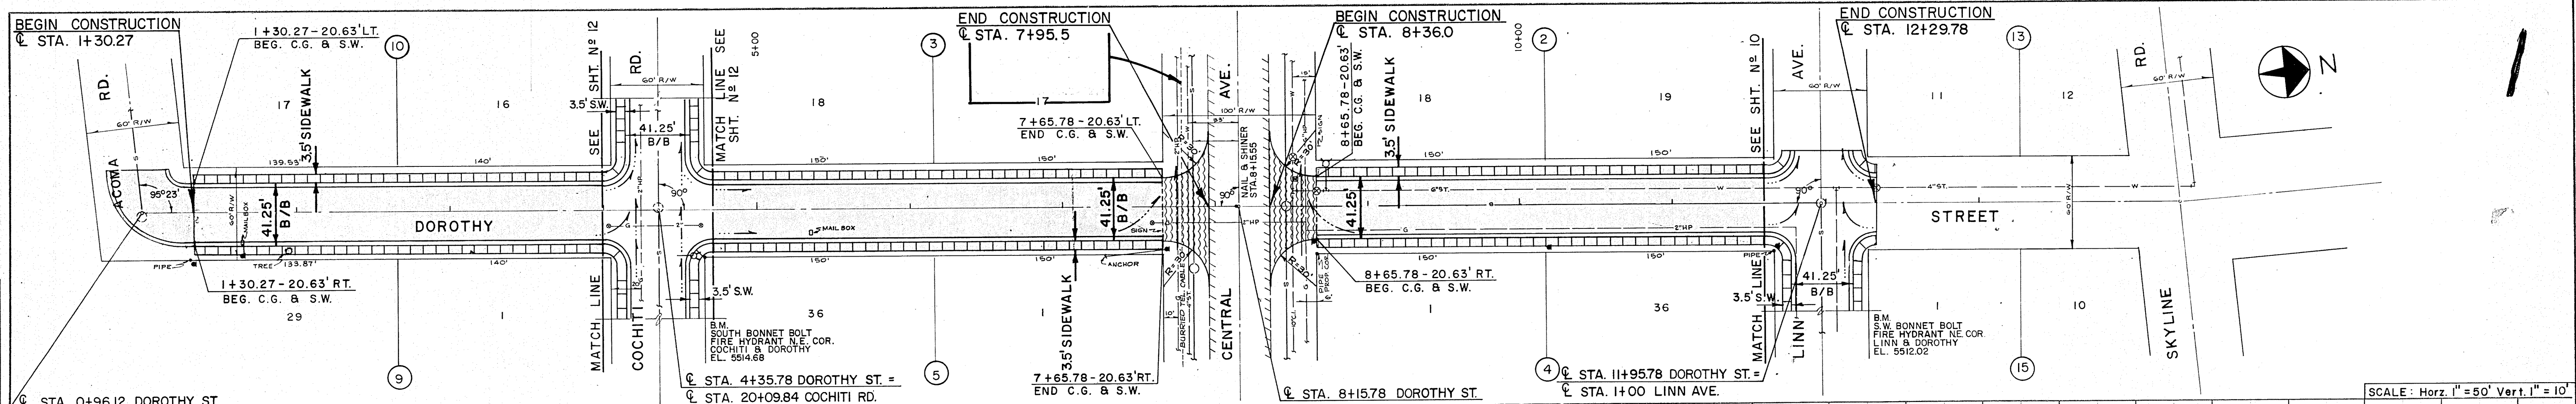


PLATE 2-PLAN-PROFILE O. P. R. & C.
MADE AND PRINTED IN U.S.A.
CHARLES STUNING COMPANY

AS BUILT DRAWING

PLAN	DATE	BY	DATE	BY
SURVEYED				
PLOTTED				
NOTE BOOK				
RT. OF WAY CHECKED				
NO.				

PROFILE	DATE	BY	DATE	BY
SURVEYED				
PLOTTED				
NOTE BOOK				
GRADES CHECKED				
NO.				





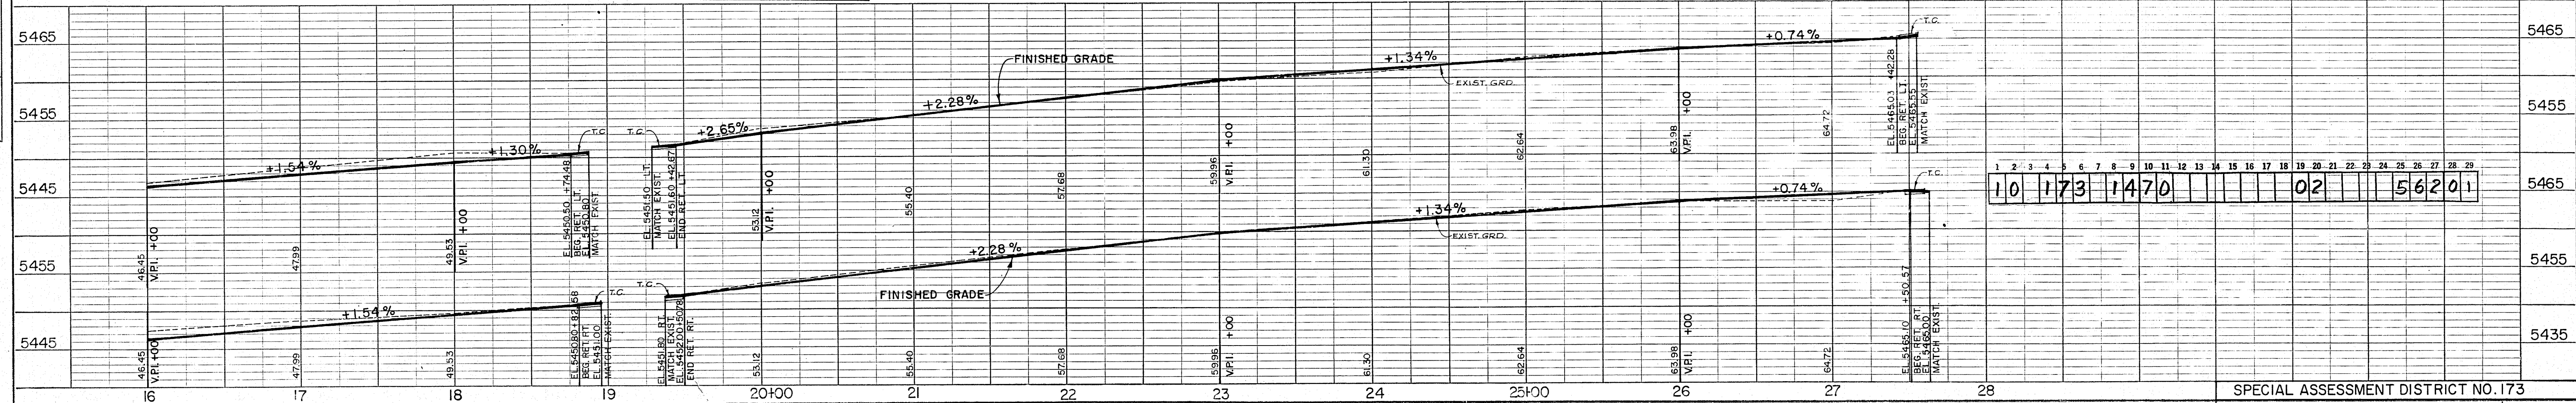


PLATE 2-PLAN-PROFILE O.P.R. & R.E.
MADE AND PRINTED IN U.S.A.
CHARLES BRUNING COMPANY

AS BUILT DRAWING

PROFILE NO. _____	SURVEYED _____ PLOTTED _____ GRADES CHECKED _____ B. M.'S NOTED _____ STRUCTURE NOTATIONS CHECKED _____	BY _____	DATE _____
	NOTE BOOK		

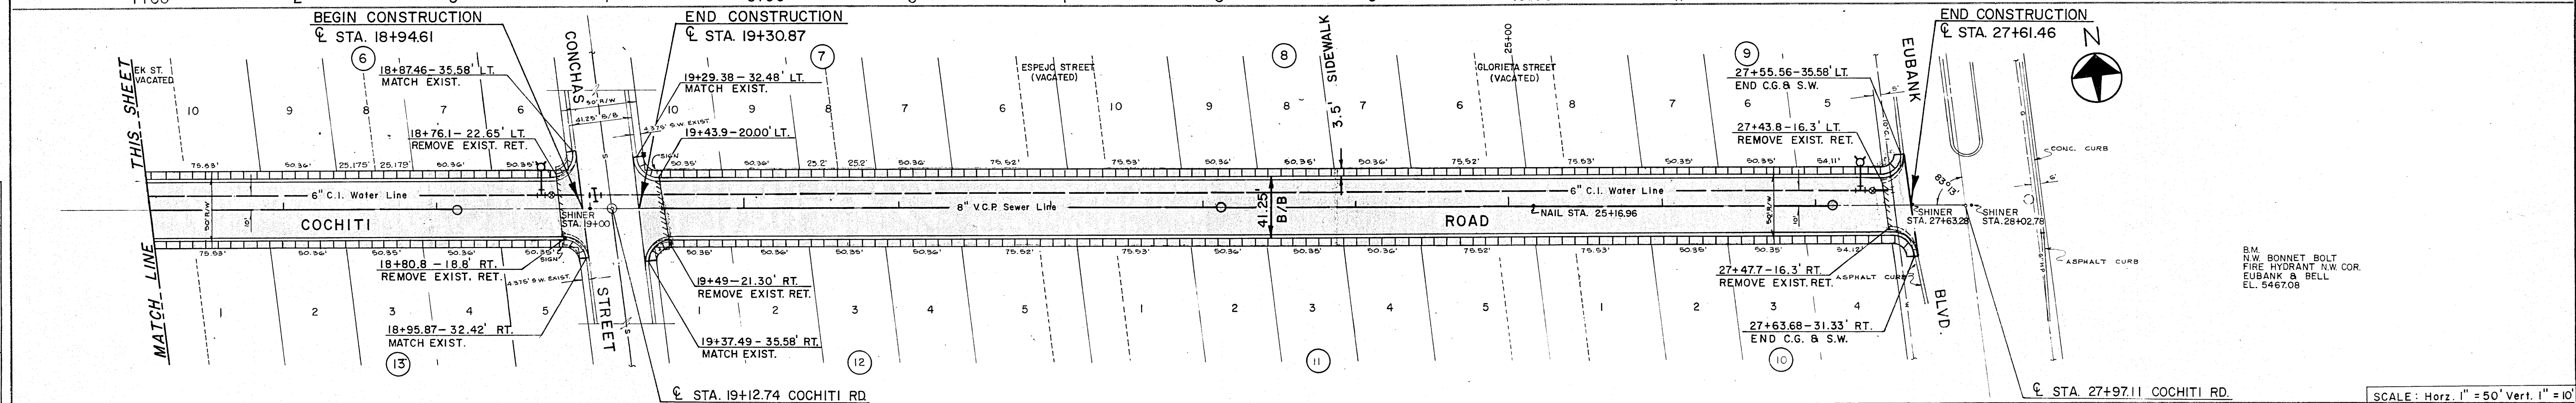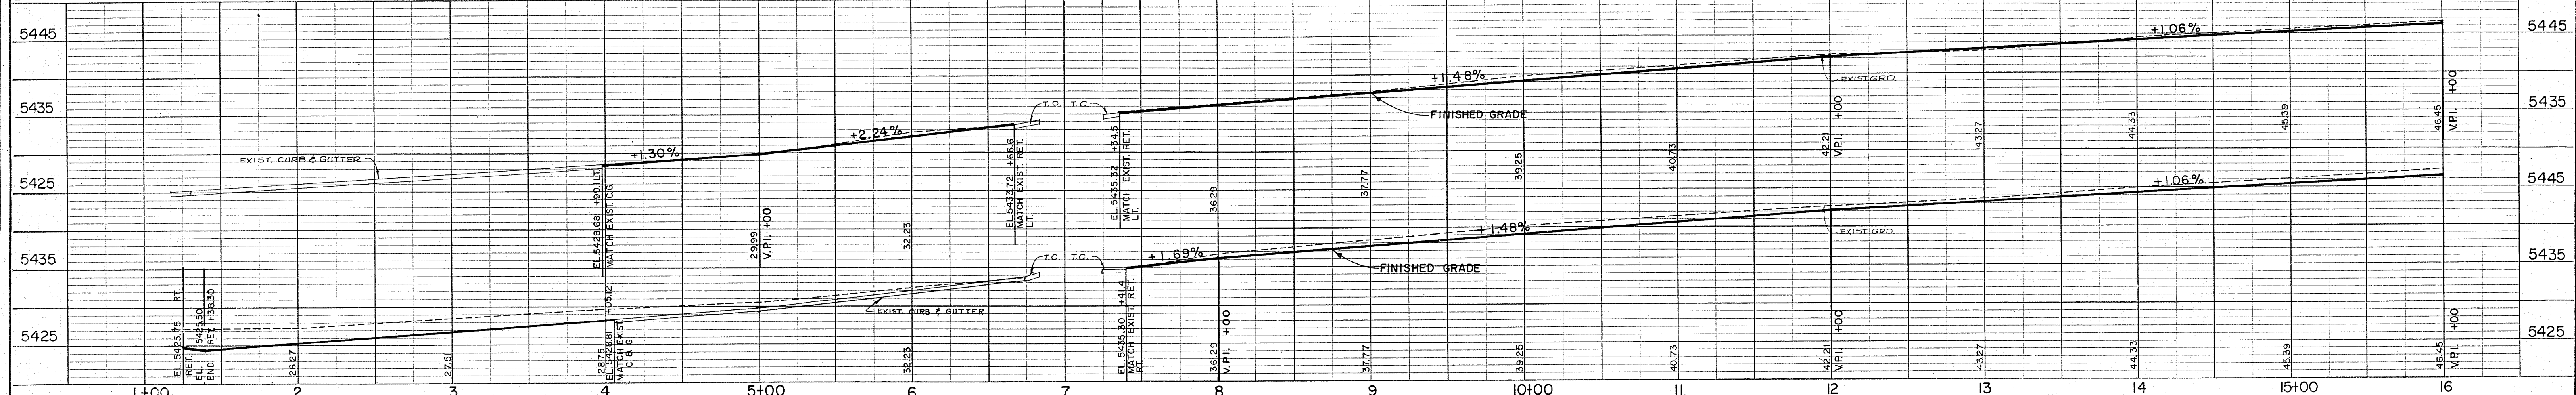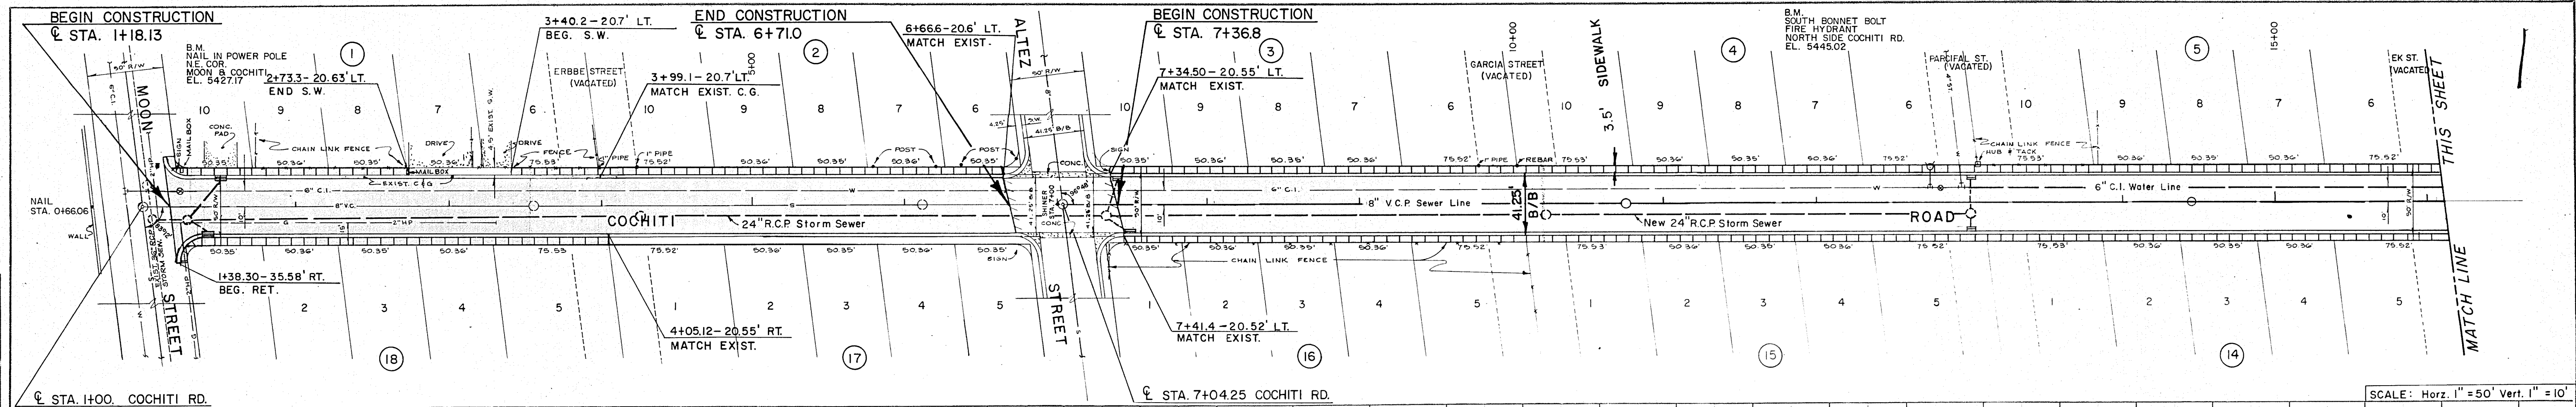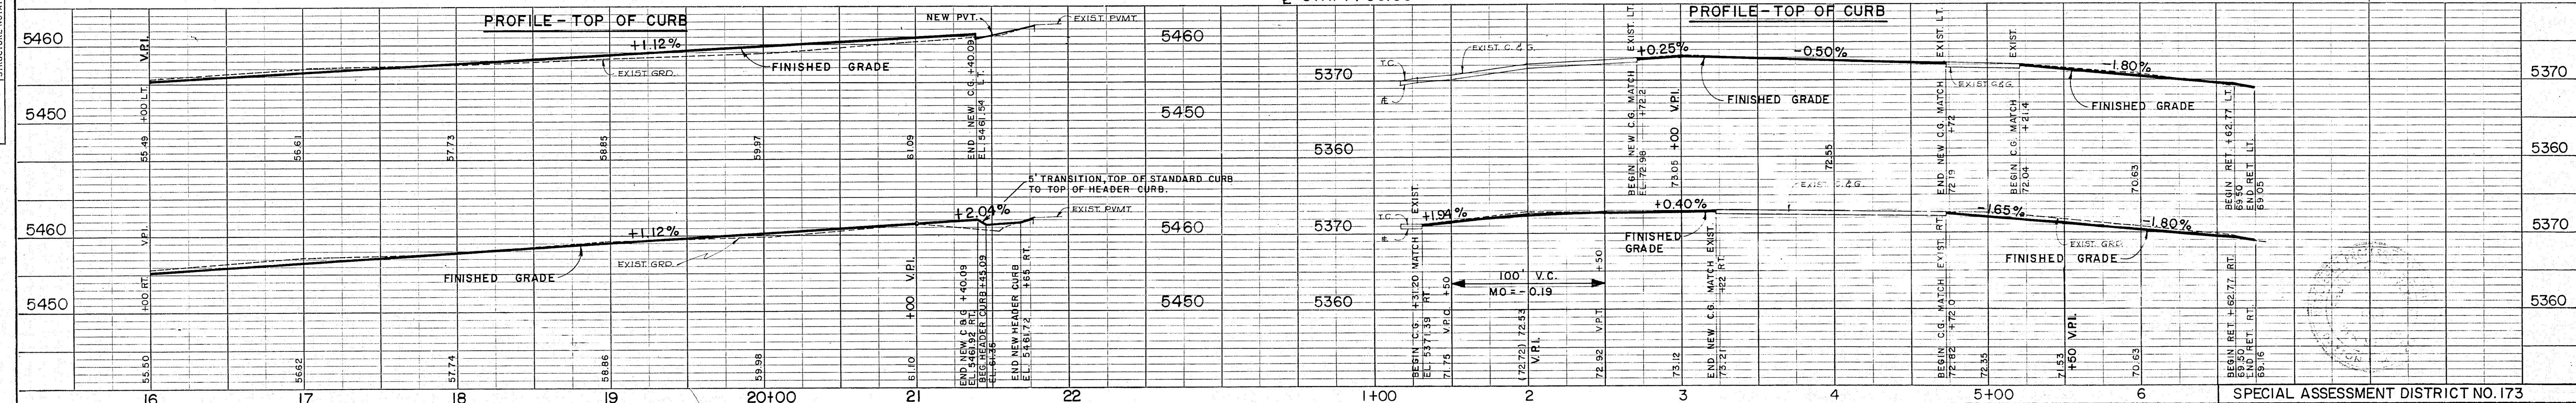

PLAN	SURVEYED	DATE
	PLOTTED	BY
PROFILE	GRADES CHECKED	DATE
	STRUCTURE NOTATIONS CHKD.	BY

PLAN	SURVEYED	DATE
	PLOTTED	BY
PROFILE	GRADES CHECKED	DATE
	STRUCTURE NOTATIONS CHKD.	BY



PLATE 2-PLAN-PROFILE O.P.R. & E.
MADE AND PRINTED IN U.S.A.
CHARLES BRUNING COMPANY

AS BUILT DRAWING

SPECIAL ASSESSMENT DISTRICT NO. 173





CITY OF ALBUQUERQUE
PAVING PLAN & PROFILE

BELL AVE. (Moon To Eubank)

SHEET
16
OF

DATE	BY
PLAN	
SURVEYED	
PLOTTED	
GRADES CHECKED	
RT. OF WAY CHECKED	
NO.	

DATE	BY
PROFILE	
SURVEYED	
PLOTTED	
GRADES CHECKED	
STRUCTURE NOTATIONS CHECKED	
NO.	

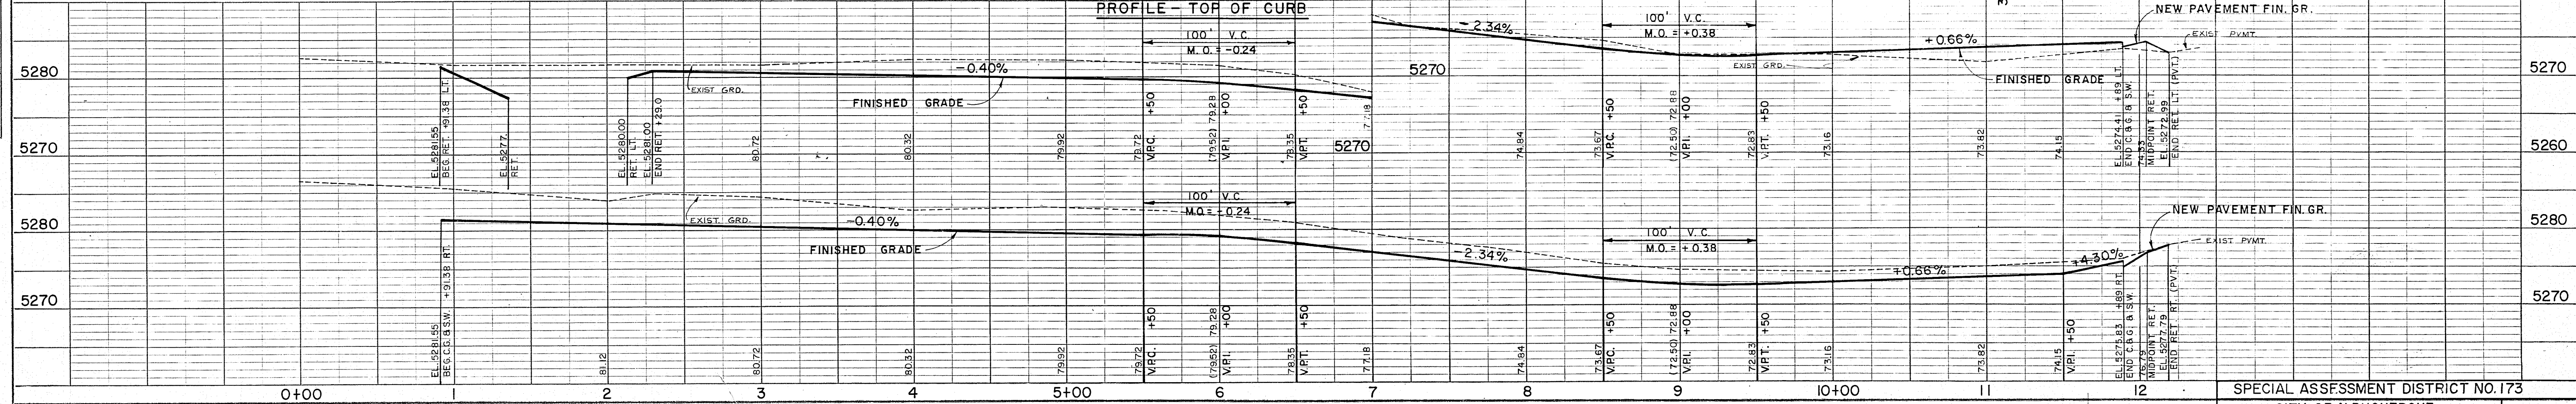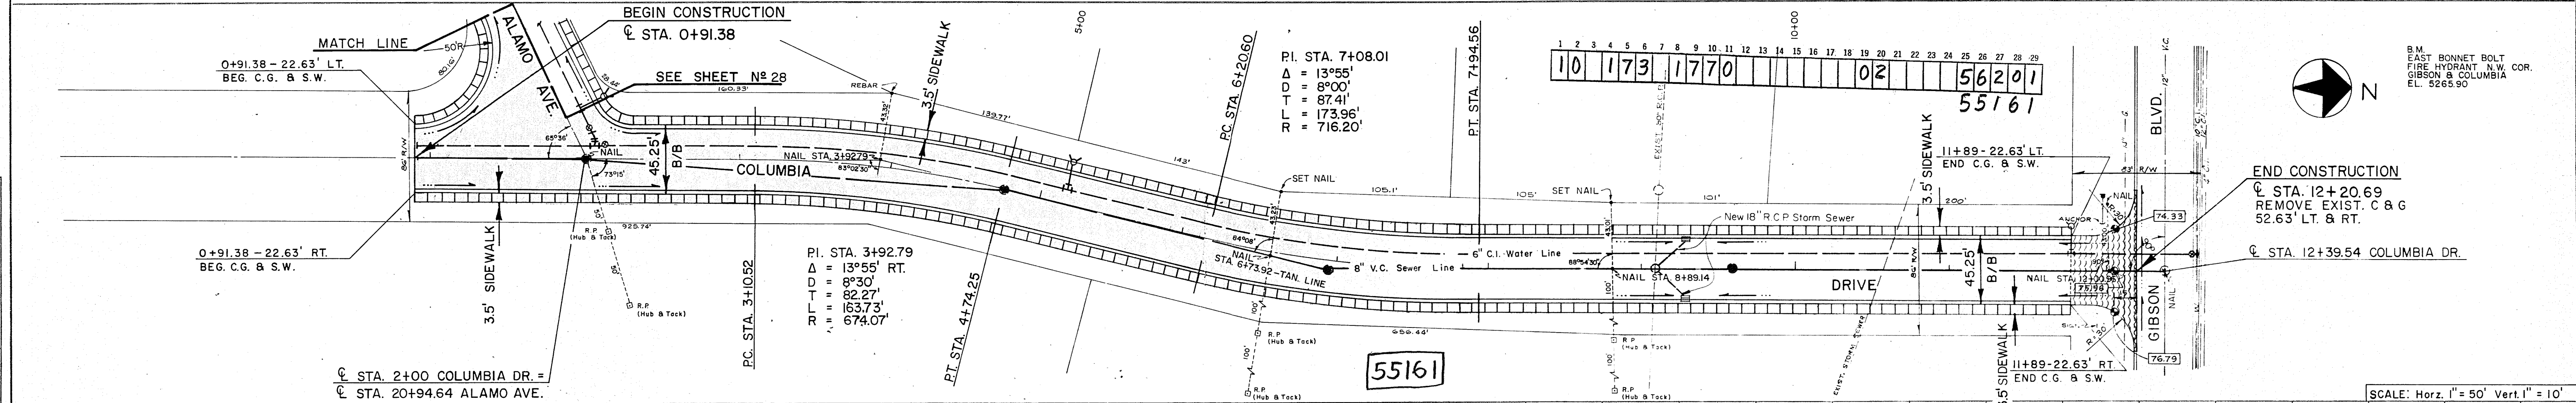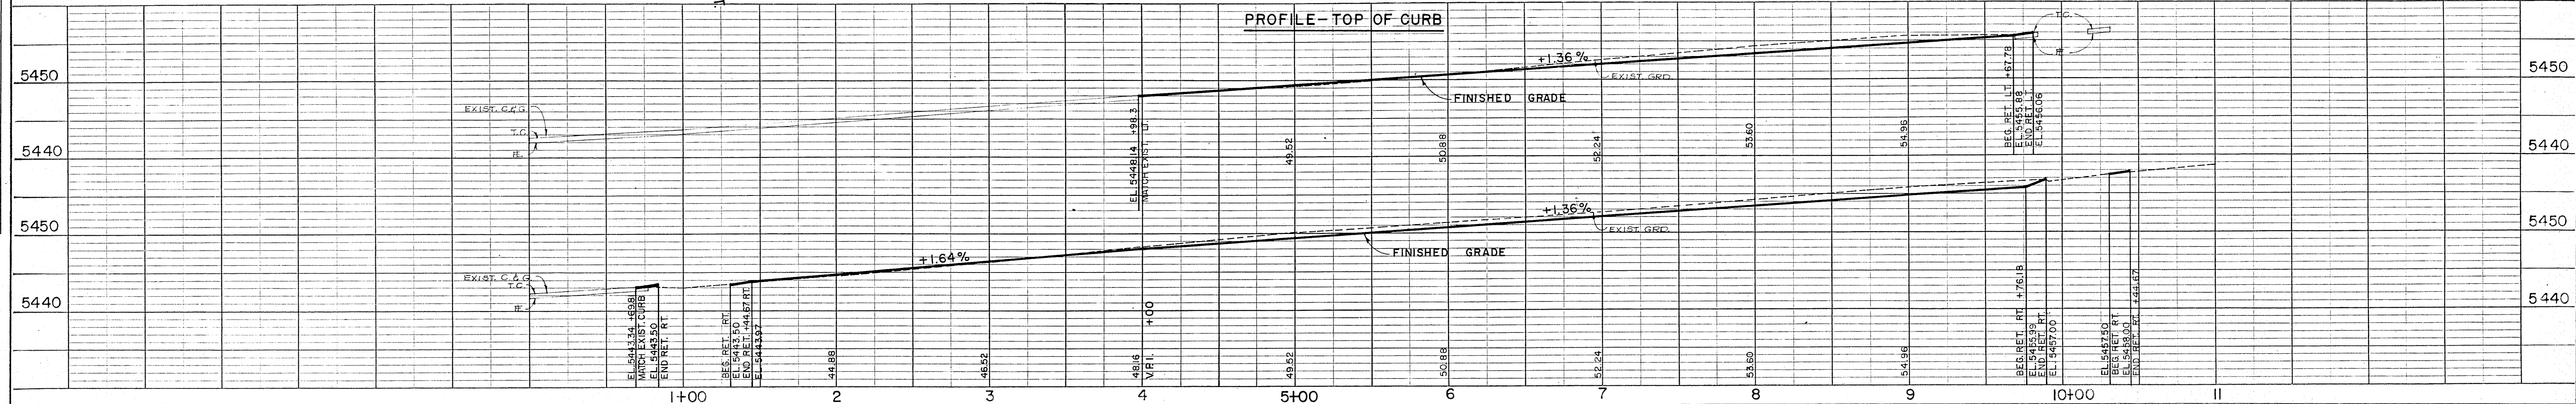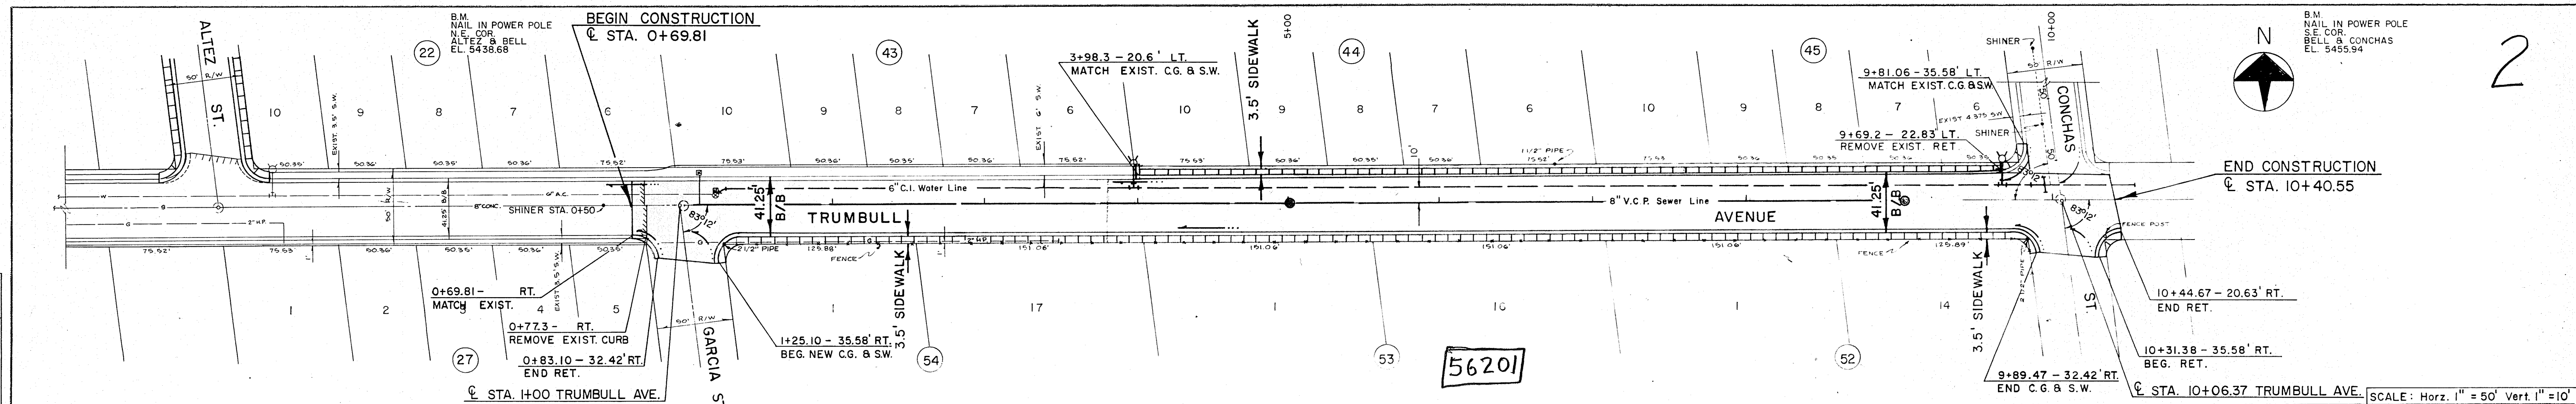

PLAN	DATE	BY	DATE	BY
SURVEYED				
NOTED				
ALIGNED				
CHECKED				
NO.				

PROFILE	DATE	BY	DATE	BY
SURVEYED				
NOTED				
GRADES				
CHECKED				
NO.				

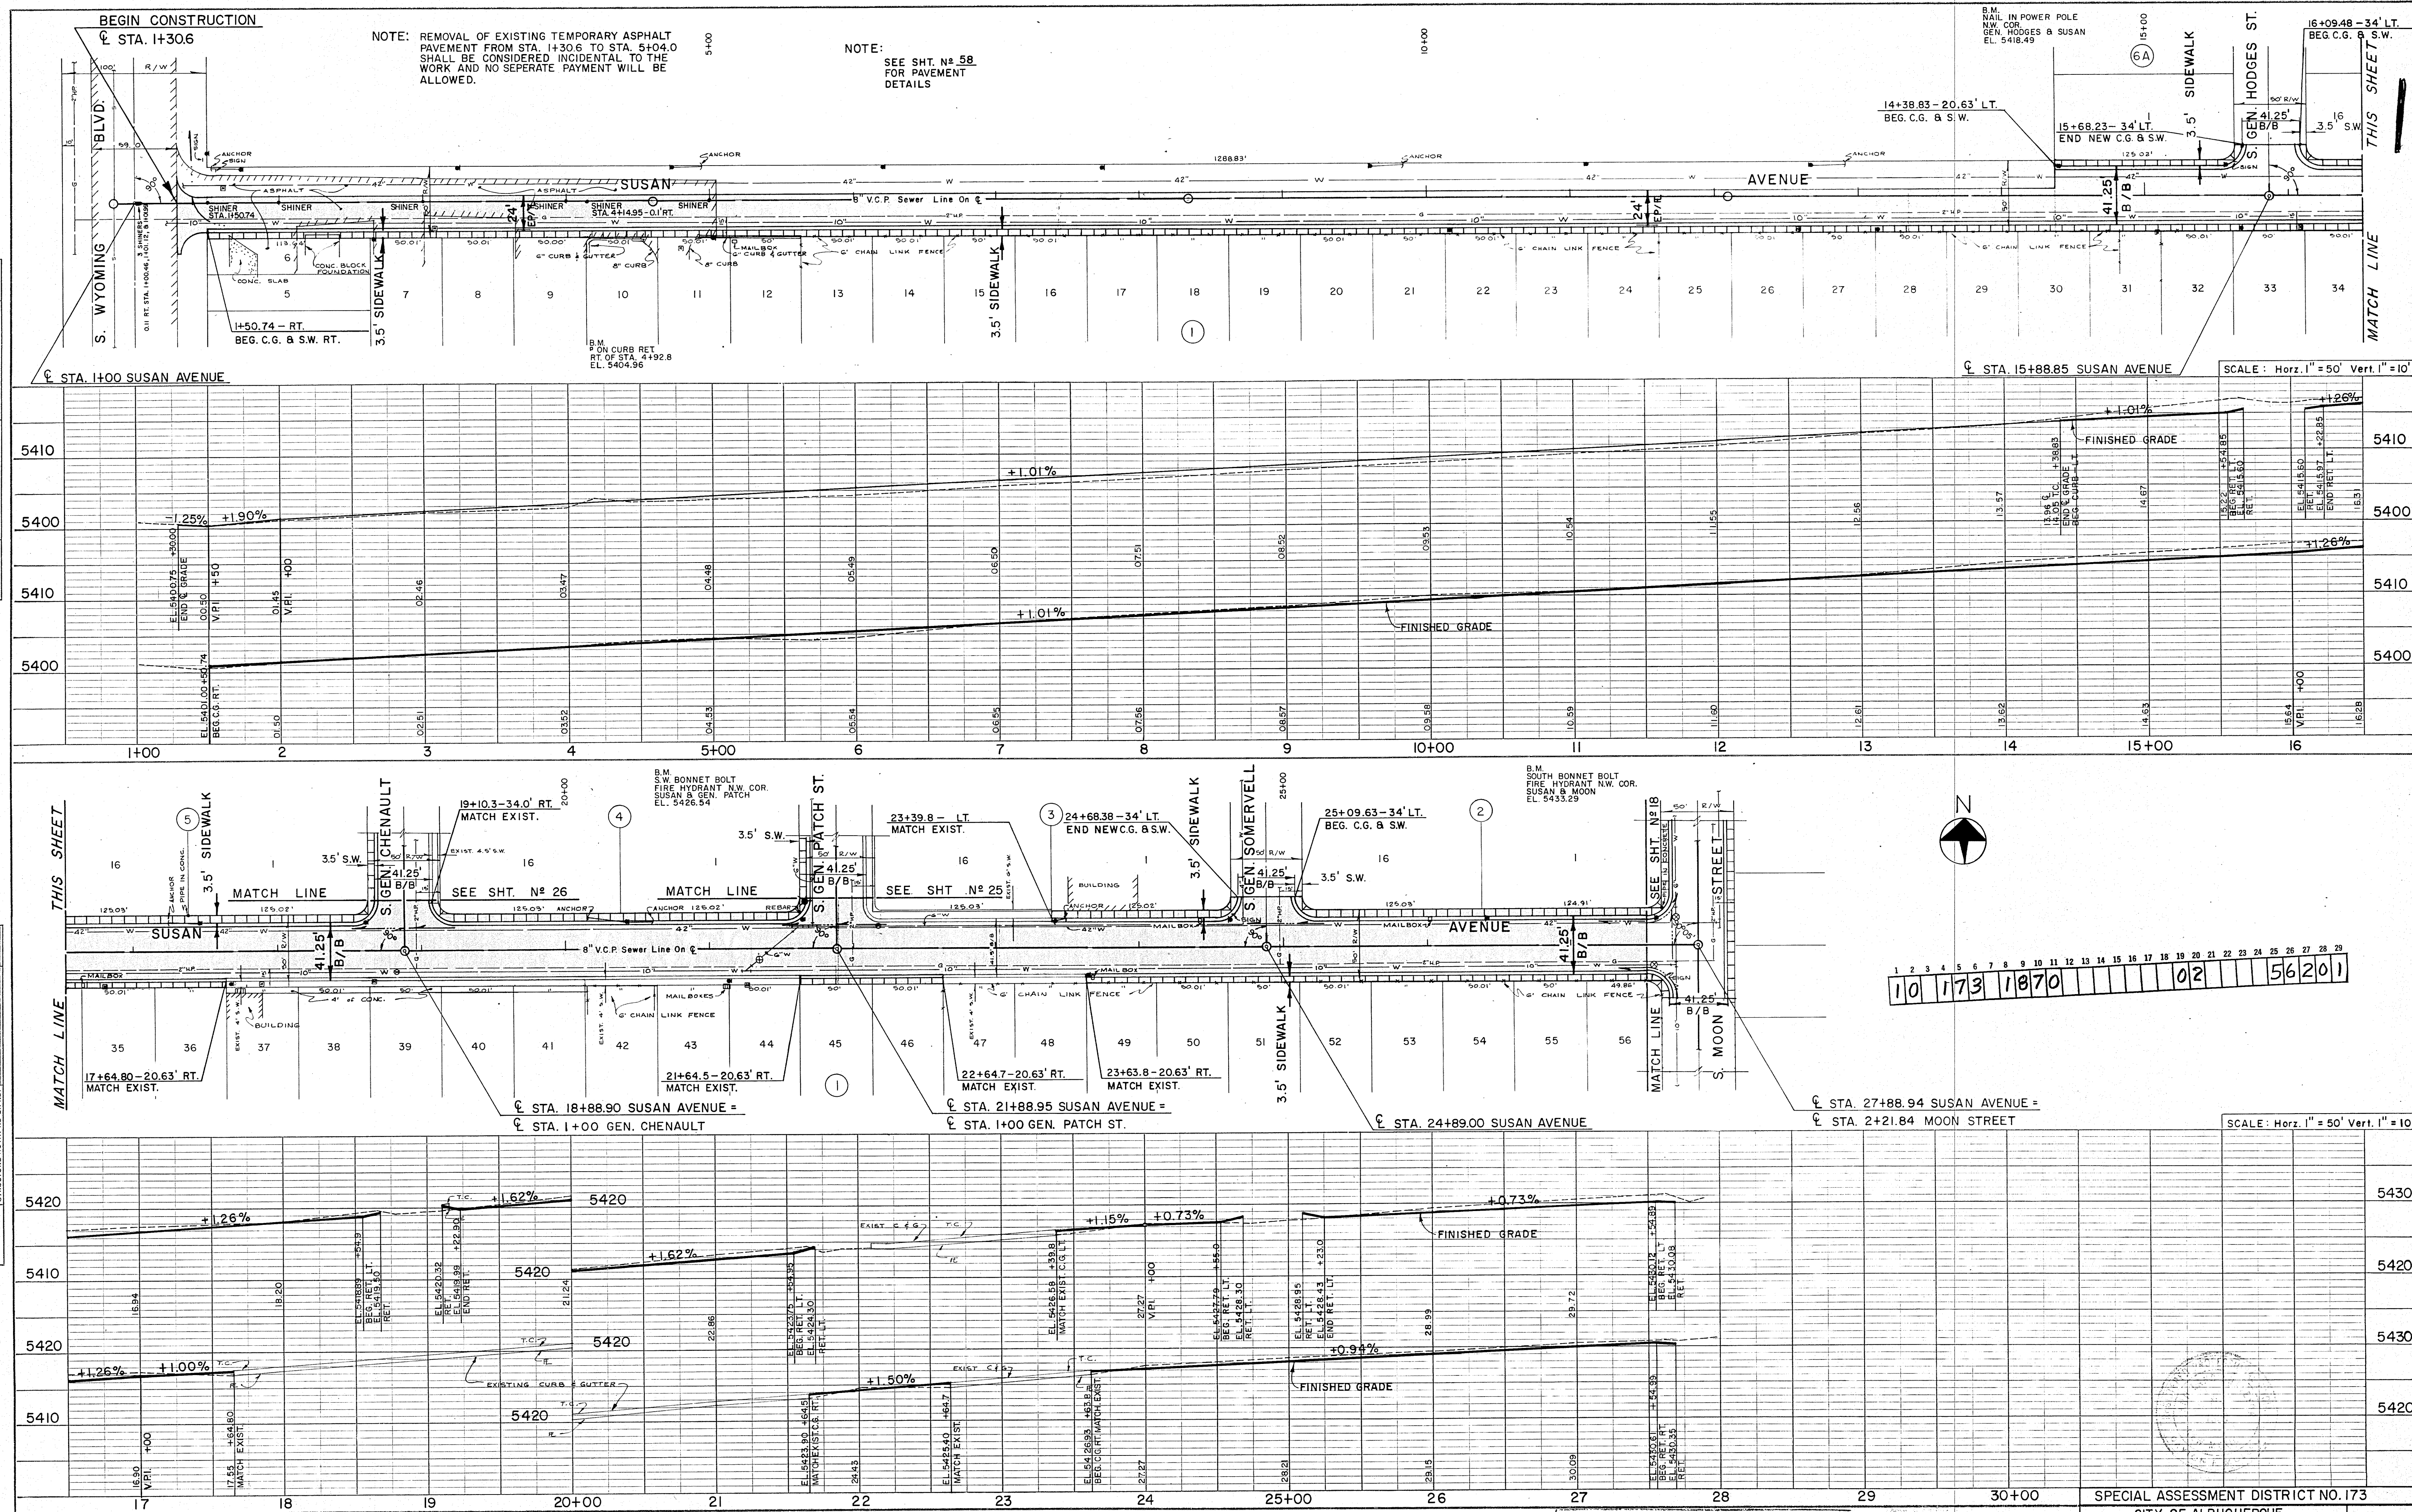


PLATE 2-PLAN-PROFILE P. R. & R. E.
MADE AND PRINTED IN U.S.A.
CHARLES BRUNING COMPANY



AS BUILT DRAWING



SPECIAL ASSESSMENT DISTRICT NO. 173



CITY OF ALBUQUERQUE
PAVING PLAN & PROFILE

SUSAN AVE. (Wyoming To Moon)

SHEET
18
OF

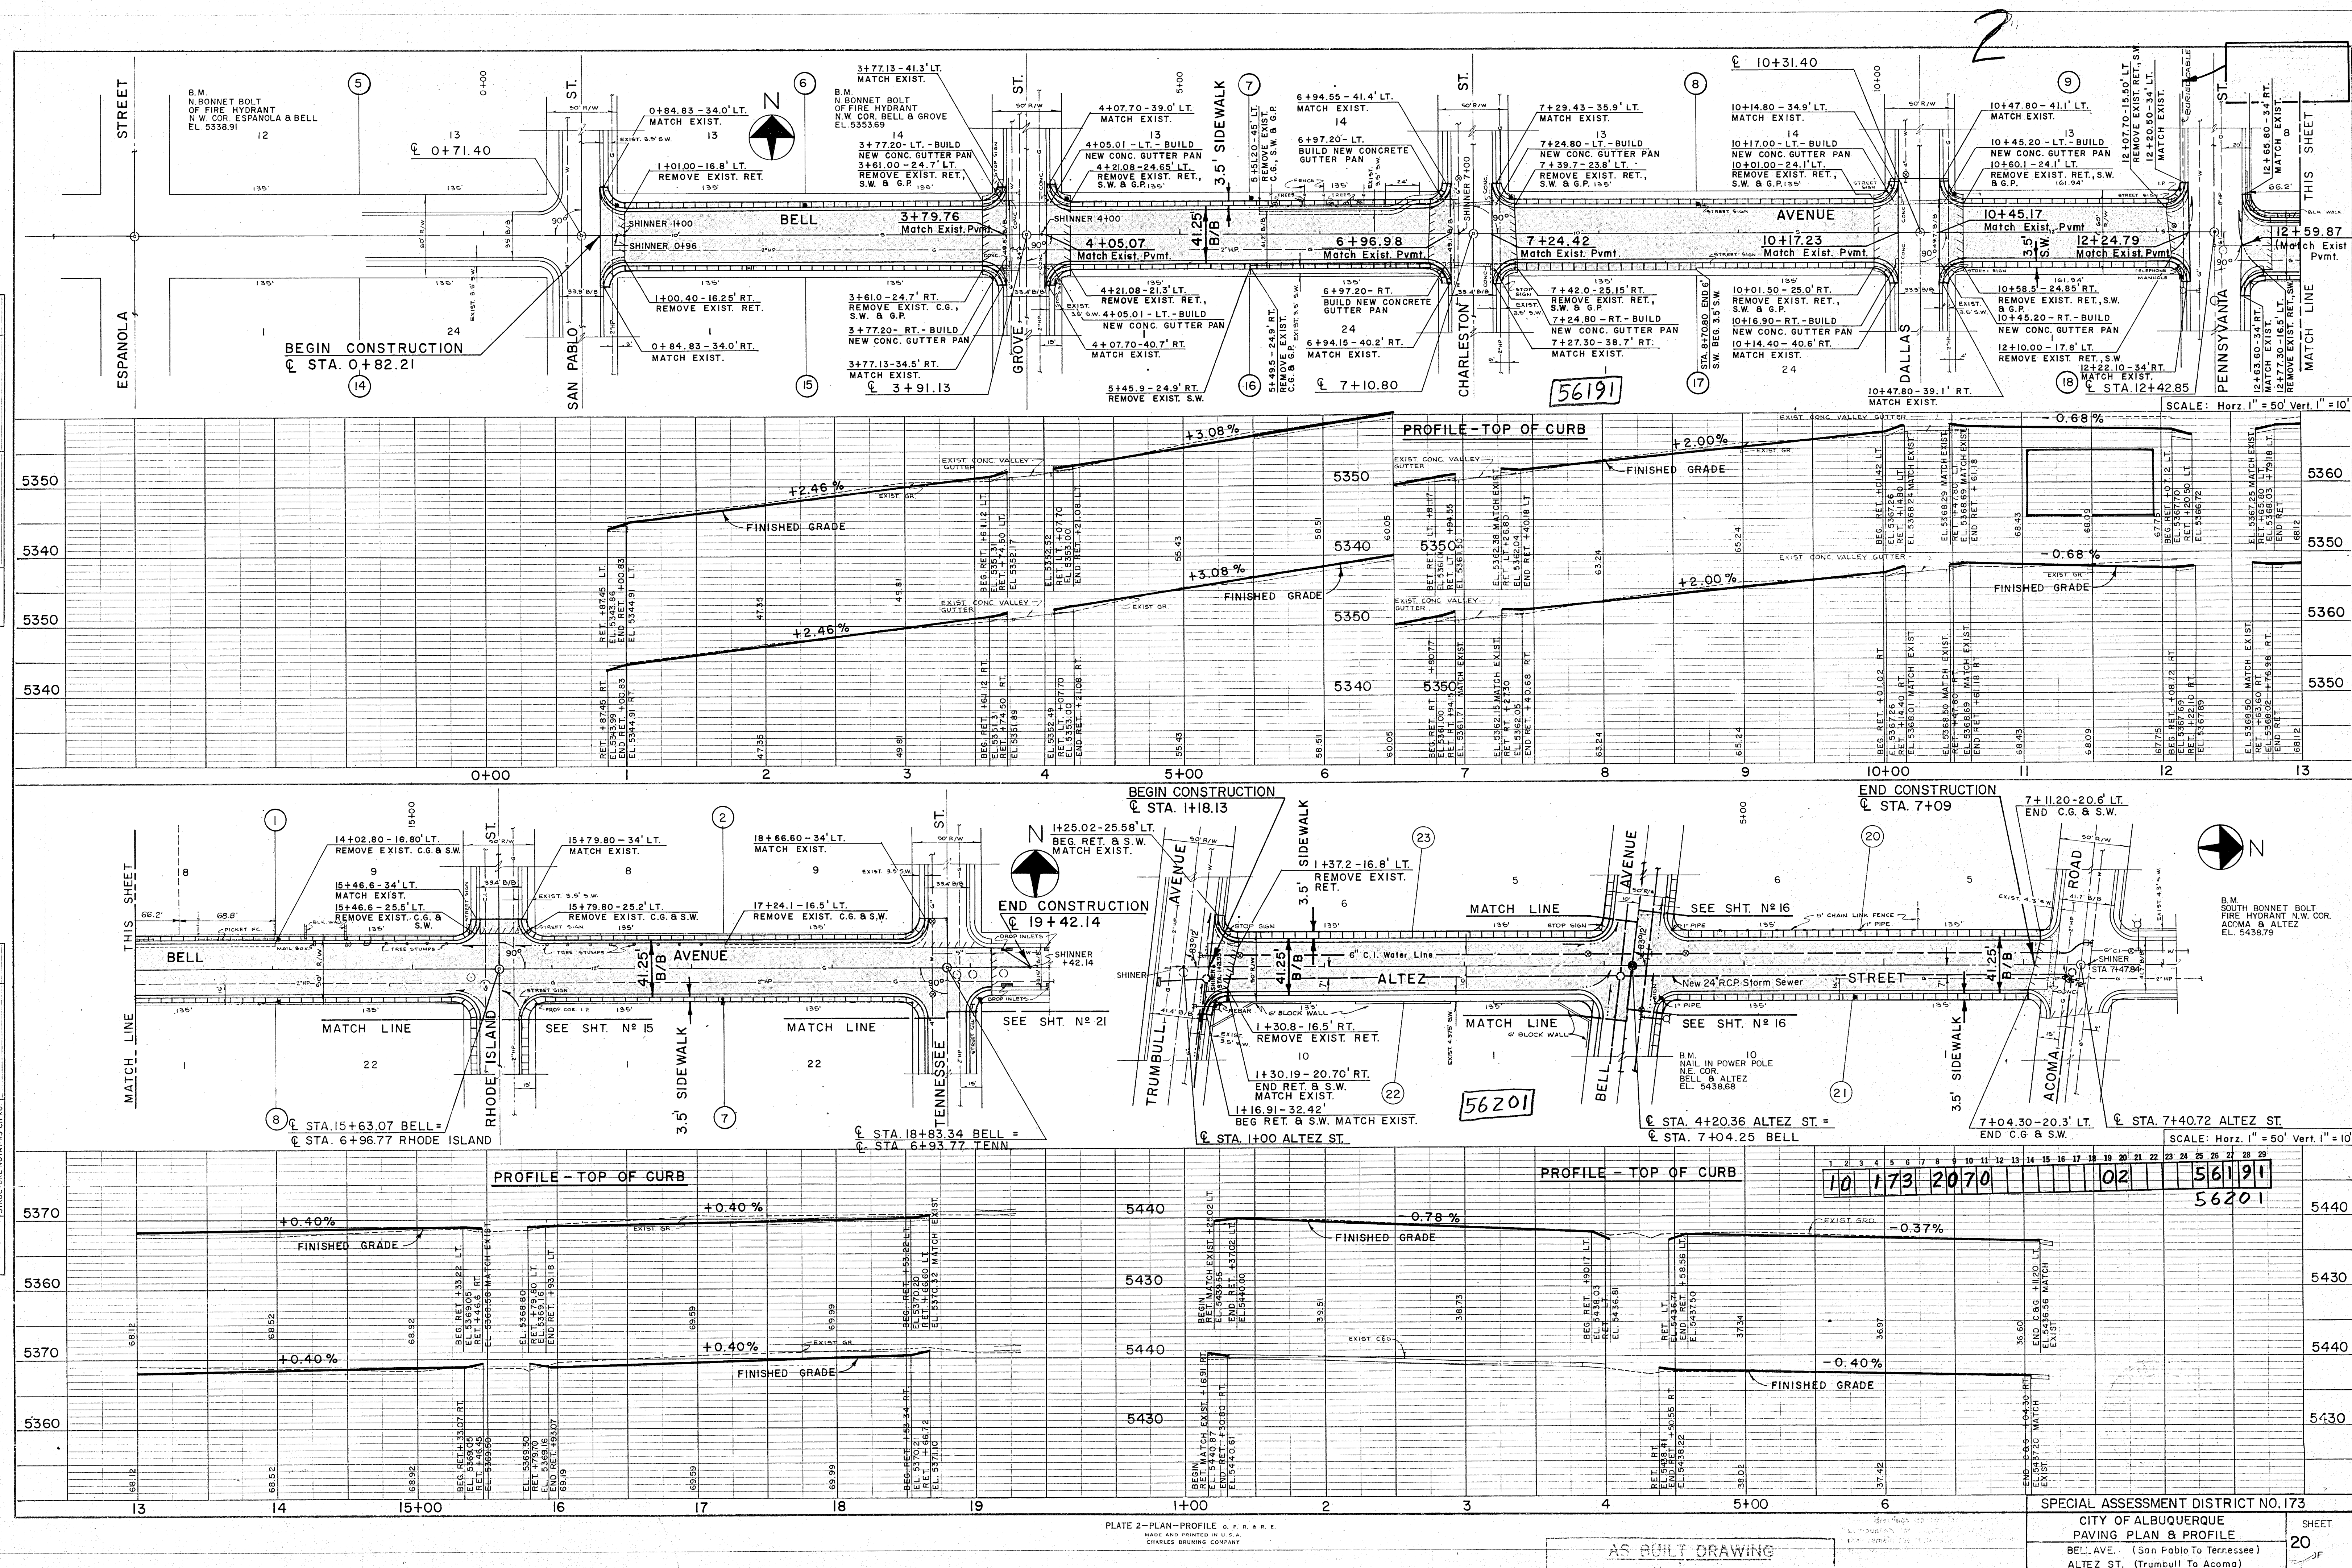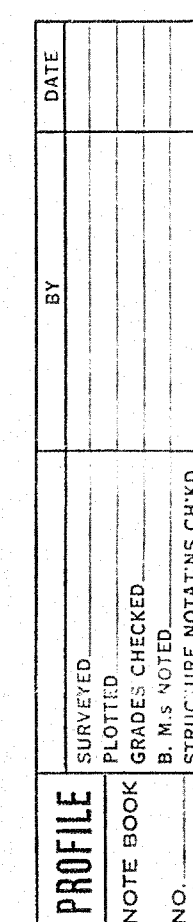

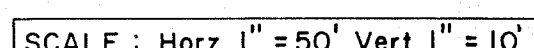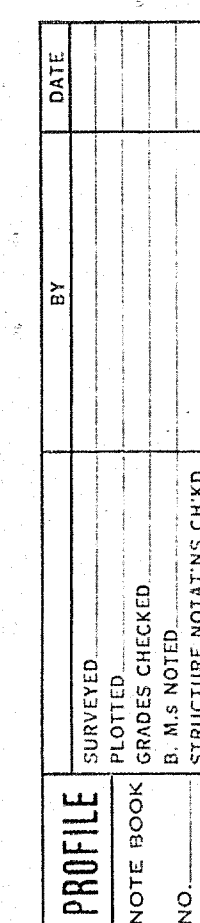

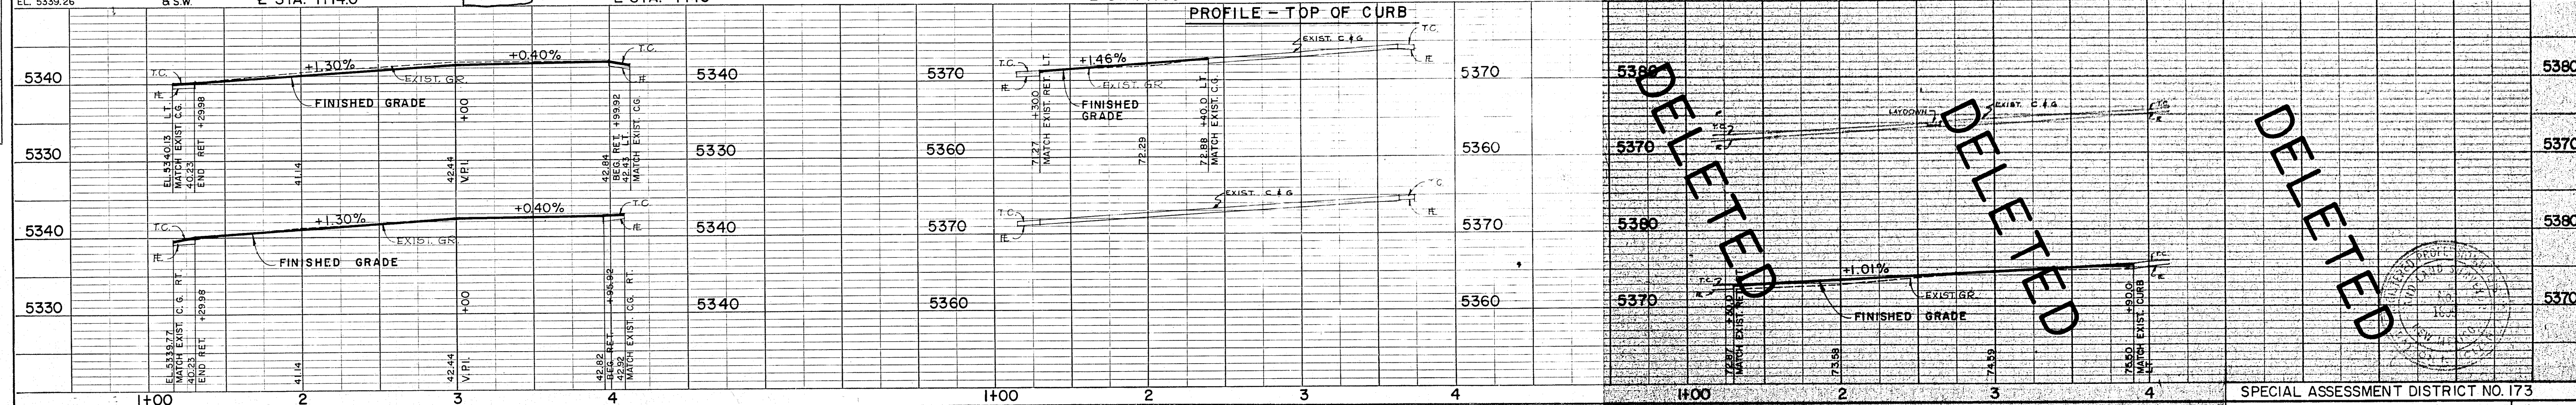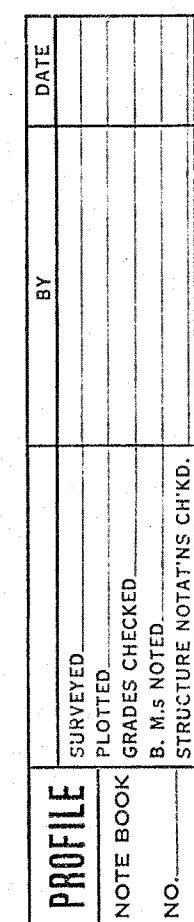

PLAN	SURVEYED	DATE
	NOTED	BY
	NOTED	NO.
	NOTED	NO.

PROFILE	SURVEYED	DATE
	NOTED	BY
	NOTED	NO.
	NOTED	NO.

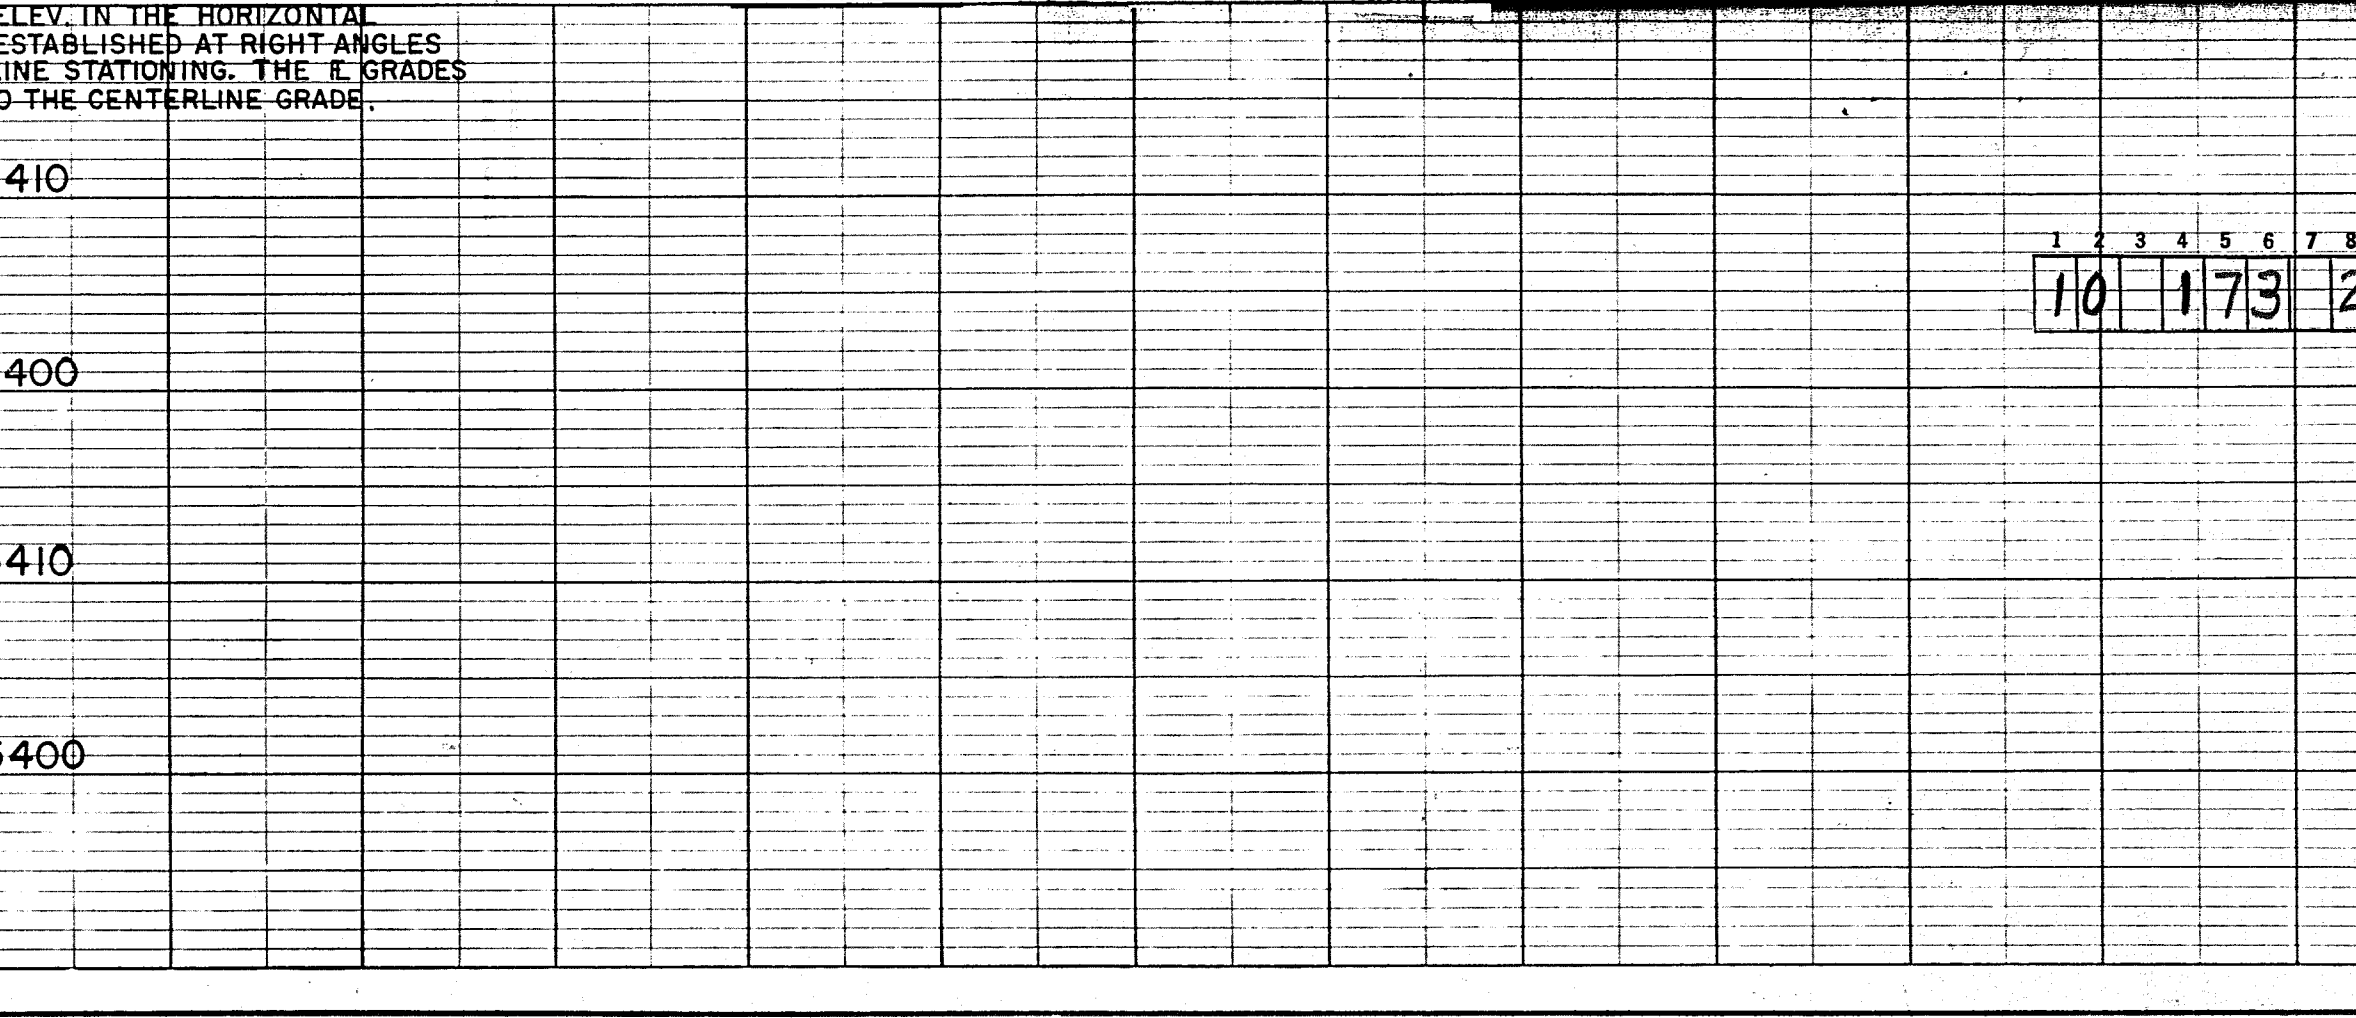
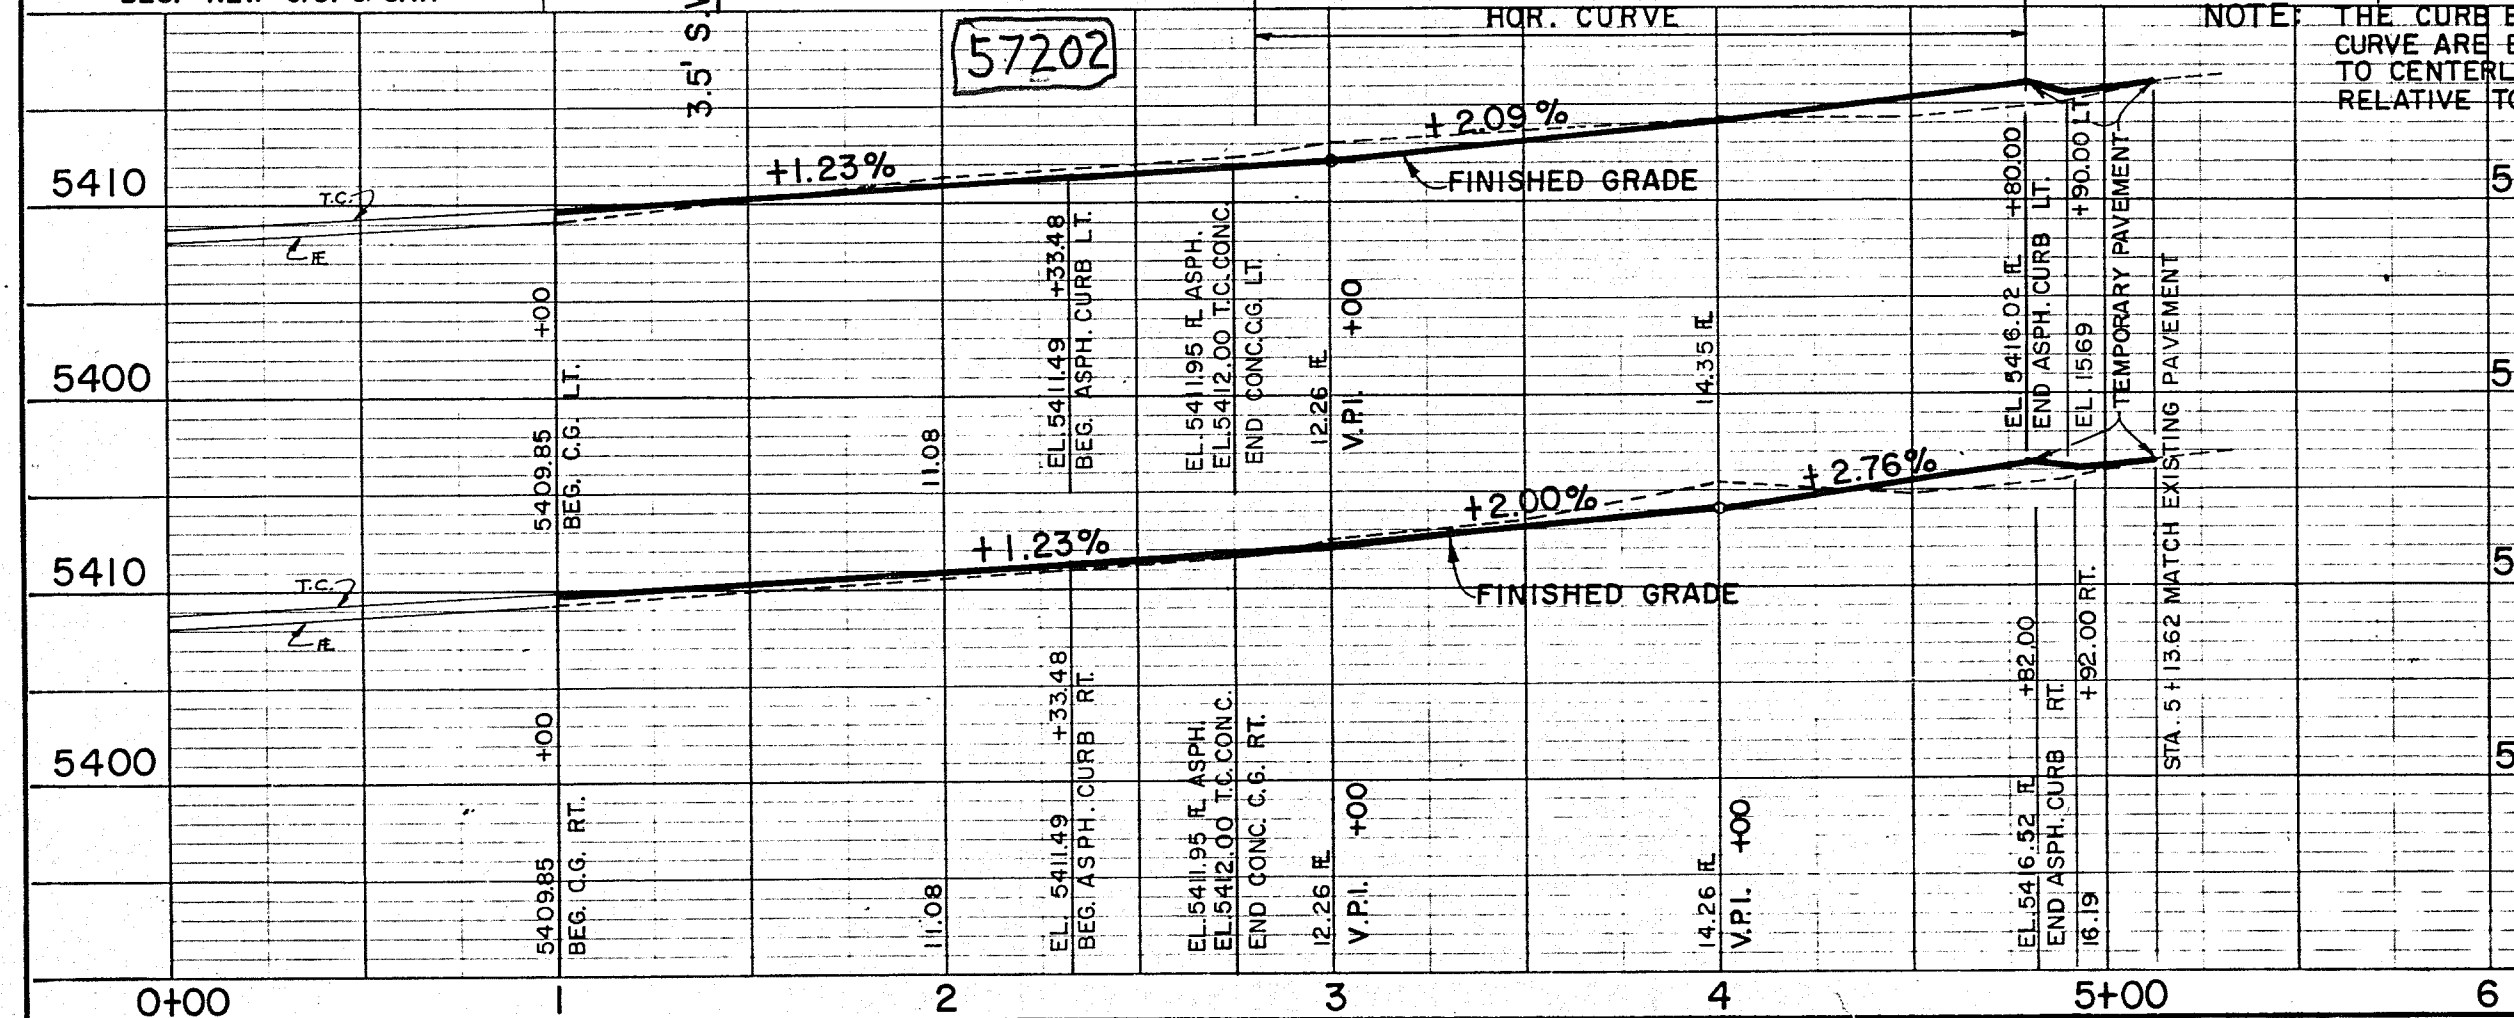
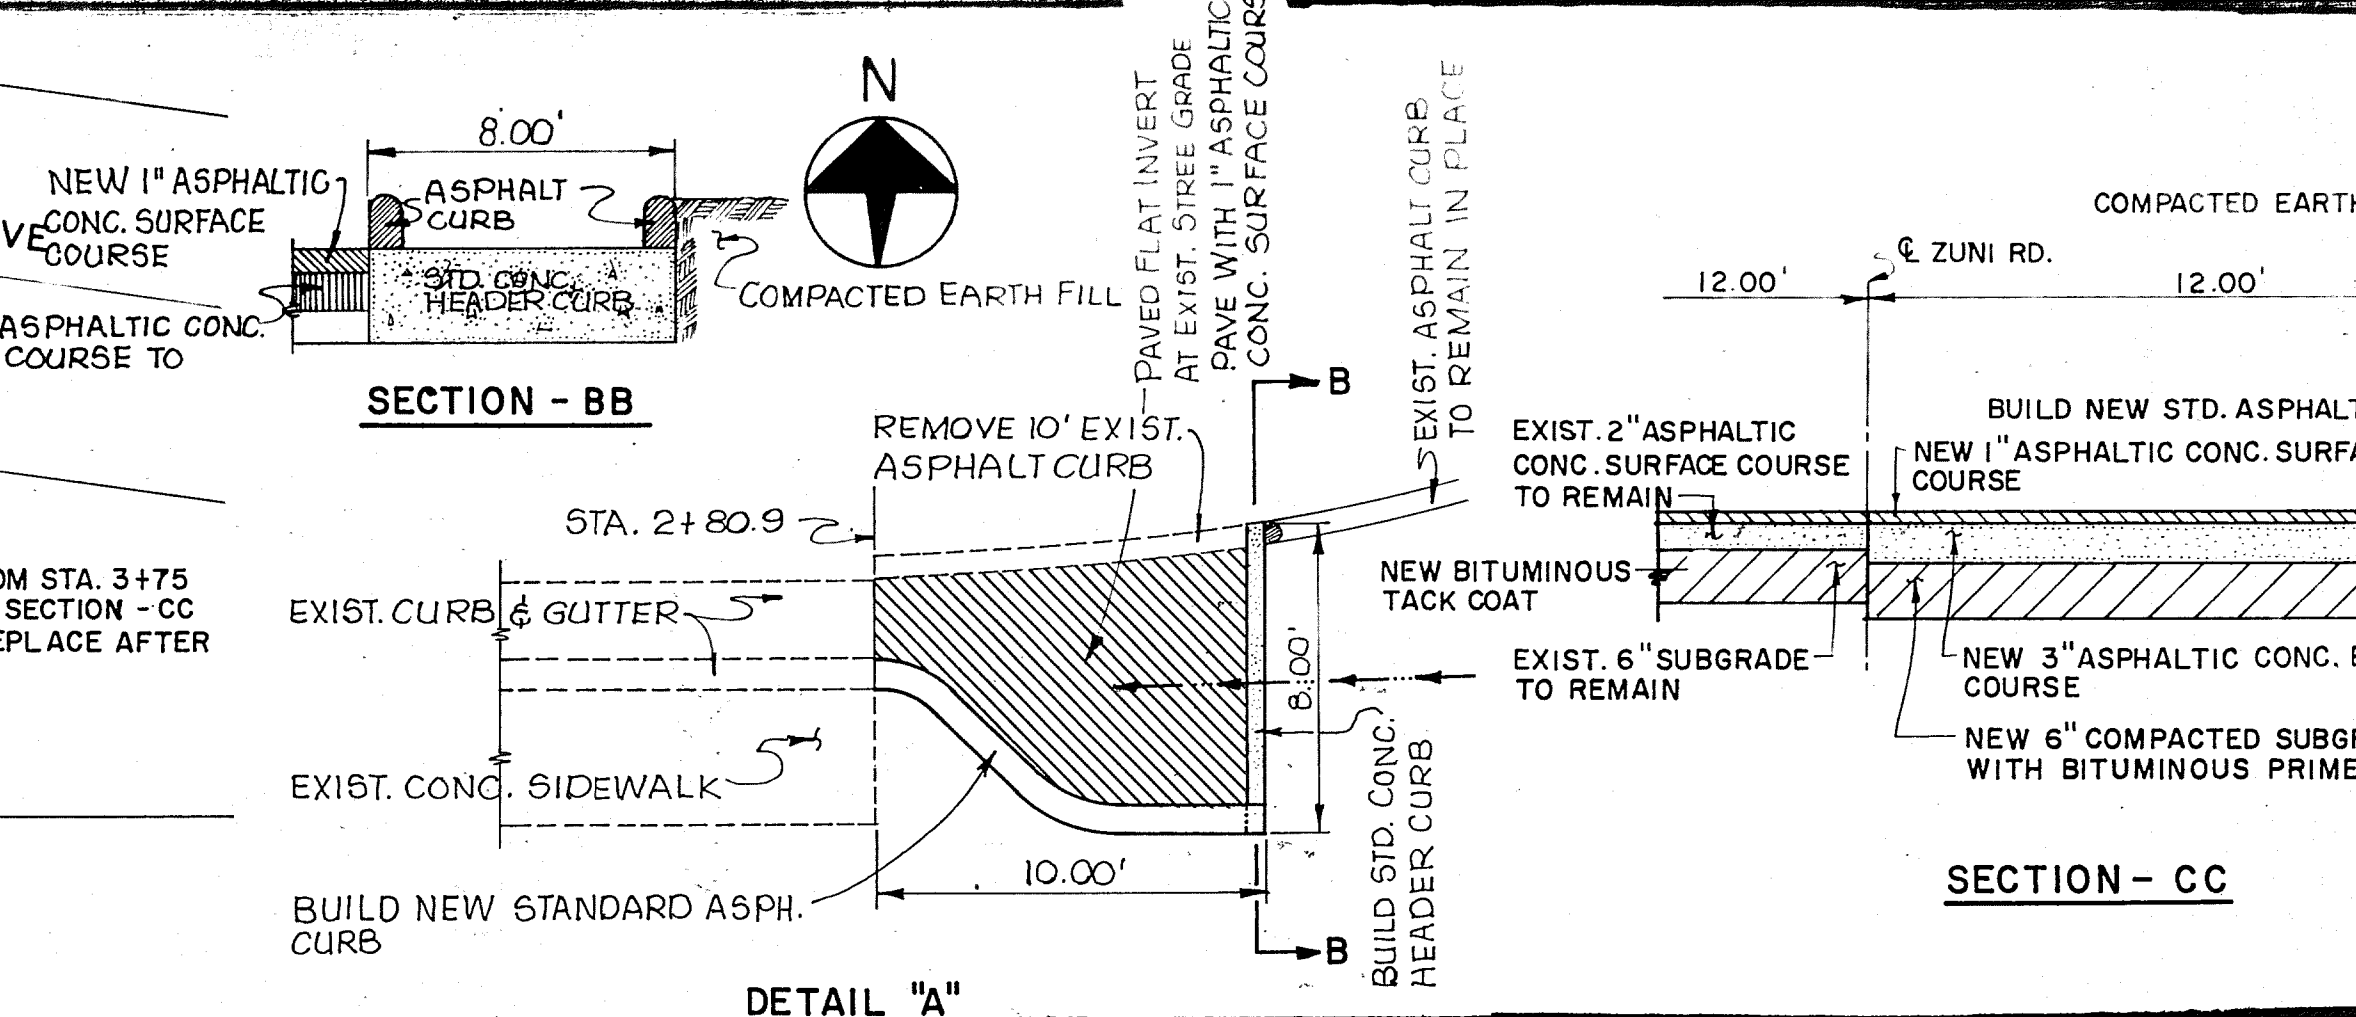
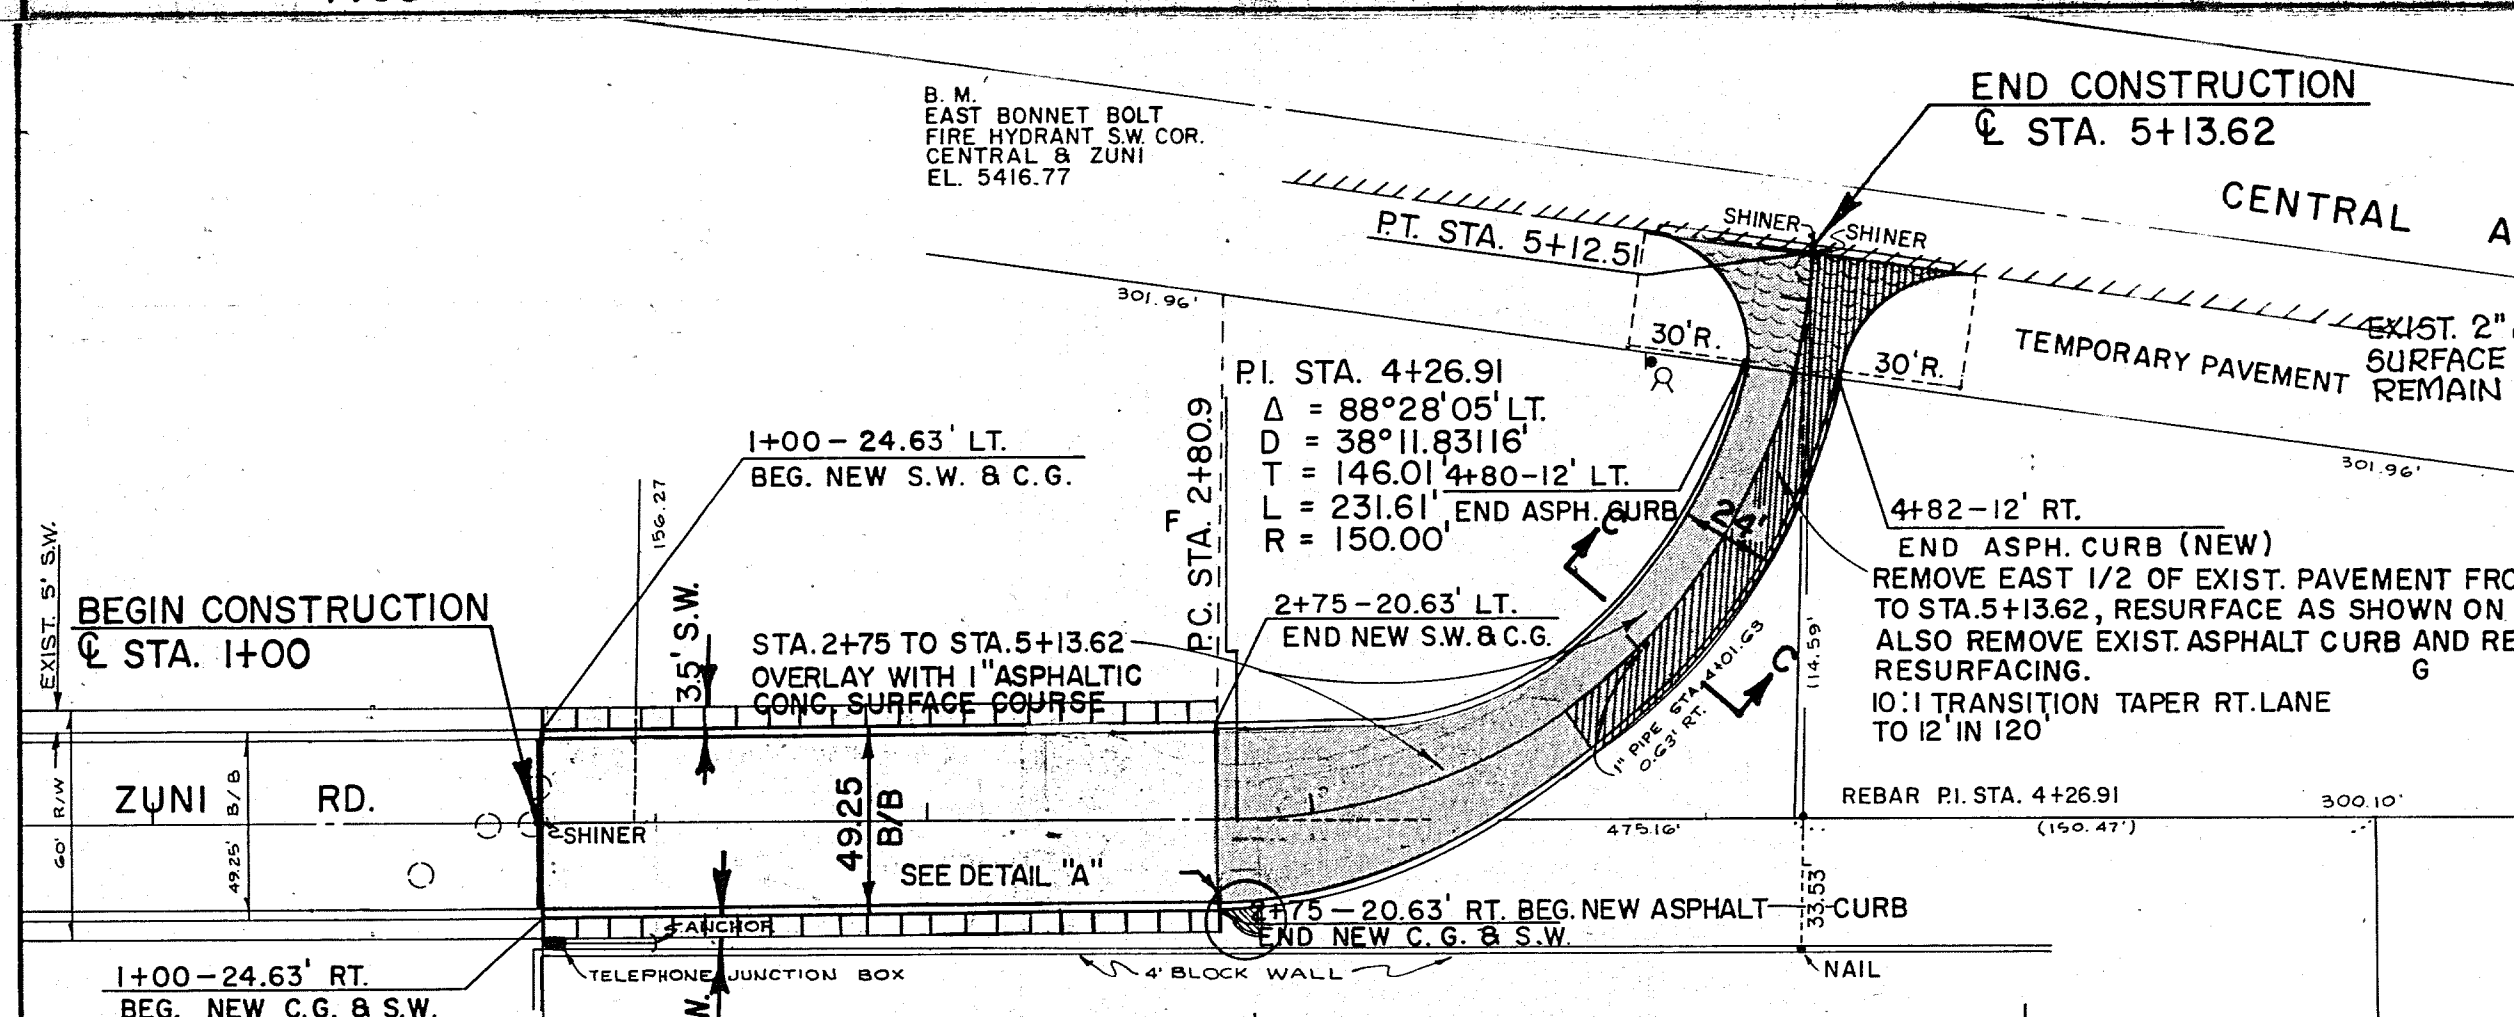
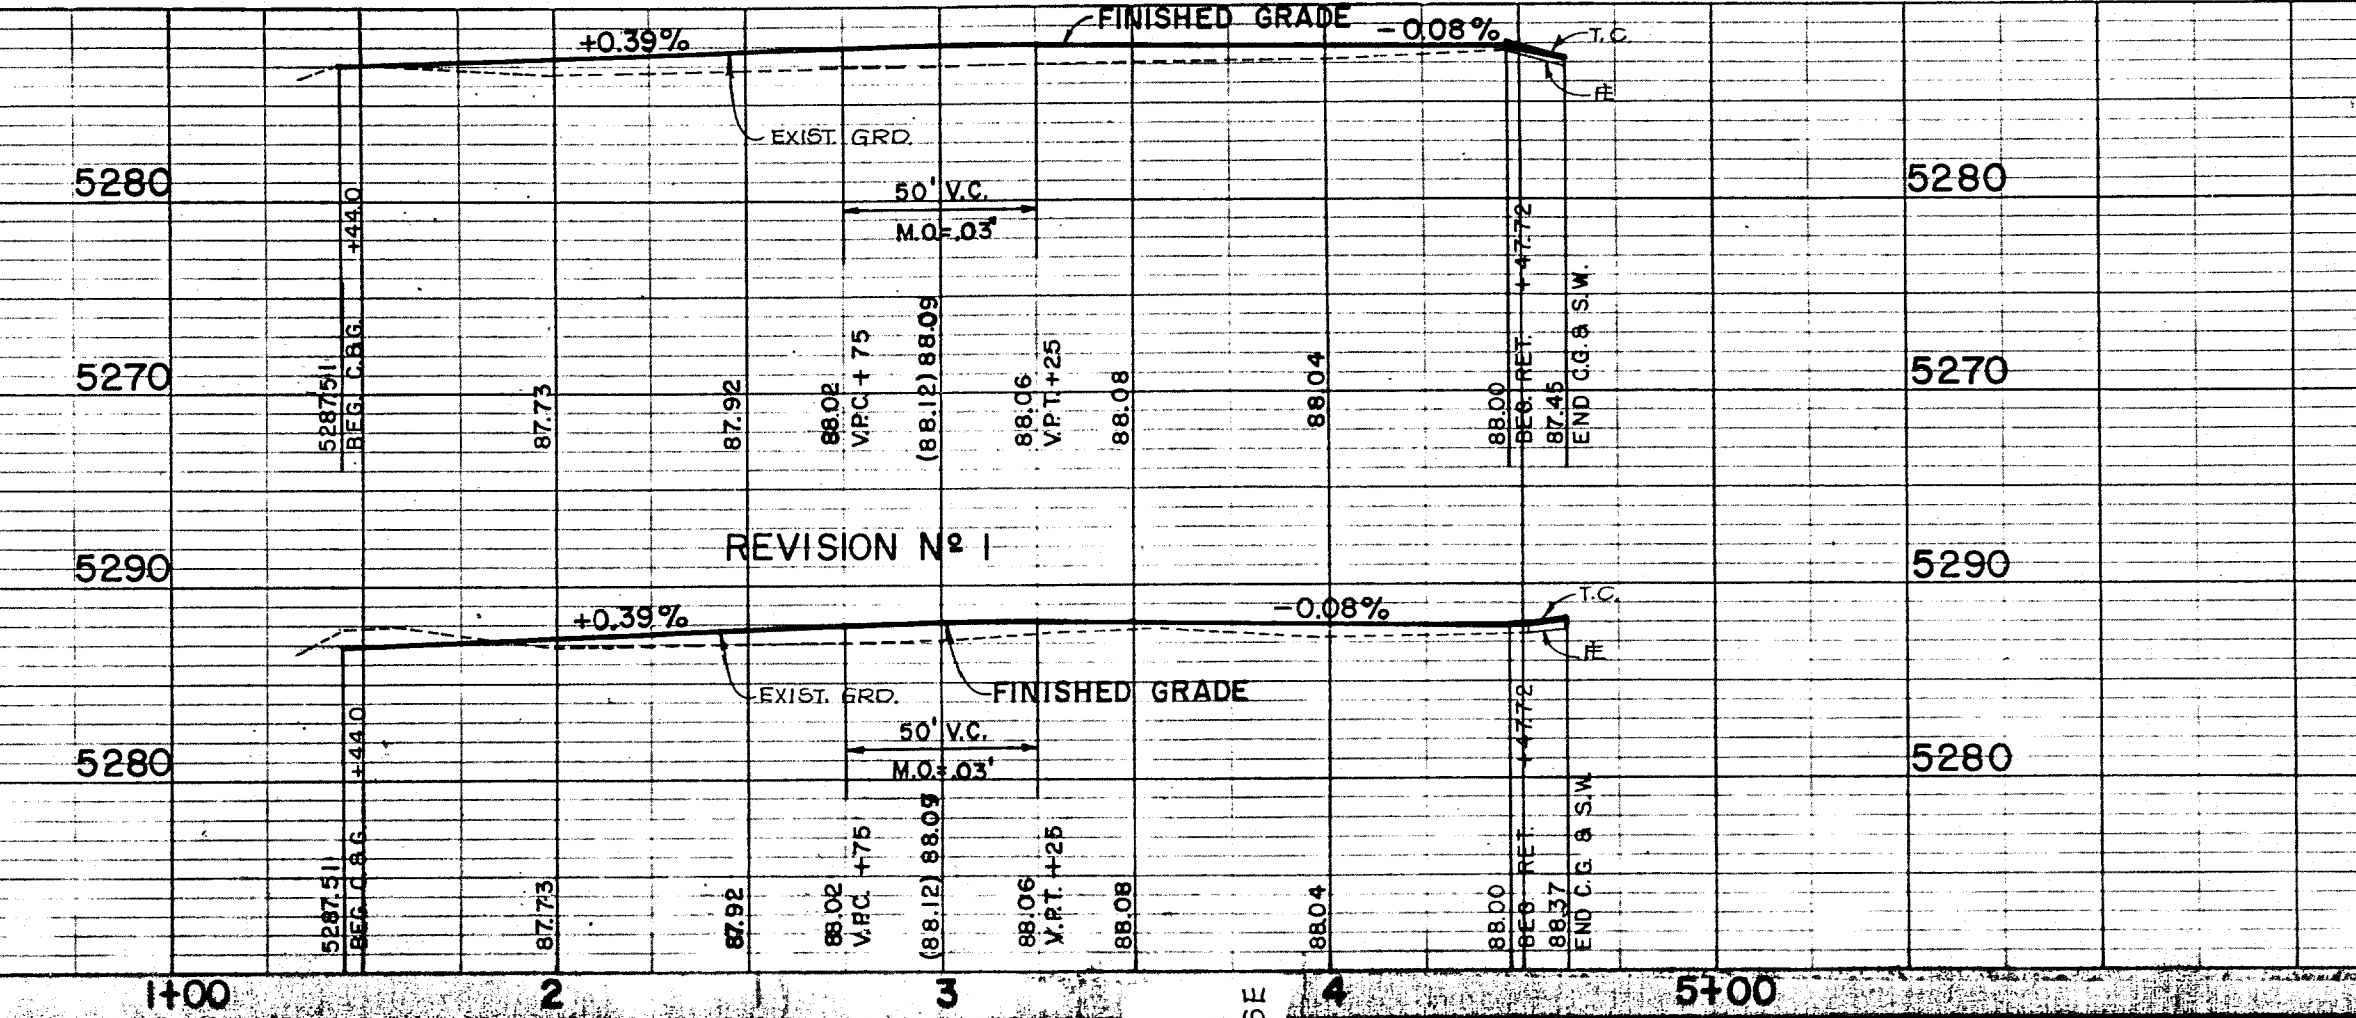
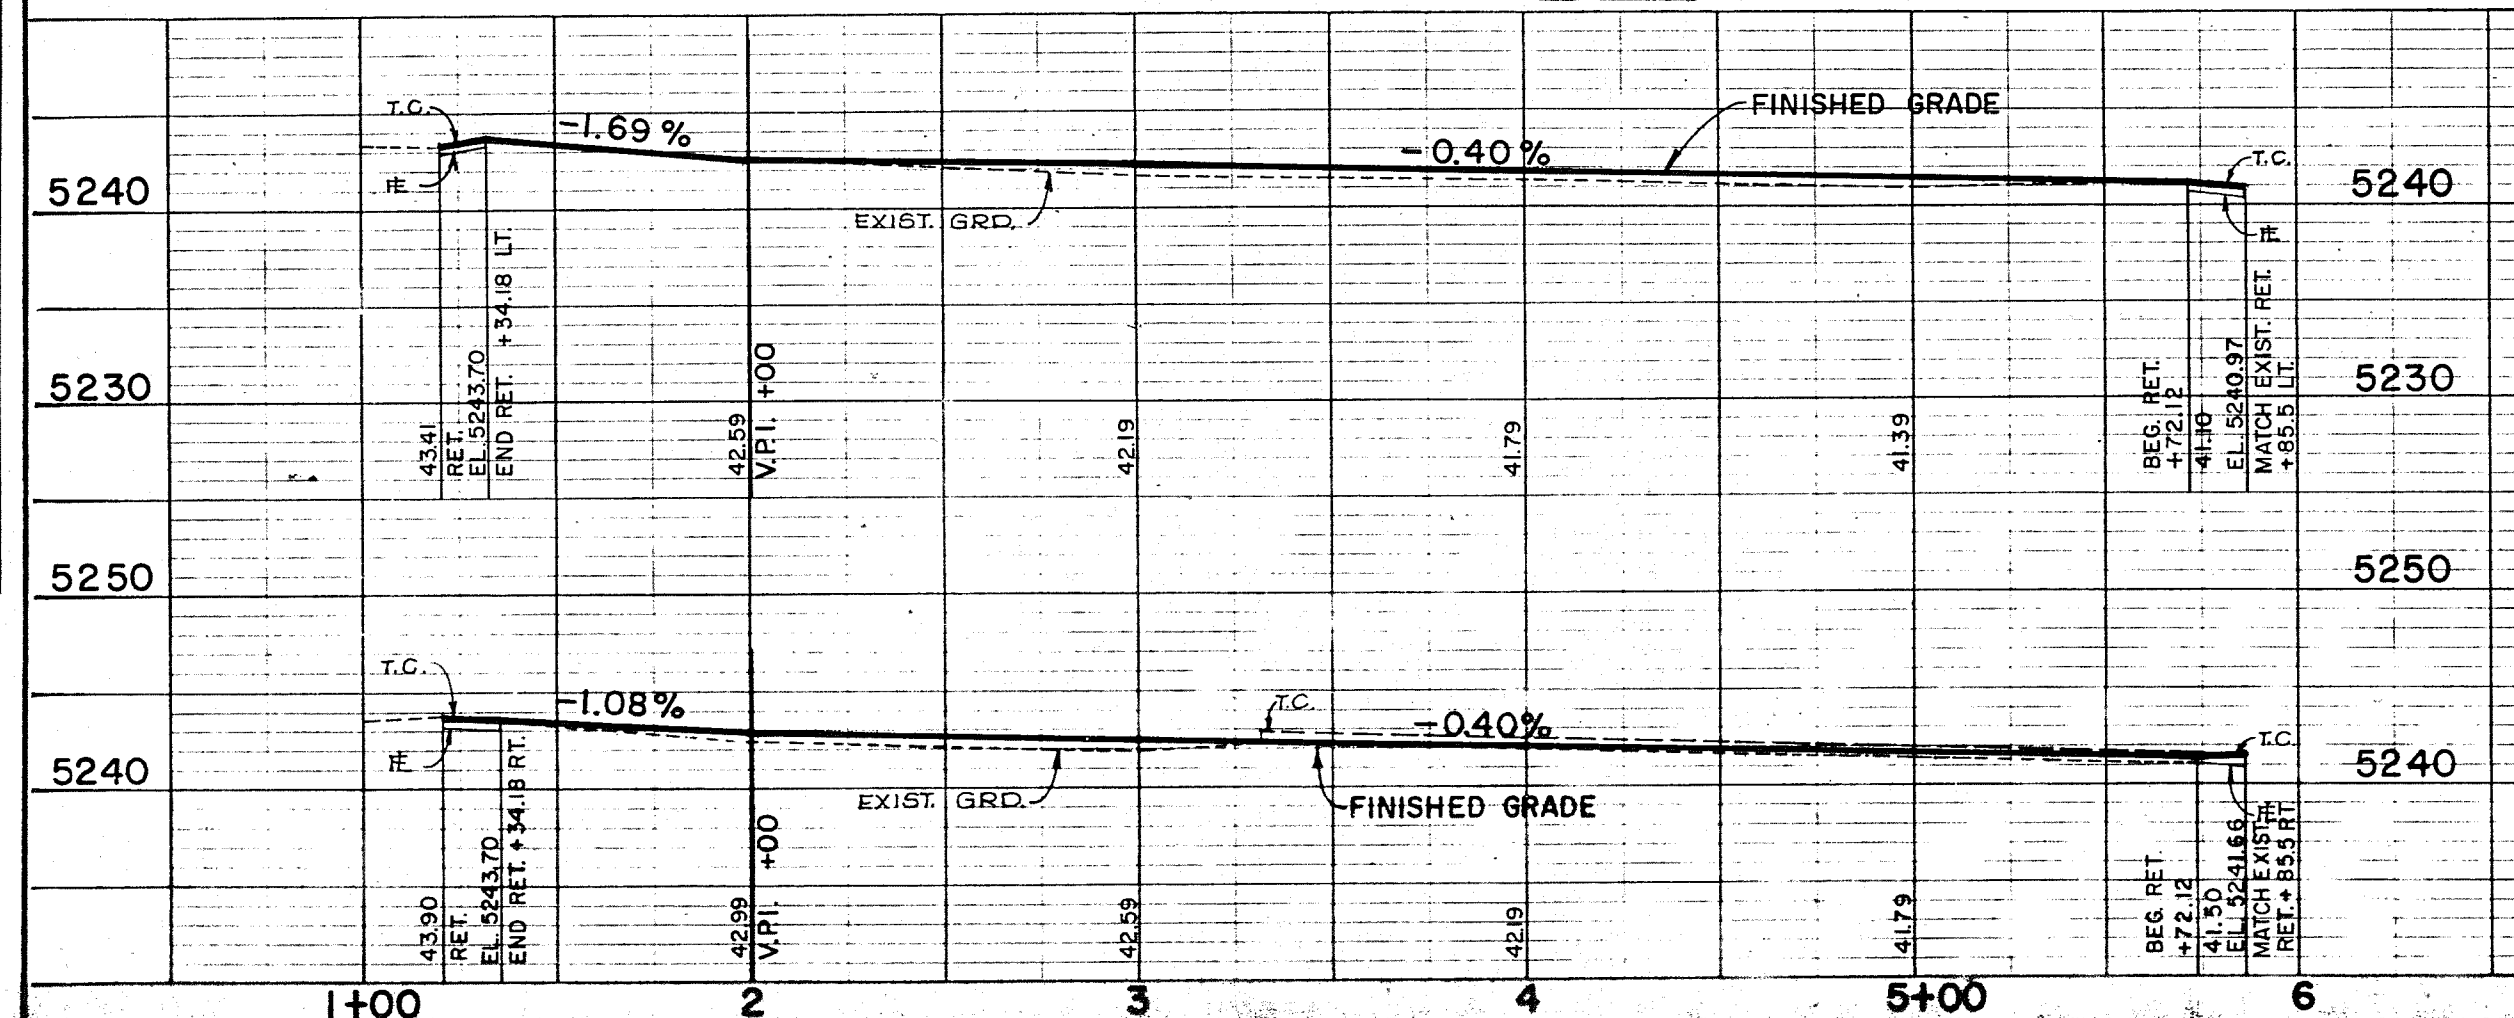
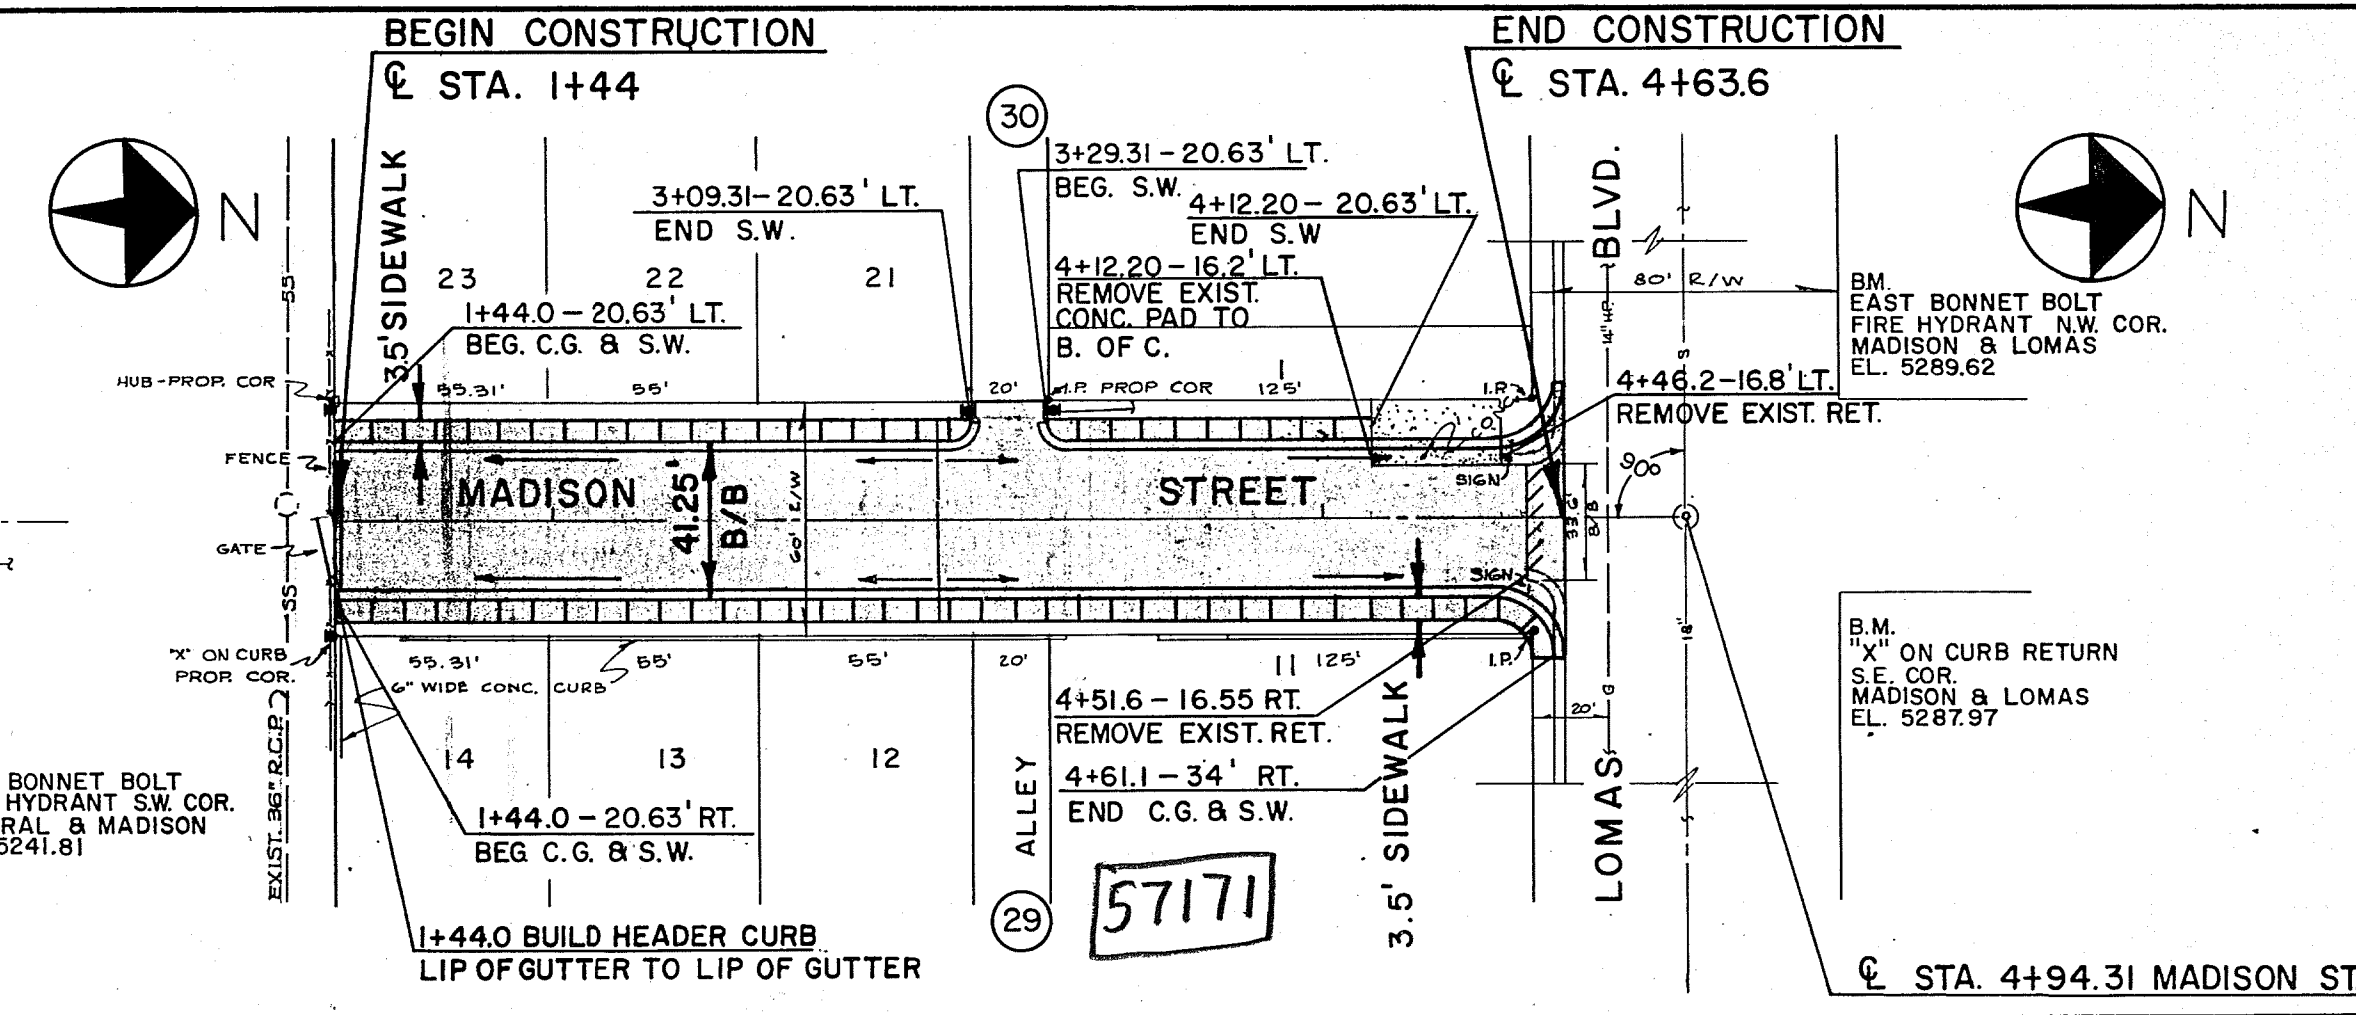
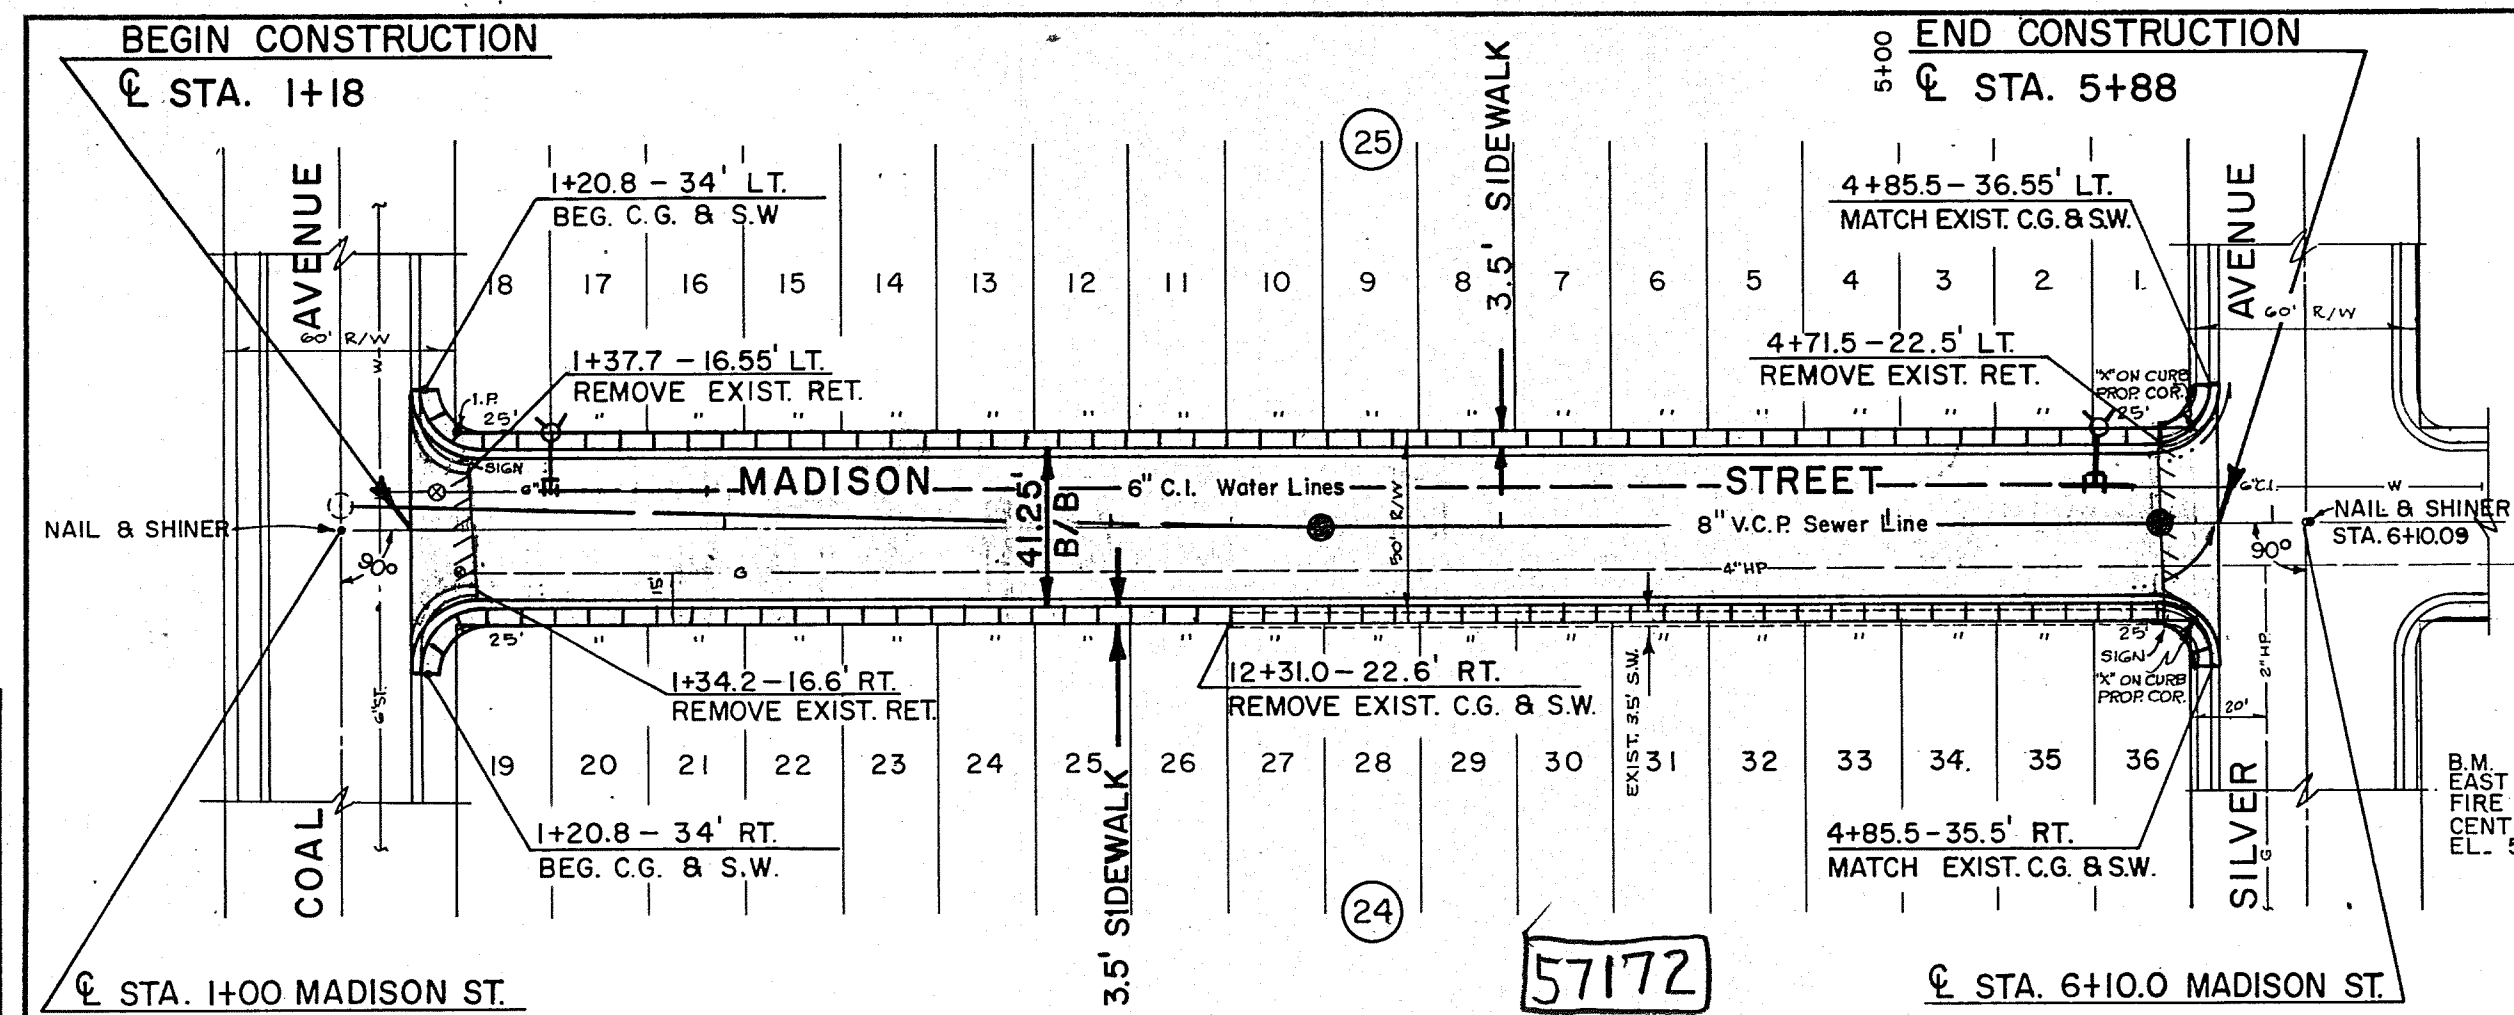


PLATE 2—PLAN—PROFILE OF R.R.E.
MADE AND PRINTED IN U.S.A.
CHARLES BRUNING COMPANY

AS BUILT DRAWING


REVISION N° 2, JULY 15, 1970

REVISION N° 1, JUNE 23, 1970



SPECIAL ASSESSMENT DISTRICT NO. 173
CITY OF ALBUQUERQUE
PAVING PLAN & PROFILE
MADISON ST. (Coal To Silver)
MADISON ST. (Lomas South)
ZUNÍ RD. (Central South)

SHEET
24
OF



PROFILE	SURVEYED _____ BY _____ DATE _____
NOTE BOOK	PLOTTED _____
NO.	GRADES CHECKED _____ B. M'S NOTED _____ STRUCTURE NOTING GIVEN _____

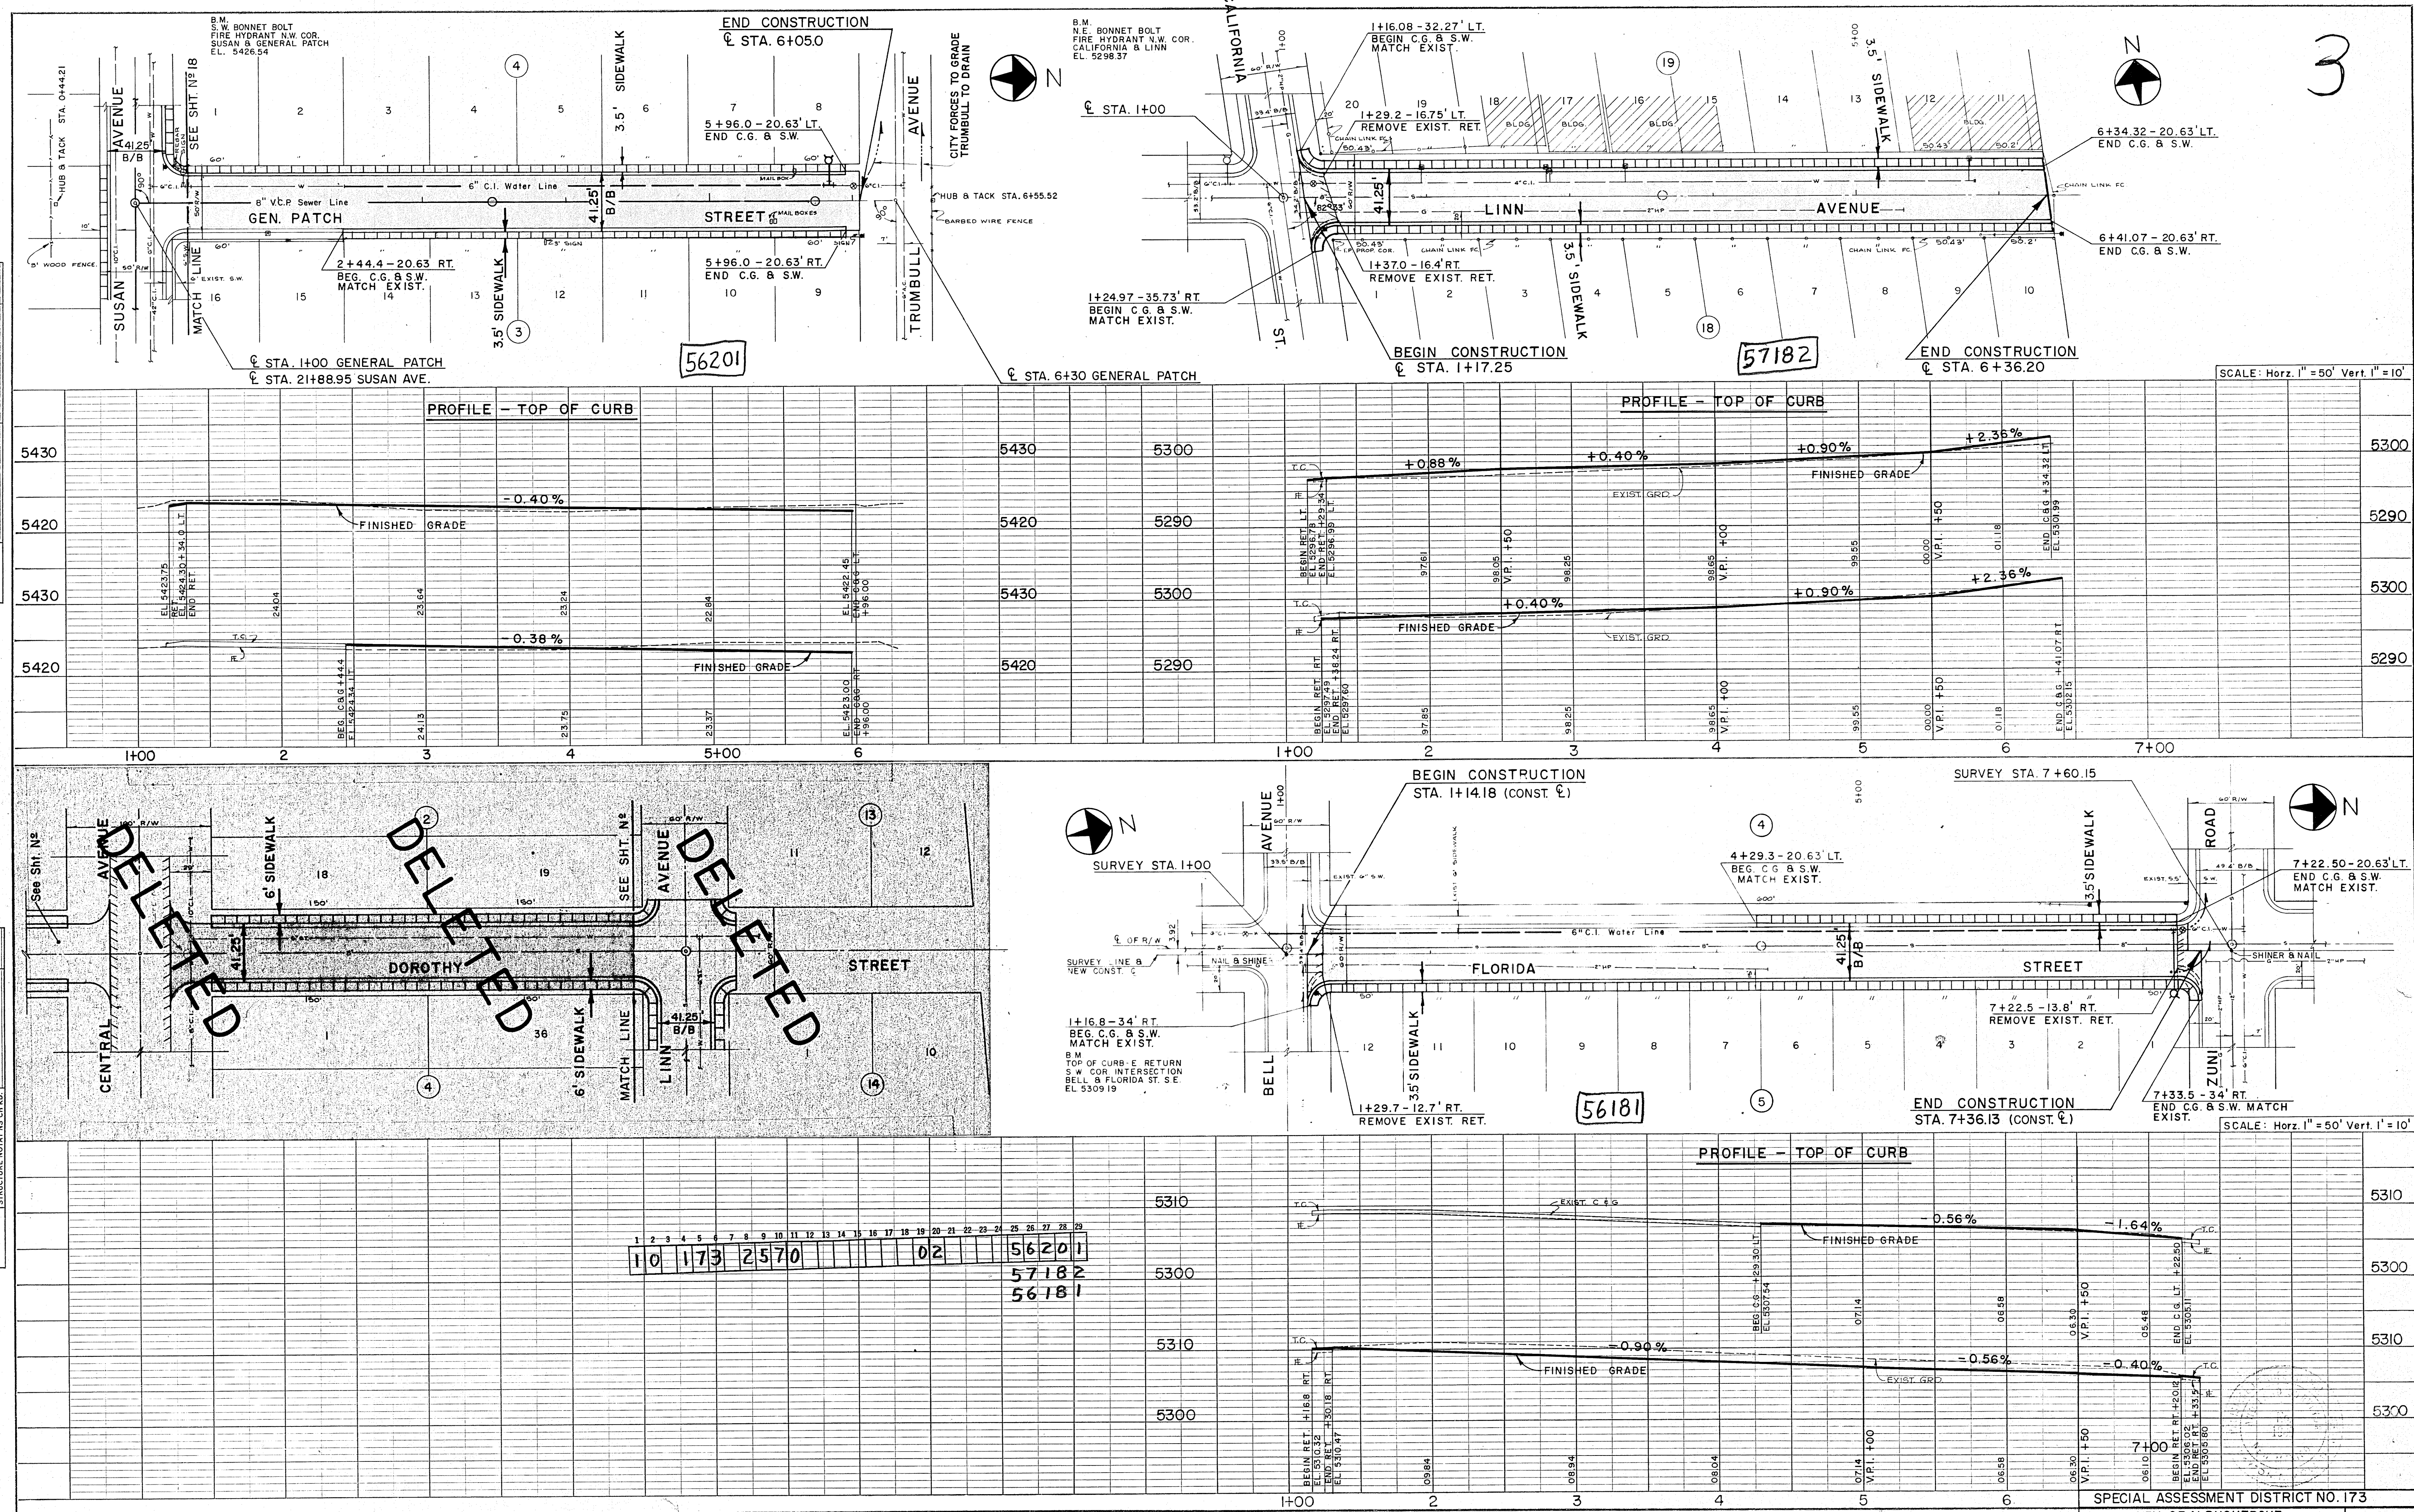

PLAN	DATE	BY
	SURVEYED	
NO.	NOTE BOOK	
	FLIPPED	
STRUCTURE NOTATIONS CHKD.		

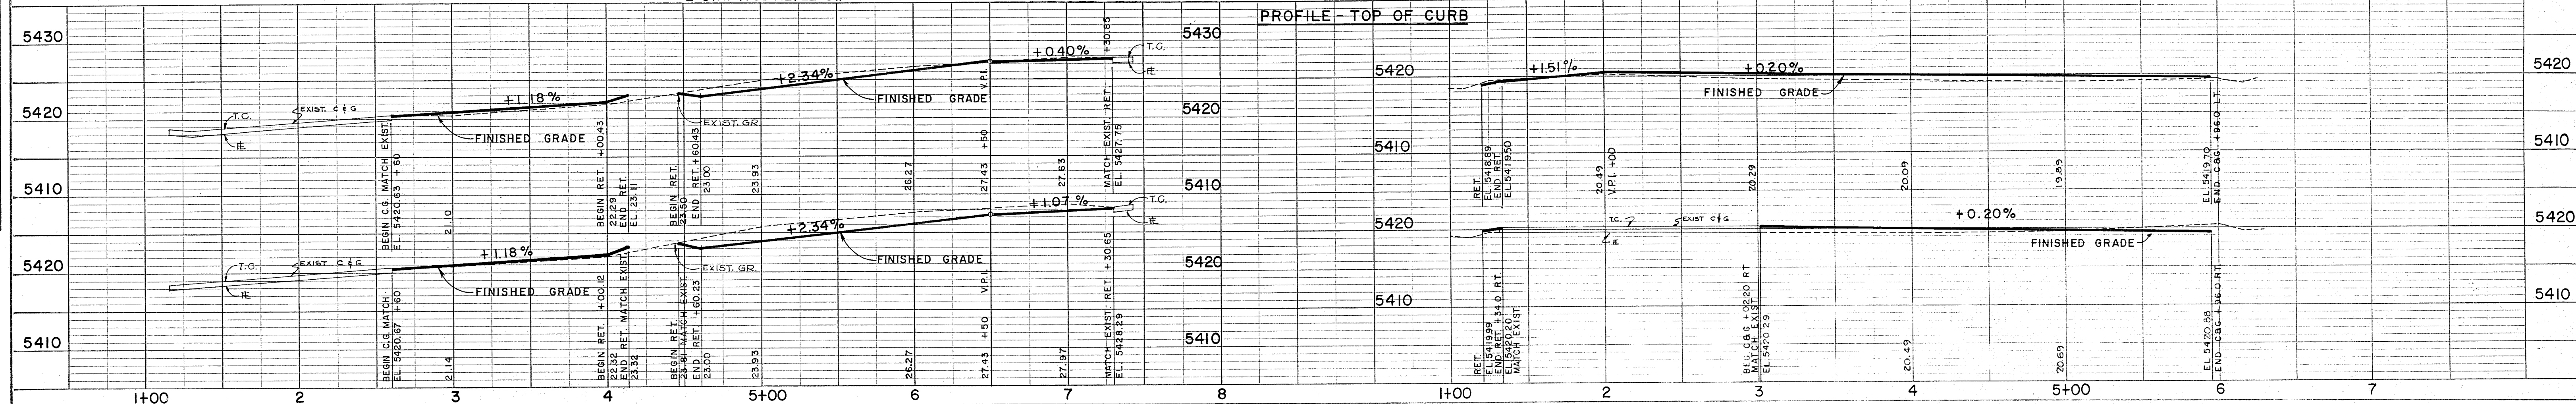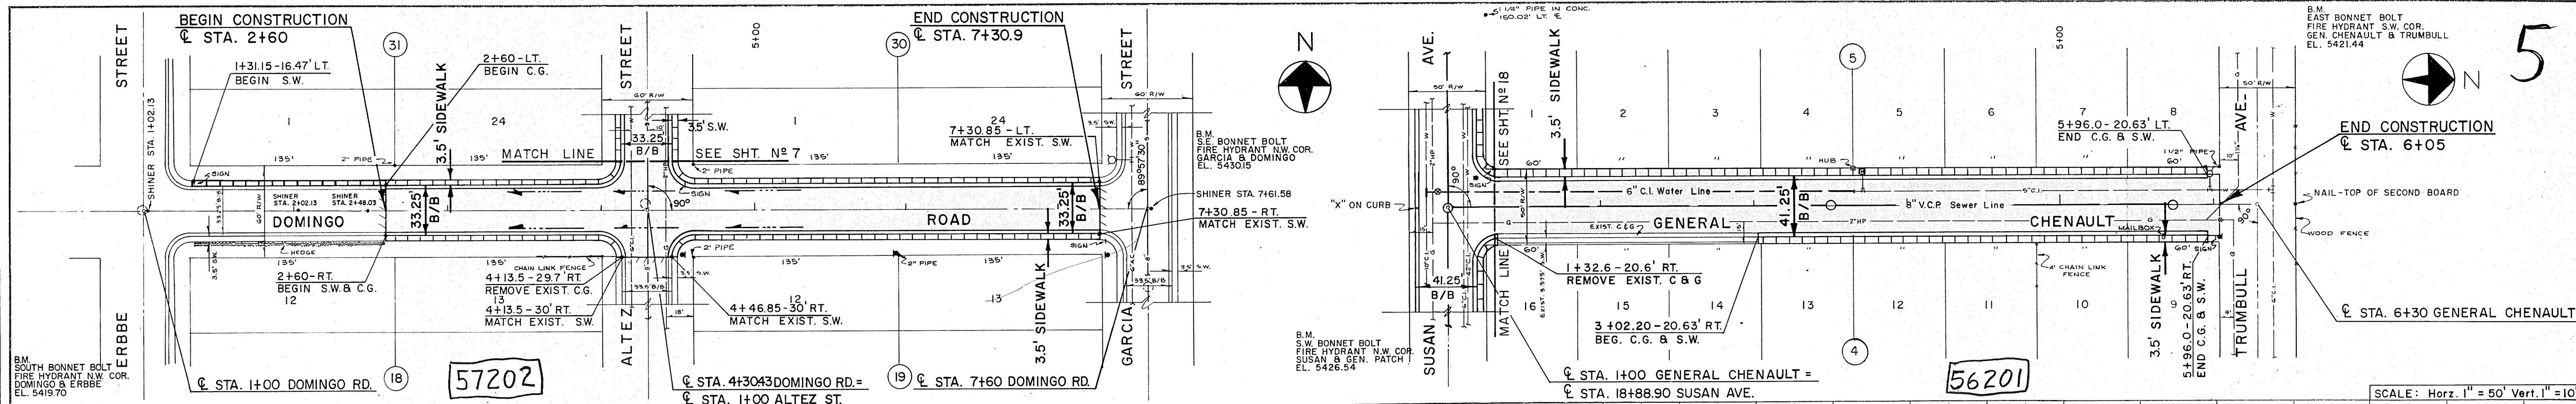


PROFILE	DATE	BY
	SURVEYED	
NO.	NOTE BOOK	
	FLIPPED	
STRUCTURE NOTATIONS CHKD.		

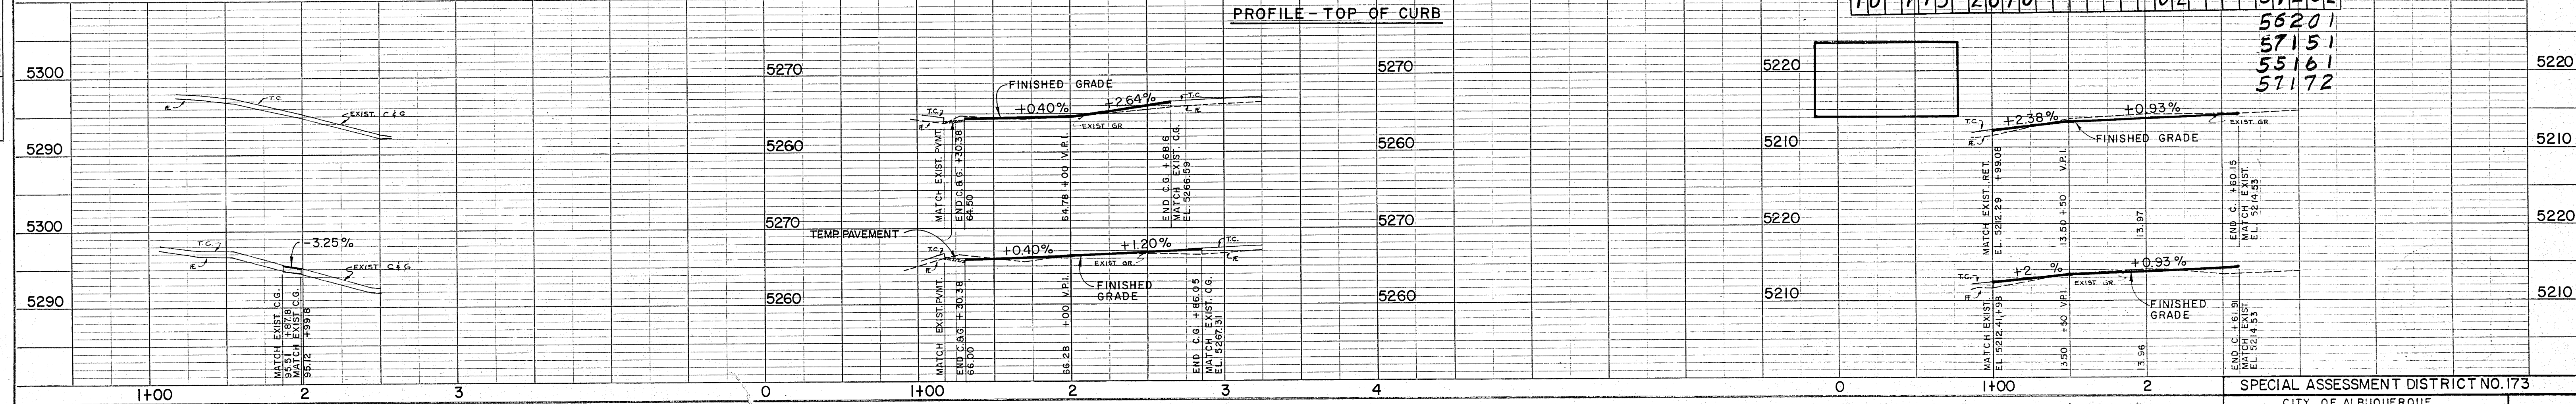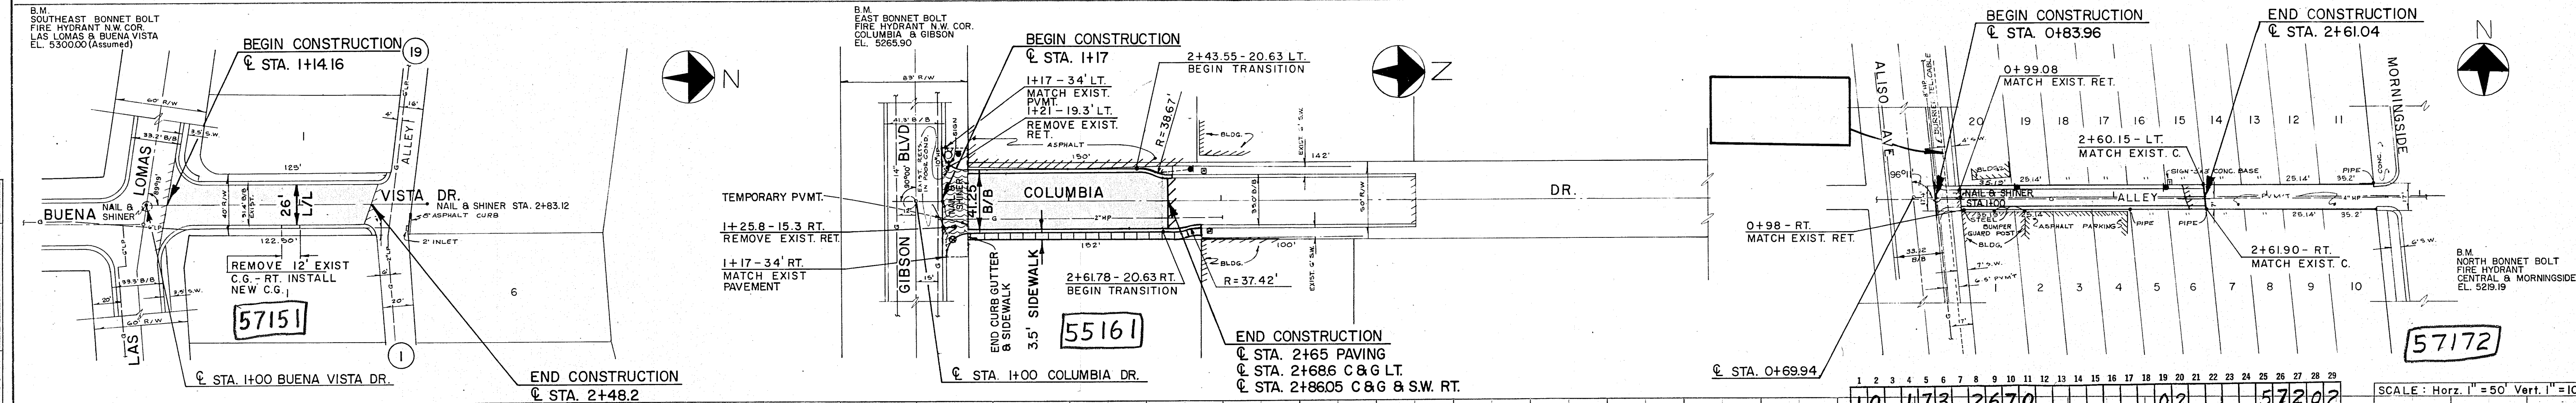

PLAN	SURVEYED	DATE
	NOTE BOOK	BY
NO.	ALIGNED	
	RT. OF WAY CHECKED	

PROFILE	SURVEYED	DATE
	NOTE BOOK	BY
NO.	ALIGNED	
	RT. OF WAY CHECKED	


BEGIN CONSTRUCTION
C STA. 1+41.28

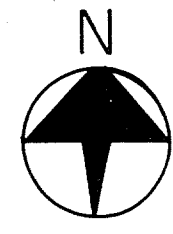

B.M.
TOP CURB
NORTH END DROP INLET
WEST SIDE YALE
EL. 5205.29


C STA. 1+00 ALAMO AVE.

1+43.6 - C
REMOVE EXIST.
C.G. & S.W.

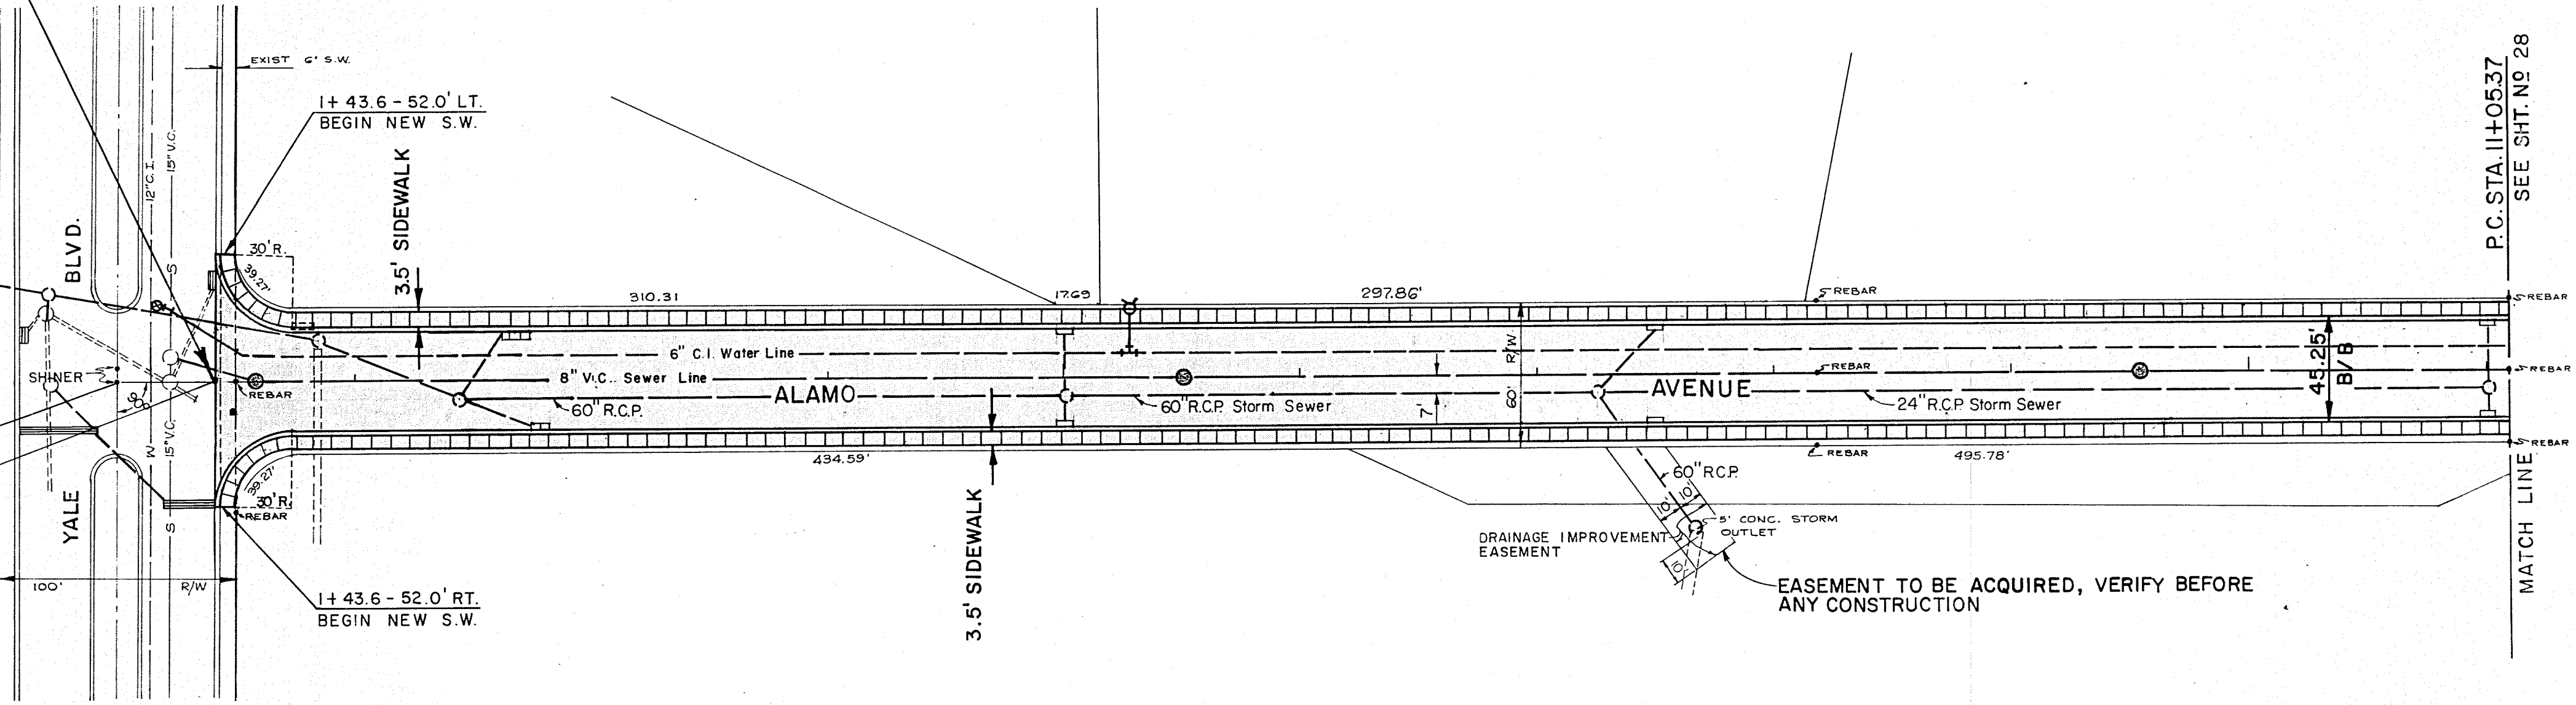

NOTE: FOR MORE INFORMATION ON UTILITY'S, AT THIS
STREET INTERSECTION SEE SHEET NO. 69

1	2	3	4	5	6	7	8	9	10	11	12	13	14	15	16	17	18	19	20	21	22	23	24	25	26	27	28	29
10	173	2770																	02							55161		

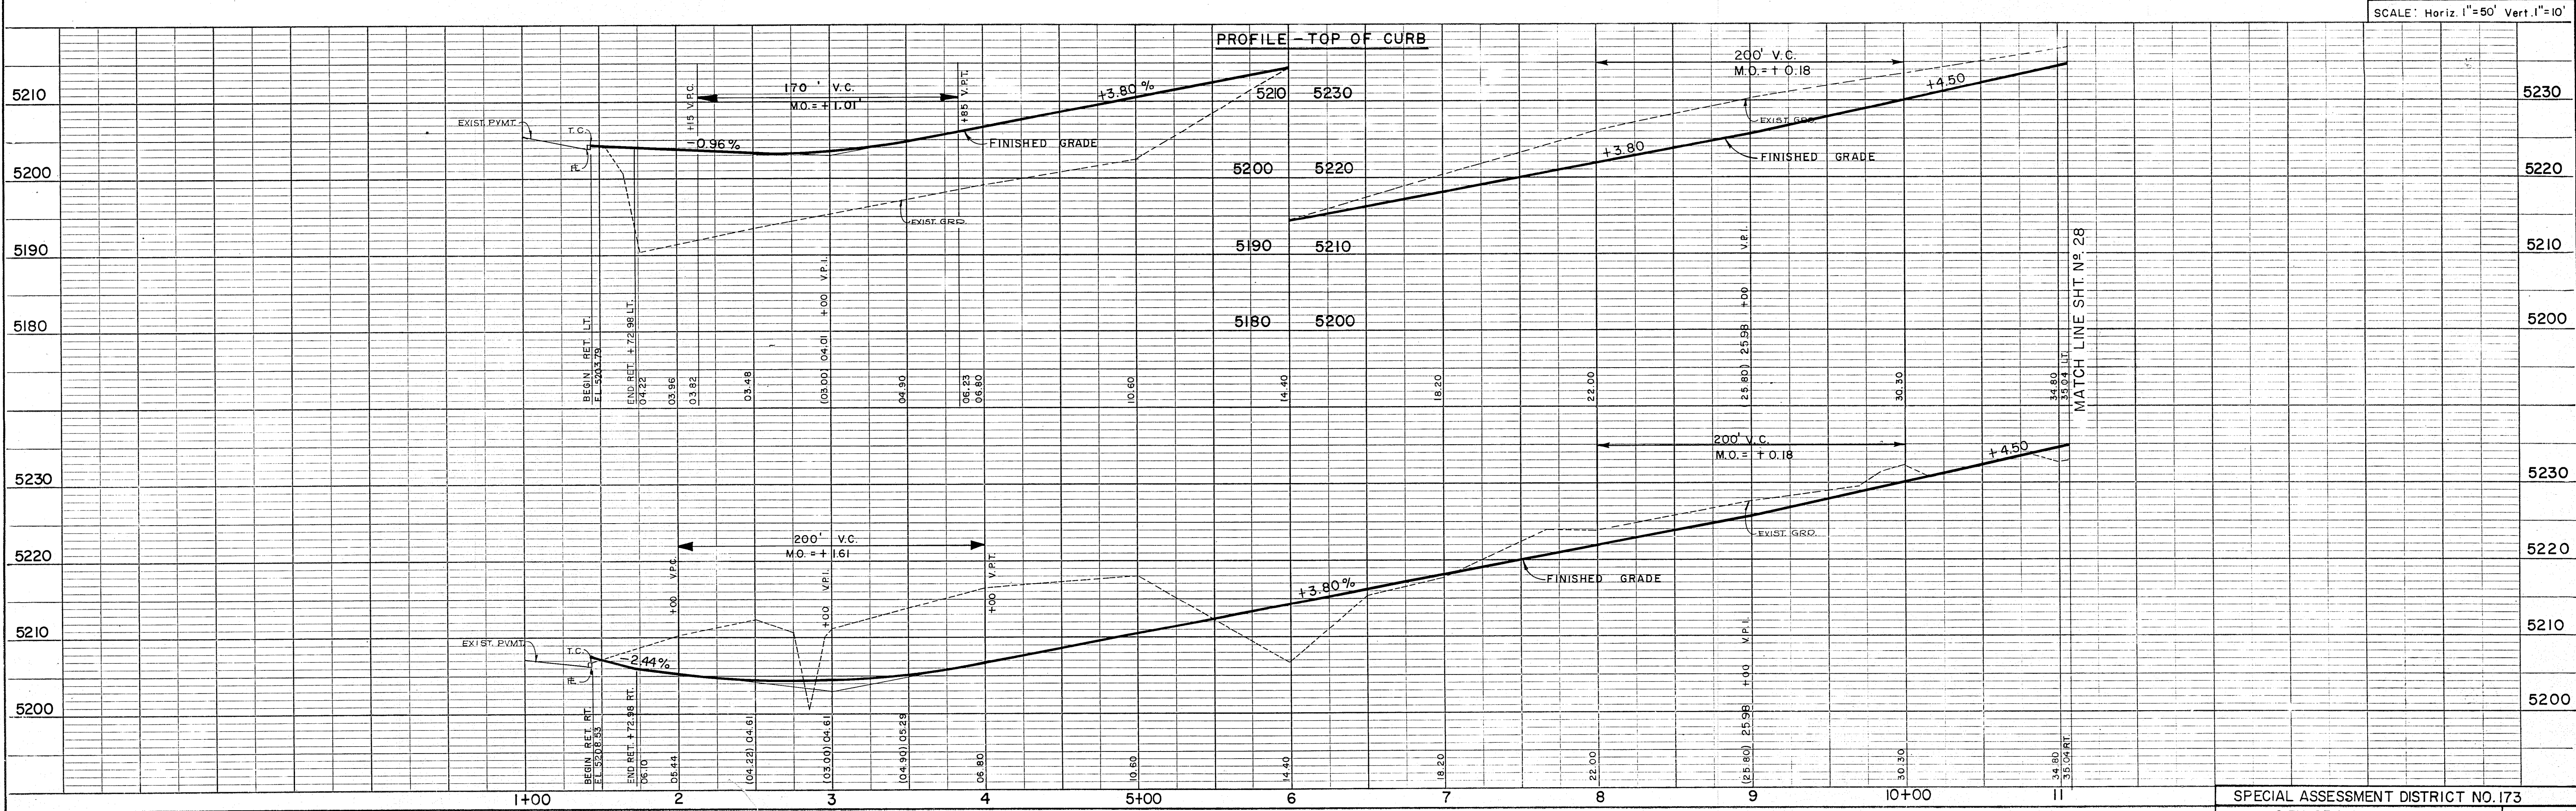

BRUNING NO. 42-161



PLATE 1-PLAN-PROFILE O.P.R. & E.
MADE AND PRINTED IN U.S.A.
CHARLES BRUNING COMPANY

AS BUILT DRAWING

These drawings do not constitute a contract. The contractor shall be responsible for the construction of the project in accordance with the approved plans and specifications.

SPECIAL ASSESSMENT DISTRICT NO. 173
CITY OF ALBUQUERQUE
PAVING PLAN & PROFILE
ALAMO AVE. Yale East

SHEET
27
OF

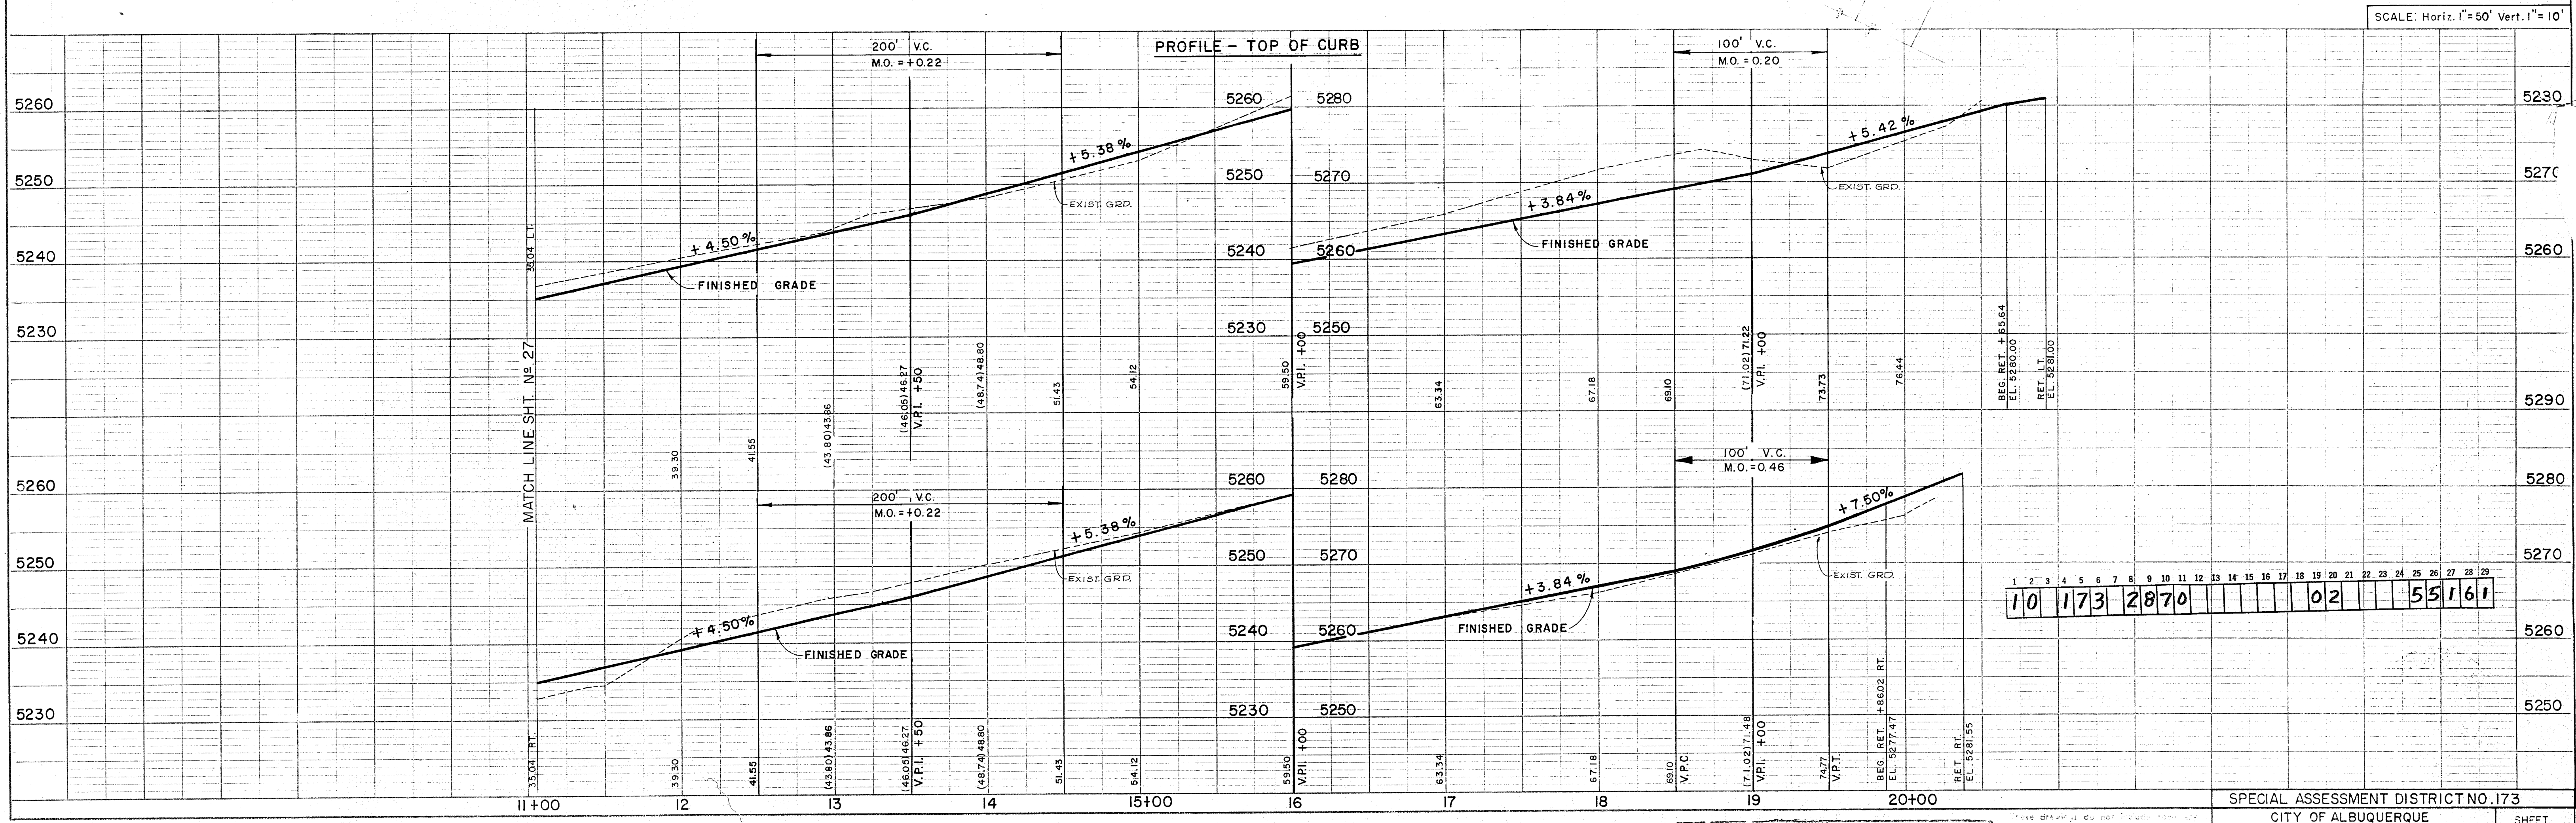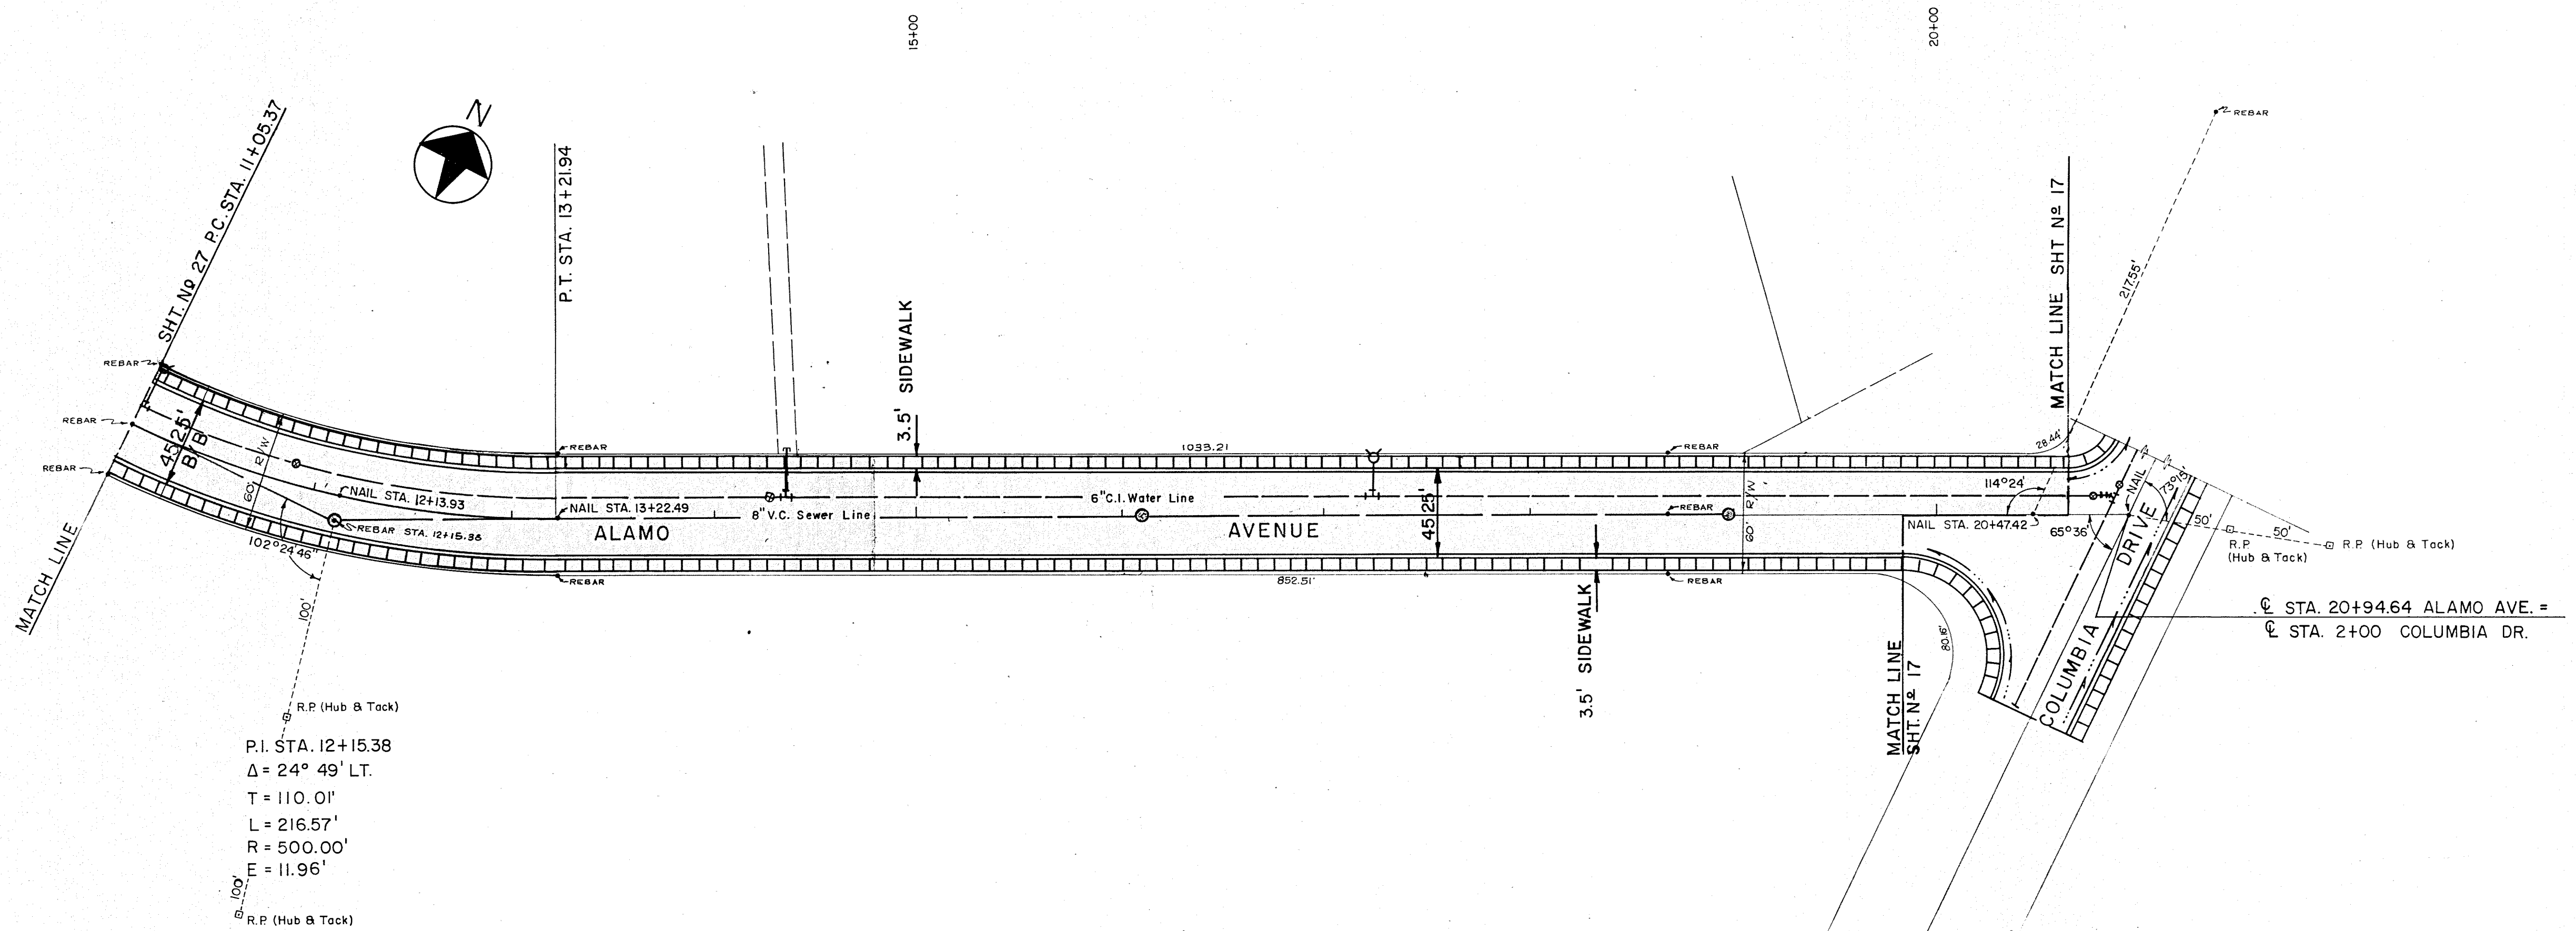

AS BUILT DRAWING