


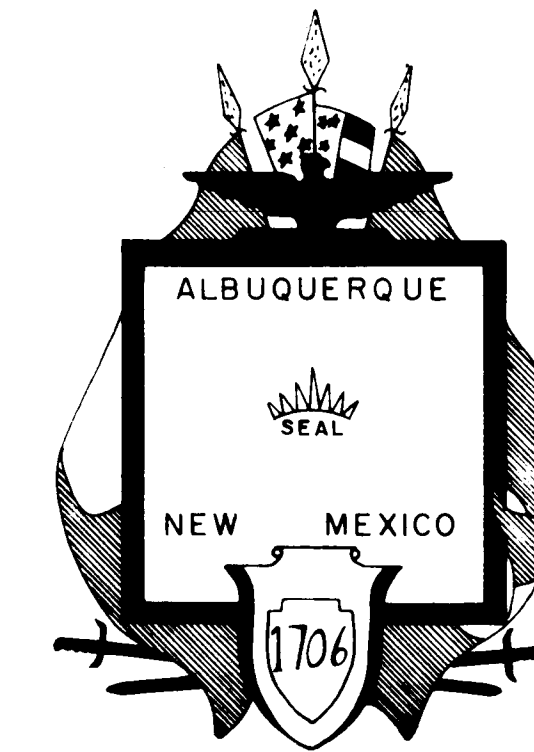

**CITY OF ALBUQUERQUE, NEW MEXICO
MUNICIPAL DEVELOPMENT DEPARTMENT**

INDEX

DESCRIPTION

COVER SHEET
LOCATION MAP
INDEX OF STREETS, GENERAL NOTES & LEGEND
PAVING PLAN & PROFILE
WATER PLAN & PROFILE
SEWER PLAN & PROFILE
SIDEWALK LOCATION & INDEX MAP
SIDEWALK PLANS
RETAINING WALL DETAILS

SHEET No.

1
2
3
4 - 15
16 - 19
20 - 22
23
24 - 66
67

**SPECIAL ASSESSMENT
DISTRICT NO. 194**

1 2 3 4 5 6 7 8 9 10 11 12
10 194 0182

ALL SHEETS
APPROVAL OF AS BUILT DRAWINGS
ASST. CITY ENGINEER - FIELD
<i>[Signature]</i>
DATE 12-11-82

SCANNED BY
BY LASON

WILSON & COMPANY ENGINEERS & ARCHITECTS
ALBUQUERQUE, NEW MEXICO

RECORD DRAWING
DATE 01/21/82
[Signature]

JUNE 1980

78-507

GENERAL NOTES:

1. ALL RADII OF CURB RETURNS ARE SHOWN TO FLOWLINE OF CURB.
2. ALL DIMENSIONS ARE TO FLOWLINE OF CURB.
3. ALL FINISH GRADES AND PROFILES SHOWN ARE TOP OF CURB GRADES, UNLESS OTHERWISE NOTED. MATCH FLOWLINES OF GUTTERS WHEN CONNECTING NEW CURB AND GUTTER TO EXISTING.
4. ALL UTILITY POLES ARE TO BE RELOCATED BY OTHERS.
5. CURB AND GUTTER SHOWN AS EXISTING AND NOT TO BE REMOVED UNDER THIS CONTRACT WHICH IS DAMAGED OR DISPLACED BY THE CONTRACTOR SHALL BE REMOVED AND REPLACED BY THE CONTRACTOR AT HIS EXPENSE.
6. WHEN ABUTTING NEW PAVEMENT TO EXISTING, CUT BACK EXISTING PAVEMENT TO A STRAIGHT LINE AS REQUIRED TO REMOVE ANY BROKEN OR CRACKED PAVEMENT AND MATCH NEW TO EXISTING.
7. WHEN REMOVAL OF EXISTING CURB AND GUTTER OR SIDEWALK IS REQUIRED, REMOVE BACK TO NEAREST JOINT, OR MAKE SAW CUT.
8. ALL GAS VALVE BOXES, GAS MANHOLES, ELECTRICAL MANHOLES, AND TELEPHONE MANHOLES WILL BE ADJUSTED TO GRADE BY OTHERS.
9. IT WILL BE THE CONTRACTOR'S RESPONSIBILITY TO PROTECT AND MAINTAIN IN SERVICE ALL EXISTING UTILITIES.
10. DRIVEPADS ARE TO BE LOCATED WHERE THERE IS EVIDENCE OF AN EXISTING DRIVE, AS DETERMINED BY THE PROJECT ENGINEER. DRIVEWAY PERMIT MUST BE OBTAINED FROM TRAFFIC ENGINEERING BY THE OWNER.
11. THE CITY OF ALBUQUERQUE STANDARD DETAILS ARE INCLUDED IN PART IN THE BACK OF THE SPECIFICATIONS.
12. ALL WATER VALVE BOXES AND SEWER MANHOLES IN THE CONSTRUCTION AREA ARE TO BE ADJUSTED TO FINISH GRADE UNDER THIS CONTRACT.
13. SUBGRADE PREPARATION UNDER CURB AND GUTTER, DRIVEPADS AND SIDEWALK SHALL BE CONSIDERED INCIDENTAL TO THE CONSTRUCTION OF SUCH AND SHALL BE INCLUDED IN THE BID PRICE FOR SUCH ITEMS.
14. A DISPOSAL SITE FOR ALL EXCESS EXCAVATION MATERIAL, ASPHALTIC PAVING, CONCRETE PAVING, HOUSE FOUNDATIONS AND FLOORS, EXISTING CATCH BASINS, ETC. SHALL BE OBTAINED BY THE CONTRACTOR. ALL COSTS INCURRED IN OBTAINING A DISPOSAL SITE AND HAUL THERE TO SHALL BE CONSIDERED INCIDENTAL TO CONSTRUCTION AND NO DIRECT PAYMENT WILL BE MADE THEREFOR.
15. WHEEL CHAIR RAMPS SHALL BE CONSTRUCTED AT ALL CURB RETURNS CONSTRUCTED ON THIS PROJECT AT LOCATIONS SHOWN ON THE PLANS, IN ACCORDANCE WITH CITY STANDARD DETAILS. WHEEL CHAIR RAMPS SHALL BE MEASURED AND PAID AS CONCRETE SIDEWALK AND CONCRETE CURB & GUTTER.
16. THE CONTRACTOR WILL BE REQUIRED TO CONFINE HIS WORK WITHIN THE CONSTRUCTION LIMITS AND/OR ROW TO PRESERVE EXISTING VEGETATION AND PRIVATE PROPERTY. OVERNITE PARKING OF CONSTRUCTION EQUIPMENT SHALL NOT OBSTRUCT DRIVEWAY OPENINGS OR DESIGNATED TRAFFIC LANES.
17. ROLLER OPERATION OF FIFTY (50) TONS OR MORE SHALL NOT BE USED IN THIS PROJECT WHERE UNDERGROUND UTILITIES ARE PRESENT. THE REQUIRED COMPACTION AT THESE LOCATIONS SHALL BE EFFECTED BY MEANS OF OTHER TYPES OF ROLLING AVAILABLE.
18. ALL EXCAVATIONS FOR STORM DRAINS, AND OTHER EXCAVATIONS AS NECESSARY SHALL BE GOVERNED BY THE CONSTRUCTION SAFETY AND HEALTH STANDARDS (TITLE 29, CODE OF FEDERAL REGULATIONS, PART 1518-PUBLISHED IN THE FEDERAL REGISTER ON APRIL 17, 1971), AND MODIFICATIONS THERETO.
19. UNLESS OTHERWISE SHOWN ON SEWER PLAN AND PROFILES, SEWER STUBS TO PROPERTY LINE SHALL BE 4" CAST IRON SOIL PIPE.
20. PERMANENT SIGNING AND ALL STRIPING BY CITY FORCES. CONSTRUCTION SIGNING AND STRIPING BY CONTRACTOR. ALL COSTS INCURRED FOR CONSTRUCTION SIGNING AND STRIPING SHALL BE CONSIDERED INCIDENTAL TO CONSTRUCTION AND NO DIRECT PAYMENT WILL BE MADE THEREFORE.
21. ALL WATER LINES CONSTRUCTED IN THIS PROJECT SHALL HAVE A MIN. OF 48" COVER FROM FINISHED PAVEMENT TO TOP OF PIPE.
22. TEMPORARY RELOCATION OF MAILBOXES MAY BE REQUIRED DURING CONSTRUCTION. THIS WORK WILL BE CONSIDERED INCIDENTAL TO COMPLETION OF THE WORK AND NO PAYMENT WILL BE MADE THEREFORE.
23. THE NEW MEXICO STANDARD SPECIFICATIONS FOR PUBLIC WORKS CONSTRUCTION, 1979 EDITION, AND THE SUPPLEMENTAL SPECIFICATIONS WILL GOVERN WORK ON THIS PROJECT, UNLESS OTHERWISE NOTED ON THE PLANS.
24. ALL MAILBOXES THAT ARE RELOCATED WILL BE REINSTALLED AS DIRECTED. THE INSTALLATION WILL BE PERMANENT IN NATURE.
25. 48 HOURS PRIOR TO ANY EXCAVATION, CONTRACTOR MUST CONTACT LINE & CABLE LOCATING SERVICE, 765-1234, FOR LOCATION OF EXISTING UTILITIES.
26. UNLESS OTHERWISE SHOWN ON WATER PLANS, WATER SERVICE LINES SHALL BE 1" DIAMETER.
27. CONCRETE BLOCKING SHALL BE INSTALLED ON ALL WATER LINE TEES, CAPS, ELBOWS AND FIRE HYDRANTS PER CITY OF ALBUQUERQUE STANDARD DETAILS.
28. ALL BARRICADING & SIGNING WILL BE IN ACCORDANCE WITH "THE NEW MEXICO MANUAL & SPECIFICATIONS FOR A UNIFORM SYSTEM OF TRAFFIC CONTROL DEVICES FOR STREETS & HIGHWAYS, 1978 EDITION."

INDEX OF STREETS

REF. NO.	MAP KEY	NAME OF STREETS	FROM	TO	IMPROVEMENT SHEET NO.		
					PAVING	SAN. SEW.	WATER
1	L-21	COCHITI RD. SE	SHIRLEY RD.	JUAN TABO RD.	● 5	● 5	● 16
3	D-18	SAN ANTONIO DR. NE	SAN PEDRO BLVD.	LOUISIANA BLVD.	● 13		
4	G-16	CHEROKEE RD. NE	TULANE DR.	TYSON PL.	● 4		
6	K-11	52ND ST. SW	450 FT. SOUTH OF CHURCHILL RD.	CHURCHILL RD.	● 14		
7	H-16	TULANE DR. NE	CORONADO FREEWAY	DRAINAGE & UTILITIES R.O.W.			● 16
9	G-20	VERANDA RD. NE	GENERAL CHENALT	286 FT. EAST	● 8		
13	H-13	INDIAN SCHOOL ROAD NW	HENAU BLVD. EXTENSION	12TH ST.	● 11		
14	G-14	SAN CLEMENTE AVE. NW	4TH ST.	ALAMEDA DRAIN		● 21	● 17
15	K-10	NADO ST. SW	GONZALES RD.	LEN PL.	● 12	● 20	● 18
15	K-10	LEN PL. SW	NADO ST.	PARDO ST.	● 12	● 20	● 18
15	K-10	PARDO ST. SW	LEN PL.	GONZALES RD.	● 12	● 20	● 18
16	G-12	VERANDA RD. NW	GLENWOOD RD.	DURANES DITCH	● 15	● 22	● 19
17	G-12	DECKER RD. NW	TRELLIS RD.	GLENWOOD RD.		● 22	● 19
18	H-11	EL AGUILA PL. NW	VISTA GRANDE DR.	420 FT. EAST	● 4		
20	E-11	DELLYNE AVE. NW	393 FT. WEST OF VALLE VISTA DR.	COORS BLVD.	● 7, 8		
20	E-11	VALLE VISTA DR. NW	DELLYNE	533 FT. NORTH	● 8		
21	E-11	COLLEGE ST. NW	VALLE VISTA DR.	AVENIDA ARTURO	● 6		
21	K-12	47TH ST. SW	LA VIDA NUEVA LOOP	CENTRAL AVE. WEST	● 6		
22	L-22	FIGUEROA ST. NE	CENTRAL AVE. EAST	LINX AVE.	● 10		● 16
23	F-21	EUBANK BLVD. NE	90 FT. NORTH OF CAMINO DEL SOL	LAYTON AVE.	● 9		

LEGEND

EXISTING UTILITIES

- G — GAS
— W — WATER
— S — SANITARY SEWER
— SD — STORM DRAIN
— MH — MANHOLE
— WV — WATER VALVE
— WM — WATER METER
— U — UTILITY POLE
— LP — LIGHT POLE
— FH — FIRE HYDRANT
— DI — DROP INLET
— UT — BURIED TELEPHONE LINE
- PROFILE
- L — LEFT PROPERTY LINE
— R — RIGHT PROPERTY LINE
— T — TOP OF EXISTING CURB OR CONCRETE FOUNDATIONS
- PLAN
- (R) REMOVE
(C) CONSTRUCT
(I) INSTALL
WCR WHEEL CHAIR RAMP LOCATION

ALBUQUERQUE, NEW MEXICO
SPECIAL ASSESSMENT DISTRICT NO. 194

INDEX OF STREETS, GENERAL NOTES, LEGEND

DESIGN	DRAWN	DATE	JUNE 1980
		FILE NO.	78-507
		SHEET NO.	3
		OF	67

RECORD DRAWING
DATE 01/22/89
[Signature]

