


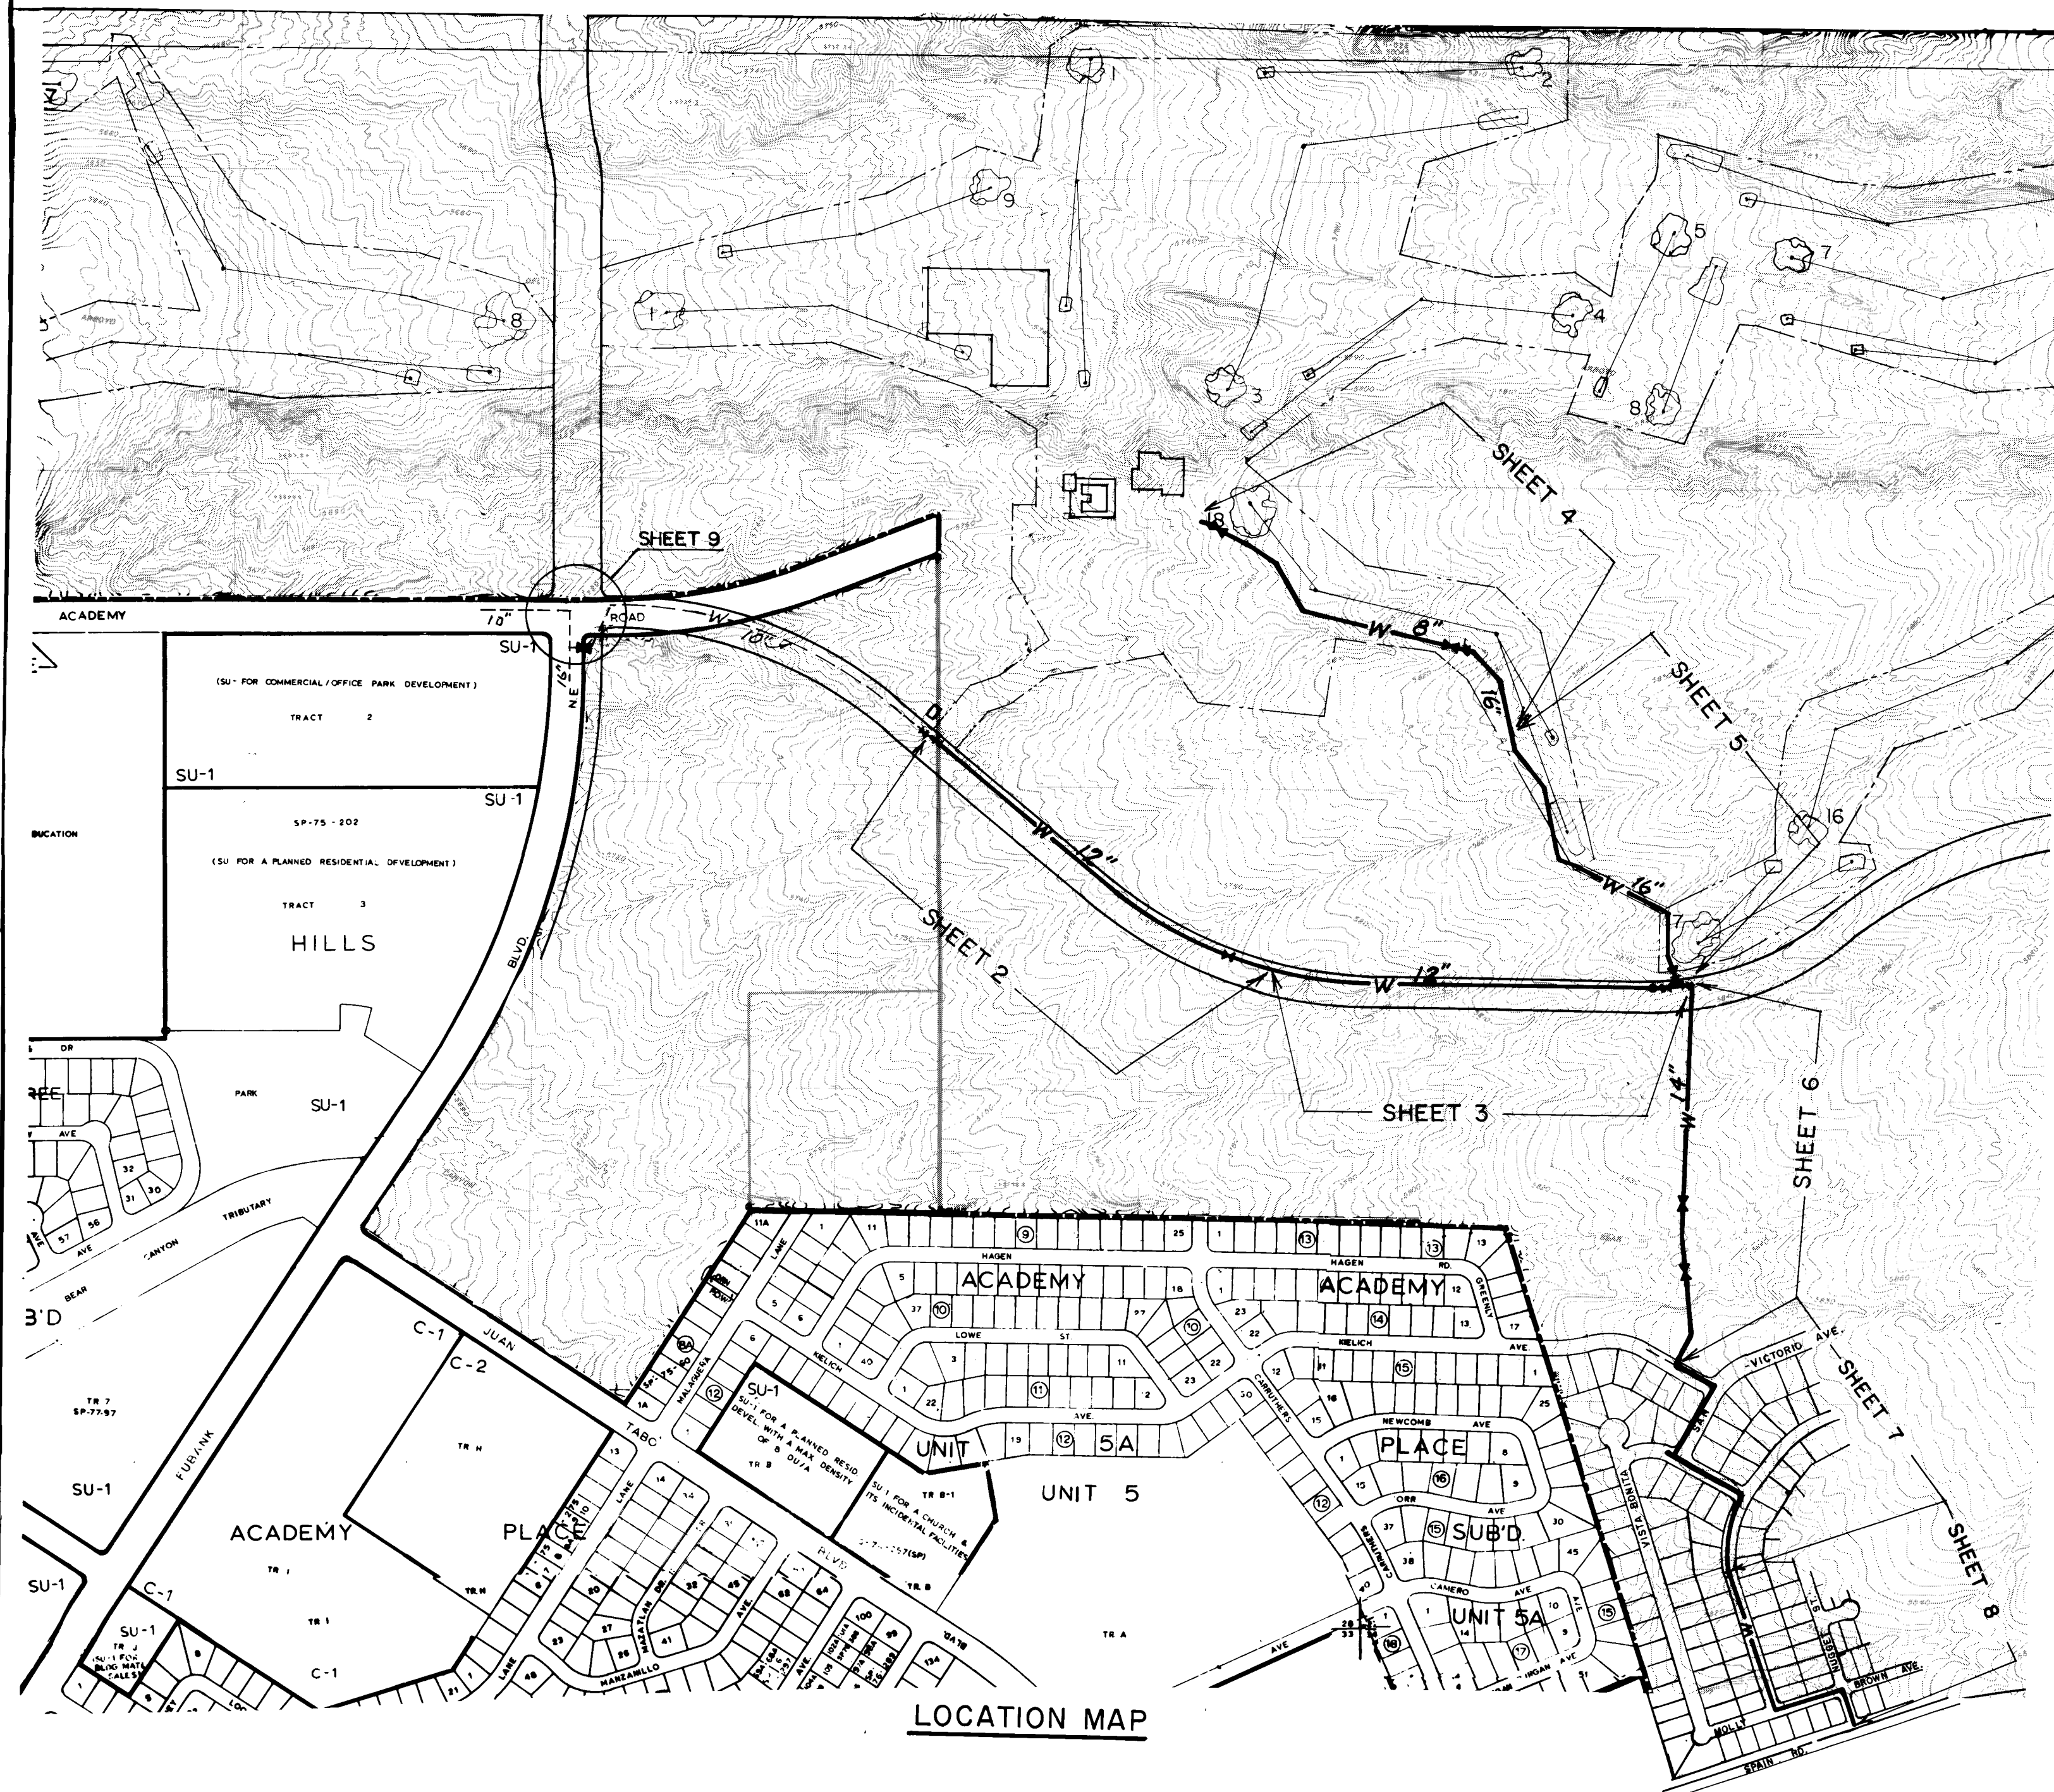

INDEX OF DRAWINGS

| SHEET NO.        | TITLE                                                   |
|------------------|---------------------------------------------------------|
| SHEET 1 OF 9     | TITLE SHEET, INDEX OF DRAWINGS AND LOCATION MAP         |
| PLAN AND PROFILE |                                                         |
| SHEET 2 OF 9     | STA. 0+00 TO 14+00                                      |
| SHEET 3 OF 9     | STA. 14+00 TO 28+14.21                                  |
| SHEET 4 OF 9     | STA. 0+00 TO 14+00                                      |
| SHEET 5 OF 9     | STA. 14+00 TO 24+97.69                                  |
| SHEET 6 OF 9     | STA. 0+25.5 TO 11+26.12                                 |
| SHEET 7 OF 9     | STA. 11+26.12 TO 20+30.96                               |
| SHEET 8 OF 9     | STA. 20+30.96 TO 30+08.63                               |
| SHEET 9 OF 9     | TANOAN COUNTRY CLUB-WATER LINE CONNECTION MODIFICATIONS |

DATE: NOV. 1980

NOTICE TO CONTRACTORS

1. New Mexico Standard Specifications for Public Works Construction - 1979 Edition will be referred to hereon as the "Standard Specification."
2. All work detailed on these plans to be performed under contract shall, except as otherwise stated or provided for hereon, be constructed in accordance with "Contract Documents for City-Wide Utilities and Cash Paving No. 29" and the Standard Specification."
3. Two working days prior to any excavation, contractor must contact Line Locating Service, 765-1234, for location of existing utilities.
4. Prior to construction, the contractor shall excavate and verify the horizontal and vertical locations of all obstructions. Should a conflict exist, the contractor shall notify the engineer or surveyor so that the conflict can be resolved with a minimum amount of delay.
5. Electronic Marker disks shall be installed at all locations as described in Section 131 of the Specifications.

PROJECT TITLE

ZONE 7E WATER MASTER PLAN LINES-1980

PROJECT LOCATION

ALBUQUERQUE, NEW MEXICO

ALL SHEETS  
APPROVAL OF 10 SHEETS  
ASST. CITY ENGINEER  
DATE 11/30/80






**GORDON HERKENHOFF & ASSOCIATES, INC.**  
302 Eighth Street, N.W.  
Albuquerque, New Mexico 87102  
(505) 247-0294


HOBBS


FARMINGTON

SANTA FE
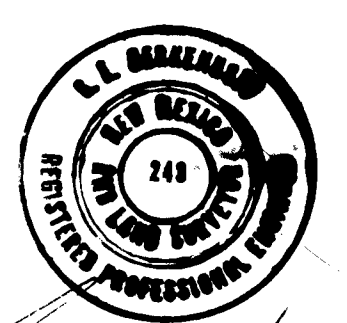
|                                                                                       |                    |      |                    |             |         |
|---------------------------------------------------------------------------------------|--------------------|------|--------------------|-------------|---------|
|  |                    |      |                    |             |         |
| CITY OF ALBUQUERQUE<br>PUBLIC WORKS DEPARTMENT<br>ENGINEERING DIVISION                |                    |      |                    |             |         |
| TITLE: COVER SHEET, LOCATION MAP AND INDEX OF DRAWINGS                                |                    |      |                    |             |         |
| APPROVALS                                                                             | ENGINEER           | DATE | APPROVALS          | ENGINEER    | DATE    |
| City Engineer                                                                         |                    |      | Liquid Waste       | N/D         |         |
| A.C.E. - Design                                                                       | J. K. K. 29 Jan 81 |      | Traffic            |             |         |
| A.C.E. - Hydrology                                                                    |                    |      | Water              | D. Thompson | 1/30/81 |
| APPROVED FOR CONSTRUCTION<br>R. S. S. 11/30/80                                        |                    |      | CITY ENGINEER DATE |             |         |
| DRAWING NO. 1027                                                                      |                    |      | SHEET 1 OF 9       |             |         |

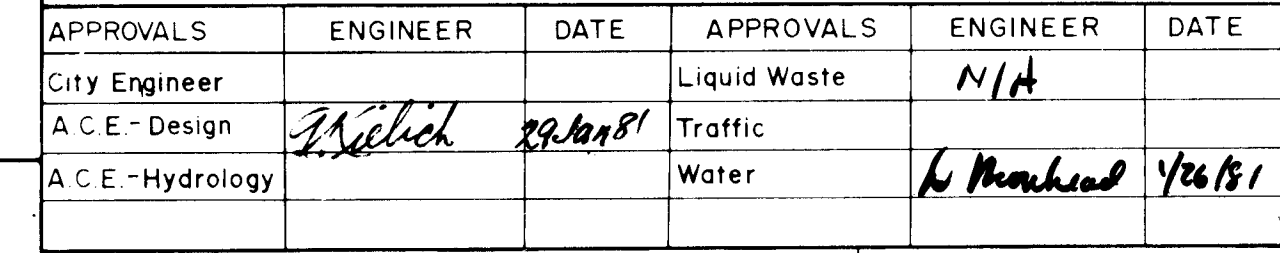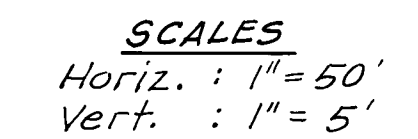[illegible]

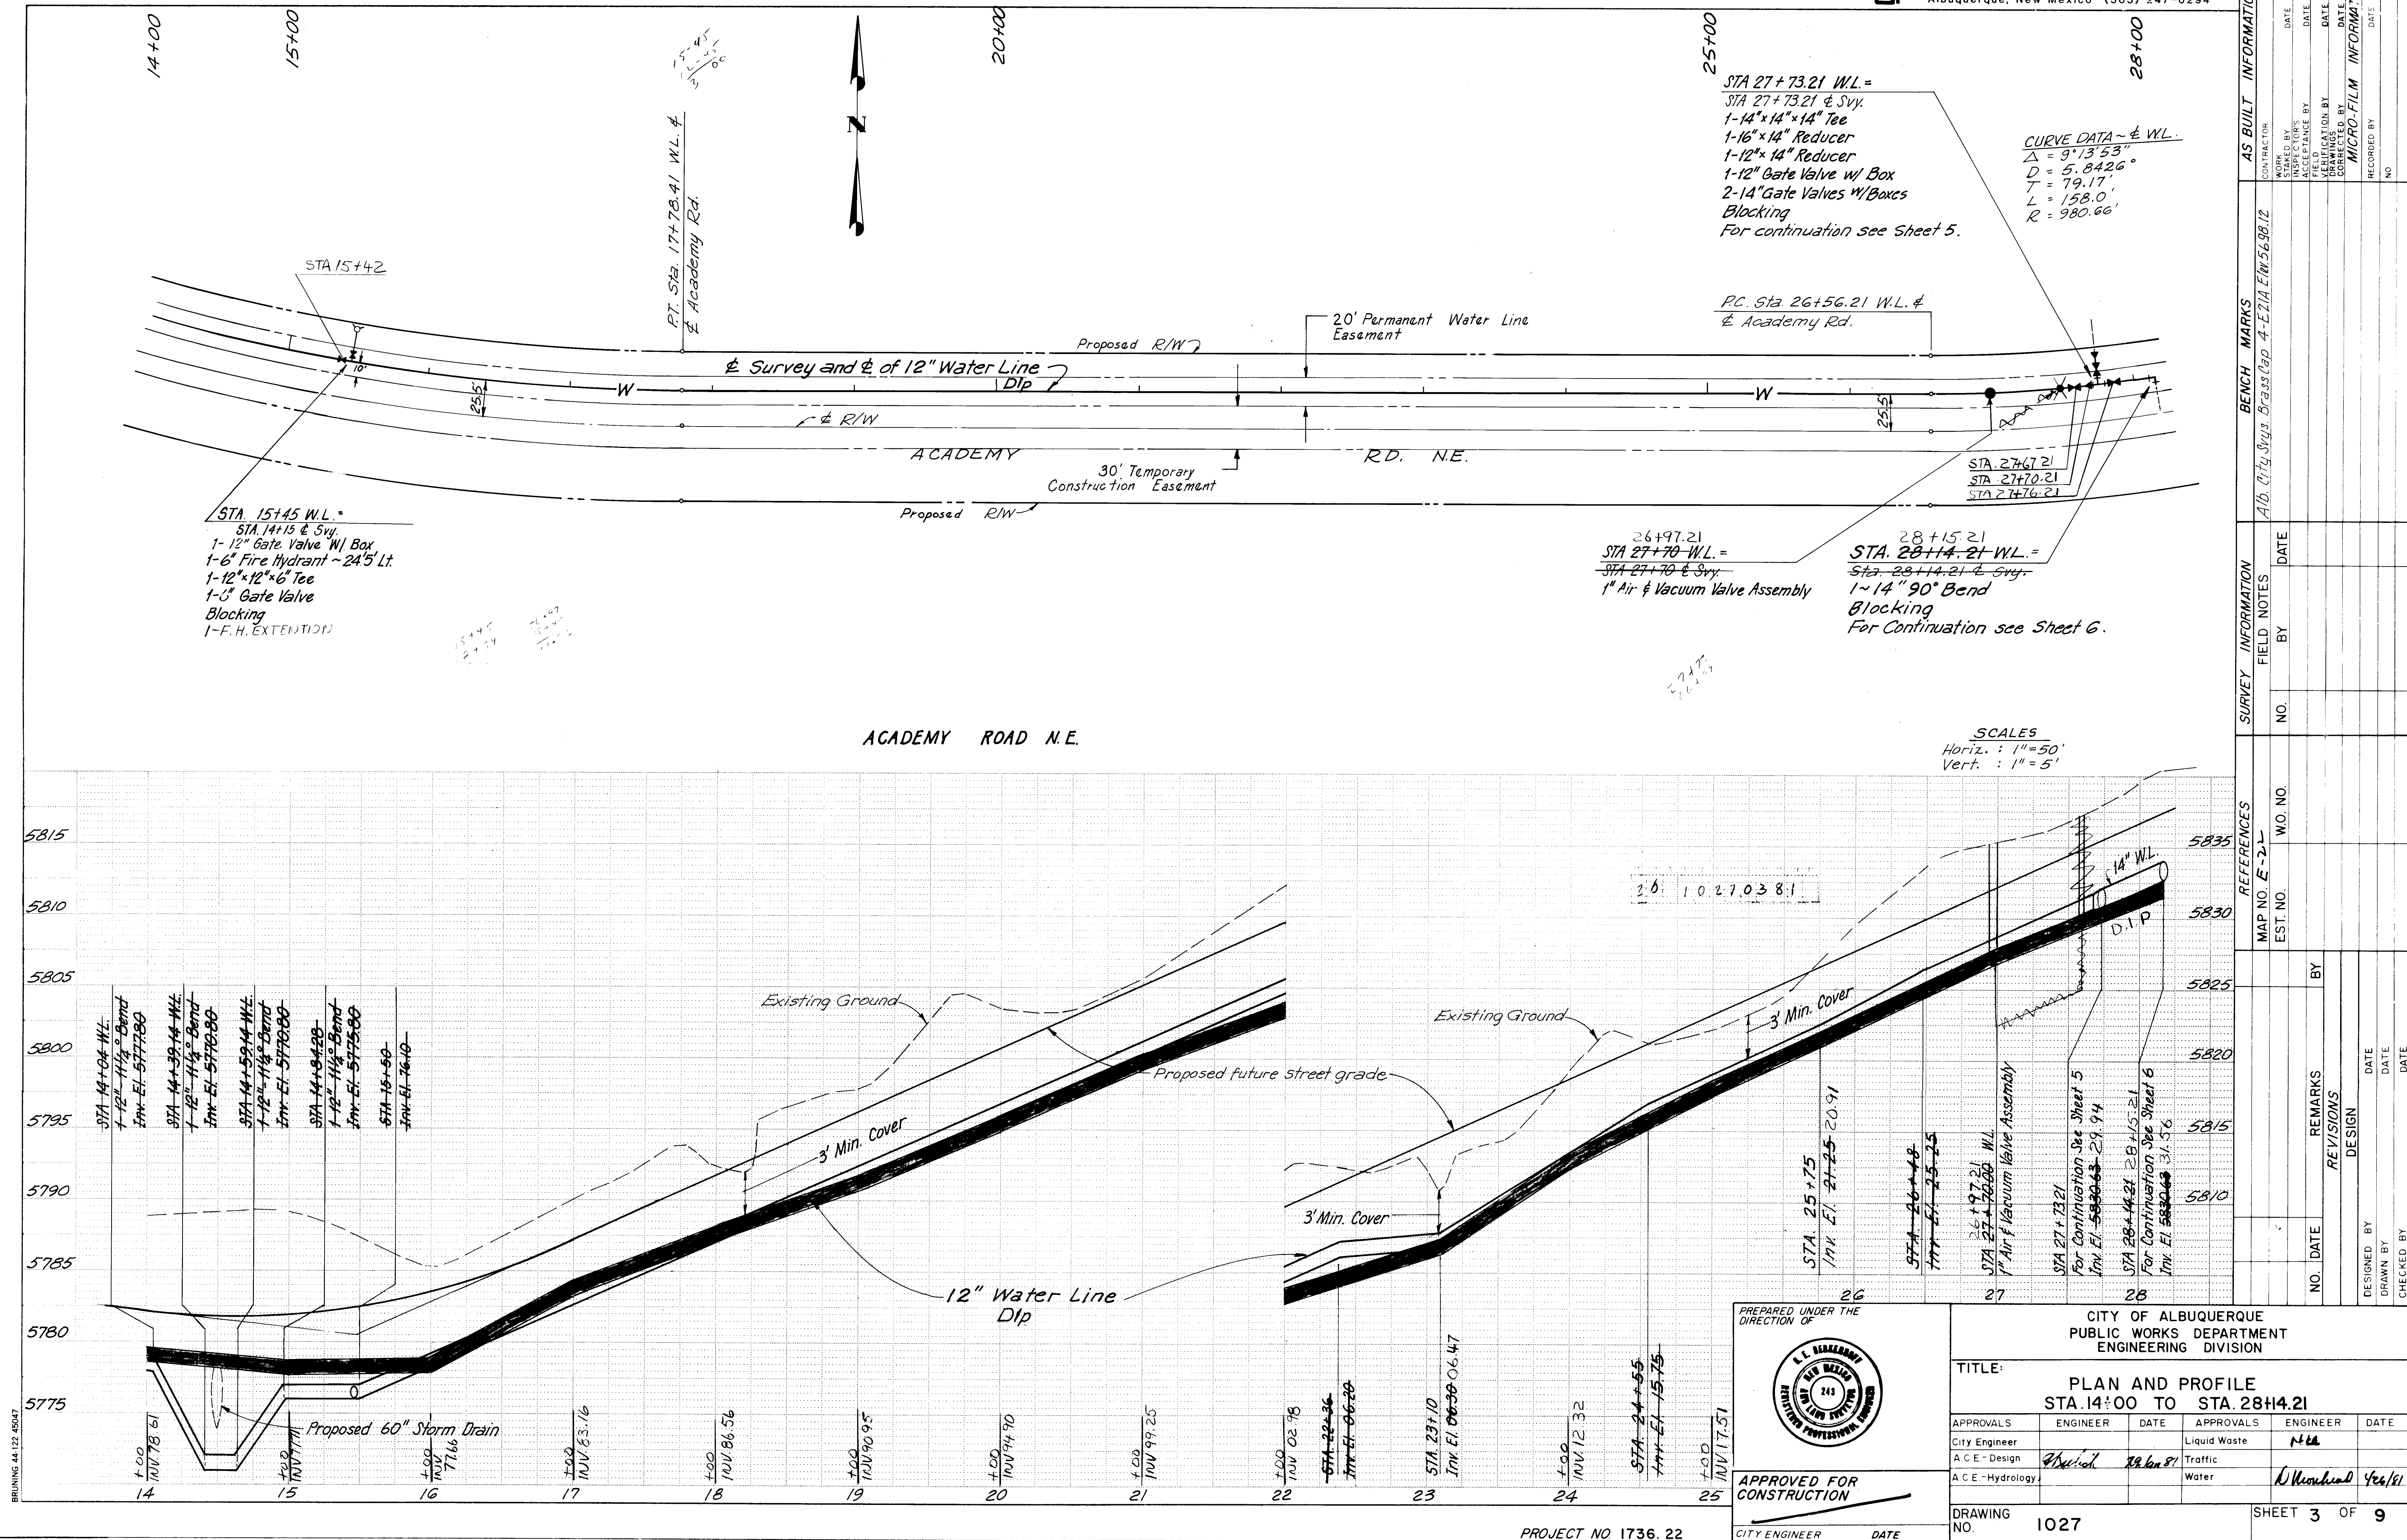


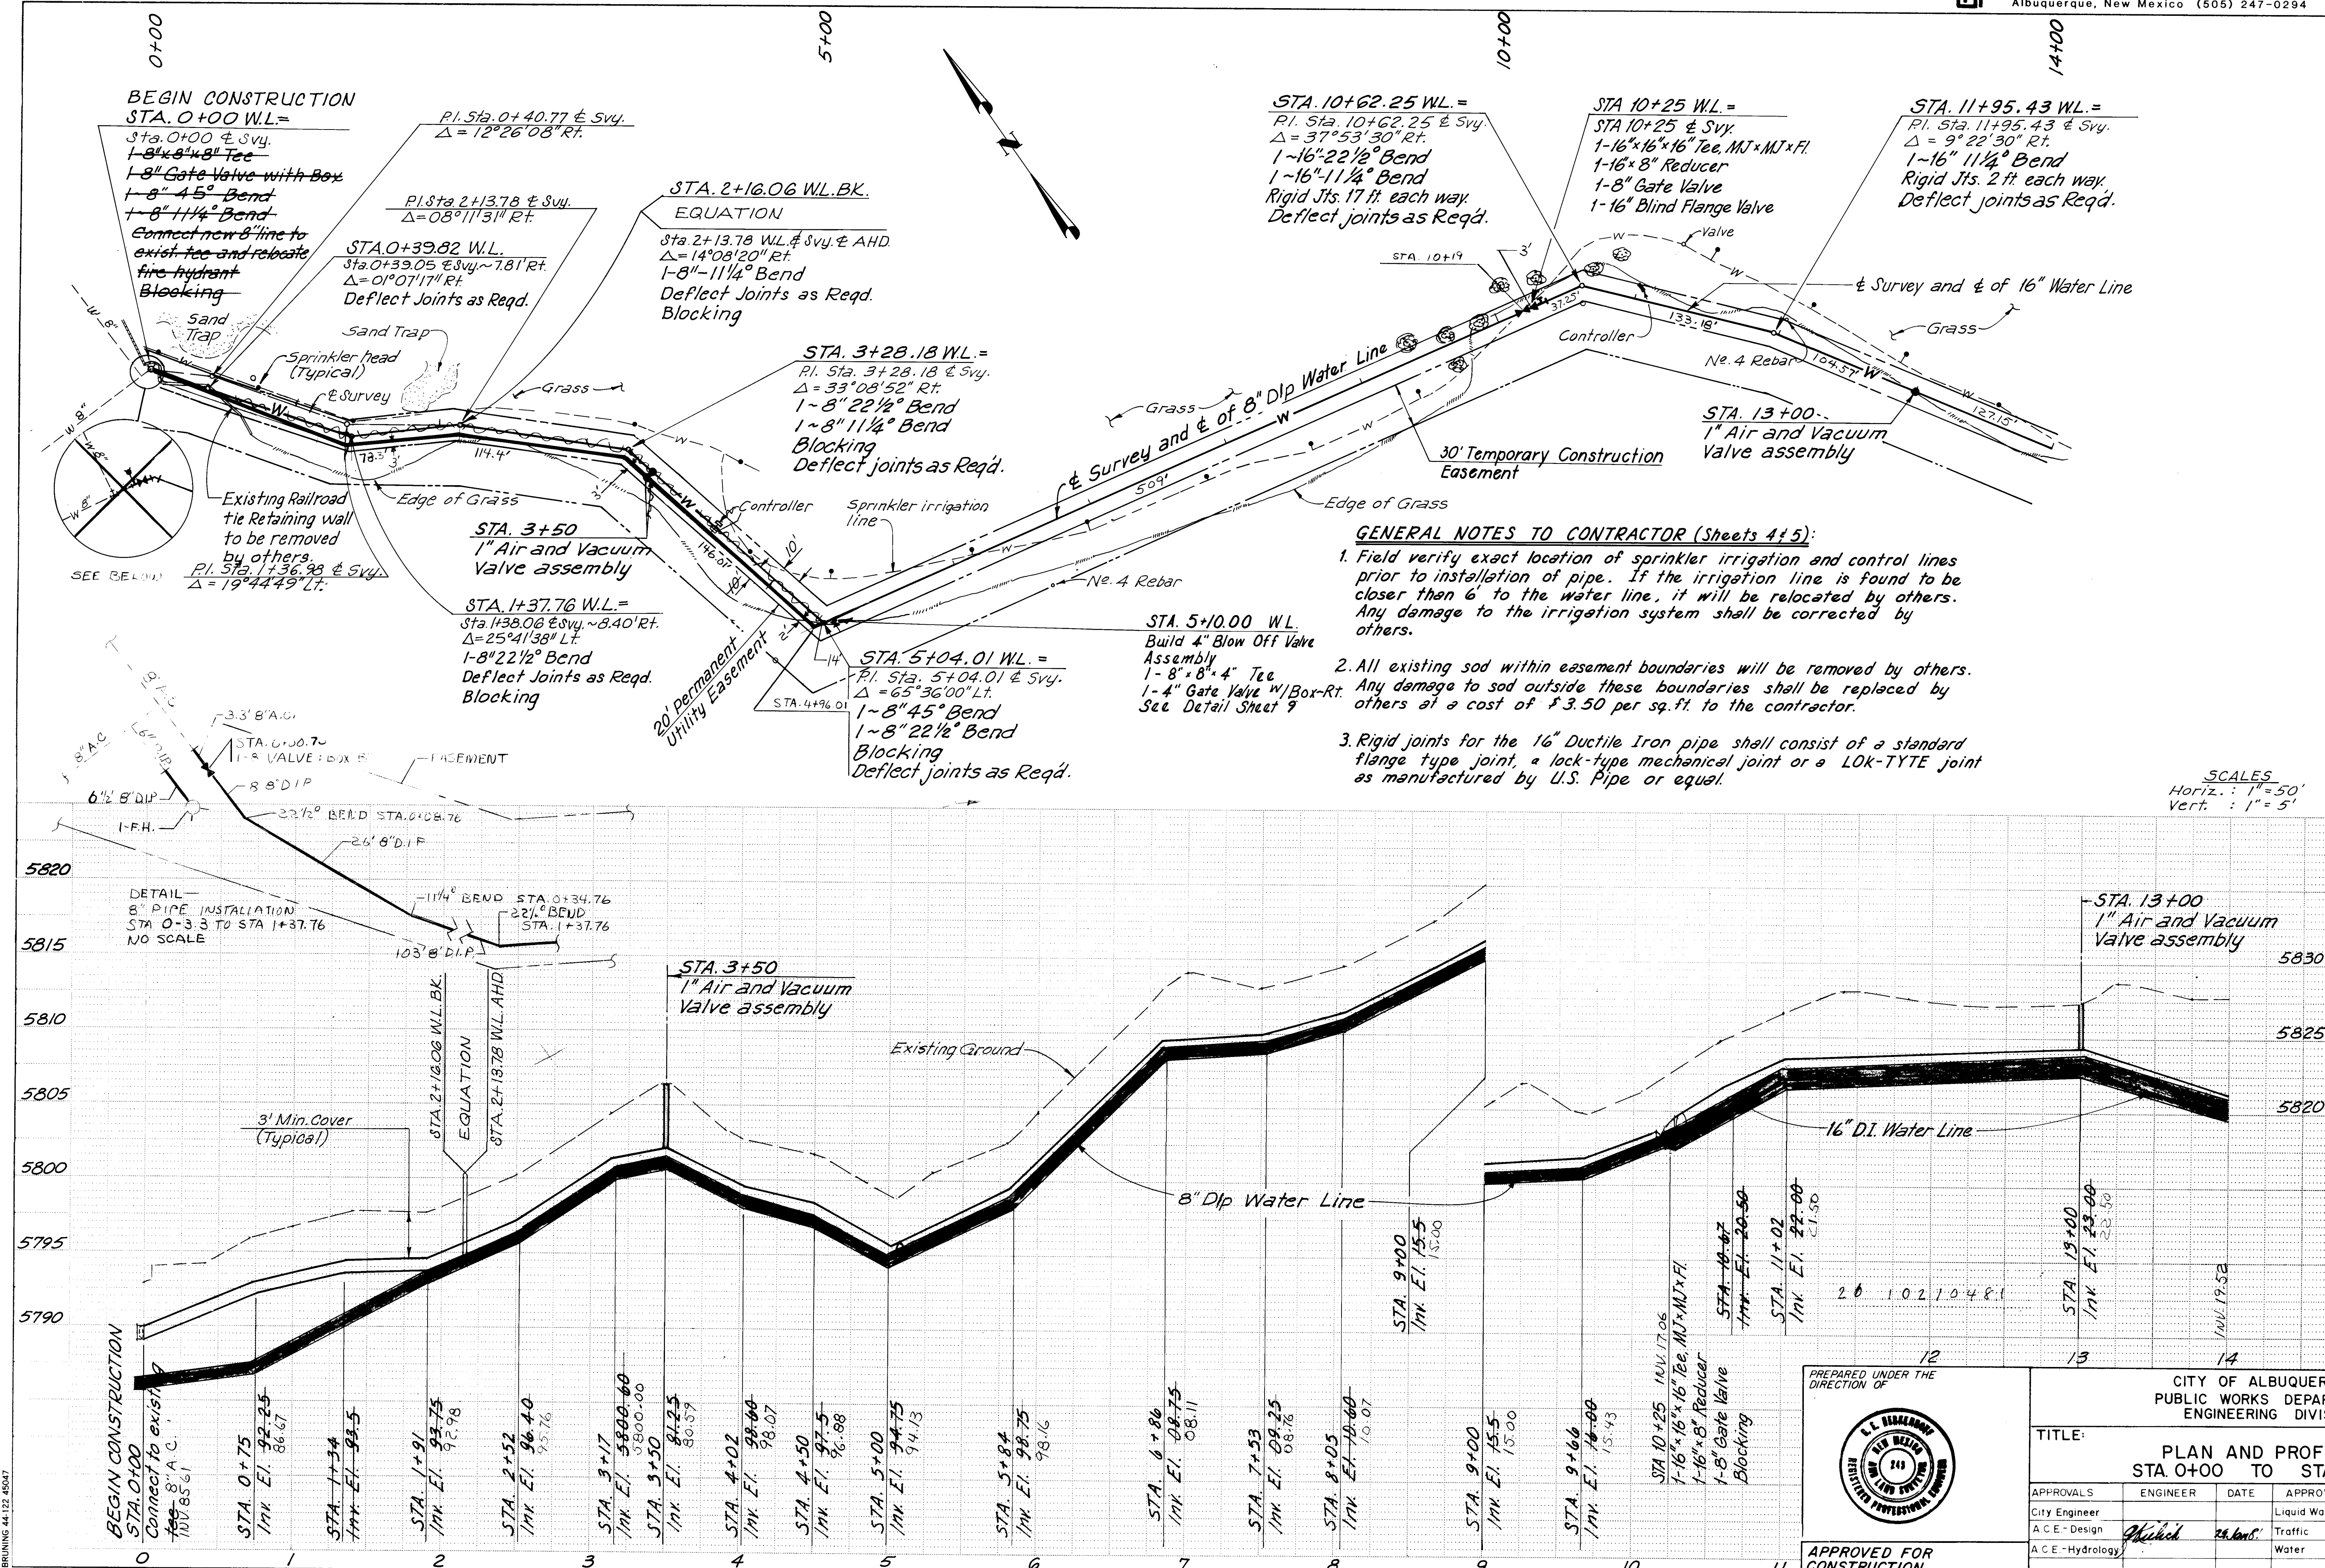

BRINING 44-122-45047

PROJECT NO. 1736.22


PREPARED UNDER THE DIRECTION OF

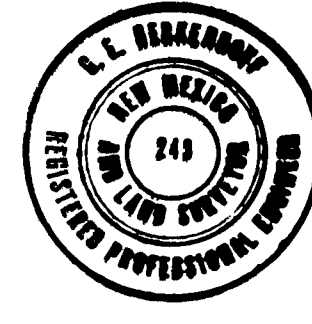

APPROVED FOR CONSTRUCTION



CITY ENGINEER \_\_\_\_\_ DATE \_\_\_\_\_

| CITY OF ALBUQUERQUE<br>PUBLIC WORKS DEPARTMENT<br>ENGINEERING DIVISION |          |        |              |               |
|------------------------------------------------------------------------|----------|--------|--------------|---------------|
| TITLE:<br>PLAN AND PROFILE<br>STA. 0+00 TO STA. 14+00                  |          |        |              |               |
| APPROVALS                                                              | ENGINEER | DATE   | APPROVALS    | ENGINEER      |
| City Engineer                                                          |          |        | Liquid Waste | N/A           |
| A.C.E. - Design                                                        | Michael  | 2/2/01 | Traffic      |               |
| A.C.E. - Hydrology                                                     |          |        | Water        | G. Herkenhoff |
| DRAWING NO. 1027                                                       |          |        | SHEET 4 OF 9 |               |

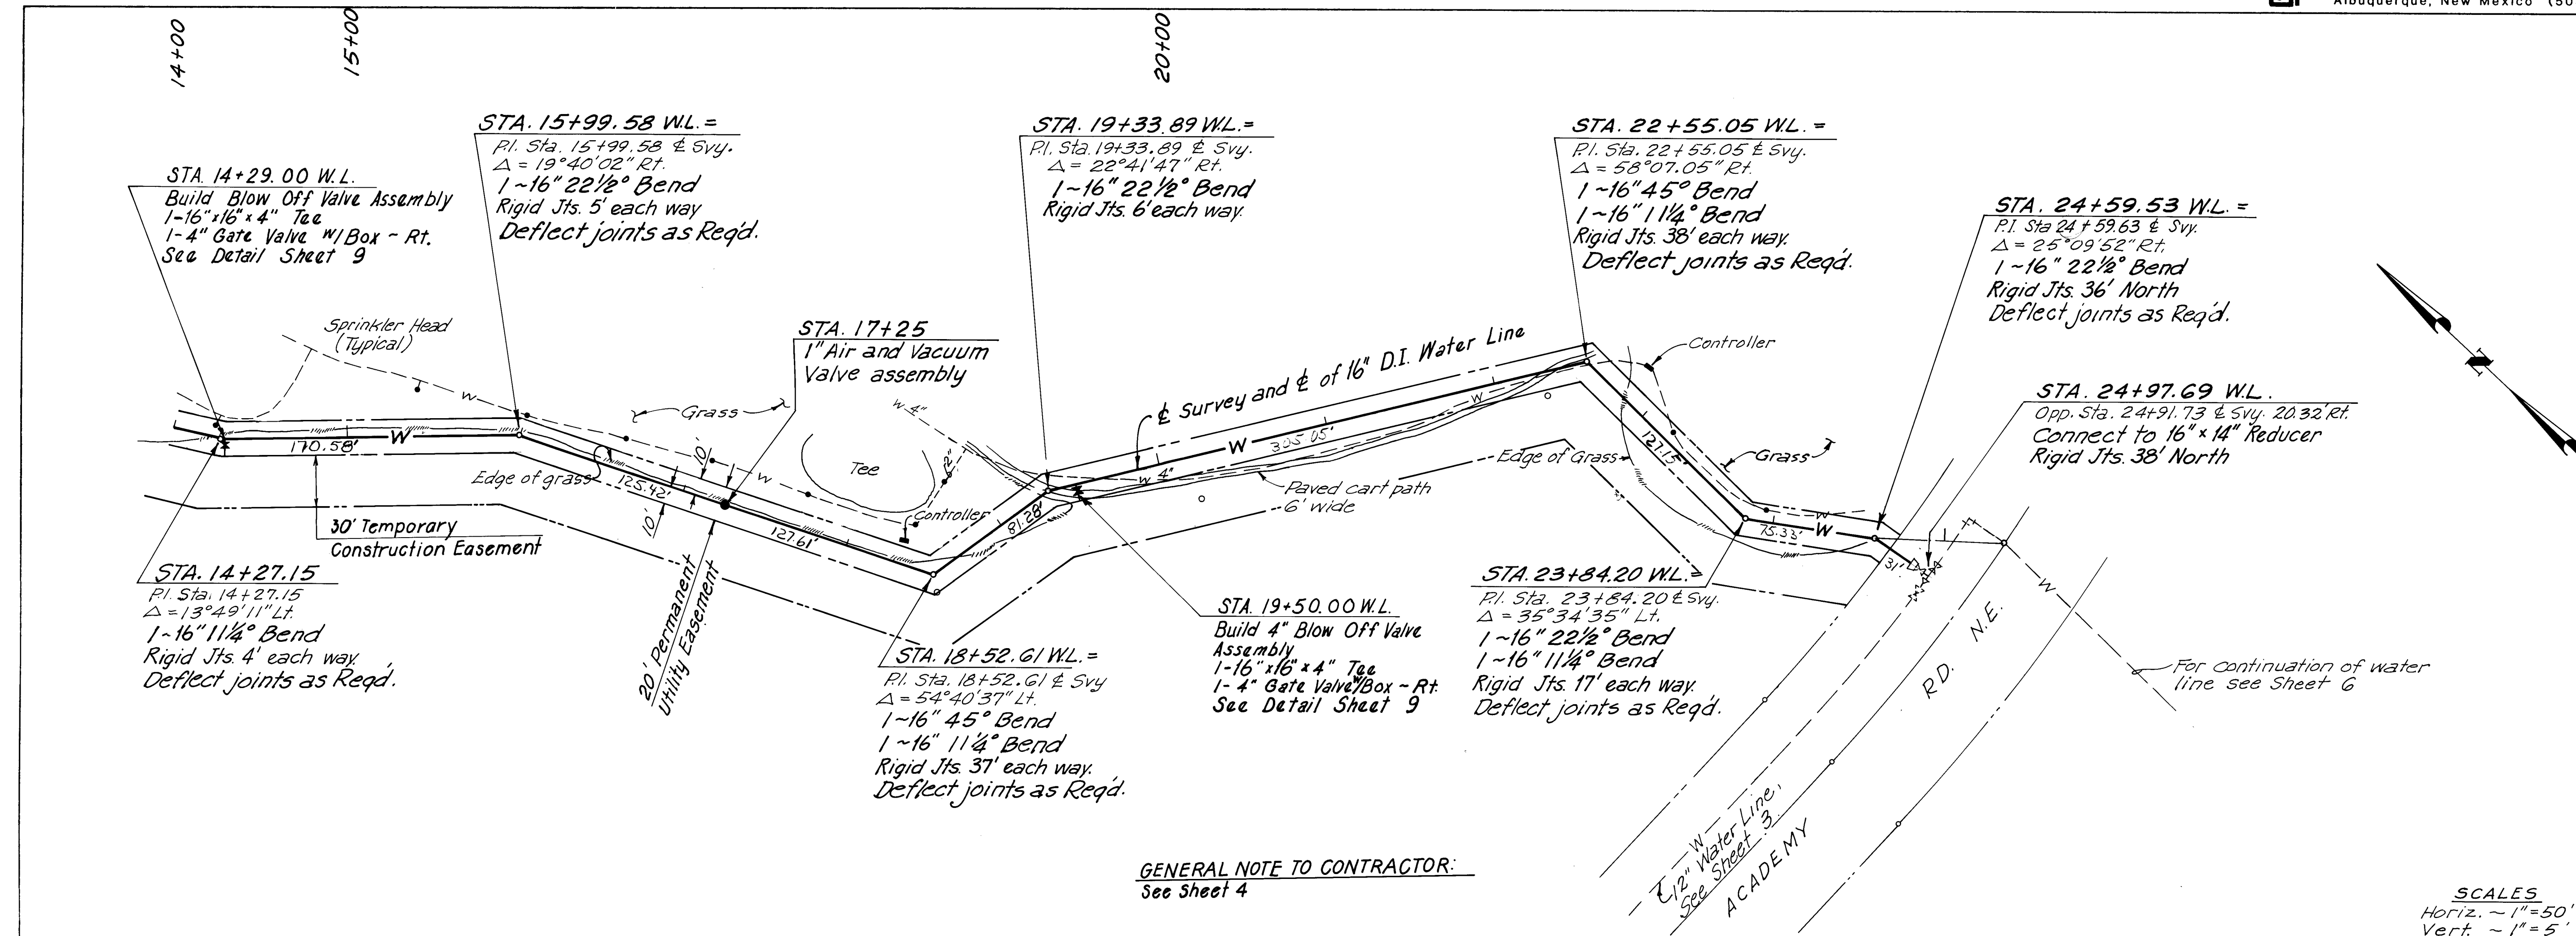

GENERAL NOTE TO CONTRACTOR:  
See Sheet 4



SCALES  
Horiz. ~ 1" = 50'  
Vert. ~ 1" = 5'


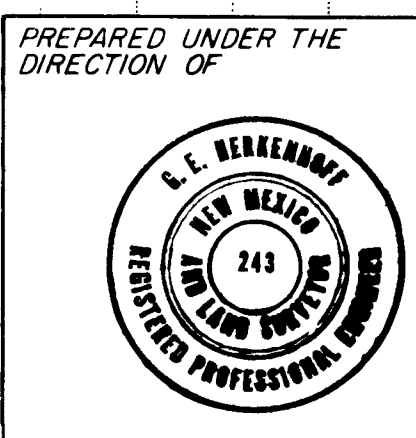
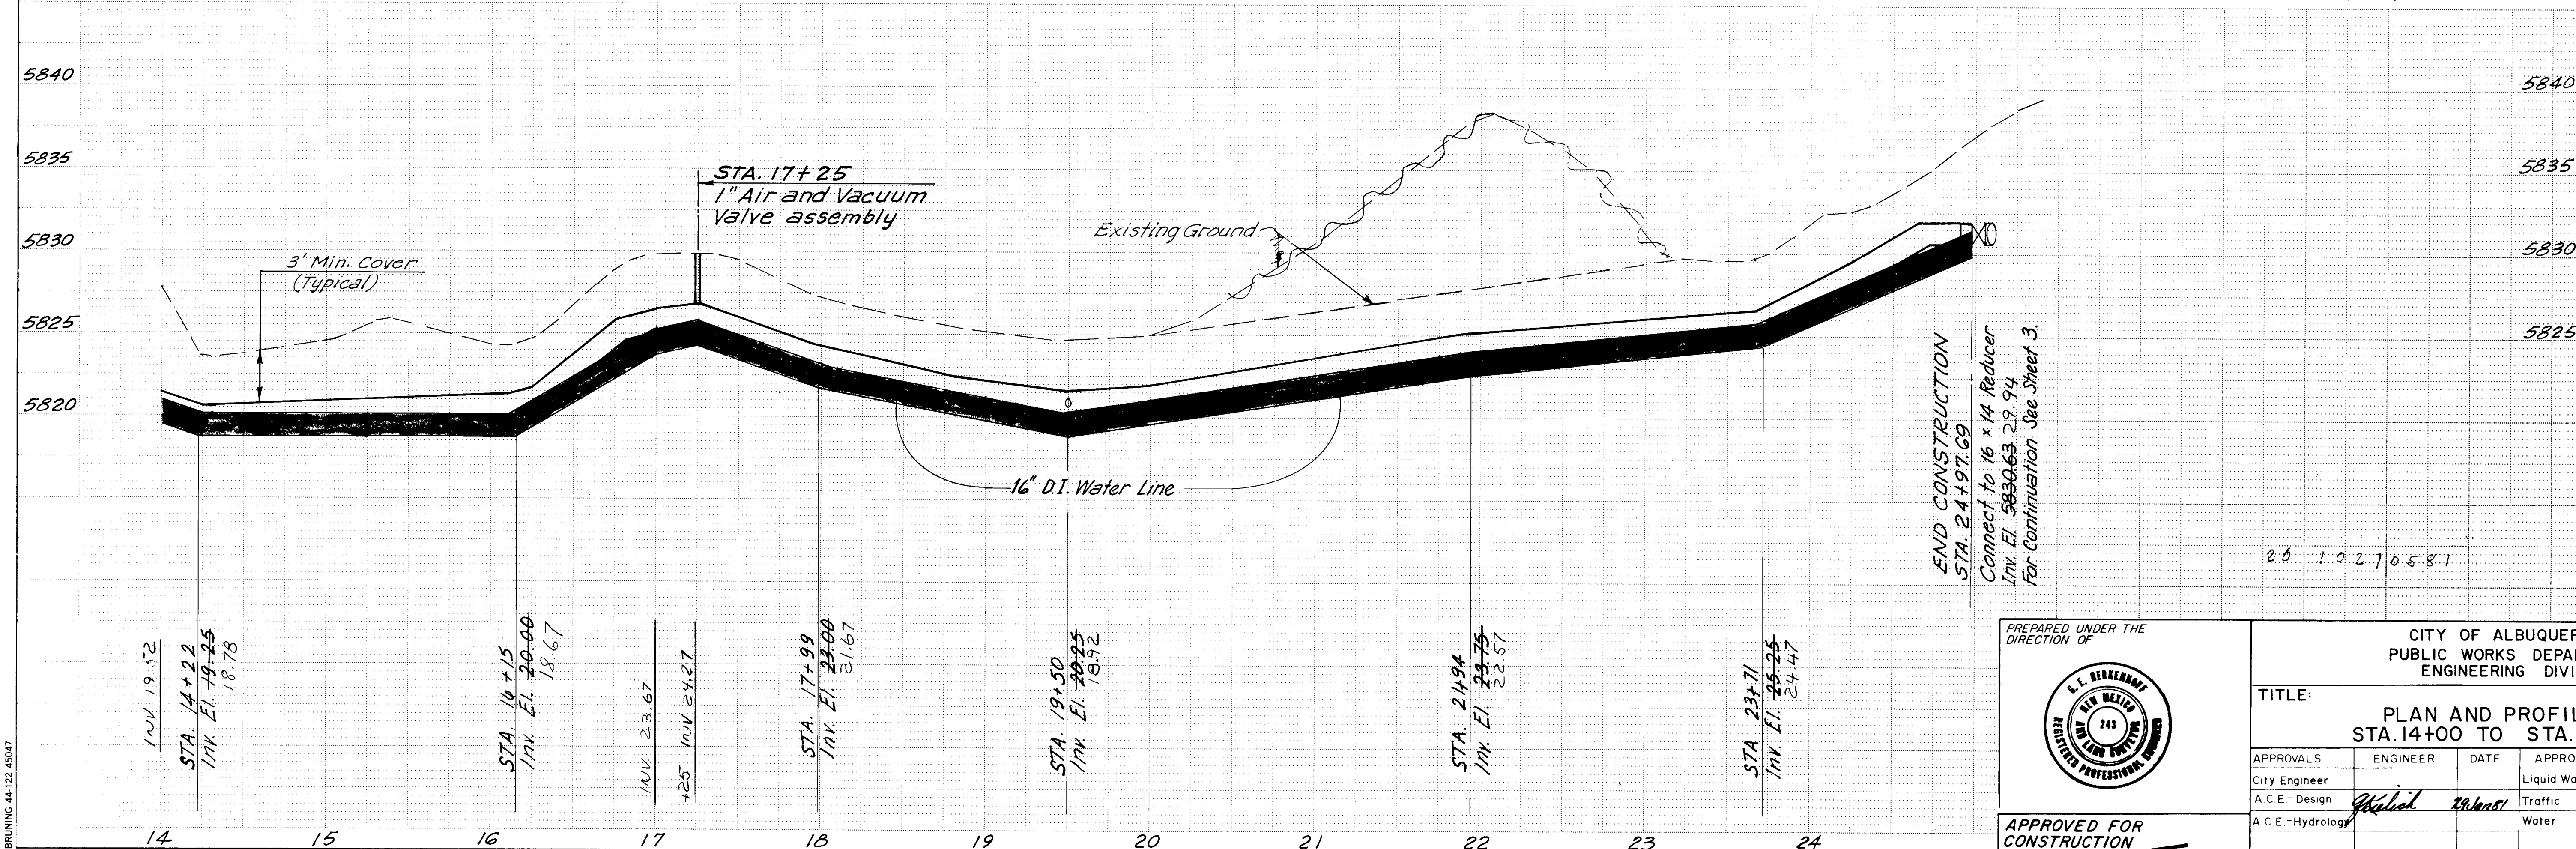


APPROVED FOR CONSTRUCTION  
CITY ENGINEER DATE

|                                                                        |          |      |              |          |      |
|------------------------------------------------------------------------|----------|------|--------------|----------|------|
| CITY OF ALBUQUERQUE<br>PUBLIC WORKS DEPARTMENT<br>ENGINEERING DIVISION |          |      |              |          |      |
| TITLE:<br>PLAN AND PROFILE<br>STA. 14+00 TO STA. 24+97.69              |          |      |              |          |      |
| APPROVALS                                                              | ENGINEER | DATE | APPROVALS    | ENGINEER | DATE |
| City Engineer                                                          |          |      | Liquid Waste | N/A      |      |
| A.C.E. - Design                                                        |          |      | Traffic      |          |      |
| A.C.E. - Hydrology                                                     |          |      | Water        |          |      |
| DRAWING NO. 1027                                                       |          |      | SHEET 5 OF 9 |          |      |




|  |    | REFERENCES |          | SURVEY INFORMATION |    | BENCH MARKS |                                                                                                                 | AS BUILT INFORMATION |  |
|--|----|------------|----------|--------------------|----|-------------|-----------------------------------------------------------------------------------------------------------------|----------------------|--|
|  |    | MAP NO.    | W.O. NO. | FIELD NOTES        |    |             |                                                                                                                 | CONTRACTOR           |  |
|  |    | EST. NO.   |          | NO.                | BY | DATE        | WORK<br>STARTED BY<br>INSPECTED BY<br>ACCEPTANCE BY<br>FIELD<br>VERIFICATION BY<br>DATE<br>CORRECTED BY<br>DATE |                      |  |
|  |    |            |          |                    |    |             |                                                                                                                 |                      |  |
|  |    |            |          |                    |    |             |                                                                                                                 |                      |  |
|  | </ |            |          |                    |    |             |                                                                                                                 |                      |  |

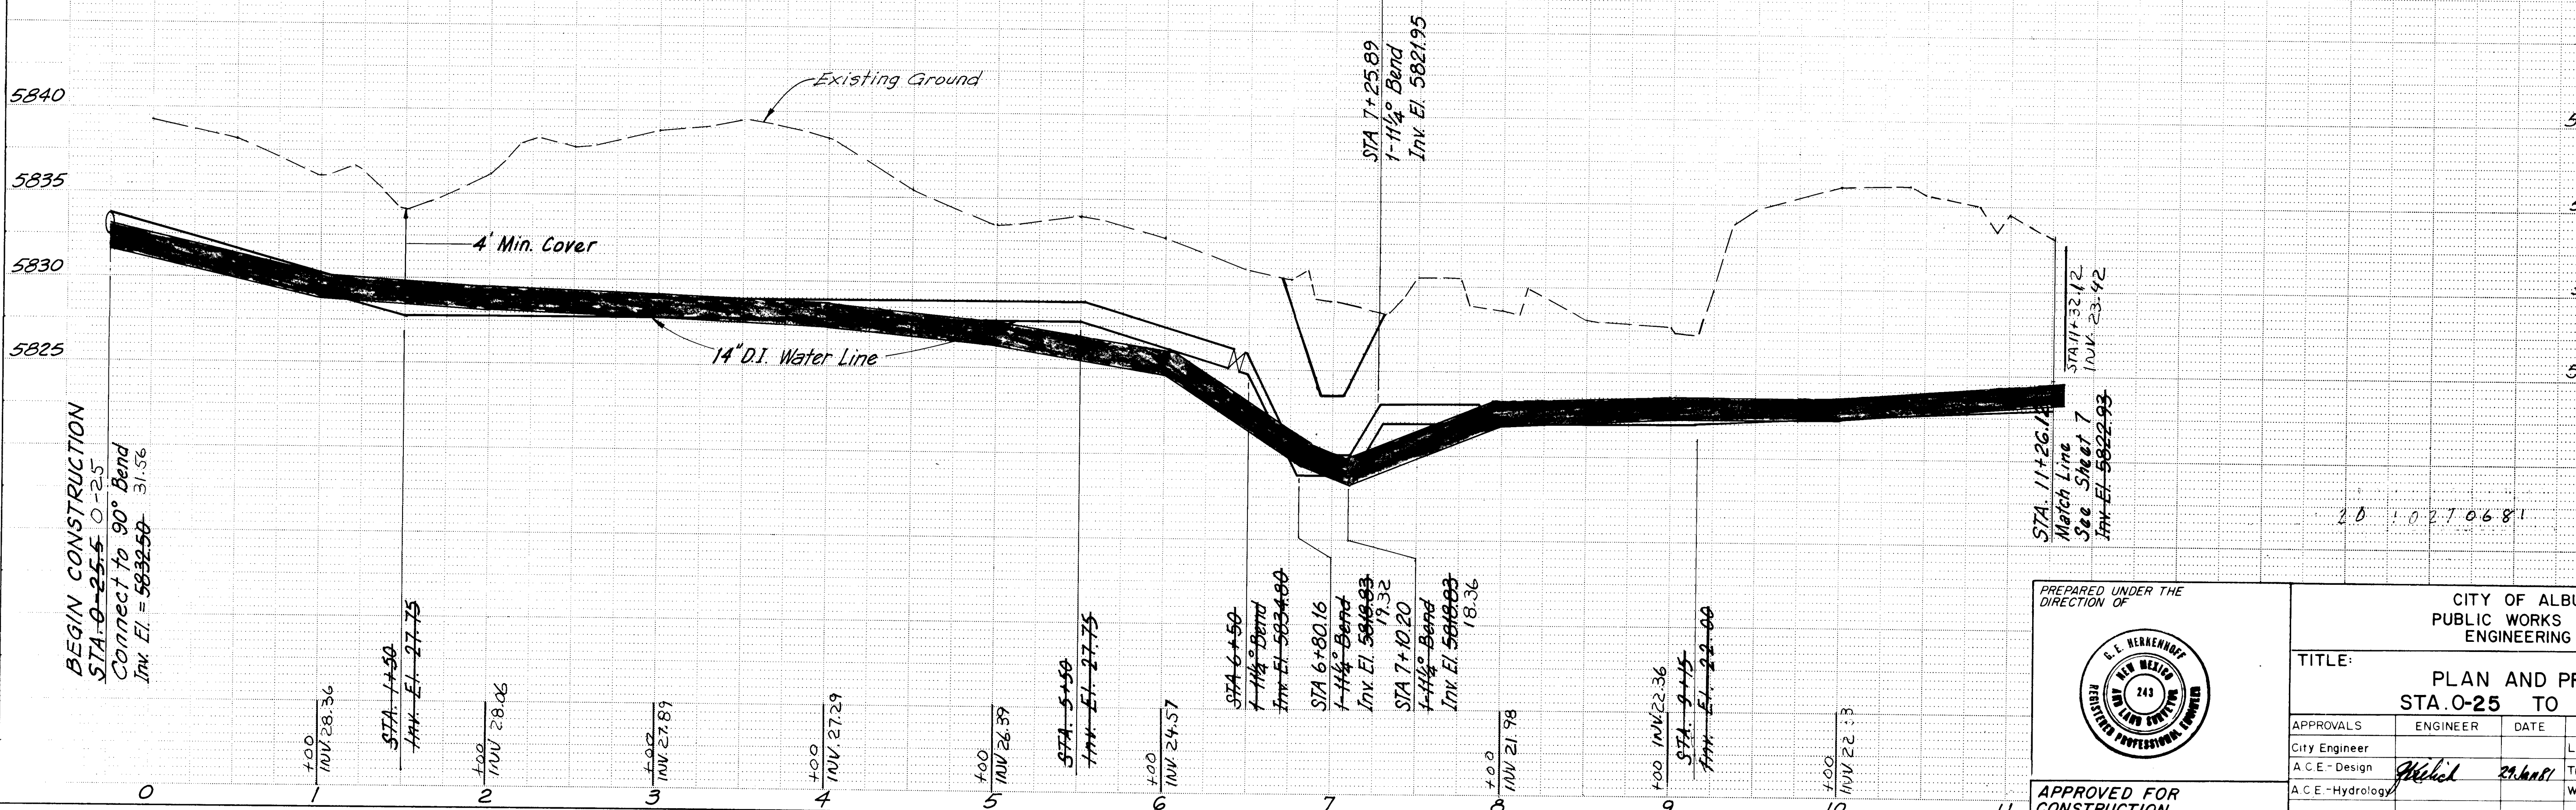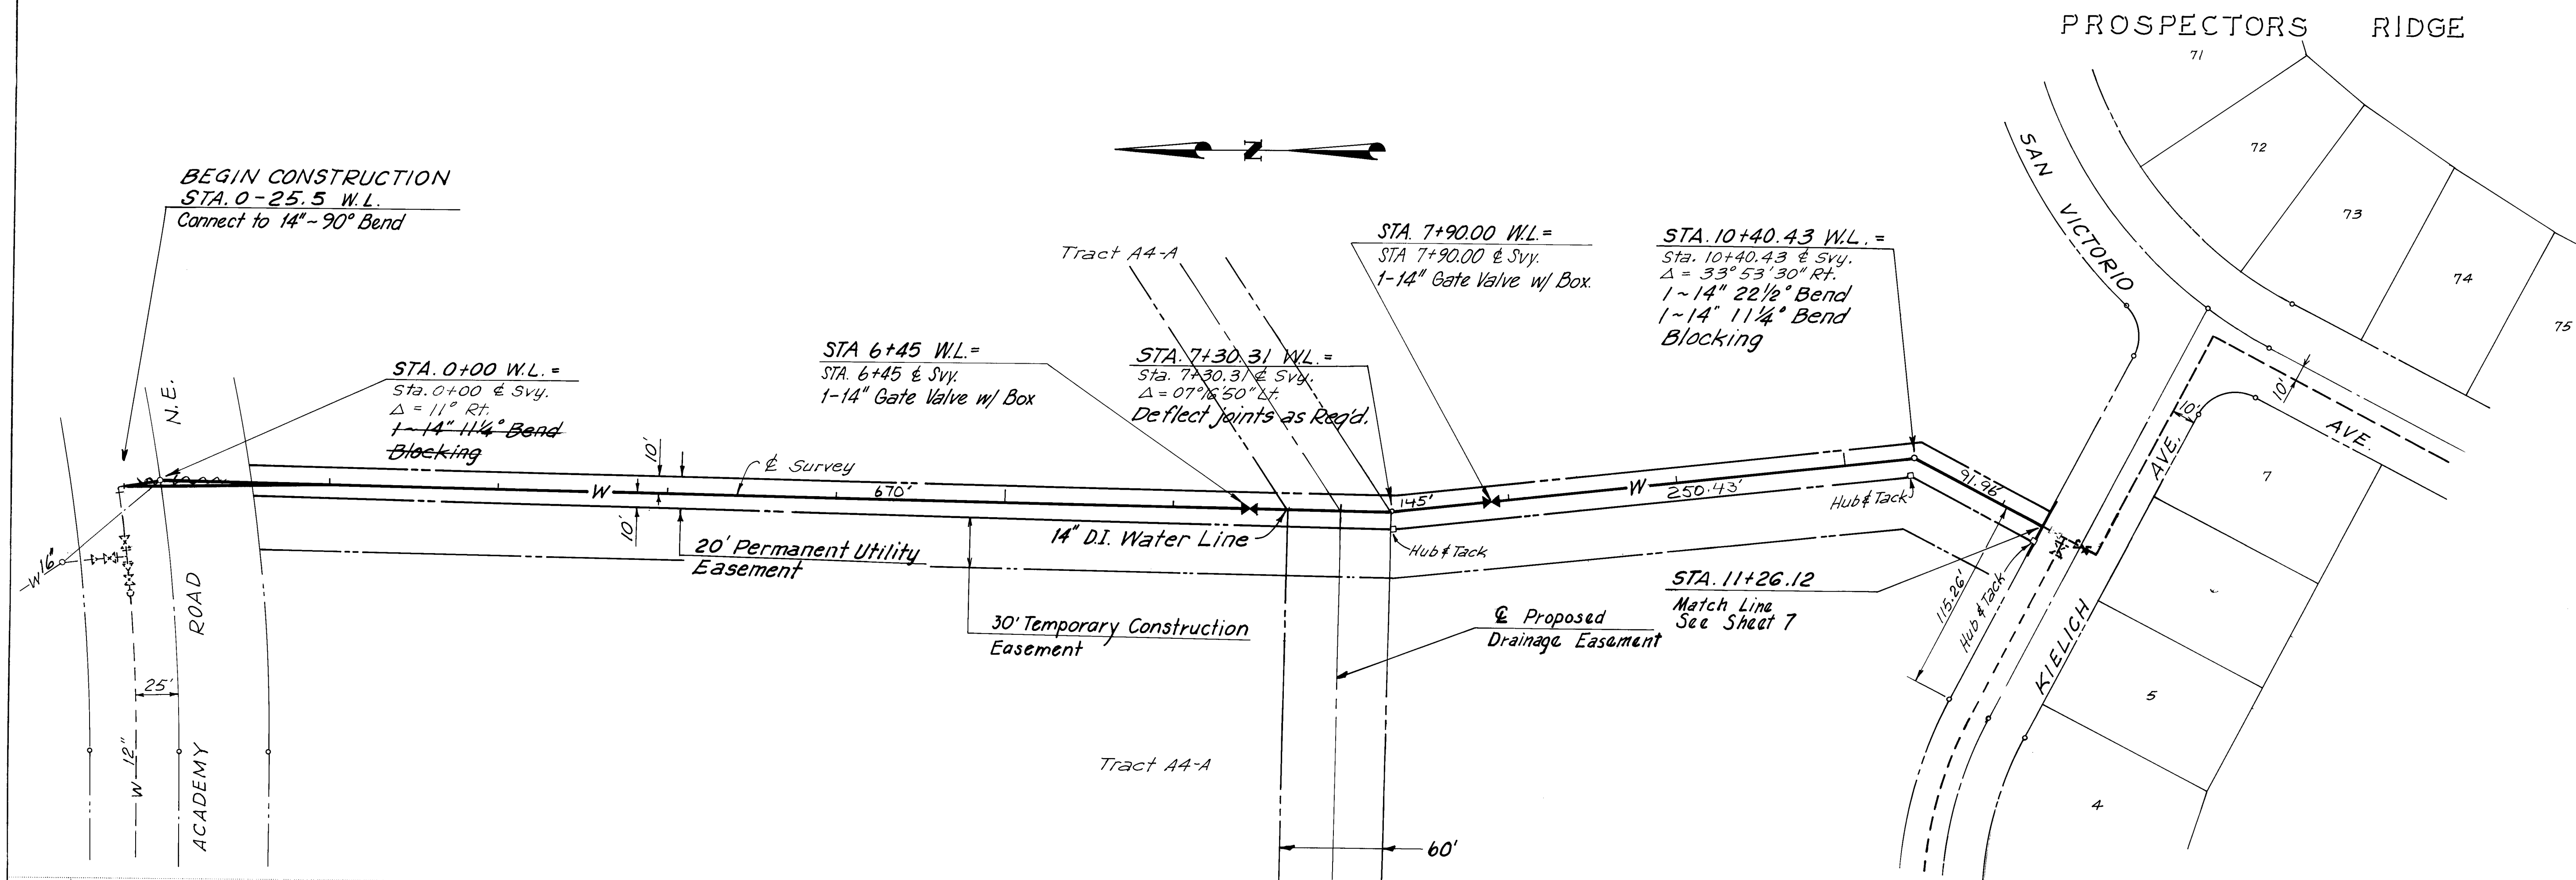[illegible]

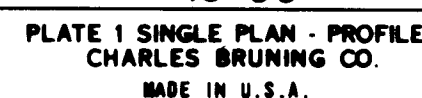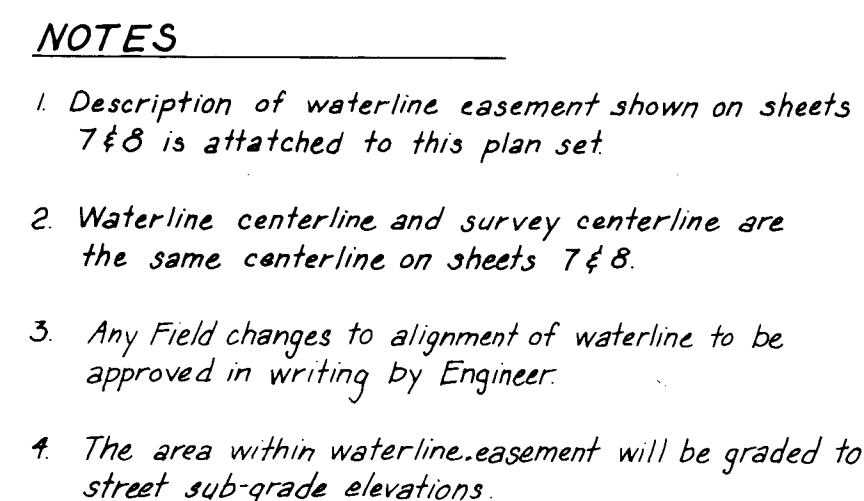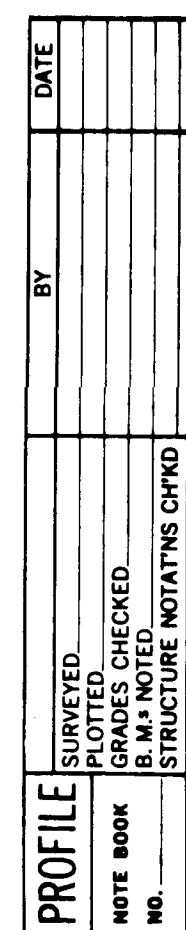


21+00  
SCALE:  
1" = 50' HOR  
1" = 5' VERT

| PREPARED UNDER THE<br>DIRECTION OF<br><br>                                                                                                                                                                                                                                                                                                    | <br><b>CITY OF ALBUQUERQUE</b><br><b>MUNICIPAL DEVELOPMENT DEPARTMENT</b><br><b>ENGINEERING DIVISION</b> |  |      |------------------------------------------------------------------------------------------------------------------------------------------------------------------------------------------------------------------------------------------------------------------------------------------------------------------------------------------------------------------------------------------------------------------------------------|-----------------------------------------------------------------------------------------------------------------------------------------------------------------------------------------------|---------------------------------------------------------------------------------------|------|---------------|--|--|---------------|--------------------|----------------|------------------|--|--|----------------------------------------------------------------------------------------------------------------------------------------------------------------------------------------------------------------------------------------------------------------------------------------------------------------------------------------------------------------------------------------------------------------------------|-----------|----------|------|--------------|------------|--|---------|--|--|-------|--------------------|----------------|--|
| <b>TITLE:</b> <span style="float: right; font-size: 1.2em;"><b>PLAN &amp; PROFILE</b></span><br><span style="float: right; font-size: 1.5em;"><b>STA. 11+26.12 TO STA. 20+30.96</b></span>                                                                                                                                                                                                                                         |                                                                                                                                                                                               |                                                                                       | <table border="1" style="width: 100%; border-collapse: collapse;"> <tr> <th style="text-align: center;">APPROVALS</th> <th style="text-align: center;">ENGINEER</th> <th style="text-align: center;">DATE</th> </tr> <tr> <td>City Engineer</td> <td></td> <td></td> </tr> <tr> <td>A.C.E.-Design</td> <td><i>[Signature]</i></td> <td><i>2/28/82</i></td> </tr> <tr> <td>A.C.E.-Hydrology</td> <td></td> <td></td> </tr> </table> | APPROVALS                                                                                                                                                                                     | ENGINEER                                                                              | DATE | City Engineer |  |  | A.C.E.-Design | <i>[Signature]</i> | <i>2/28/82</i> | A.C.E.-Hydrology |  |  | <table border="1" style="width: 100%; border-collapse: collapse;"> <tr> <th style="text-align: center;">APPROVALS</th> <th style="text-align: center;">ENGINEER</th> <th style="text-align: center;">DATE</th> </tr> <tr> <td>Liquid Waste</td> <td><i>N/A</i></td> <td></td> </tr> <tr> <td>Traffic</td> <td></td> <td></td> </tr> <tr> <td>Water</td> <td><i>[Signature]</i></td> <td><i>2/28/82</i></td> </tr> </table> | APPROVALS | ENGINEER | DATE | Liquid Waste | <i>N/A</i> |  | Traffic |  |  | Water | <i>[Signature]</i> | <i>2/28/82</i> |  |
| APPROVALS                                                                                                                                                                                                                                                                                                                                                                                                                          | ENGINEER                                                                                                                                                                                      | DATE                                                                                  |      |               | City Engineer                                                                                                                                                                                                                                                                                                                                                                                                                      |                                                                                                                                                                                               |                                                                                       | A.C.E.-Design                                                                                                                                                                                                                                                                                                                                                                                                                      | <i>[Signature]</i>                                                                                                                                                                            | <i>2/28/82</i>                                                                        |      |               | A.C.E.-Hydrology                                                                                                                                                                                                                                                                                                                                                                                                                   |                                                                                                                                                                                               |                                                                                       | APPROVALS                                                                                                                                                                                                                                                                                                                                                                                                                          | ENGINEER                                                                                                                                                                                      | DATE                                                                                  |      |               | Liquid Waste                                                                                                                                                                                                                                                                                                                                                                                                                       | <i>N/A</i>                                                                                                                                                                                    |                                                                                       |      | Traffic                                                                                                                                                                                                                                                                                                                                                                                                                            |                                                                                                                                                                                               |                                                                                       | Water                                                                                                                                                                                                                                                                                                                                                                                                                              | <i>[Signature]</i>                                                                                                                                                                            | <i>2/28/82</i>                                                                        |      |               | <b>APPROVED FOR CONSTRUCTION</b><br><i>[Signature]</i>                                                                                                                                                                                                                                                                                                                                                                             |                                                                                                                                                                                               |                                                                                       | <b>CITY ENGINEER</b>                                                                                                                                                                                                                                                                                                                                                                                                               | <b>DATE</b>                                                                                                                                                                                   | <b>DRAWING NO.</b> <span style="font-size: 1.2em;">1027</span>                        |      |               |                                                                                                                                                                                                                                                                                                                                                                                                                                    |                                                                                                                                                                                               | <b>SHEET 7 OF 9</b>                                                                   |      |               
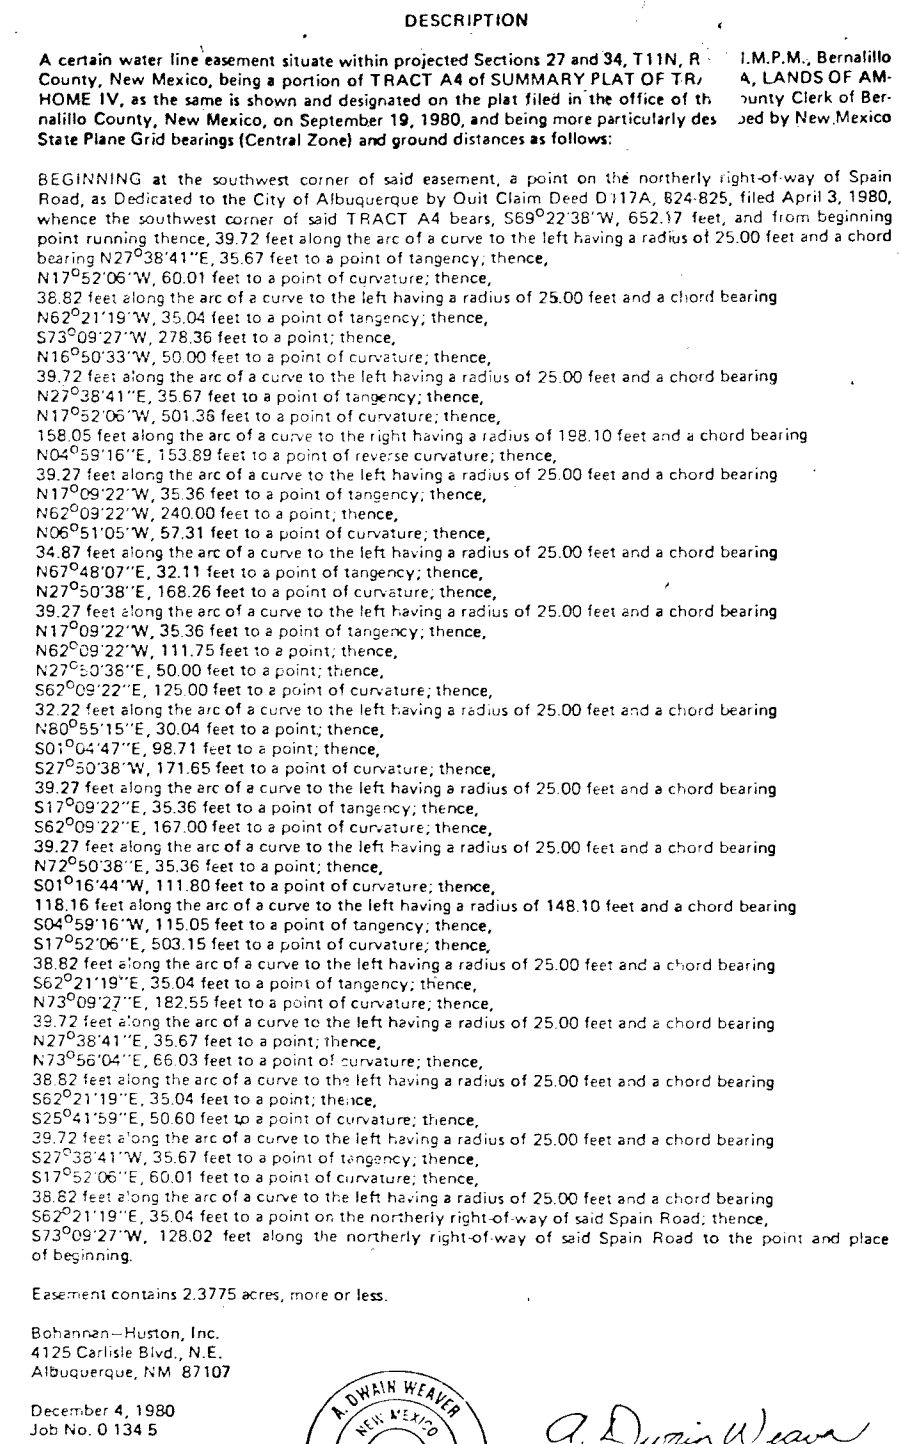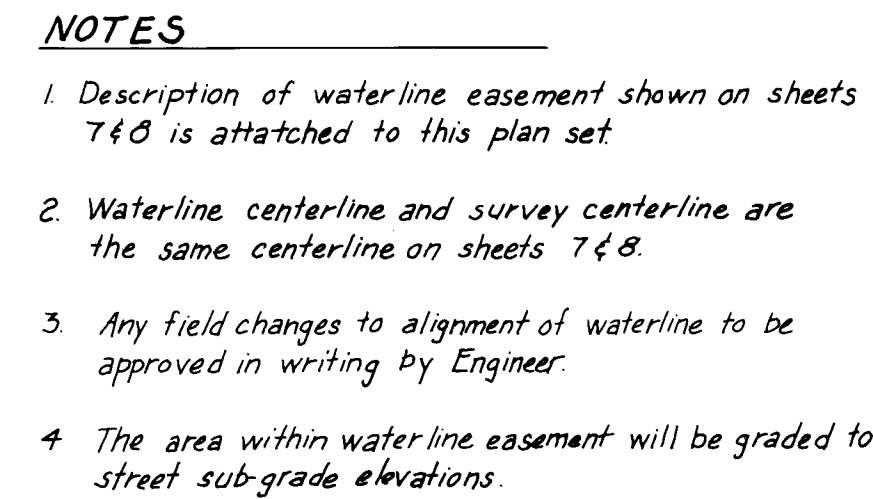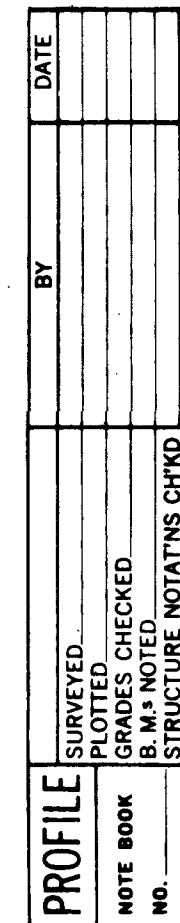

|                                                                                       |  |---------------------------------------------------------------------------------------|--|--|--|--|--|--|--|--|--|---------------------------------------------------------------------------------------------------------------------------------------------------------------------------------------------------------------------------------------------------------|--|--|--|--|--|--|--|--|--|---------------------------------------------------------------------------------------------------------------------------------------------------------------------|--|--|--|--|--|--|--|--|--|
| QUERQUE<br>NENT DEPARTMENT<br>DIVISION                                                |  |  |  |  |  |  |  |  |  | BENCH MARKS<br>STATION IS LOCATED 475' EAST FROM EXT.<br>OF CENTERLINE ON NOREN DR. AND 26 SO.<br>OF CENTERLINE ON SPAIN RD. STATION<br>IS A STANDARD A.S.C. BRASS CAP SET IN<br>CONCRETE. FLUSH WITH GROUND AND<br>STAMPED "BD-3", ELEVATION '5722.27. |  |  |  |  |  |  |  |  |  | AS-BUILT INFORMATION<br>CONTRACTOR<br>WORK<br>STAINED BY<br>INSPECTOR'S<br>FIELD<br>VERIFICATION BY<br>CORRECTED BY<br>MICRO-FILM INFORMATION<br>RECORDED BY<br>NO. |  |  |  |  |  |  |  |  |  |
| REFERENCES                                                                            |  |  |  |  |  |  |  |  |  | SURVEY INFORMATION                                                                                                                                                                                                                                      |  |  |  |  |  |  |  |  |  |                                                                                                                                                                     |  |  |  |  |  |  |  |  |  |
| MAP NO. E-22                                                                          |  |  |  |  |  |  |  |  |  | NO.                                                                                                                                                                                                                                                     |  |  |  |  |  |  |  |  |  | DATE                                                                                                                                                                |  |  |  |  |  |  |  |  |  |
| EST. NO.                                                                              |  |  |  |  |  |  |  |  |  | W.O. NO.                                                                                                                                                                                                                                                |  |  |  |  |  |  |  |  |  | BY                                                                                                                                                                  |  |  |  |  |  |  |  |  |  |
| NO. DATE                                                                              |  |  |  |  |  |  |  |  |  | REMARKS                                                                                                                                                                                                                                                 |  |  |  |  |  |  |  |  |  | BY                                                                                                                                                                  |  |  |  |  |  |  |  |  |  |
| DESIGN                                                                                |  |  |  |  |  |  |  |  |  | DESIGNED BY RGB                                                                                                                                                                                                                                         |  |  |  |  |  |  |  |  |  | DATE NOV. 1980                                                                                                                                                      |  |  |  |  |  |  |  |  |  |
| DRAWN BY JNH                                                                          |  |  |  |  |  |  |  |  |  | DATE DEC. 1980                                                                                                                                                                                                                                          |  |  |  |  |  |  |  |  |  | CHECKED BY RGB                                                                                                                                                      |  |  |  |  |  |  |  |  |  |
| DATE DEC. 1980                                                                        |  |  |  |  |  |  |  |  |  | DATE DEC. 1980                                                                                                                                                                                                                                          |  |  |  |  |  |  |  |  |  | DATE DEC. 1980                                                                                                                                                      |  |  |  |  |  |  |  |  |  |
|  |  | PROFILE                                                                               |  |  | STA. 30+08.63                                                                         |  |  | APPROVALS                                                                             |  |  |  |  |  |  |  |  |  | ENGINEER                                                                                                                                                                                                                                                |  |  |  |  |  |  |  |  |  | DATE                                                                                                                                                                |  |  |  |  |  |  |  |  |  |
| Chief Engineer                                                                        |  |  |  |  |  |  |  |  |  | N/A                                                                                                                                                                                                                                                     |  |  |  |  |  |  |  |  |  |                                                                                                                                                                     |  |  |  |  |  |  |  |  |  |
| Inspector                                                                             |  |  |  |  |  |  |  |  |  | D. Mendenhall                                                                                                                                                                                                                                           |  |  |  |  |  |  |  |  |  | J. Mendenhall                                                                                                                                                       |  |  |  |  |  |  |  |  |  |
| SHEET                                                                                 |  |  |  |  |  |  |  |  |  | 8                                                                                                                                                                                                                                                       |  |  |  |  |  |  |  |  |  | 9                                                                                                                                                                   |  |  |  |  |  |  |  |  |  |

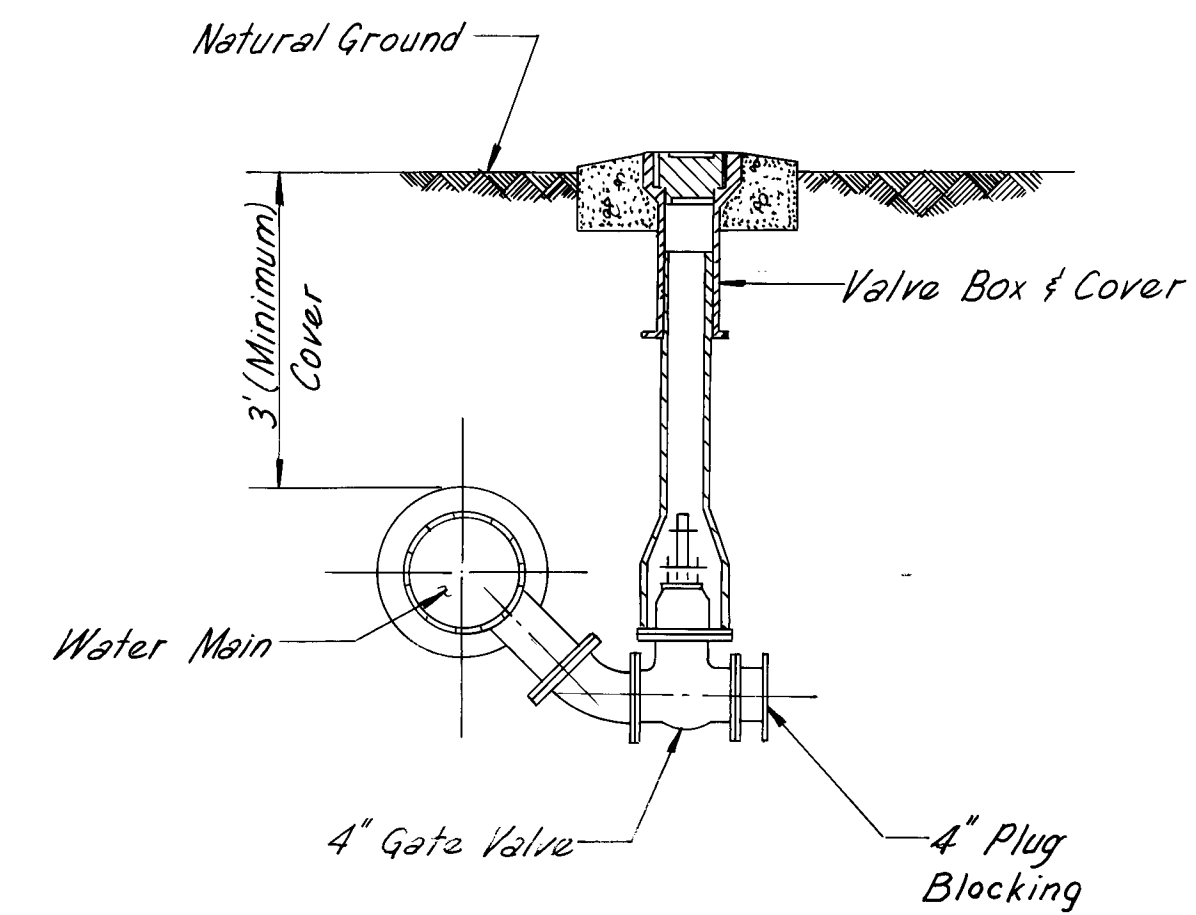

NOTE TO CONTRACTOR:  
Coordinate all construction with City Water Resources Dept., Tanoan Country Club, and City Engineer (Field).  
Schedule water shut-offs a minimum of two weeks prior to making connections to golf course water lines.  
All water valves within the golf course will be operated only by Tanoan Golf Course personnel.

[illegible]

|                                                                                                                                  |                                                                                                                   |                            |          |                                    |              |                            |          |      |
|----------------------------------------------------------------------------------------------------------------------------------|-------------------------------------------------------------------------------------------------------------------|----------------------------|----------|------------------------------------|--------------|----------------------------|----------|------|
| <p>PREPARED UNDER THE<br/>DIRECTION OF</p>  | <p>CITY OF ALBUQUERQUE<br/>PUBLIC WORKS DEPARTMENT<br/>ENGINEERING DIVISION</p>                                   |                            |          |                                    |              |                            |          |      |
|                                                                                                                                  | <p><b>TITLE:</b></p> <p style="font-size: 1.2em;">TANOAN COUNTRY CLUB WATER LINE<br/>CONNECTION MODIFICATIONS</p> |                            |          |                                    |              |                            |          |      |
|                                                                                                                                  | APPROVALS                                                                                                         |                            | ENGINEER | DATE                               | APPROVALS    |                            | ENGINEER | DATE |
|                                                                                                                                  | City Engineer                                                                                                     |                            |          |                                    | Liquid Waste |                            | N/A      |      |
| A.C.E. - Design                                                                                                                  |                                                                                                                   | <i>Handwritten: 2/2/08</i> |          | Traffic                            |              |                            |          |      |
| A.C.E. - Hydrology                                                                                                               |                                                                                                                   |                            |          | Water                              |              | <i>Handwritten: 1/2/08</i> |          |      |
|                                                                                                                                  |                                                                                                                   |                            |          |                                    |              |                            |          |      |
| <p><b>APPROVED FOR<br/>CONSTRUCTION</b></p>                                                                                      |                                                                                                                   |                            |          | <p><b>DRAWING<br/>NO. 1027</b></p> |              |                            |          |      |
| CITY ENGINEER _____ DATE _____                                                                                                   |                                                                                                                   |                            |          | SHEET 9 OF 9                       |              |                            |          |      |