

MERCHANTS, INCORPORATED

**HANOVER STREET, NW.
IMPROVEMENTS**

MARCH 6, 1981

ANDREWS, ASBURY & ROBERT, INC.
CONSULTING ENGINEERS
ALBUQUERQUE NEW MEXICO



NOTICE TO CONTRACTORS

1. NEW MEXICO STANDARD SPECIFICATIONS FOR PUBLIC WORKS CONSTRUCTION-1979 EDITION WILL BE REFERRED TO HEREON AS THE "STANDARD SPECIFICATION".
2. ALL WORK DETAILED ON THESE PLANS TO BE PERFORMED UNDER CONTRACT SHALL, EXCEPT AS OTHERWISE STATED OR PROVIDED FOR HEREON, BE CONSTRUCTED IN ACCORDANCE WITH "CONTRACT DOCUMENTS FOR CITY-WIDE UTILITIES AND CASH PAVING NO. 29 AND THE STANDARD SPECIFICATION".
3. TWO WORKING DAYS PRIOR TO ANY EXCAVATION, CONTRACTOR MUST CONTACT LINE LOCATING SERVICE, 765-1234, FOR LOCATION OF EXISTING UTILITIES.
4. PRIOR TO CONSTRUCTION, THE CONTRACTOR SHALL EXCAVATE AND VERIFY THE HORIZONTAL AND VERTICAL LOCATIONS OF ALL OBSTRUCTIONS. SHOULD A CONFLICT EXIST, THE CONTRACTOR SHALL NOTIFY THE ENGINEER OR SURVEYOR SO THAT THE CONFLICT CAN BE RESOLVED WITH A MINIMUM AMOUNT OF DELAY.
5. ALL UTILITIES AND UTILITY SERVICE LINES SHALL BE INSTALLED PRIOR TO PAVING.
6. BACKFILL COMPACTION SHALL BE ACCORDING TO SPECIFIED STREET USE.
7. IF CURB IS DEPRESSED FOR A DRIVEPAD, THE DRIVEPAD SHALL BE CONSTRUCTED PRIOR TO ACCEPTANCE OF CURB AND GUTTER.
8. ALL STORM DRAINAGE FACILITIES SHALL BE COMPLETED PRIOR TO FINAL ACCEPTANCE.
9. THE REQUESTOR OR DEVELOPER SHALL BE RESPONSIBLE FOR REPAIR OR REPLACEMENT OF ALL CURB AND GUTTER OR SIDEWALK DAMAGED AFTER APPROVAL BY THE CITY ENGINEER OF WORK COMPLETED BY THE CONTRACTOR.

INDEX

DESCRIPTION	SHEET No.
TITLE SHEET & LOCATION MAP	1
PAVING & STORM SEWER PLAN & PROFILE - HANOVER STREET NW	2
WATER & SANITARY SEWER PLAN & PROFILE - HANOVER STREET NW	3

1 2 3 4 5 6 7 8 9 10
214 10470186

ENGR'S FILE NO. 80-246A

SET NO.


APPROVED FOR
CONSTRUCTION
CITY ENGINEER
DATE 4/2/81

DRAWING
NO.

1047

SHEET OF
1 3

RECORD DRAWING

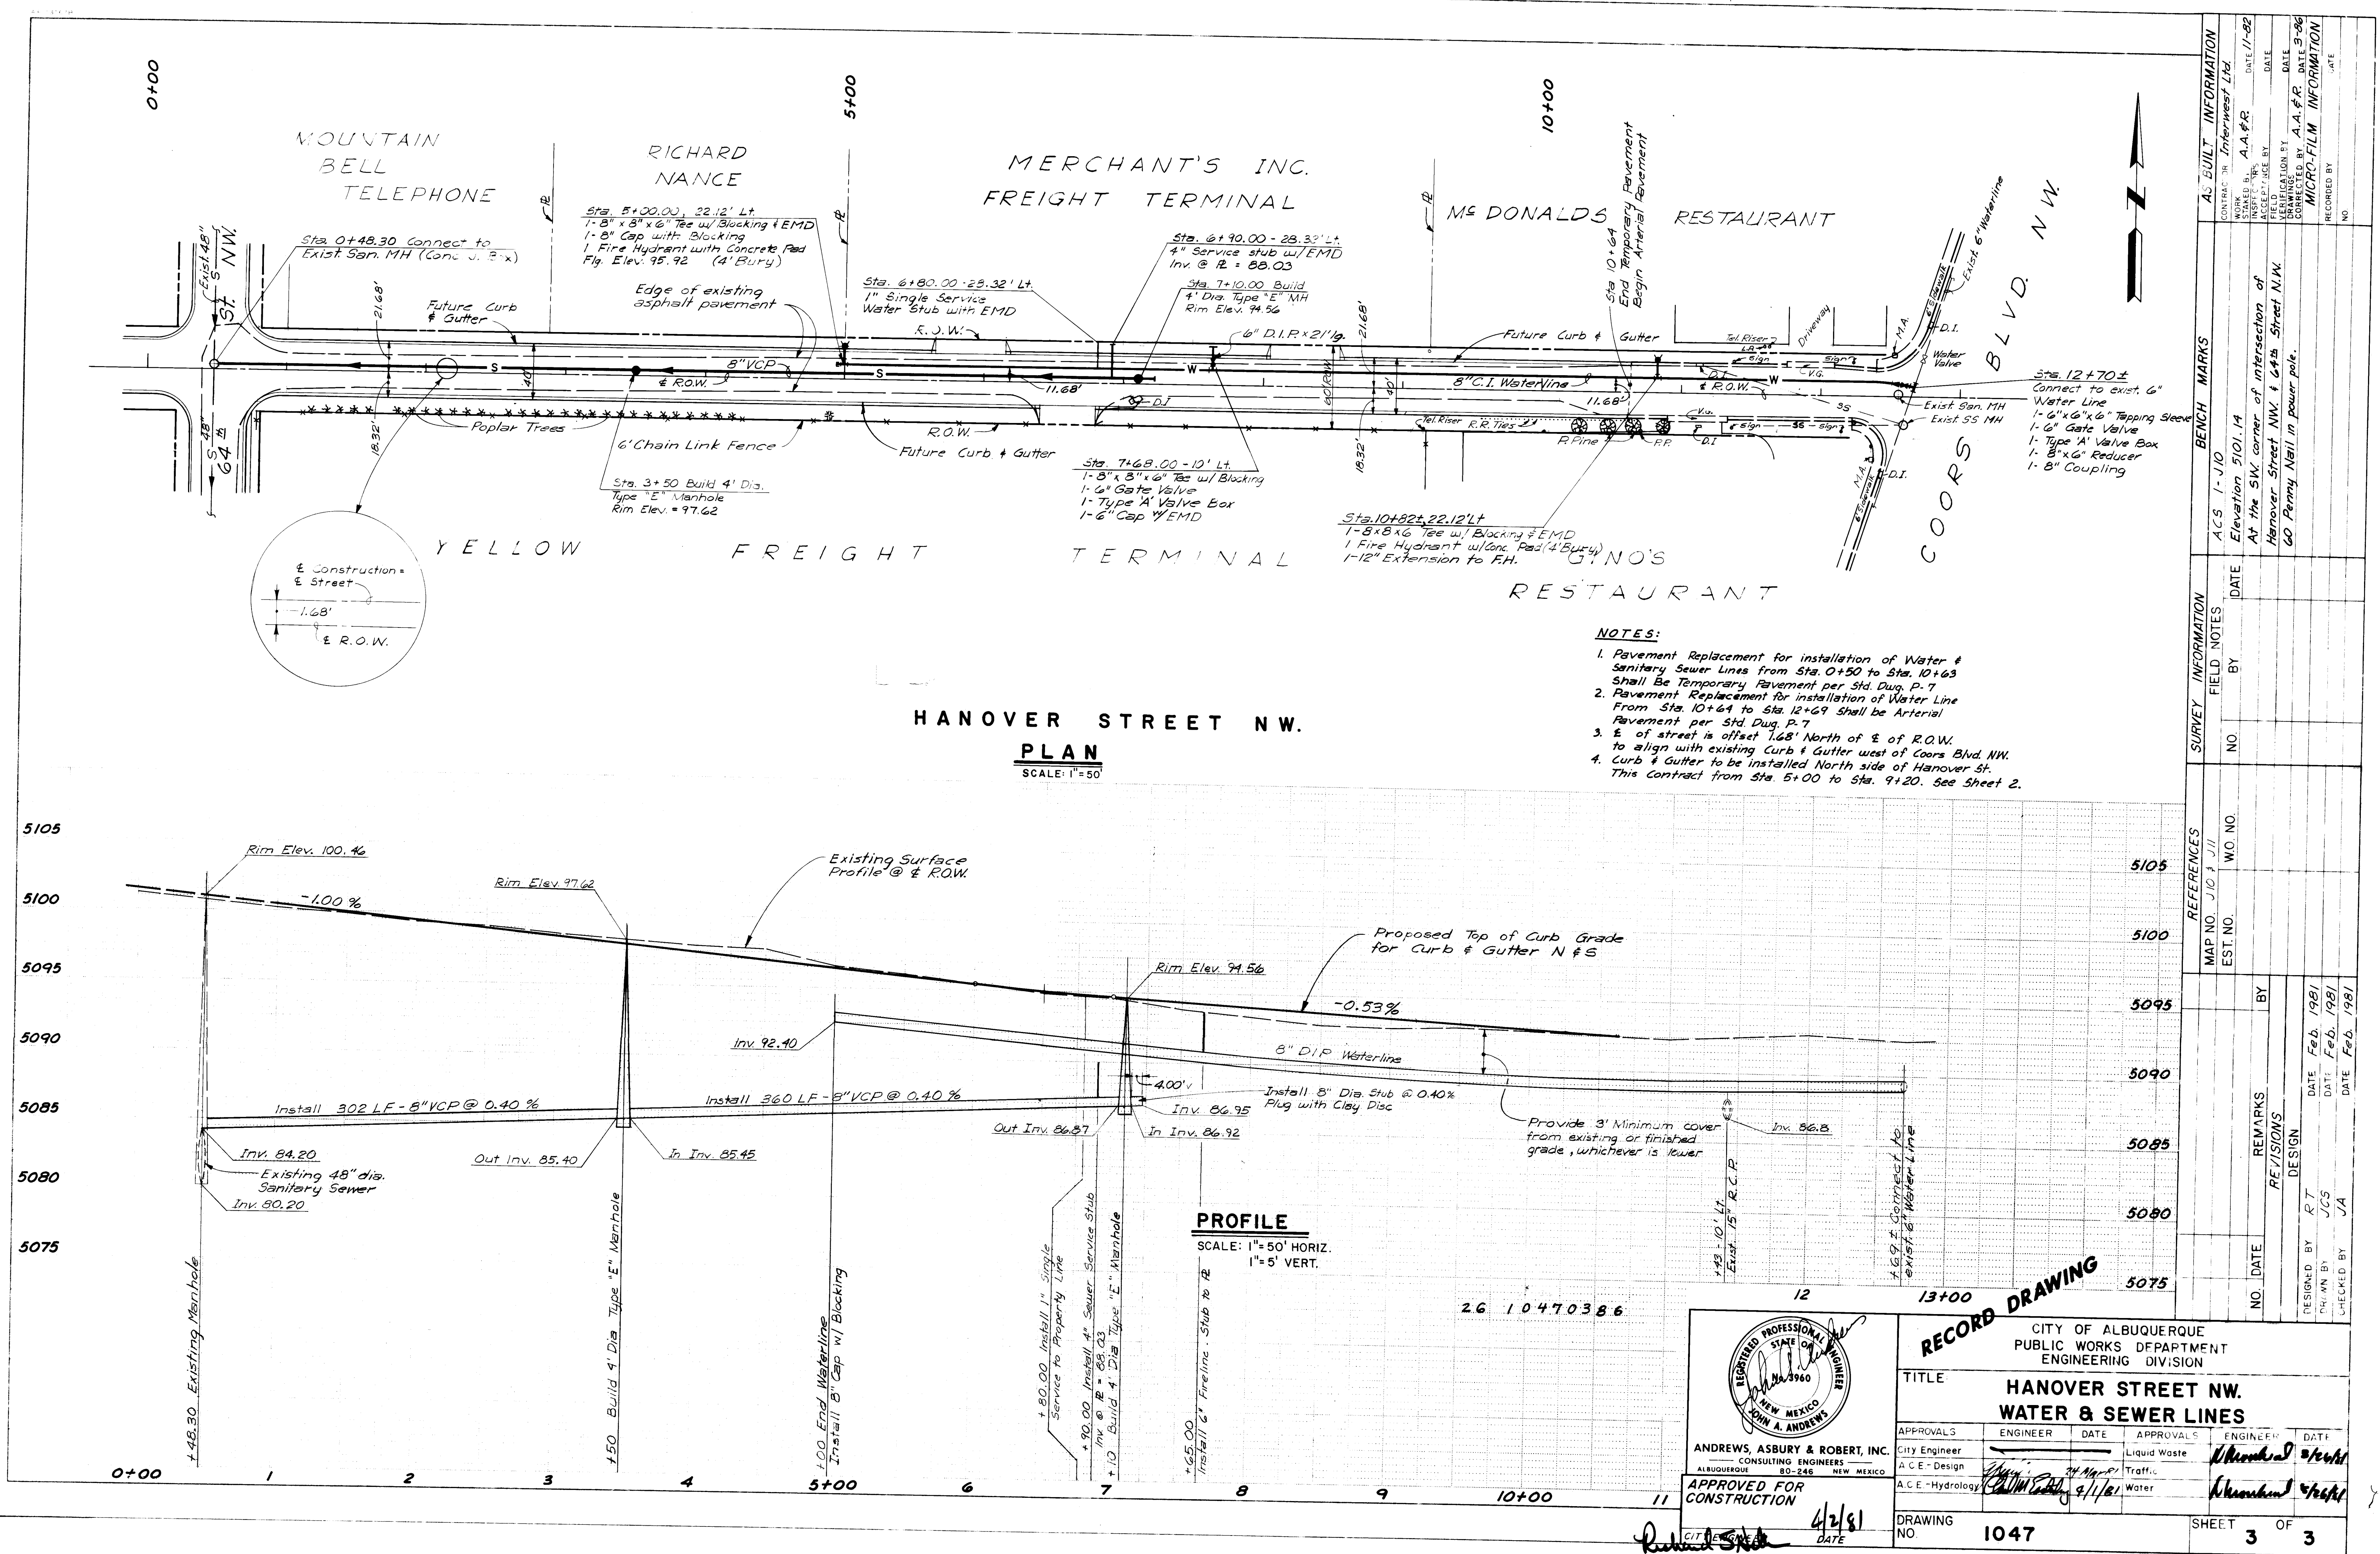

HANOVER STREET NW.


PLAN
SCALE: 1"=50'

PROFILE

SCALE: 1"=50' HORIZ.
1"=5' VERT.

NOTES:

- 1. Pavement Replacement for installation of Water & Sanitary Sewer Lines from Sta. 0+50 to Sta. 10+63 Shall Be Temporary Pavement per Std. Dwg. P. 7
- 2. Pavement Replacement for installation of Water Line From Sta. 10+64 to Sta. 12+69 Shall be Arterial Pavement per Std. Dwg. P. 7
- 3. E of street is offset 1.68' North of E of R.O.W. to align with existing Curb & Gutter west of Coors Blvd. NW.
- 4. Curb & Gutter to be installed North side of Hanover St. This Contract from Sta. 5+00 to Sta. 9+20. See Sheet 2.

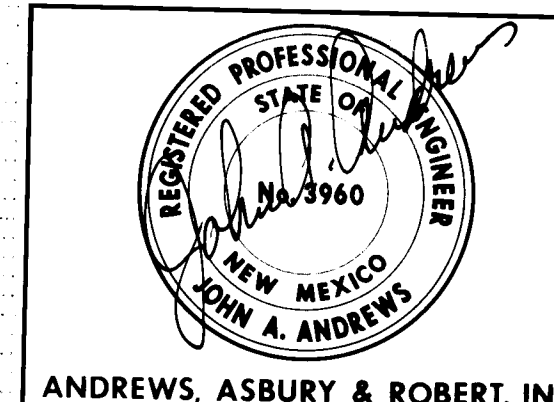

ANDREWS, ASBURY & ROBERT, INC.
CONSULTING ENGINEERS
ALBUQUERQUE 80-245 NEW MEXICO

APPROVED FOR CONSTRUCTION
DATE 4/2/81

RECORD DRAWING


CITY OF ALBUQUERQUE
PUBLIC WORKS DEPARTMENT
ENGINEERING DIVISION

TITLE: HANOVER STREET NW. WATER & SEWER LINES

APPROVALS	ENGINEER	DATE	APPROVALS	ENGINEER	DATE
City Engineer			Liquid Waste	Andrew A. Andrews	4/2/81
A.C.E. - Design			Traffic		
A.C.E. - Hydrology			Water	Andrew A. Andrews	4/2/81

DRAWING NO. 1047 SHEET 3 OF 3

SURVEY INFORMATION		BENCH MARKS		AS BUILT INFORMATION	
FIELD NOTES	DATE	AC 1-1-10	Elevation 5101.14	CONTRACT NO.	Interwest Ltd.
NO	NO			DATE	11-82
MAP NO. J10 & J11	EST. NO.	W.O. NO.		INSPECTED BY	A.A.A.R.
				DATE	
REMARKS	BY	DATE		VERIFICATION BY	
DESIGN	R.T.	Feb. 1981		DATE	
CHECKED BY	J.A.	Feb. 1981		COMPILED BY	A.A.A.R.
				DATE	
				MICRO-FILM INFORMATION	
				RECORDED BY	
				DATE	

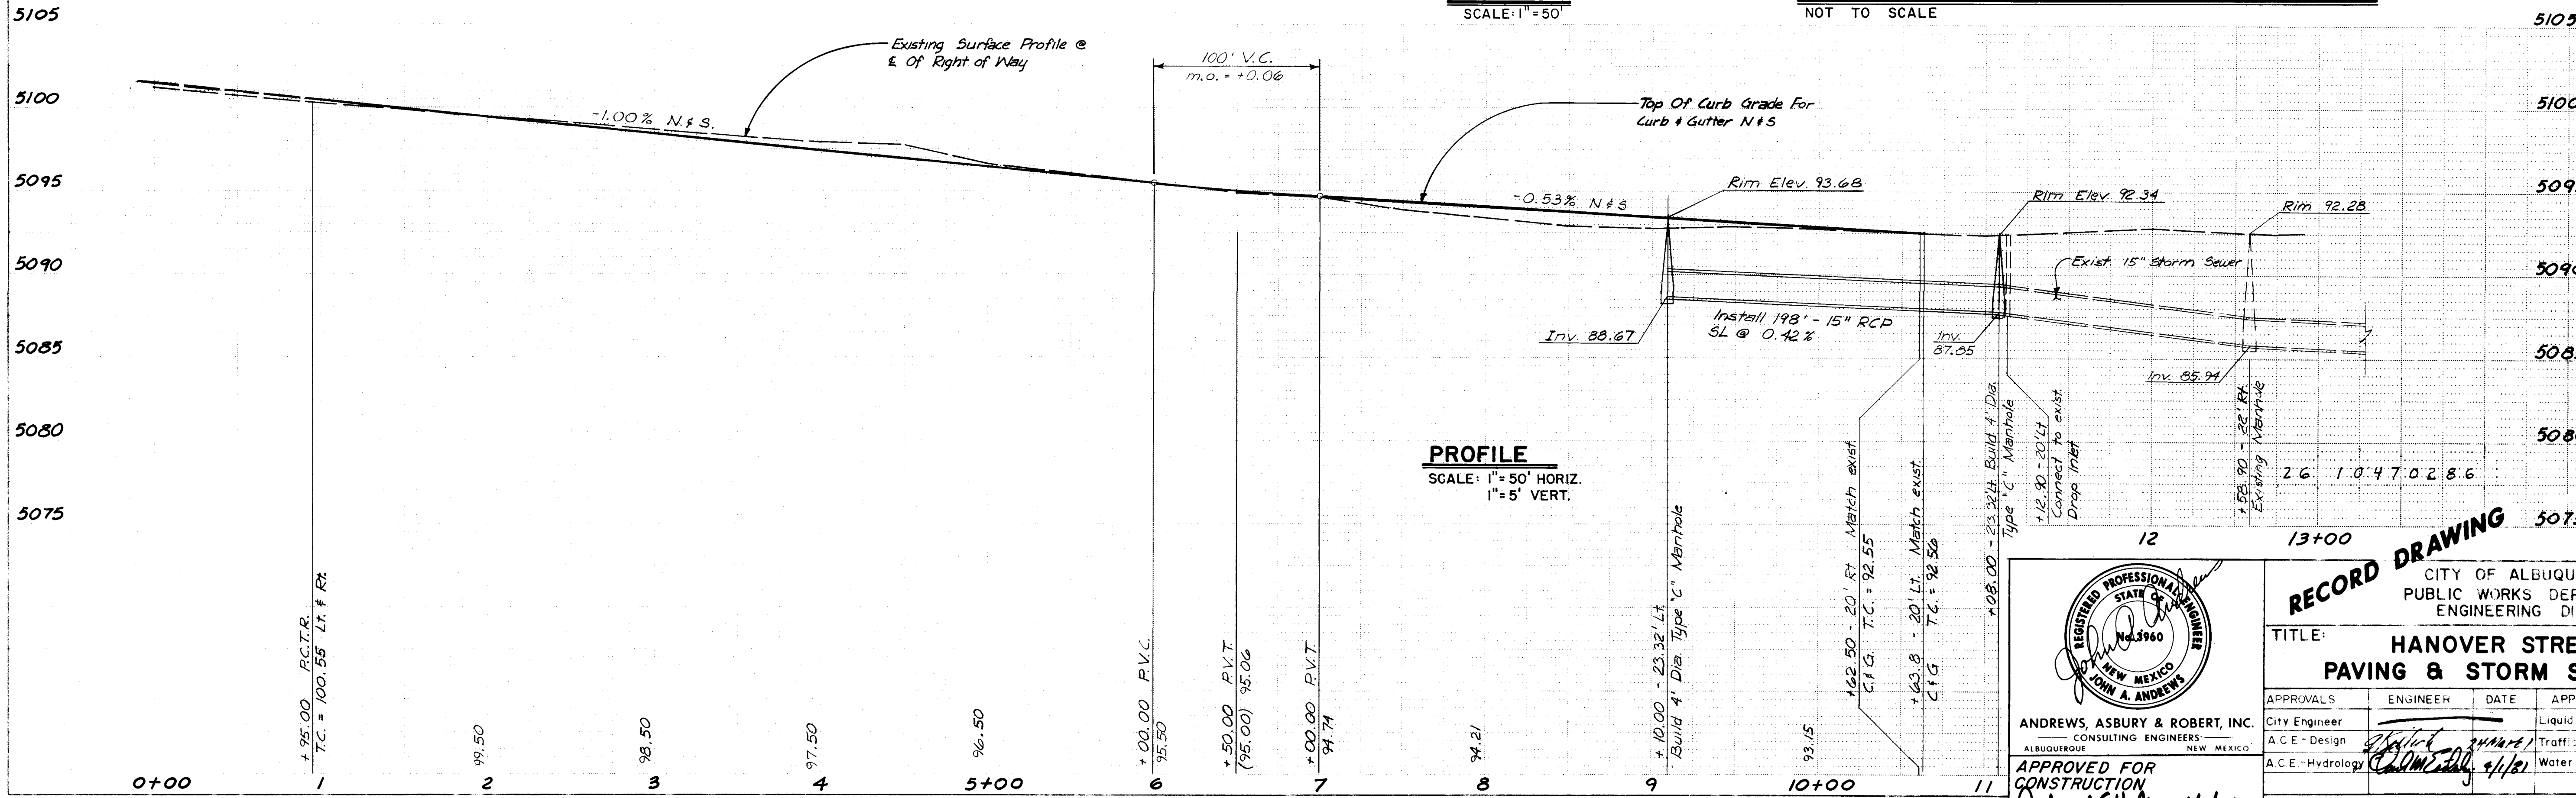

EQUIP										AS BUILT INFORMATION									
DEPARTMENT										CONTRACTOR <i>Interwest Ltd.</i>									
VISION										BENCH MARKS									
STREET NW.										A.C.S. 1-JIO									
SEWER LINES										Elevation 5101.14									
APPROVALS										DATE									
Waste										BY									
ENGINEER										DATE									
DATE										DATE									
3/20/91										DATE									
SHEET										DATE									
2										DATE									
OF										DATE									
3										DATE									