

ROSE ACRES ADDITION

BLOCK NO. 1—LOTS 5 & 6
[REDACTED] SANITARY SEWER

LASON 1-505-344-9404
BEST COPY AVAILABLE

NOTICE TO CONTRACTORS

New Mexico Standard Specifications for Public Works Construction—1989 Edition will be referred to herein as the "Standard Specification."

All work shall conform to these plans, to any amendments thereto, and to the Standard Specification, except as otherwise indicated on the plans. The Engineer shall be responsible for the accuracy of the data furnished by the contractor.

All work shall conform to the Standard Specification, except as otherwise indicated on the plans. The Engineer shall be responsible for the accuracy of the data furnished by the contractor.

All work shall conform to the Standard Specification, except as otherwise indicated on the plans. The Engineer shall be responsible for the accuracy of the data furnished by the contractor.

1. The contractor shall be responsible for the accuracy of the data furnished by the contractor.

2. The contractor shall be responsible for the accuracy of the data furnished by the contractor.

3. The contractor shall be responsible for the accuracy of the data furnished by the contractor.

4. The contractor shall be responsible for the accuracy of the data furnished by the contractor.

5. The contractor shall be responsible for the accuracy of the data furnished by the contractor.

6. The contractor shall be responsible for the accuracy of the data furnished by the contractor.

7. The contractor shall be responsible for the accuracy of the data furnished by the contractor.

8. The contractor shall be responsible for the accuracy of the data furnished by the contractor.

9. The contractor shall be responsible for the accuracy of the data furnished by the contractor.

10. The contractor shall be responsible for the accuracy of the data furnished by the contractor.


11. The contractor shall be responsible for the accuracy of the data furnished by the contractor.

12. The contractor shall be responsible for the accuracy of the data furnished by the contractor.


1	2	3	4	5	6	7	8	9	10	11	12
2	6	1	0	4	8	0	1	8	1		

APPROVAL OF AS BUILT DRAWINGS
ASST. CITY ENGINEER - FIELD
[Signature]
DATE 9-1-81

10401

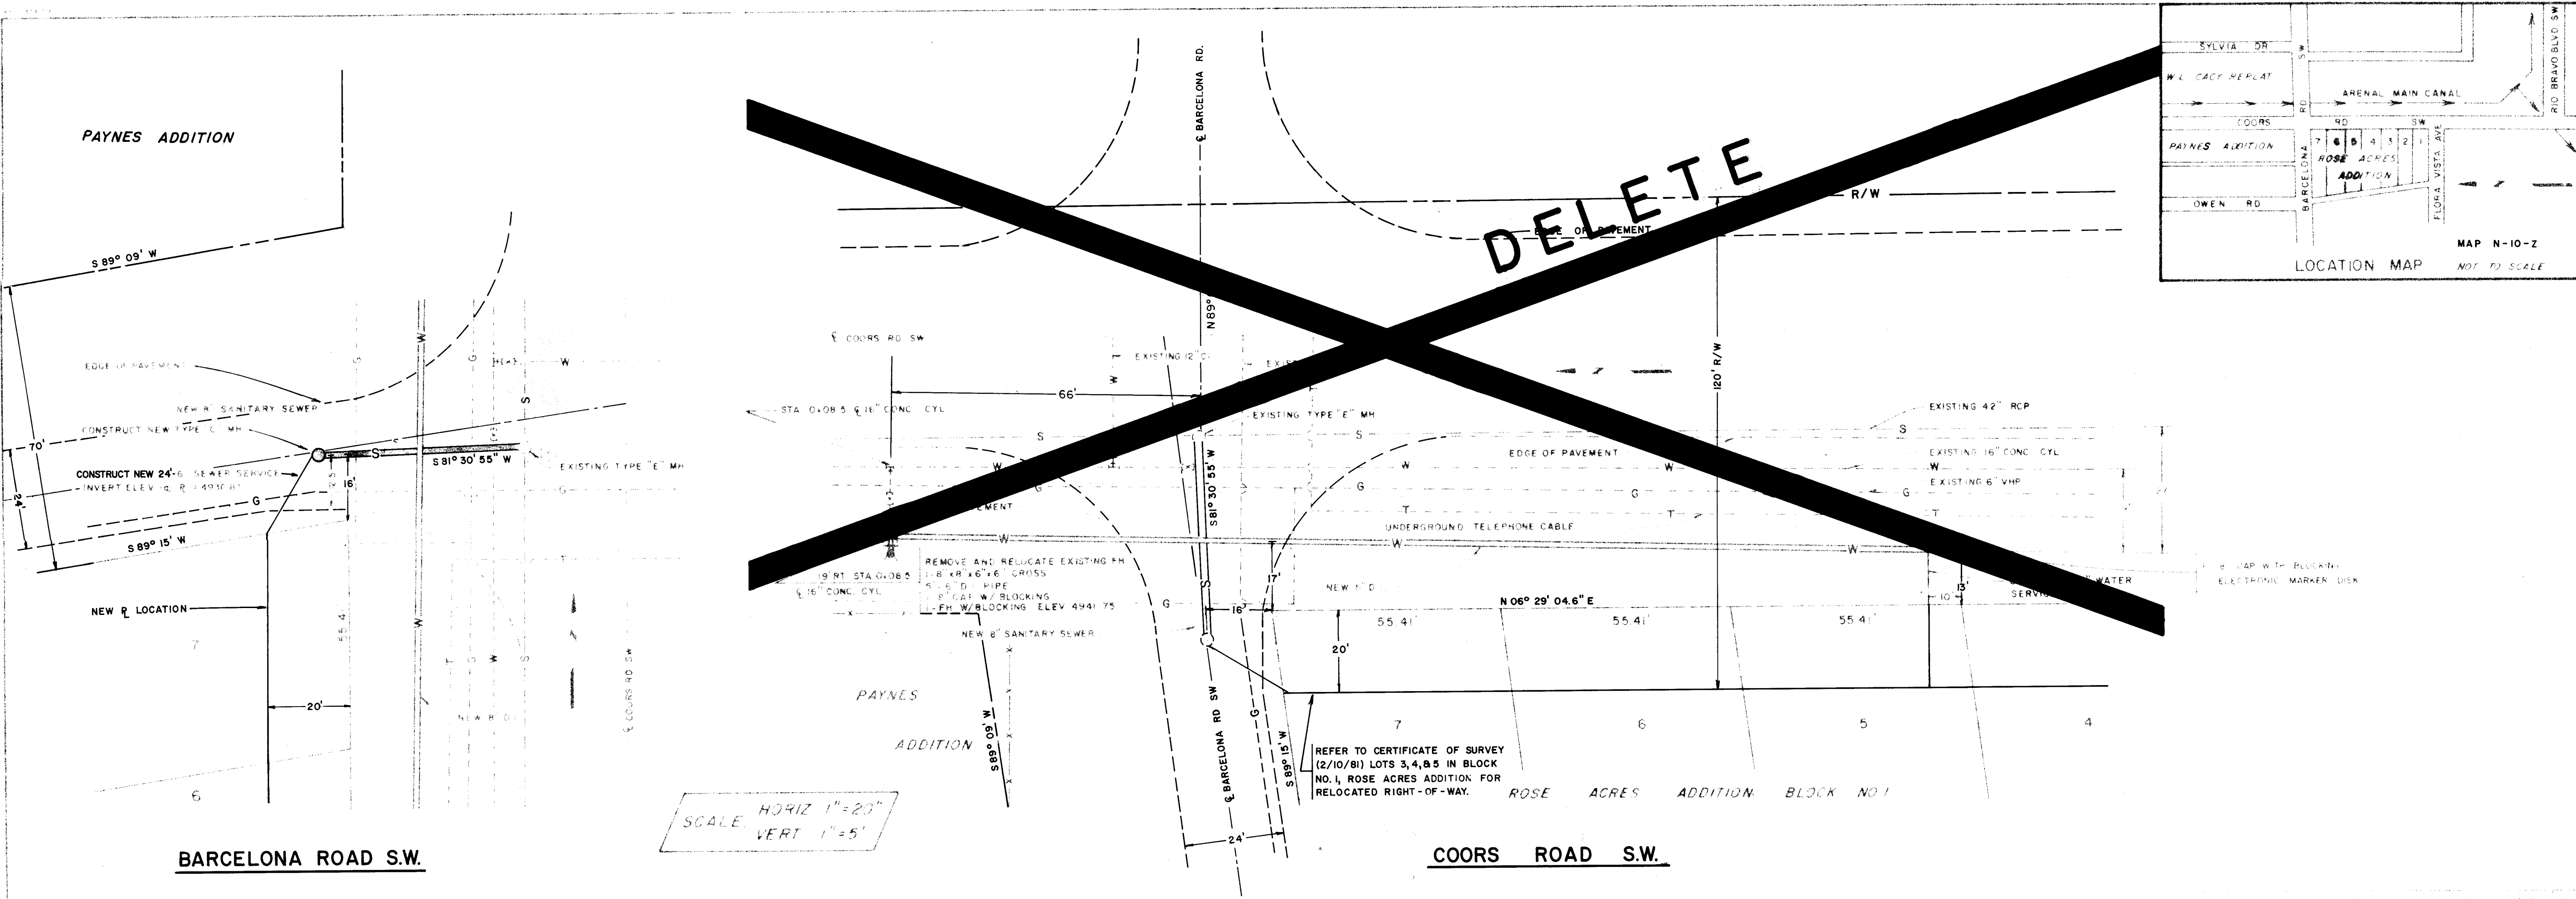

FOR WATER INFO. SEE PROJECT 1032

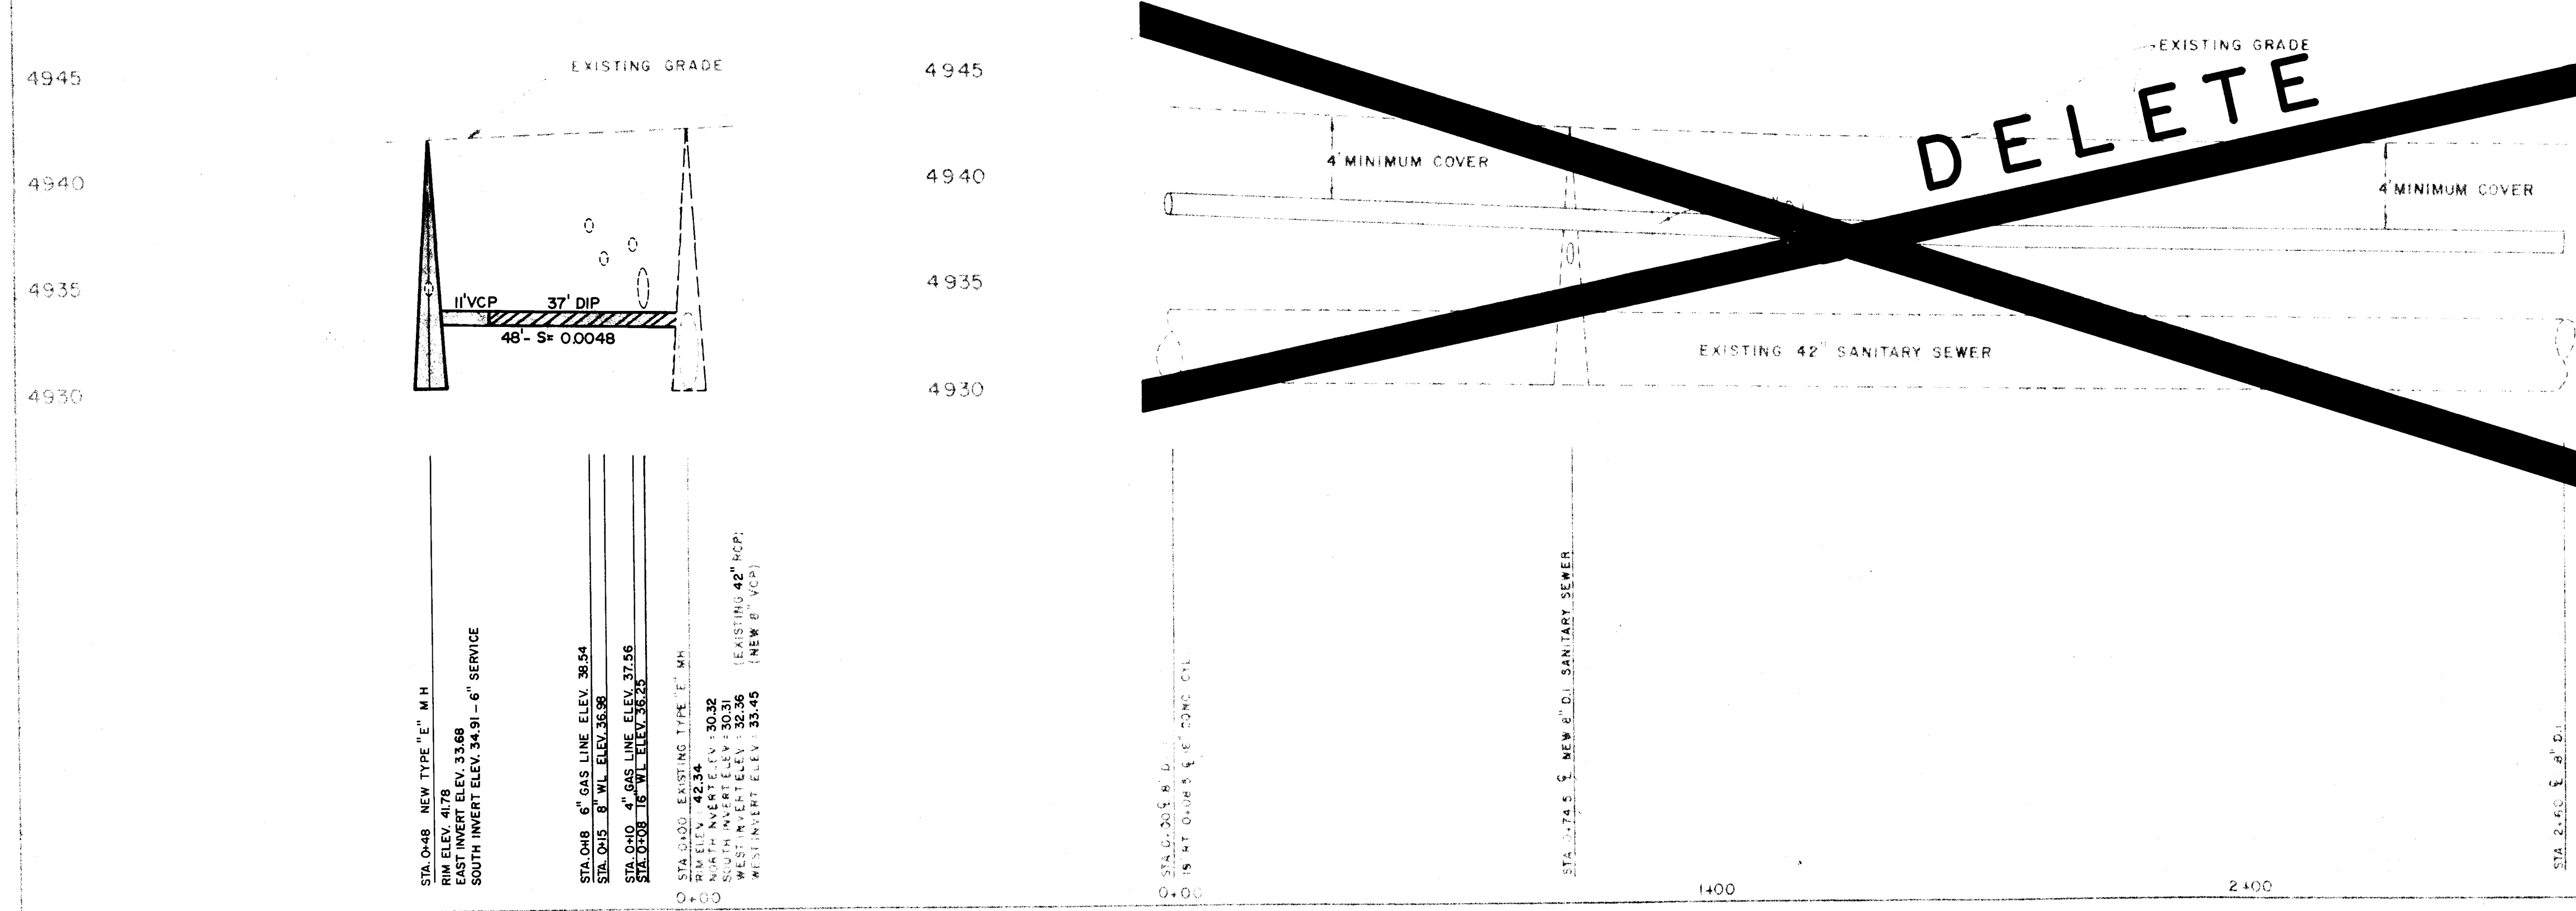

STA 0+00 NEW TYPE "E" M.H.	STA 0+00 NEW TYPE "E" M.H.
RIM ELEV. 4178	RIM ELEV. 4178
EAST INVERT ELEV. 33.68	EAST INVERT ELEV. 33.68
SOUTH INVERT ELEV. 34.31 - 6" SERVICE	SOUTH INVERT ELEV. 34.31 - 6" SERVICE
STA 0+05 6" GAS LINE ELEV. 38.54	STA 0+05 6" GAS LINE ELEV. 38.54
STA 0+05 8" W.L. ELEV. 38.58	STA 0+05 8" W.L. ELEV. 38.58
STA 0+10 4" GAS LINE ELEV. 37.56	STA 0+10 4" GAS LINE ELEV. 37.56
STA 0+10 16" W.L. ELEV. 36.25	STA 0+10 16" W.L. ELEV. 36.25
STA 0+10 EXISTING TYPE "E" M.H.	STA 0+10 EXISTING TYPE "E" M.H.
STATIONING: 0+00 TO 0+10	STATIONING: 0+00 TO 0+10
SOUTH INVERT ELEV. 30.31	SOUTH INVERT ELEV. 30.31
WEST INVERT ELEV. 30.31	WEST INVERT ELEV. 30.31
WEST INVERT ELEV. 30.45	WEST INVERT ELEV. 30.45

1	2	3	4	5	6	7	8	9	10	11	12
2	0	1	0	4	8	0	2	8	1		

APPROVAL OF AS BUILT DRAWINGS
ASSISTANT CITY ENGINEER - FIELD
[Signature]
DATE 9-1-81

		CITY OF ALBUQUERQUE MUNICIPAL DEVELOPMENT DEPARTMENT ENGINEERING DIVISION	
TITLE: ROSE ACRES ADDITION, BLOCK NO. 1 - LOTS 5 AND 6 SANITARY SEWER			
APPROVALS	ENGINEER	DATE	APPROVALS
City Engineer	<i>[Signature]</i>	12/27/81	Liquid Waste
A.C.E. Design			Traffic
A.C.E. Hydrology			Water
APPROVED FOR CONSTRUCTION <i>[Signature]</i> 2/27/81 CITY ENGINEER		DRAWING NO. 1048	
		SHEET 2 OF 2	

AS BUILT INFORMATION	BENCH MARKS	SURVEY INFORMATION	REFERENCES	REVISIONS	DESIGN
CONTROL: NM-45-8, LOCATED 6' SOUTH OF MEDIAN NOSE AND 15' WEST OF THE NORTH MEDIAN (Q) THE INTERSECTION OF COORS RD. SW AND RIO BRAVO BLVD. SW. STANDARD NM5HC BRASS CAP STAMPED "NM-45-8"		MAP NO. N-10-2-2022	EST. NO. 1048	NO. 1	DATE 12-2-80
INSPECTED BY: RICHARD ROMERO/DELE/5/81		DATE	DATE	DATE	DATE
RECORDED BY: L.H.		DATE	DATE	DATE	DATE
NO.		DATE	DATE	DATE	DATE
ELEV. = 4939.34'		DATE	DATE	DATE	DATE