


CITYVIEW ESTATES UNIT B
COPPER CHANNEL BRIDGE AT MONTE ALTO DR.

#T-48

LASON 1-505-344-9404
BEST COPY AVAILABLE

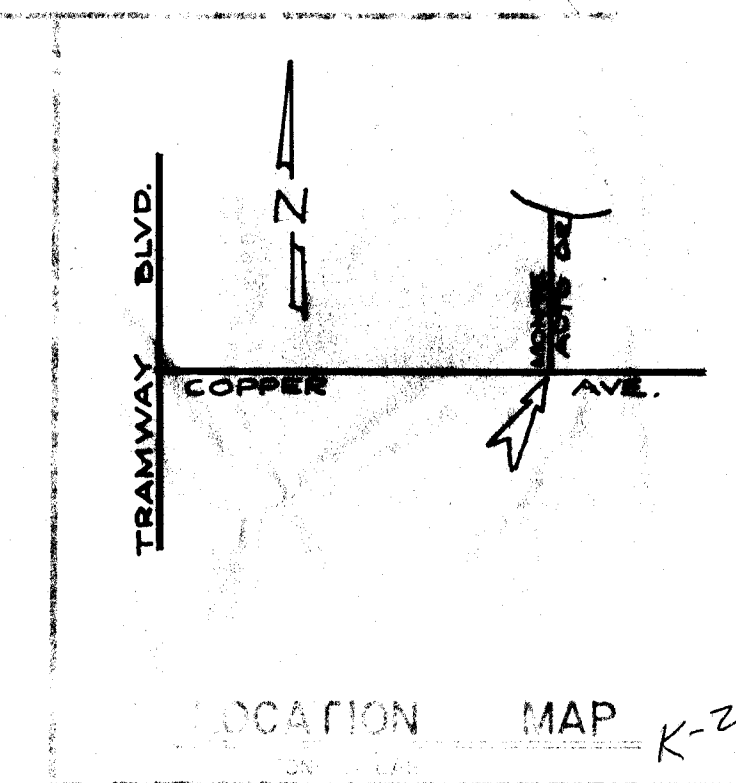

NOTICE TO CONTRACTORS

1. The City of San Antonio is the owner of the project. The City of San Antonio is not responsible for the design or construction of the project. The City of San Antonio is not responsible for the design or construction of the project.

2. The City of San Antonio is the owner of the project. The City of San Antonio is not responsible for the design or construction of the project. The City of San Antonio is not responsible for the design or construction of the project.

NOTICE TO CONTRACTORS

1. The City of San Antonio is the owner of the project. The City of San Antonio is not responsible for the design or construction of the project. The City of San Antonio is not responsible for the design or construction of the project.

2. The City of San Antonio is the owner of the project. The City of San Antonio is not responsible for the design or construction of the project. The City of San Antonio is not responsible for the design or construction of the project.

3. The City of San Antonio is the owner of the project. The City of San Antonio is not responsible for the design or construction of the project. The City of San Antonio is not responsible for the design or construction of the project.

4. The City of San Antonio is the owner of the project. The City of San Antonio is not responsible for the design or construction of the project. The City of San Antonio is not responsible for the design or construction of the project.

5. The City of San Antonio is the owner of the project. The City of San Antonio is not responsible for the design or construction of the project. The City of San Antonio is not responsible for the design or construction of the project.

APPROVAL OF AS BUILT DRAWINGS
CHIEF CONSTRUCTION ENGINEER
W.S. M...
DATE 2-17-86




26 10550186


DRAWING NO. 1055

SHEET 1 OF 5


CITY VIEW ESTATES
UNIT "B"

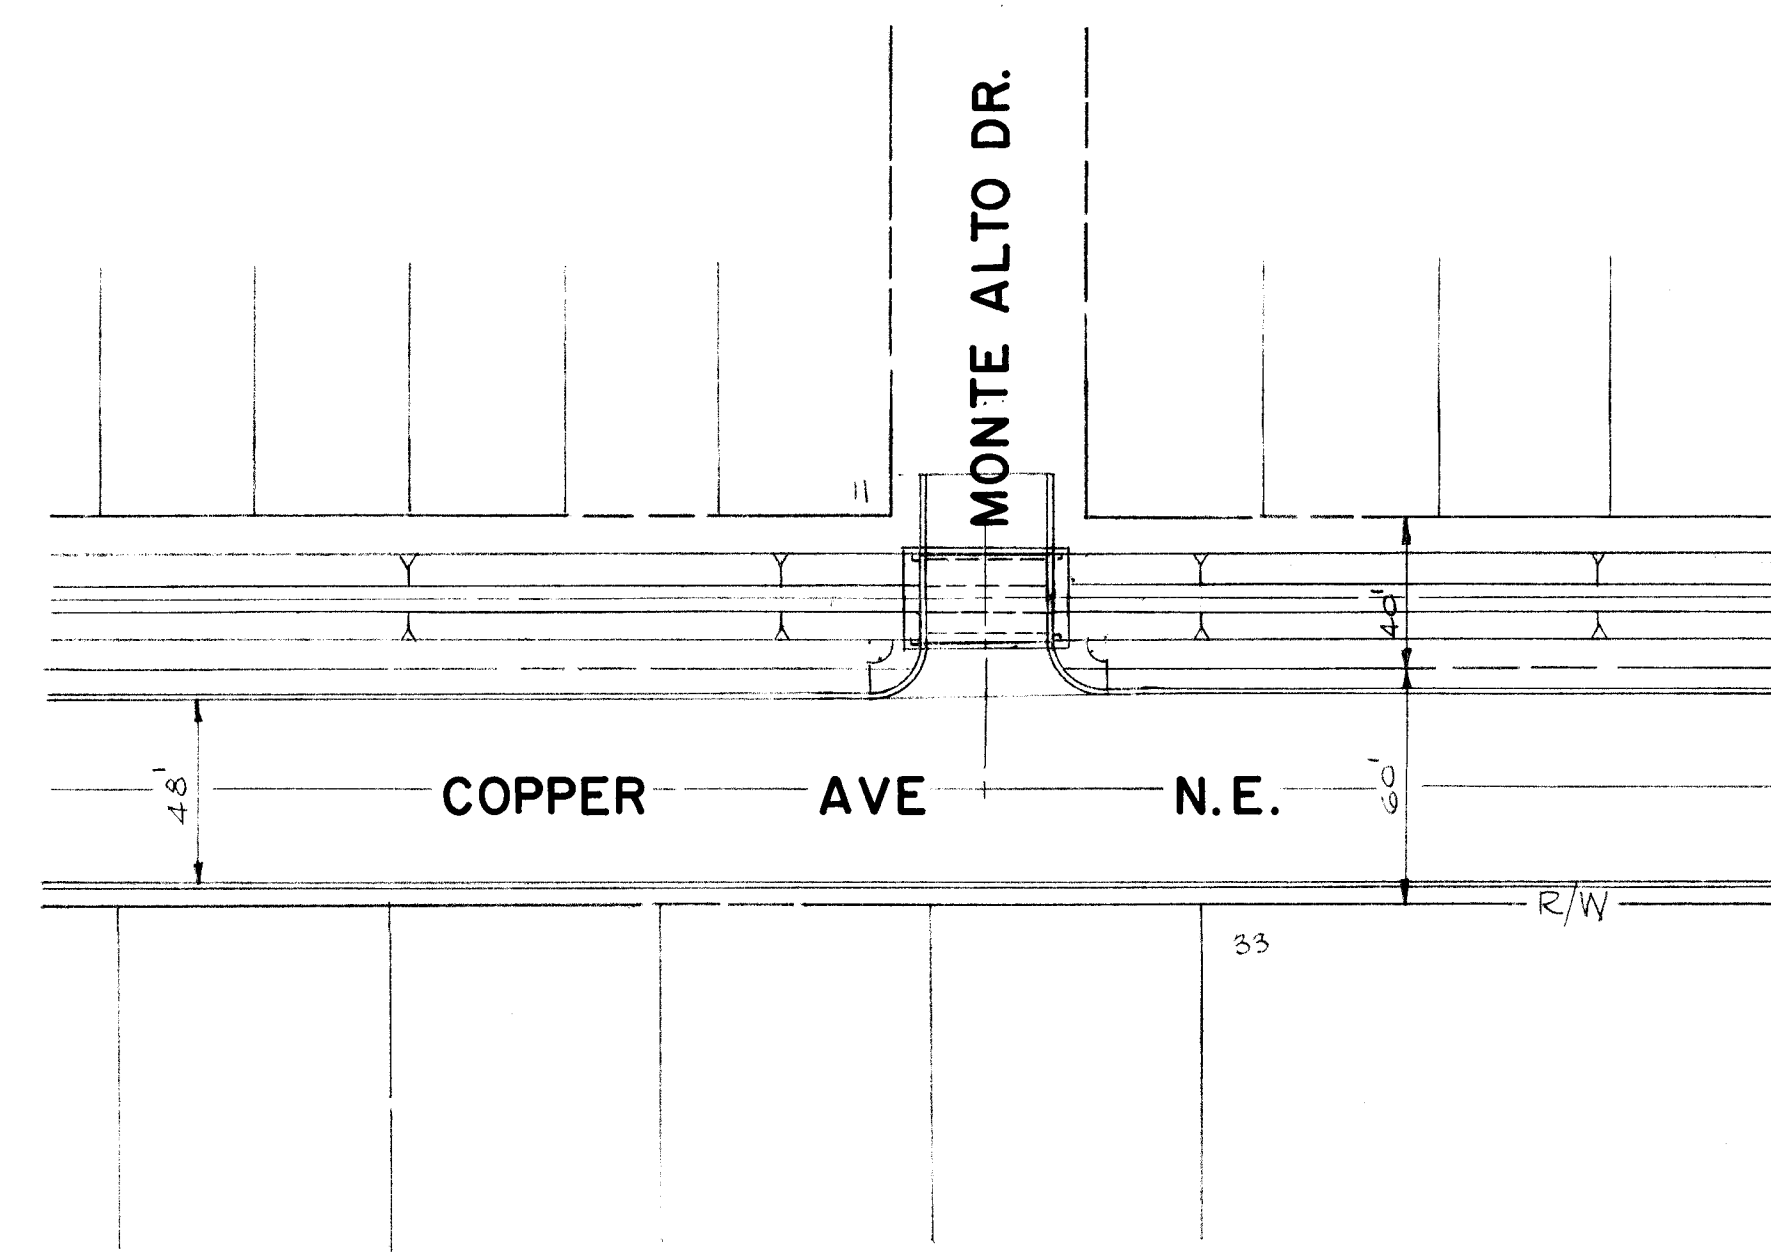


SITE PLAN
SCALE 1" = 40'

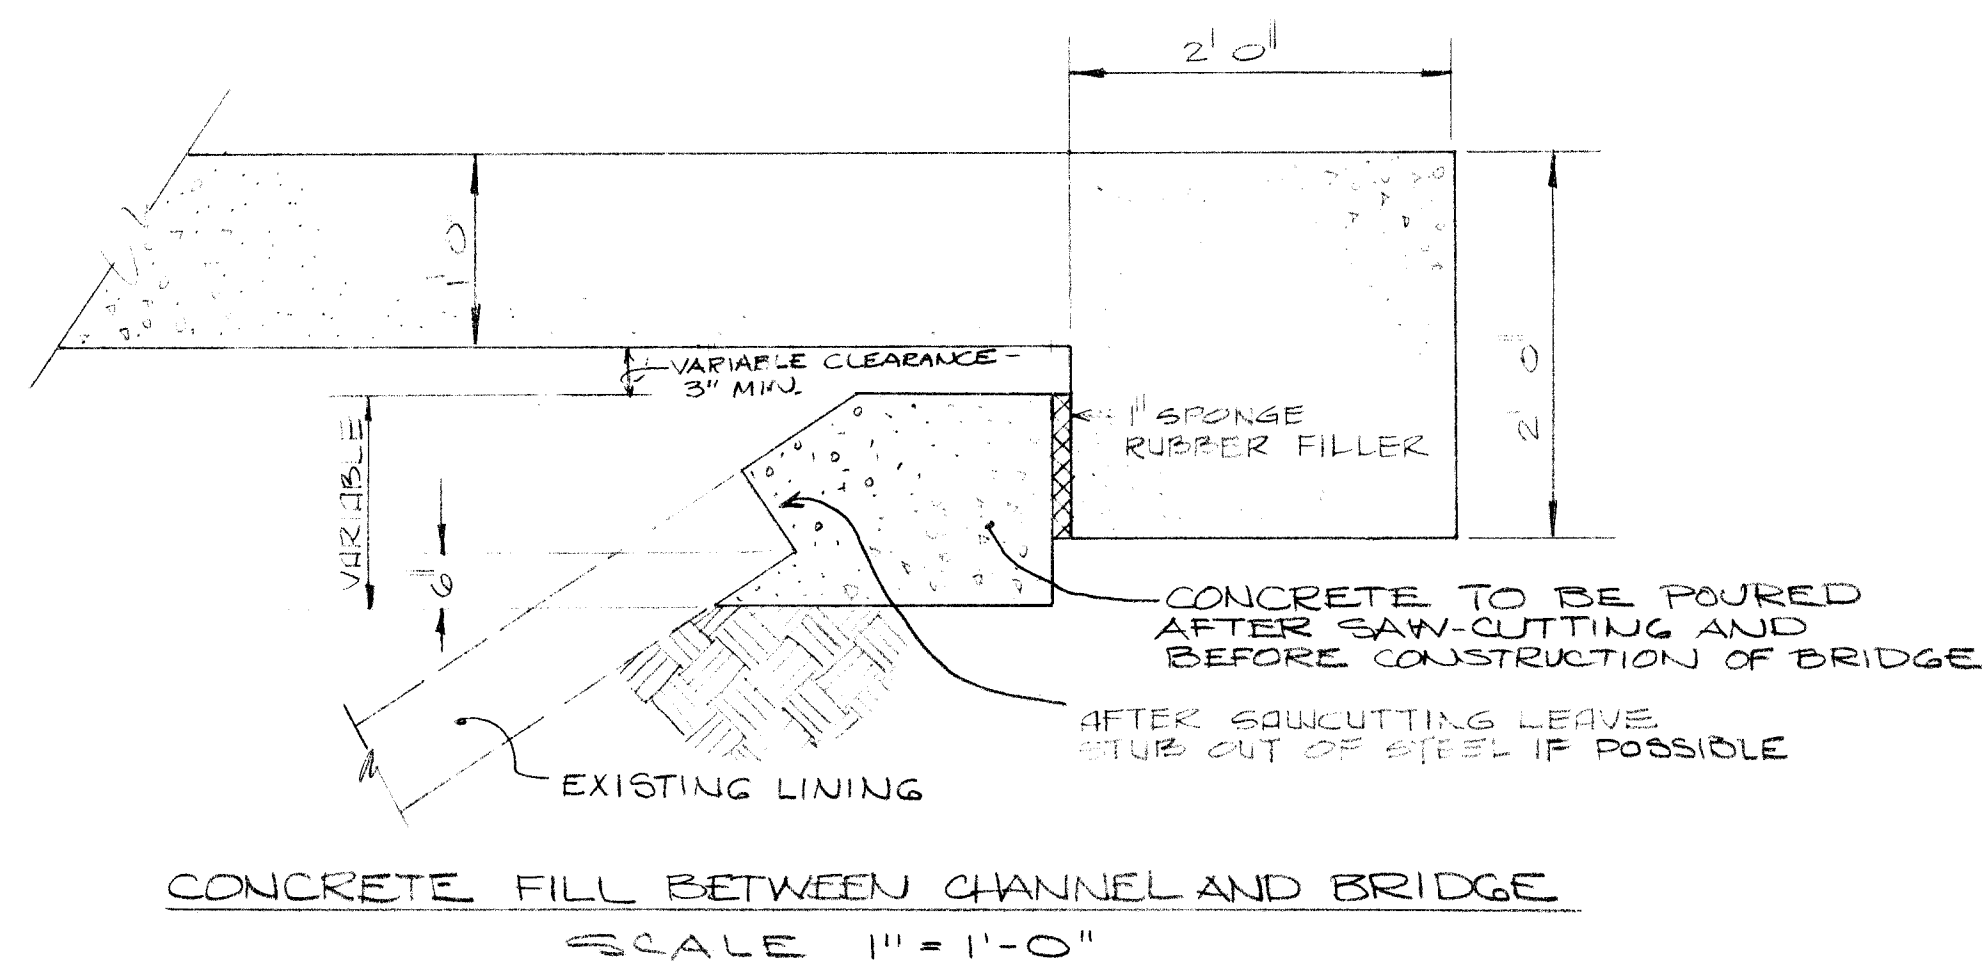


CONCRETE FILL BETWEEN CHANNEL AND BRIDGE
SCALE 1" = 1'-0"

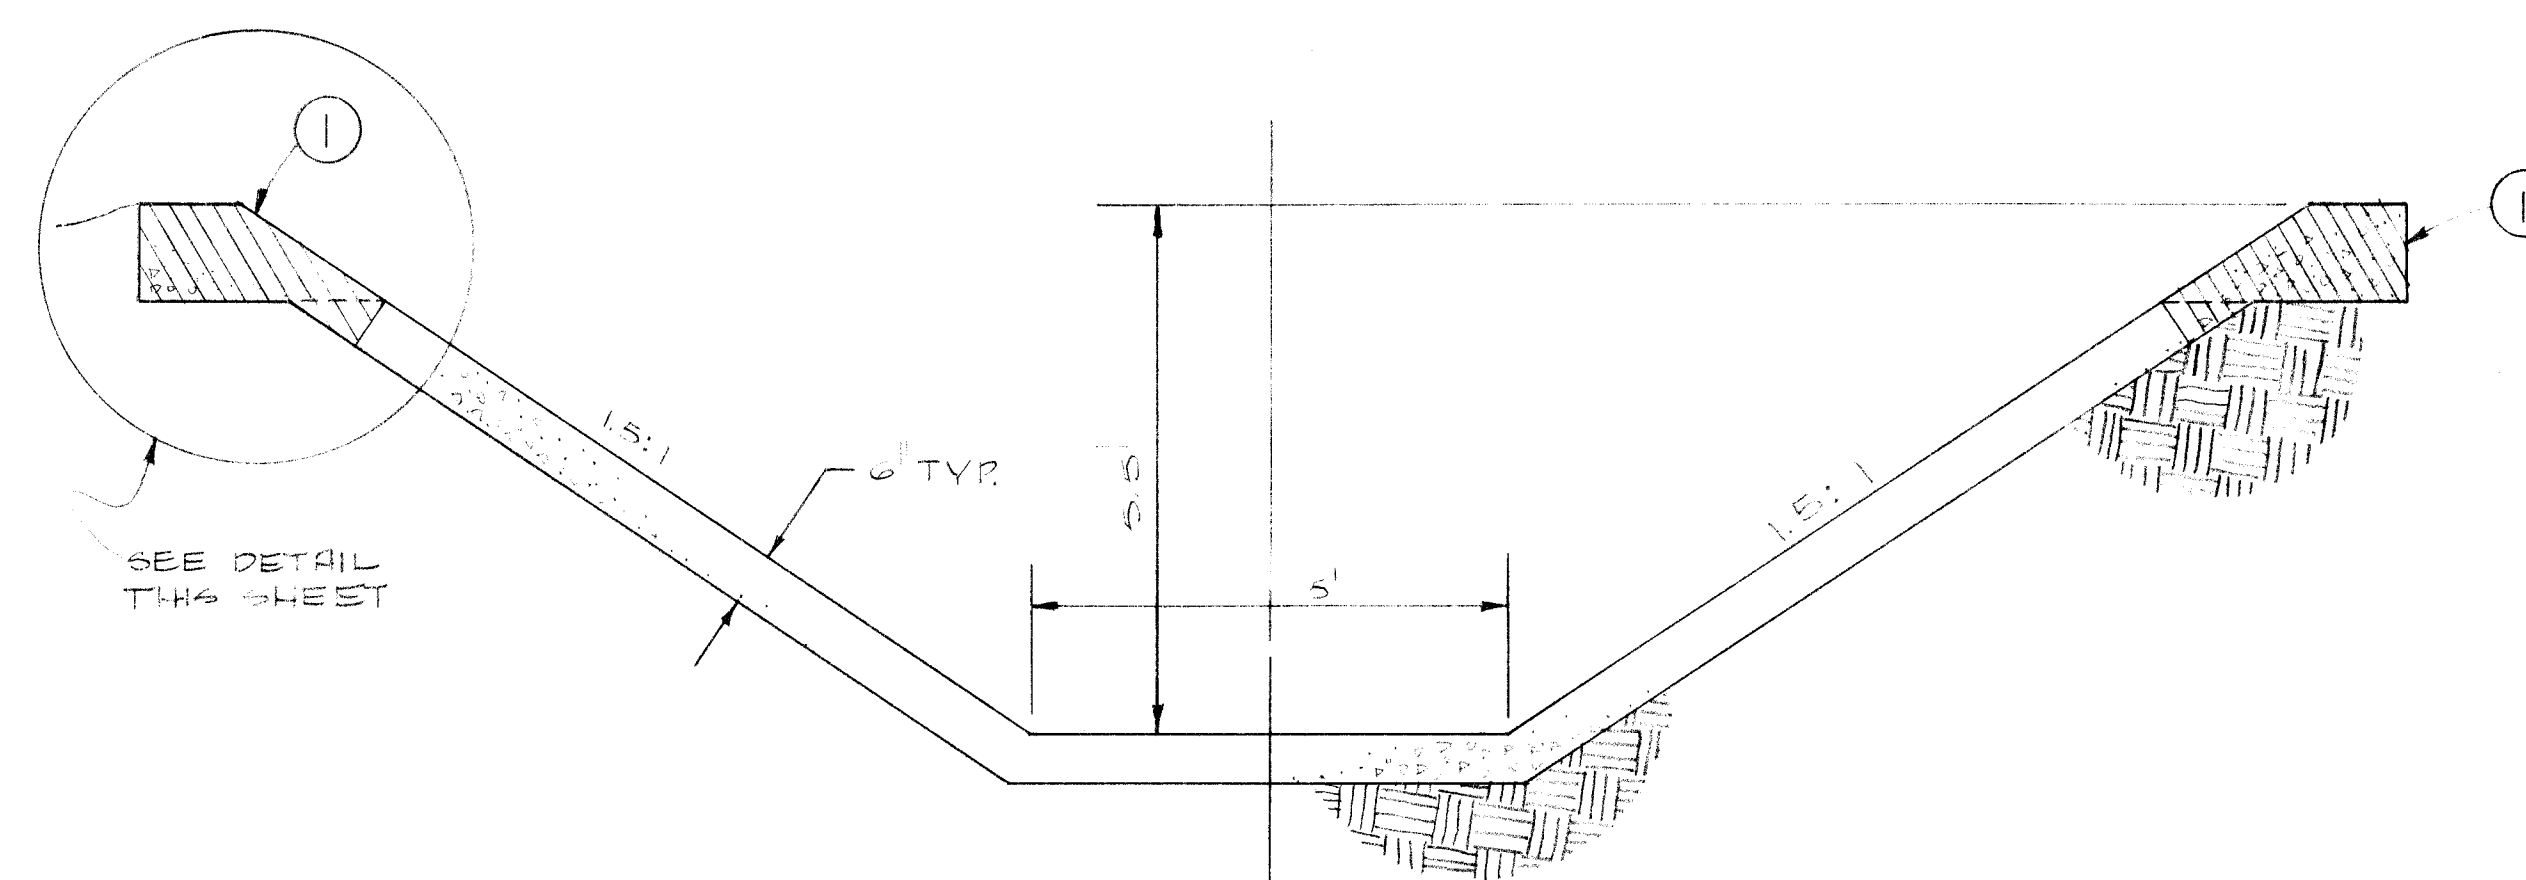

CHANNEL SECTION
SCALE 1" = 20'

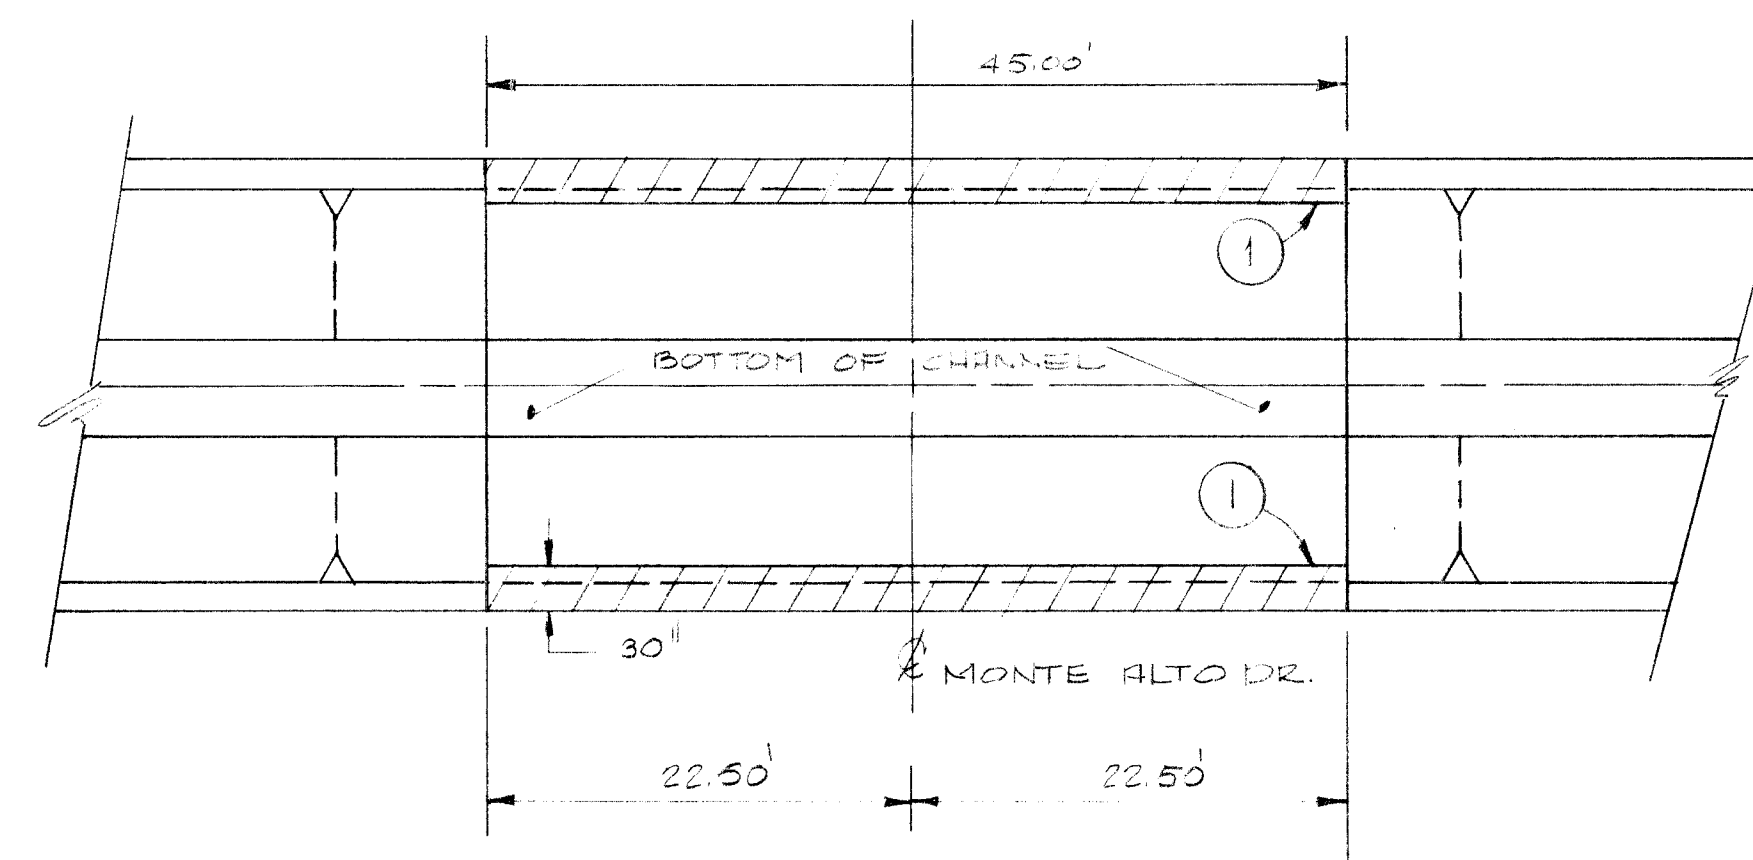

PLAN VIEW
SCALE 1" = 100'

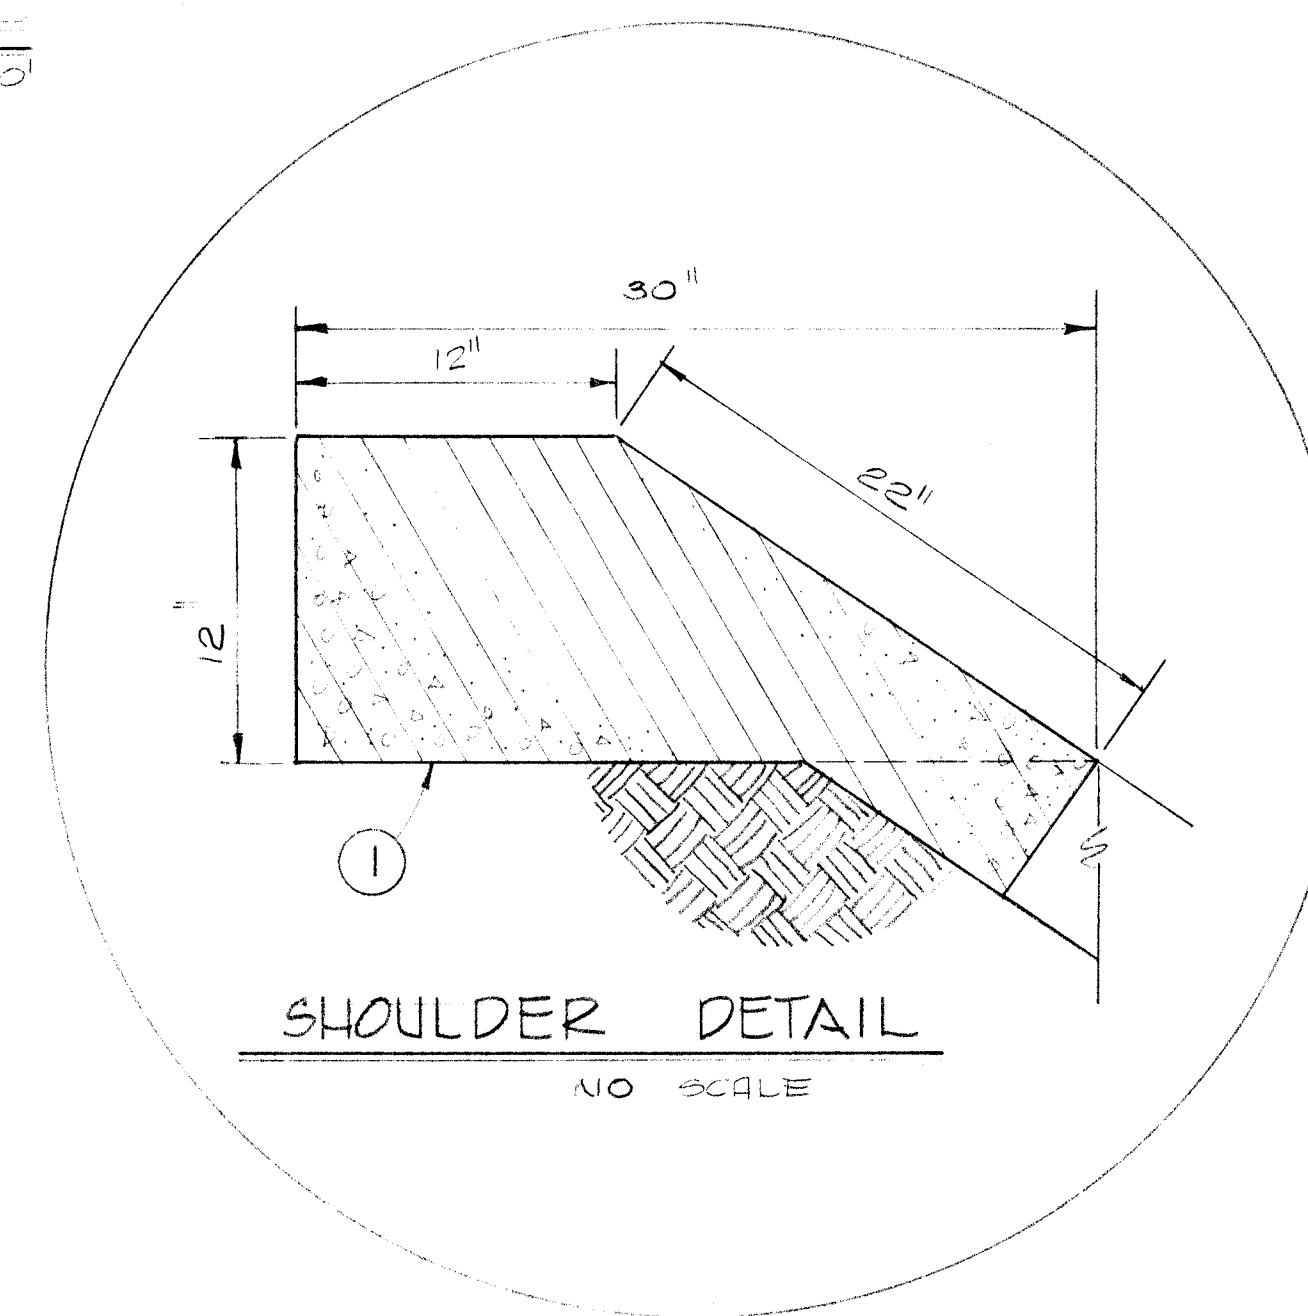

SHOULDER DETAIL
NO SCALE

① REMOVE EXIST. CONC.
LINING AND RECONSTRUCT
PUMP AND 24" ON EACH
SIDE OF CH. OF MONTE
ALTO DR.


LEGEND

EXISTING CHANNEL
LINING TO BE REMOVED



CITY OF ALBANY, N.Y. MUNICIPAL DEVELOPMENT DEPARTMENT ENGINEERING DIVISION			
TITLE: COTTER CHANNEL LINING MODIFICATION AT MONTE ALTO DR.			
DESIGNED BY R.S. Miller 4/4/81	CHECKED BY R. Miller 4/4/81	DATE 4/4/81	BY R. Miller
DRAWING NO. 1055	PROJECT NO. K-23	SHEET NO. 2	TOTAL SHEETS 5

T-48

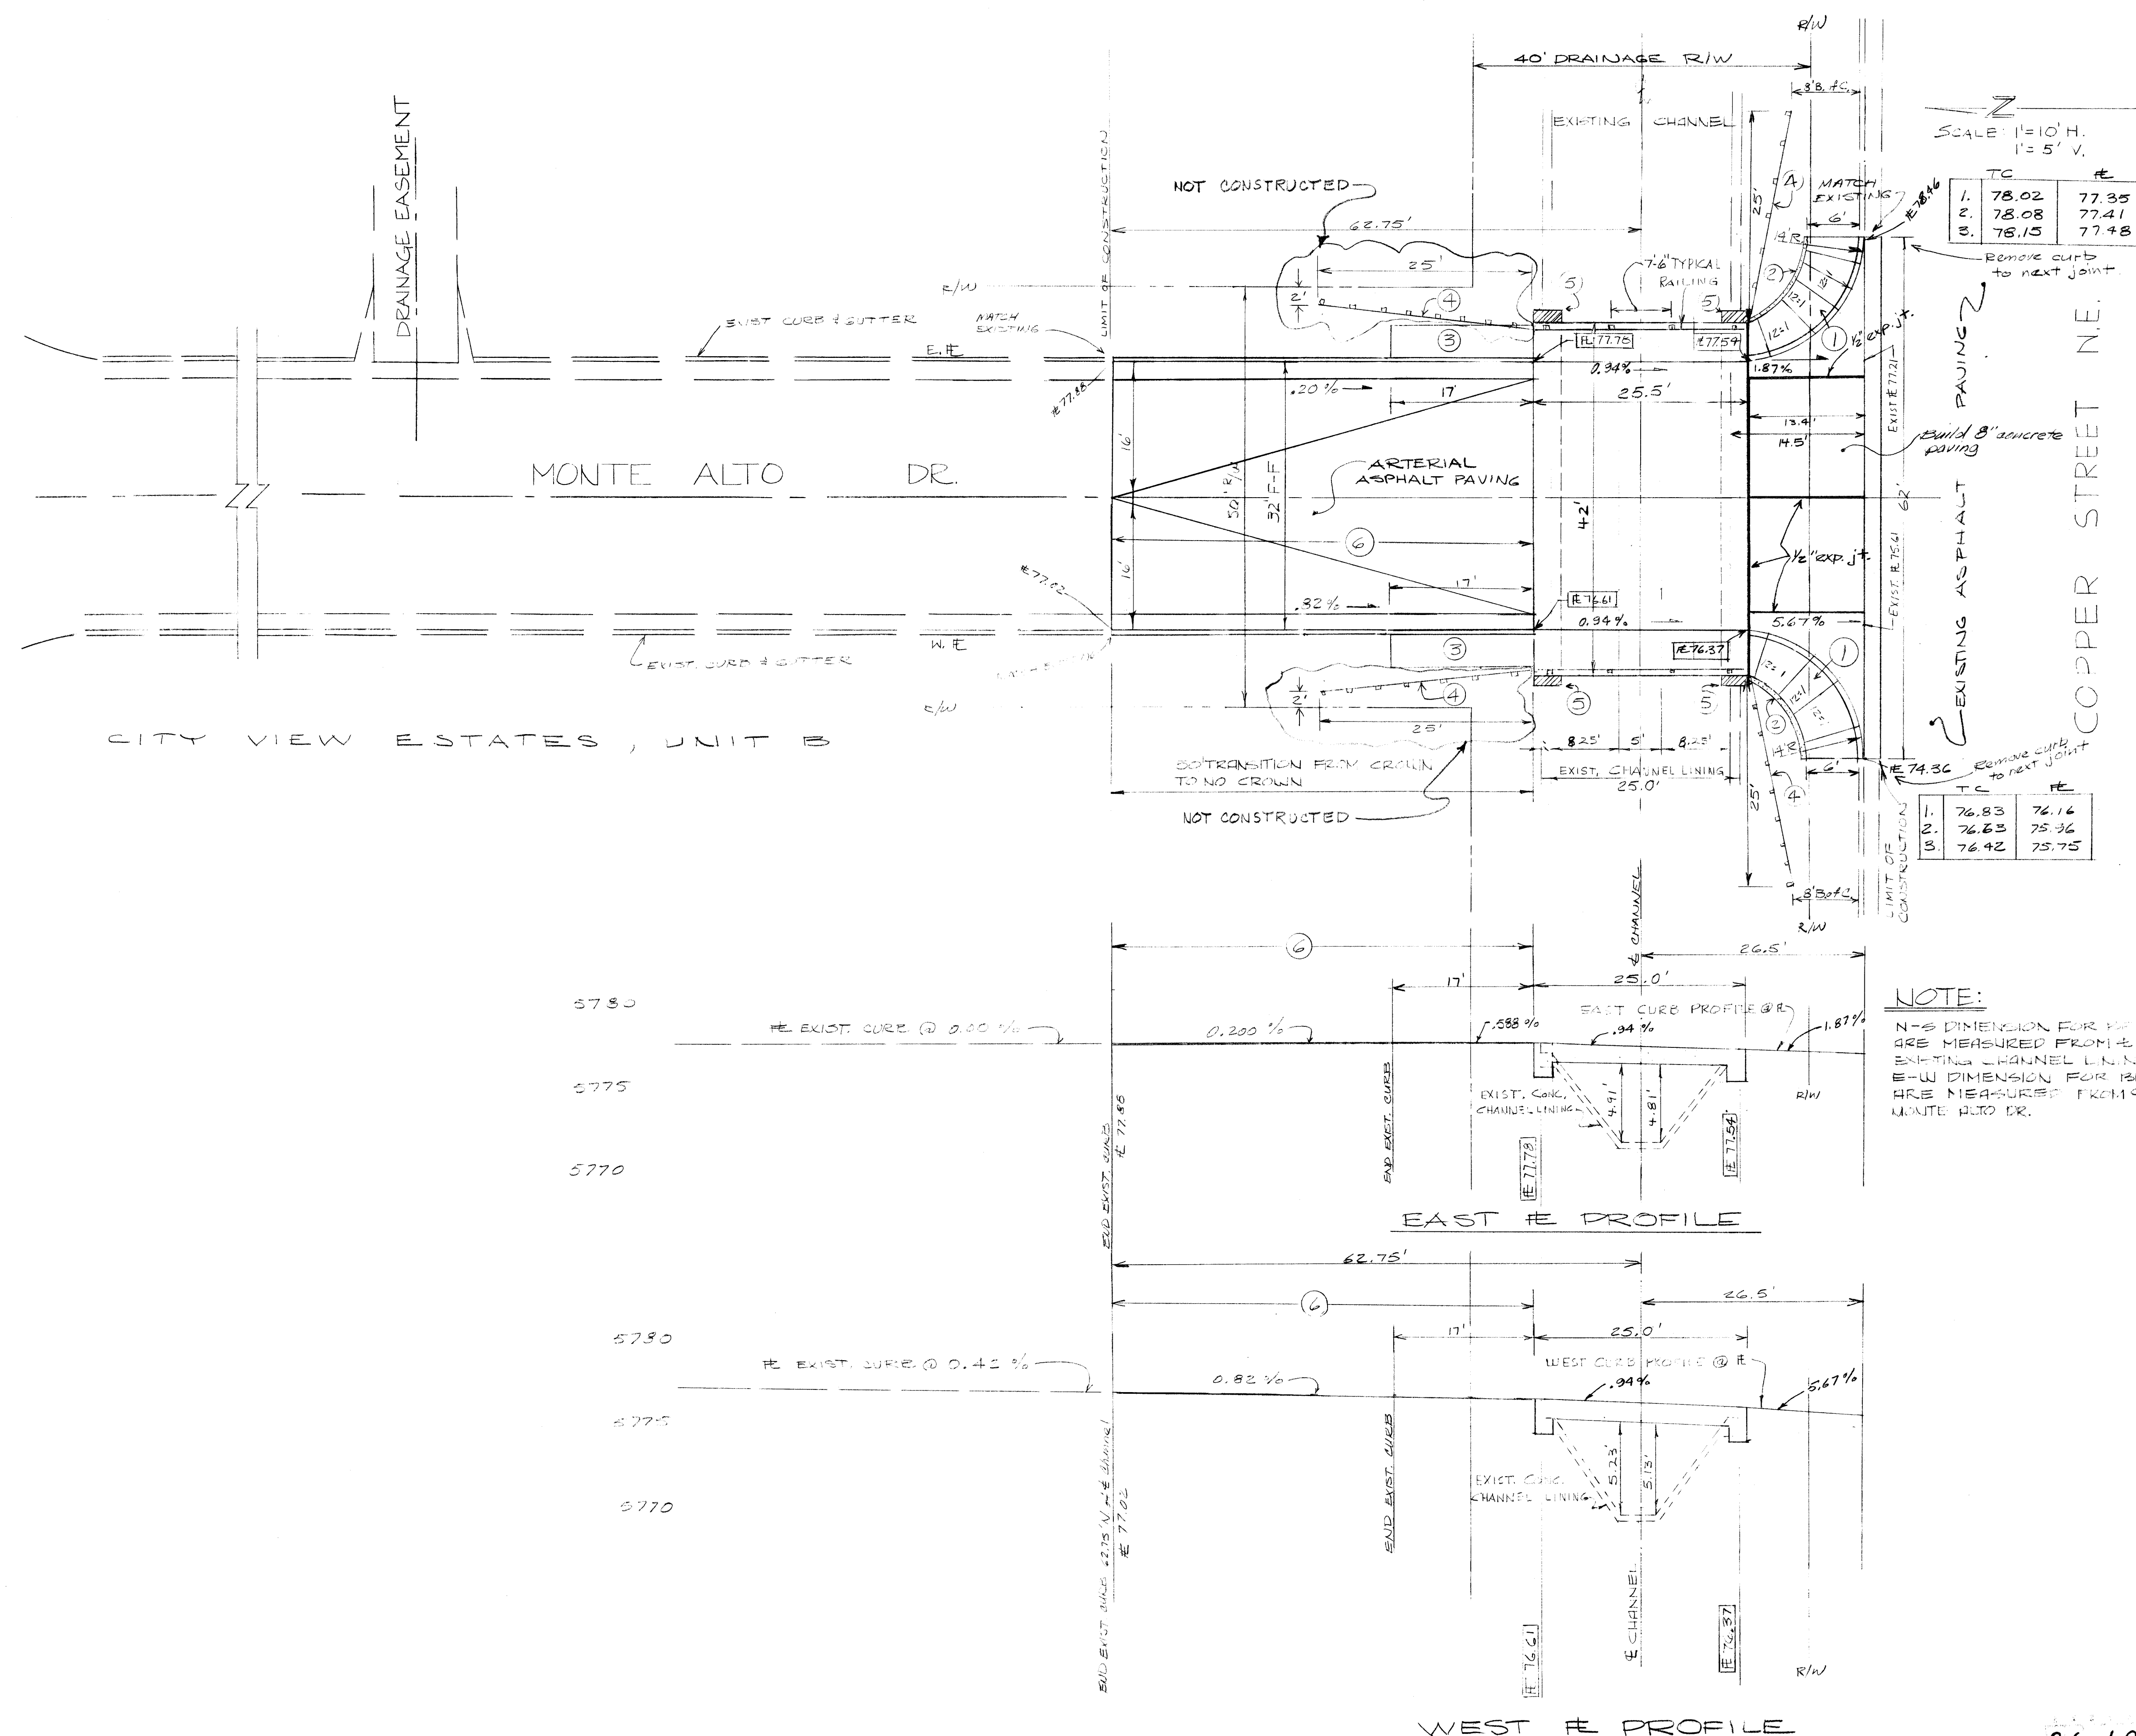

LEGEND
77.15 EXIST. ELEVATIONS
77.15 PROP. ELEVATIONS

NOTES:

- BUILD STD. WAREHOUSE RAMP PER STD. Dwg. P-1711.
- BUILD STD. HEADS OVER AT TOP OF WAREHOUSE RAMP.
- BUILD 1" CONCRETE SIDEWALK.
- BUILD STD. GUARD RAIL 25' LONG. USE TYPE "C" ANCHORS AT EACH END.
- LIMIT OF MODIFICATION OF EXISTING CHANNEL, 25' EACH SIDE OF MONTE ALTO DR. SEE SHEET 2 FOR DETAILS.
- REMOVE EXISTING PAVING, BUILD 50' TRANSITION FROM CROWN TO NO CROWN SECTION.




COPPER CHANNEL AT MONTE ALTO DR.
CONCRETE BRIDGE

26 10550386

1055 K-23 3 5
T-48

PS 26 G. ARCHONDE 4-17-81 12-K23 JEWEL PL. & DOMINGO
ELEV. 8805.79


S. MIRANDA
T. SANCHEZ

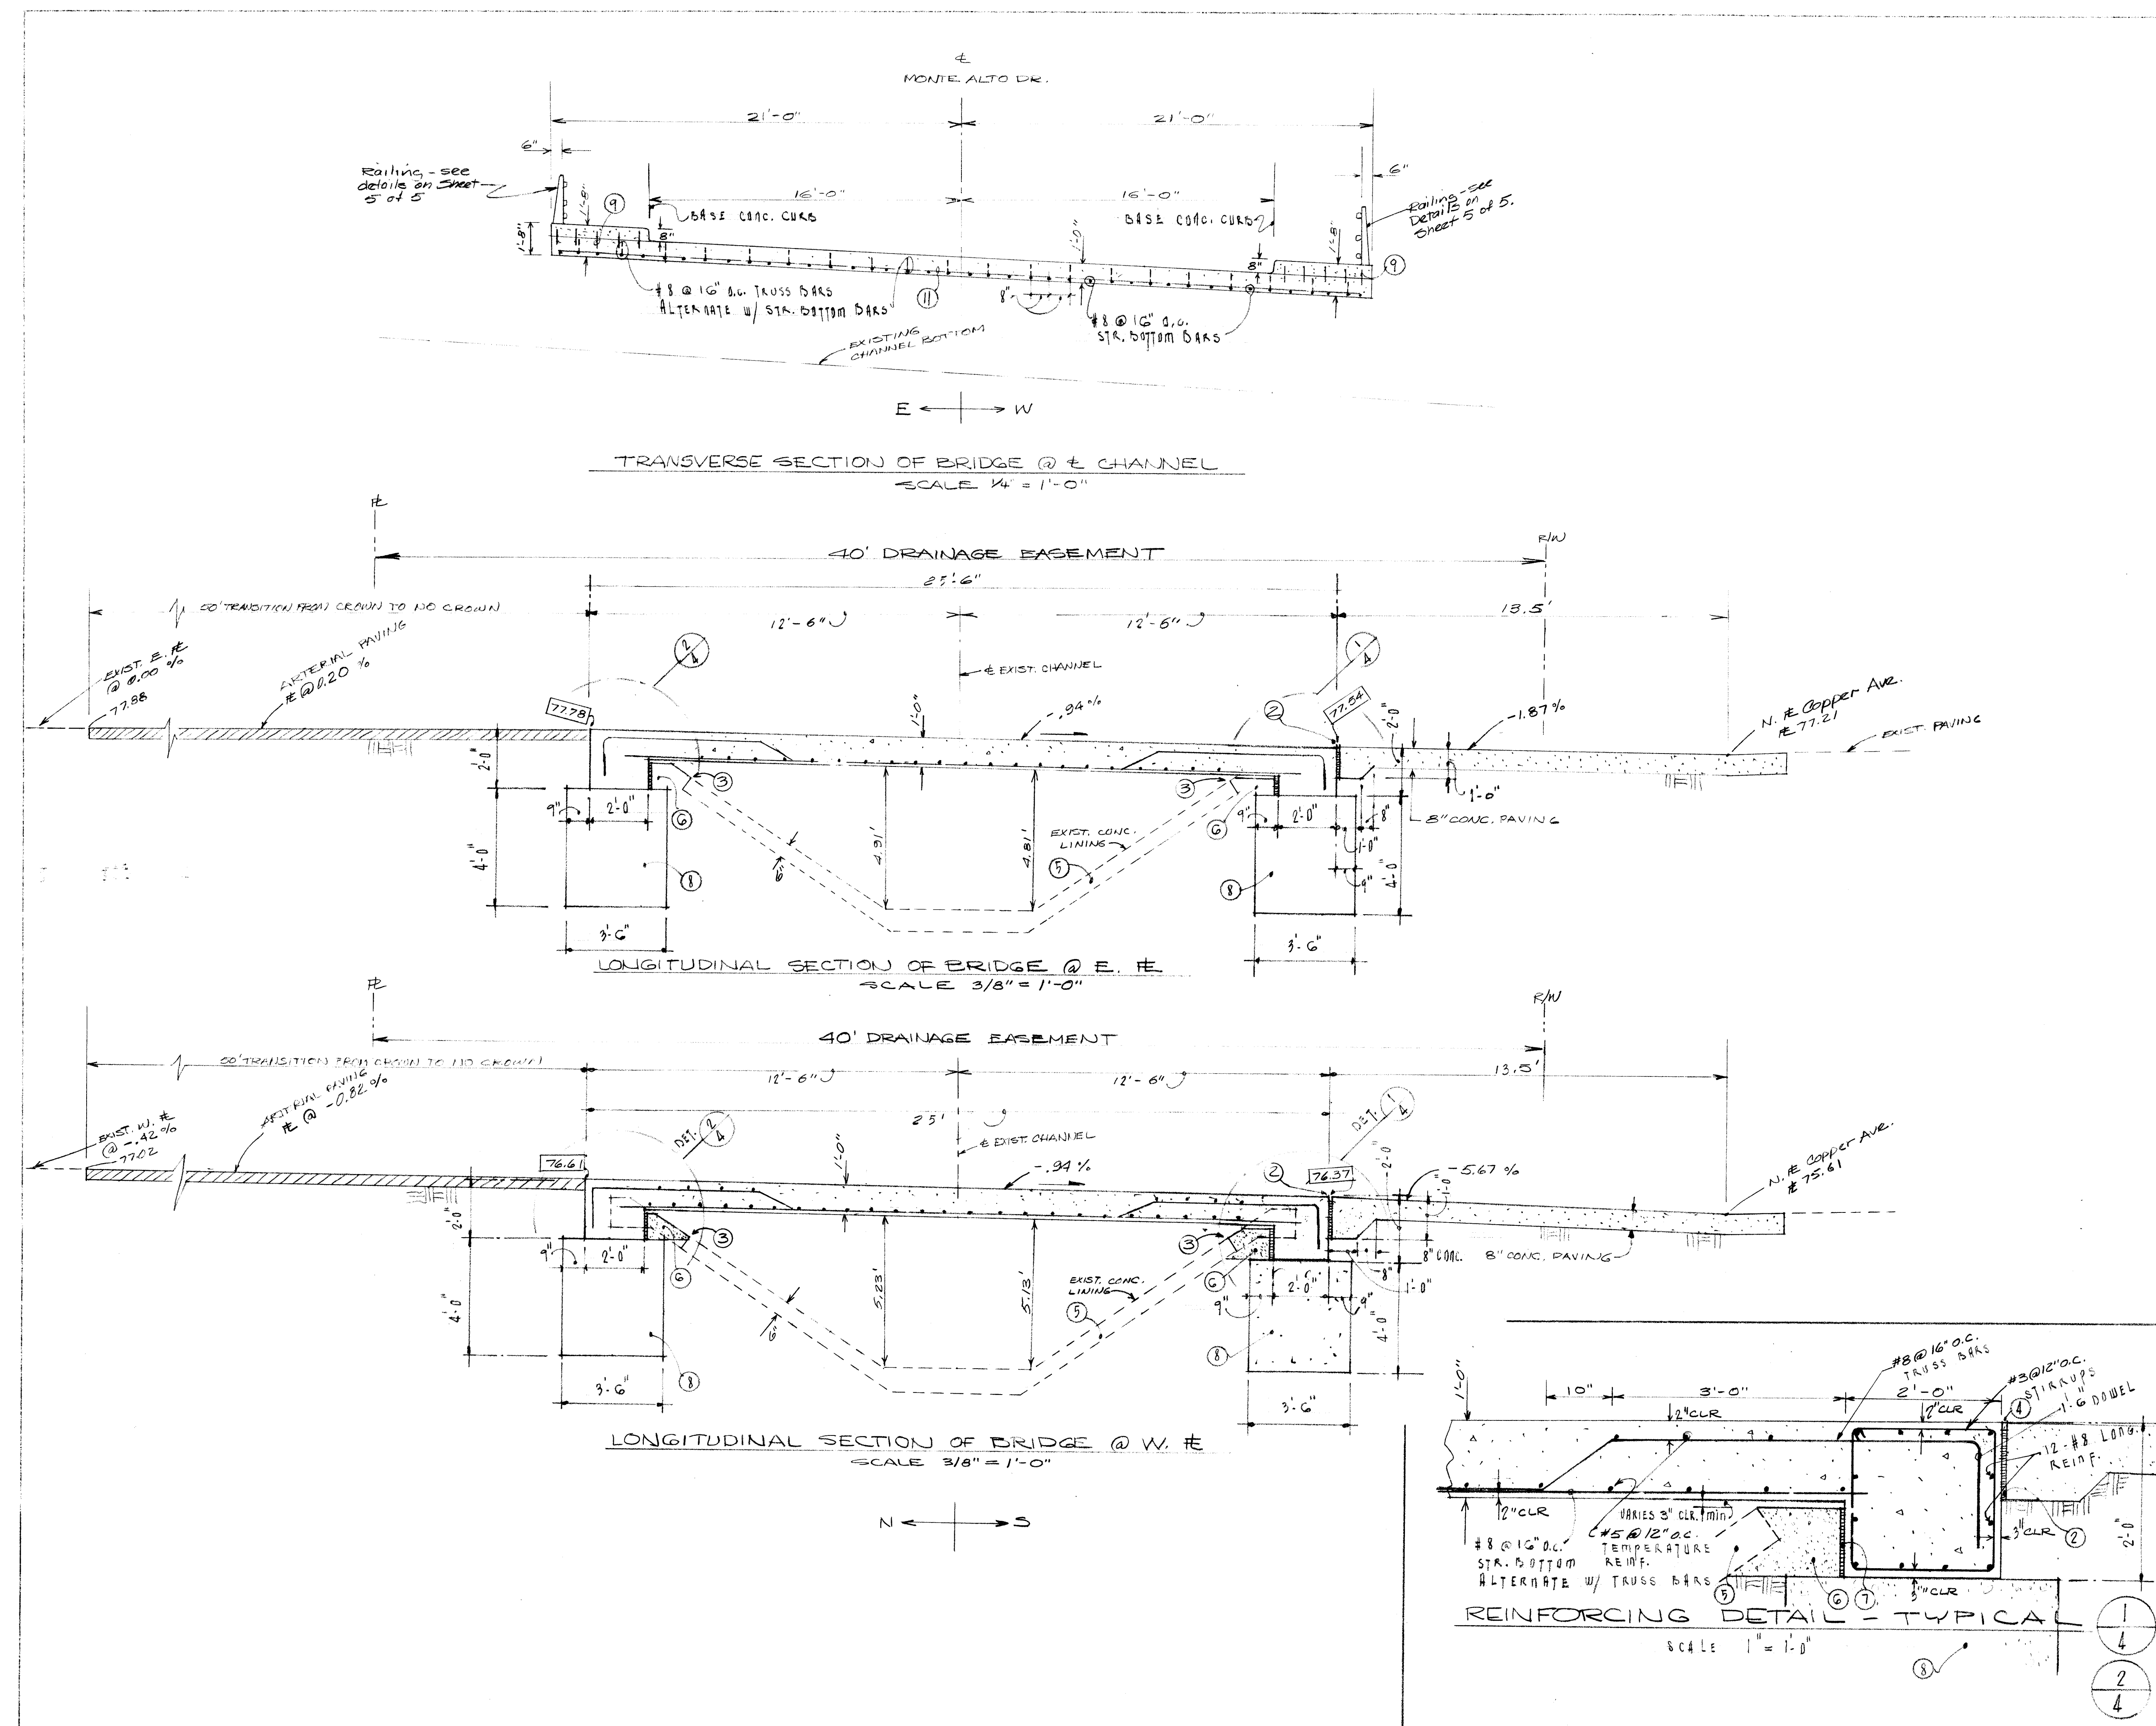

NOTES:

- ALL CONCRETE WORK TO BE 4000 PSI. COMPRESSIVE STRENGTH AT 28 DAYS. REINFORCING TO BE A-615 GRADE 60.
- 3/4" EXPANSION JOINT. PREMOLOD MATERIAL. AT SECT. DET. ONLY.
- MODIFICATION OF TOP OF EXIST. CHANNEL LINING BY OTHERS. SEE PWS. 1119.
- SEALER.
- EXISTING CONC. LINING.
- CONCRETE FILL.
- 1" EXP. JOINT. PREMOLOD MATERIAL.
- EXCAVATE AS SHOWN, PLACE AND COMPACT BASE COURSE MATERIAL TO 95% MODIFIED PROCTOR.
- #4 x 10' LONG DOBELS @ 8" O.C. DIRECTION - AT 14" O.C. 12-5 DIR.
- #4 x 8' LONG REBAR ANCHOR WELDED TO PIPE SLEEVES.
- #5 @ 12" O.C. TEMPERATURE REINFORCING.
- 3/16" STEEL PL.

26 10550481

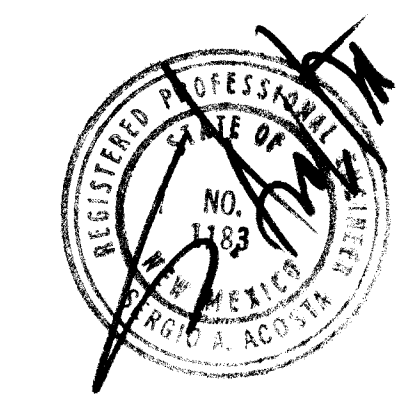

CITY OF ALBUQUERQUE MUNICIPAL DEVELOPMENT DEPARTMENT ENGINEERING DIVISION			
TITLE: COPPER CHANNEL AT MONTE ALTO DR. CONG. BRIDGE CONSTRUCTION DETAILS			
NO.	DATE	REVISIONS	ENGINEER
1	4/24/96	1	EMMETT
2	5/1/96	2	EMMETT
3	5/1/96	3	EMMETT
4	5/1/96	4	EMMETT

SHAWING NO. 1055 K23 SHEET 4 OF 5

T-48

