


COPPER AVENUE N.W.

WIDENING BETWEEN 4TH. ST. & 5TH. ST. N.W.

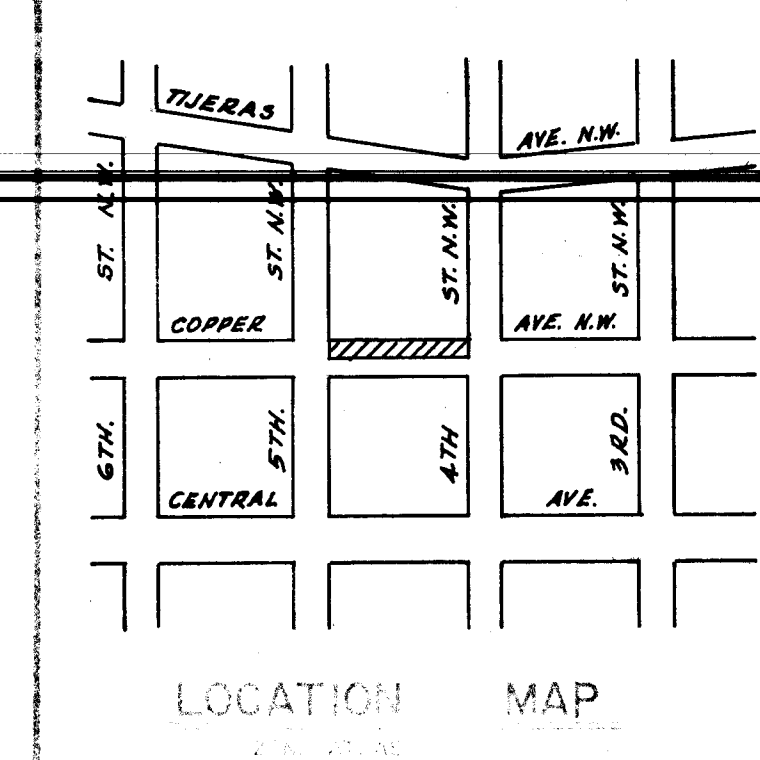

INDEX	
SHEET	TITLE
1.	TITLE SHEET
2.	PLAN

"NOTICE TO CONTRACTORS"

1. New Mexico Standard Specifications for Public Works Construction - 1959 Edition will be referred to herein as the "Standard Specification."
2. All work intended to be performed under contract shall, except as otherwise stated or provided for herein, be constructed in accordance with the Standard Specifications for City-Wide Utilities and Sanitation No. 30, and the Standard Specification No. 31.
3. Two working days prior to any excavation, contractor must contact Line Locating Service, 765-1234, for location of existing utilities.
4. Prior to construction, the contractor shall excavate and verify the horizontal and vertical locations of all existing utilities. Should a conflict exist, the contractor shall notify the Engineer or Surveyor so that the conflict can be resolved with minimum amount of delay.

THE FOLLOWING NOTES APPLY WHEN CHECKED

- ☒ All utilities and utility service lines shall be relocated prior to starting.
- ☒ Backfill operations shall be according to specified methods (Arterial Section).
- ☒ Backfill requirements shall be determined by the City Engineer.
- ☒ Curb and wheelcurb ramps within the curb returns shall be constructed whenever a new curb return is constructed.
- ☒ Curb and wheelcurb ramps shall be constructed prior to completion of the curb and gutter.
- ☒ All storm drainage facilities shall be completed prior to final acceptance.

APPROVAL OF AS BUILT DRAWINGS
ASST. CITY ENGINEER-FIELD
<i>[Signature]</i>
DATE: 5-12-81

1	2	3	4	5	6	7	8	9	10	11	12
2	0	1	0	5	6	0	1	8	2		

APPROVED FOR CONSTRUCTION
<i>[Signature]</i> 5/15/81


DRAWING NO.

1056

SHEET	OF
1	2




1. INSTALL 2" P.V.C. UNDER NEW SIDEWALK, 18" BELOW GRADE.
2. TRAFFIC SIGNAL INTERCONNECT WITH NYLON PULL CORD.
3. INSTALL PULL BOXES AT 150' INTERVALS FROM SIGNAL FOUNDATION TO SIGNAL FOUNDATION.

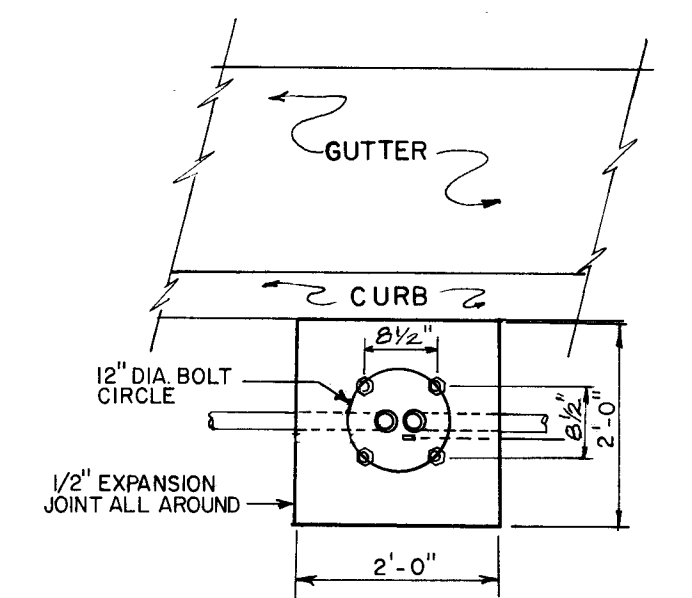

 NEW SIDEWALK BY THE CITY

 NEW ARTERIAL PAVING

- | | T.C. | F.L. |
|---|-------|-------|
| 1 | 52.07 | 51.40 |
| 2 | 52.09 | 51.42 |
| 3 | 52.12 | 51.45 |

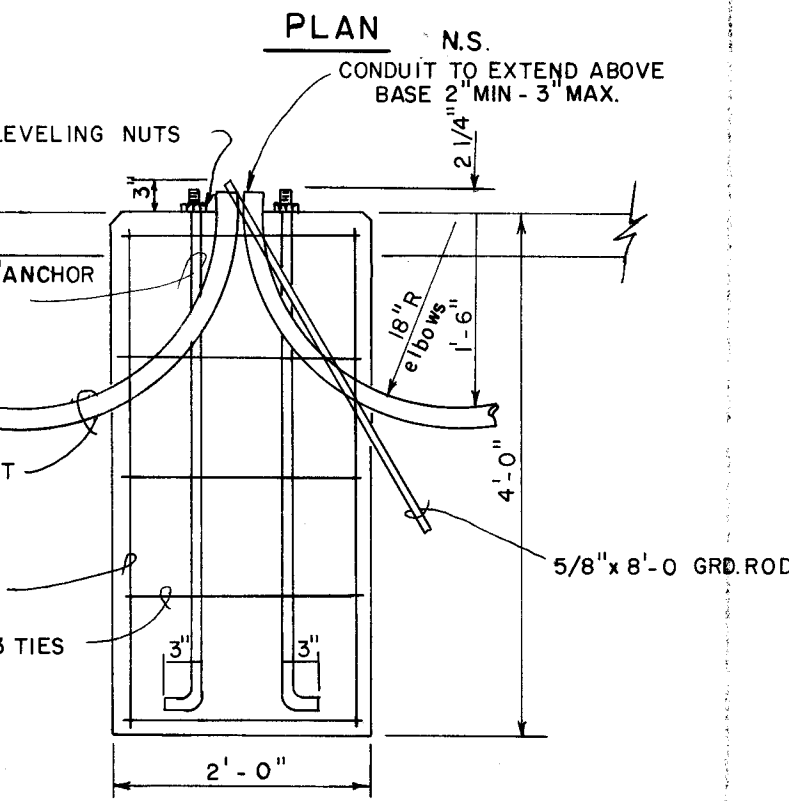

SECTION
STREET LIGHT BASE DETAIL

	T.C.	F.L.
1	52.07	51.40
2	52.09	51.42
3	52.12	51.45

TWO WORKING DAYS PRIOR TO ANY EXCAVATION CONTRACTOR MUST CONTACT LINE LOCATING SERVICE, 714-4234, FOR LOCATION OF EXISTING UTILITIES.

NOTICE TO CONTRACTOR
 PAVING IS REQUIRED FOR DRIVEWAY.
 THE DRIVEWAY SHALL BE CONSTRUCTED
 PRIOR TO ACCEPTANCE OF THE CURB &
 GUTTER

NOTICE TO CONTRACTOR
PRIOR TO EXCAVATION, THE CONTRACTOR SHALL EXCAVATE AND VERIFY THE HORIZONTAL AND VERTICAL LOCATIONS OF ALL OBSTRUCTIONS. SHOULD A CONFLICT EXIST, THE CONTRACTOR SHALL NOTIFY THE ENGINEER OR SURVEYOR SO THAT THE CONFLICT CAN BE RESOLVED WITH A MINIMUM AMOUNT OF DELAY.

COPPER AVE. WIDENING BETWEEN
FOURTH ST. AND FIFTH ST. N.W.

DRAWING NO.	I056	MAG. NO.	K-14	SHEET	2	OF	2
-------------	------	----------	------	-------	---	----	---