

CHANNELIZATION
MADEIRA DR. AT COPPER AVE.

"NOTICE TO CONTRACTORS"

- 1.) New Mexico Standard Specifications for Public Works Construction - 1979 Edition will be referred to hereon as the "Standard Specification."
- 2.) All work detailed on these plans to be performed under contract shall, except as otherwise stated or provided for hereon, be constructed in accordance with "Contract Documents for City-Wide Utilities and Cash Paving No. 29" and the Standard Specification."
- 3.) Two working days prior to any excavation, contractor must contact Line Locating Service, 765-1234, for location of existing utilities.
- 4.) Prior to construction, the contractor shall excavate and verify the horizontal and vertical locations of all obstructions. Should a conflict exist, the contractor shall notify the engineer or surveyor so that the conflict can be resolved with minimum amount of delay.

THE FOLLOWING NOTES APPLY WHEN CHECKED

- ☐ All utilities and utility service lines shall be installed prior to paving.
- ☒ Backfill compaction shall be according to specified street use.
- ☒ Tack coat requirements shall be determined by the City Engineer.
- ☒ Sidewalks and wheelchair ramps within the curb returns shall be constructed wherever a new curb return is constructed.
- ☒ If curb is depressed for a driveway, the driveway shall be constructed prior to acceptance of the curb and gutter.
- ☐ All storm drainage facilities shall be completed prior to final acceptance.

APPROVAL OF AS BUILT DRAWINGS											
ASSISTANT CITY ENGINEER - FIELD											
<i>[Signature]</i>											
DATE 7/5/82											


1	2	3	4	5	6	7	8	9	10	11	12
26	1	0	5	9	0	1	8	2			

APPROVED FOR CONSTRUCTION	<i>[Signature]</i>	8/19/82
CITY ENGINEER		DATE

DRAWING NO.

1059

SHEET 1 OF 2

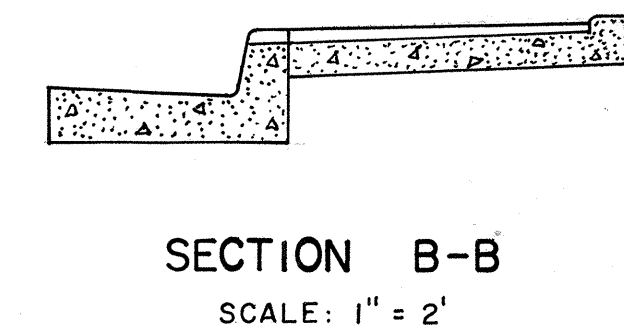

1	2	3	4	5	6	7	8	9	10	11	12
2	6		1	0	5	9	0	2	8	2	

CITY OF ALBUQUERQUE PUBLIC WORKS DEPARTMENT ENGINEERING DIVISION						GD 80-5
TITLE: CHANNELIZATION, MADEIRA DR. AT COPPER AVE.						
APPROVALS	ENGINEER	DATE	APPROVALS	ENGINEER	DATE	
City Engineer	<i>[Signature]</i>	18 Mar 81	Liquid Waste	<i>[Signature]</i>	3/19/81	
A.C.E.-Design (M)			Traffic			
A.C.E.-Hydrology			Water			
DRAWING NO.			SHEET 2 OF 2			