


SCANNED
BY LASON

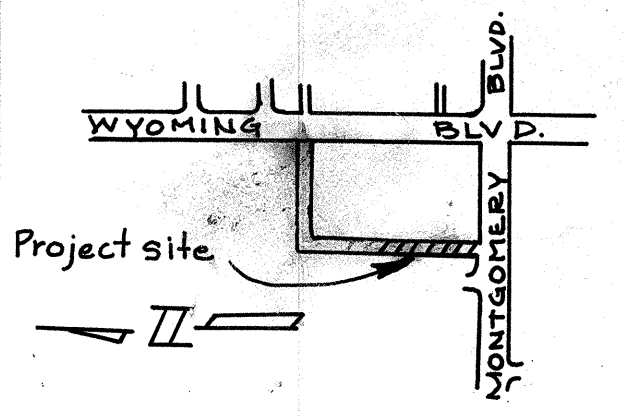

LOCATION MAP
ZONE ATLAS F-19

LOS PASTORES SHOPPING CENTER

MONTGOMERY & WYOMING
ALLEY PAVING
FROM STA. 20+14.3 TO STA. 22+88.8

NOTICE TO CONTRACTORS

- 1.) New Mexico Standard Specifications for Public Works Construction - 1979 Edition will be referred to hereon as the "Standard Specification."
- 2.) All work detailed on these plans to be performed under contract shall, except as otherwise stated or provided for hereon, be constructed in accordance with "Contract Documents for City-Wide Utilities and Cosh Paving No. 30" and the Standard Specification."
- 3.) Two working days prior to any excavation, contractor must contact Line Locating Service, 765-1234, for location of existing utilities.
- 4.) Prior to construction, the contractor shall excavate and verify the horizontal and vertical locations of all obstructions. Should a conflict exist, the contractor shall notify the engineer or surveyor so that the conflict can be resolved with minimum amount of delay.

THE FOLLOWING NOTES APPLY WHEN CHECKED

- ☒ All utilities and utility service lines shall be installed prior to paving.
- ☒ Backfill compaction shall be according to specified street use.
- ☒ Tack coat requirements shall be determined by the City Engineer.
- ☐ Sidewalks and wheelchair ramps within the curb returns shall be constructed whenever a new curb return is constructed.
- ☐ If curb is depressed for a driveway, the driveway shall be constructed prior to acceptance of the curb and gutter.
- ☐ All storm drainage facilities shall be completed prior to final acceptance.

ALL SHEETS
APPROVAL OF AS BUILT DRAWINGS
ASST. CITY ENGINEER-FIELD
[Signature]
DATE 5-8-82

1 2 3 4 5 6 7 8 9 10 11 12
26 10640182

