


"NOTICE TO CONTRACTORS"

- 1) New Mexico Standard Specifications for Public Works Construction - 1979 Edition will be referred to hereon as the "Standard Specification."
- 2) All work detailed on these plans to be performed under contract shall, except as otherwise stated or provided for hereon, be constructed in accordance with "Contract Documents for City-Wide Utilities and Cash Paving No. 21" and the Standard Specification."
- 3) Two working days prior to any excavation, contractor must contact Line Locating Service, 765-1234, for location of existing utilities.
- 4) Prior to construction, the contractor shall excavate and verify the horizontal and vertical locations of all obstructions. Should a conflict exist, the contractor shall notify the engineer or surveyor so that the conflict can be resolved with minimum amount of delay.

CONSTRUCTION PLANS FOR CITY PARK HANDICAPPED RAMPS ALBUQUERQUE, NEW MEXICO

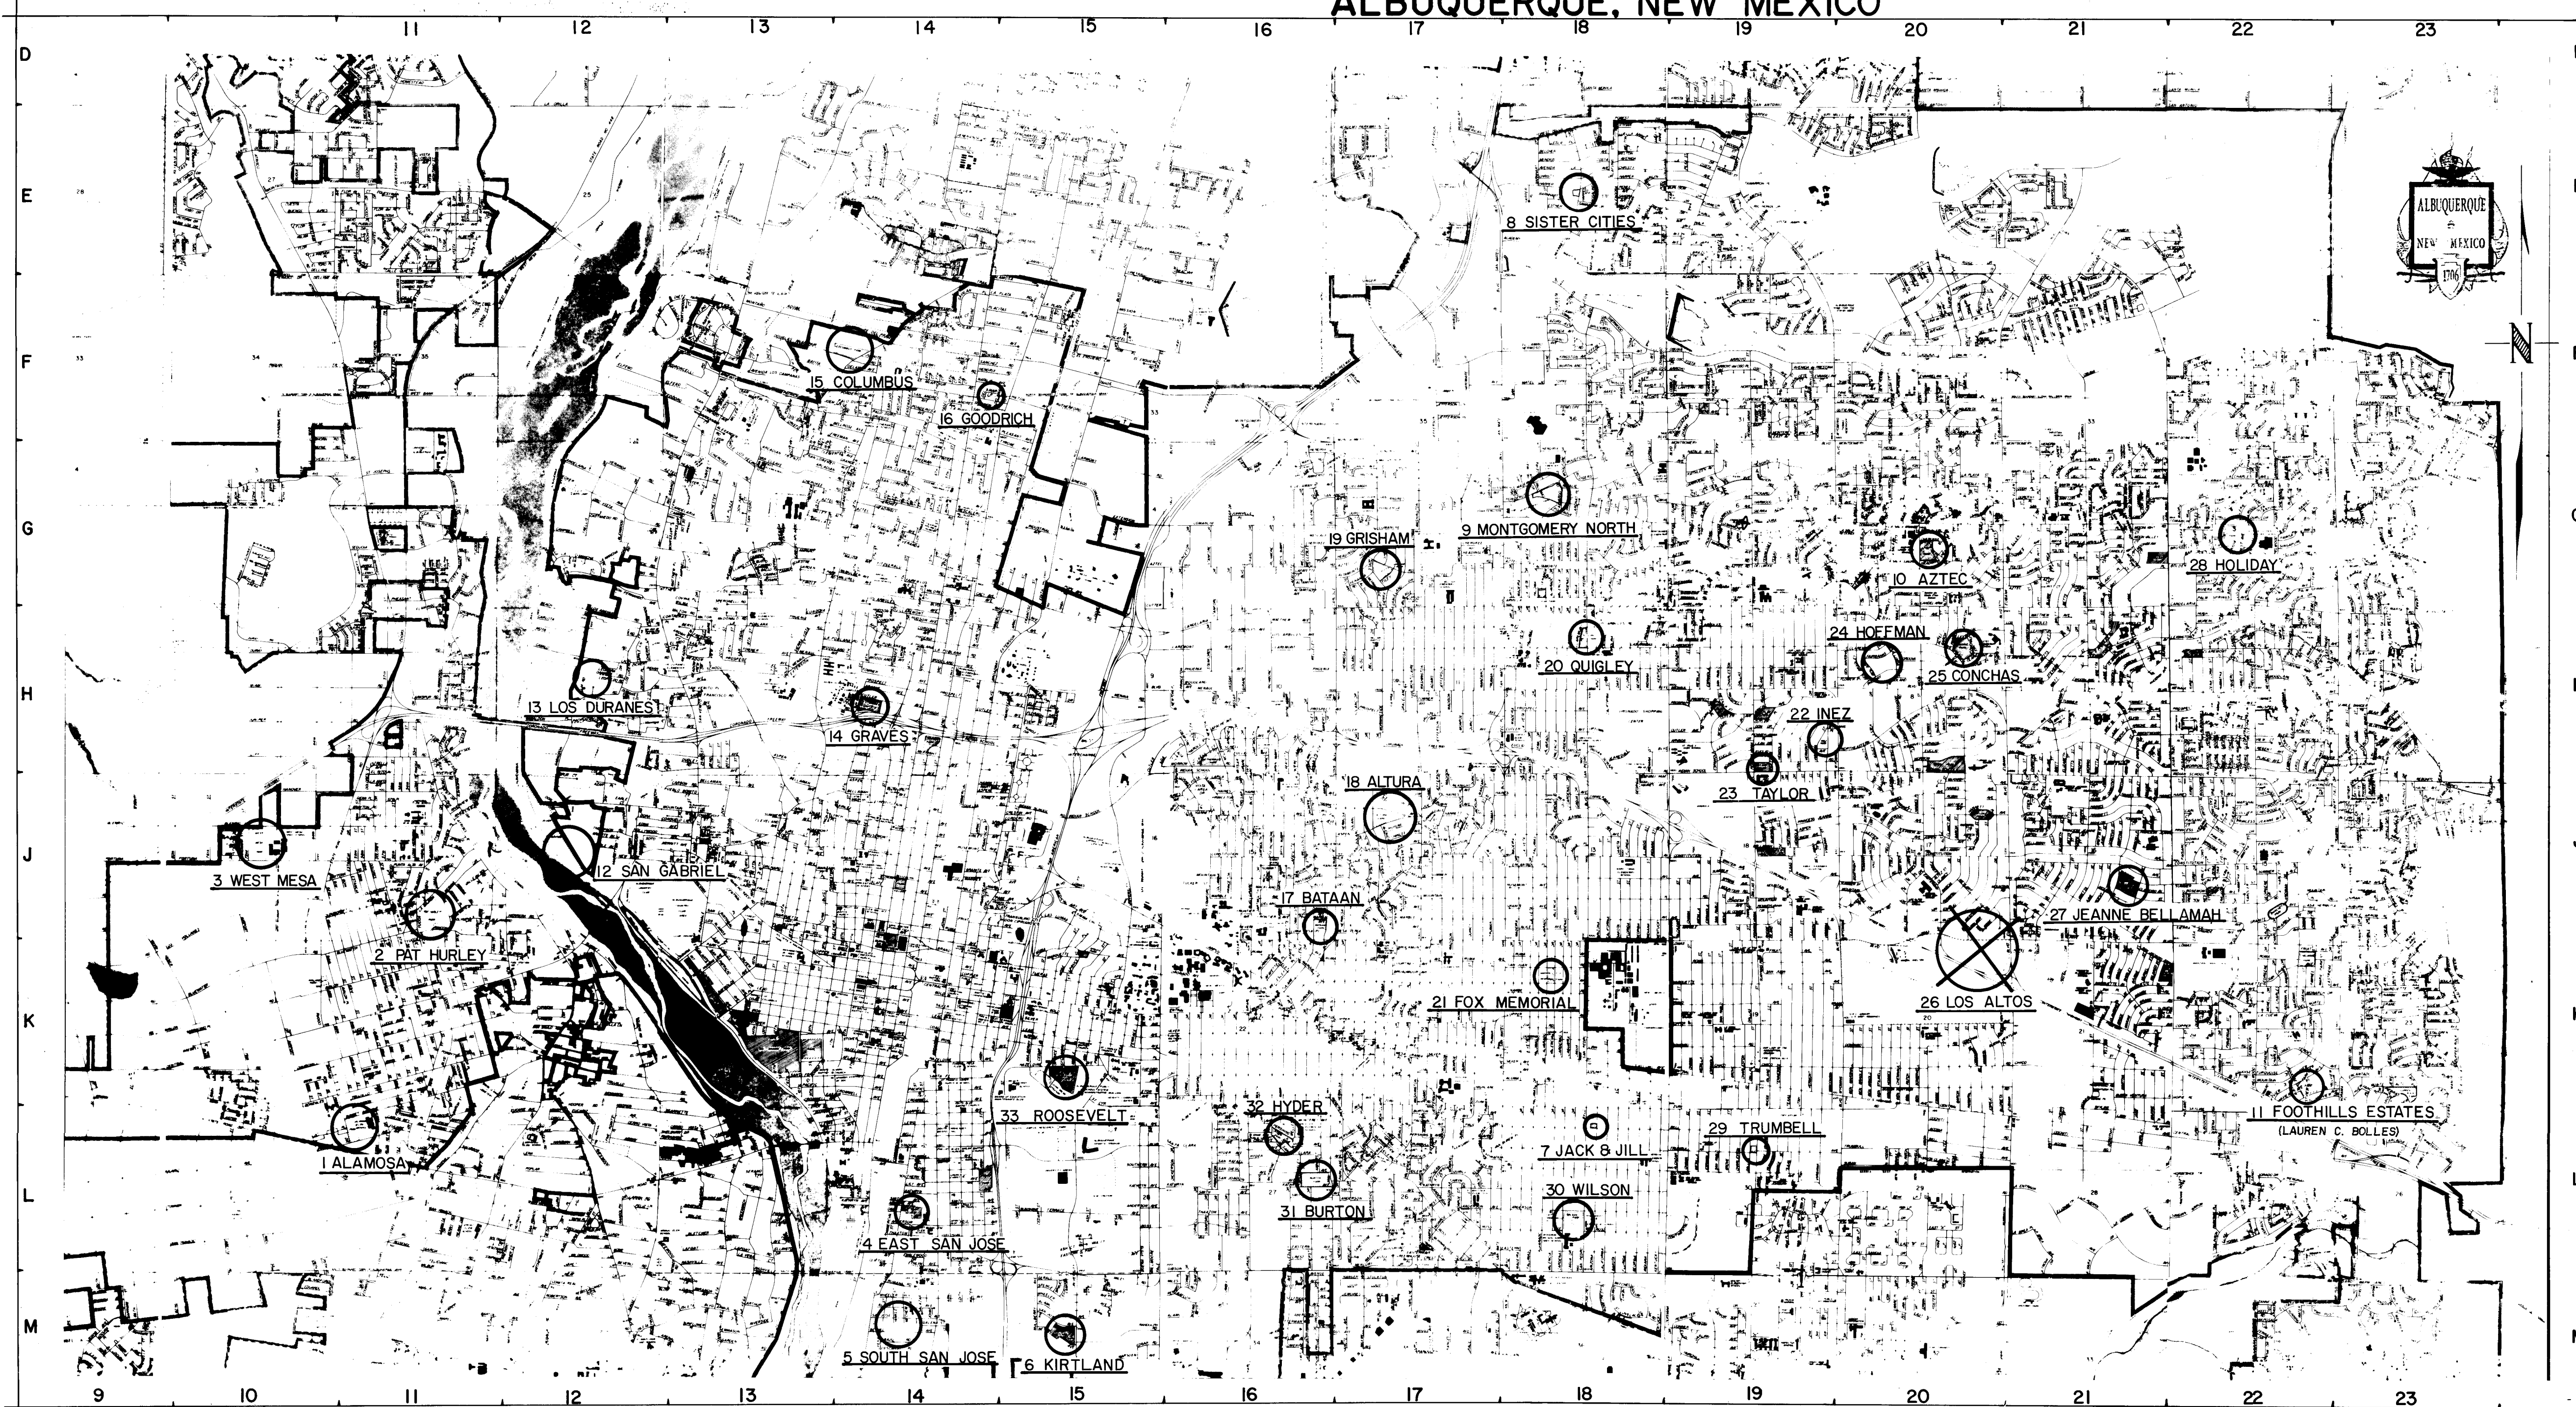

INDEX TO DRAWINGS

SHEET	DESCRIPTION
-------	-------------

SHEET	VICINITY MAP		
	PARK NUMBER	PARK NAME	MAP NUMBER
1	1	ALAMOSA	L-11
	2	PAT HURLEY	J-11
	3	WEST MESA	J-10
	4	EAST SAN JOSE	L-14
	5	SOUTH SAN JOSE	M-14
	6	KIRTLAND	M-15
2	7	JACK & JILL	L-13
	8	SISTER CITIES	E-13
	9	MONTGOMERY NORTH	G-16
	10	AZTEC	G-20
	11	FOOTHILLS ESTATES (LAUREN C. BOLLES)	K-22
	12	SAN GABRIEL	J-12
3	13	LOS DURANES	H-12
	14	GRAVES	H-14
	15	COLUMBUS	F-14
	16	GOODRICH	F-14
	17	BATAAN	J-10
	18	ALTURA	J-17
4	19	GRISHAM	G-17
	20	QUIGLEY	H-11
	21	FOX MEMORIAL	K-15
	22	INEZ	H-19
	23	TAYLOR	H-19
	24	HOFFMAN	H-20
5	25	CONCHAS	H-22
	26	LOS ALTOS	K-20
	27	JEANNE BELLAMAH	J-21
	28	HOLIDAY	G-27
	29	TRUMBELL	L-19
	30	WILSON	L-18
6	31	BURTON	L-18
	32	HYDER	L-16
	33	ROOSEVELT	K-15

ALL SHEETS
APPROVAL OF AS-BUILT DRAWINGS
BY THE ENGINEER FIELD
3-12-82

PREPARED UNDER THE SUPERVISION OF

Jerry D. Hart

11/10/80



FOR MEURER, SERAFINI AND MEURER, INC.

APPROVALS	ENGINEER	DATE
City Engineer	<i>[Signature]</i>	3/15/81
A.C.E.-Design	<i>[Signature]</i>	2/24/81
Traffic	<i>[Signature]</i>	3/11/81
Parks Dept.	<i>[Signature]</i>	3/11/81



MEURER, SERAFINI AND MEURER, INC.

2601 WYOMING BOULEVARD, N.E. • ALBUQUERQUE, NEW MEXICO 87110

(505) 292-1936 • A GENCE CO.


JOB NO. 0690030

GENERAL NOTES:


1. AFTER CONSTRUCTION, THE AS-BUILT RAMP LOCATION SHALL BE REFERENCED TO EXISTING PERMANENT FACILITIES SUCH AS STREET CENTERLINE, CURB RETURNS, PROPERTY LINES, ETC. (EXCLUDE: FIRE HYDRANTS, PP'S, TREES)
2. MANY OF THE LOCATIONS ARE IN AREAS OF ADJACENT IRRIGATION SYSTEMS. PARKS MAINTENANCE DIVISION WILL COMPLETE ANY NECESSARY RELOCATION PRIOR TO CONSTRUCTION. THE CONTRACTOR WILL BE OBLIGED TO KEEP THE CITY ENGINEER'S INSPECTOR INFORMED WELL IN ADVANCE OF PLANNED AREAS OF CONSTRUCTION IN ORDER TO COORDINATE PARKS DEPARTMENT WORK.
3. CONTRACTOR SHALL SUBMIT A CONSTRUCTION SCHEDULE TO THE CITY ENGINEER BEFORE BEGINNING ANY WORK.

- 8 PHOTOS FOR PARKS ① THRU ⑩
- 9 PHOTOS FOR PARKS ⑪ THRU ③③
- 10 RAMP DETAILS
ESTIMATED QUANTITIES


26 10650182

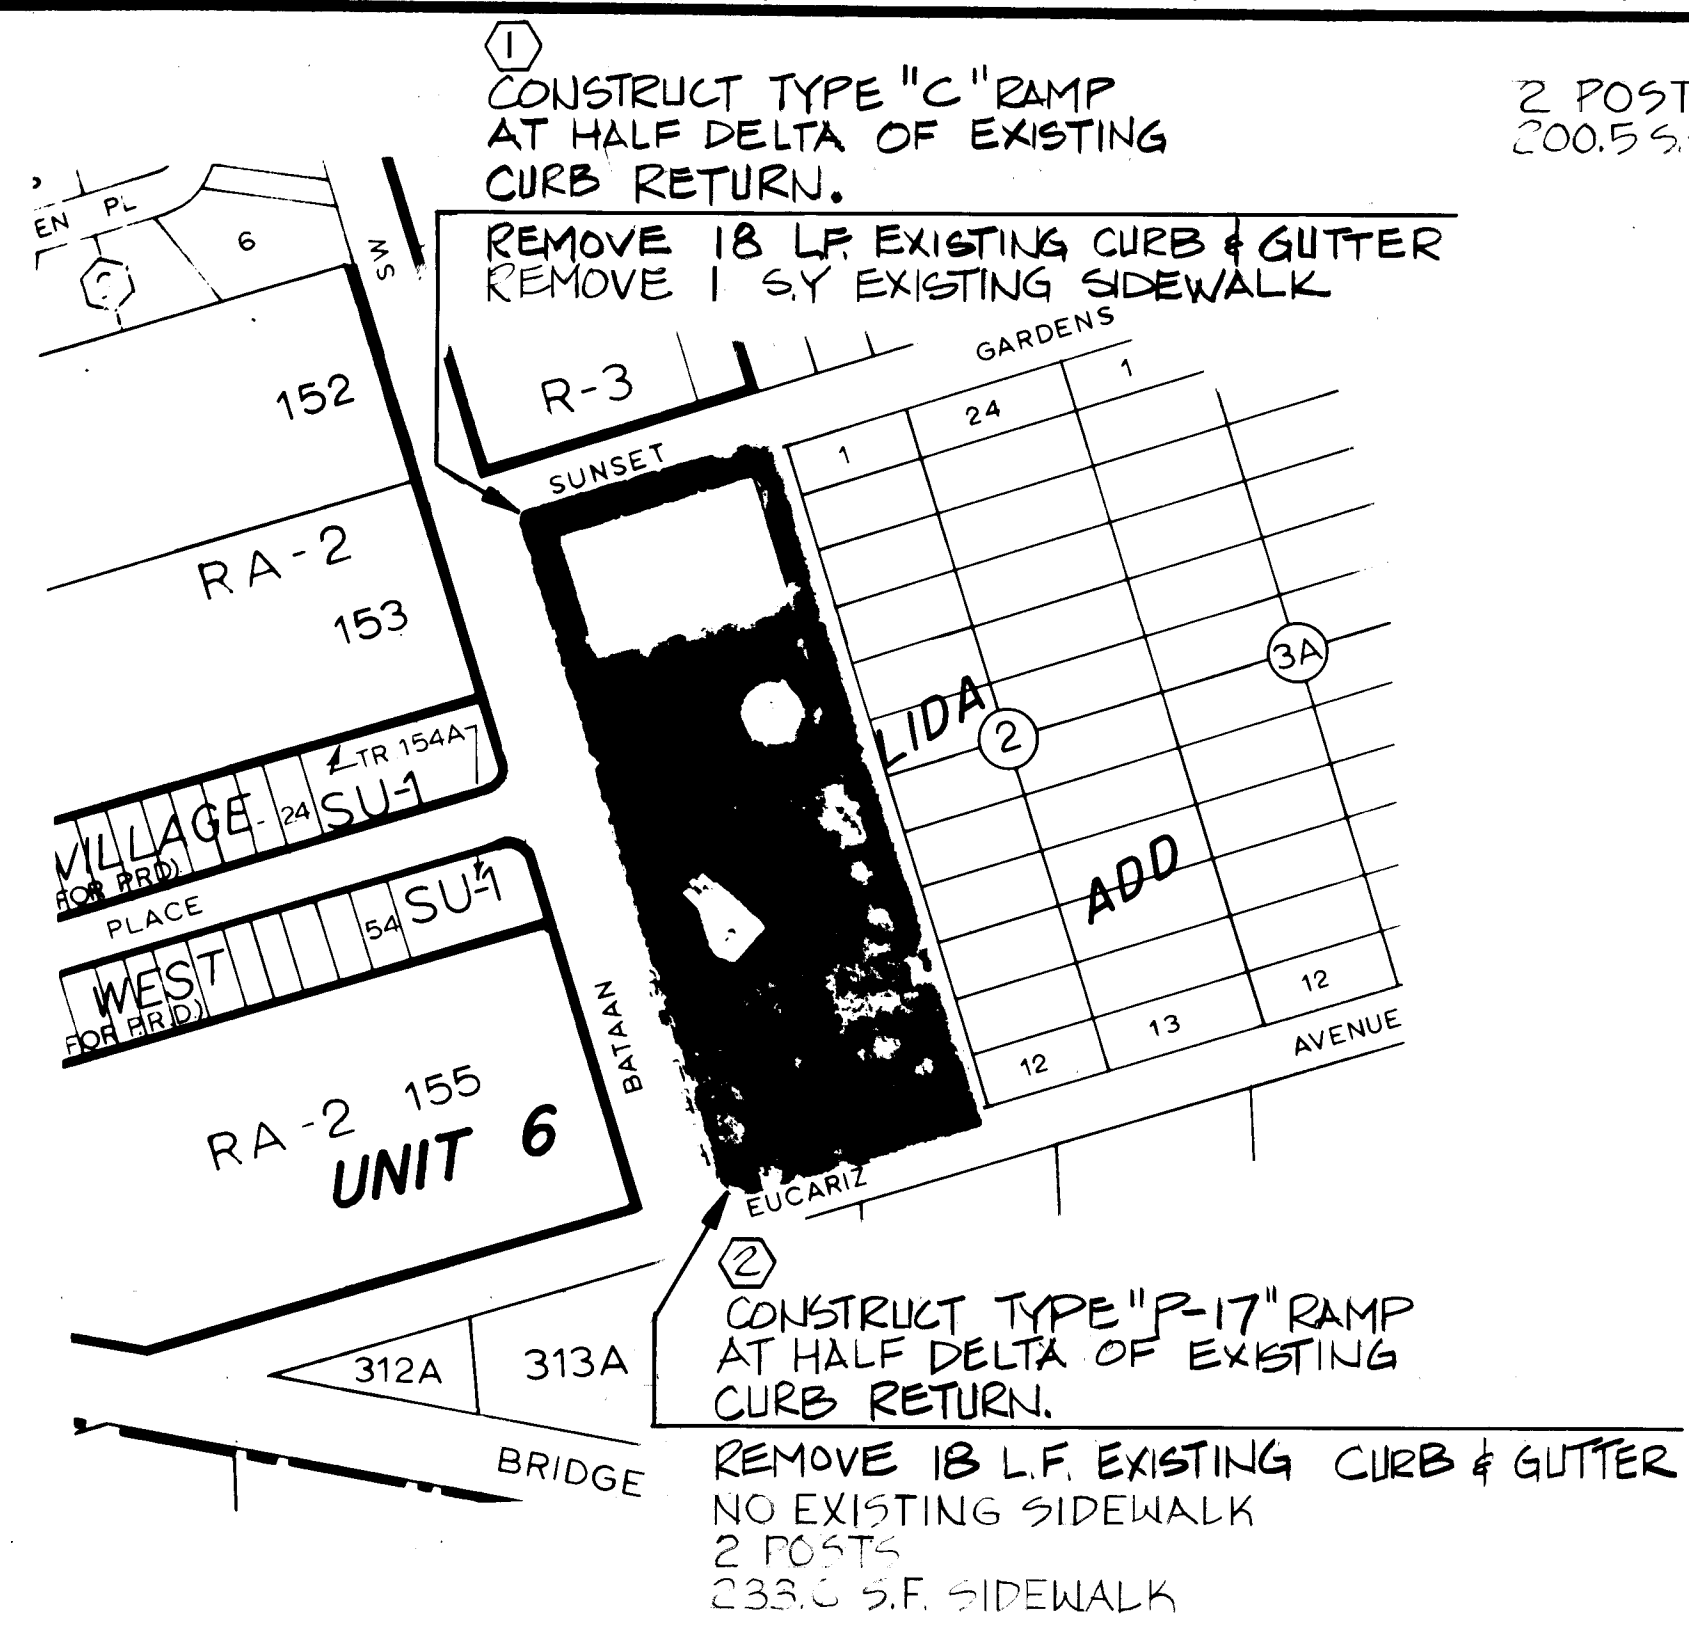


① ALAMOSA L-11

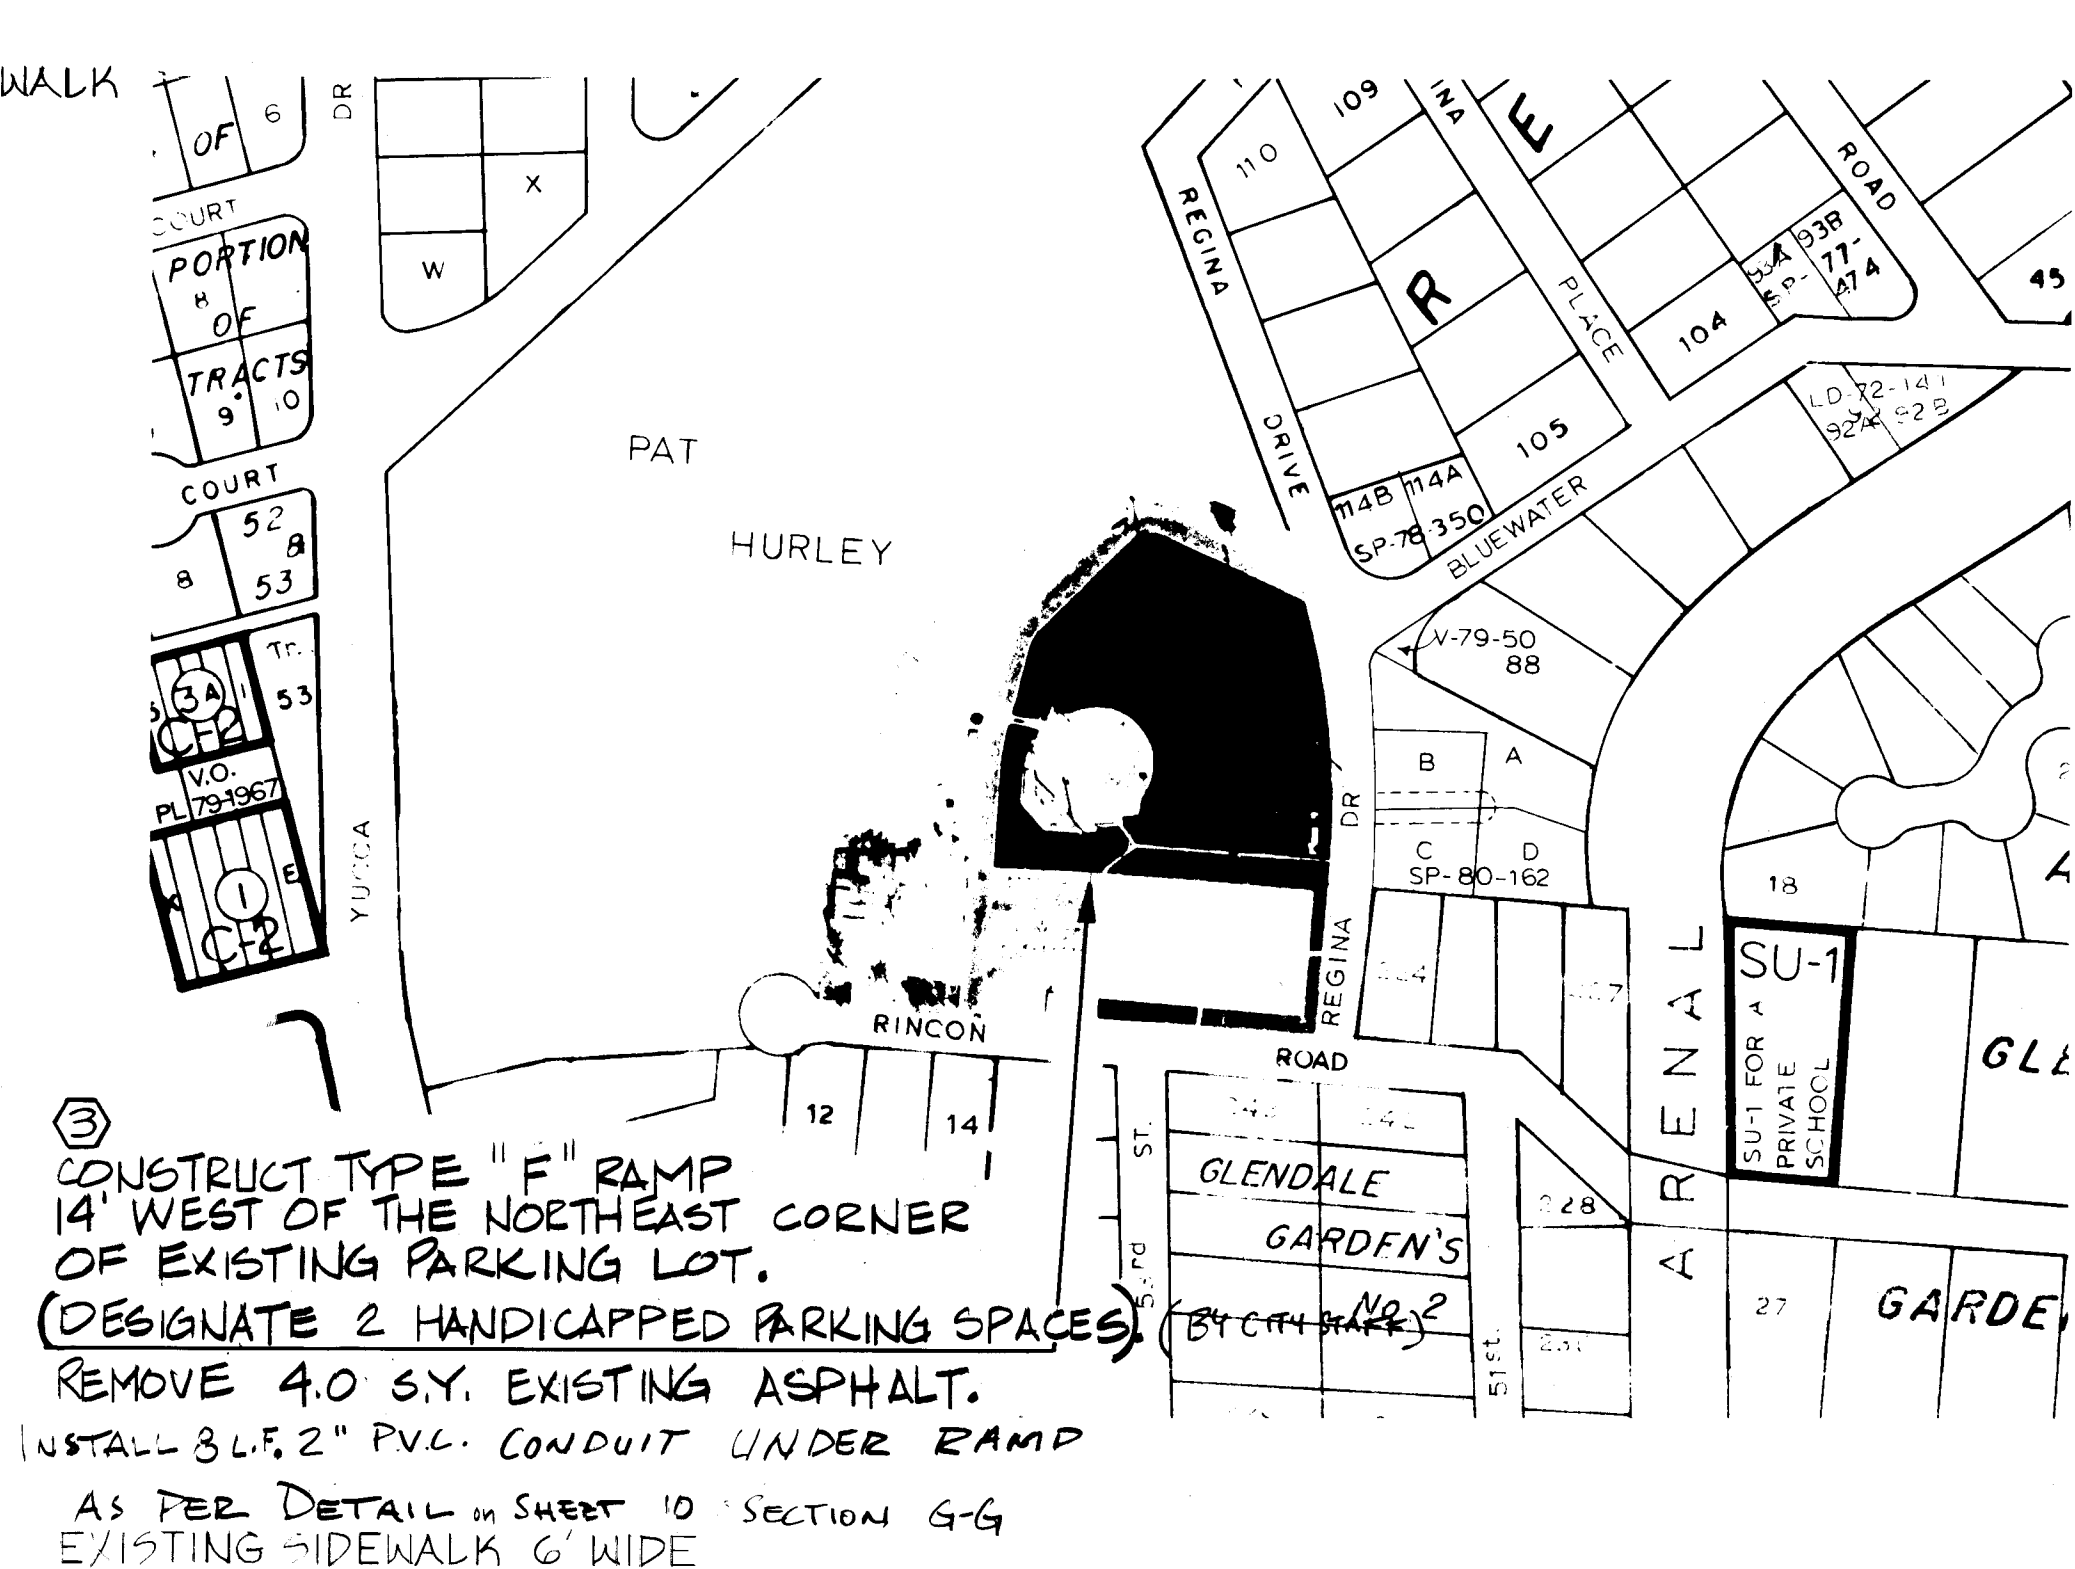


② PAT HURLEY J-11

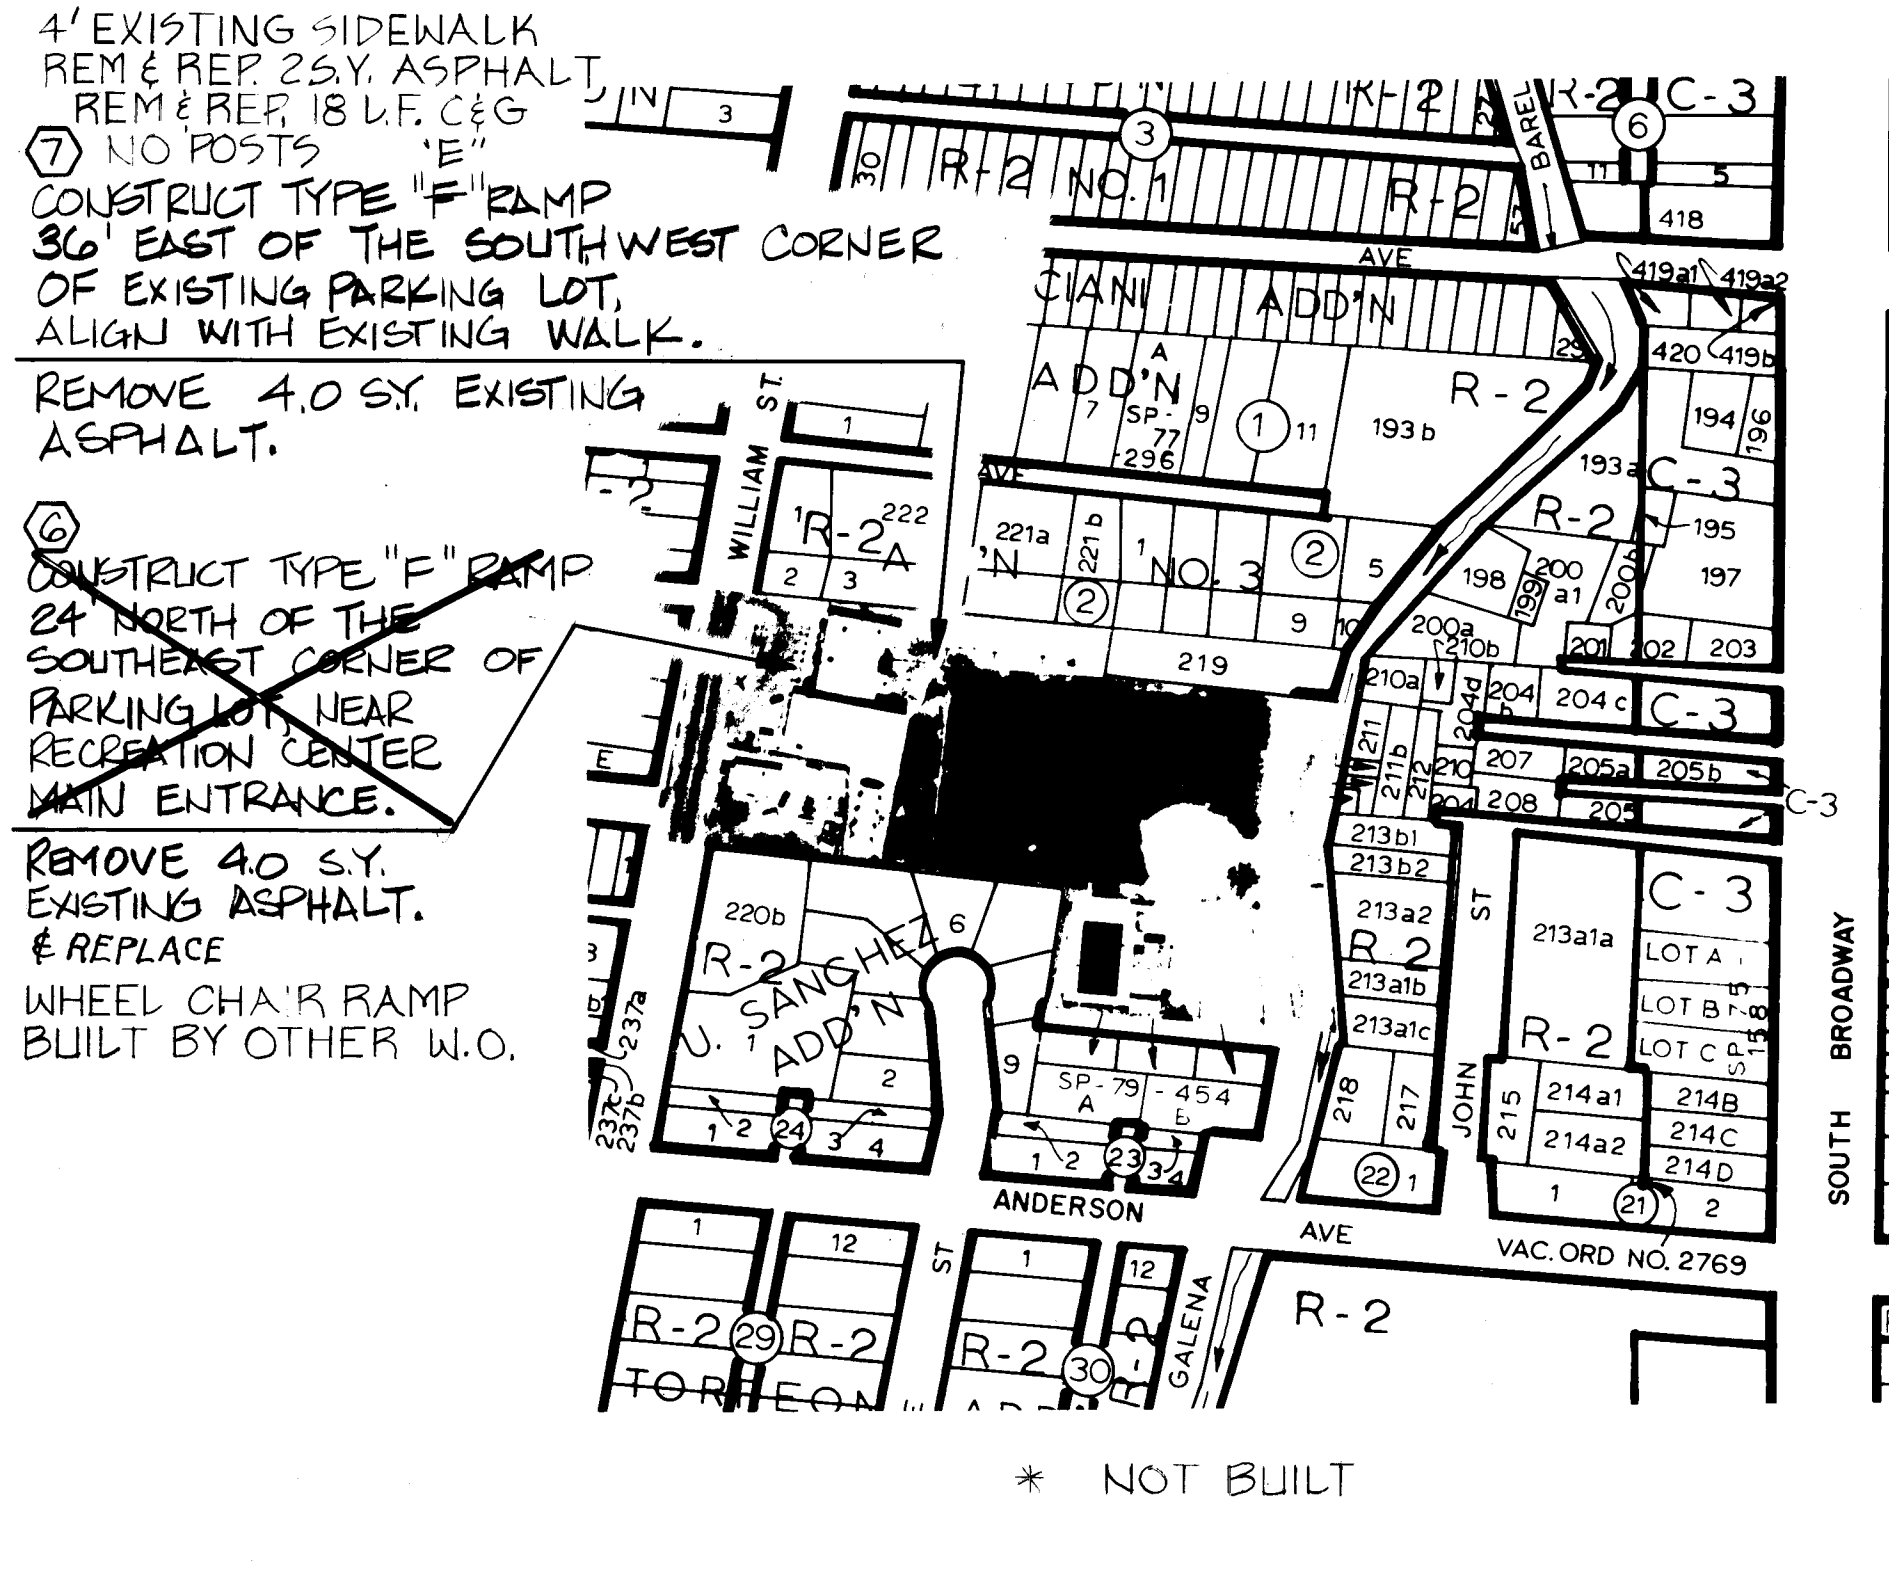


④ EAST SAN JOSE L-14

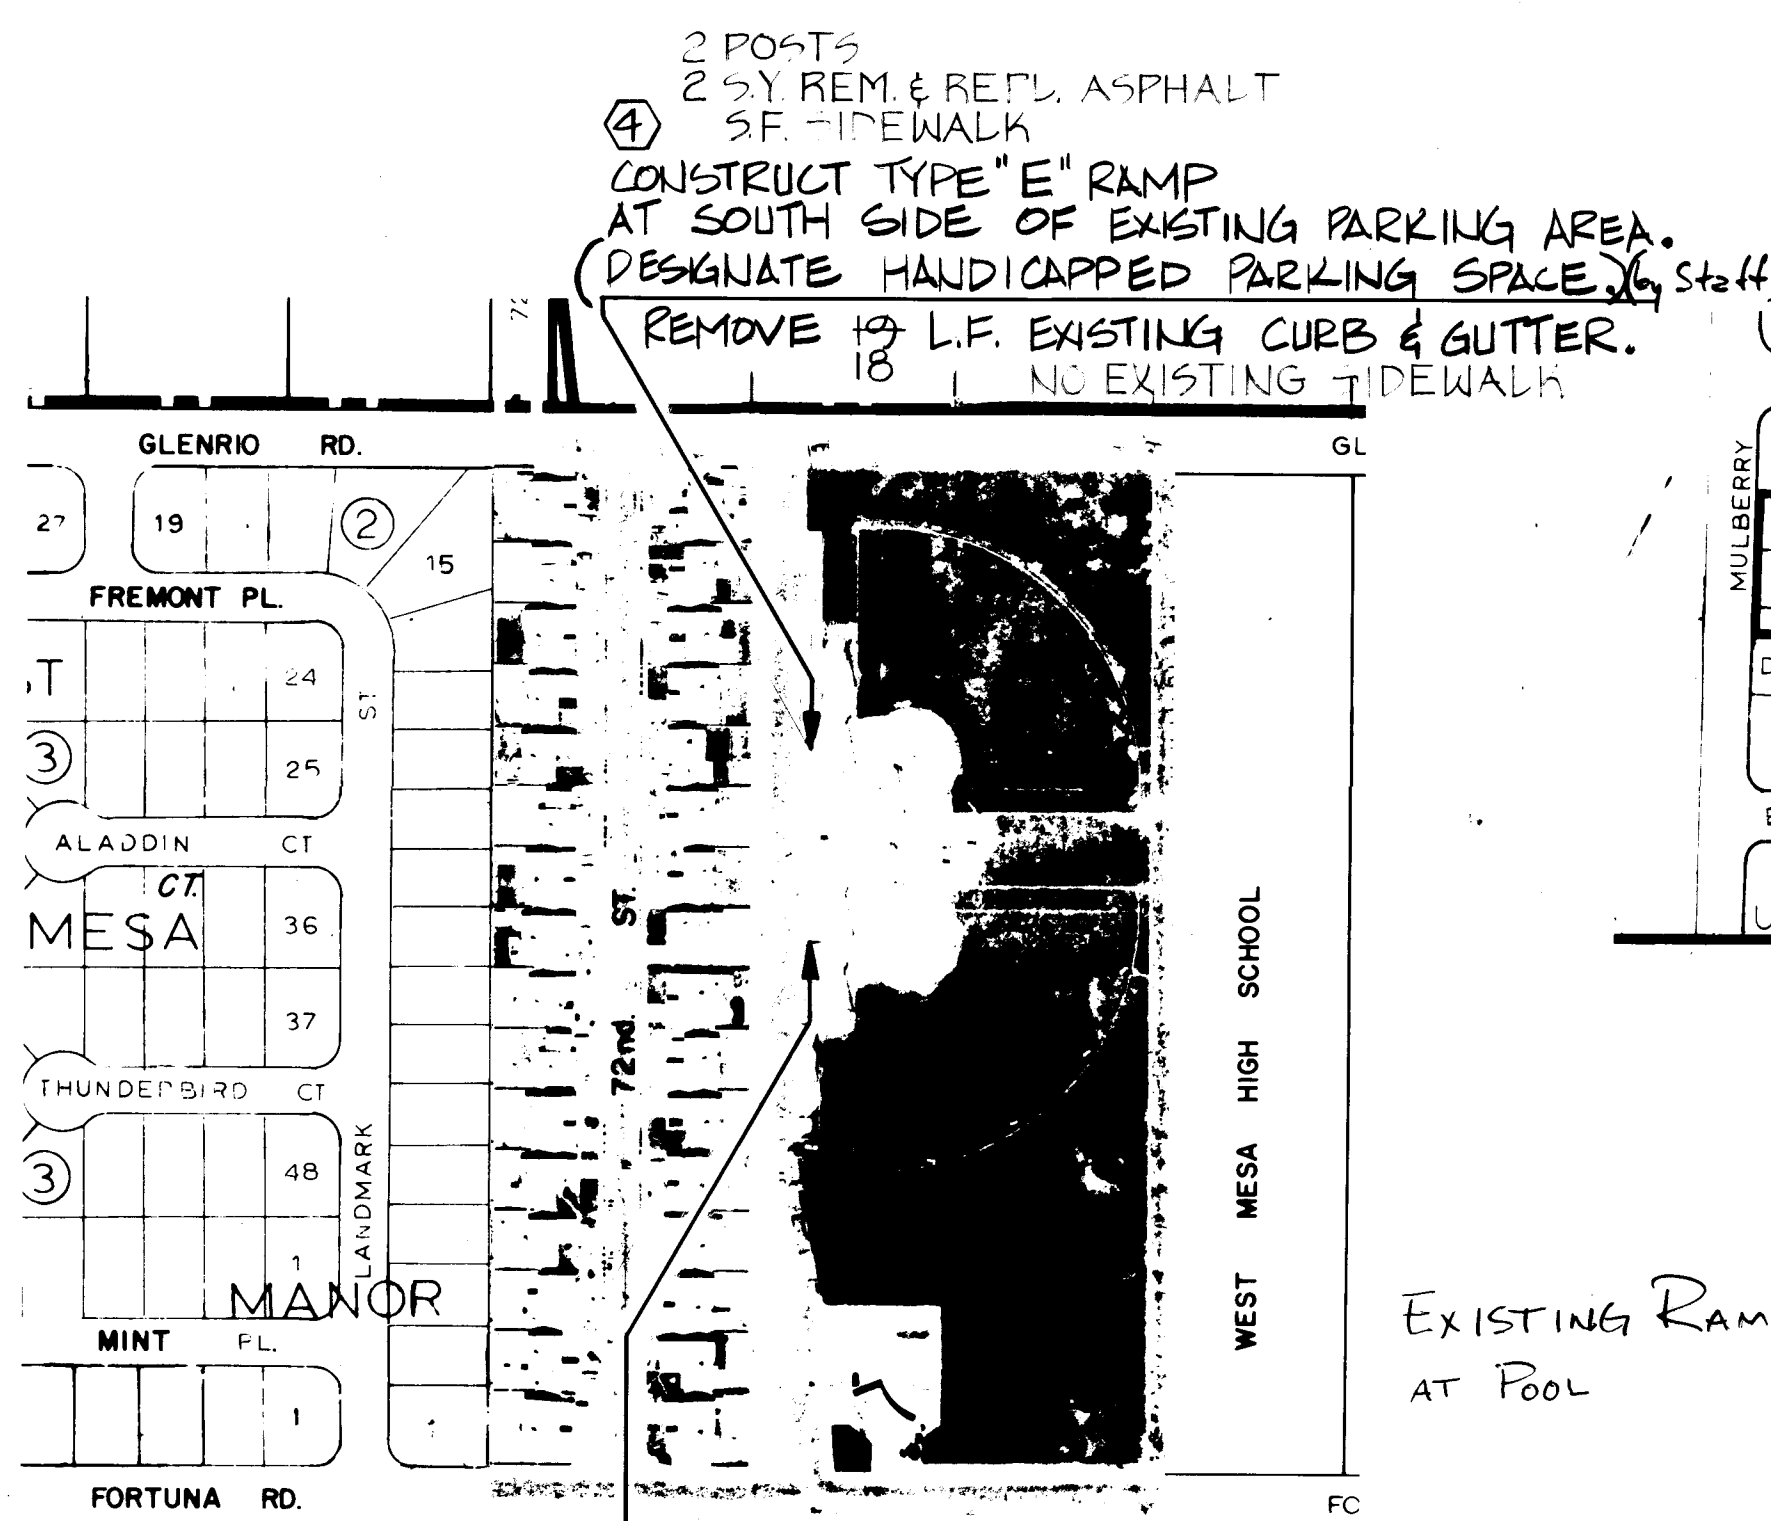

③ WEST MESA J-10

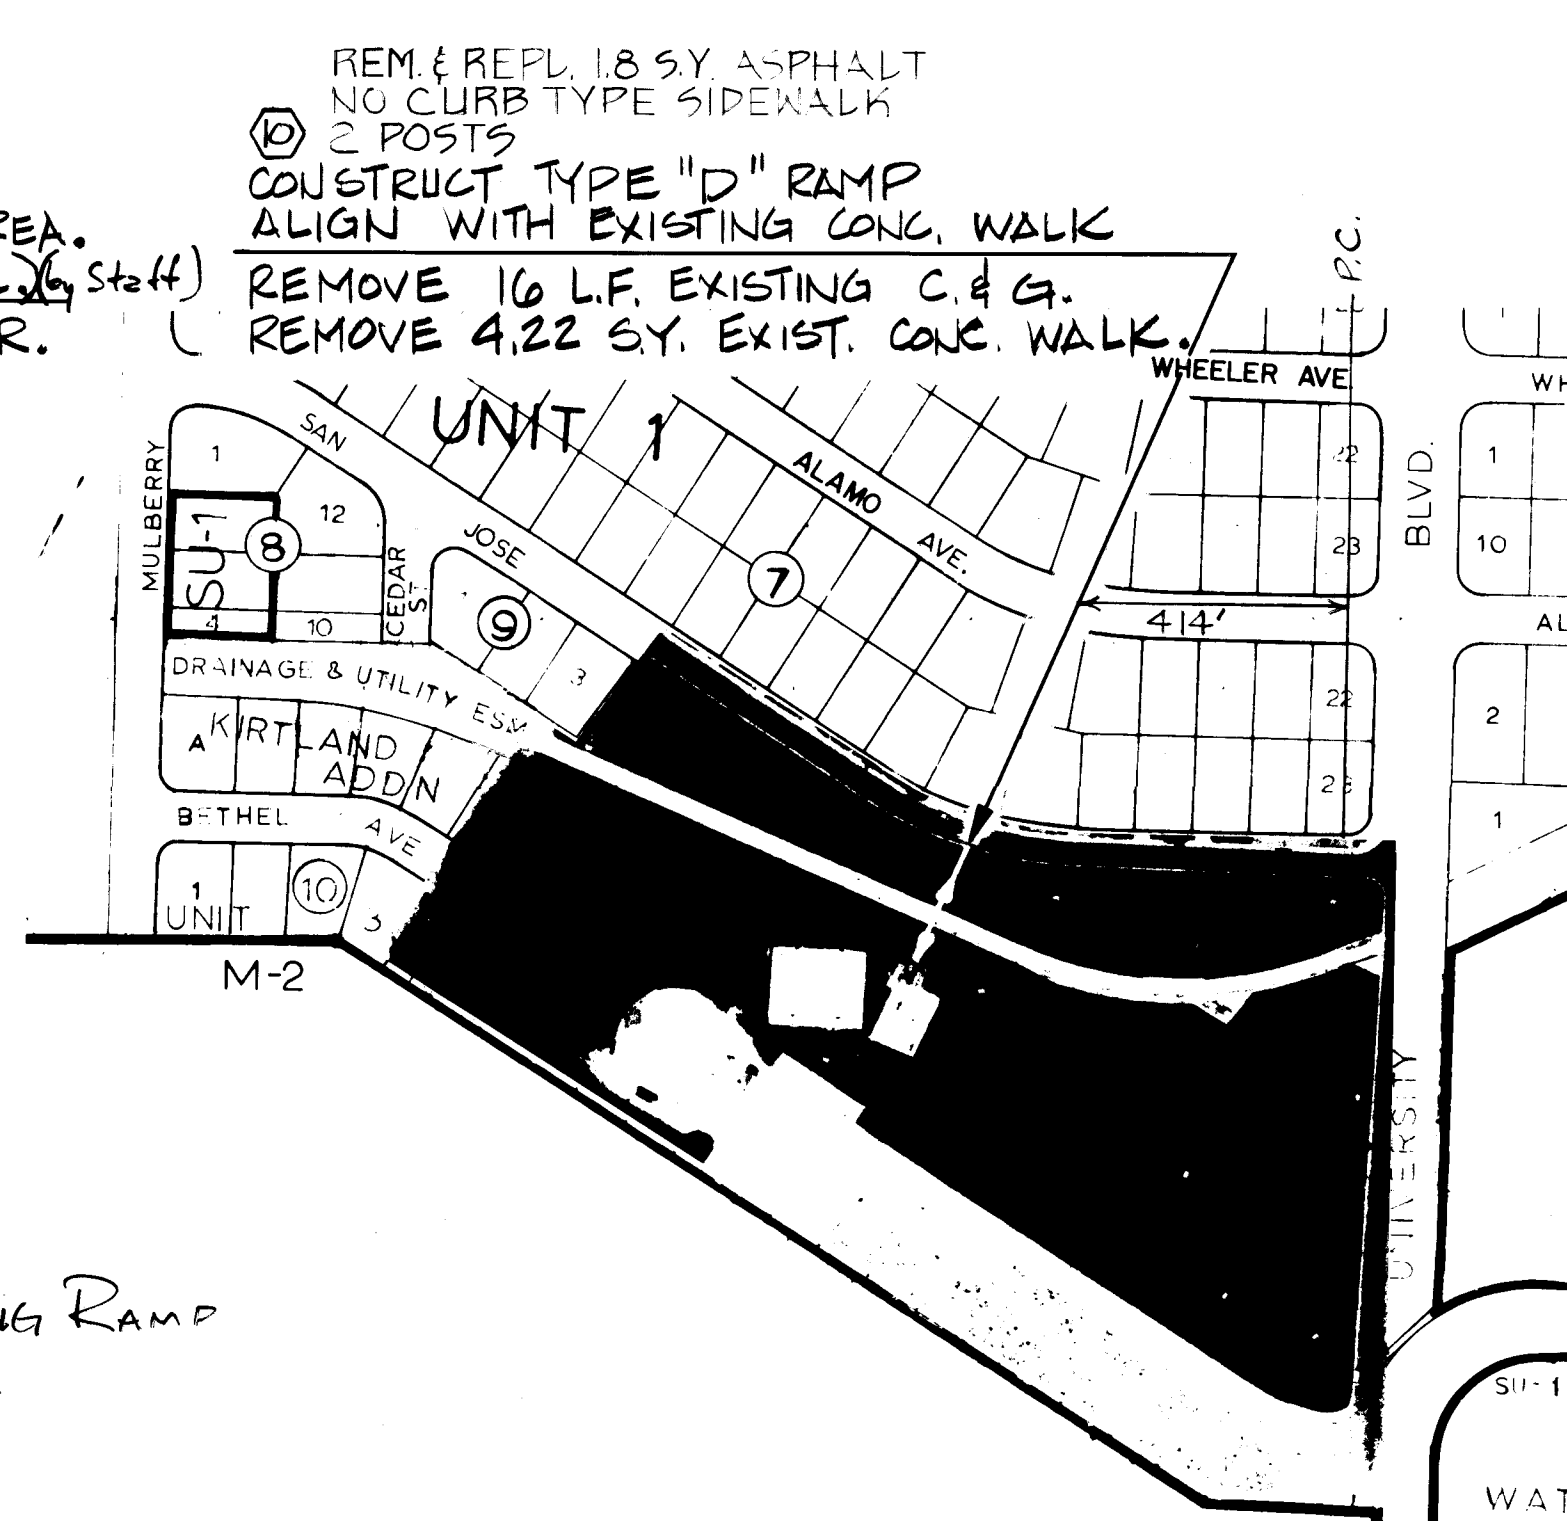

⑥ KIRTLAND M-15

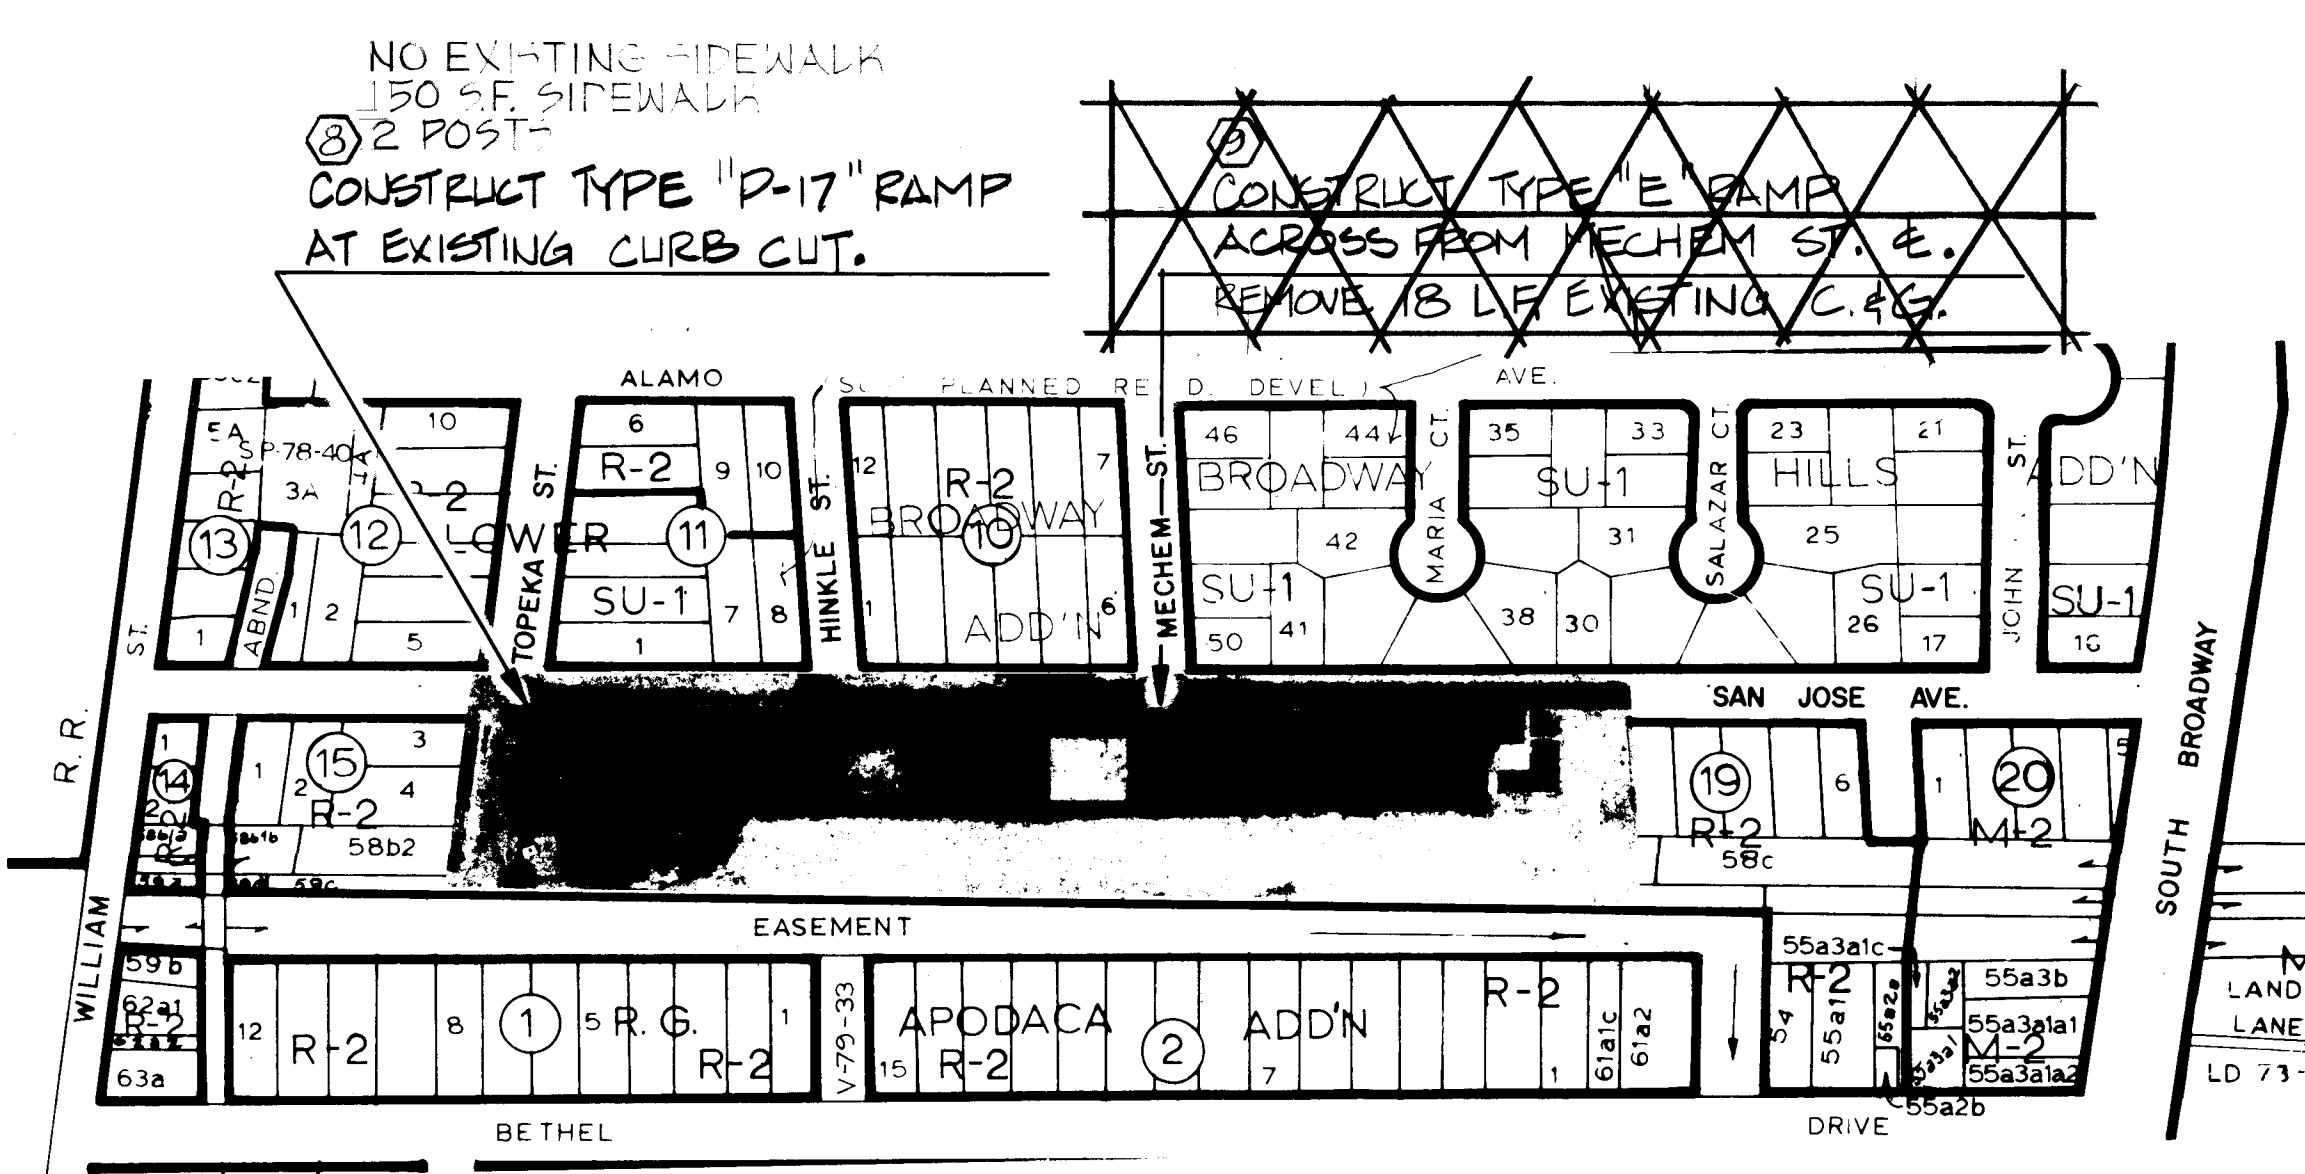

⑤ SOUTH SAN JOSE M-14

MEURER, SERAFINI AND MEURER, INC.
CONSULTING ENGINEERS - SURVEYORS - PLANNERS
2001 UNIVERSITY BLVD., N.E. SUITE 7 ALBUQUERQUE, NEW MEXICO 87112 (505) 262-1330

PLANS PREPARED UNDER THE DIRECTION OF
J. D. HART
CITY ENGINEER

CITY OF ALBUQUERQUE
MUNICIPAL DEVELOPMENT DEPARTMENT
ENGINEERING DIVISION

TITLE: CITY PARK HANDICAPPED RAMPS
PARK NUMBER ① THRU ⑥


APPROVALS	ENGINEER	DATE	APPROVALS	ENGINEER	DATE
City Engineer			Liquid Waste		N/A
A.C.E. - Design			Traffic		N/A
A.C.E. - Hydrology			Water		N/A

DESIGNED BY: D. MAIN DATE: 11-10-80
DRAWN BY: C. BLOOM DATE: 11-10-80
CHECKED BY: J.D. HART JR. DATE: 11-10-80


APPROVED FOR CONSTRUCTION
R. C. S. 11/11/81
CITY ENGINEER DATE

DRAWING NO. 1065 SHEET 2 OF 10


19) CONSTRUCT TYPE "D" RAMP
ALIGN W/ EXIST. WALK
REMOVE 18 L.F. EXIST. CURB
REMOVE 8.116 SY. EXIST. WALK
EXIST. 3.5' SIDEWALK
REM. & REPL. 2 SY. ASPHALT
2 POSTS

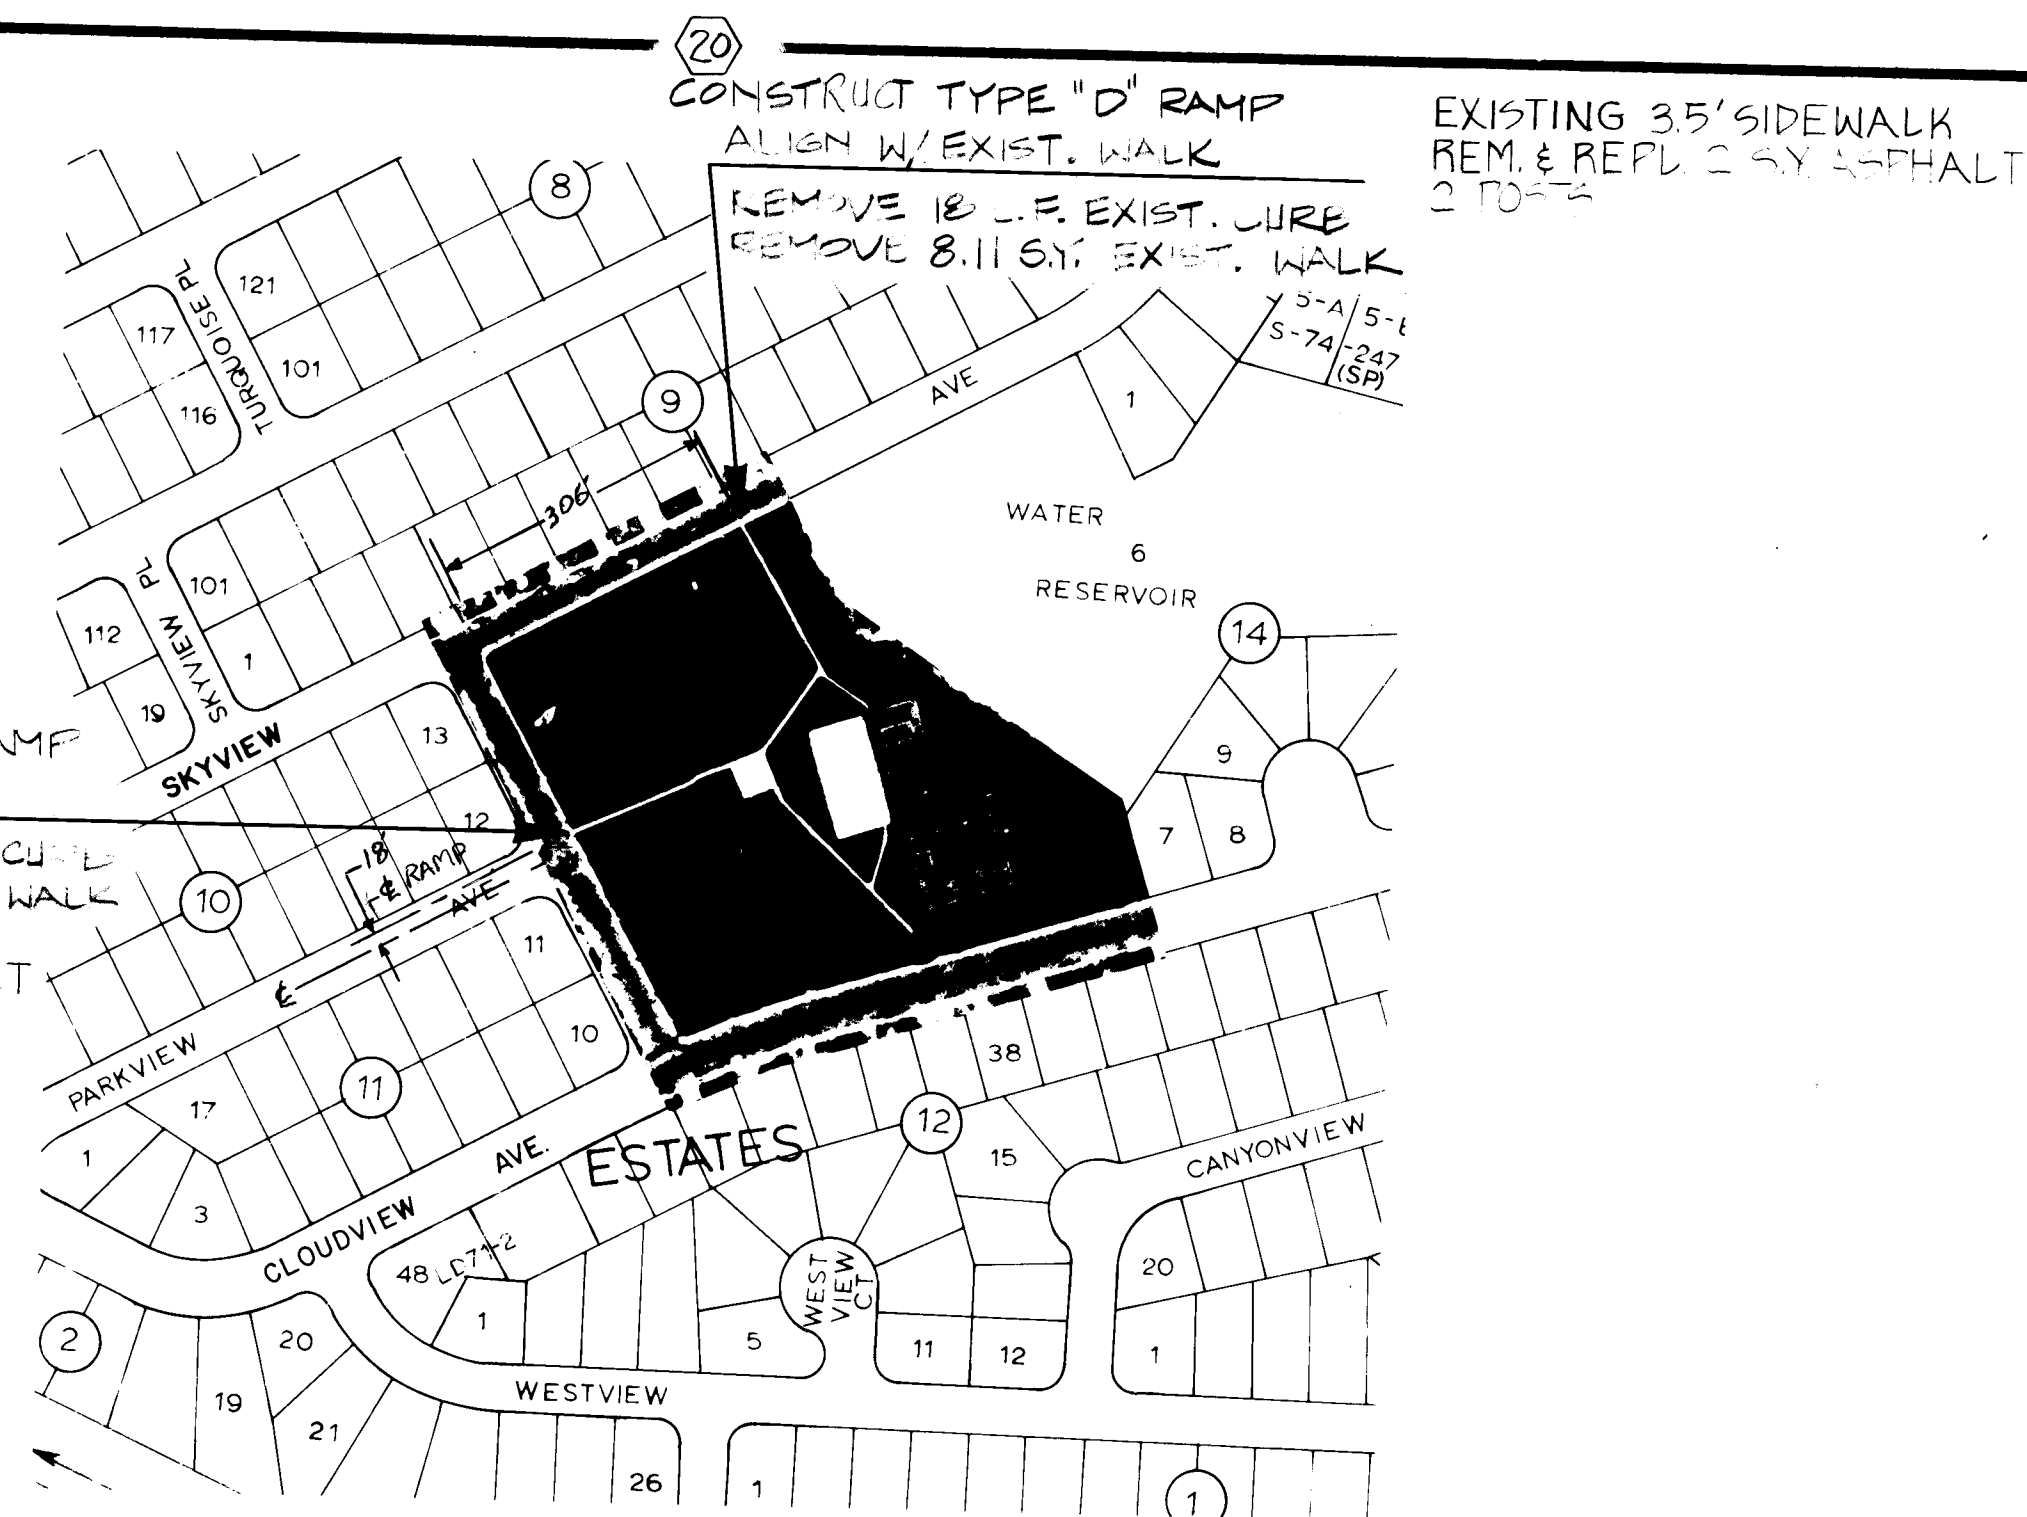


11) FOOTHILLS K-22

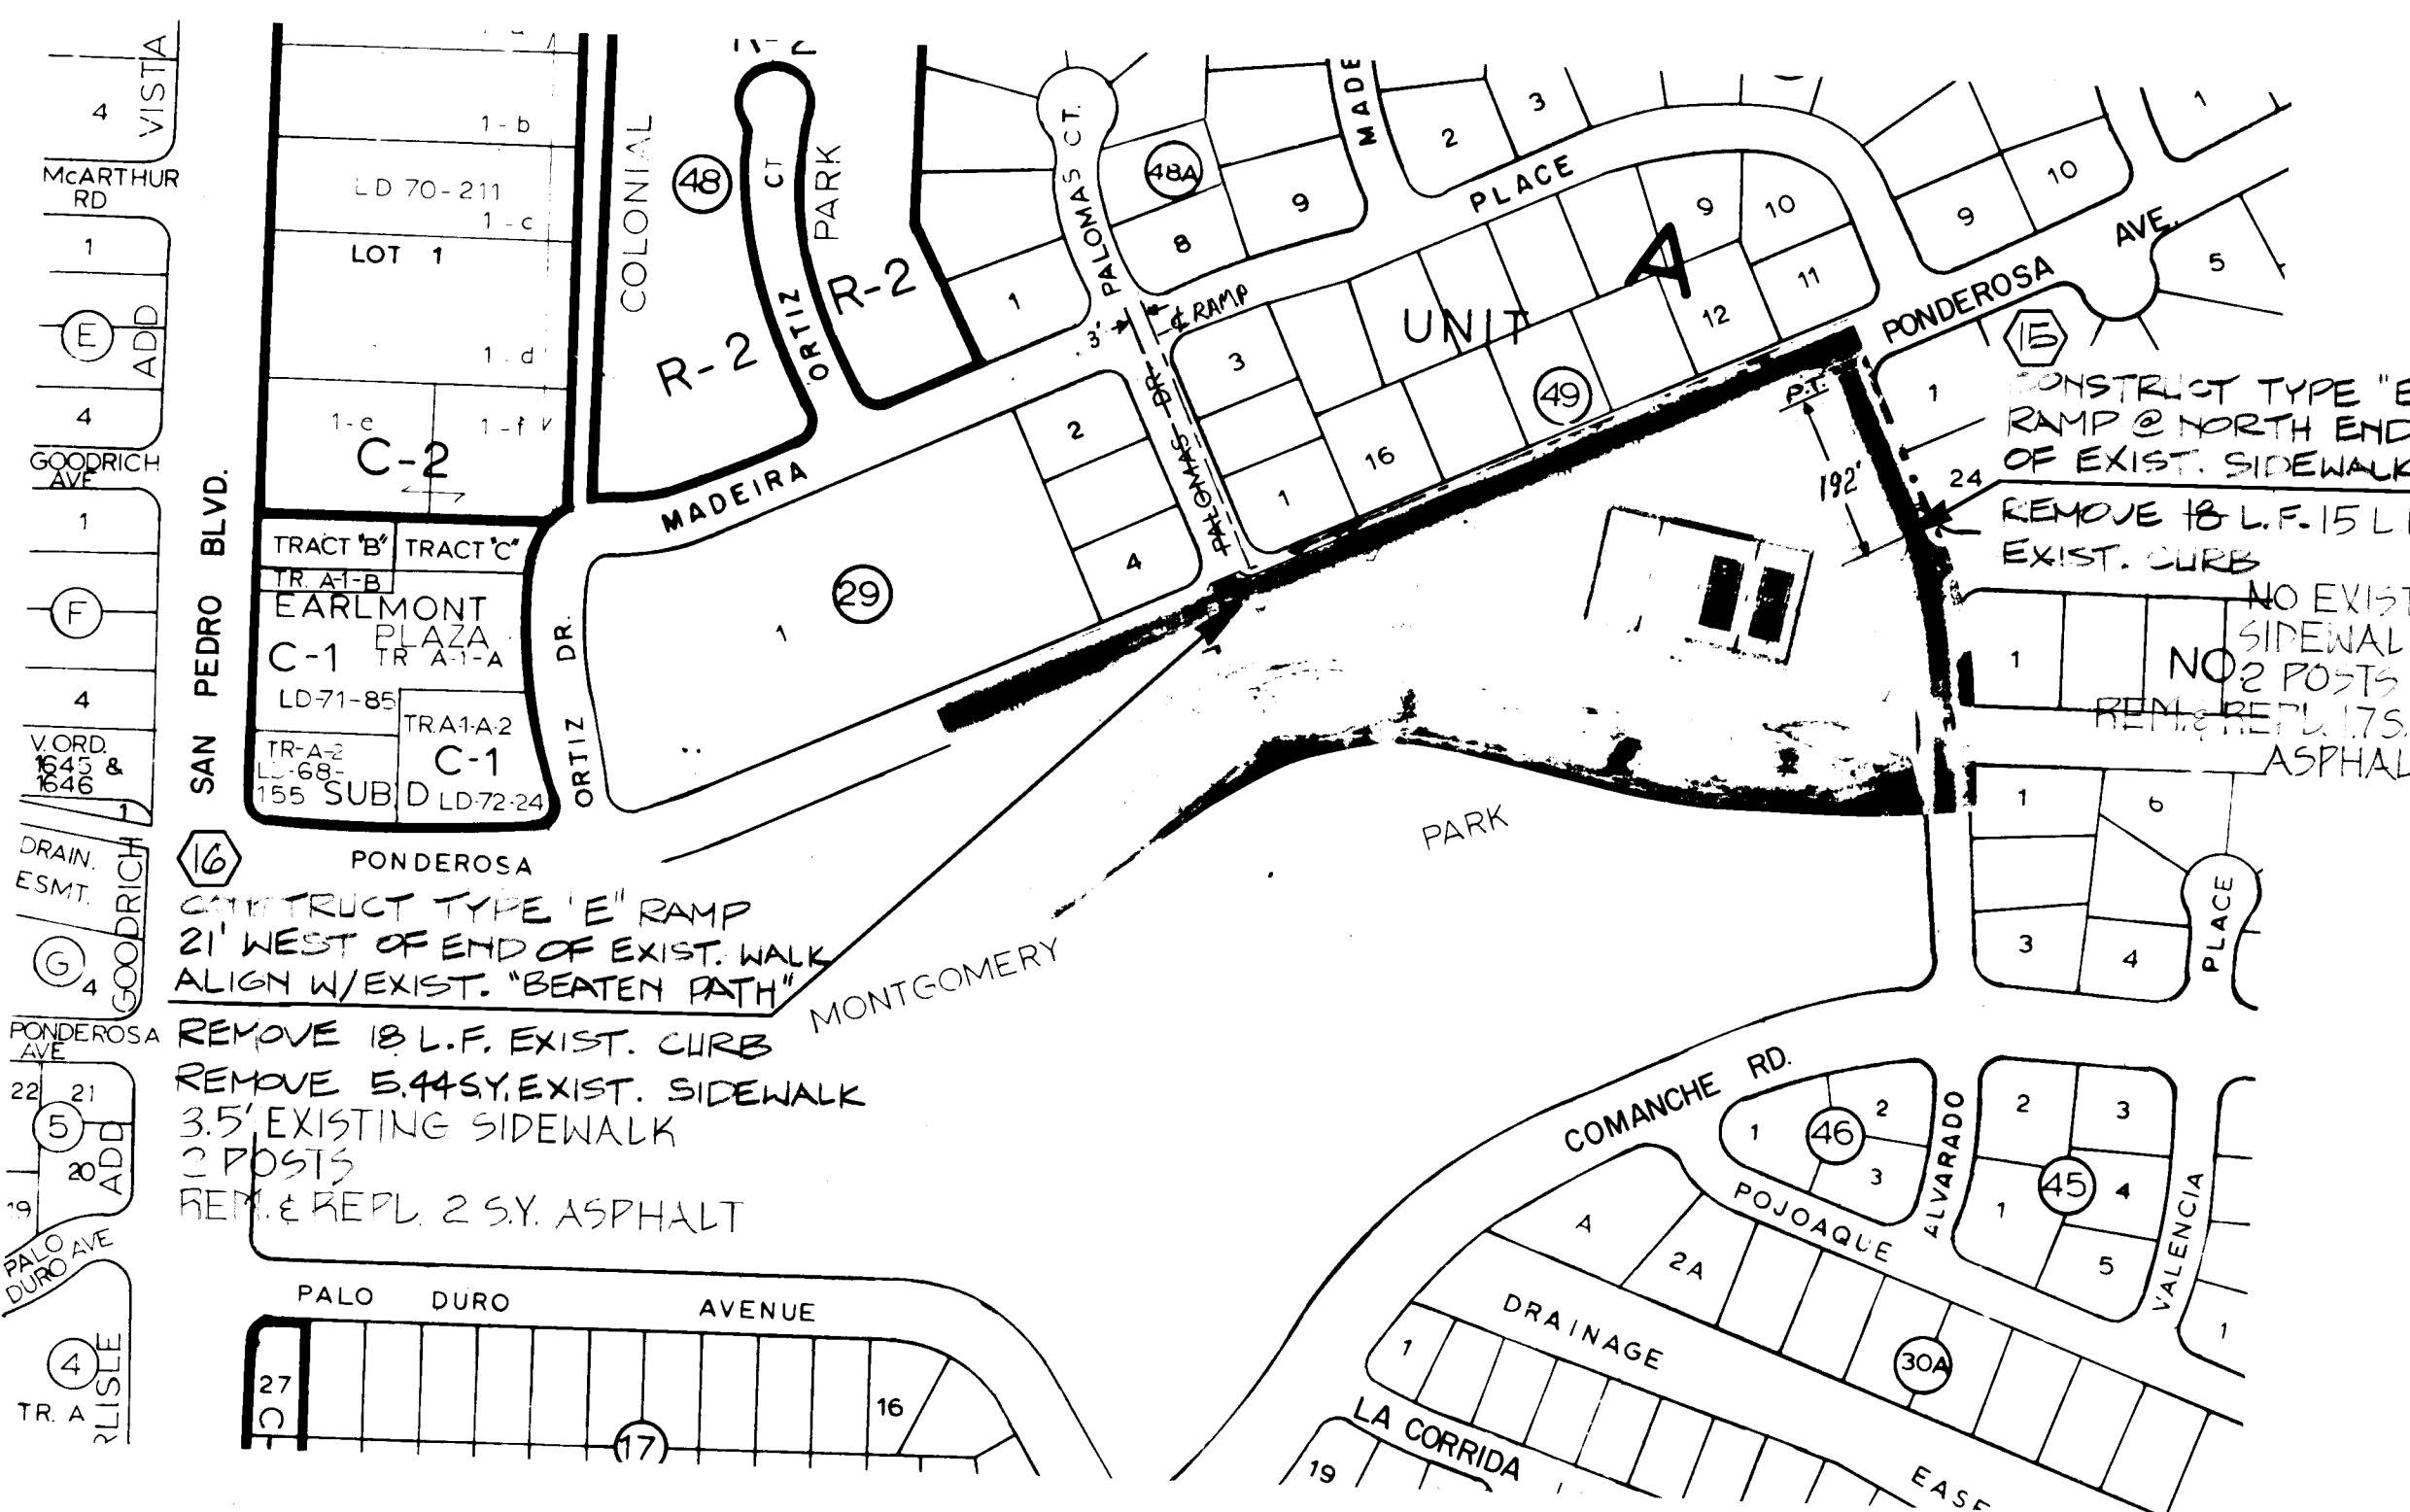


9) MONTGOMERY NORTH G-18

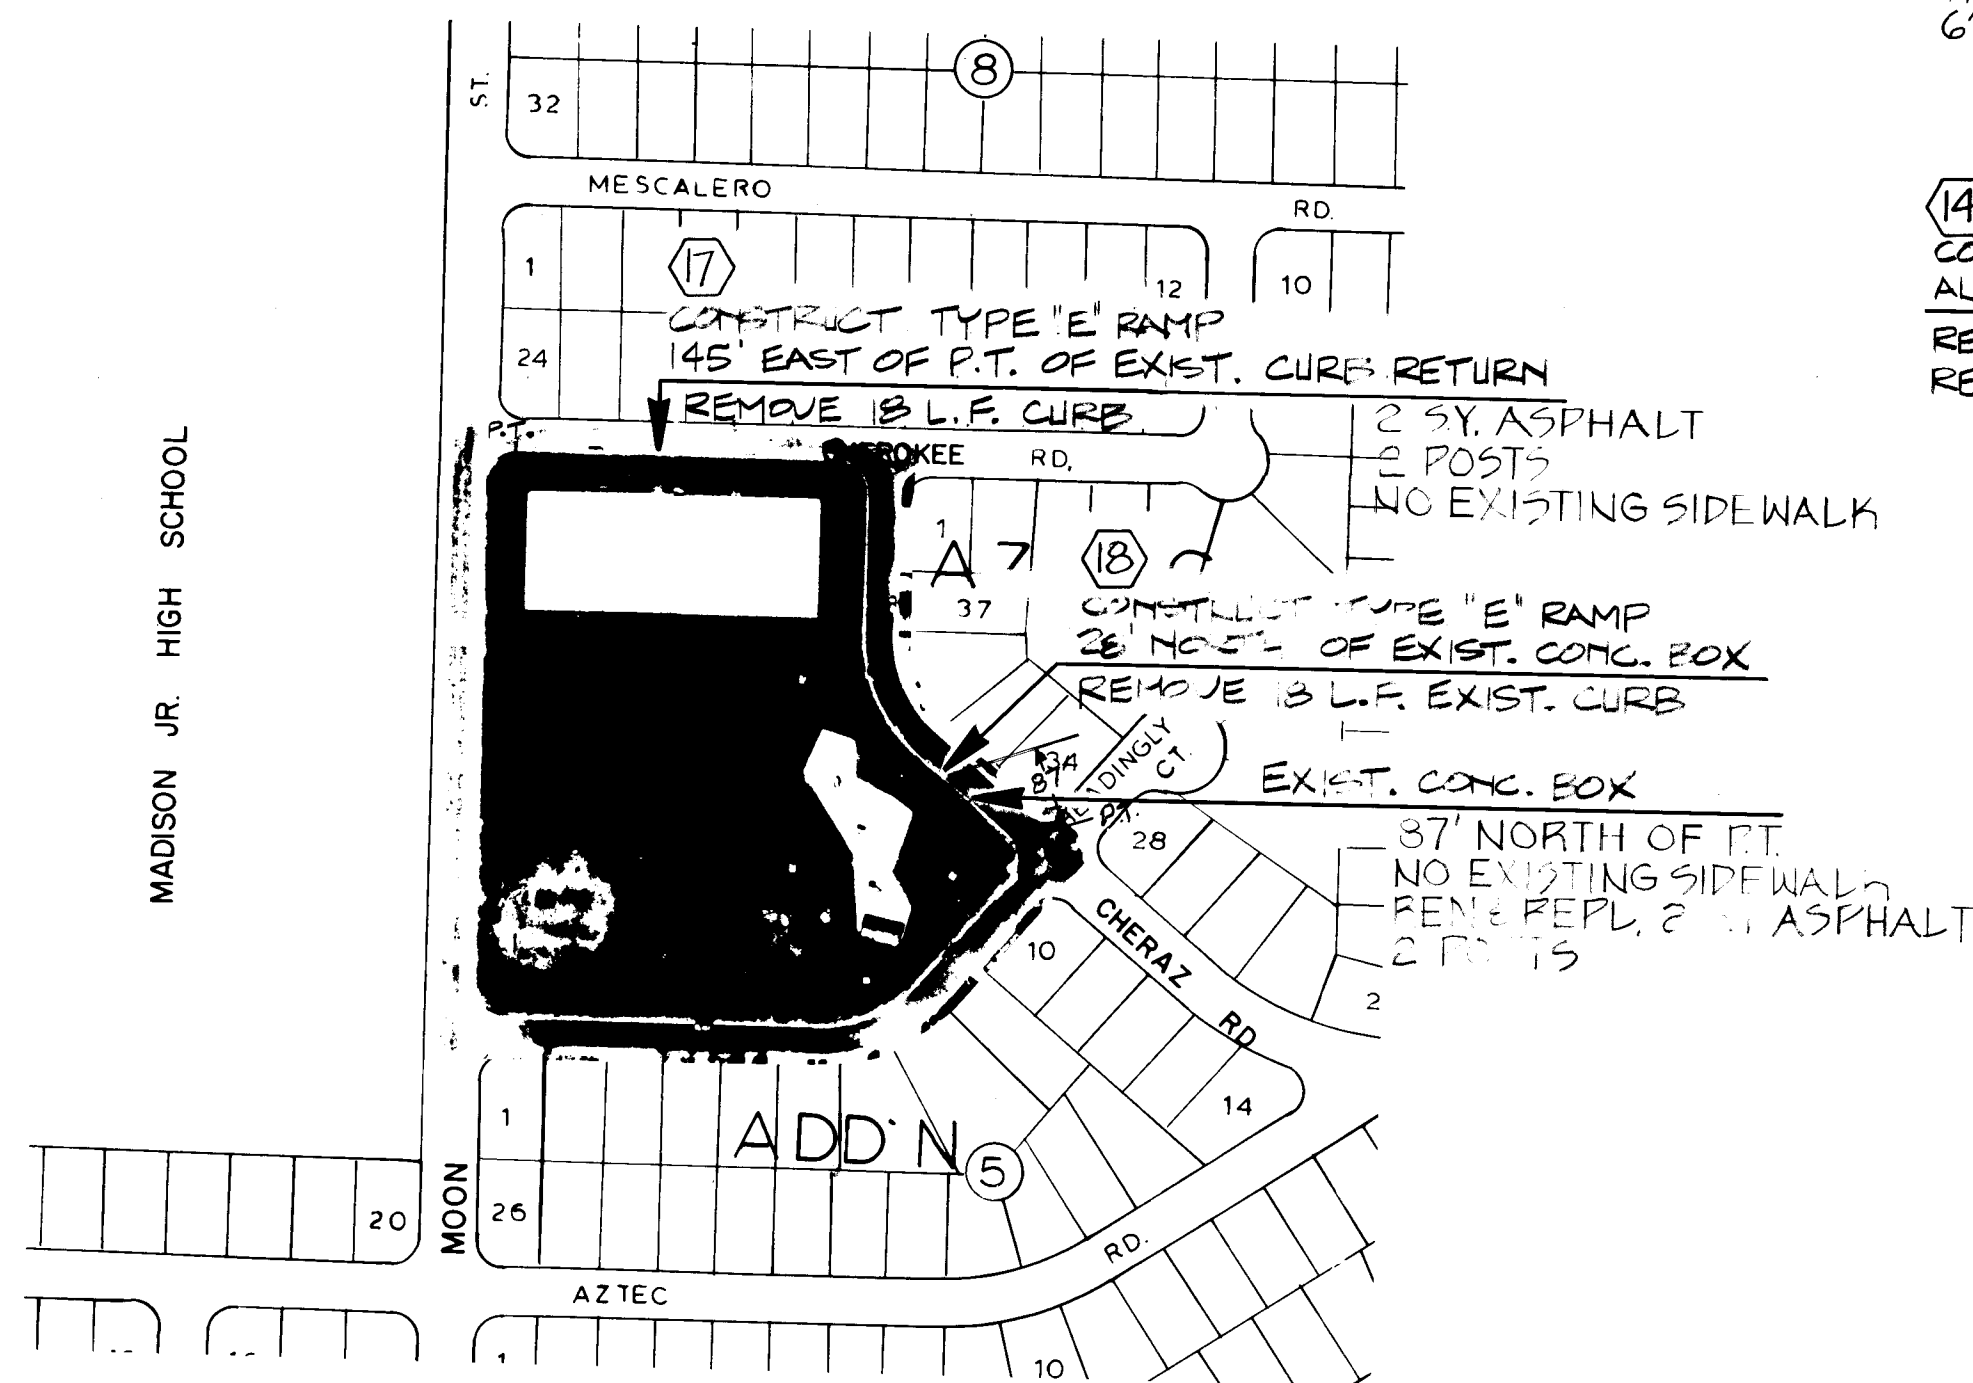


10) AZTEC G-20

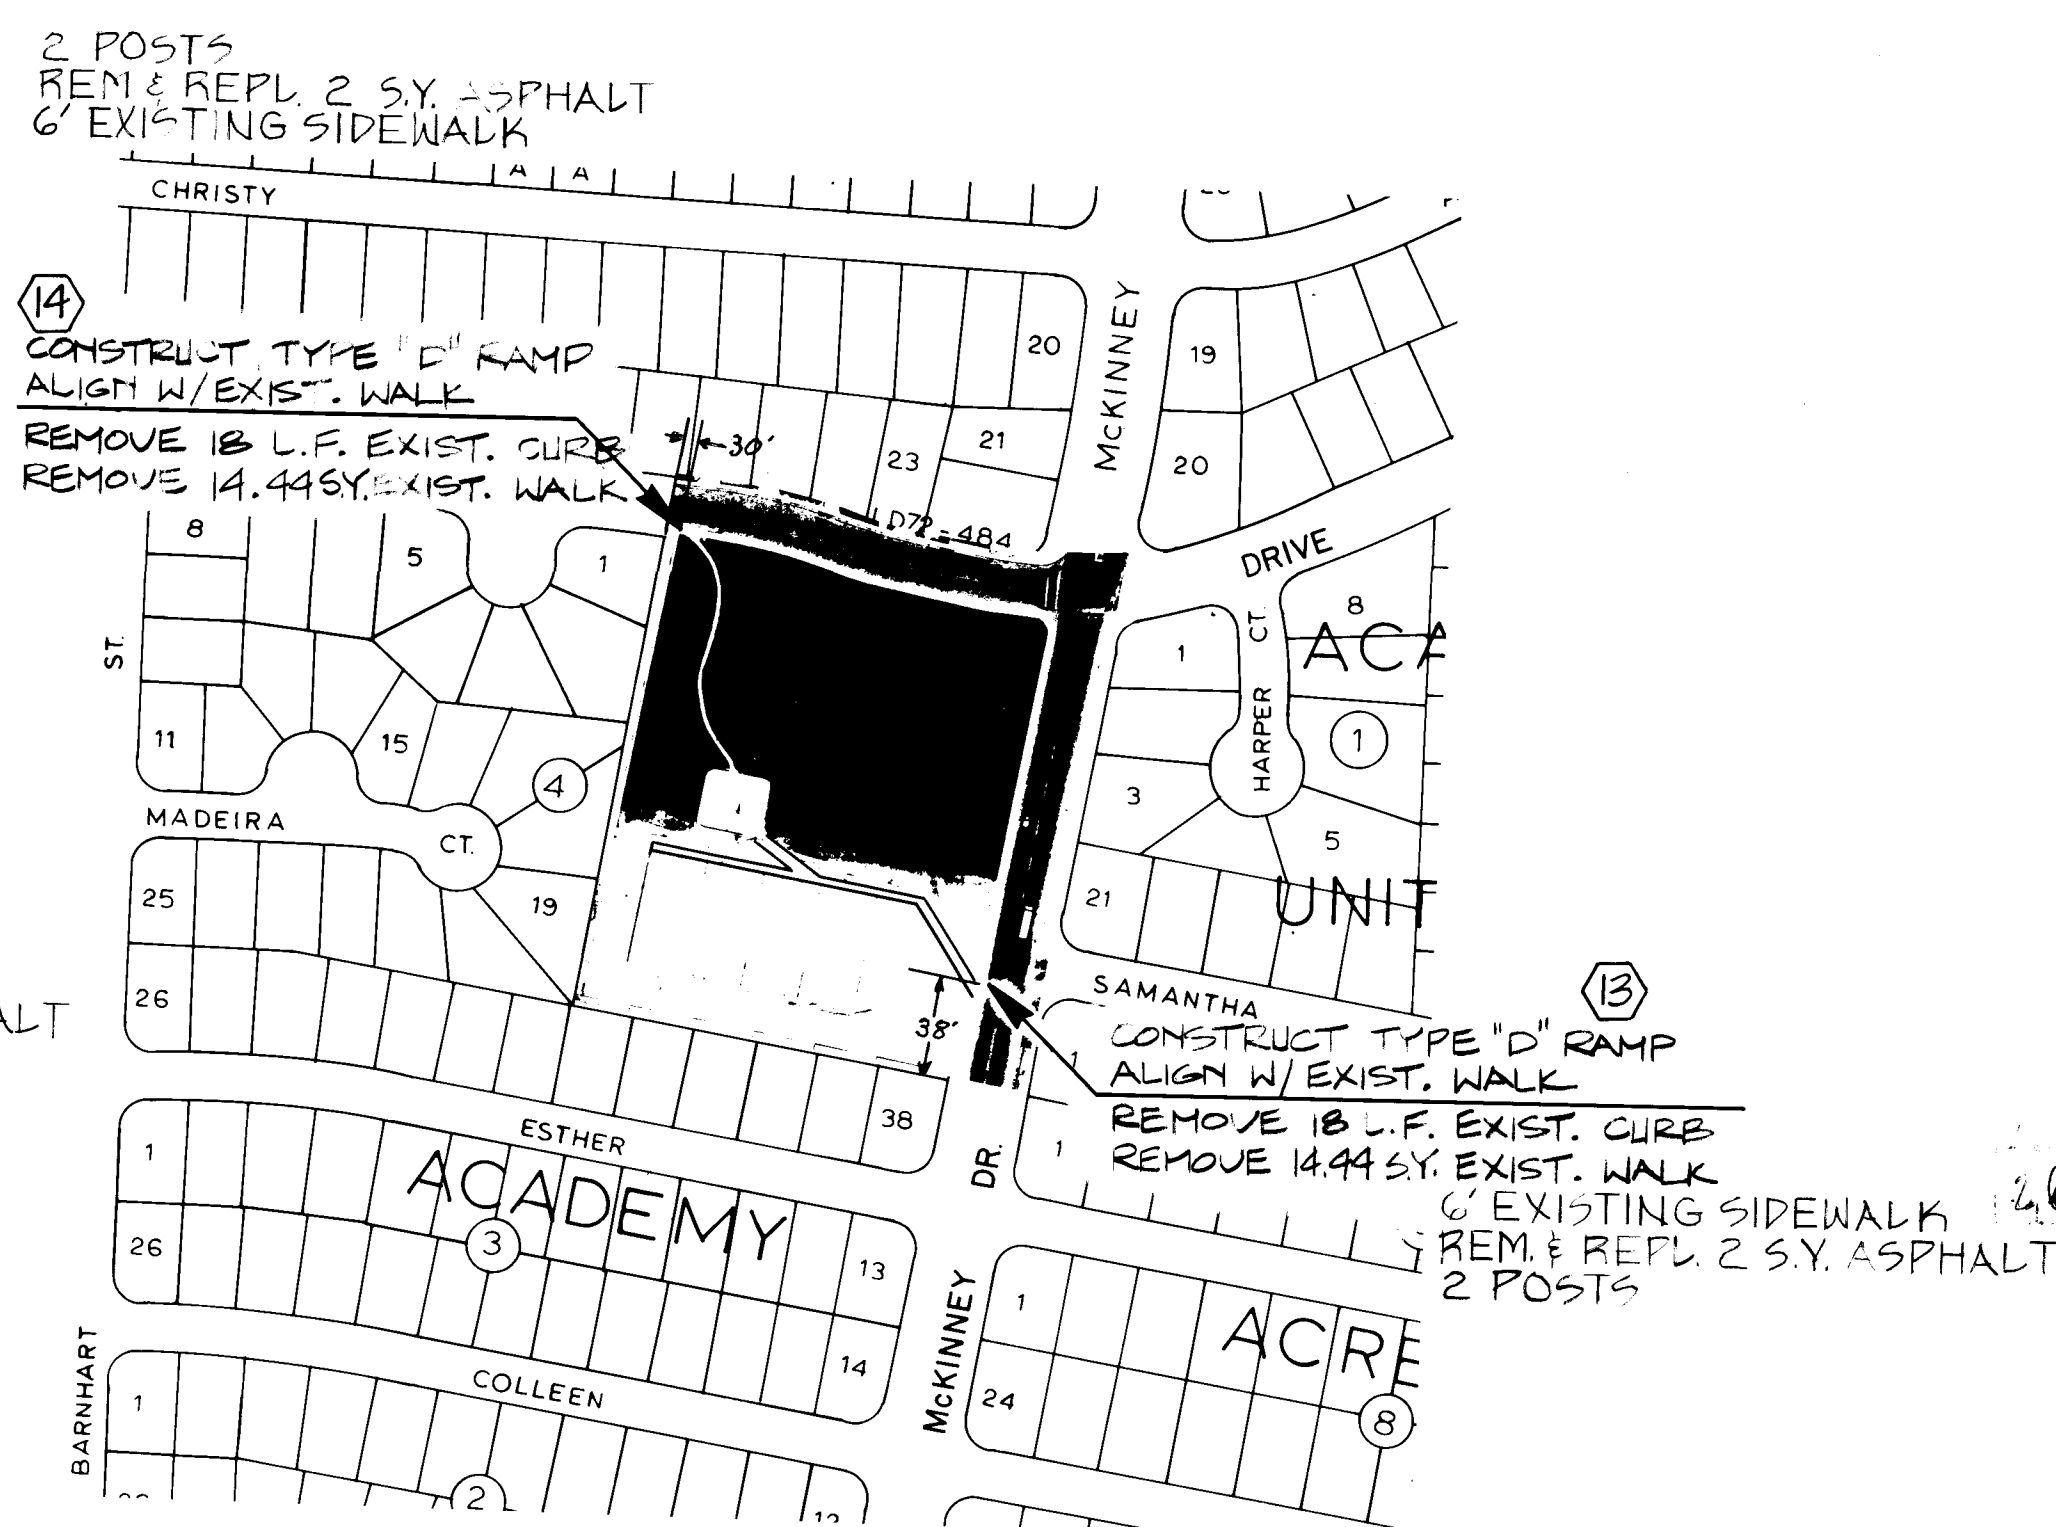







8) SISTER CITIES E-18

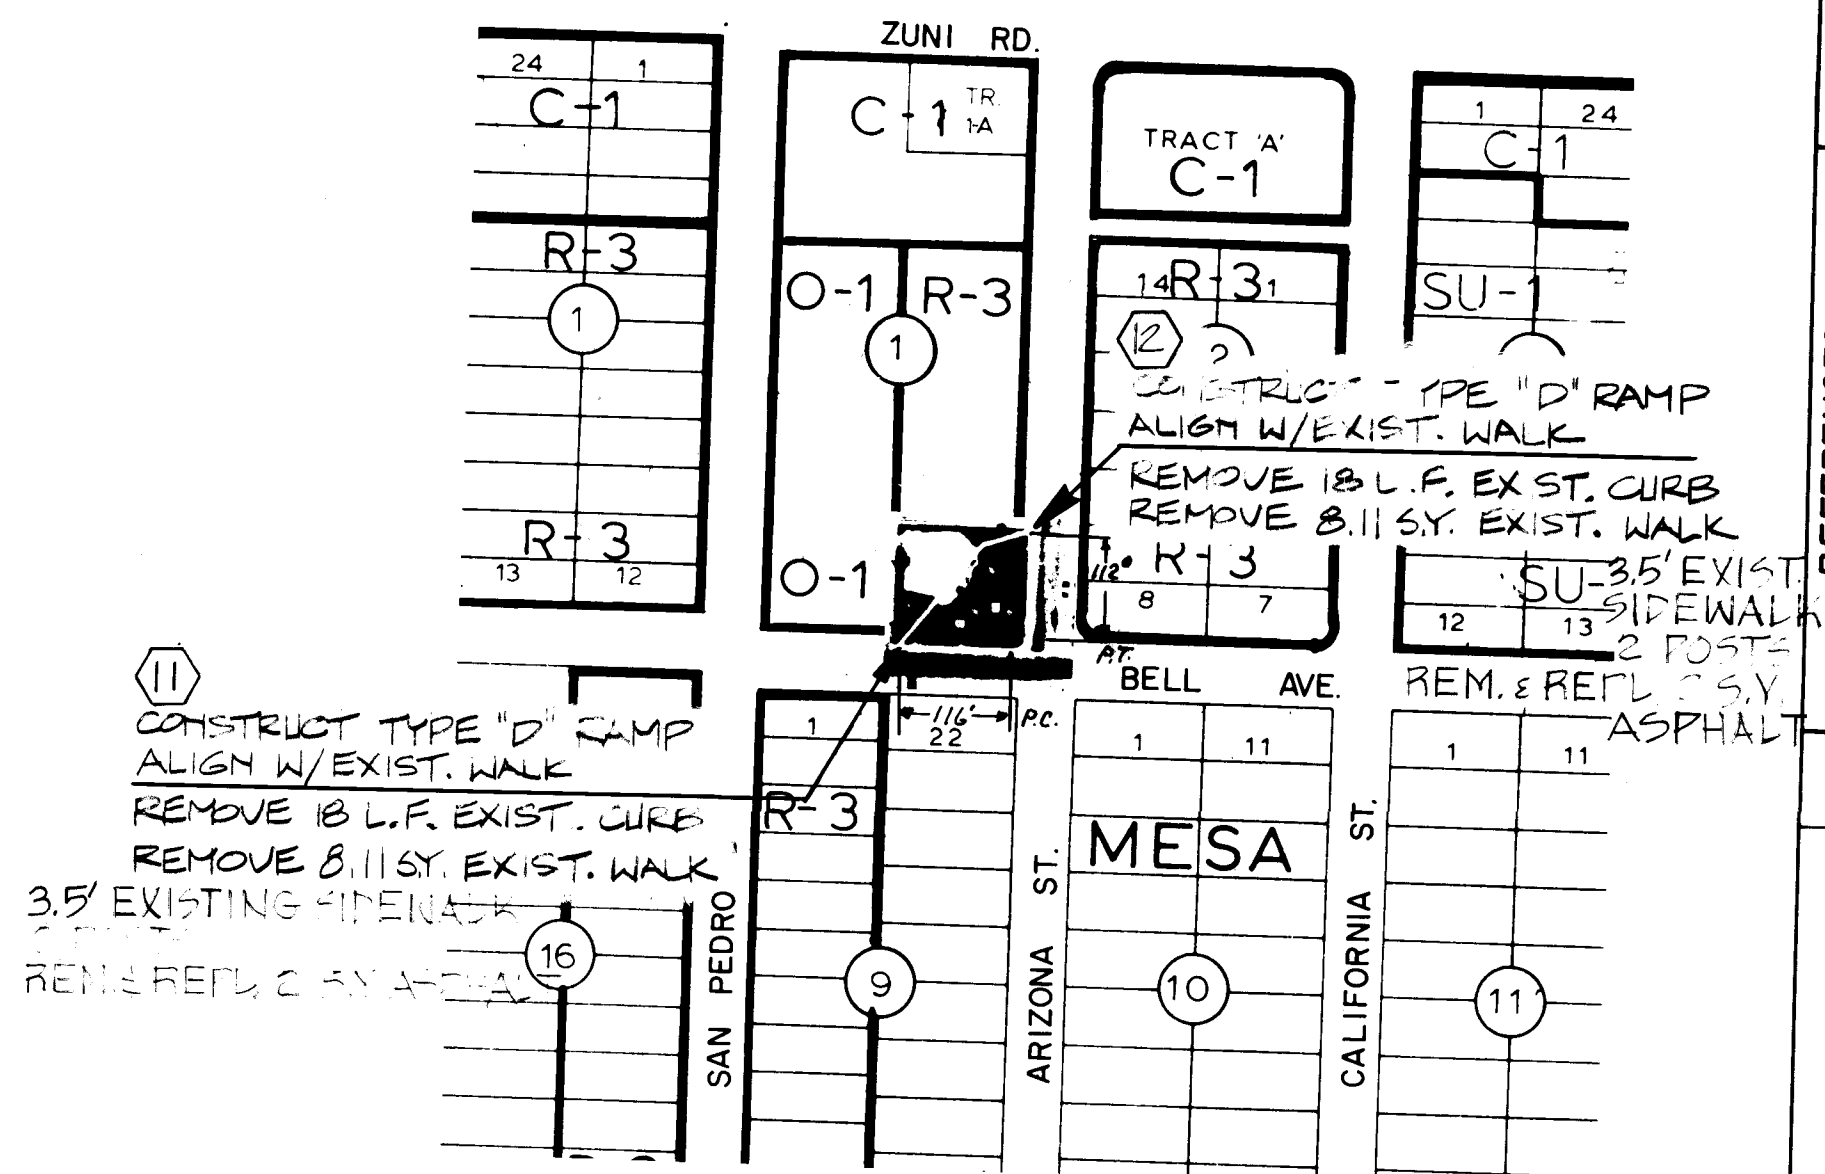

7) JACK & JILL L-18

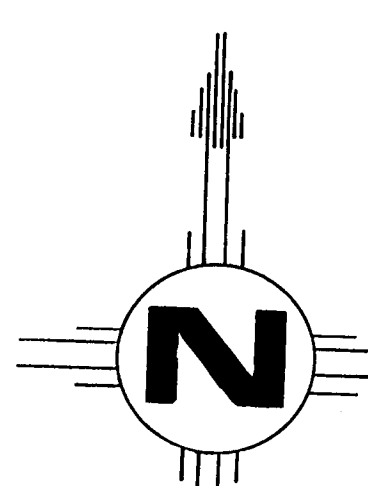

MEURER, SERAFINI AND MEURER, INC. CONSULTING ENGINEERS - SURVEYORS - PLANNERS 2801 WYOMING BLVD., N.E. SUITE F ALBUQUERQUE, NEW MEXICO 87112 (505) 261-1000		CITY OF ALBUQUERQUE MUNICIPAL DEVELOPMENT DEPARTMENT ENGINEERING DIVISION	
TITLE: CITY PARK HANDICAPPED RAMPS PARK NUMBER (7) THRU (11)			
APPROVALS	ENGINEER	DATE	APPROVALS
City Engineer			Liquid Waste
A.C.E. - Design			Traffic
A.C.E. - Hydrology			Water
DRAWING NO. 1065		SHEET 3 OF 10	
APPROVED FOR CONSTRUCTION DATE 3/1/81		DESIGNED BY: D. MAIN DRAWN BY: C. SLOCUM CHECKED BY: J.D. TRACT 1/81	

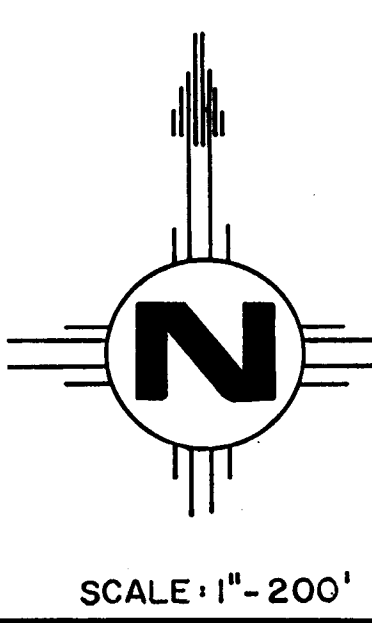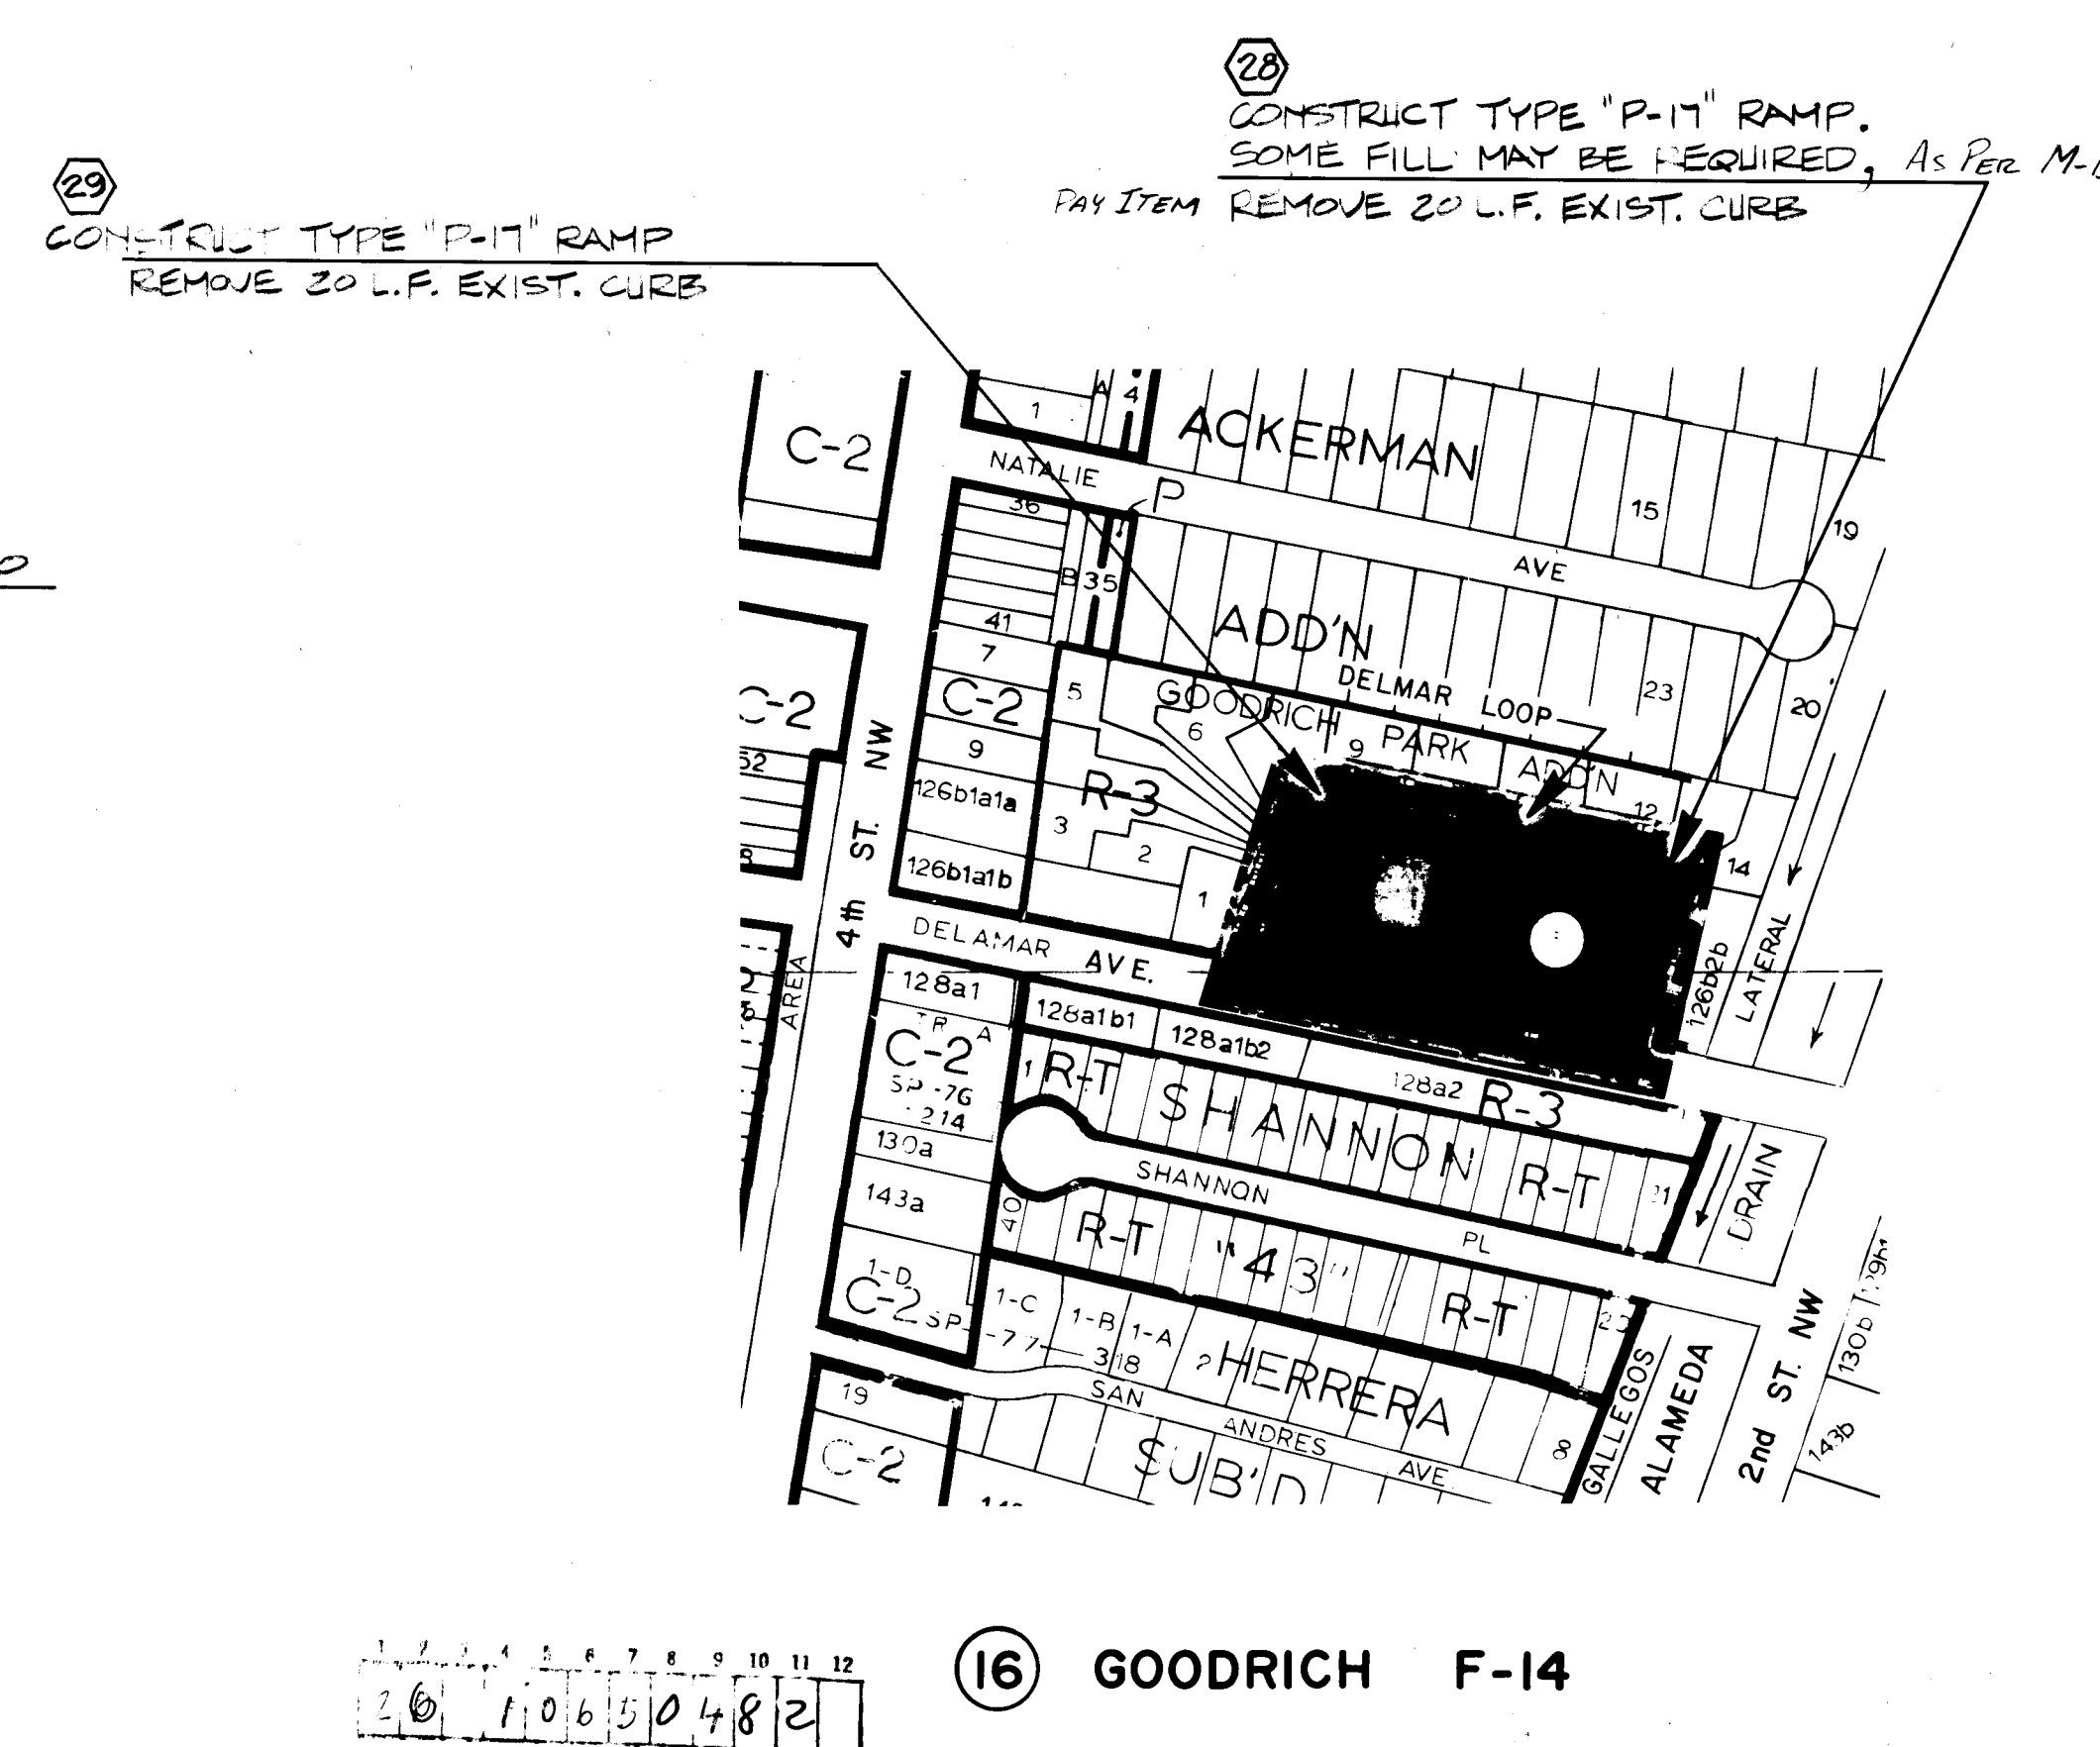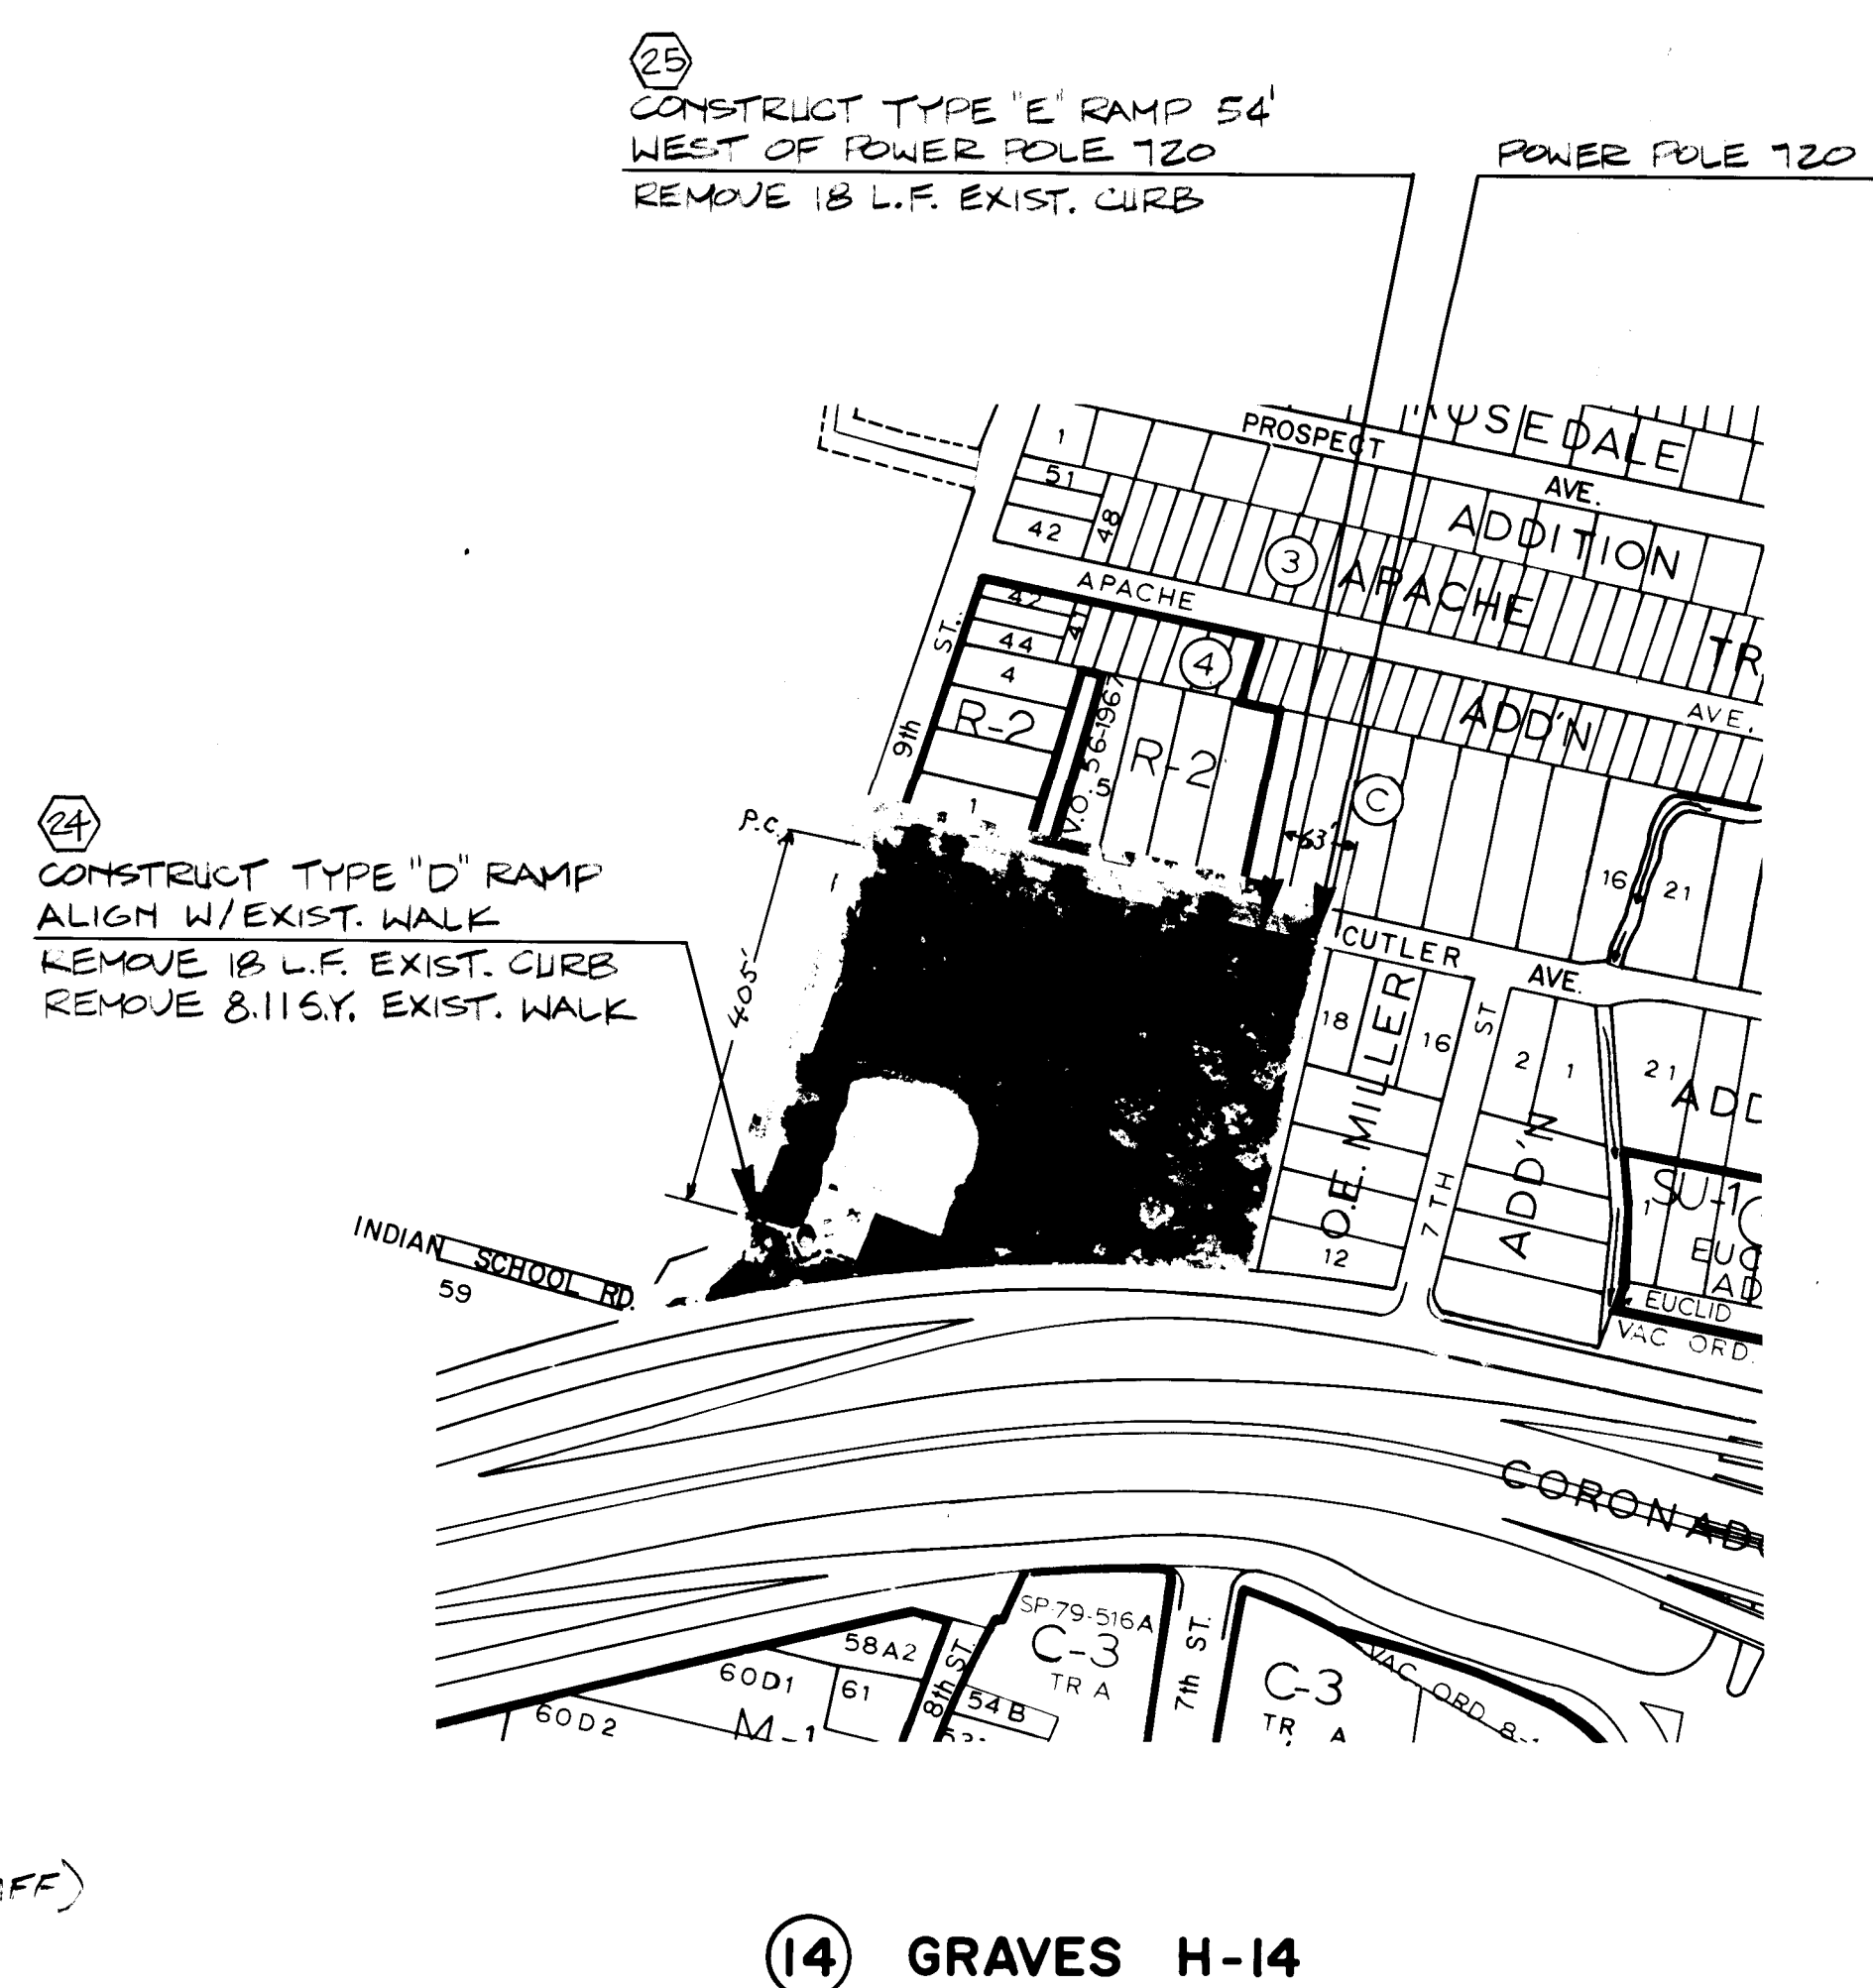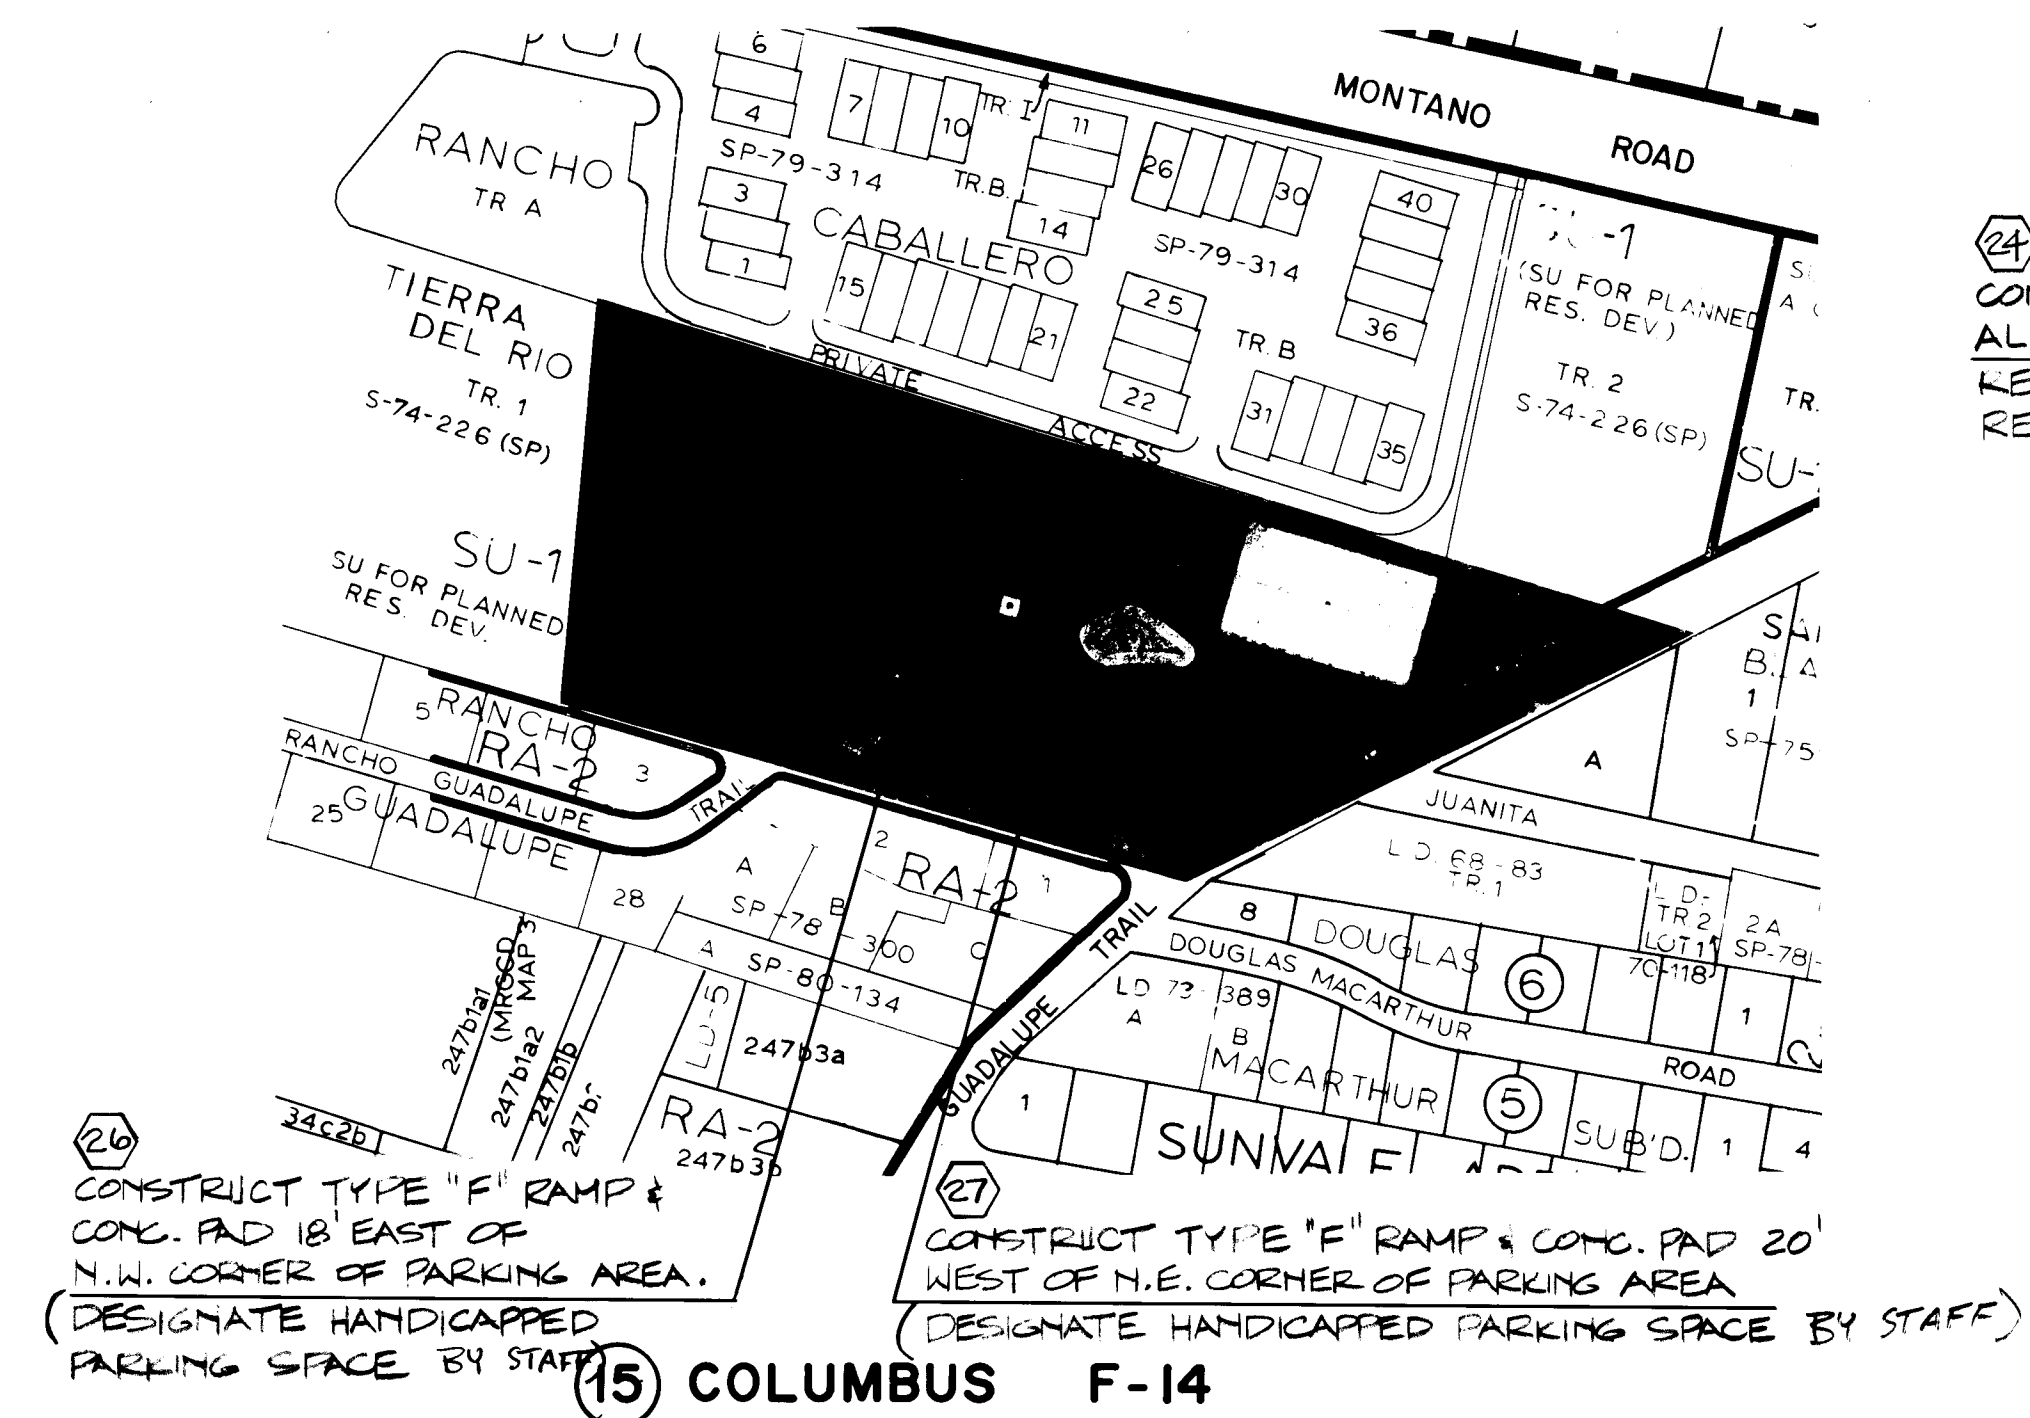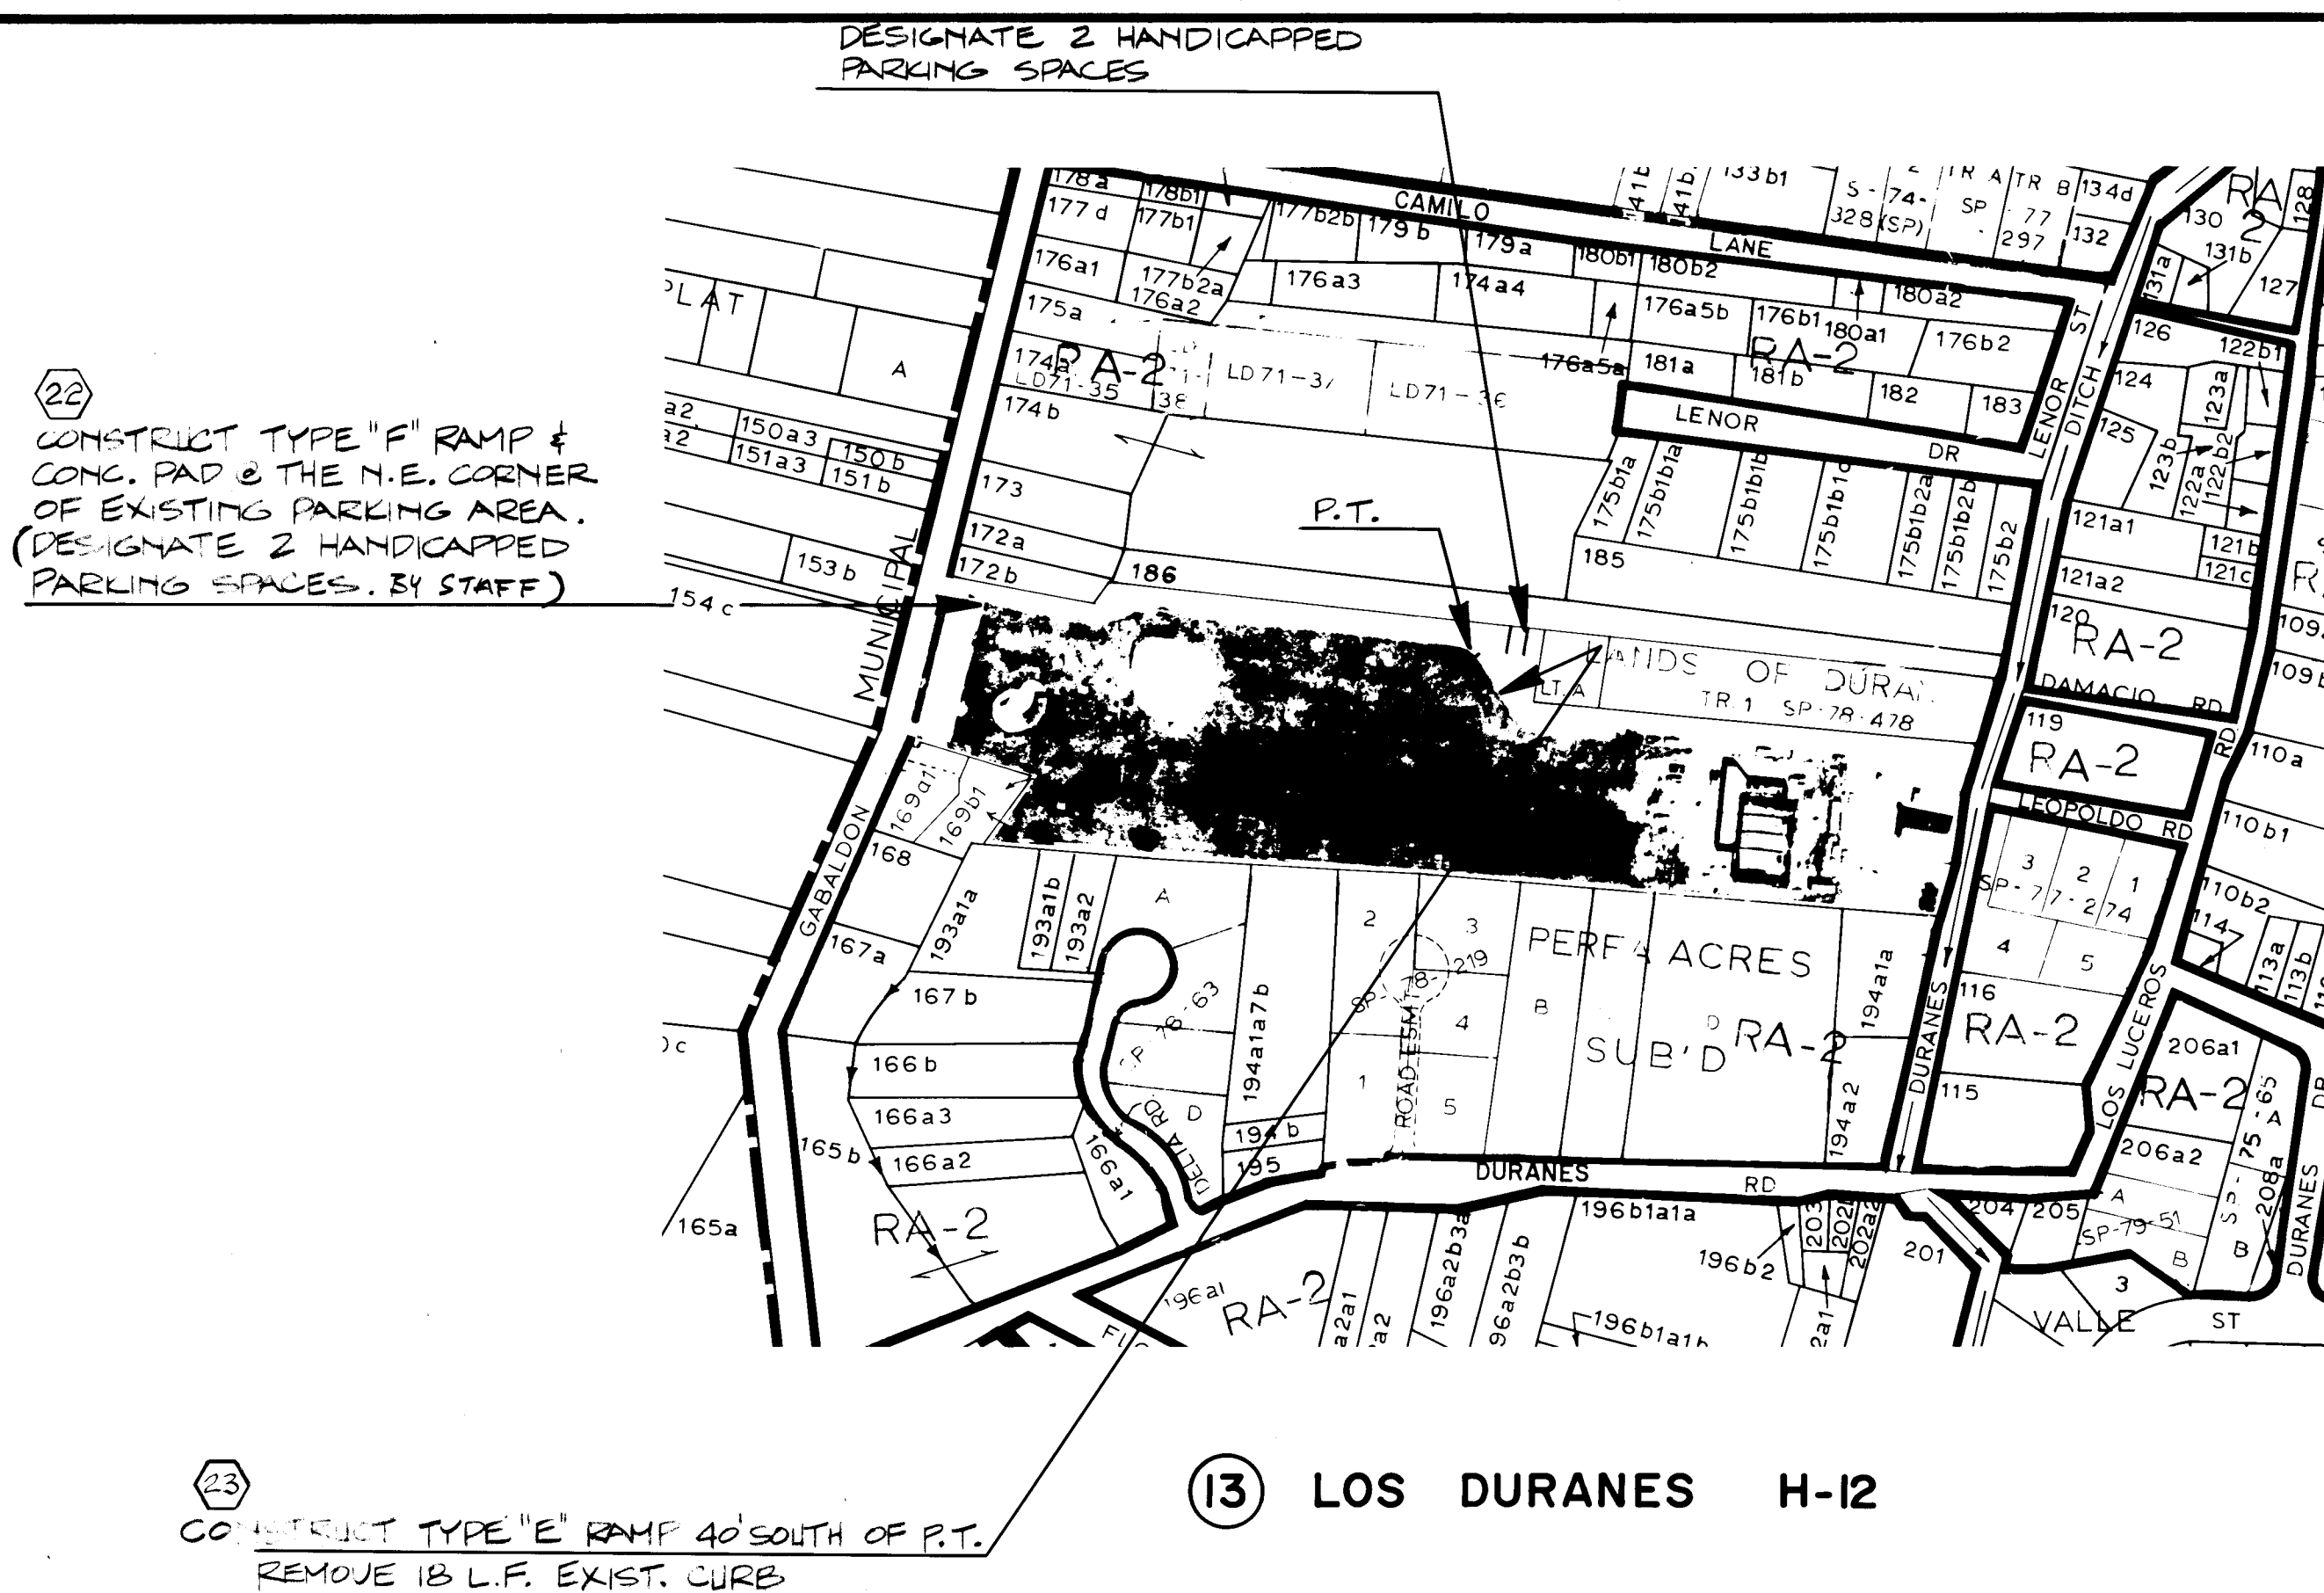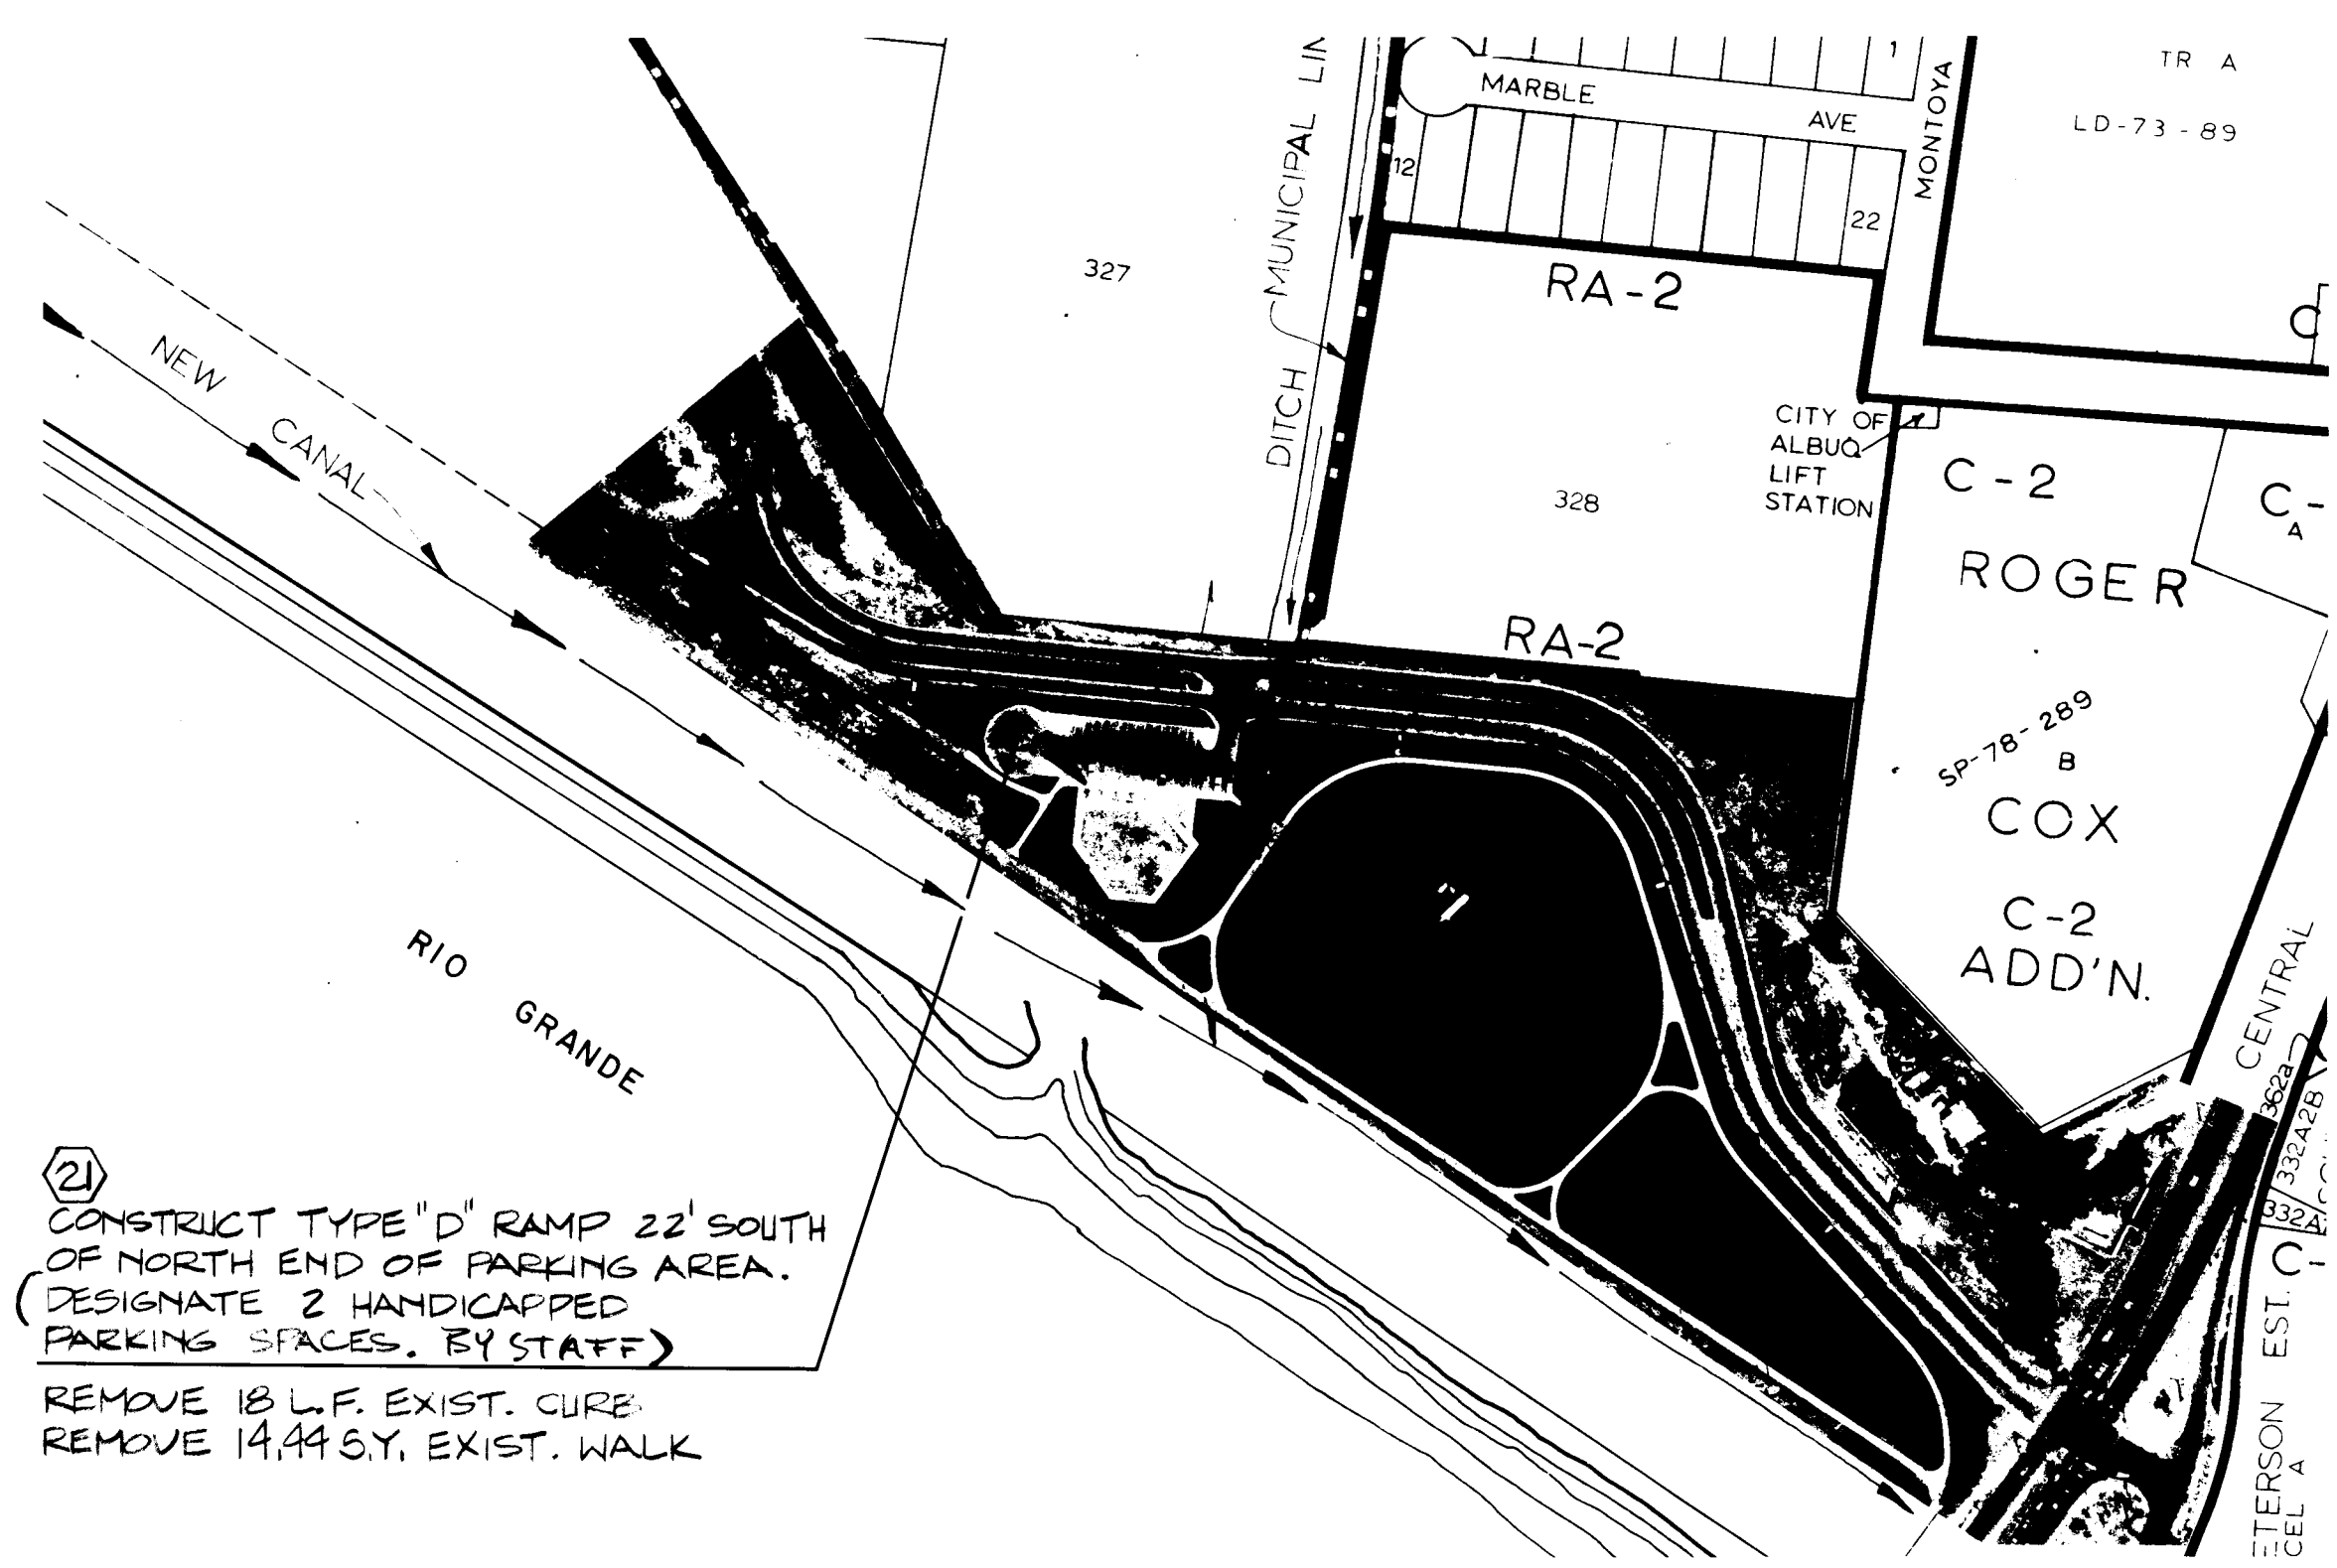

MEURER, SERAFINI AND MEURER, INC. CONSULTING ENGINEERS - SURVEYORS - PLANNERS 2801 WYOMING BLVD., N.E. SUITE 1 ALBUQUERQUE, NEW MEXICO 87112 (505) 262-1335		CITY OF ALBUQUERQUE MUNICIPAL DEVELOPMENT DEPARTMENT ENGINEERING DIVISION	
TITTLE: CITY PARK HANDICAPPED RAMPS PARK NUMBER ⑫ THRU ⑮			
APPROVALS	ENGINEER	DATE	APPROVALS
City Engineer			Liquid Waste
A.C.E. - Design			Traffic
A.C.E. - Hydrology			Water
DRAWING NO. 1065		SHEET 4 OF 10	

AS BUILT INFORMATION		BENCH MARKS		SURVEY INFORMATION		REFERENCES		REMARKS	
CONTRACTOR	DATE	CONTRACTOR	DATE	NO.	BY	MAP NO. F-14, H-14, J-12	EST. NO.	NO.	DATE
SEABE, B.		SEABE, B.							
ACCEPTANCE BY		ACCEPTANCE BY							
VERIFICATION BY		VERIFICATION BY							
CHECKED BY		CHECKED BY							
RECORDED BY		RECORDED BY							
DATE		DATE							
NO.		NO.							

[illegible]

31) CONSTRUCT TYPE "P-17" RAMP
12.5' EAST OF EXISTING STOP SIGN POST.
REMOVE 20 L.F. EXISTING CURB & GUTTER.

ARLISLE

RIALTO AVE

ADDISON DR.

GRISHAM PARK

VERANDA ST.

TULLY ST.

SHERMAN PLACE RD.

SIERRA DR.

GRACE LAND RD.

**CONSTRUCT TYPE "P-17" RAMP
8' WEST OF EXISTING FIRE HYDRANT.
REMOVE 16 L.F. EXISTING CURB & GUTTER.**

**CONSTRUCT TYPE "I"
12' EAST OF SHERMAN PLACE RD.
REMOVE 13 L.F. EXISTING
TO RELOCATE EXISTING**

AMP
RD PLACE.

ING CURB & GUTTER. NOTIFY ~~Key Sooter Parks Dept~~
PAGE CAN.

(40)

CONSTRUCT TYPE "E" RAMP
37' SOUTH OF P.T. EXISTING CURB RETURN.

REMOVE 18 L.F. EXISTING CURB & GUTTER.

Key Rogers Parvus Duff

25

6

7

8

446</

38
CONSTRUCT TYPE "E" RAMP
13' NORTH OF P.T. EXISTING
CURB RETURN.

REMOVE 13 LF. EXISTING C

36
CONSTRUCT TYPE "E" RAMP
8' SOUTH OF EXISTING CONC.
SPRINKLER CONTROL BOX.

REMOVE 15 L.F. EXIST. CURB & GUTTER


(37) CONSTRUCT TYPE "E" RAMP
7' NORTH OF END OF EXISTING SIDEWALK
ABOUT EXISTING SIDEWALK @ END.
REMOVE 10 L.F. EXISTING C&G.

(39)
CONSTRUCT TYPE 'E' RAMP
11' SOUTH OF P.T. EXISTING 15' R. CURB RETURN
NOTE: REPLACE BROKEN STONE OF
RETURN, MATCH FLOWLINE.
REMOVE 26 L.F. EXISTING C&G.


MEURER, SERAFINI AND MEURER, INC.		CONSULTING ENGINEERS - SURVEYORS - PLANNERS		DESIGNED DRAWN BY																									
2601 WYOMING BLVD., N.E. SUITE F ALBUQUERQUE, NEW MEXICO 87112 (505) 262-1026				NO. DATE																									
PLANS PREPARED UNDER THE DIRECTION OF 		CITY OF ALBUQUERQUE MUNICIPAL DEVELOPMENT DEPARTMENT ENGINEERING DIVISION																											
		TITLE: CITY PARK HANDICAPPED RAMPS PARK NUMBER 17 THRU 22																											
APPROVED FOR CONSTRUCTION 		<table border="1"> <thead> <tr> <th>APPROVALS</th> <th>ENGINEER</th> <th>DATE</th> <th>APPROVALS</th> <th>ENGINEER</th> <th>DATE</th> </tr> </thead> <tbody> <tr> <td>City Engineer</td> <td></td> <td></td> <td>Liquid Waste</td> <td>N/A</td> <td></td> </tr> <tr> <td>A.C.E. - Design</td> <td><i>Glenn</i></td> <td><i>11/10/61</i></td> <td>Traffic</td> <td><i>W. J. Marks</i></td> <td><i>4/1/62</i></td> </tr> <tr> <td>A.C.E. - Hydr. & Gr.</td> <td></td> <td></td> <td>Water</td> <td>N/A</td> <td></td> </tr> </tbody> </table>		APPROVALS	ENGINEER	DATE	APPROVALS	ENGINEER	DATE	City Engineer			Liquid Waste	N/A		A.C.E. - Design	<i>Glenn</i>	<i>11/10/61</i>	Traffic	<i>W. J. Marks</i>	<i>4/1/62</i>	A.C.E. - Hydr. & Gr.			Water	N/A			
APPROVALS	ENGINEER	DATE	APPROVALS	ENGINEER	DATE																								
City Engineer			Liquid Waste	N/A																									
A.C.E. - Design	<i>Glenn</i>	<i>11/10/61</i>	Traffic	<i>W. J. Marks</i>	<i>4/1/62</i>																								
A.C.E. - Hydr. & Gr.			Water	N/A																									
CITY ENGINEER DATE <i>4/1/62</i>		DRAWING NO. 1065		SHEET 5 OF 10																									




(27) JEANNE BELLAMAH J-21

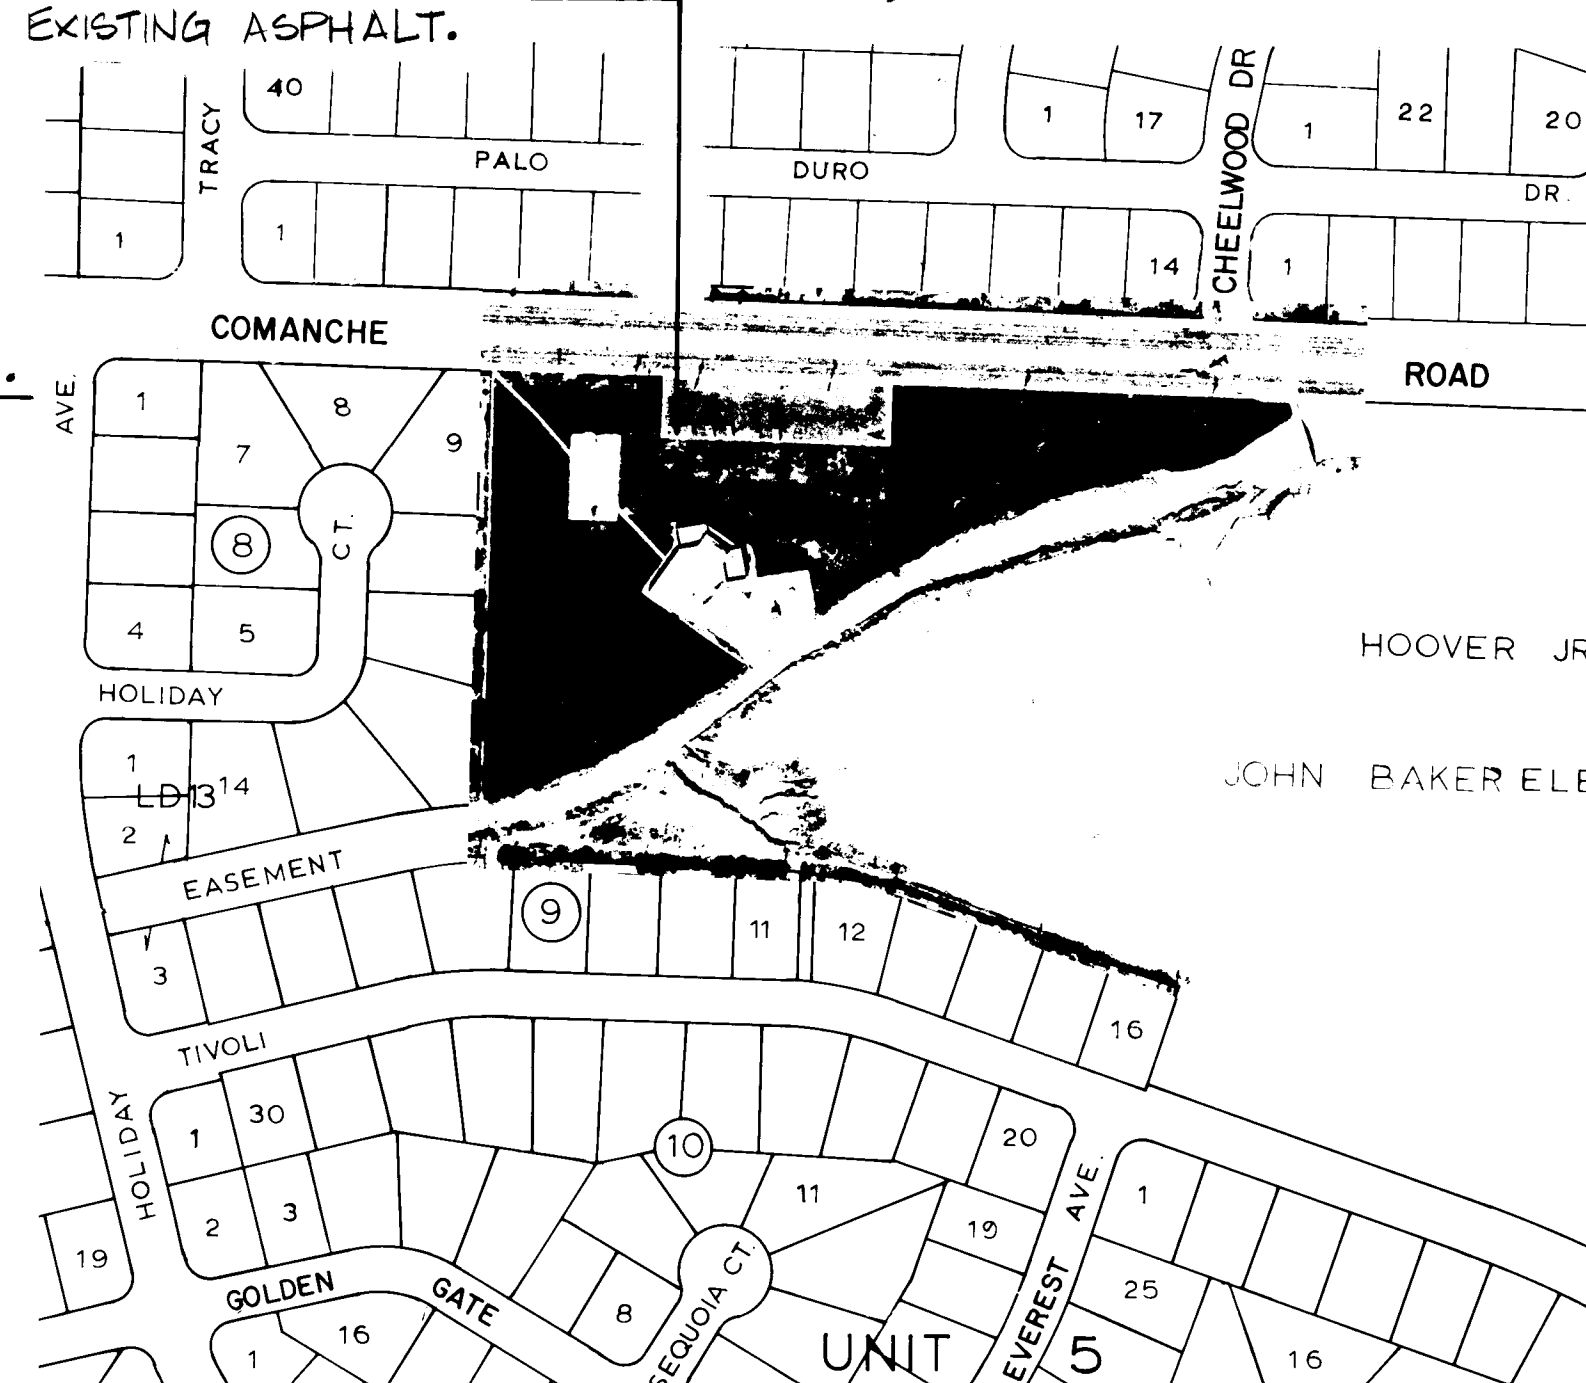


(28) HOLIDAY G-22

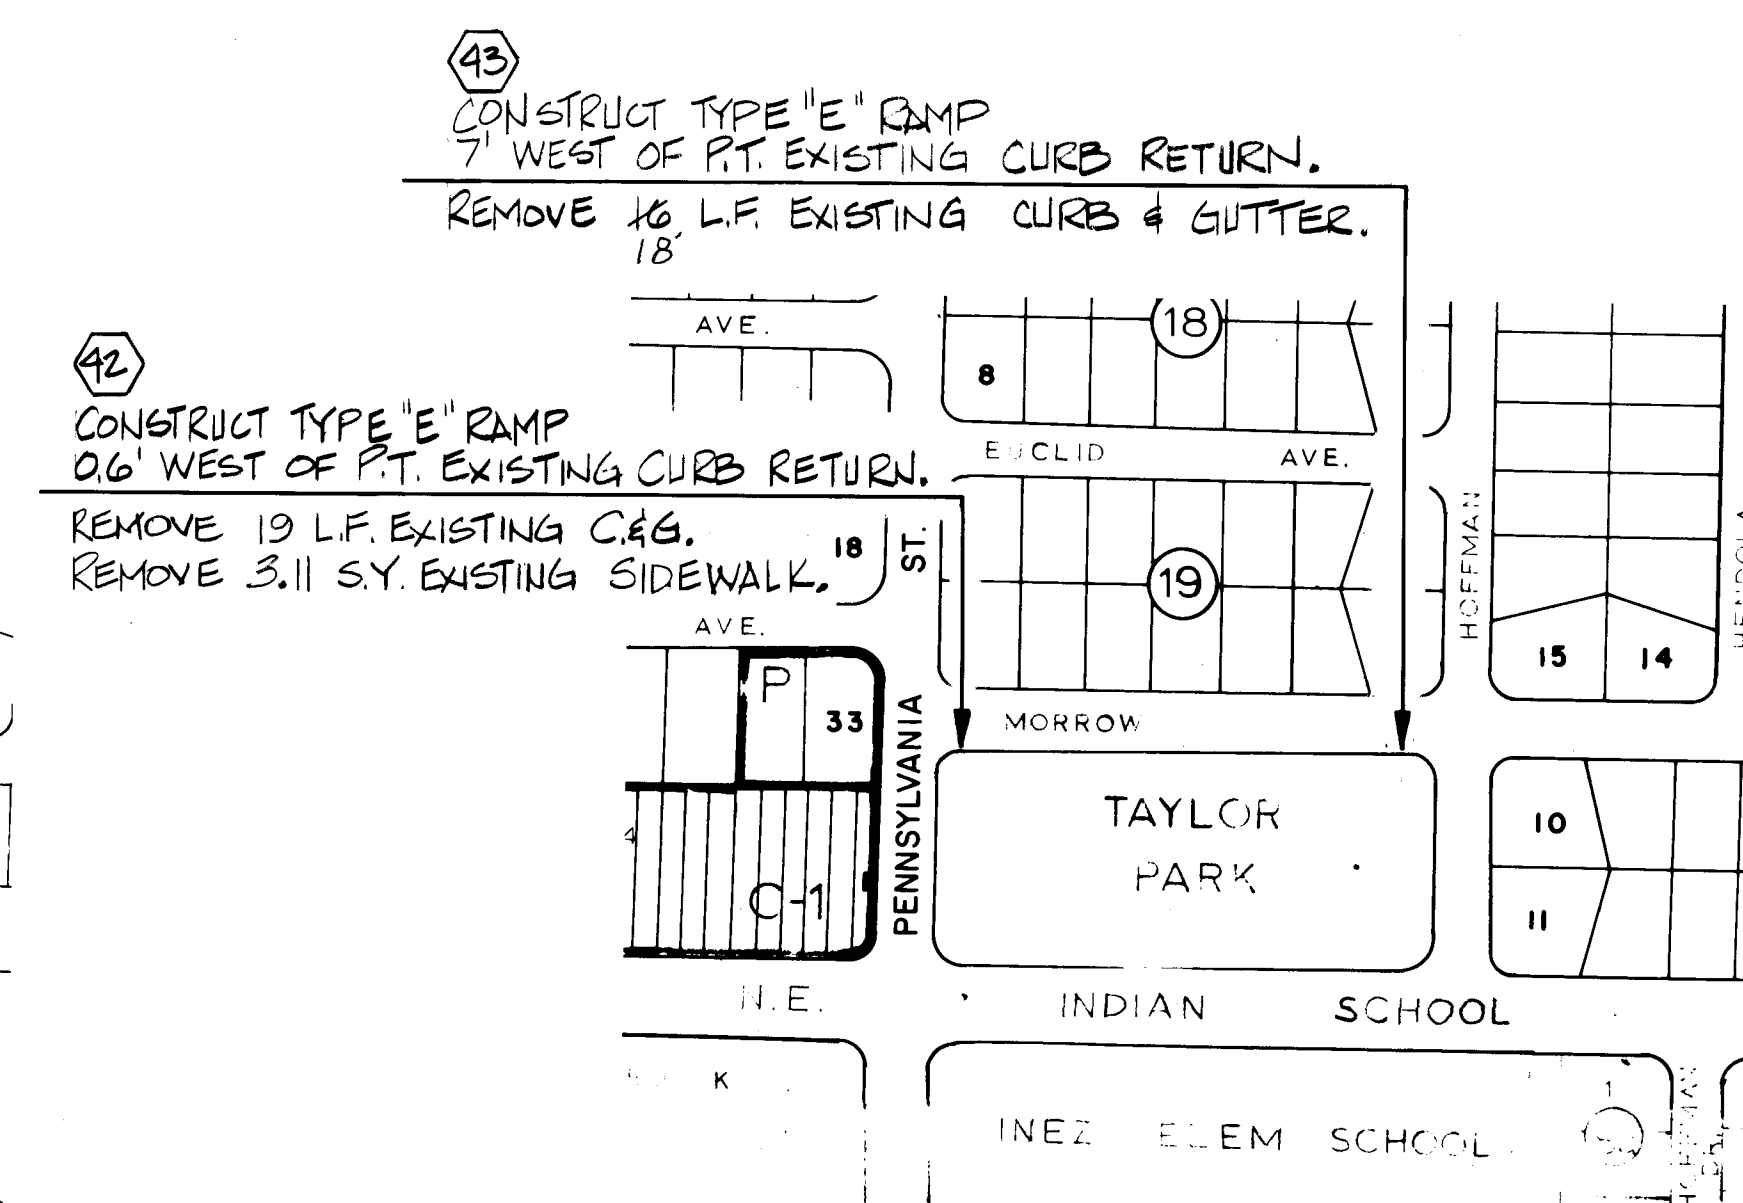

②③ TAYLOR H-19

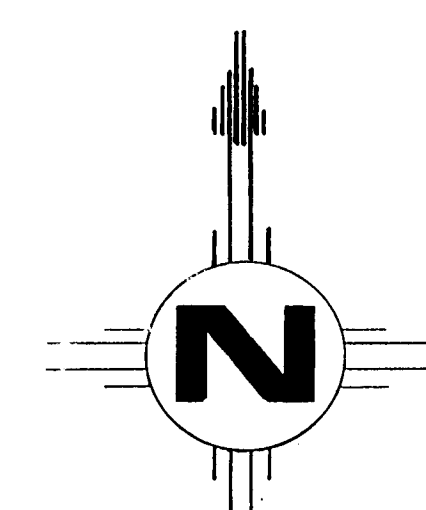

SCALE: 1"=200'

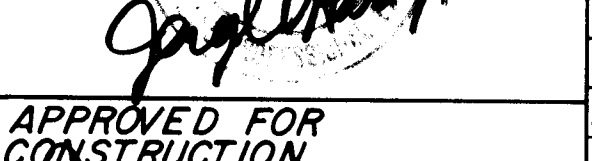MEURER, SERAFINI AND MEURER, INC.		CONSULTING ENGINEERS - SURVEYORS - PLANNERS		NO. NO. NO.		DESIGNED BY DRAWN BY	
2601 WYOMING BLVD., N.E. SUITE F ALBUQUERQUE, NEW MEXICO 87112 (505) 261-1535		CITY OF ALBUQUERQUE MUNICIPAL DEVELOPMENT DEPARTMENT ENGINEERING DIVISION		TITLE: CITY PARK HANDICAPPED RAMPS PARK NUMBER (23) THRU (28)			
PLANS PREPARED UNDER THE DIRECTION OF 		APPROVALS City Engineer A.C.E. - Design A.C.E. - Hydrology		ENGINEER DATE Liquid Waste Traffic Water		ENGINEER DATE N/A N/A N/A	
APPROVED FOR CONSTRUCTION 		DRAWING NO. 1065		SHEET 6 OF 10			
CITY ENGINEER DATE							

PHOTOS FOR PARKS SHOWN ON SHEET 2



1 ALAMOSA 1 Northwest corner of park, at the intersection of Sunset Gardens Road SW and Estero SW.
2 ALAMOSA 2 Southwest corner of park, at the intersection of Bucaria Ave. SW and Bataan SW.



3 PAT HURLEY 1 Northeast corner of parking lot adjacent to Rincon Road NW just west of 5th St. NW.



3 WEST MESA 4 Northern most parking lot along west side of park, off Glenrio or Fortuna Rd. NW, South end of parking area.



3 WEST MESA 5 Middle parking lot along west side of park, off Glenrio or Fortuna Rd. NW, North end of parking area.



4 EAST SAN JOSE 6 Front parking lot off Williams St. SW, Main entrance to Community Recreation Center.



4 EAST SAN JOSE 7 Back parking lot off Williams St. SW, Main entrance to Community Recreation Center, and entrance to back playground area.



5 SOUTH SAN JOSE 8 Northwest corner of park, at the intersection of San Jose Ave. SE and Moqueka St. SE.



5 SOUTH SAN JOSE 9 North side of park, off San Jose Ave. SE, Mid-block, across from Moqueka St. SE.



6 HIGHLAND 10 North side of park, along San Jose Ave. SE, off University Blvd. SE, Mid-block, along San Jose Ave. SE.

PHOTOS FOR PARKS SHOWN ON SHEET 3



7 JACK & JILL 11 Southwest corner of park, Mid-block along Bell Ave. SE.
8 JACK & JILL 12 North east corner of park, Mid-block along Arizona St. SE.



9 SISTER CITIES 13 Southeast corner of park, adjacent to McKinney Dr. NE, across from Samantha Dr. NE.



9 SISTER CITIES 14 Northwest corner of park, adjacent to Harper Rd. NE, Mid-block along Harper Rd. NE.



9 MONTGOMERY NORTH 15 East side of park adjacent to Alvarado Dr. NE, Mid-block along Alvarado, across from Natalie Ave. NE.




9 MONTGOMERY NORTH 16 North side of park adjacent to Sonderosa Ave. NE, Mid-block along Sonderosa, across from Palomas Dr. NE.



10 AZTEC 17 North side of park adjacent to Cherokee Rd. NE, Mid-block between Moor St. and Cherokee Rd. NE.



10 AZTEC 18 East side of park adjacent to Cherokee Rd. NE, Mid-block along Cherokee Rd. NE.

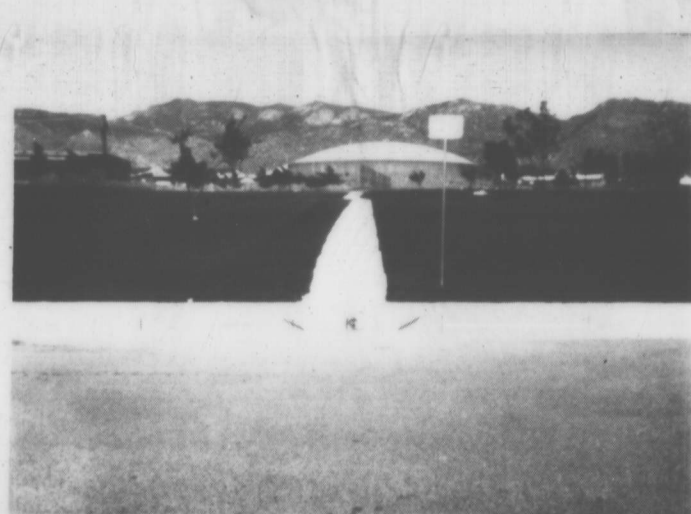

11 FORTNITE ESTATES 19 East side of park, adjacent to Parkway Place NE, Mid-block along Parkway, across from Parkway Ave. NE.



11 FORTNITE ESTATES 20 Northeast corner of park, adjacent to Skyview Ave. NE, Mid-block along Skyview Ave. NE.

PHOTOS FOR PARKS SHOWN ON SHEET 4



12 SAN CARRITO 21 South parking lot off Santa Ave. NE, North end of parking area.



13 LOS DURANES 22 North end of west parking lot off Galsaldeo Rd. NW and Leopoldo Rd. NW.



13 LOS DURANES 23 North side of park adjacent to Leopoldo Rd. NW, Mid-block along Leopoldo as alignment change.



14 GRAVES 24 Southwest corner of park, at 9th St. NW, just north of 9th St. NW and Indian School Rd. NW.



14 GRAVES 25 Northeast corner of park, along Cutler Ave. NW.



15 COLUMBUS 26 Northwest corner of parking lot off Douglas MacArthur St. NW and Guadalupe Trail NW.



15 COLUMBUS 27 Northeast corner of parking lot off Douglas MacArthur St. NW and Guadalupe Trail NW.




16 GOODRICH 28 Northwest corner of park at Goodrich Loop.



16 GOODRICH 29 Northeast corner of park at Goodrich Loop.

LEGEND FOR PHOTO LABELS

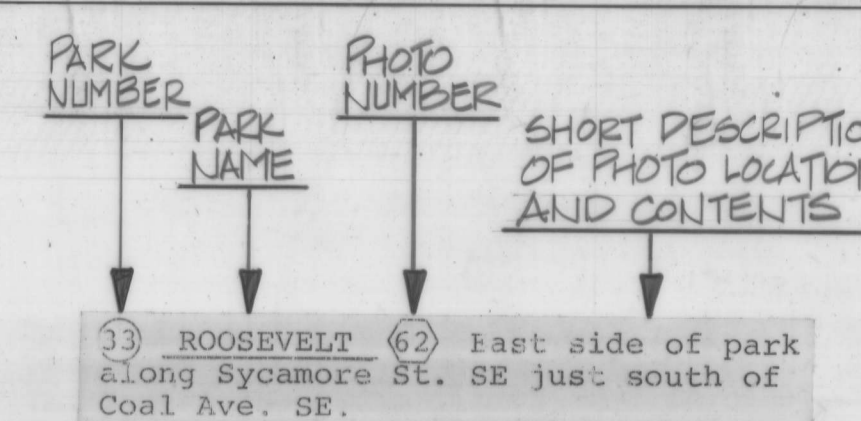


MEURER, SERAFINI AND MEURER, INC. CONSULTING ENGINEERS - SURVEYORS - PLANNERS
2001 WYOMING BLVD., NE SUITE 17 ALBUQUERQUE, NEW MEXICO 87112 (505) 262-1100

PLANS PREPARED UNDER THE DIRECTION OF
OF
6788
APPROVED FOR CONSTRUCTION
CITY ENGINEER DATE 3/16/81

CITY OF ALBUQUERQUE
ENGINEERING DIVISION
TITLE: CITY PARK HANDICAPPED RAMPS
PHOTOS FOR PARKS 1 THRU 29

APPROVALS	ENGINEER	DATE	APPROVALS	ENGINEER	DATE
City Engineer			Liquid Waste	N/A	
A.C.E. - Design			Traffic		2/16/81
A.C.E. - Hydrology			Water	N/A	


DRAWING NO. 1065 SHEET 8 OF 10
DESIGNED BY D. WALL DATE 11-10-80
DRAWN BY P. MAIN DATE 11-10-80
CHECKED BY J.D. HART JR. DATE 11-10-80

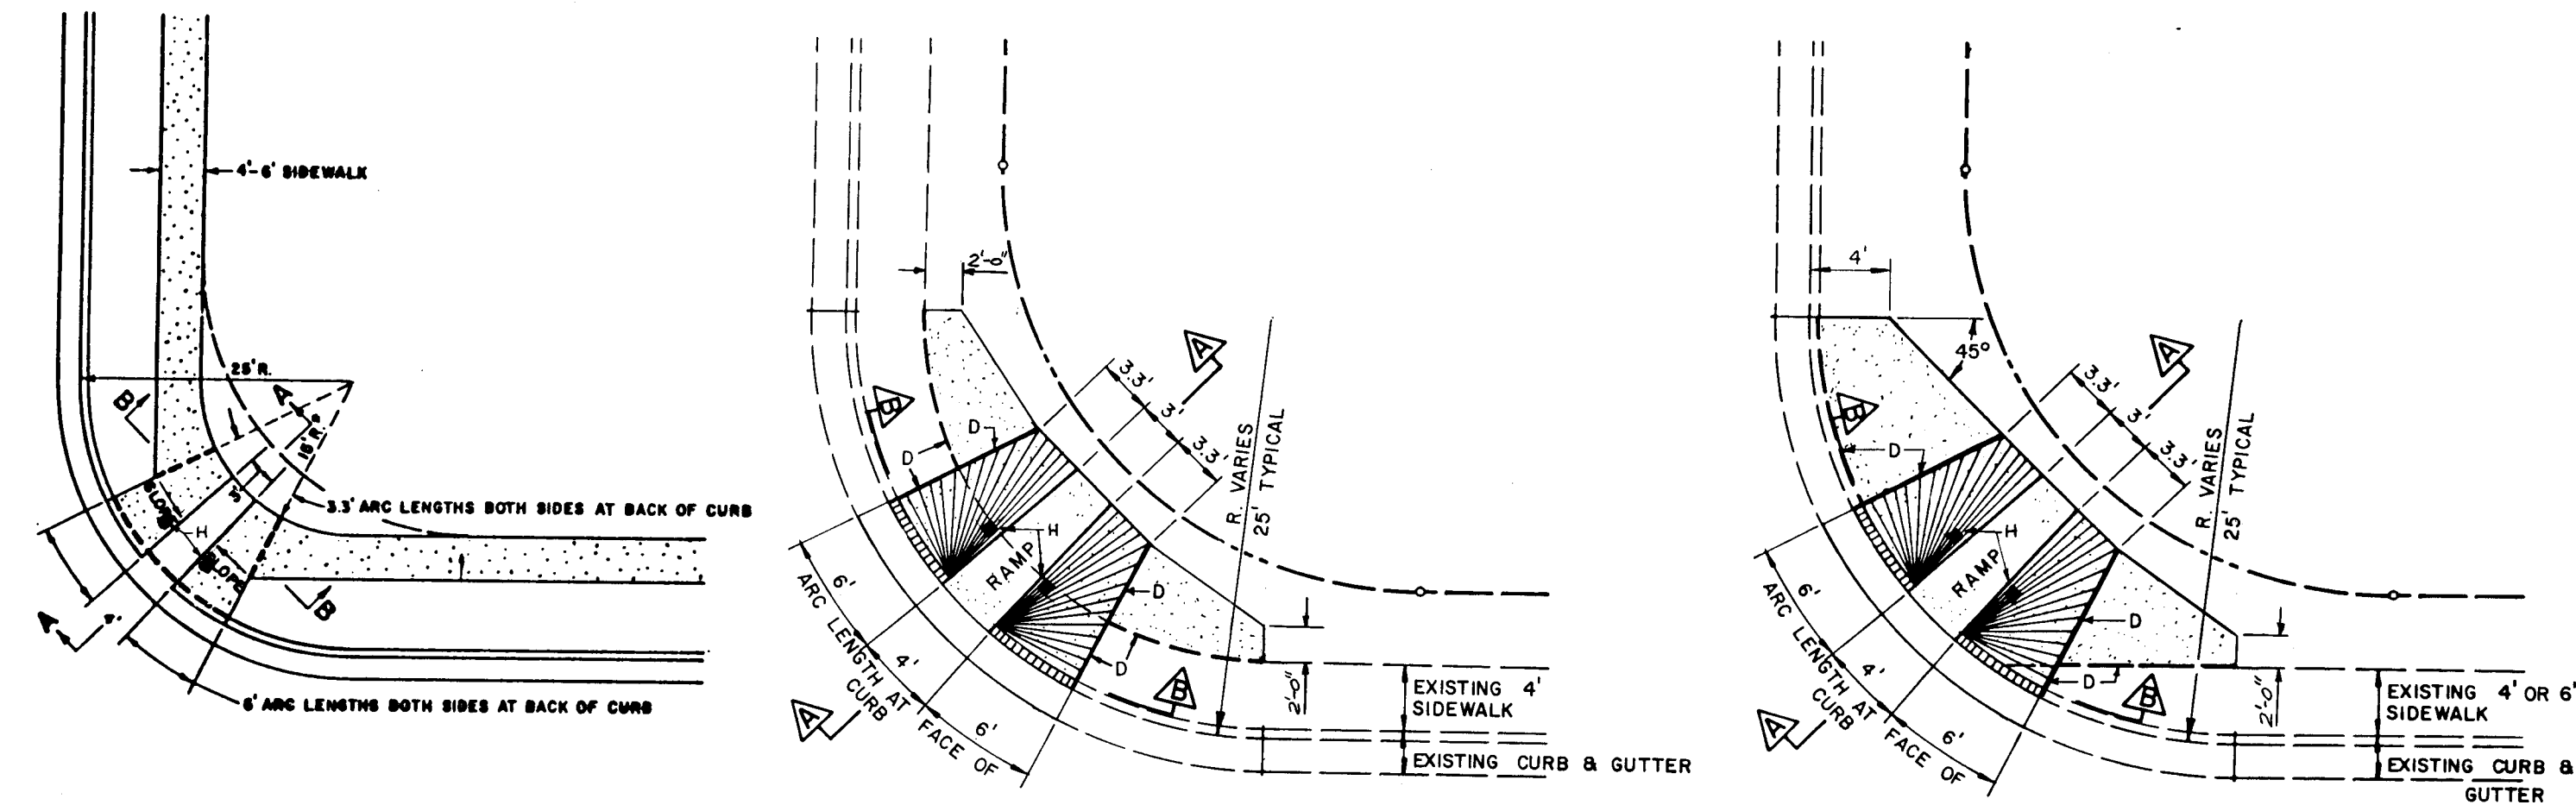


PLAN: TYPE "P-17" RAMP

PLAN: TYPE "B" RAMP


PLAN: TYPE "C" RAMP

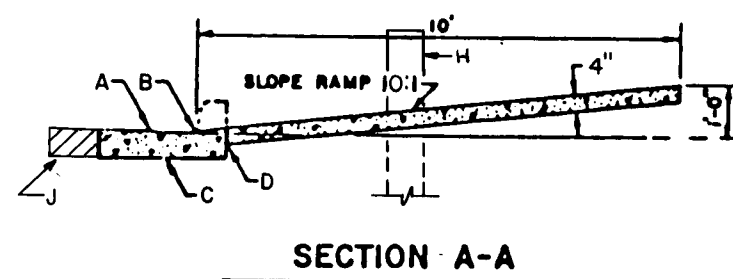


SECTION A-A

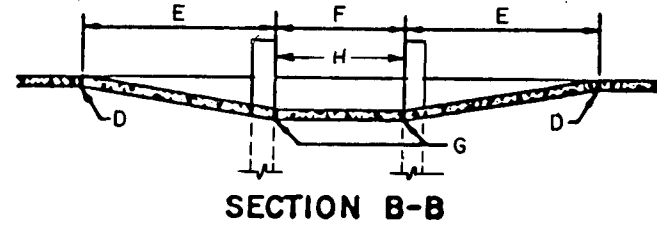


SECTION B-B

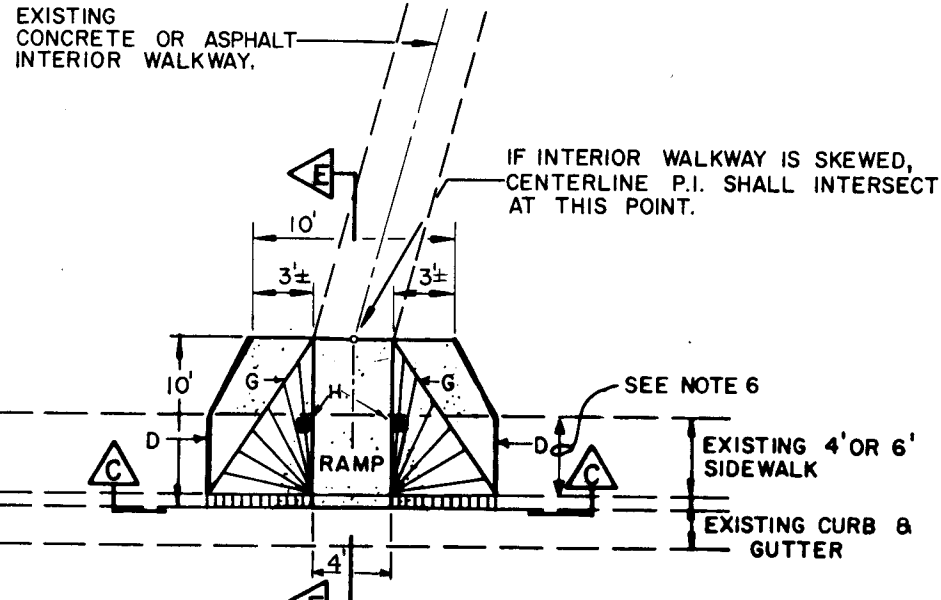


PLAN: TYPE "D" RAMP

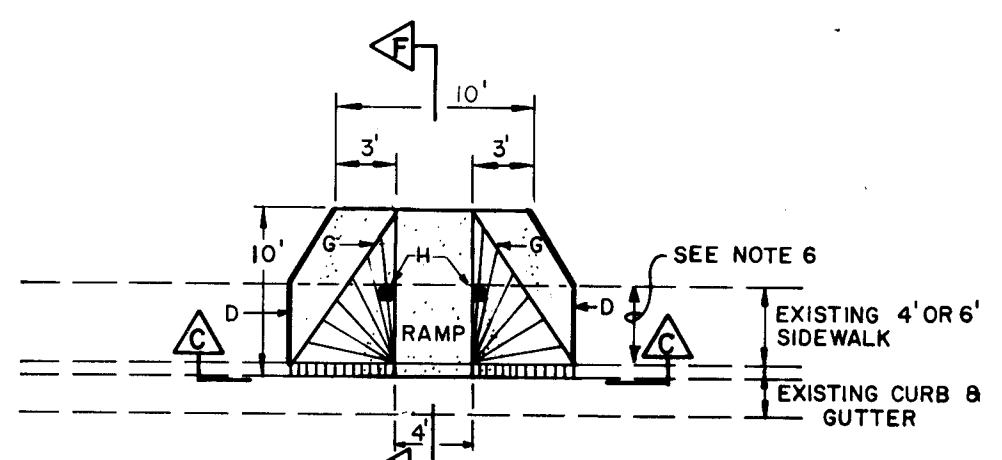


PLAN: TYPE "E" RAMP

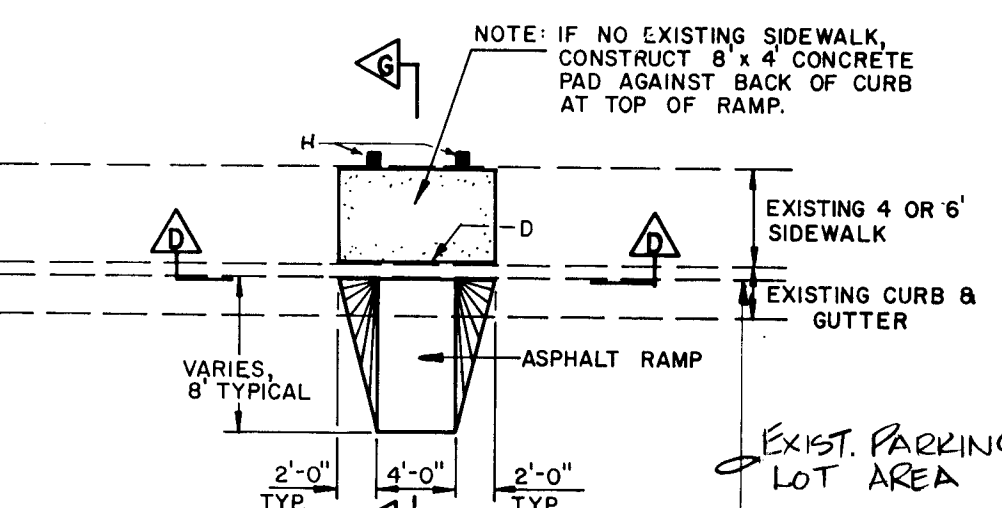


PLAN: TYPE "F" RAMP

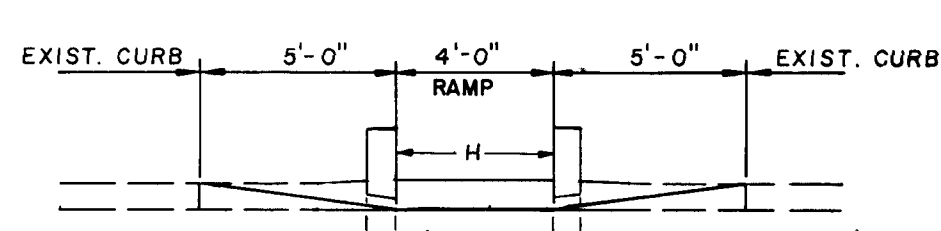


SECTION C-C

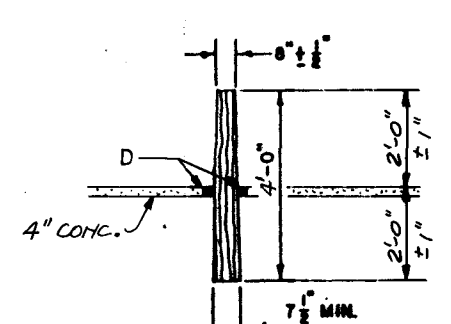


TYPICAL GUARD POST

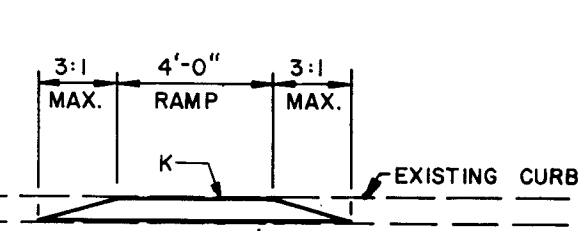


SECTION D-D

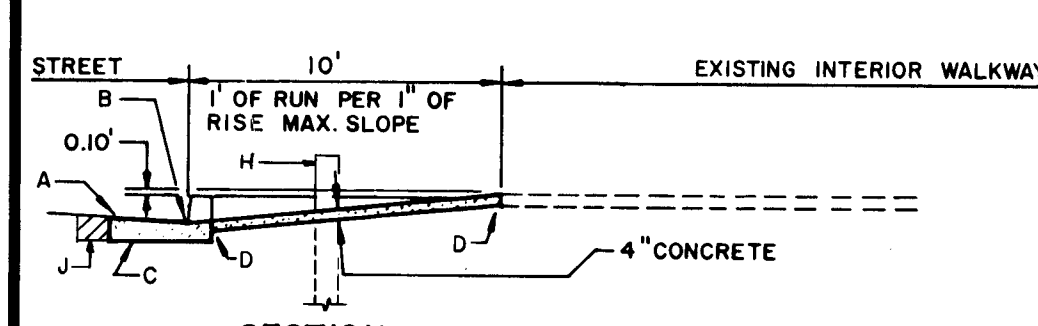

SECTION E-E

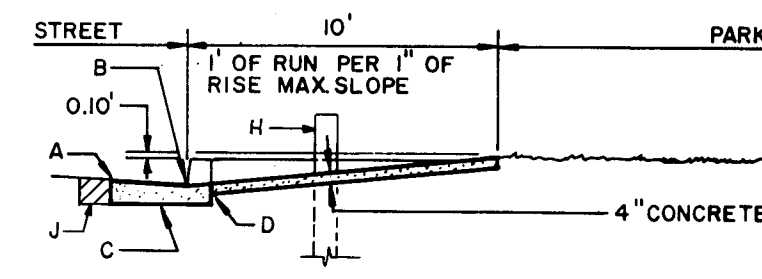

SECTION F-F

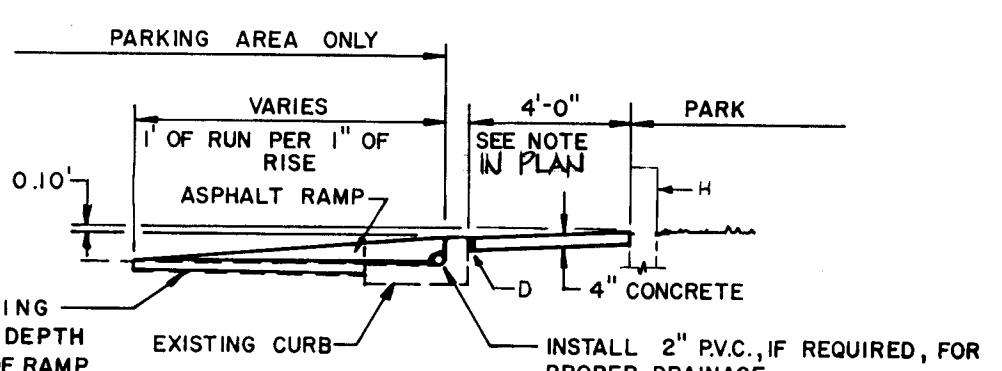

SECTION G-G

RAMP DETAILS

NOT TO SCALE

GENERAL NOTES:

- RADIUS VARIES DEPENDING UPON LOCATION OF BACK OF SIDEWALK. RADIUS SHALL BE ESTABLISHED SO AS TO MAINTAIN 10' LENGTH OF RAMP.
- WHEEL CHAIR RAMPS ARE NORMALLY TO BE LOCATED AT THE CENTER OF RETURN OR AS DIRECTED BY THE CITY TRAFFIC ENGINEER.
- SURFACE TEXTURE OF WHEEL CHAIR RAMP SHALL BE OBTAINED BY HEAVY BROOMING (TEXTURE DEPTH .035"), TRANSVERSE TO THE SLOPE OF THE RAMP.
- SLOPES SHALL BE UNIFORM WITH NO ABRUPT CHANGES IN GRADE.
- GUTTER FLOW-LINE PROFILE SHALL BE MAINTAINED THROUGH THE AREA OF THE RAMP, AND DRAINAGE CATCH BASIN STRUCTURES SHALL NOT BE PLACED IN LINE WITH RAMPS.
- IF NO EXISTING SIDEWALK THIS DIMENSION TO BE 4'-0".
- SUBGRADE UNDER SIDEWALKS SHALL BE COMPACTED TO 90% MAX. DENSITY AS DETERMINED BY A.S.T.M. D-1557 TO A DEPTH OF 6".
- GUARD POSTS SHALL PROJECT 2' MIN. ABOVE CONCRETE, 4' MIN. FROM FACE OF CURB, AND 4' FROM EACH OTHER.

CONSTRUCTION NOTES:

- SLOPE OF GUTTER DEPENDENT ON REQUIREMENTS FOR VALLEY GUTTER.
- LIP AT GUTTER LINE.
- CURB AND GUTTER.
- EXPANSION JOINT.
- 4' FT. AT FACE OF CURB.
- 4' FT. AT FACE OF CURB, 3' FT. MIN. AT BACK OF SIDEWALK.
- CONTRACTOR (BURNETT) JOINTS.
- 8' x 8' TREATED GUARD POST.
- REMOVE AND REPLACE 1'-0" WIDTH OF EXIST. PAVEMENT WHENEVER CURB AND GUTTER IS REMOVED. REPLACE W/ STD. ARTERIAL OR RESIDENTIAL PAVING DEPENDING ON EXISTING PAVEMENT THICKNESS.
- CONTRACTOR MAY SUBSTITUTE FULL DEPTH ASPHALTIC CONCRETE FOR SAME PRICE AS ITEMS SHOWN.

ESTIMATED QUANTITIES

SPECIAL NOTES
 A. IF ONE RAMP IS BUILT, DIVIDE ALL ESTIMATED QUANTITIES BY 2 TO FIND QUANTITY REQUIRED TO BUILD ONE RAMP.
 B. THE TYPE E RAMP MAY BE BUILT BY A PROJECT BUILDING A CUL-DE-SAC AT PASEFAL & CLAREMONT, IF SO, BUILD ONLY THE TYPE D RAMP UNDER THIS CONTRACT.

1. CURB & SIDEWALK REMOVALS ARE TO THE NEAREST JOINT SO THAT ONLY COMPLETE STONES ARE REMOVED.

SPECIAL NOTE	PARK NUMBER	PARK NAME	ZONE ATLAS MAP NUMBER	SHEET WHERE SHOWN ON THESE PLANS	RAMP TYPE & QUANTITY TO BE CONSTRUCTED							
					EXIST	P-17	B	C	D	E	F	
A.	①	ALAMOSA	L-11	2		1		1				
	②	PAT HURLEY	J-11	2								1
	③	WEST MESA	J-10	2						2		
	④	EAST SAN JOSE	L-14	2								2
	⑤	SOUTH SAN JOSE	M-14	2		1						
	⑥	KIRTLAND	M-15	2	1				1			
	⑦	JACK & JILL	L-18	3					2			
	⑧	SISTER CITIES	E-18	2					2			
	⑨	MONTGOMERY NORTH	G-14	2						2		
	⑩	AZTEC	J-12	2						2		
		⑪	FOOTHILLS ESTATES (LAUREN C. BOLLES)	K-22	2				2			
	⑫	SAN GABRIEL	J-12	4				1				
	⑬	LOS DURANES	H-12	4	1					1	1	
	⑭	GRAVES	H-14	4					1	1		
	⑮	COLUMBUS	H-14	4								2
	⑯	GOODRICH	F-14	4		2						
	⑰	BATAAN	J-16	5		2						
	⑱	ALTURA	J-17	5						2		
	⑲	GRISHAM	G-17	5		1				1		
	⑳	QUIGLEY	H-18	5						2		
	㉑	FOX MEMORIAL	K-18	5						2		
		㉒	INEZ	H-19	5						2	
㉓		TAYLOR	H-19	6						2		
㉔		HOFFMAN	H-20	6		1				1		
㉕		CONCHAS	H-20	6						1	1	
㉖		LOS ALTOS	K-20	5	1				2			
㉗		JEANNE BELLAMAH	J-21	5						2		
㉘		HOLIDAY	G-22	5							1	
㉙		TRUMBELL	L-12	7					1	1		
㉚		WILSON	L-12	7	1					1	1	
㉛		BURTON	J-16	7						2		
		㉜	HYDER	J-16	7			1			1	
	㉝	ROOSEVELT	K-16	7	1	TO BE RENOVATED				2		

STANDARD ESTIMATED QUANTITIES												
RAMP TYPE	REMOVALS				CONSTRUCTION							
	P-13	P-14	M-1	P-42	P-46	M-22	M-13	M-25	P-71	P-60		
P-17	16 LF	0	0	128 LF		6 LF	0	0	0	0	2 EA	
B	16 LF	6.66 SF	0	32 SF		6 LF	0	0	0	0	2 EA	
C	16 LF	0.11 TO 1.0 SF	0	48 LF		6 LF	0	0	0	0	2 EA	
D	14 LF	8.25 TO 9.11 SF	0	120 LF		4 LF	0	0	0	0	2 EA	
E	14 LF	5.44 TO 6.22 SF	0	180 LF		4 LF	0	0	0	0	2 EA	
F	0	0	3.15 TO 4.37 SF	32 SF		0	4.00 TO 5.30 SF	4.20 TO 5.30 SF	4.00 TO 5.30 SF	8 LF	2 EA	
* IF REQUIRED												

MEURER, SERAFINI AND MEURER, INC.
 CONSULTING ENGINEERS - SURVEYORS - PLANNERS
 2601 WYOMING BLVD., N.E. SUITE F ALBUQUERQUE, NEW MEXICO 87112 (505) 292-1936

PLANS PREPARED UNDER THE DIRECTION OF

APPROVED FOR CONSTRUCTION
 DATE 3/11/81
 CITY ENGINEER

CITY OF ALBUQUERQUE
 MUNICIPAL DEVELOPMENT DEPARTMENT
 ENGINEERING DIVISION

TITLE: CITY PARK HANDICAPPED RAMPS
 RAMP DETAILS - ESTIMATED QUANTITIES

APPROVALS	ENGINEER	DATE	APPROVALS	ENGINEER	DATE
City Engineer			Liquid Waste	M/A	
A.C.E. - Design			Traffic	T. HART, JR.	3/11/81
A.C.E. - Hydrology			Water	M/A	

DRAWING NO. 1065
 SHEET 10 OF 10