


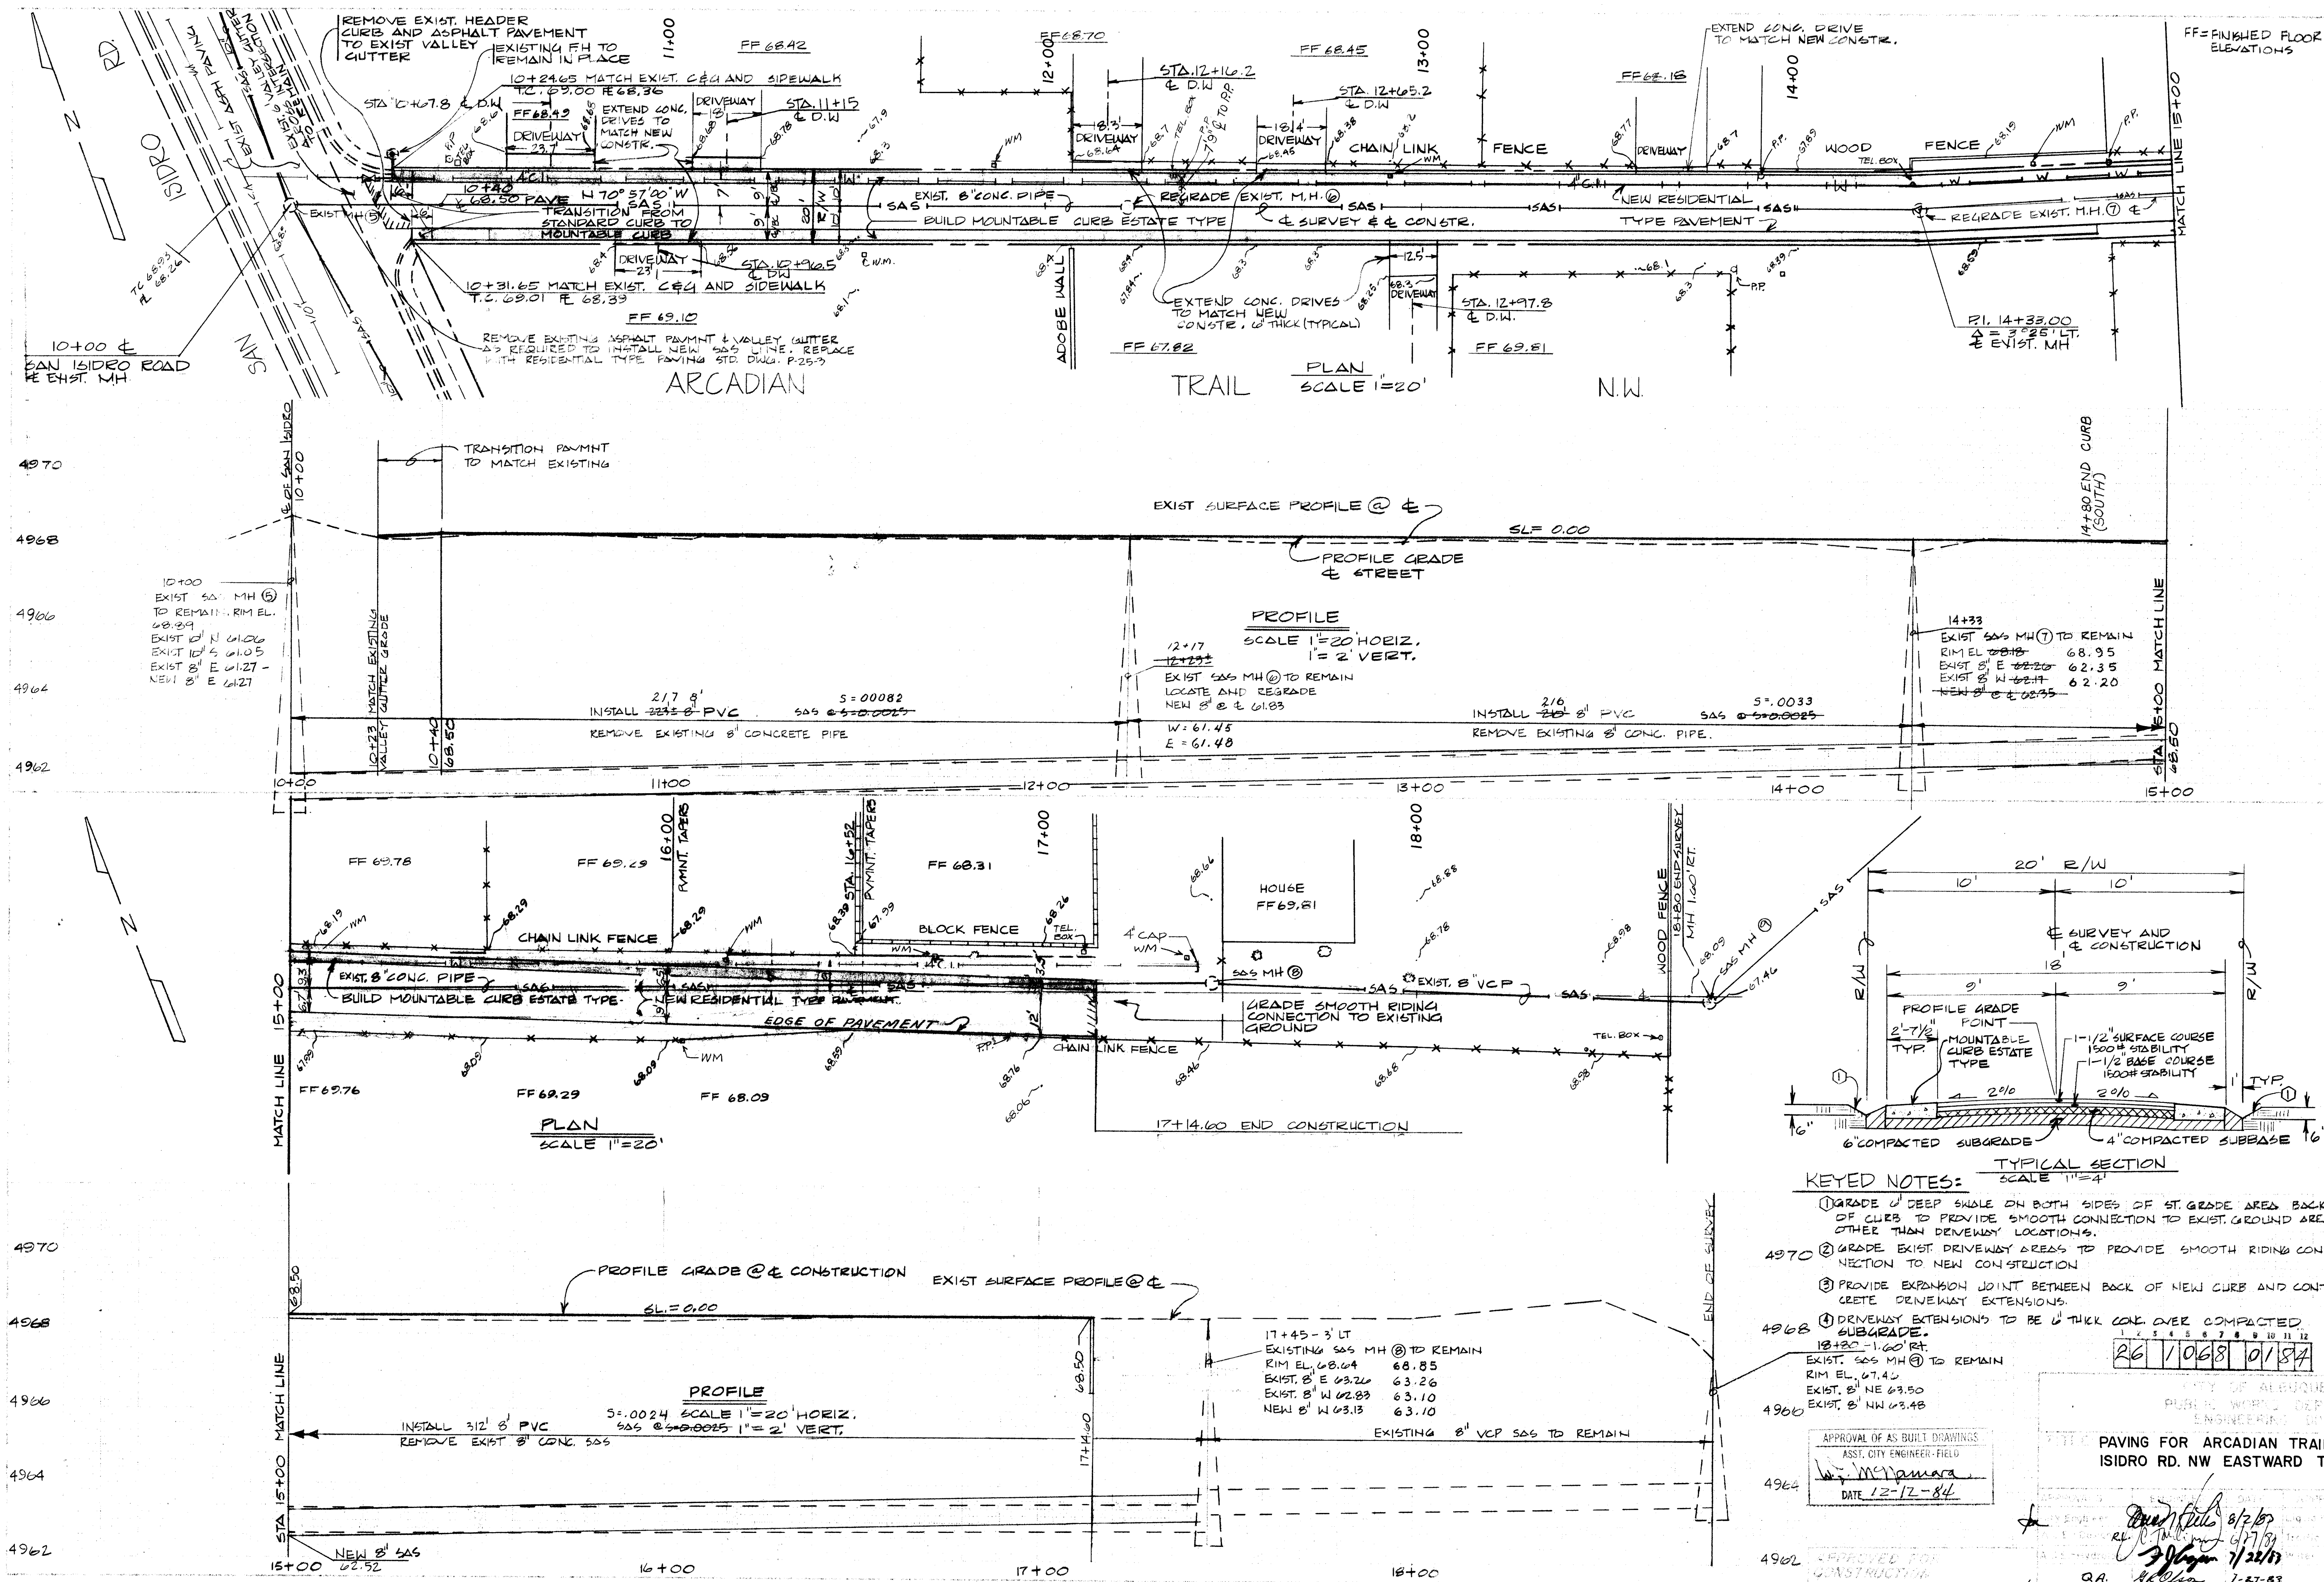

CEM 4968 94 T/C S. RET. S.E. COR
SAN VIDRO & ARCADIAN
BM 104-13 AT INTERSECTION OF CHEROKEE
RD. N.W. AND SAN VIDRO ST. N.W.
A SQUARE CORNERED IN TOP OF
CONCRETE CURB AT THE SSUN
ELEV. 1067.70

ANGEL
 J. DURAN
 J. GARCIA
 R. BARROS

P. FISCHER/R. LOVATO
S.U.S./C.C./M.B.
P. LOVATO

KEYED NOTES:

- ① GRADE 6" DEEP SHOULDER ON BOTH SIDES OF ST. GRADE AREA BACK OF CURB TO PROVIDE SMOOTH CONNECTION TO EXIST. GROUND AREAS OTHER THAN DRIVEWAY LOCATIONS.
- 4970 ② GRADE EXIST. DRIVEWAY AREAS TO PROVIDE SMOOTH RIDING CONNECTION TO NEW CONSTRUCTION
- ③ PROVIDE EXPANSION JOINT BETWEEN BACK OF NEW CURB AND CONCRETE DRIVEWAY EXTENSIONS.
- 4968 ④ DRIVEWAY EXTENSIONS TO BE 6" THICK CONC. OVER COMPACTED SUBGRADE.
- 13+20 1.60 FT.
EXIST. S&G MH ⑤ TO REMAIN
- RIM EL. 67.42
- EXIST. 8' NE 63.50
EXIST. 8' NW 63.48
- | | | | | | | | | | | | |
|----|---|---|---|---|---|---|---|---|----|----|----|
| 1 | 2 | 3 | 4 | 5 | 6 | 7 | 8 | 9 | 10 | 11 | 12 |
| 26 | 1 | 0 | 6 | 8 | 0 | 7 | 8 | 4 | | | |
- CITY OF ALBUQUERQUE
PUBLIC WORKS DEPARTMENT

PAVING FOR ARCADIAN TRAIL N.W. FROM SAN
ISIDRO RD. NW EASTWARD TO END OF R/W.

APPROVAL OF AS BUILT DRAWINGS
ASST. CITY ENGINEER - FIELD
W. J. McNamara
DATE *12-12-84*

1068

W.F. 628-83
A. J. Fournier 7-1-83
W.F. 628-83