


LOCATION MAP F-15

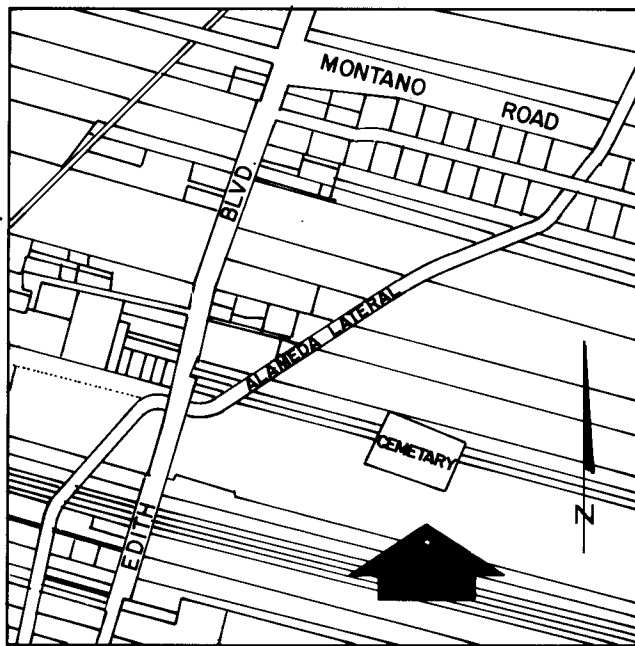

SHEET NO.	TITLE
1.	COVER SHEET
2.	PLAT
3.	UTILITIES P & P

NIKANDA ROAD - WATER LINE

ALBUQUERQUE NEW MEXICO

NOTICE TO CONTRACTORS.

NEW MEXICO STANDARD SPECIFICATIONS FOR PUBLIC WORKS CONSTRUCTION - 1979 EDITION WILL BE REFERRED TO HEREON AS THE STANDARD SPECIFICATION.

ALL UTILITIES AND UTILITY SERVICE LINES SHALL BE INSTALLED PRIOR TO FINISH.

BACKFILL COMPACTION SHALL BE ACCORDING TO SPECIFIED STREET USE.

BACKFILL REQUIREMENTS SHALL BE DETERMINED BY THE CITY ENGINEER.


SIDEWALKS AND WHEELCHAIR RAMPS WITHIN THE CURB RETURN SHALL BE CONSTRUCTED WHENEVER A NEW CURB RETURN IS CONSTRUCTED.

IF CURB IS DEEPENED FOR A DRIVEWAY, THE DRIVEWAY SHALL BE CONSTRUCTED PRIOR TO ACCEPTANCE OF THE CURB AND BUTTER.

ALL STORM DRAINAGE FACILITIES SHALL BE COMPLETED PRIOR TO FINAL ACCEPTANCE.



TWO WORKING DAYS PRIOR TO ANY EXCAVATION, CONTRACTOR MUST CONTACT LINE LOCATING SERVICE, 765-1854, FOR LOCATION OF EXISTING UTILITIES.

PRIOR TO CONSTRUCTION, THE CONTRACTOR SHALL EXAMINE AND VERIFY THE HORIZONTAL AND VERTICAL LOCATIONS OF ALL OBSTRUCTIONS SHOULD A CONFLICT EXIST, THE CONTRACTOR SHALL NOTIFY THE ENGINEER OR SURVEYOR SO THAT THE CONFLICT CAN BE RESOLVED WITH A MINIMUM AMOUNT OF DELAY.

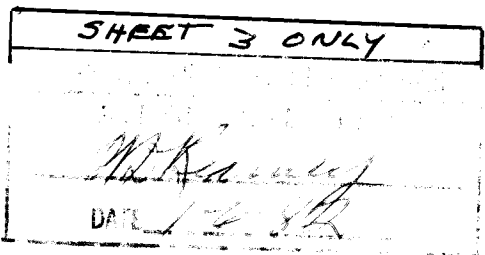

26 10780181

DESIGN ENGINEER : _____ DATE : MARCH 30, 81.
C.A. COONCE
CITY ENGINEER : Richard Heller DATE : 5/8/81
RICHARD HELLER

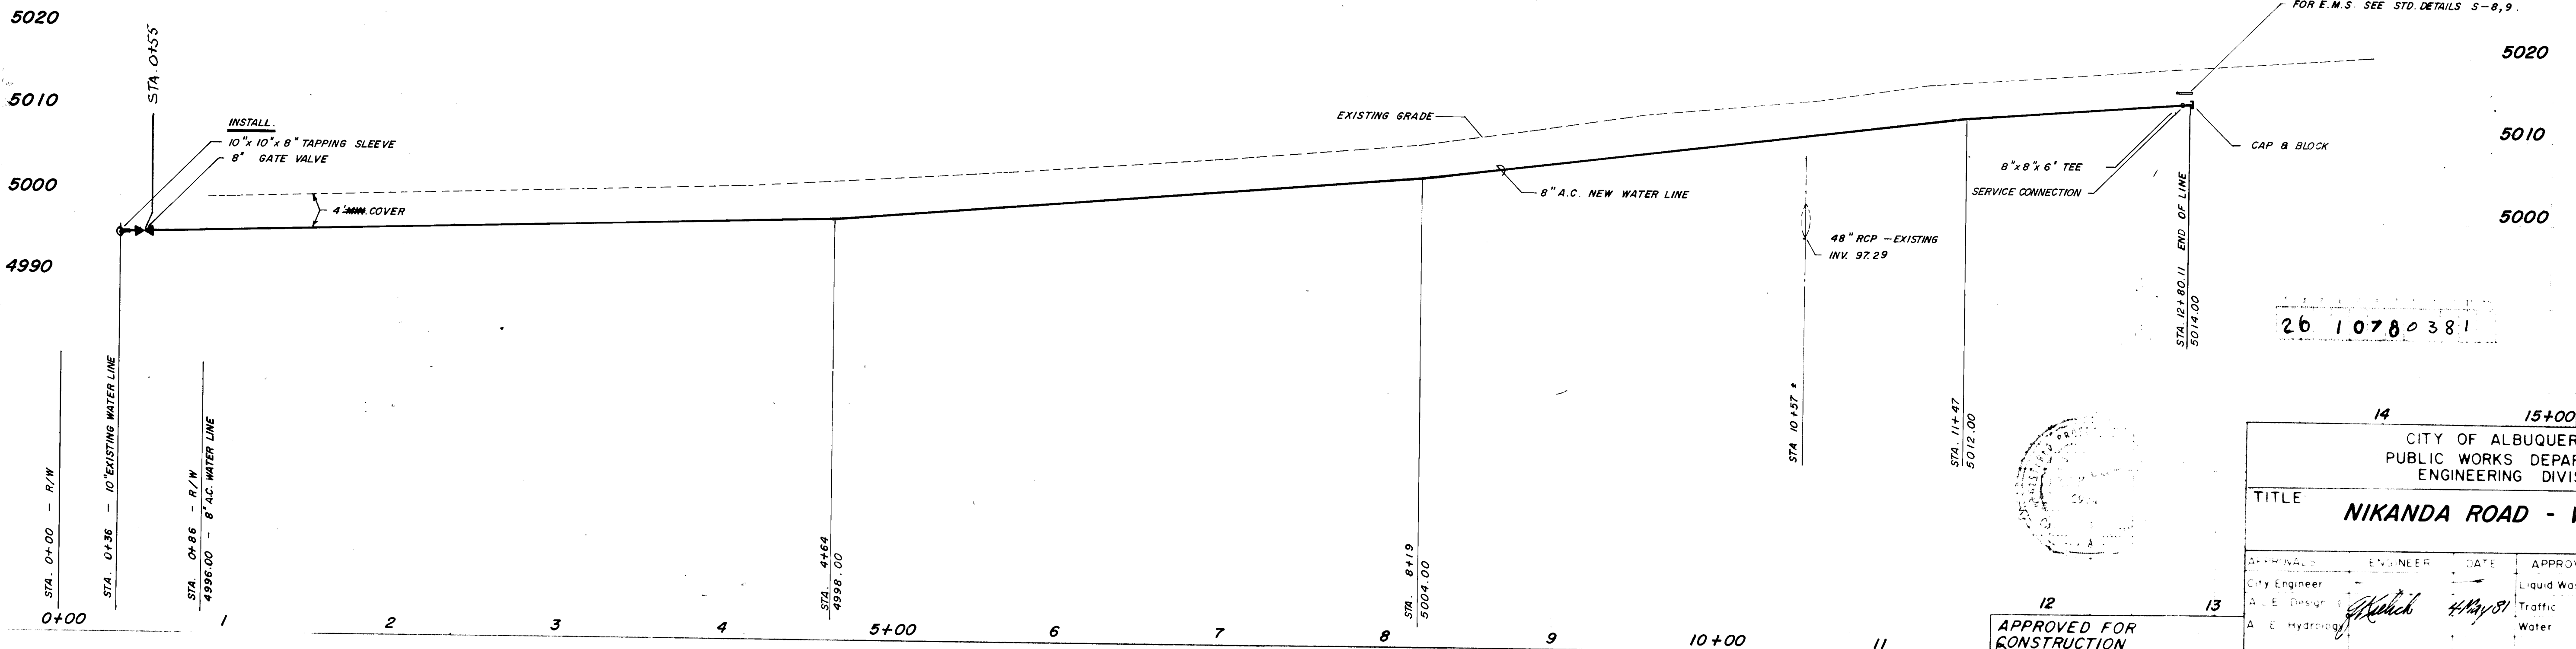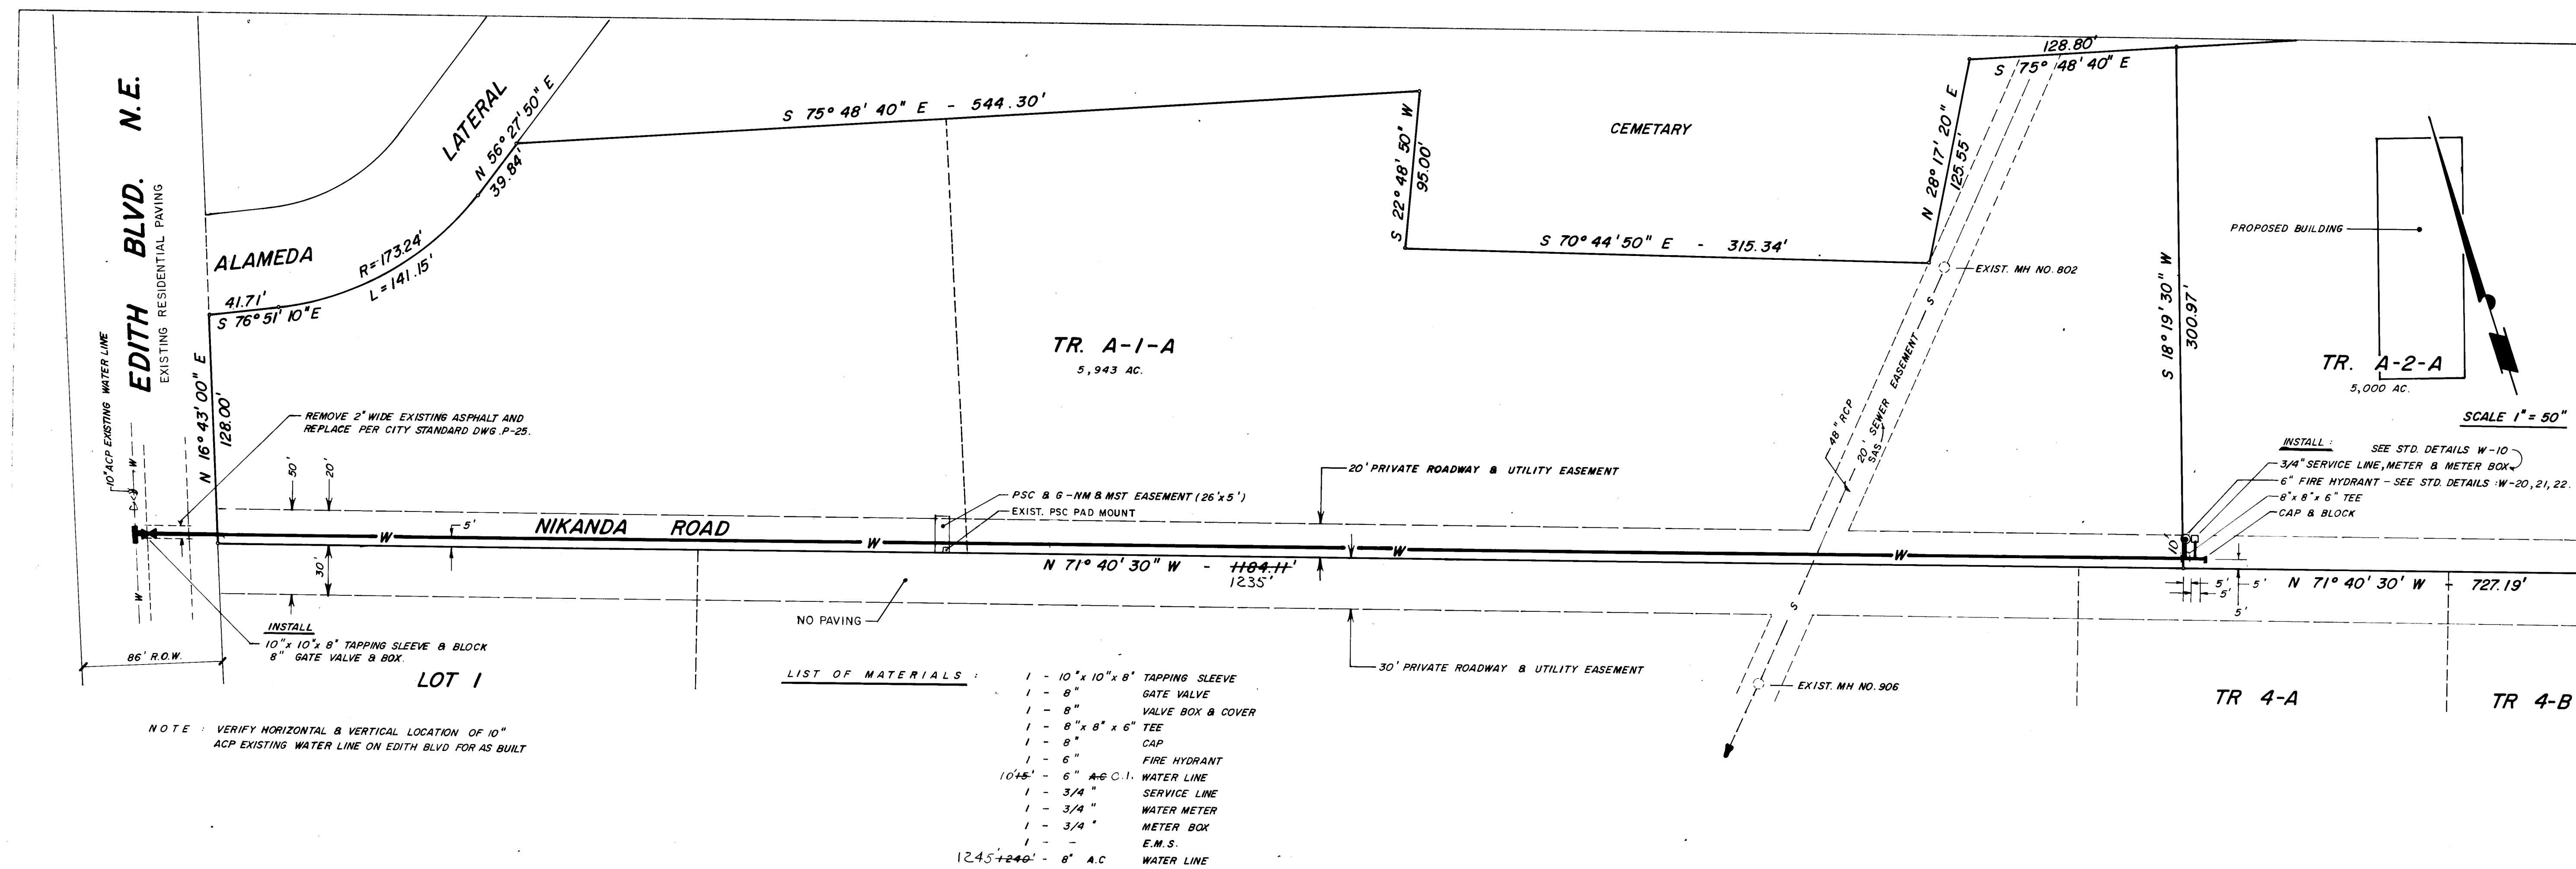

APPROVED FOR CONSTRUCTION

Richard S. Hill

CITY ENGINEER

DATE 5/8/81

CITY OF ALBUQUERQUE PUBLIC WORKS DEPARTMENT ENGINEERING DIVISION					
TITLE NIKANDA ROAD - WATER LINE					
APPROVED	ENGINEER	DATE	APPROVALS	ENGINEER	DATE
City Engineer			Liquid Waste	4-29-81	
A.E. Design			Traffic		
A.E. Hydrology			Water	4-29-81	
DESIGNED BY	DATE	DESIGNED BY	DATE	DESIGNED BY	DATE
DRAWN BY	MARCH 30, 81	DRAWN BY	MARCH 30, 81	DRAWN BY	MARCH 30, 81
CHECKED BY	C.A.C.	CHECKED BY	C.A.C.	CHECKED BY	C.A.C.
DRAWING NO. 1078			SHEET 3 OF 3		

REFERENCES		SURVEY INFORMATION		BENCH MARKS		AS BUILT INFORMATION	
MAP NO	WO NO	NO	FIELD NOTES				
EST NO			BY	DATE			
					N.M. 47-9 ELEV 4972.038		
					SH BRASS CAP IN MEDIAN ON 2ND ST. N.W. 125' N.E.		
					OF PLEASANT ST.		