

K-23

WATERLINE EXTENSION

SOUTH SIDE OF LOMAS BLVD.

FROM 464' WEST OF TO 234' WEST OF TOMASITA ST.

NOTES TO CONTRACTORS

1. The waterline extension shall be installed in accordance with the specifications and standards of the City of Albuquerque, New Mexico, and the National Fire Protection Association (NFPA) standards for fire protection systems.

2. The waterline extension shall be installed in accordance with the specifications and standards of the City of Albuquerque, New Mexico, and the National Fire Protection Association (NFPA) standards for fire protection systems.

3. The waterline extension shall be installed in accordance with the specifications and standards of the City of Albuquerque, New Mexico, and the National Fire Protection Association (NFPA) standards for fire protection systems.

4. The waterline extension shall be installed in accordance with the specifications and standards of the City of Albuquerque, New Mexico, and the National Fire Protection Association (NFPA) standards for fire protection systems.

5. The waterline extension shall be installed in accordance with the specifications and standards of the City of Albuquerque, New Mexico, and the National Fire Protection Association (NFPA) standards for fire protection systems.

6. The waterline extension shall be installed in accordance with the specifications and standards of the City of Albuquerque, New Mexico, and the National Fire Protection Association (NFPA) standards for fire protection systems.

7. The waterline extension shall be installed in accordance with the specifications and standards of the City of Albuquerque, New Mexico, and the National Fire Protection Association (NFPA) standards for fire protection systems.

8. The waterline extension shall be installed in accordance with the specifications and standards of the City of Albuquerque, New Mexico, and the National Fire Protection Association (NFPA) standards for fire protection systems.

9. The waterline extension shall be installed in accordance with the specifications and standards of the City of Albuquerque, New Mexico, and the National Fire Protection Association (NFPA) standards for fire protection systems.

10. The waterline extension shall be installed in accordance with the specifications and standards of the City of Albuquerque, New Mexico, and the National Fire Protection Association (NFPA) standards for fire protection systems.

X

26 10800182

SHEET 2 OF 2	
APPROVAL OF AS BUILT DRAWINGS	
ASST. CITY ENGINEER FIELD	
DATE 2/1/81	

LASON 1-505-344-9404
BEST COPY AVAILABLE


Richard S. Helle 7/28/81

1080

1 2

UT

UNIVERSITY
BIRMINGHAM
9/18

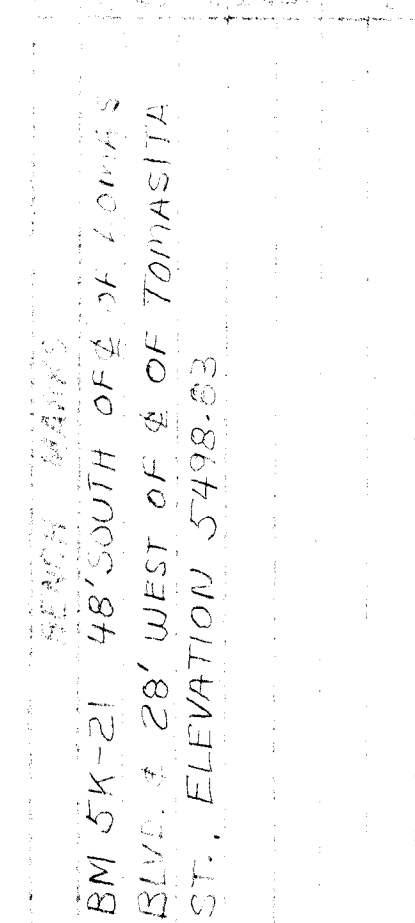

PS-18 P.F. ANGEL 4-7-81

100-443886-10
 100-443886-11
 100-443886-12
 100-443886-100

FROM
DEPARTMENTS
SOUTH
- SOUTH SIDE OF
WEST OF TO 234

SHEET 2 OF 2

_____ NEW WATER LINE
 — — W — — EXISTING WATER LINE
 — — UT — — UNDERGROUND TELEPHONE

CITY OF ALBUQUERQUE
MUNICIPAL DEVELOPMENT DEPARTMENT
ENGINEERING DIVISION

WATER LINE EXTENSION - SOUTH SIDE OF
OF LOMAS BLVD. - FROM 464' WEST OF TO 234'
WEST OF TOMASITA ST.

14A
D. Thompson 5/2/81

1080 K-21 2 OF 2