


4TH STREET
WATER EXTENSION STOVER TO CROMWELL

INDEX
SHT. 1 TITLE SHEET
SHT. 2 PLAN & PROFILE
SHT. 3 DETAIL DRAWING

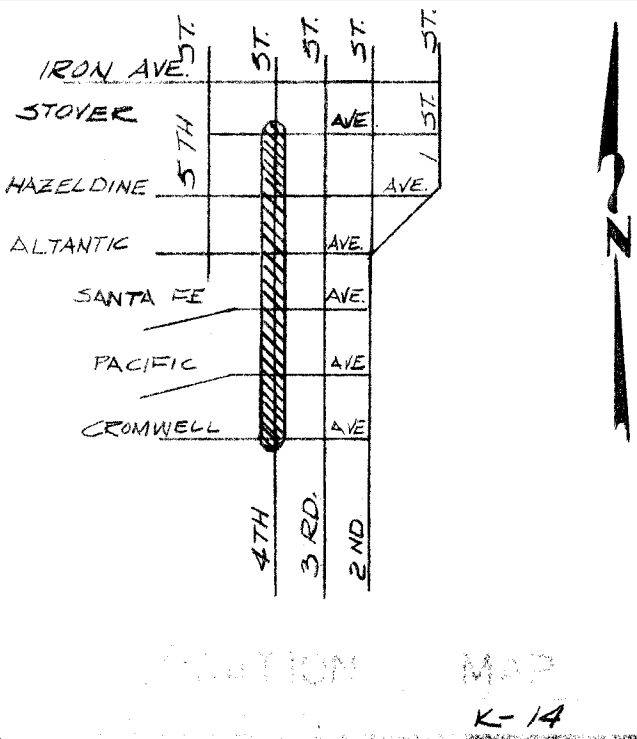

LASON 1-505-344-9404
BEST COPY AVAILABLE


APPROVAL OF AS BUILT DRAWINGS
ASSY. CITY ENGINEER - FIELD
[Signature]
DATE *12/15/82*

26 10810182

Richard Spiller 7/28/81

1081

1 3

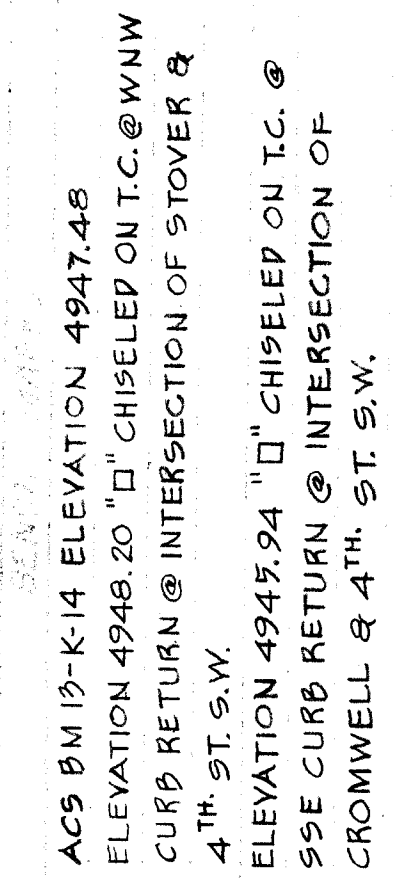

 EXIST. WATER LINE
 NEW WATER LINE
 NEW FIRE HYDRANT & NEW GATE VALVE
 REMOVE & REPLACE WATER METER

1081

9/17/81 EXCHANGED VALVE ON #1ST 4 STROVER
STATIONING ON VALVES.

6/24/81
SERGIO MIRANDA
ANDY J. OLIVAS

APPROVED FOR
CONSTRUCTION
Richard S. Hall 7/29/81
CITY ENGINEER DATE




CITY OF ALBUQUERQUE
PUBLIC WORKS DEPARTMENT
ENGINEERING DIVISION
FILE: WATERLINE EXTENSION ON 4TH STREET
FROM STOVER AVE. TO CROMWELL AVE. S.W.

Shround 7/1/81
Shround 7/1/81

1081

2

3

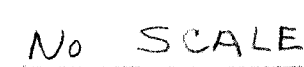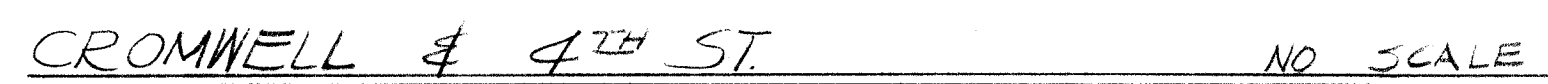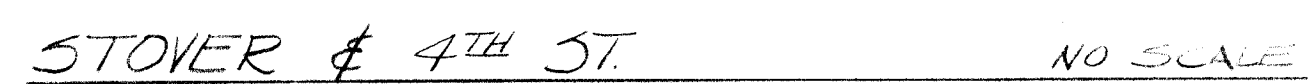

CITY OF ALBUQUERQUE
MEMORIAL DEVELOPMENT DEPARTMENT
ENGINEERING DIVISION

TITLE WATERLINE EXTENSION ON 4TH STREET
FROM STOVER AVE. TO CROMWELL AVE. SW

ENGINEER J. C. BROWN
CITY ENGINEER
CHECKED BY
DATE
APPROVED BY
DATE

J. C. Brown 18 Jun 81
D. H. H. H. H. H. 7/1/81
D. H. H. H. H. H. 7/1/81

DRAWING NO. 1081
SHEET 3 OF 3