

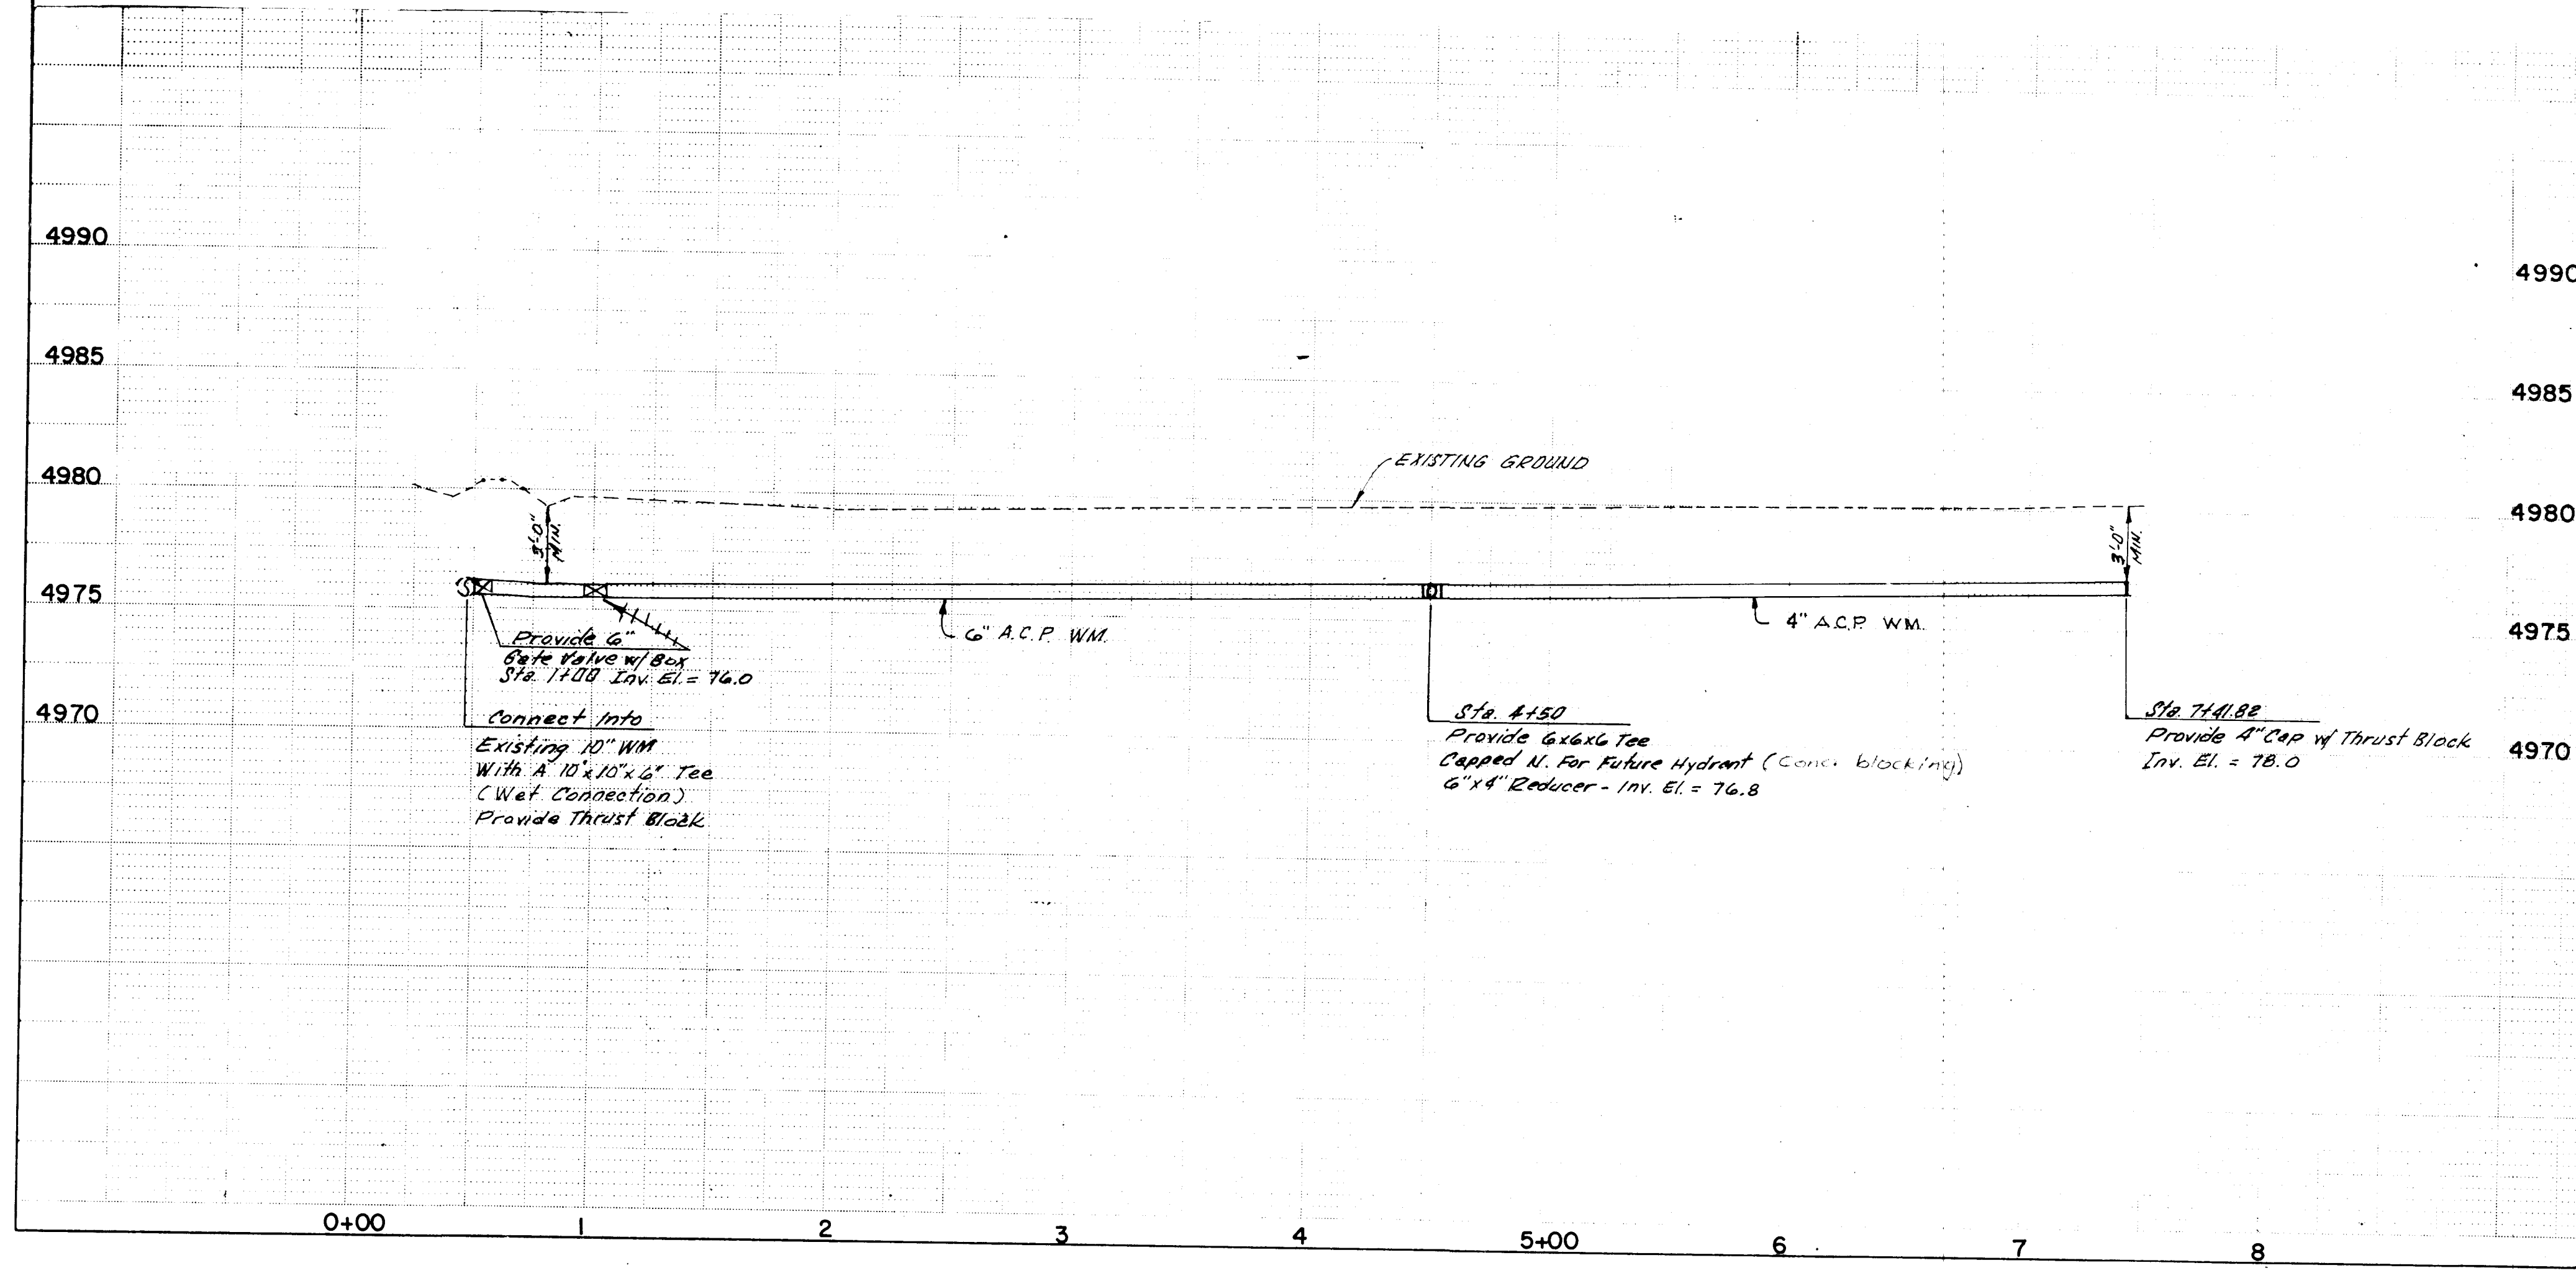


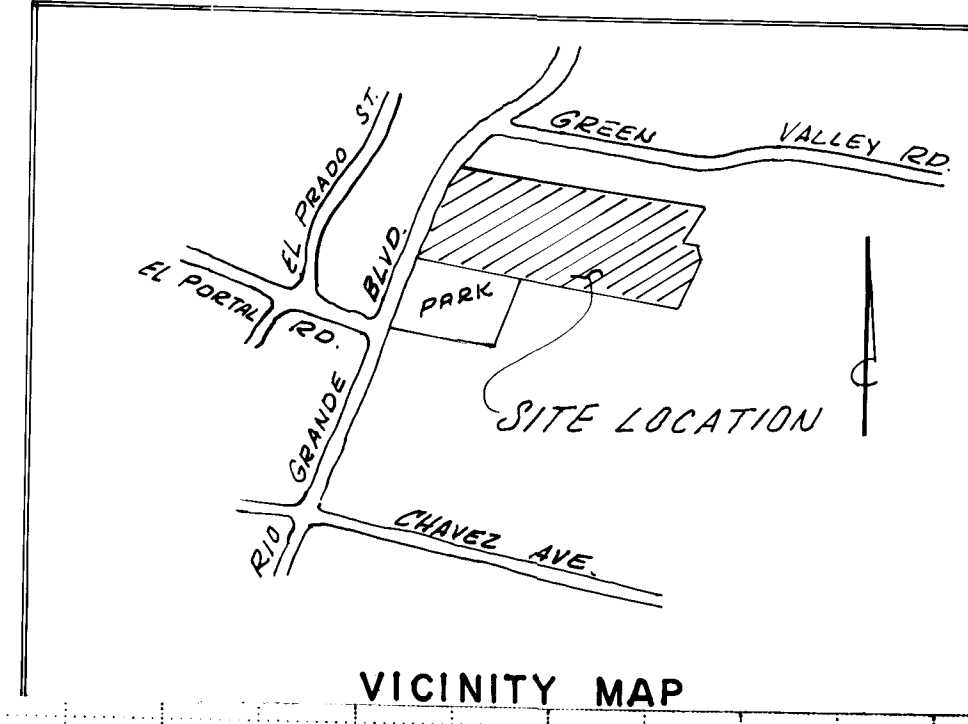

APPROVAL OF AS BUILT DRAWINGS
ASST. CITY ENGINEER - FIELD
DATE 11/19/77

23 108 0177

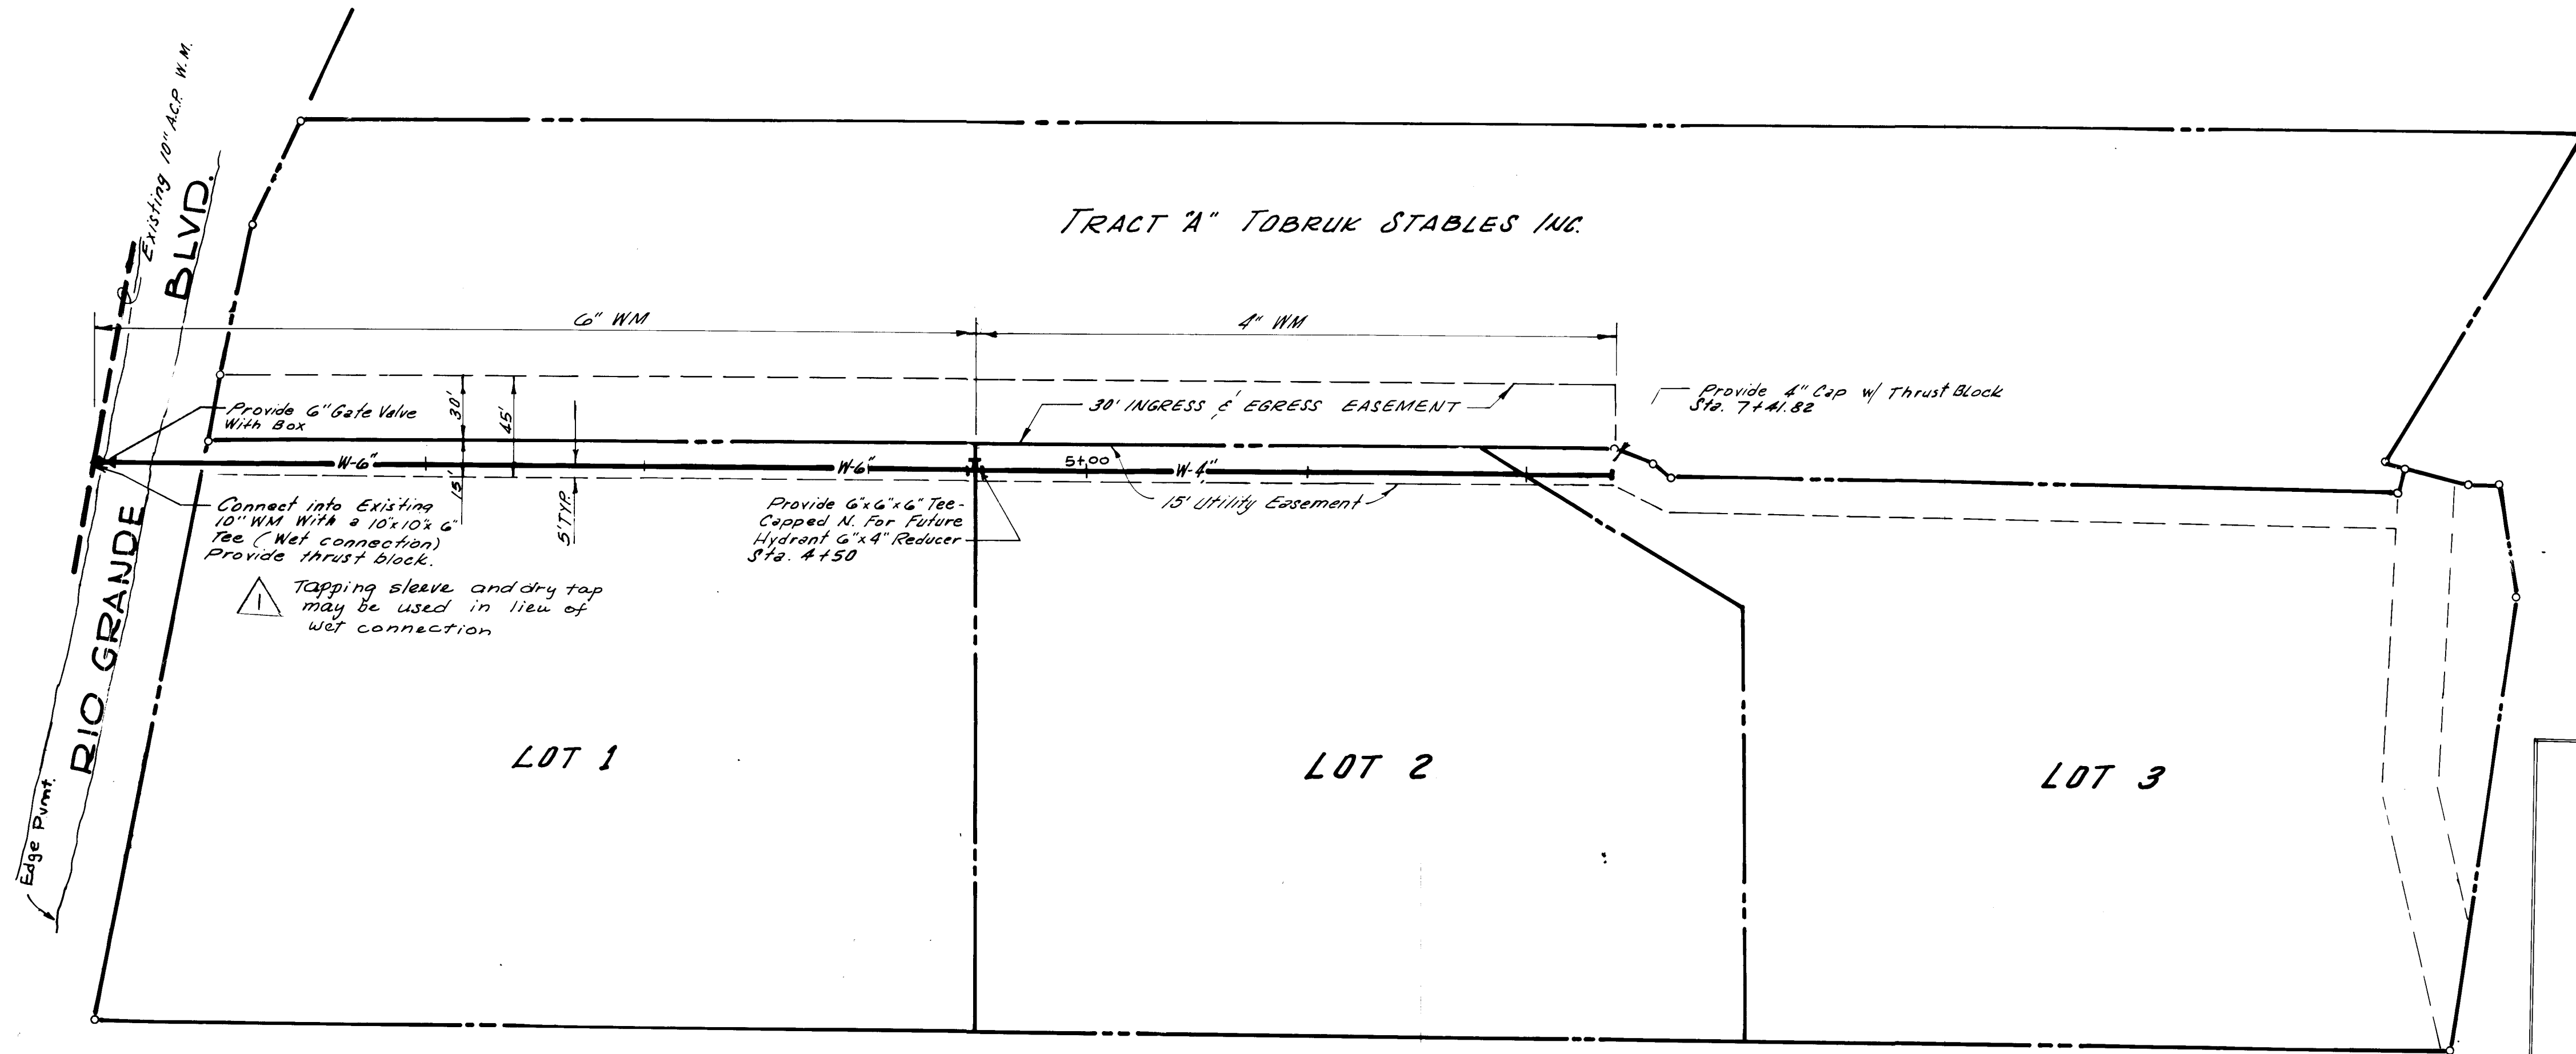

APPROVED FOR CONSTRUCTION
CITY ENGINEER DATE

AS BUILT INFORMATION			
CONTRACTOR	DON COE	DATE	
DESIGNED BY		DATE	
CHECKED BY	BEAN, M.	DATE	11-6-78
FIELD LOCATION BY		DATE	
DRAWINGS		DATE	3-8-78
CONTRACTED BY	ORTEGA, P.	DATE	
AS BUILT INFORMATION			
RECORDED BY		DATE	
NO.	23-108-0178	DATE	524178

DATE	AUG 1977
SCALE	1"=50' H 5'
DRAWN	K.W.
CHECKED	ROD
NO.	32-1-0001

CITY OF ALBUQUERQUE PUBLIC WORKS DEPARTMENT ENGINEERING DIVISION					
TITLE: PRADOS TRANQUILOS WATER EXTENSION DESIGN					
APPROVALS	ENGINEER	DATE	APPROVALS	ENGINEER	DATE
City Engineer		11/19/77	Liquid Waste		
A.C.E. - Design		1/3/77	Traffic		
A.C.E. - Hydrology			Water		
DRAWING NO.	W-108-77			SHEET	1 OF 1

SURVEY INFORMATION		BENCH MARKS		AS BUILT INFORMATION	
MAP NO.	E-14-84	CONTRACTOR	CONTRACTOR	WORK	DATE
EST. NO.	W-108-77	DATE	DATE	DESIGNED BY	DATE
NO.		BY	BY	CHECKED BY	DATE
NO.		NO.	NO.	FIELD LOCATION BY	DATE
NO.		NO.	NO.	DRAWINGS	DATE
NO.		NO.	NO.	CONTRACTED BY	DATE
NO.		NO.	NO.	RECORDED BY	DATE
NO.		NO.	NO.	NO.	NO.