


KNIGHT ROAD & SPAIN ROAD

FROM AMERICAN HERITAGE TO DRAIN CHANNEL

PAVING

INDEX

Sheet No.	Description
1 of 5	Title
2 of 5	Plan and Profile
3 of 5	Cross Sections
4 of 5	Cross Sections
5 of 5	Cross Sections

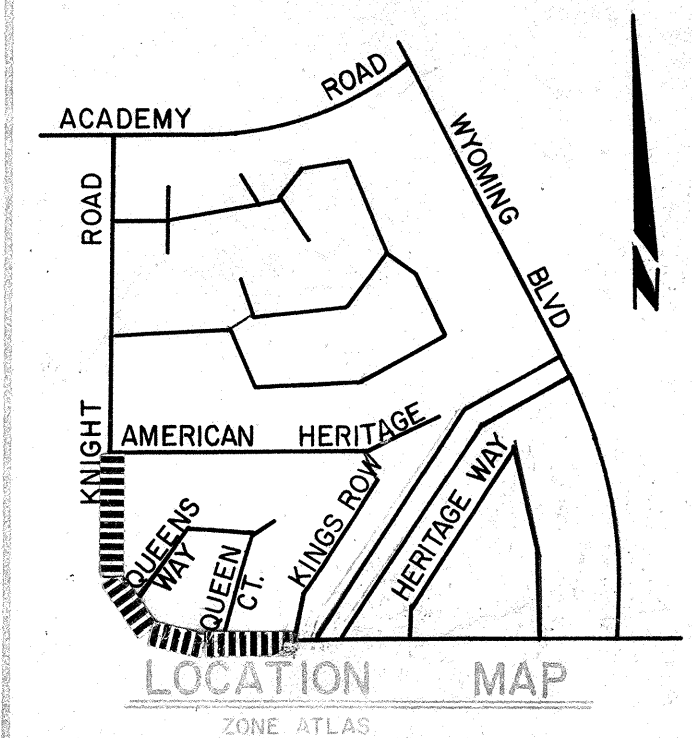

ZONE ATLAS
E-19 & F-19

"NOTICE TO CONTRACTORS"

- 1.) New Mexico Standard Specifications for Public Works Construction - 1979 Edition will be referred to hereon as the "Standard Specification."
- 2.) All work detailed on these plans to be performed under contract shall, except as otherwise stated or provided for hereon, be constructed in accordance with "Contract Documents for City-Wide Utilities and Cash Paving No. _____ and the Standard Specification."
- 3.) Two working days prior to any excavation, contractor must contact Line Locating Service, 765-1234, for location of existing utilities.
- 4.) Prior to construction, the contractor shall excavate and verify the horizontal and vertical locations of all obstructions. Should a conflict exist, the contractor shall notify the engineer or surveyor so that the conflict can be resolved with minimum amount of delay.

THE FOLLOWING NOTES APPLY WHEN CHECKED

- ☒ All utilities and utility service lines shall be located prior to paving.
- ☒ Backfill compaction shall be according to specified street use.
- ☒ Tack coat requirements shall be determined by the City Engineer.
- ☒ Sidewalks and wheelchair ramps within the curb return shall be constructed wherever a new curb return is constructed.
- ☒ If curb is depressed for a driveway, the driveway shall be constructed prior to acceptance of the curb and gutter.
- ☒ All storm drainage facilities shall be completed prior to final acceptance.

1 2 3 4 5 6 7 8 9 10 11 12
26 10890182

APPROVAL OF AS BUILT DRAWINGS
ASSIST. CITY ENGINEER - FIELD
M. Scammon
DATE 12/14/82

APPROVED FOR
CONSTRUCTION
Richard S. Hall 6/2/82

DRAWING
NO. 1089

SHEET 1 OF 5

Δ CURVE DATA
 $R = 349.99'$
 $\Delta = 90^\circ 20' 40''$
 $L = 551.87'$
 $T = 352.10'$

⑥ BUILD 15' WIDE DRIVEPAD AT STA. 15+26.87 PER ALB. STD. P-11-1, TRANSITION GRADING 10' ON EACH SIDE TO MATCH EDGES OF DRIVEPAD.

RD. CATCH BASIN DOUBLE "C"

CATCH BASIN TYPE "A"

24" RCP PLAN

91.00

91.50


24" RCP

91.56


6'


SECTION A-A

CATCH BASIN RETAIL

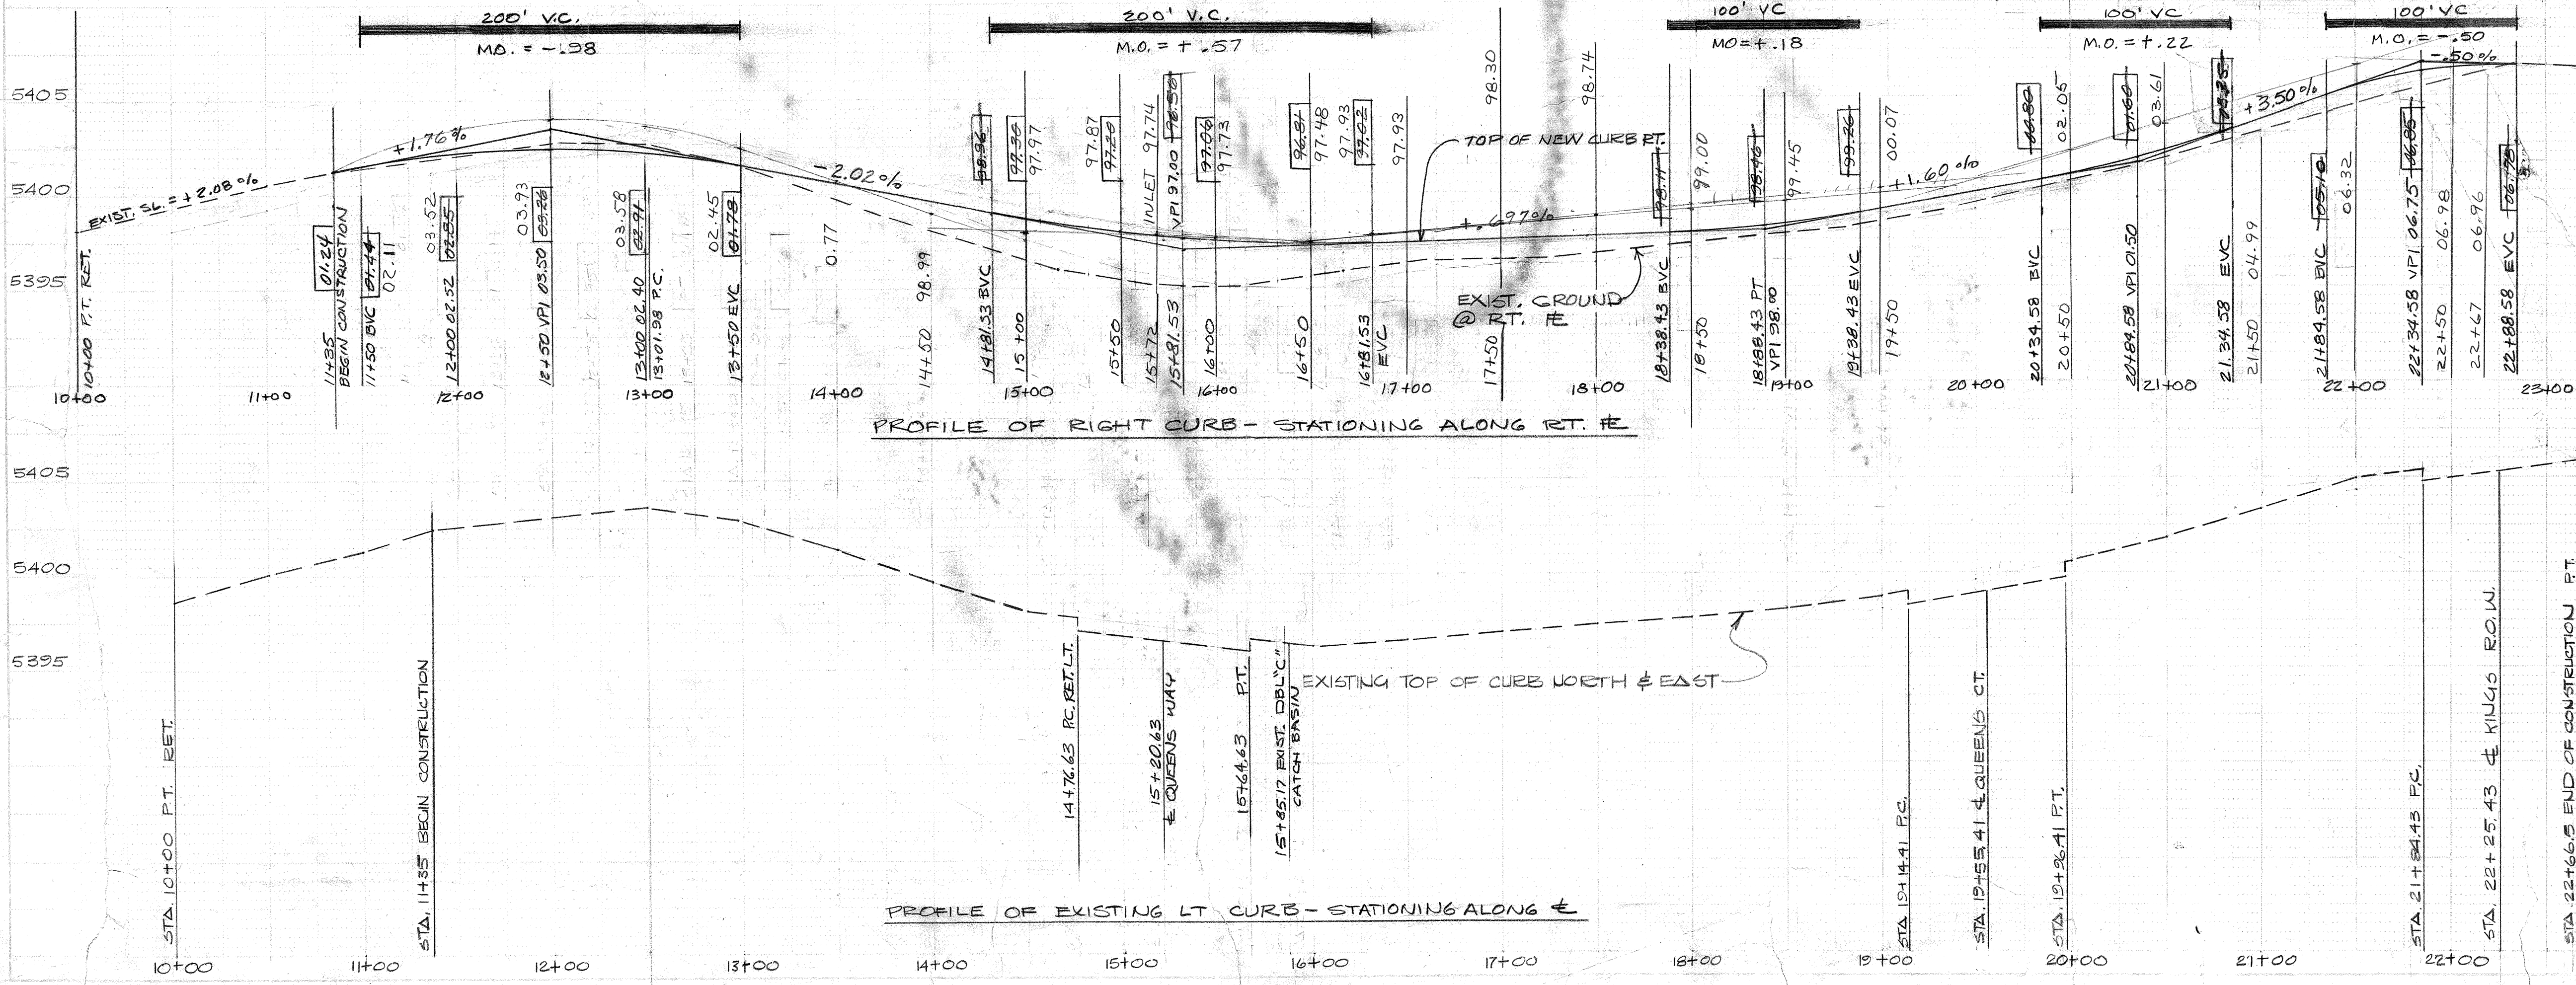

ENGINEER'S SEAL										SURVEY INFORMATION			BENCH MARKS			AS BUILT INFORMATION		
										FIELD NOTES								
										NO.	BY	DATE						
										PS-26	C. ARECHUNDE	4-6-81						
											A. GONZALES							
											M. AREYTA							
											M. GUTIERREZ							
										REMARKS								
										DESIGN								
										DESIGNED BY C. TOMLINSON								
										DATE								
										DRAWN BY								
										DATE								
										CHECKED BY								
										DATE								
PROJECT DEPARTMENT DIVISION AND SPAIN RD. FROM EASEMENT.										DESIGNED BY P.R. Harvey			DATE 6/4/82					
APPROVALS ENGINEER DATE																		
MAINT. SHEET OF										2			5					

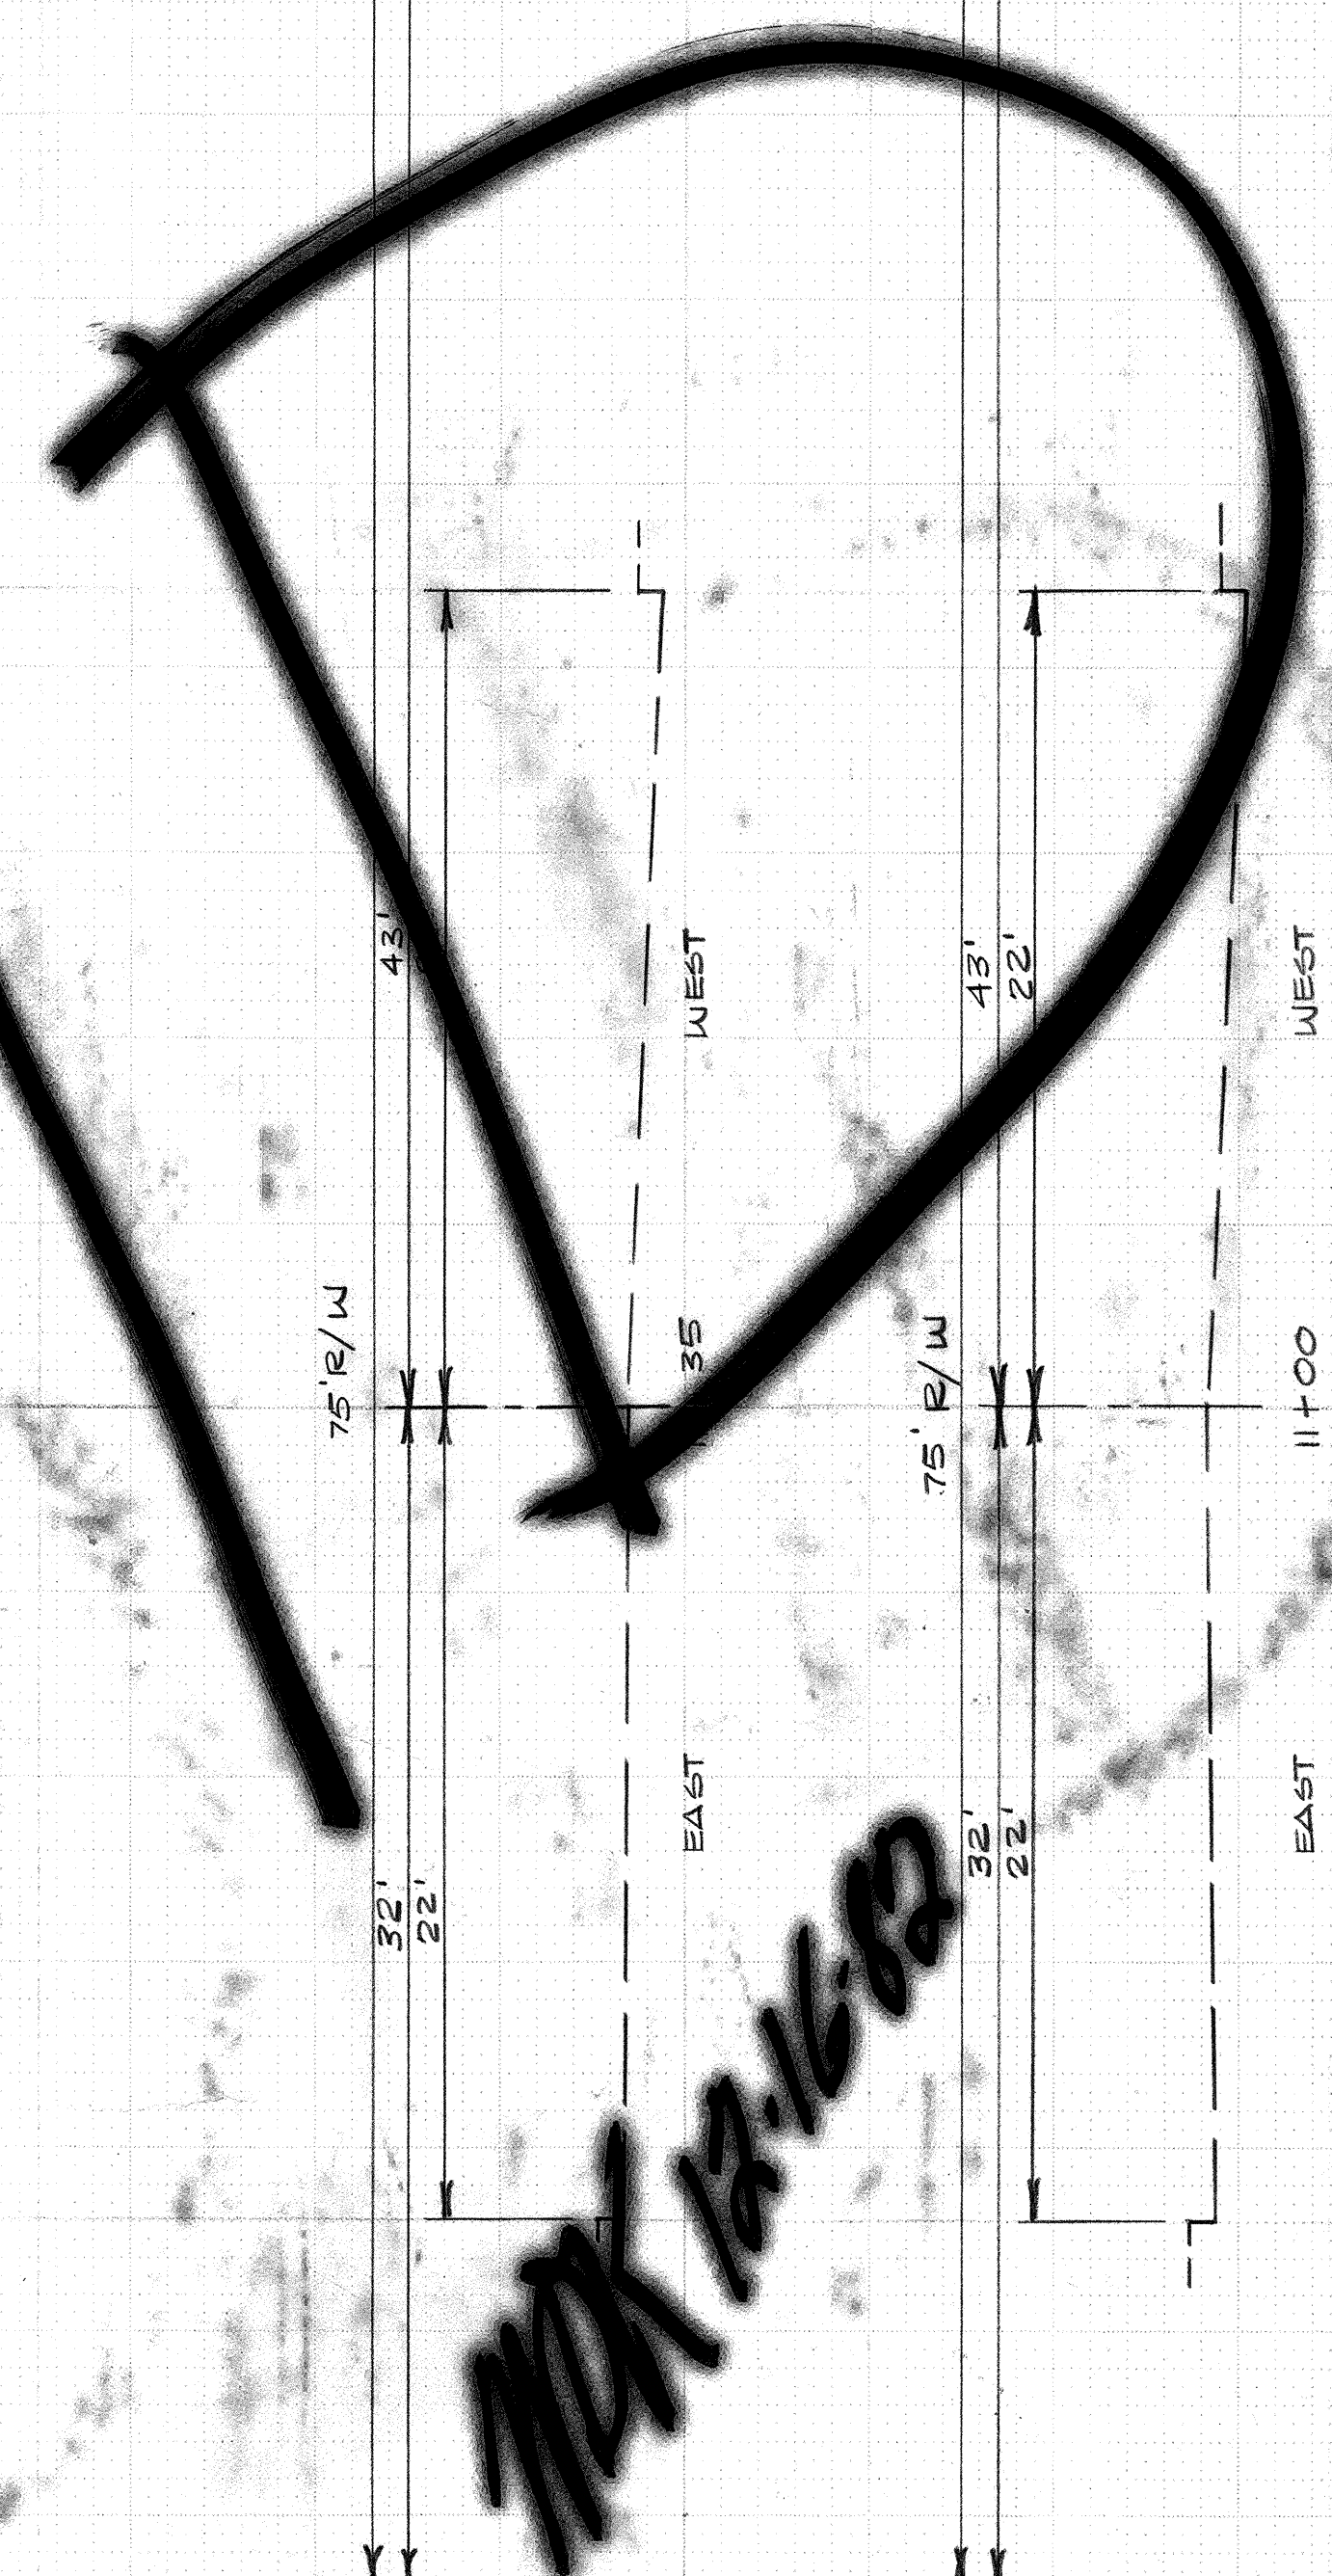[illegible]

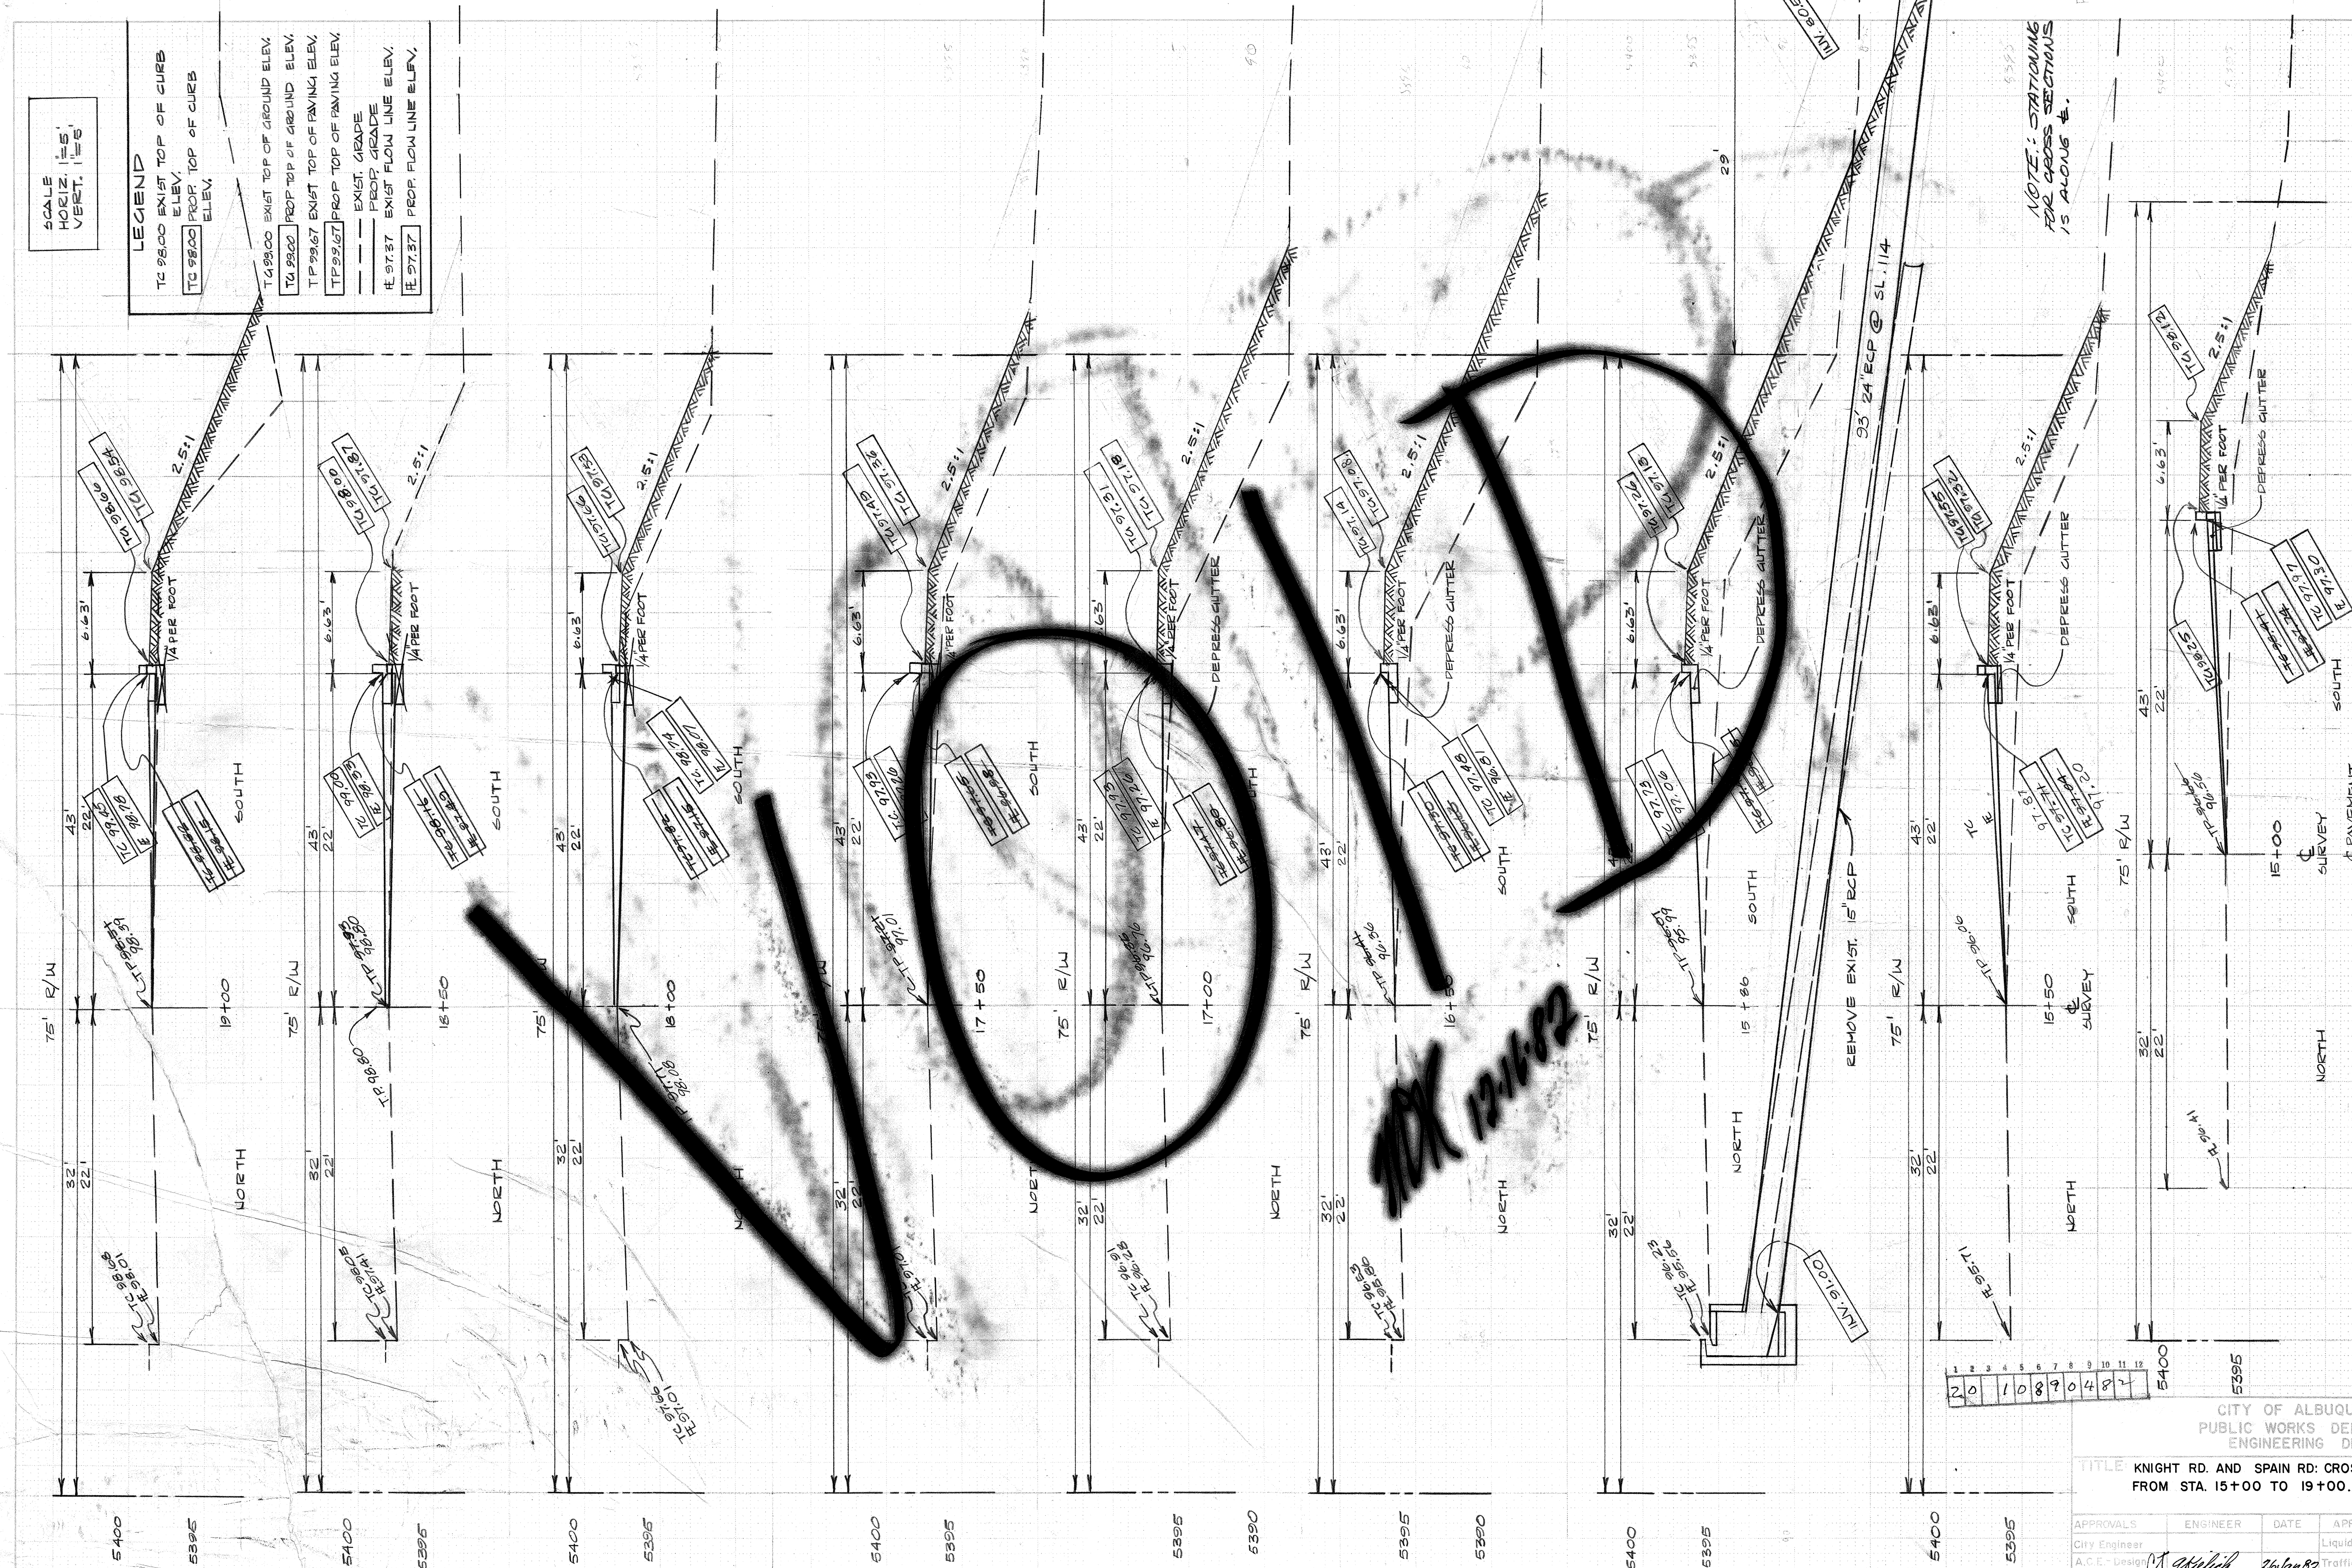

SCALE
HORIZ. 1"=5'
VERT. 1"=5'

LEGEND
TC 98.00 EXIST. TOP OF CURB
ELEV.
TP 98.67 EXIST. TOP OF FAVING ELEV.
PROP. TOP OF CURB
ELEV.
TP 98.67 EXIST. TOP OF FAVING ELEV.
PROP. GRADE
E 97.37 EXIST. FLOW LINE ELEV.
E 97.37 PROP. FLOW LINE ELEV.

NOTE: STATIONING
FOR CROSS SECTIONS
IS ALONG E.

APPROVED FOR
CONSTRUCTION
Richard Stahl 6/2/82
CITY ENGINEER DATE

CITY OF ALBUQUERQUE
PUBLIC WORKS DEPARTMENT
ENGINEERING DIVISION

TITLE KNIGHT RD. AND SPAIN RD: CROSS SECTIONS
FROM STA. 15+00 TO 19+00.


APPROVALS	ENGINEER	DATE	APPROVALS	ENGINEER	DATE
CITY ENGINEER	A.C.E. Design	6-1-82	Liquid Waste	N.A. RAA	
A.C.E. Hydrology	Richard Stahl	6-1-82	Water		
PARKS	Robert Boring	1-22-82	STREET MAINT.		

DRAWING NO. 1089 SHEET 4 OF 5

REFERENCES			SURVEY INFORMATION			BENCH MARKS			AS BUILT INFORMATION		
MAP NO.	EST. NO.	WQ. NO.	NO.	BY	DATE	12-P-19	ELEV.	DATE	CONTRACTOR	NO.	DATE
F-19			P5-36	G. ARCHULDE	4/6/81	12-P-19	5412.82	84			
				A. GONZALES							
				M. ABREYTA							
				M. GUTIERREZ							

DESIGNED BY C. TOMLINSON
DRAWN BY A. SALAS
CHECKED BY

NO. DATE REVISIONS
1 2 3 4 5 6 7 8 9 10 11 12
20 10890482

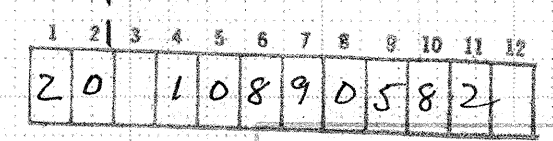

APPROVALS	ENGINEER	DATE	APPROVALS	ENGINEER
City Engineer			Liquid Waste	
A.C.E. - Design	<i>OT Kishel</i>	<i>6-1-82</i>	Traffic	<i>N.A. Burt</i>
A.C.E. - Hydrology	<i>James Burt</i>	<i>6-1-82</i>	Water	
PARKS			STREET MAINT.	
<i>Walt Boley 1-22-82</i>				
DRAWING NO.	1089			SHEET 5

[illegible]