



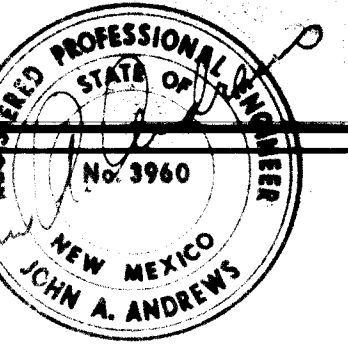

APPROVED FOR CONSTRUCTION
City Engineer _____ Date _____

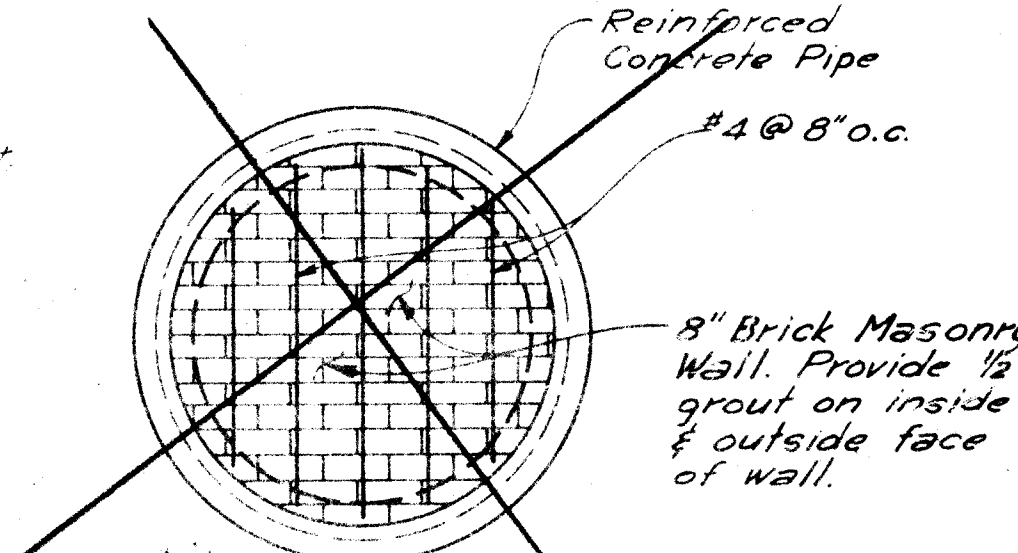

BRICK MASONRY PLUG DETAIL
SCALE: 1/2"=1'-0"


APPROVALS
RSA 11/1/79
City Engineer _____ Date _____

BENCH MARK
A.C.S. T.M. 23
Elev. 5850.93
See Sheet 2

RELAY OF STORM
SEWER LINE.. 1/31/80 CT

PLAN
DATE
BY
REVISIONS
NO. 1
NO. 2
NO. 3
NO. 100

PROFILE
DATE
BY
REVISIONS
NO. 1
NO. 2
NO. 3
NO. 100

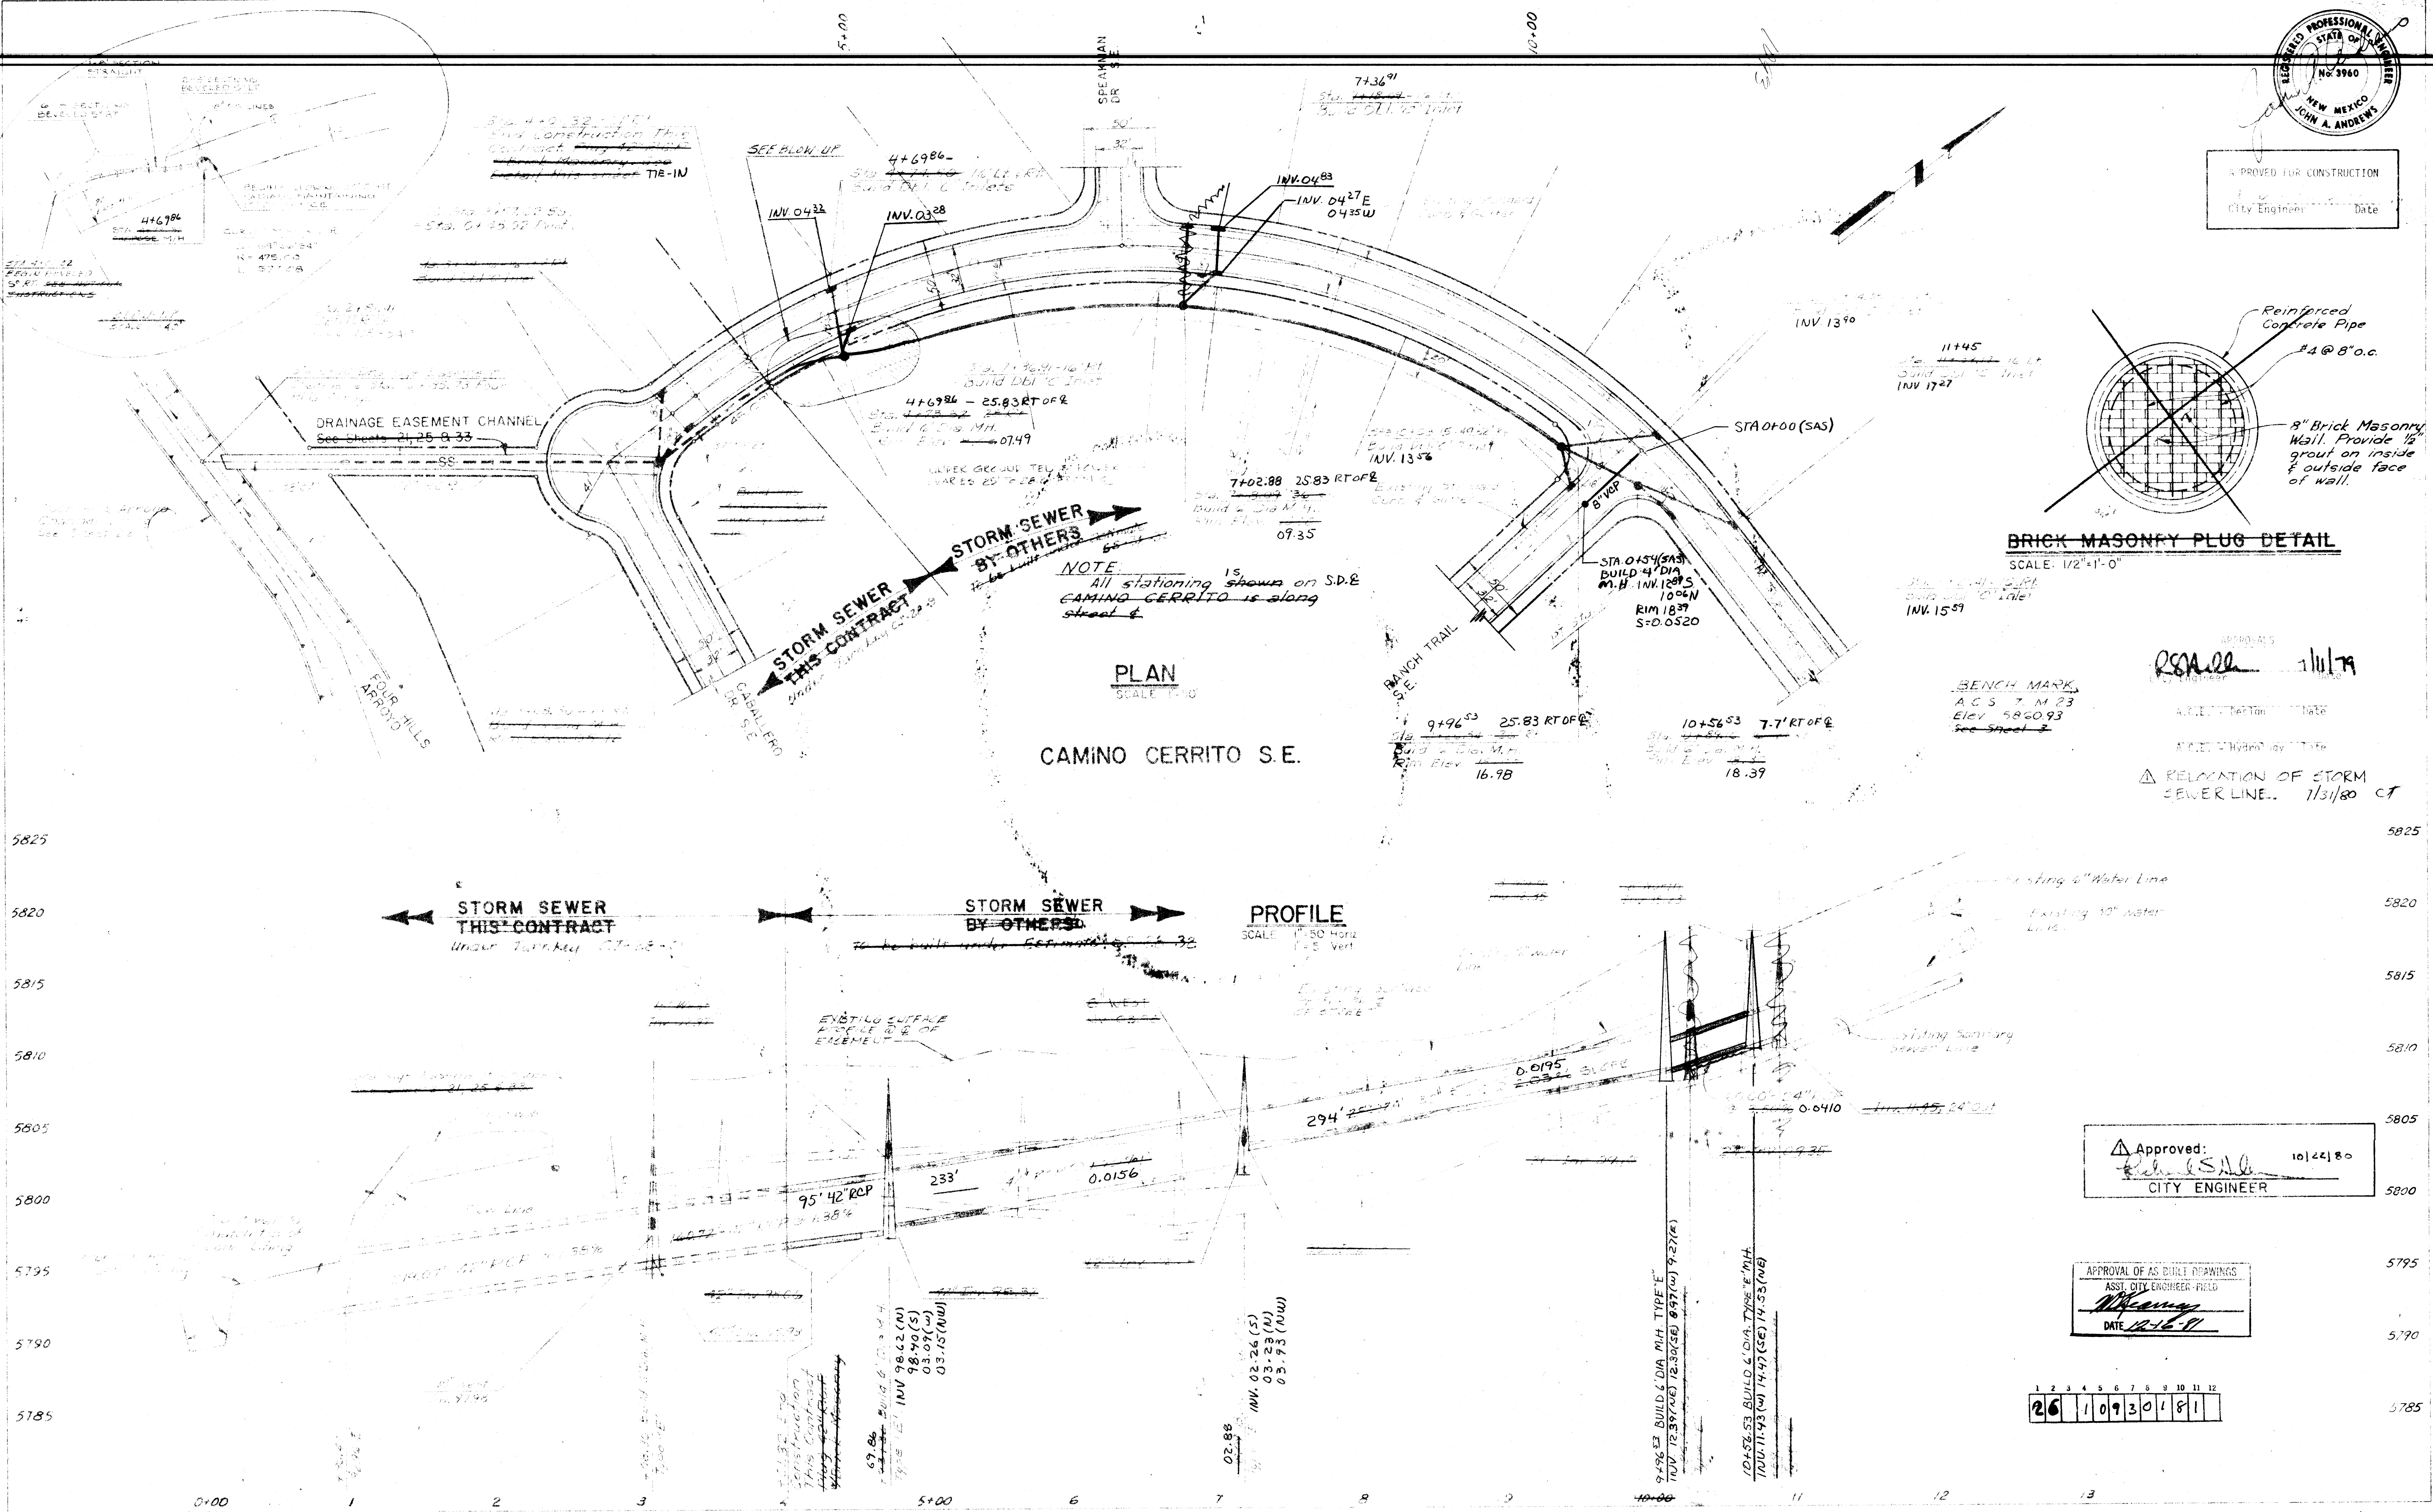

ANDREWS, ASBURY & ROBERT, INC.
CONSULTING ENGINEERS
ALBUQUERQUE NEW MEXICO

FOUR HILLS VILLAGE, NINETEENTH INSTALLMENT

CAMINO CERRITO S.E.,

STORM SEWER

1093

SHEET 1 OF 1

LASON 1-505-344-9404
BEST COPY AVAILABLE