

[illegible]

NOTICE TO CONTRACTORS

1. New York State Standard Specification for Public Works Construction - 1974 edition will be referred to hereinafter as the "Standard Specification"

2. If it was deemed on these plans to be performed under contract, stated or otherwise stated or provided for herein, be constructed in accordance with Contract Documents for City Wide Utilities and Other Paving Job 3.1, and the Standard Specification


3. If it was deemed to be a reconstruction, contractor must conform with existing Section 170.134 for condition of existing curbs

4. If it was deemed to be a contract, the contractor shall excavate and backfill and compact to the vertical limits of all adjacent areas. If such a contract exists, the contractor shall notify the engineer in advance so that the contractor can be advised with minimum amount of delay.

1	2	3	4	5	6	7	8	9	10	11
26			10	9	8			01	84	

APPROVED FOR CONSTRUCTION <i>R. W. Shupard 10/10/63</i>	DRAWING NO. 1098	SHEET OF 1 2
---	---------------------	-----------------


SCALE: 1"=20'

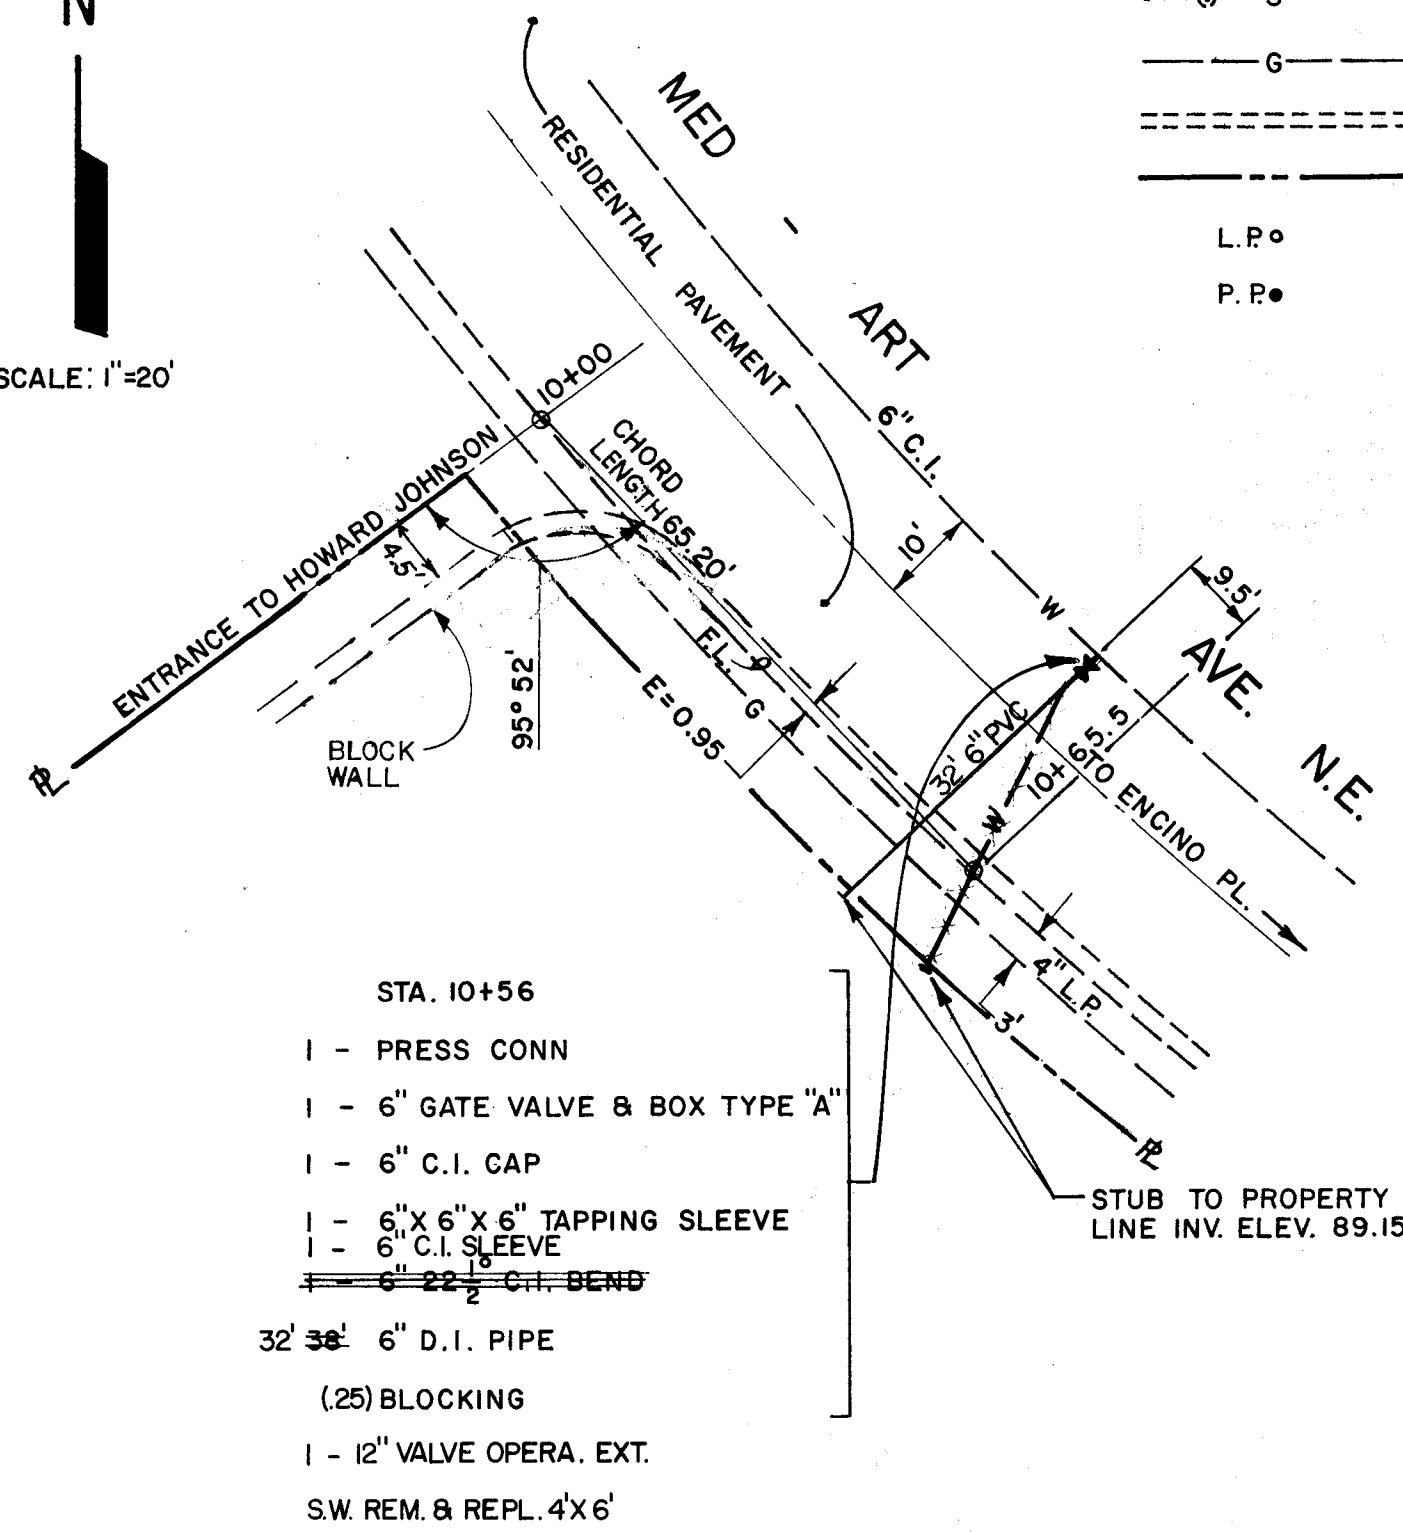

LEGEND

- W — EXIST. WATER LINE & GATE VALVE
- W — NEW WATER LINE & GATE VALVE
- W — NEW UNMETERED FIRE LINE
- W — EXIST. FIRE HYDRANT
- S — EXIST. SANITARY SEWER LINE & MANHOLE
- G — EXIST. L.P. GAS LINE
- EXIST. CURB & GUTTER
- RIGHT-OF-WAY LINE
- L.P. — STREET LIGHT POLE
- P.P. — POWER POLE

SCALE: 1"= 40'

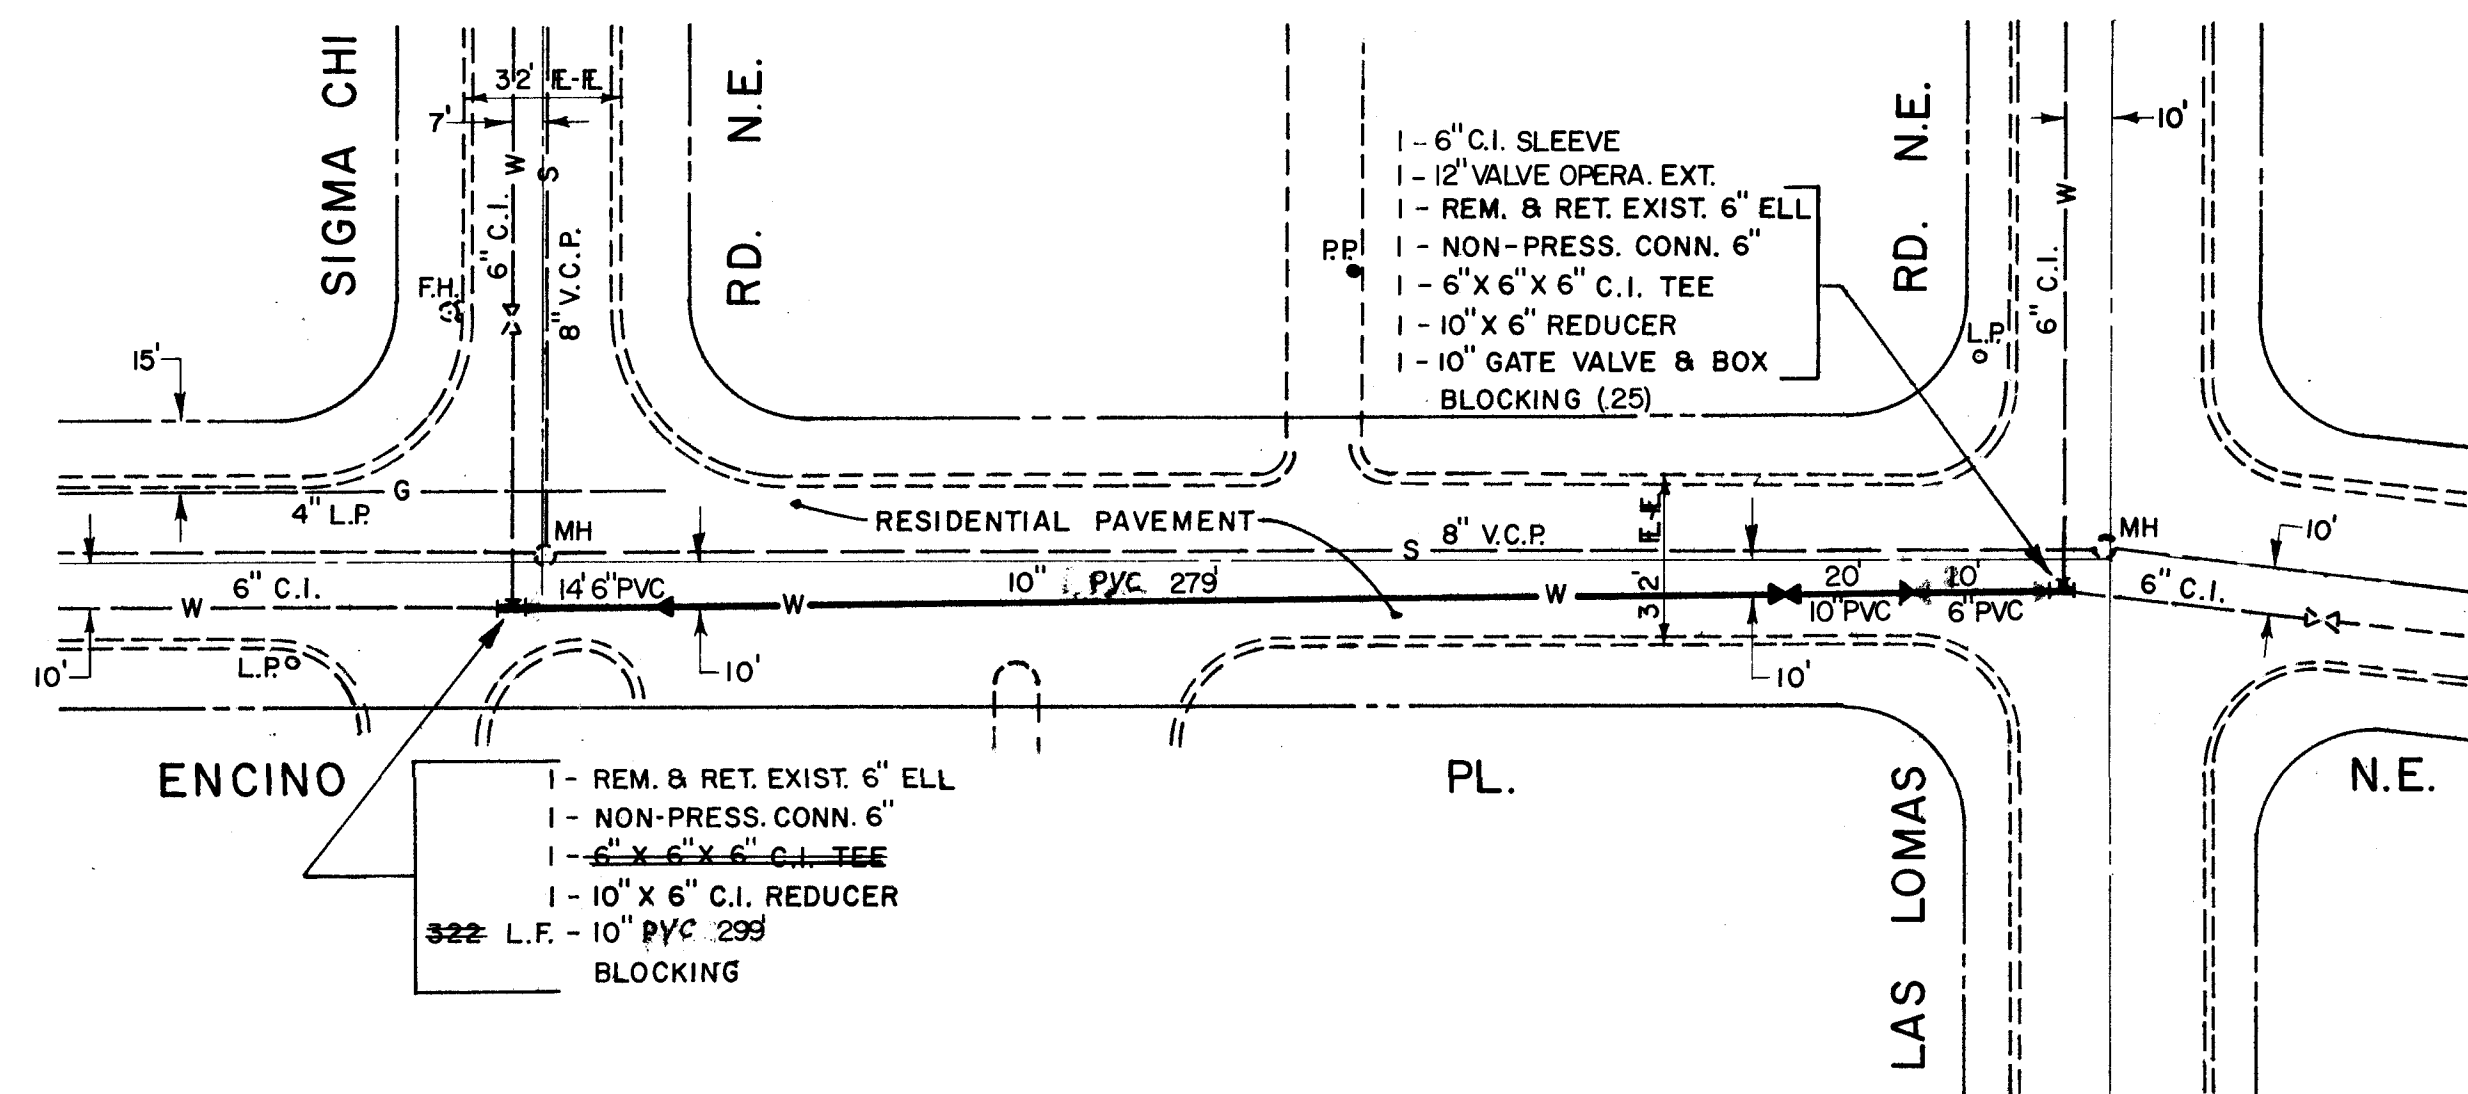


TWO WORKING DAYS PRIOR TO ANY EXCAVATION CONTRACTOR MUST CONTACT LINE LOCATING SERVICE, 765-1234, FOR LOCATION OF EXISTING UTILITIES.

NOTICE TO CONTRACTOR
PRIOR TO EXCAVATION, THE CONTRACTOR SHALL EXCAVATE AND VERIFY THE HORIZONTAL AND VERTICAL LOCATIONS OF ALL DESTROYED UTILITIES. SHOULD A CONFLICT EXIST, THE CONTRACTOR SHALL NOTIFY THE ENGINEER OR SURVEYOR SO THAT THE CONFLICT CAN BE RESOLVED WITH A MINIMUM AMOUNT OF DELAY.

VALMONTE

ADDITION

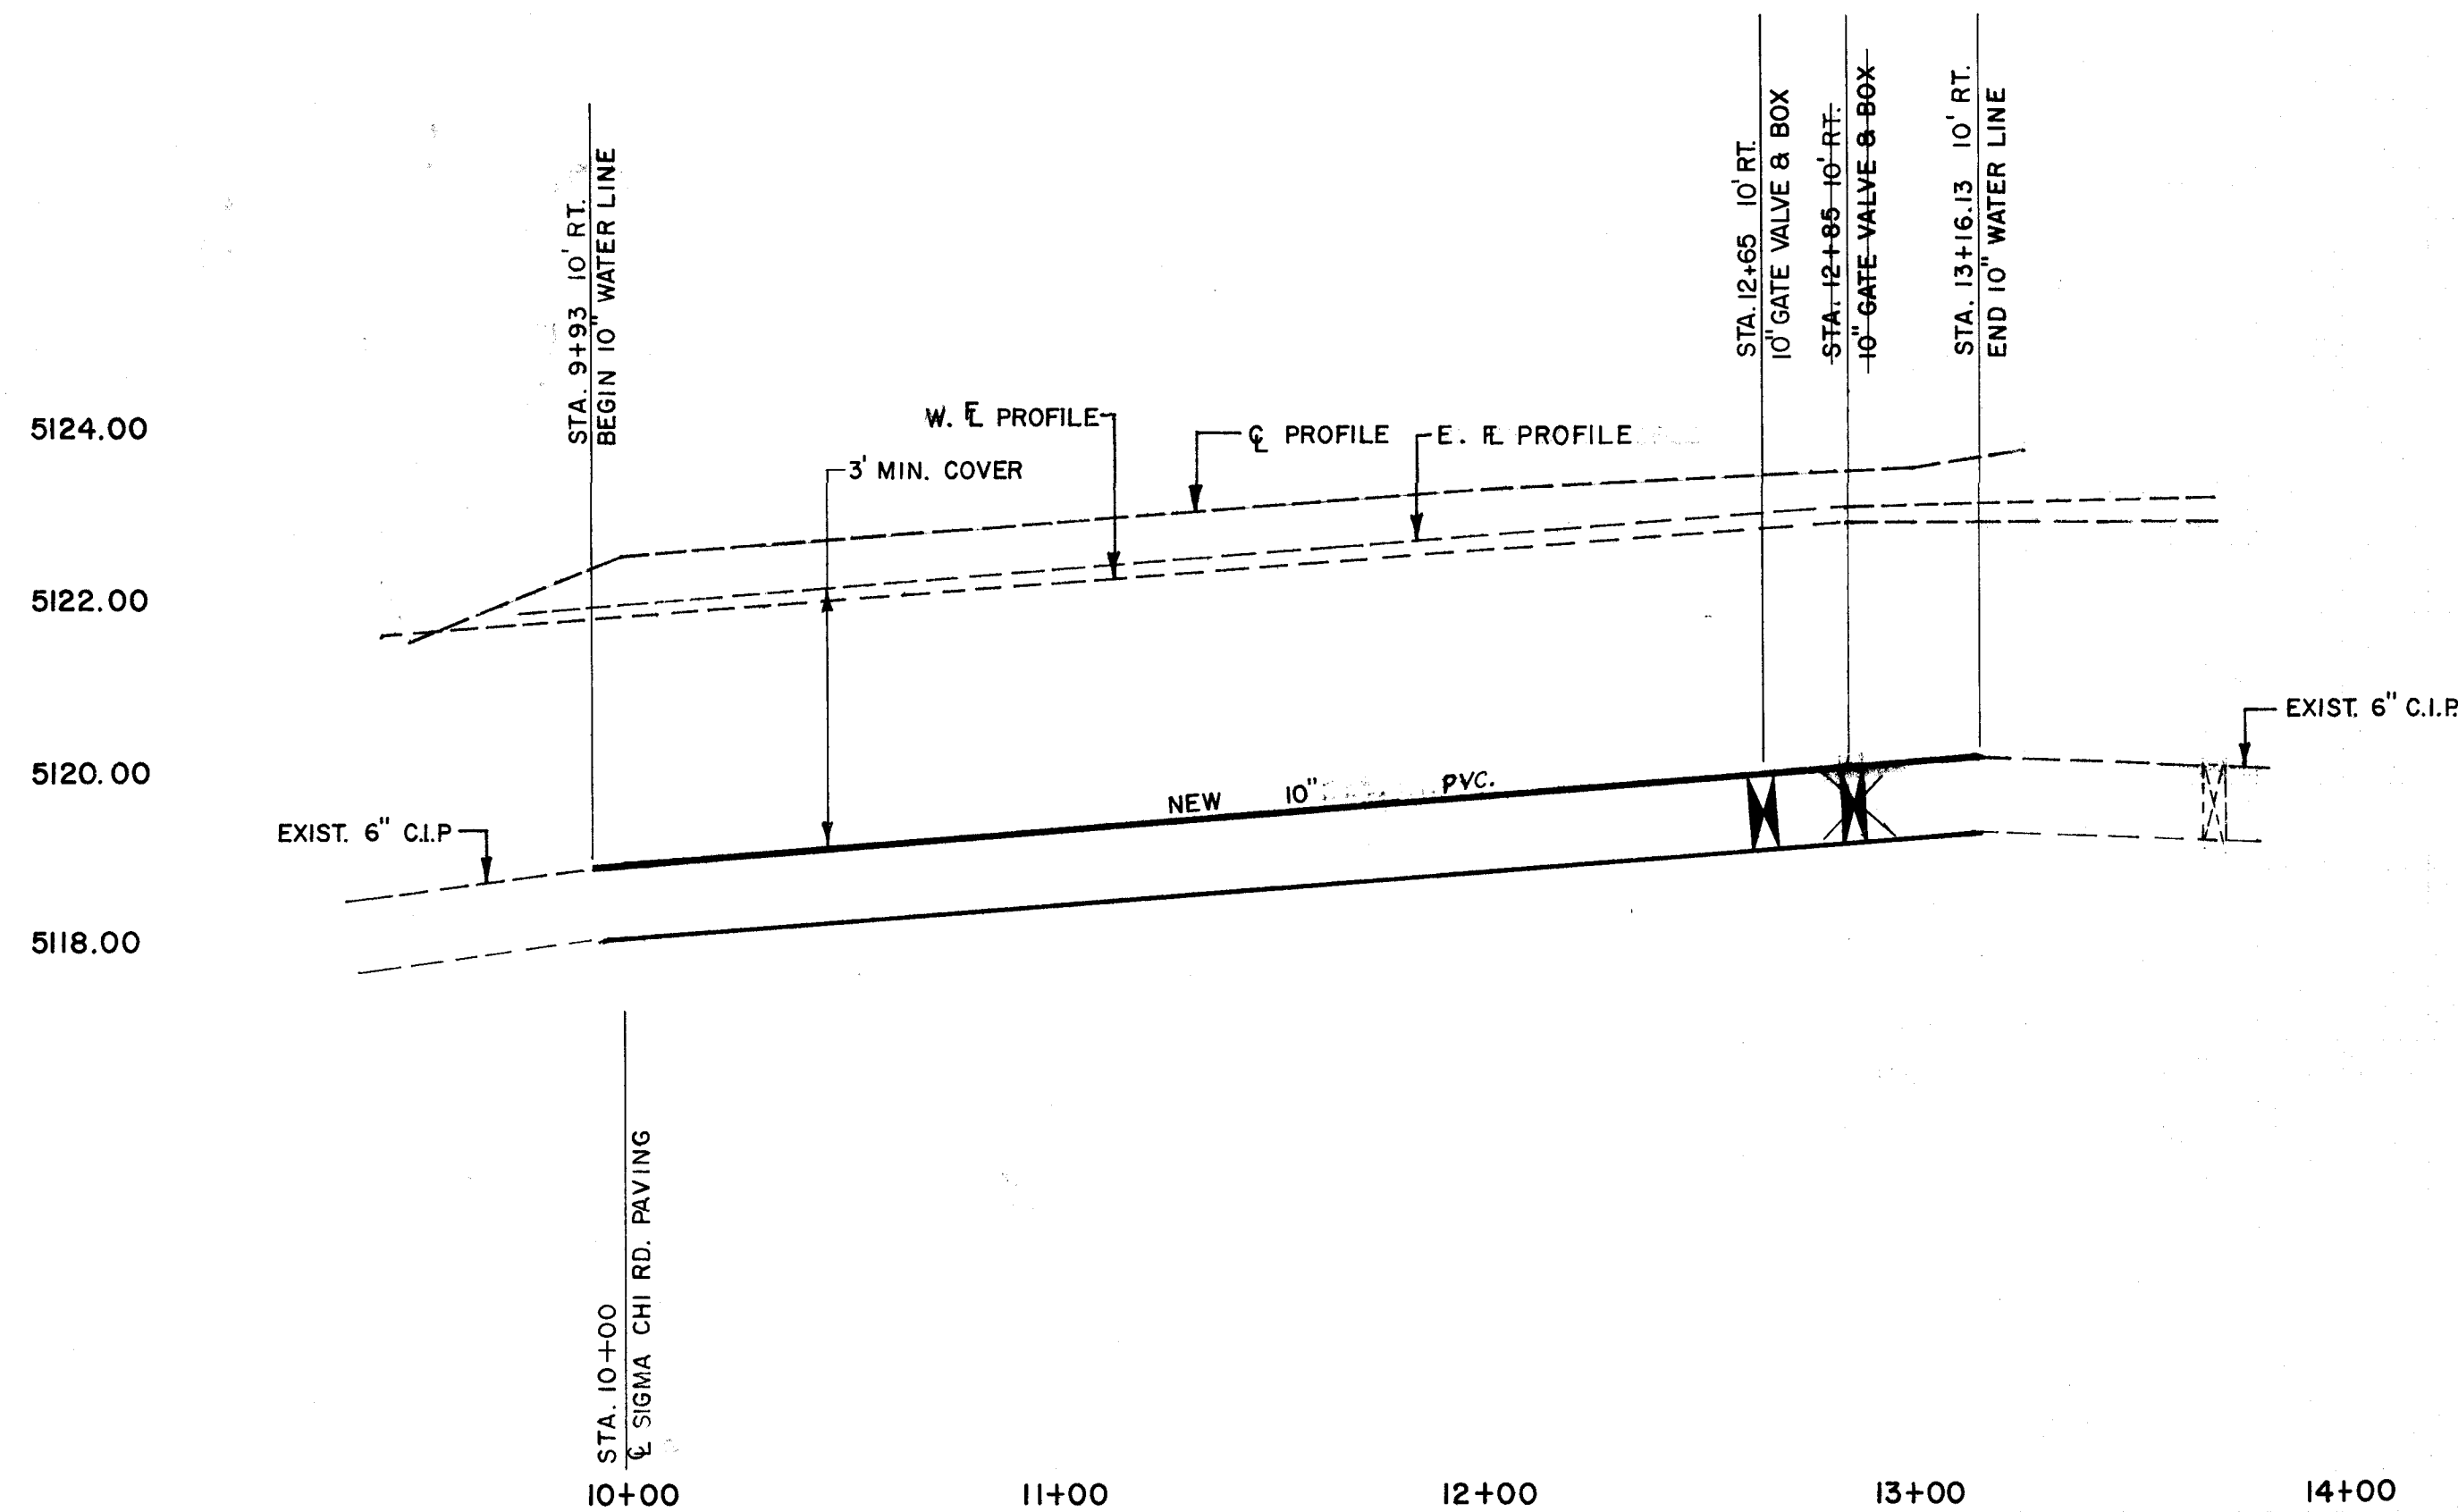

LASON 1-505-344-9404
BEST COPY AVAILABLE

APPROVED FOR
CONSTRUCTION
DATE 7/1/83
CITY ENGINEER

ENCINO PL. WATER LINE EXTENSION
FROM SIGMA CHI RD. TO LAS LOMAS RD.

DATE 7/1/83
DATE 7/1/83
DATE 7/1/83

1098

NEW CONCEPTS
M. QUINEZ 3-84
R. DURAN 4-84

C.B.M. ELEV. 5123.36 "B" CHISELED ON TOP OF CURB,
SSE RETURN INTERSECTION OF ENCINO PL. NE &
SIGMA CHI RD. N.E.
C.B.M. ELEV. 5085.94 "C" CHISELED ON TOP OF CURB
WSW RETURN ENTRANCE TO HOWARD JOHNSON'S
OFF MEDICAL ARTS

5-13-81

MERCER, H

PS 19

4-20-81
5-28-81
7-20-83

PHIL FISCHER
ISAAC E. LARGE
BEN EMMETT