


JUNCTION STRUCTURE DIMENSION CHART							
STREET NAME & STATION	③	④	⑤	⑥	⑦	⑧	⑨
Nugget St.	18"	24"	45°	.0425	.0779	1.00	7.00
Molly Brown St.	18"	24"	45°	.1764	.1950	1.00	7.00

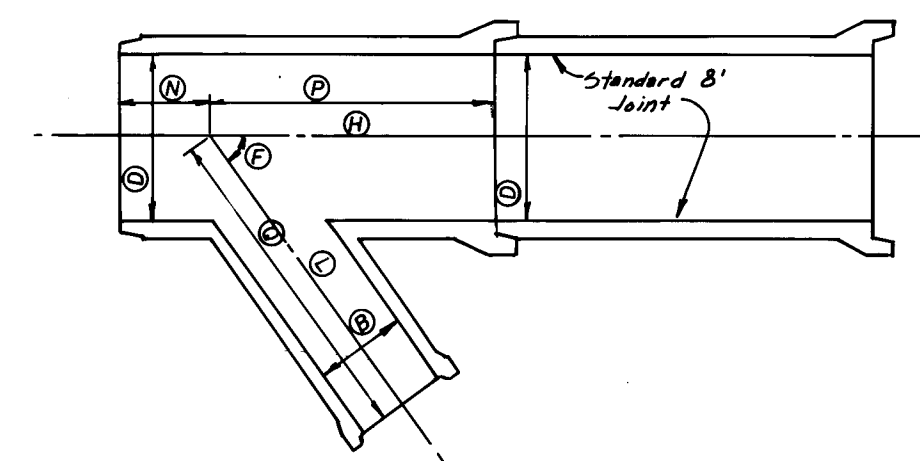

STORM SEWER JUNCTION STRUCTURE DETAIL
NOT TO SCALE

LEGEND

- Sanitary Sewer Flow Direction
- Concrete Encasement
- Clay Plug
- Sanitary Sewer Service
- Existing Manhole
- Manhole (Proposed Sanitary Sewer)
- Manhole (Proposed Storm Sewer)
- Transverse Drop Inlet

CONSTRUCTION OF LOWELL STREET AND SAN VICTORIO EAST OF STA. 13+69.62 NOT INCLUDED IN THIS CONTRACT, FOR INFORMATION ONLY.

Notes:

- Water and sewer lines shall be installed per supplemental General Conditions Section 18.1 Policy on the proximity of Water and Sewer lines, New Mexico Standard Specifications for Public Works Construction, 1979 Edition.
- The Connection between different types of sewer main pipe at locations other than manholes will be made with a Con-Tex Rubber Sleeve fitting or approved equal.
- Sewer services other than those indicated, shall not tie-in to sewer main at manholes.
- Sewer mains designated on the plan set to be laid on a horizontal curve shall be exempted from the lamping requirement stated in section 592.061 of the New Mexico Standard Specifications for Public Works Construction, 1979 Edition.
- Streets shall be graded to finish grade $\pm 1.0'$ prior to installation of sanitary sewer system.
- Electronic marker discs have been installed at all service tees and at all plugged ends as specified in section 131 of the supplemental Technical Specifications to the City of Albuquerque Contract and Documents for City-Wide Utilities and Cash Paving No. 31.
- See La Vista Grande Subdivision Plans (City No. C-29-33) for design of sewer and water on Spain Rd.
- Concrete Encasement shall be used on Sanitary Sewerlines where Waterlines Cross And are Within 3' Vertically of Sewerlines.

26.1.10.2.0884

**THIS PLAN SET IS FOR
PHASE II CONSTRUCTION ONLY**

PREPARED UNDER THE DIRECTION OF		CITY OF ALBUQUERQUE MUNICIPAL DEVELOPMENT DEPARTMENT ENGINEERING DIVISION	
TITLE: PROSPECTOR'S RIDGE PROPOSED SANITARY & STORM SEWER DESIGN			
APPROVALS	ENGINEER	DATE	APPROVALS
City Engineer	<i>[Signature]</i>	7-14-81	Liquid Waste
A.C.E.-Design	<i>[Signature]</i>	7-14-81	Traffic
A.C.E.-Hydrology	<i>[Signature]</i>	7-14-81	Water
APPROVED FOR CONSTRUCTION		DESIGNED BY RCB	
<i>[Signature]</i>		DATE 1-81	
CITY ENGINEER		DRAWN BY PHF/JLM	
		DATE 1-81	
		CHECKED BY RCB	
		DATE 1-81	

Job No. 01340
SCALE:
1" = 100'

TIE INTO EXISTING MANHOLE

TIE INTO EXISTING MANHOLE. SEE CITY PLANS C-29-33, SHEET 8 OF 35

AS-BUILT INFORMATION			
CONTRACTOR	BOHANNAN - HUSTON	BRASS CAP LOCATED	AT THE NORTH, NORTHWEST PROPERTY
WORK STARTED BY	DATE	RETURN OF THE INTERSECTION OF	SPAIN ROAD AND LOWELL STREET.
ACCEPTANCE BY	DATE	THE BRASS CAP IS STAMPED AS	FOLLOWS: RET. TRT 4A, 1980
RECORDED BY	DATE	ELEVATION = 5867.69'	

SURVEY INFORMATION			
MAP NO.	E-22	EST. NO.	W.D. NO.
NO.	BY	NO.	BY
NO.	DATE	NO.	DATE