


GRETТА ST. N.E.
FROM DOMINGO NORTH TO I-40
WATER, SEWER, ~~PAVING~~

LASON 1-505-344-9404
BEST COPY AVAILABLE

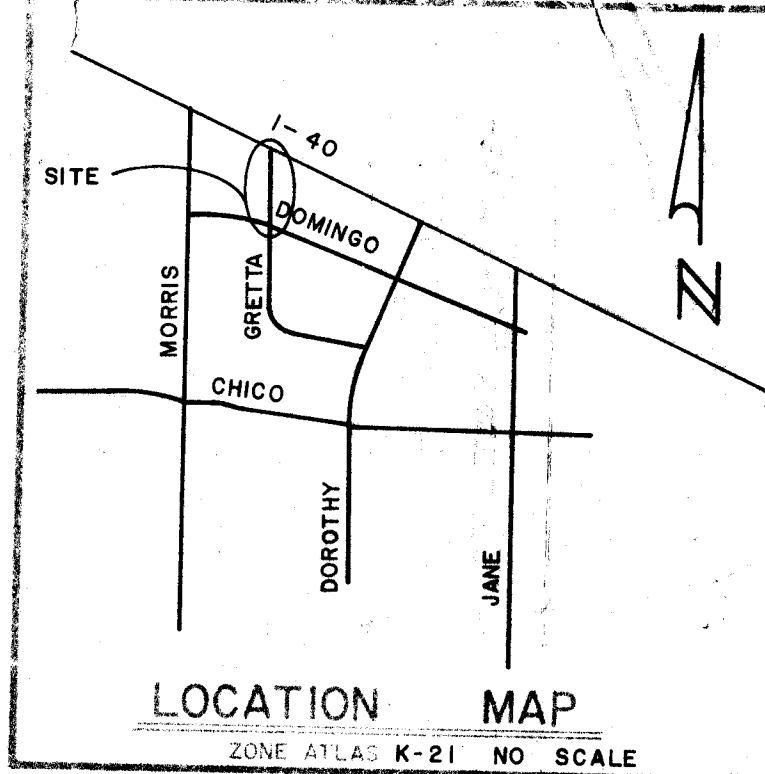

"NOTICE TO CONTRACTORS

1. Non-Metric Standard Specifications for Public Works
to Standard 1973 Edition will be referred to hereon
as the Standard Specification.

and that were excluded on those dates to be performed under contract shall, except as otherwise stated or provided, thereon, be controlled in accordance with the provisions of the City - Will County and Cash Payment No. 30 and the Standard

7. Two working days prior to any excavation, contractor must contact the Erosion Service, 765-1234, for location of existing utilities.

As prior to construction, the contractor shall excavate and mark the horizontal and vertical locations of all obstructions. Should a conflict exist, the contractor shall notify the engineer or surveyor so that the conflict can be resolved with minimum amount of delay.

THE FOLLOWING NOTES APPLY WHEN CHECKS

INDEX	
SHEET	TITLE
1	TITLE SHEET
2	P&P WATER & SEWER
3	P&P PAVING

- ✓ Asphalt and driveway surface loads shall be installed prior to paving.
- ✓ Excavation operation shall be according to specified street cut.
- ✓ Final cost estimates shall be determined by the City Engineer.
- ✓ Driveway and sidewalk curbs within the curb radius shall be constructed wherever a new curb radius is constructed.
- ✓ If it is discovered for a driveway, the driveway shall be constructed prior to acceptance of the curb and gutter.
- ✓ All storm and sewer utilities shall be completed prior

APPROVAL OF AS BUILT DRAWINGS
ASST. CITY ENGINEER - FIELD
[Signature]
DATE 3-1-83

Reference Drawing No. 137
For Paving

1	2	3	4	5	6	7	8	9	10	11
2	6		1	1	1	1	0	1	8	2

APPROVED FOR
CONSTRUCTION
Richard Sheller

DRAWING
NO.

019044


SHEET	OF
1	

SCALE
HORIZ 1"=20'
VERT 1"=5'


SANITARY SEWER SERVICE CONNECTION						
LOT	29	30	31	32A	33	34
STA.	10186	11111	11738	11761	11866	12111
INVELEV.	83.53	83.85	84.17	84.49	84.80	85.16

SEE PROFILE

RHODES SANDIA VISTA

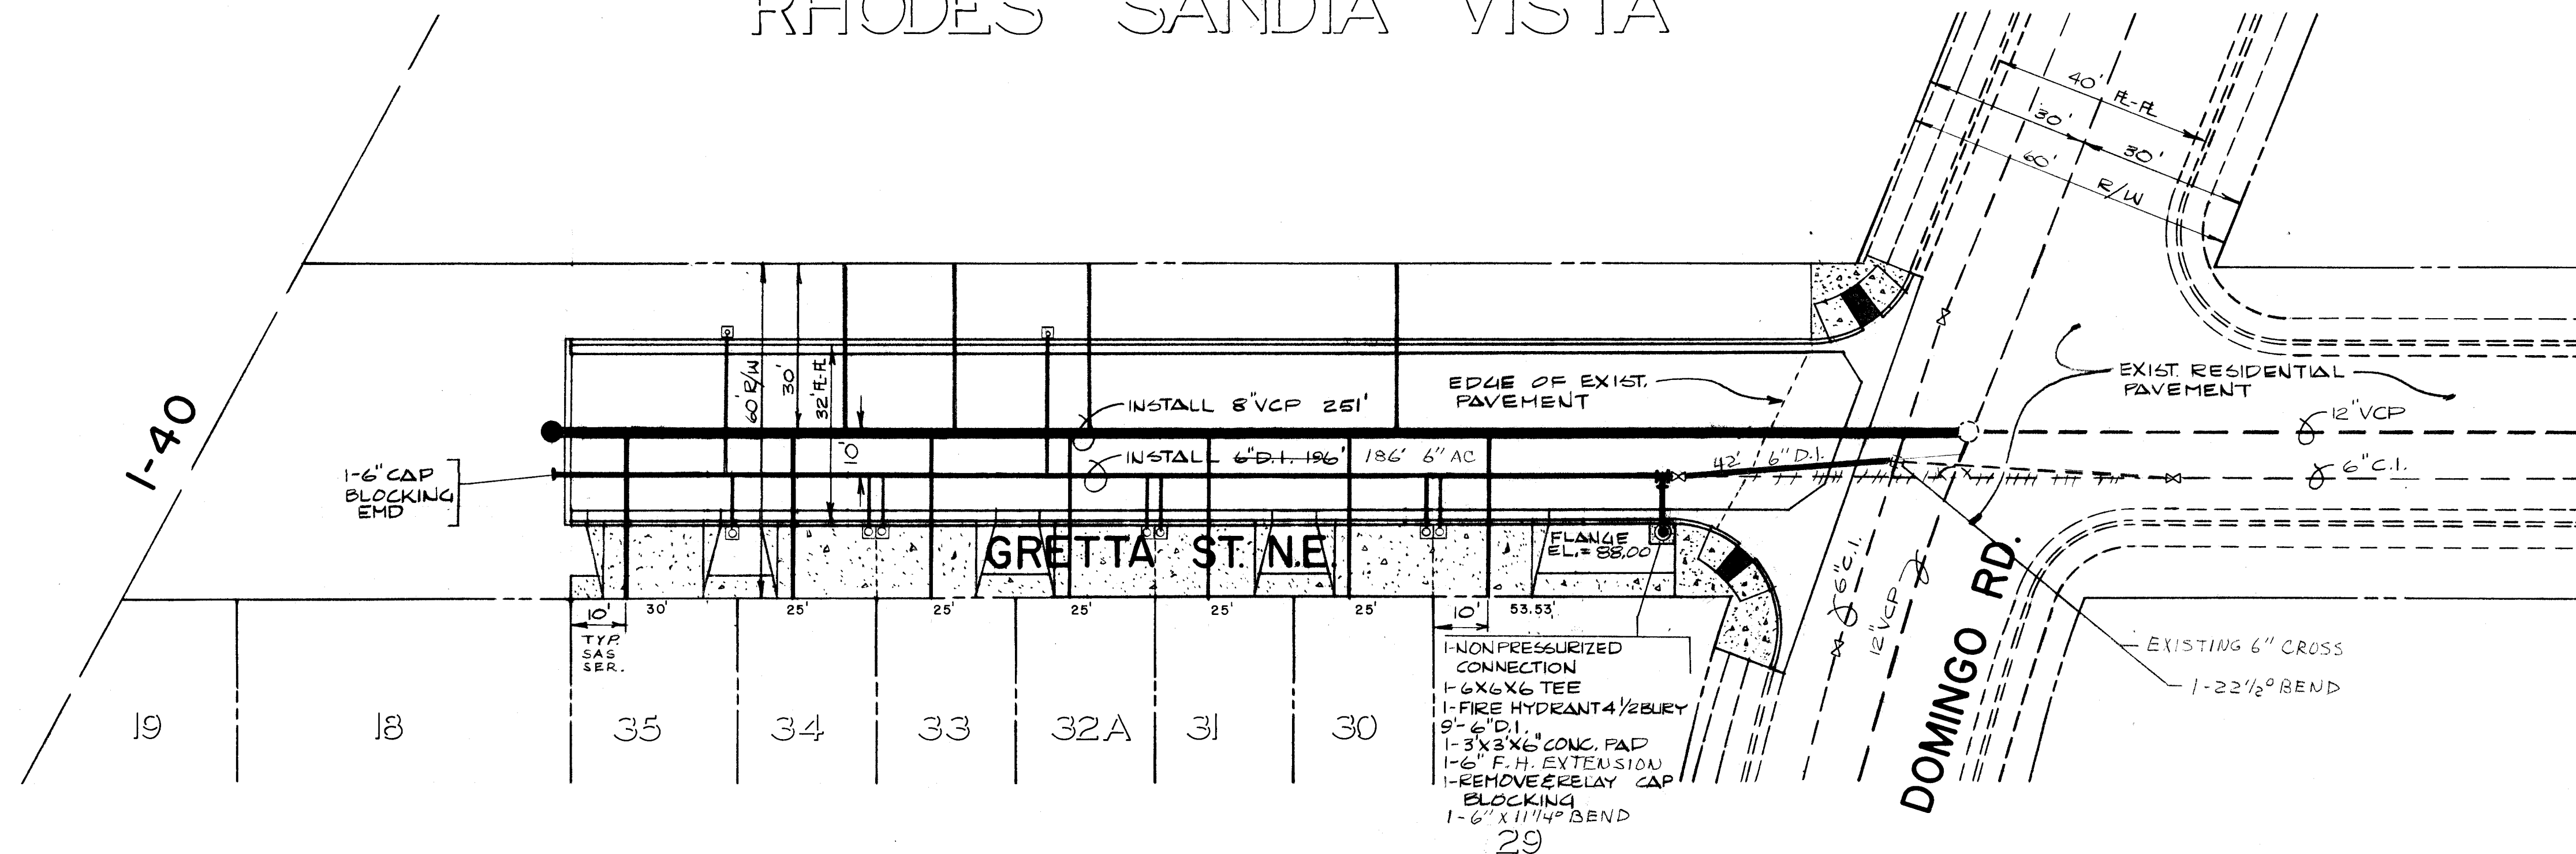

LASON 1-505-344-9404
BEST COPY AVAILABLE

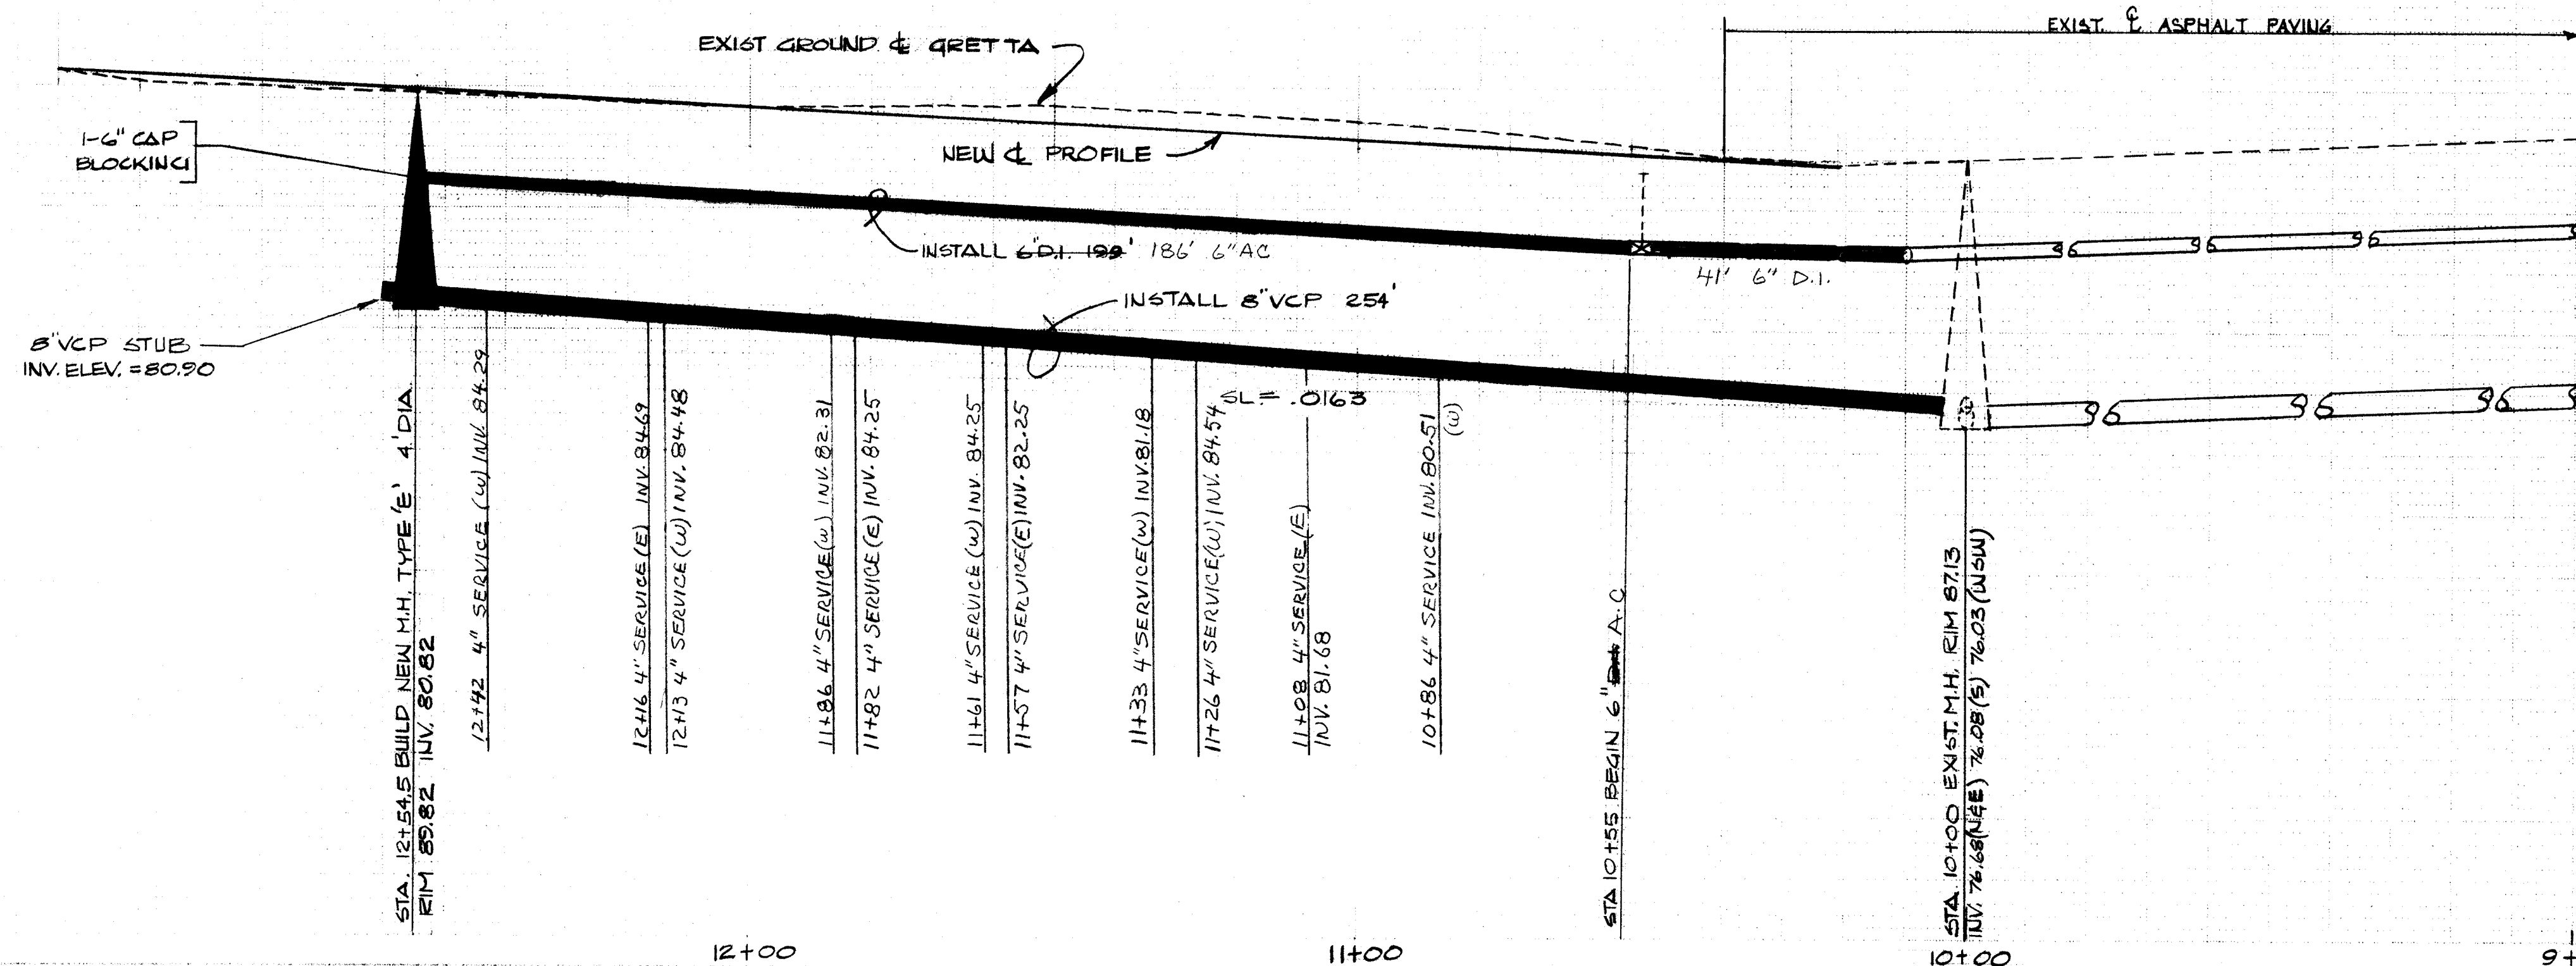

- LEGEND:
- NEW MANHOLE & 8" VCP
 - EXIST MANHOLE
 - NEW 6" D.I. PIPE
 - EXIST CURB & GUTTER
 - NEW CURB & GUTTER
 - EXPANSION JOINT MATERIAL
 - NEW WATER SERVICES
 - COUPLE & SINGLE
 - FIRE HYDRANT

5495
5490
5485
5480
5475

NOTES:
1. LOT 29 AS PER REPEAT OF 3/11/80 RECORDING NO. A7-239 FORMERLY LOT 15.
2. CONSTRUCT WATER SERVICES AS PER CITY STD. DWG W-10 WITH CONC. PAD.

1 2 3 100

CITY OF ALBUQUERQUE
MUNICIPAL ENGINEERING DEPARTMENT
ENGINEERING DIVISION
TITLE WATER & SEWER ON GRETTA ST. NORTH OF DOMINGUE.

DESIGNED BY: [Signature] DATE: 9/12/81
CHECKED BY: [Signature] DATE: 9/12/81
DRAWN BY: [Signature] DATE: 9/12/81
DATE: 9/12/81
SHEET: 2 OF 3

RHODES SANDIA VISTA

NOT
PART
OF

THIS
CONTRACT

	FL	TC
1	87.20	87.87
2	87.16	87.83
3	87.12	87.79

	EC	TC
1	86.61	87.28
2	86.37	87.04
3	86.12	86.79

REMOVE EXIST SIDEWALK
REPLACE WITH WHEELCHAIR
RAMPS AND SIDEWALK.

EXIST 4
SIDEWALK

DOMINGO RD.

CURVE DATA FOR RETURNS

NE RETURN
 $\Delta = 68^{\circ} 10' 00''$
 $R = 20'$
 $T = 13.53'$
 $L = 23.79'$

NW RETURNS
 $\Delta = 105^{\circ} 00' 00''$
 $R = 20'$
 $T = 26.06'$
 $L = 36.65'$

LEGEND :

	EXISTING CURB & GUTTER
	NEW CURB & GUTTER
	NEW SIDEWALK & WHEEL- CHAIR RAMPS.
	NEW VALLEY GUTTER
	NEW FLOWLINE ELEVATION
	NEW TOP ASPHALT ELEVATION
	EXPANSION JOINT MATERIAL
	NEW WATER SERVICES
	DOUBLE & SINGLE
	FIRE HYDRANT

NOTE :
LOT 29 AS PER REPLAT OF
3/11/80 RECORDING NO. A7-239
FORMERLY LOT 15.

1	2	3	4	5	6	7	8	9	10	11	12
2	6		1	1	1	1	0	3	8	2	

CITY OF ALBUQUERQUE
MUNICIPAL DEVELOPMENT DEPARTMENT
ENGINEERING DIVISION

1745
GRETTA ST. N.E. NORTH OF DOMINGO
PAVING.

ENGINEER DATE
 P. J. [Signature] 9/22/81
 20 May 81
 6/23/81
 [Signature] 6/23/81
 [Signature] 6/23/81

DRAWING NO. **III-45**
 MAP NO. **K-21**
 SHEET **3** OF **3**

LASON 1-505-344-9404
BEST COPY AVAILABLE