

STREET RECONSTRUCTION

Sht. I COVER SHEET

Sht. 2 PLAN

APPROVAL OF AS BUILT DRAWINGS
ASST. CITY ENGINEER - FIELD
[Signature]
DATE 10-20-88


1	2	3	4	5	6	7	8	9	10	11
2	6		1	1	1	6	0	1	8	2

Richard S. Miller 8/18/8

1116

1

HOFFMANTOWN ADD.


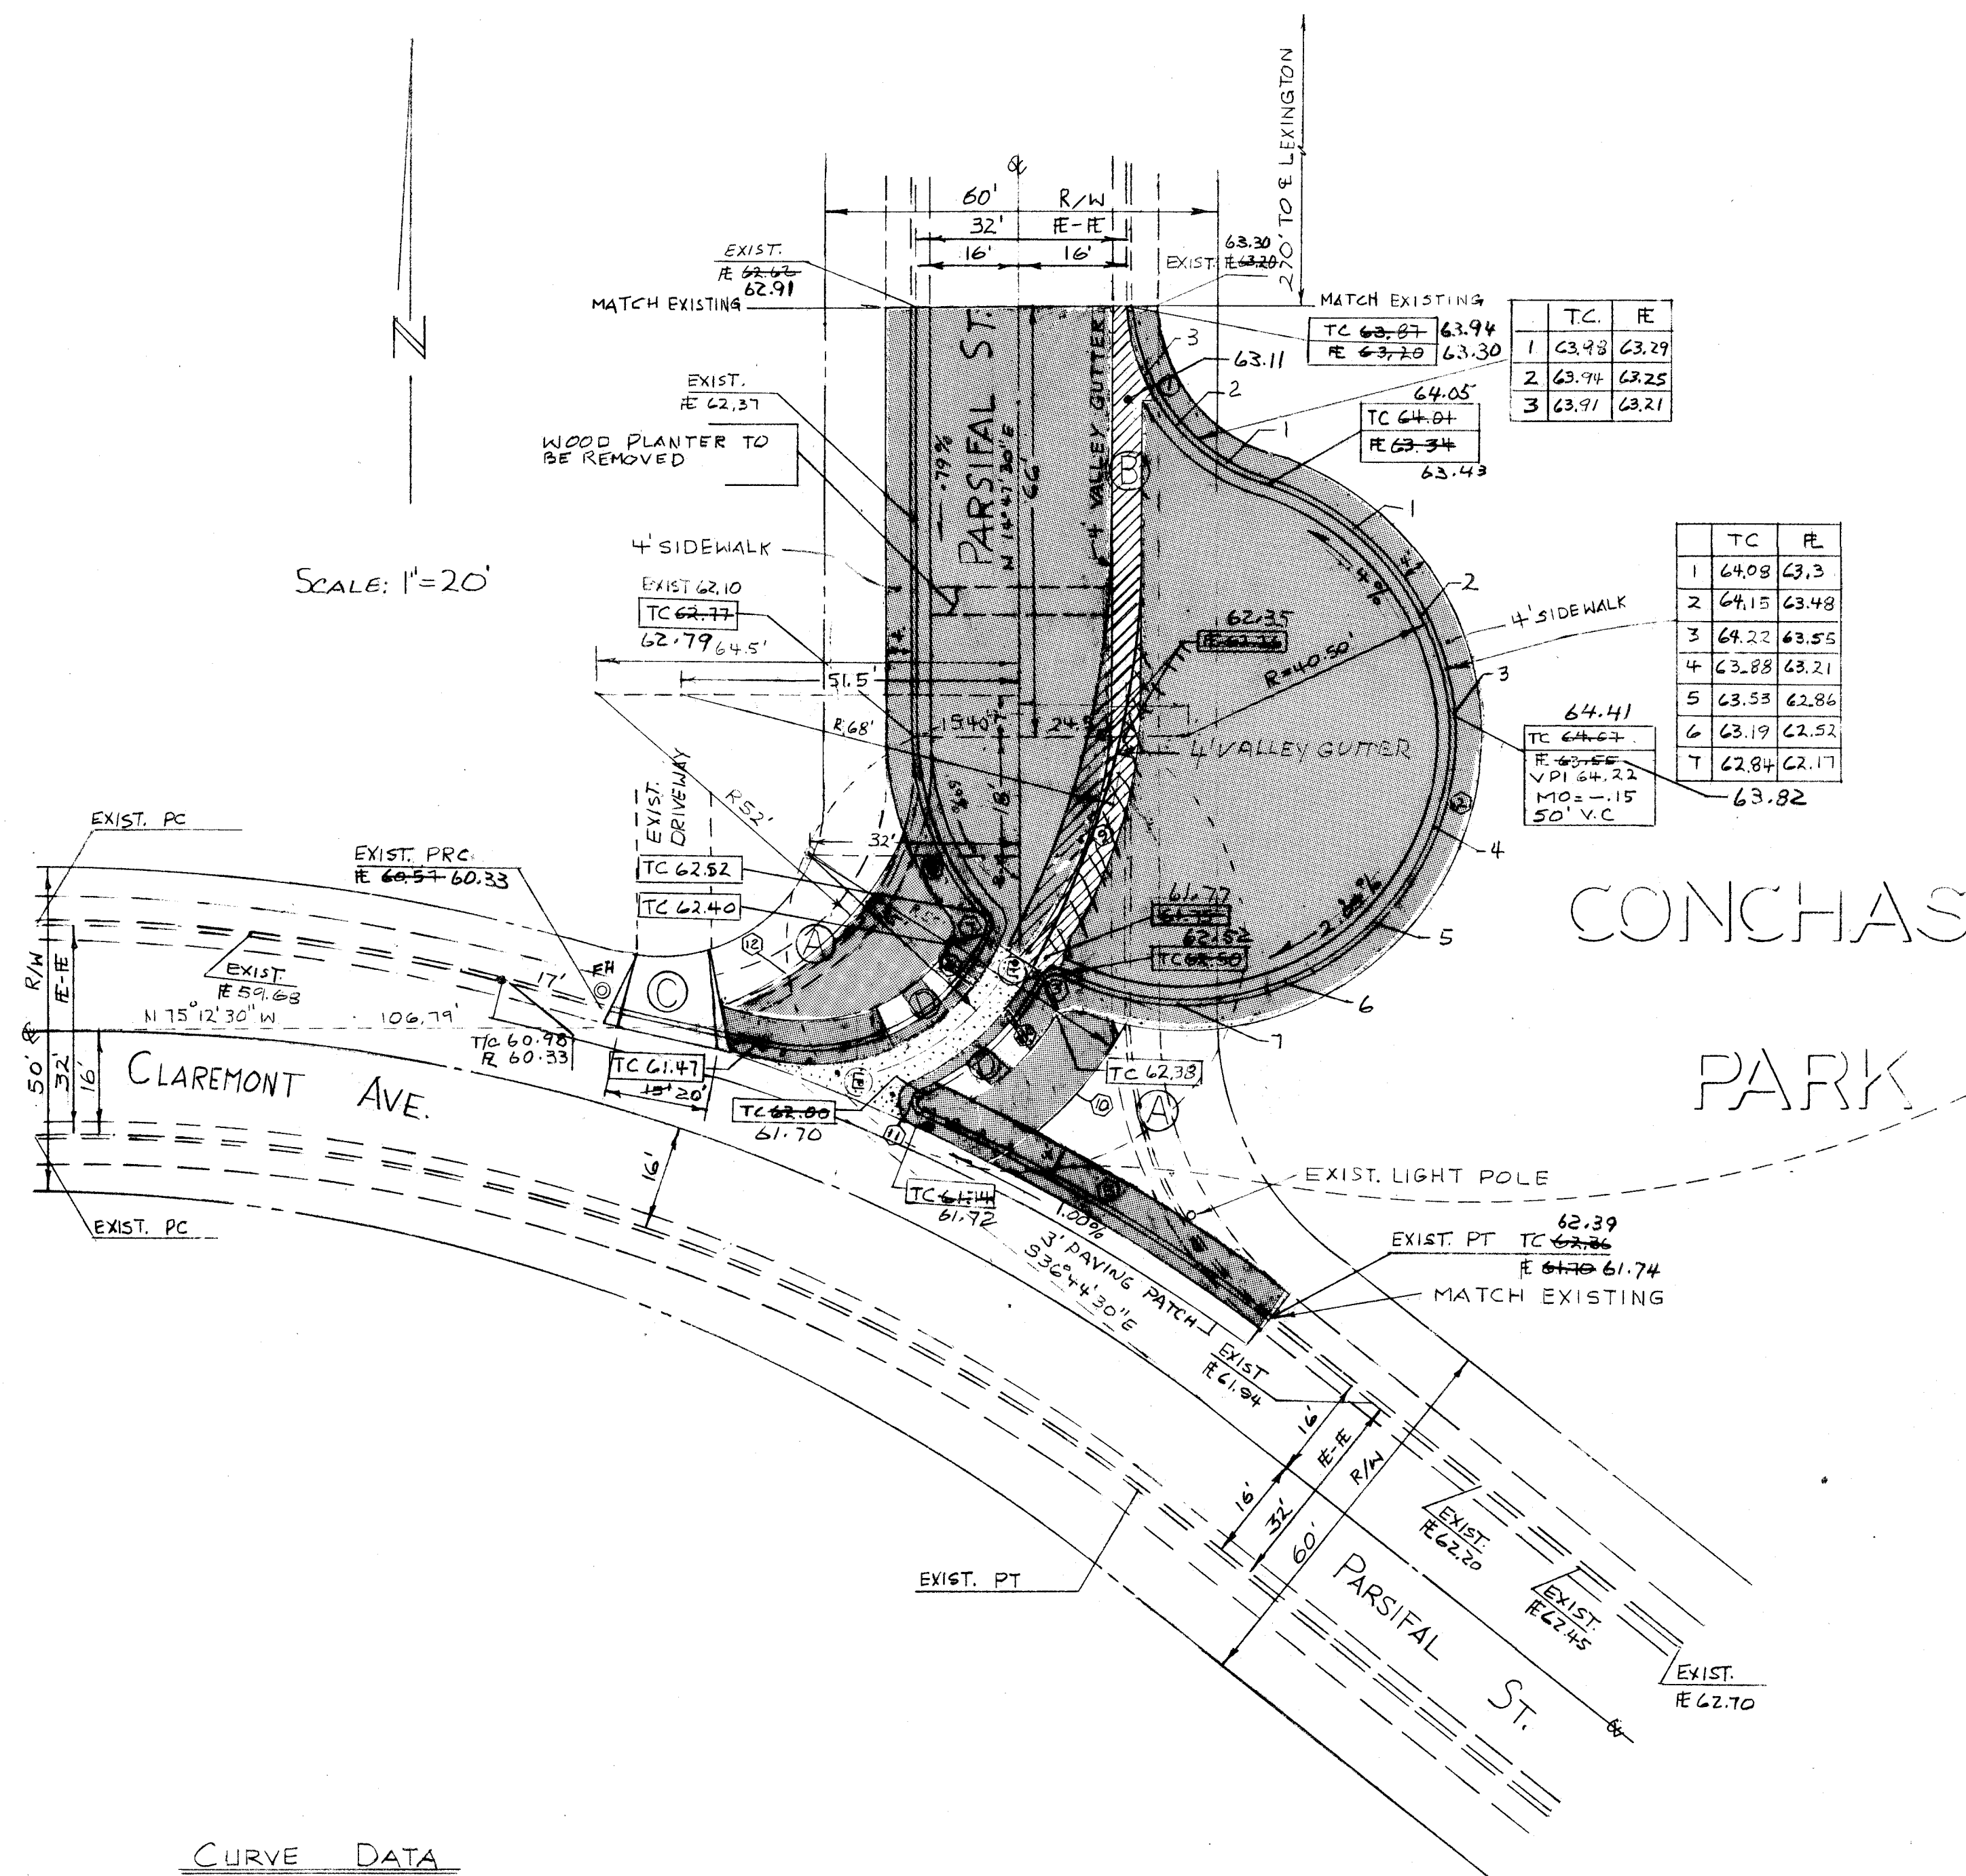


SCALE: 1"=20'

CONCHAS PARK


LEGEND

- BUILD 4' VALLEY GUTTER
- REMOVE GRASS, SIDEWALK, CURB & GUTTER AND PAVING. BUILD RESIDENTIAL TYPE PAVING, STD. C & S 4" SIDEWALK. REMOVE & REPLACE 1' OF 50" BEYOND SIDEWALK.
- EXIST. SIDEWALK, CURB & GUTTER
- (A) REMOVE C&G, PAVING, AND SIDEWALK FILL AREA WITH SELECT BACKFILL MATERIAL.
- (B) REMOVE CURB & GUTTER
- (C) REMOVE & REPLACE SIDEWALK, DRIVE P&D & C&G
- (D) BUILD WHEEL CHAIR RAMP
- (E) GUARD POSTS - 6" STEEL PIPE, CONCRETE-FILLED, 2' HIGH, 1" BULKY, @ 4' O.C.
- PROPOSED ELEVATIONS
- REMOVE ASPHALT PAVING. BUILD 6" CONC. PAVING

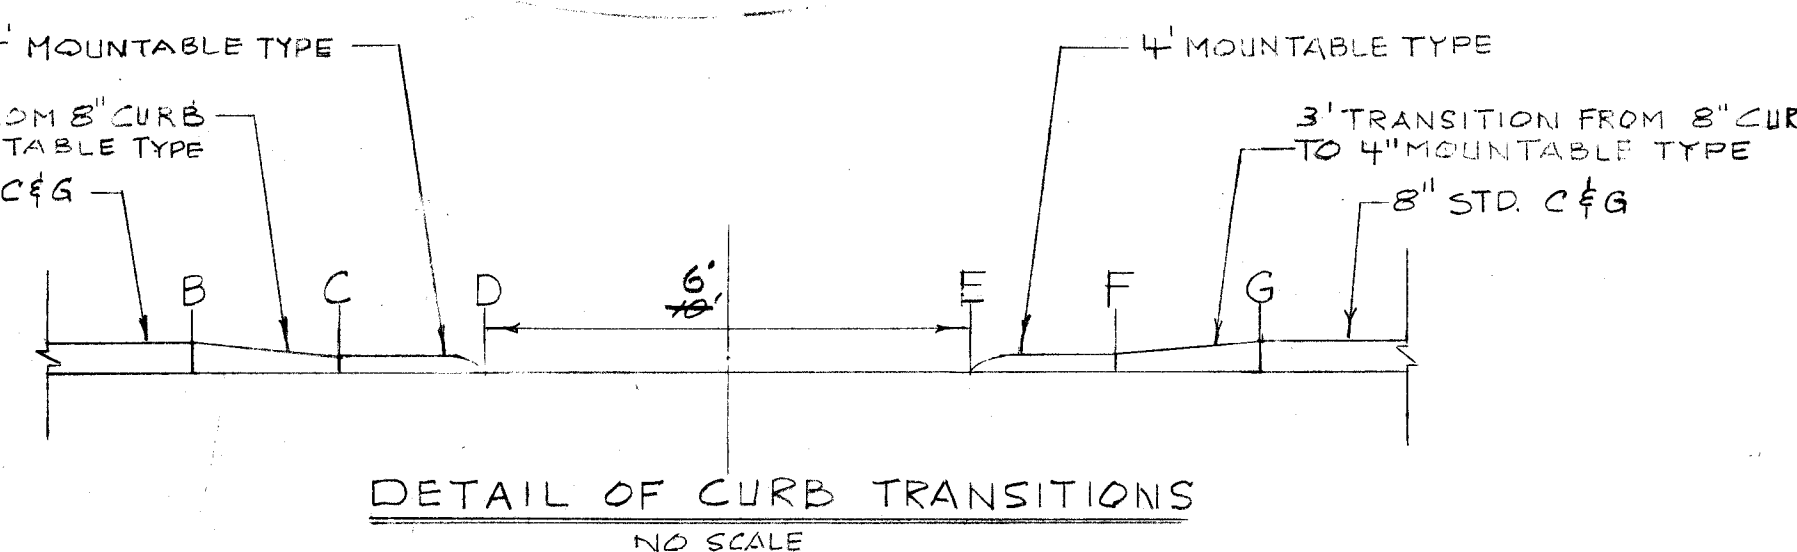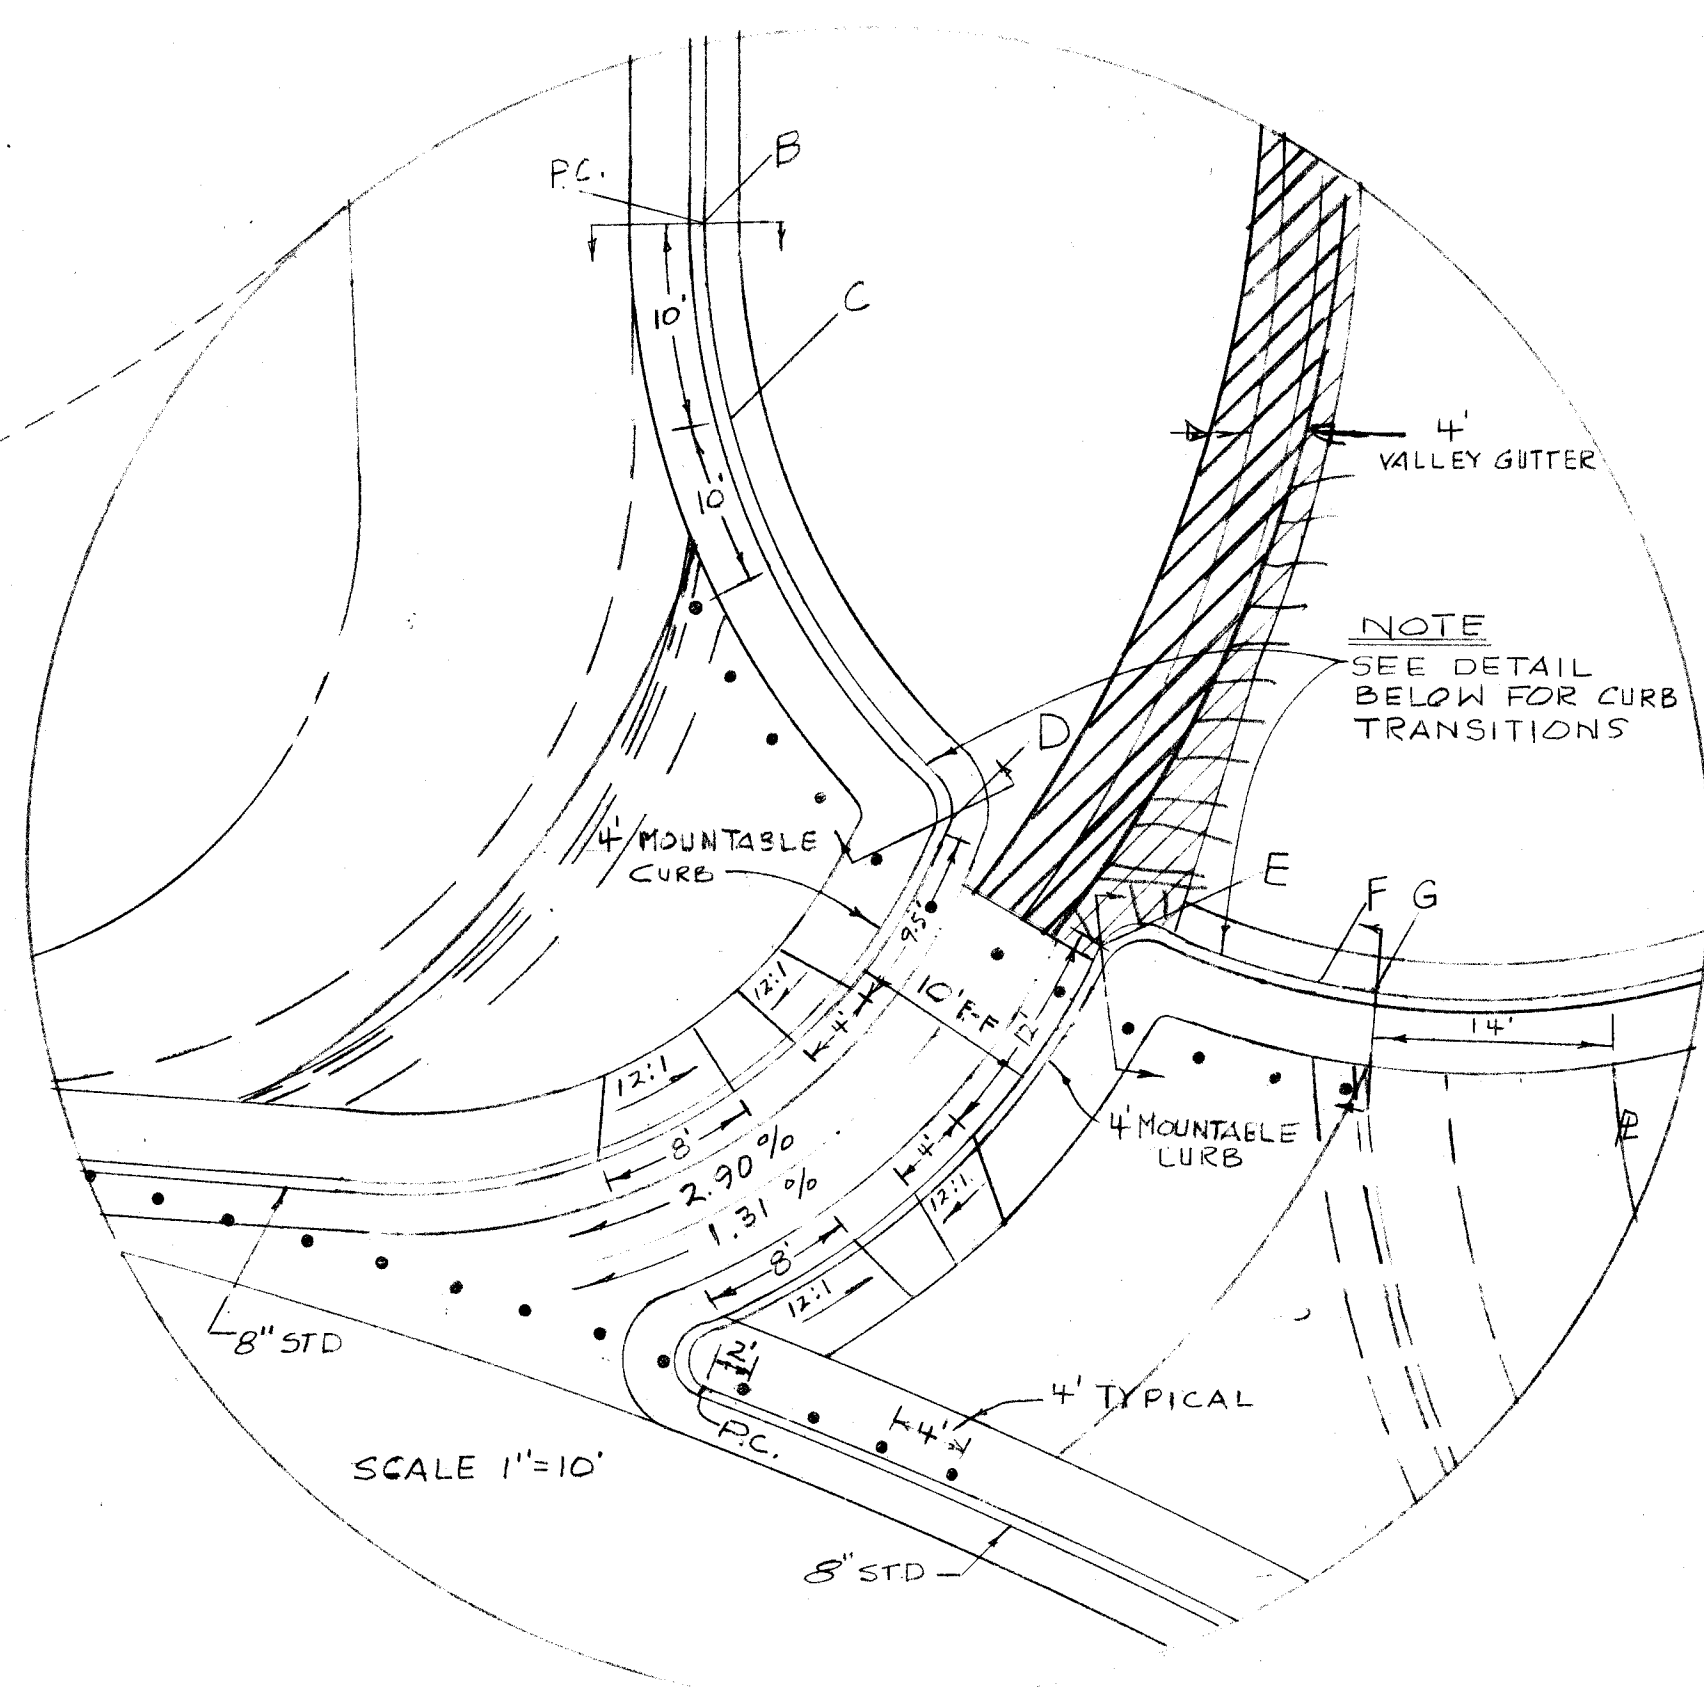

CURVE	DELTA	RADIUS TO FACE OF CURB	TANGENT	LENGTH
①	$\Delta = 75^{\circ}21'03''$	$R = 28'$	$T = 20.90'$	$L = 35.91'$
②	$\Delta = 19^{\circ}59'51''$	$R = 40.50'$	$T = 4.71'22''$	$L = 15.00'$
③	$\Delta = 98^{\circ}51'14''$	$R = 2.5'$	$T = 2.45'$	$L = 3.88'$
④	$\Delta = 41^{\circ}30'21''$	$R = 40'$	$T = 15.55'$	$L = 23.48'$
⑤	$\Delta = 13^{\circ}52'04''$	$R = 210'$	$T = 32.99'$	$L = 69.66'$
⑥	$\Delta = 78^{\circ}35'35''$	$R = 30'$	$T = 24.35'$	$L = 41.15'$
⑦	$\Delta = 60^{\circ}00'00''$	$R = 4.5'$	$T = 2.64'$	$L = 4.71'$
⑧	$\Delta = 37^{\circ}41'51''$	$R = 40.56'$	$T = 14.62'$	$L = 28.04'$
⑨	$\Delta = 58^{\circ}36'41''$	$R = 66'$	$T = 23.84'$	$L = 38.86'$
⑩	$\Delta = 27^{\circ}50'39''$	$R = 55'$	$T = 13.88'$	$L = 26.05'$
⑪	$\Delta = 138^{\circ}14'02''$	$R = 2'$	$T = 5.24'$	$L = 4.83'$
⑫	$\Delta = 12^{\circ}05'33''$	$R = 62'$	$T = 20.01'$	$L = 38.20'$

NOTE:
CONTRACTOR SHALL NOTIFY PARKS & RECREATION DEPT. IS WORKING DAYS PRIOR TO CONSTRUCTION FOR REMOVAL OF SPRINKLER SYSTEM AND SOD.

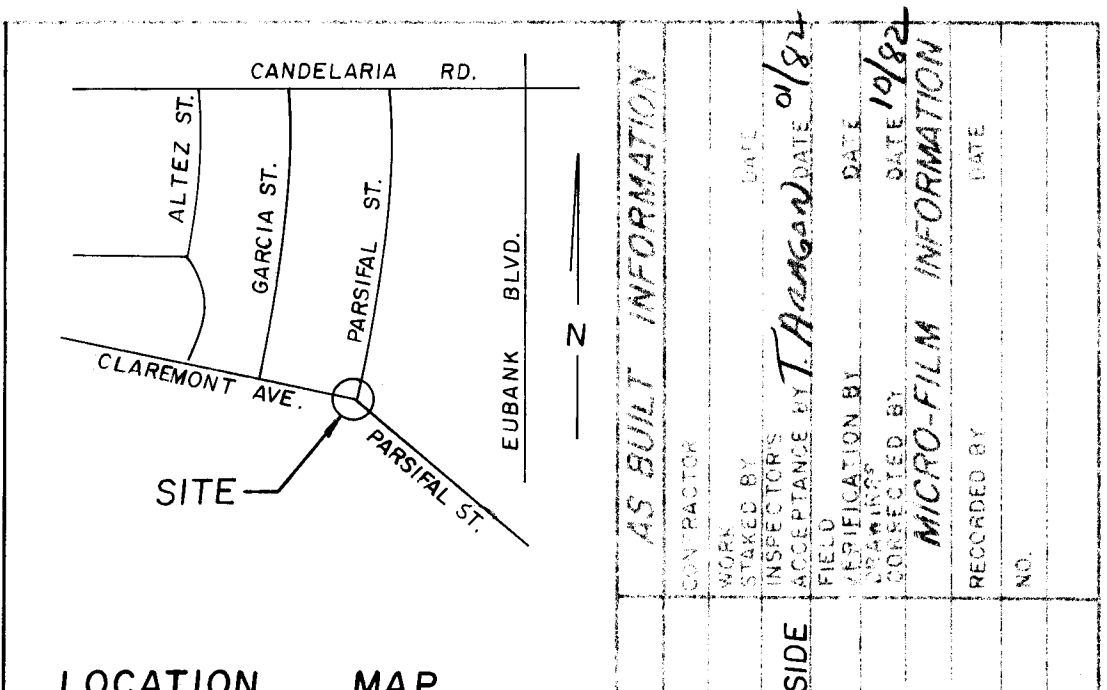

NO.	DATE	REVISIONS
1	11/11/11	1. INITIAL DESIGN
2	11/11/11	2. REVISED DESIGN
3	11/11/11	3. REVISED DESIGN
4	11/11/11	4. REVISED DESIGN
5	11/11/11	5. REVISED DESIGN
6	11/11/11	6. REVISED DESIGN
7	11/11/11	7. REVISED DESIGN
8	11/11/11	8. REVISED DESIGN
9	11/11/11	9. REVISED DESIGN
10	11/11/11	10. REVISED DESIGN
11	11/11/11	11. REVISED DESIGN
12	11/11/11	12. REVISED DESIGN
13	11/11/11	13. REVISED DESIGN
14	11/11/11	14. REVISED DESIGN
15	11/11/11	15. REVISED DESIGN
16	11/11/11	16. REVISED DESIGN
17	11/11/11	17. REVISED DESIGN
18	11/11/11	18. REVISED DESIGN
19	11/11/11	19. REVISED DESIGN
20	11/11/11	20. REVISED DESIGN

CITY OF ALBUQUERQUE
MUNICIPAL DEVELOPMENT DEPARTMENT
ENGINEERING DIVISION

TITLE: STREET RECONSTRUCTION — CLAREMONT AVE. @ PARSIFAL ST.

APPROVALS: DATE: 11/11/11
CITY ENGINEER: DATE: 11/11/11
A.C.E. DESIGN: DATE: 11/11/11
A.C.E. HYDROLOGY: DATE: 11/11/11

DRAWING NO. 1116 MAP NO. H-20 SHEET 2 OF 2