


SAS LINE REPLACEMENT & EXTENSION

IN CLAYTON ST. & ALLEY WEST OF CLAYTON
NORTH OF NEW YORK AVE. S.W.

LASON 1-505-344-9404
BEST COPY AVAILABLE

INDEX	
SHEET	TITLE
1	TITLE SHEET
2	PLAN & PROFILE

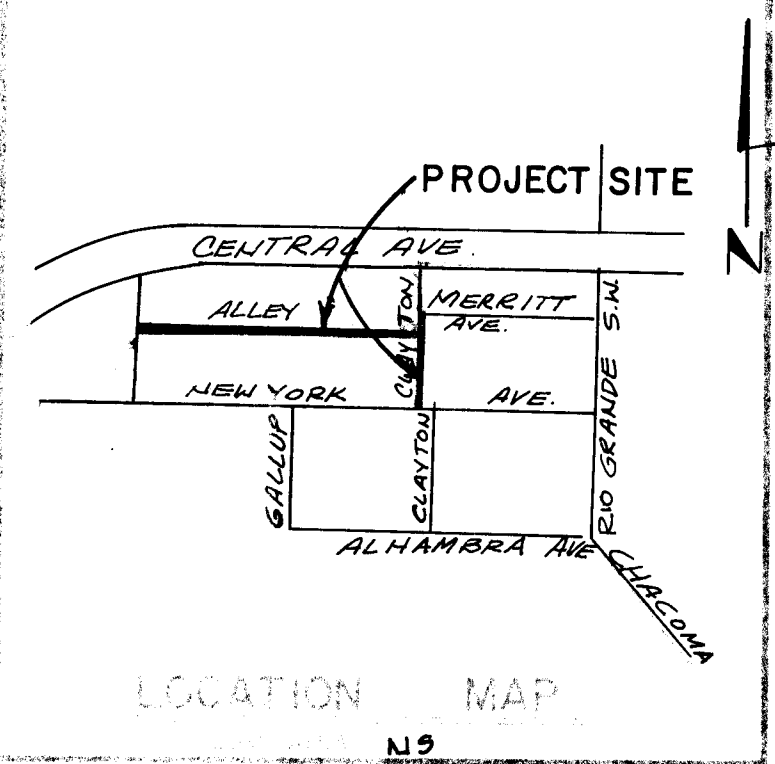

"NOTICE TO CONTRACTORS"

1. The City Engineer is authorized to issue a "Notice to Contractors" for the purpose of requiring the contractor to comply with the specifications and standards of the City of Los Angeles.

2. The contractor shall be responsible for obtaining all necessary permits and licenses from the appropriate city and state agencies.

3. The contractor shall be responsible for obtaining all necessary insurance coverage, including liability and workers' compensation.

4. The contractor shall be responsible for obtaining all necessary bonds and sureties.

5. The contractor shall be responsible for obtaining all necessary approvals from the appropriate city and state agencies.

6. The contractor shall be responsible for obtaining all necessary permits and licenses from the appropriate city and state agencies.

7. The contractor shall be responsible for obtaining all necessary insurance coverage, including liability and workers' compensation.

8. The contractor shall be responsible for obtaining all necessary bonds and sureties.

9. The contractor shall be responsible for obtaining all necessary approvals from the appropriate city and state agencies.

10. The contractor shall be responsible for obtaining all necessary permits and licenses from the appropriate city and state agencies.



- 1. The contractor shall be responsible for obtaining all necessary permits and licenses from the appropriate city and state agencies.
- 2. The contractor shall be responsible for obtaining all necessary insurance coverage, including liability and workers' compensation.
- 3. The contractor shall be responsible for obtaining all necessary bonds and sureties.
- 4. The contractor shall be responsible for obtaining all necessary approvals from the appropriate city and state agencies.
- 5. The contractor shall be responsible for obtaining all necessary permits and licenses from the appropriate city and state agencies.
- 6. The contractor shall be responsible for obtaining all necessary insurance coverage, including liability and workers' compensation.
- 7. The contractor shall be responsible for obtaining all necessary bonds and sureties.
- 8. The contractor shall be responsible for obtaining all necessary approvals from the appropriate city and state agencies.
- 9. The contractor shall be responsible for obtaining all necessary permits and licenses from the appropriate city and state agencies.
- 10. The contractor shall be responsible for obtaining all necessary insurance coverage, including liability and workers' compensation.

APPROVAL OF AS BUILT DRAWINGS
AST CITY ENGINEER-FIELD
[Signature]
DATE 2/2/88

20 11 17 01 8 2

APPROVED FOR
CONSTRUCTION
[Signature] 8/2/88
DRAWING
1117
SHEET 1 OF 2

TRACTION PARK AND CITY ELECTRIC ADD

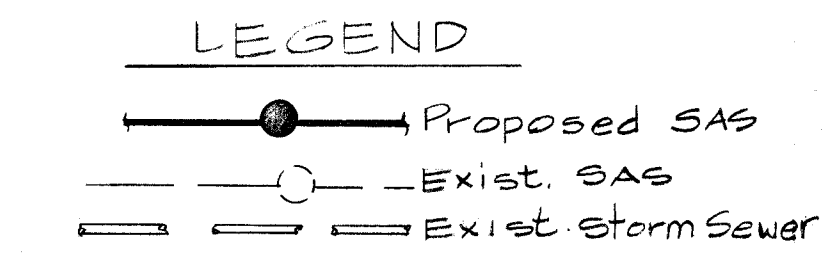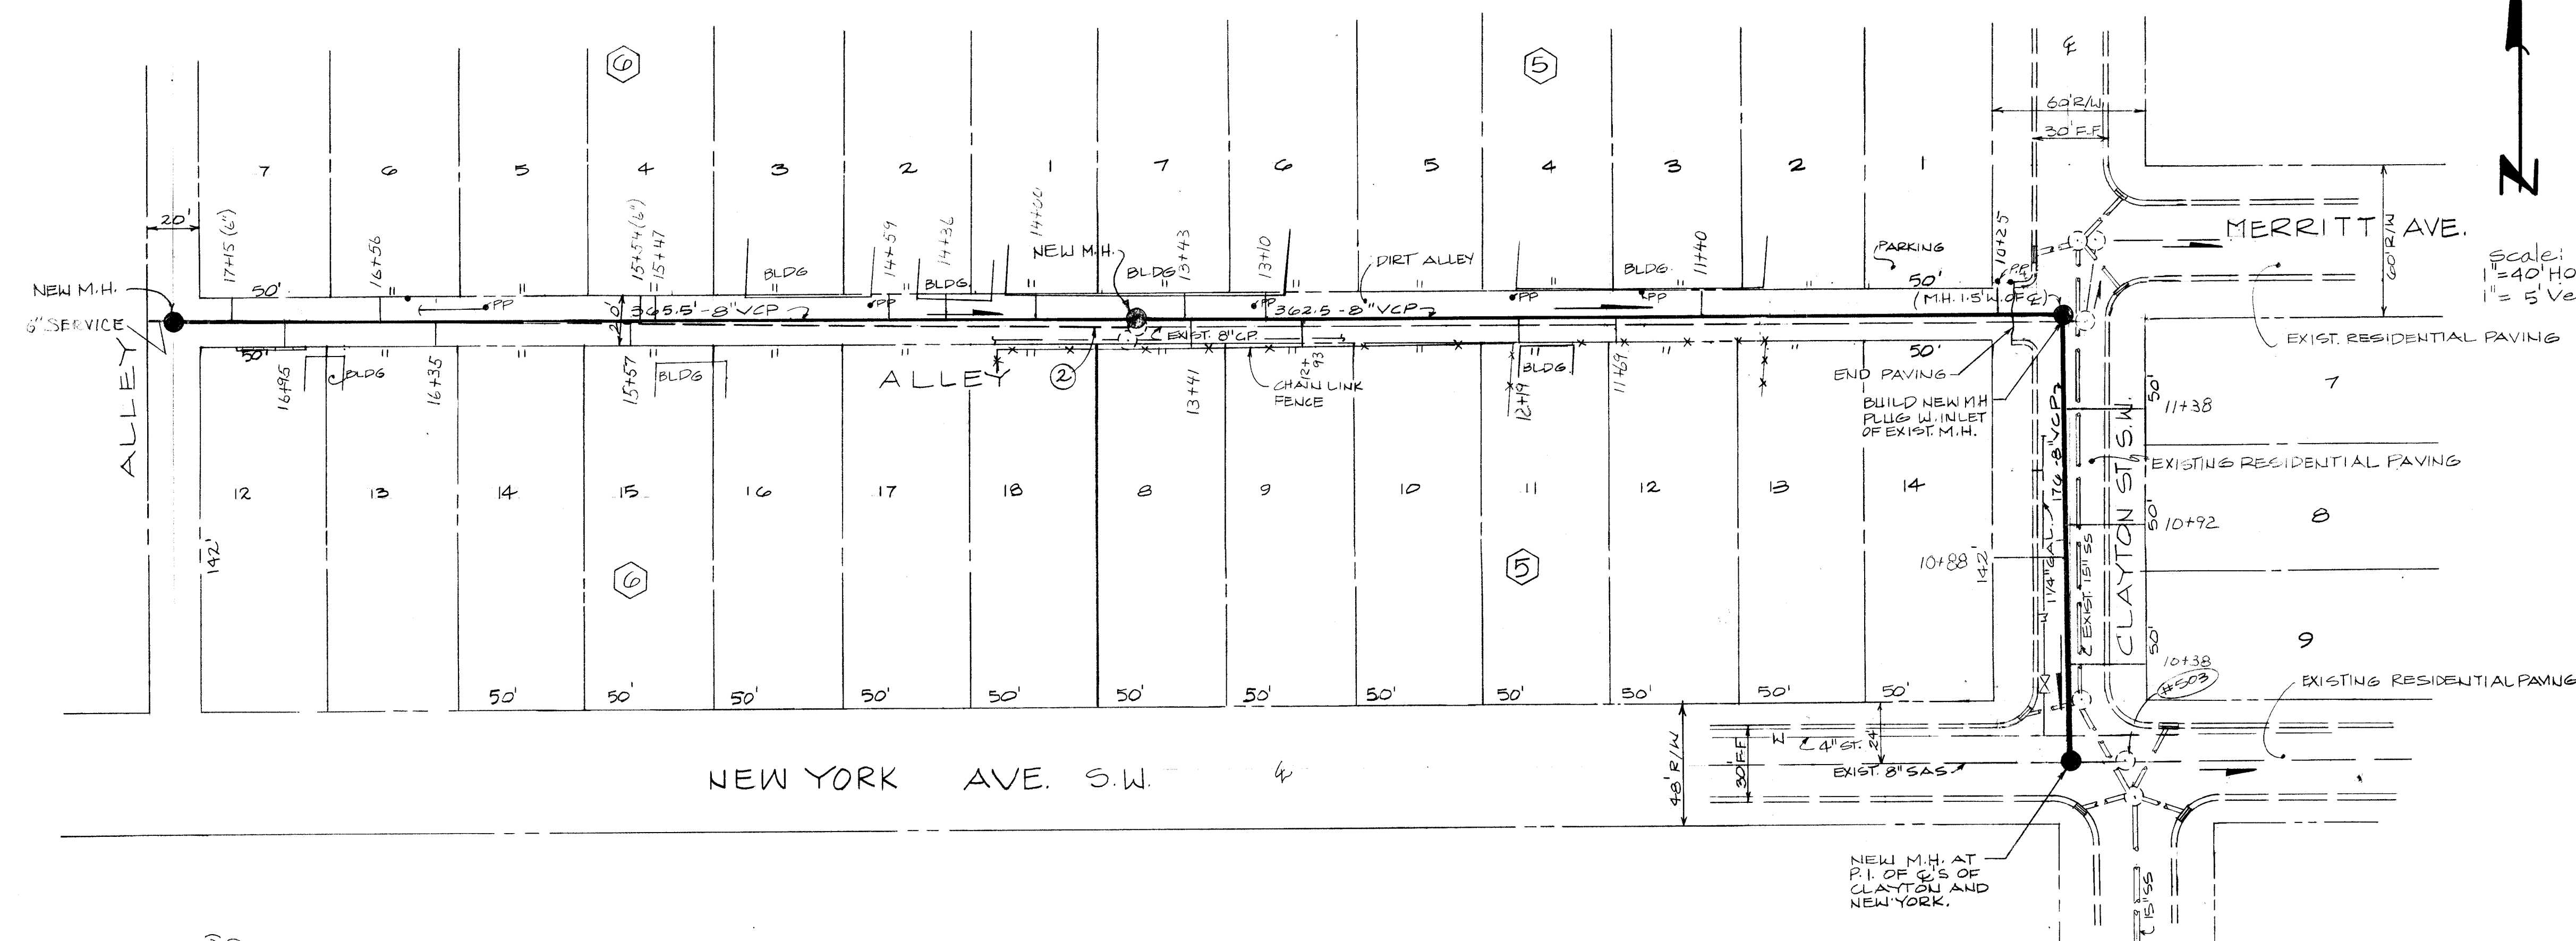

NOTES:

1. RECONNECT EXIST. SAS SERVICES TO NEW MAIN EXACT LOCATIONS OF SAS SERVICES TO BE VERIFIED IN THE FIELD.
2. REMOVE EXIST. SAS PIPE AND MANHOLES IN ALLEY.
3. NEW MANHOLE RIM ELEV'S TO MATCH EXIST. PAVEMENT ELEV'S AT M.H. LOCATIONS OR RIM ELEV OF EXIST. M.H. BEING REMOVED.

CBM 495154 RIM ELEV @ ALLEY 4
CLAYTON

9/30/01


MISC. ANGEL
18.69

9/28/01

18.20 ANGEL
18.42

6/1/01

DZANORA

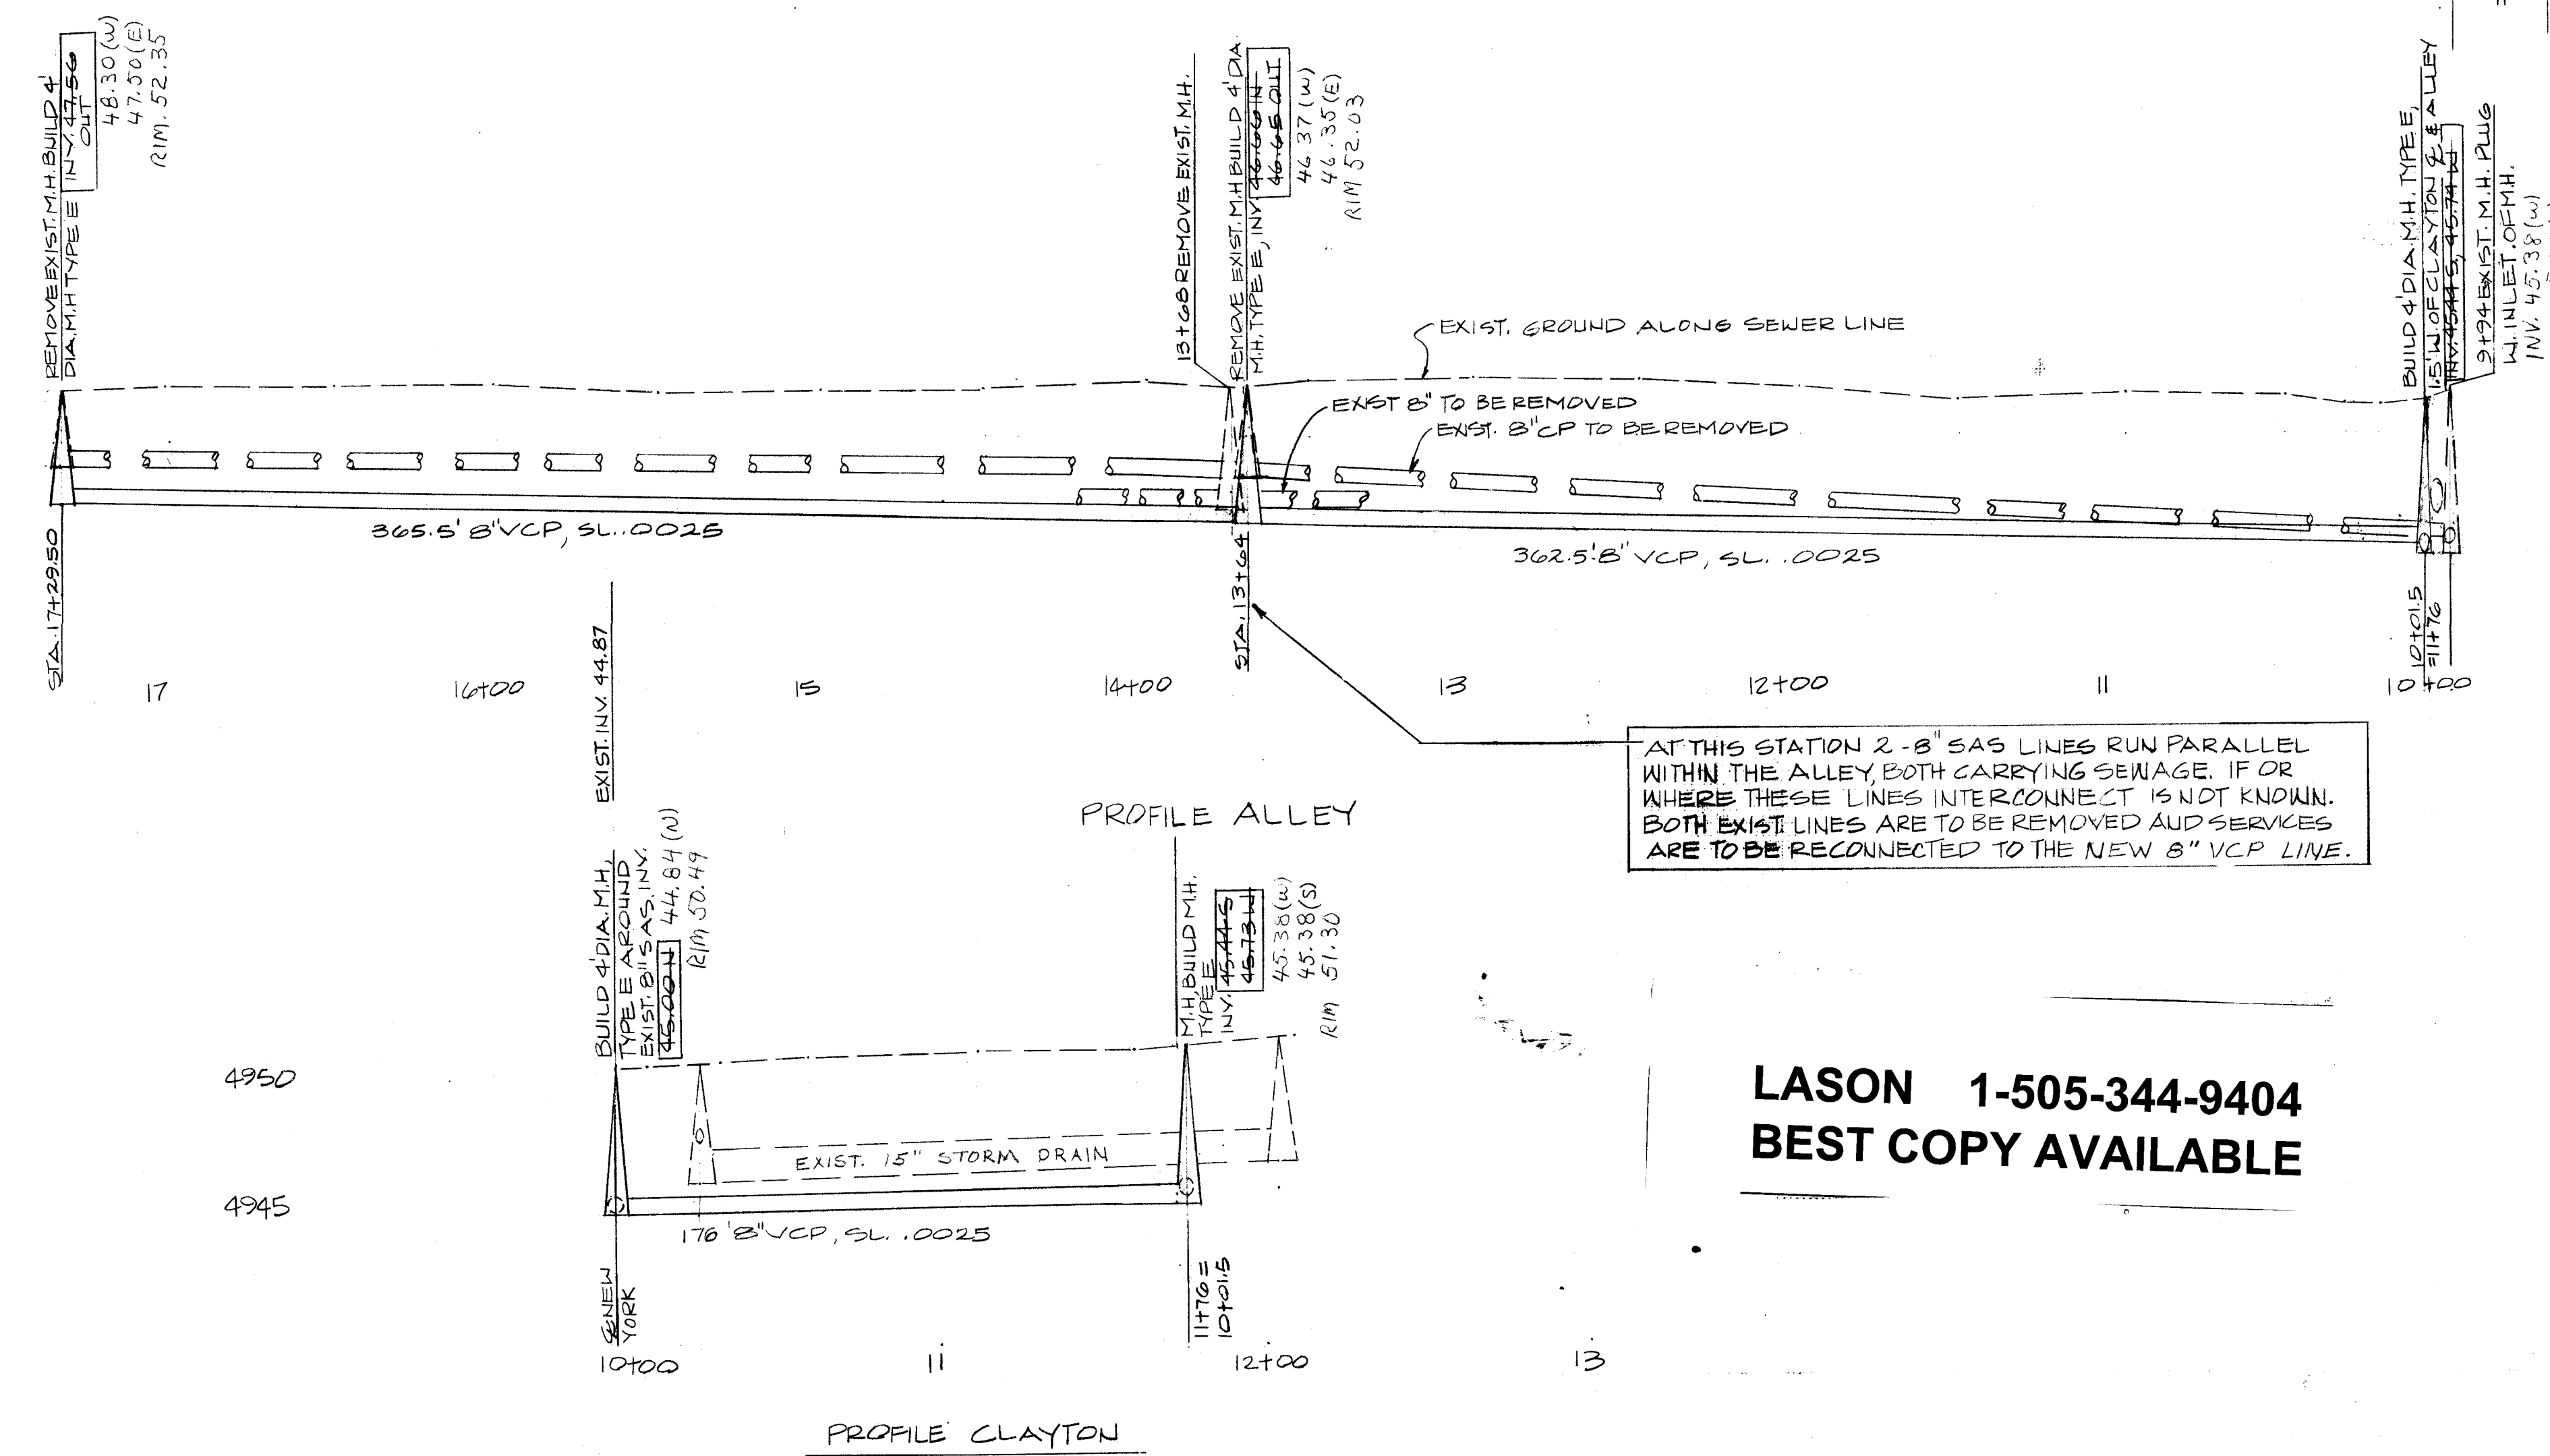

LASON 1-505-344-9404
BEST COPY AVAILABLE

SAS LINE REPLACEMENT & EXTENSION IN ALLEY
B/W CENTRAL & NEW YORK WEST OF CLAYTON ALSO ON
CLAYTON NORTH OF NEW YORK TO ALLEY.

8/10/01
J. R. Riddick 17 Aug 01

8/10/01
J. R. Riddick 17 Aug 01

1117 J-13 2 2