


EL PASEO
TOWN HOUSES
GRUPE DEVELOPMENT COMPANY

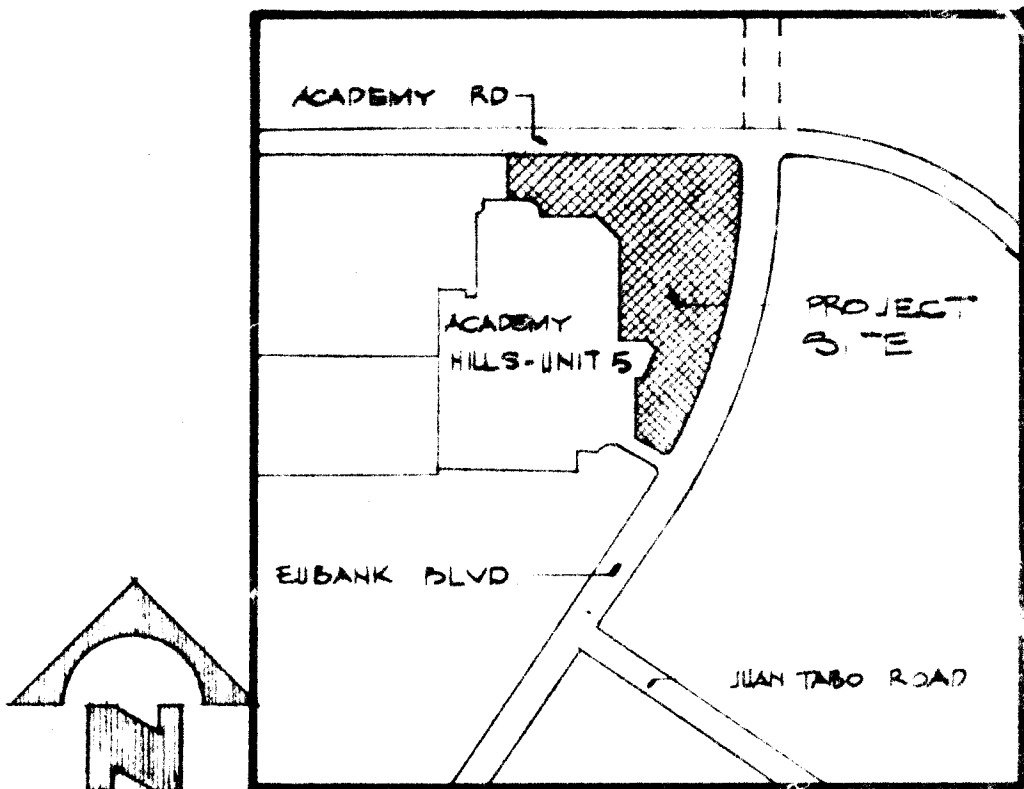

VICINITY MAP

- NOTICE TO CONTRACTORS
1. NEW MEXICO STANDARD SPECIFICATIONS FOR HIGHWAY CONSTRUCTION, 1983 EDITION, SHALL BE REFERRED TO HEREON AS THE STANDARD SPECIFICATION.
 2. ALL WORK DETAIL ON THESE PLANS TO BE PERFORMED UNDER CONTRACT SHALL EXCEPT AS OTHERWISE STATED OR PROVIDED HEREIN, BE CONSTRUCTED IN ACCORDANCE WITH CONTRACT DOCUMENTS FOR CITY, STATE AND CASH PAVING AND THE STANDARD SPECIFICATION.
 3. THE AGENCE OUVRE PRIOR TO ANY EXCAVATION CONTRACTOR MUST CONTACT THE LOCAL OFFICE OF THE CITY ENGINEER FOR LOCATION OF EXISTING UTILITIES.
 4. PRIOR TO CONSTRUCTION THE CONTRACTOR SHALL EXCAVATE AND VERIFY THE HORIZONTAL AND VERTICAL LOCATIONS OF ALL UTILITIES. SHOULD A CONFLICT EXIST THE CONTRACTOR SHALL NOTIFY THE ENGINEER OR OWNER SO THAT THE CONFLICT CAN BE RESOLVED WITH MINIMUM AMOUNT OF DELAY.

THE FOLLOWING NOTES APPLY WHEN CHECKED

- ☒ ALL CURBS AND CURB GRADIENTS SHALL BE NOTED PRIOR TO PAVING.
- ☒ BACKFILL COMPACTION SHALL BE ACCORDING TO SPECIFIED STREET USE.
- ☒ TACK COAT REQUIREMENTS SHALL BE DETERMINED BY THE CITY ENGINEER.
- ☒ SIDEWALKS AND WHEELCHAIR RAMPS WITHIN THE Curb RETURN SHALL BE CONSTRUCTED. HOWEVER, A NEW CURB RETURN IS CONSTRUCTED.
- ☐ IF C&G IS REQUIRED FOR A DRIVEWAY, THE DRIVEWAY SHALL BE CONSTRUCTED PRIOR TO ACCEPTANCE OF THE C&G AND G&G&A.
- ☐ ALL STORM DRAINAGE FACILITIES SHALL BE COMPLETED PRIOR TO FINAL ACCEPTANCE.
- ☐ PAINT ALL NEW WATER VALVE BOXES, COVER BOXES, AND BLUE ENCASE OR BLUE PAINT THE COVER BOXES. PAINTS SHALL BE EQUIVALENT TO SAFETY BLUE.

PLANS FOR SITE GRADING,
WATER & SEWER

INDEX TO DRAWINGS

- 1. COVER SHEET
- 2-4. RECORD PLAT
- 5. GRADING PLAN
- 6. COMPOSITE UTILITY PLAN
- 7-10. WATER/SEWER PLAN & PROFILE SHEETS
- 11-13. BUS BAY/TURN BAY DETAILS (STREET P&P FOR INFORMATION ONLY)

NOTE: SHEET NO. 10 DELETED

134, 136, 130 PAVING ITEMS
14, 15, 16 GRADING PLAN, DRAINAGE & RETAINING WALLS

APPROVAL OF AS BUILT DRAWINGS
CITY ENGINEER FIELD
DATE 2/2/85

CITY OF ALBUQUERQUE MUNICIPAL DEVELOPMENT DEPARTMENT ENGINEERING DIVISION					
EL PASEO (PHASE I)					
APPROVALS	ENGINEER	DATE	APPROVALS	ENGINEER	DATE
CITY ENGINEER	12846	7/30/81	JOJO WASTE	12846	7/30/81
ACE DESIGN	12846	7/30/81	TRAMP	12846	7/30/81
ACE DESIGN	12846	7/30/81	WATER	12846	7/30/81
APPROVAL FOR CONSTRUCTION	10761/81	DATE	DRAWING NO	1130	SHEET 1 OF 13

81 46737

**PLAT OF
EL PASEO**
Albuquerque, New Mexico
(A Replat of Tr. A, ACADEMY HILLS SUBDIVISION, UNIT 5)
MAY, 1981

DISCLOSURE STATEMENT

The purpose of this Plat is to locate proposed easements on Tract "A", Summary Plat of Academy Hills Subdivision, Unit 5, filed May 30, 1978, and to grant utility easements as shown hereon, and to dedicate the turn bay area and bus bay area as shown hereon. Capped Rebar were set at the exterior property corners unless otherwise designated.


NOTE: Approval of and filing with the County Clerk of Bernalillo County of this Plat does not vacate or in any way affect public or private easements, except as shown on this Plat.

NOTES:

1. Tract "A" contains 12,265 Acres.
2. Lot 113 is Common Area and includes Parking Spaces.
3. Lot 113 will be conveyed to and maintained by a Mandatory Homeowners' Association.
4. All lots shall have an easement across Lot 113 for utilities and access, except that use of such easement shall not interfere with the planned use of Lot 113 for driveways, parking, swimming pool, special landscaping and similar uses.
5. Garages are 11' x 23' and are shown thus: [27A]
6. A Garage will be conveyed with the residential lot, having the same number.
7. Lot lines do not necessarily coincide with building lines.
8. Bearings shown hereon are referenced to the Summary Plat of Academy Hills Subdivision, Unit 5, filed May 30, 1978.
9. B. M. used for construction purposes is 1-E21 A, Elevation = 5642.71.

EASEMENTS

1. Water Meter Easements are designated "W M" (See Typical Drawing Sheet 3).
2. Fire Hydrant Easements are designated "F H" (See Typical Drawing Sheet 3).
3. The Water Resources Dept. of the City of Albuquerque shall have the exclusive right to place underground utilities within 6 feet of the center-line of a sewerline and within 4 feet of the center-line of a waterline in all areas within Lot 113 designated as private drives, except for perpendicular crossings or where written approval has been obtained. Those utilities having the right for perpendicular crossings of said easement shall include but not be limited to the Gas Co. of N. M., Mountain States Tel. & Tel. Co., Public Service Co. of N. M., & Albuquerque Cable Television, Inc. The Water Resources Dept. is hereby granted an access easement over and across the areas within Lot 113 designated as private drives for the installation, service and maintenance of City Water and Sewer Lines and their appurtenances.
4. Transformer Easements are designated "T" and are 75' x 75'.

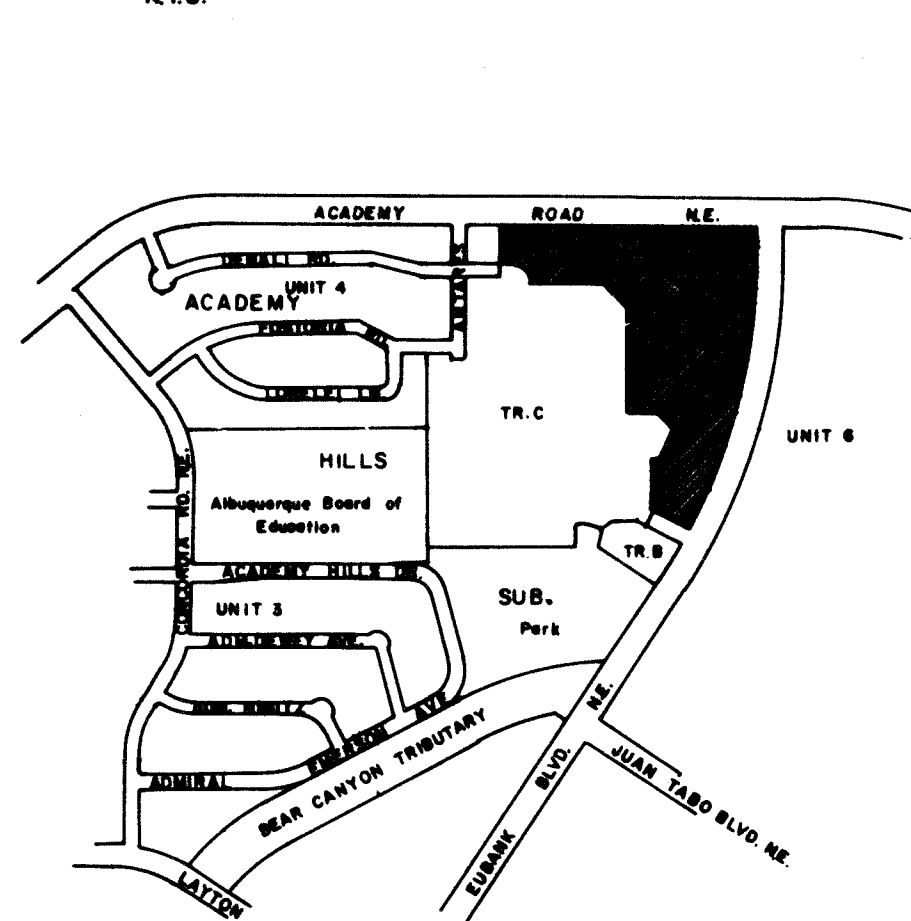VICINITY MAP

State of New Mexico } SS
County of Bernalillo }
The instrument was filed for record on
AUG 3 1 1981
at 10:04 AM. Recorded in Vol. _____
of records of Bernalillo County for the _____
_____ Deputy Clerk

DESCRIPTION:

A Replat of Tract lettered "A" of the Summary Plat of ACADEMY HILLS SUBDIVISION, UNIT 5, an Addition to the City of Albuquerque, New Mexico, as the same is shown and designated on the Plat thereof, filed in the office of the County Clerk of Bernalillo County, New Mexico, on May 30, 1978. (Now being EL PASEO)

FREE CONSENT AND DEDICATION

The undersigned owner(s) and Proprietor(s) of the property described hereon do hereby consent to the Platting of said property as shown hereon and do hereby dedicate the Public Utility Easements as shown hereon and do hereby dedicate the widening of Academy Road N.E. as shown hereon for a right turn bay area and the widening of Eubank Blvd. N.E. as shown hereon for a bus bay area and the same are with free consent and in accordance with their desires.

STATE SAVINGS AND LOAN

GRUPE CONSTRUCTION WEST, INC.

ACKNOWLEDGMENT

STATE OF CALIFORNIA } SS

COUNTY OF SAN JOAQUIN }

On this 8th day of JUNE, 1981, the foregoing instrument was acknowledged before me by VERNON E. HALL, SR. VICE PRES. AND PRES. OF GRAPE CONSTRUCTION WEST, INC. and FRANK A. PASEADORS, VICE PRES. OF STATE SAVINGS AND LOAN ASSN. My commission expires January 1, 1982

SURVEYOR'S CERTIFICATE

I, Vernon E. Hall, New Mexico Registered Land Surveyor No. 3241, do hereby certify that this Plat was prepared by me or under my supervision, meets the minimum requirements for monumentation and surveys of the Albuquerque Subdivision Ordinance, shows all easements of record, (unless otherwise noted on this Plat), and is true and correct to the best of my belief and knowledge.

Vernon E. Hall
Vernon E. Hall, N.M.L.S. No. 3241

SP81-260

APPROVED AND ACCEPTED BY:

Subdivision No. - City Zone Atlas E-21-2
Eugene H. Hales 8-31-81
Planning Director Date
David S. Hales 8/28/81
City Engineer Date
William J. Hales 6-30-81
City Engineer Date
John W. Hales 7/1/81
City Engineer Date
William J. Hales 7/27/81
City Engineer Date
William J. Hales 7-1-81
City Engineer Date
William J. Hales 8/18/81
City Engineer Date
William J. Hales 7-1-81
City Engineer Date
William J. Hales 6-30-81
City Engineer Date
William J. Hales 7/1/81
City Engineer Date
William J. Hales 8/18/81
City Engineer Date

Refuse Removal

Date


Sheet 1 of 4


HALL SURVEYING CO.


2625 Pennsylvania Ave N.E., Suite 350
Albuquerque, New Mexico 87110
Phone (505) 884-6200 & 884-6444
E-218
Client: Grape Development Co.

26 1130 0285

CITY OF ALBUQUERQUE MUNICIPAL DEVELOPMENT DEPARTMENT ENGINEERING DIVISION		
TITLE: EL PASEO (PHASE I)		
DRAWING NO. 1130	DATE MAY 81	SHEET 2 OF 13

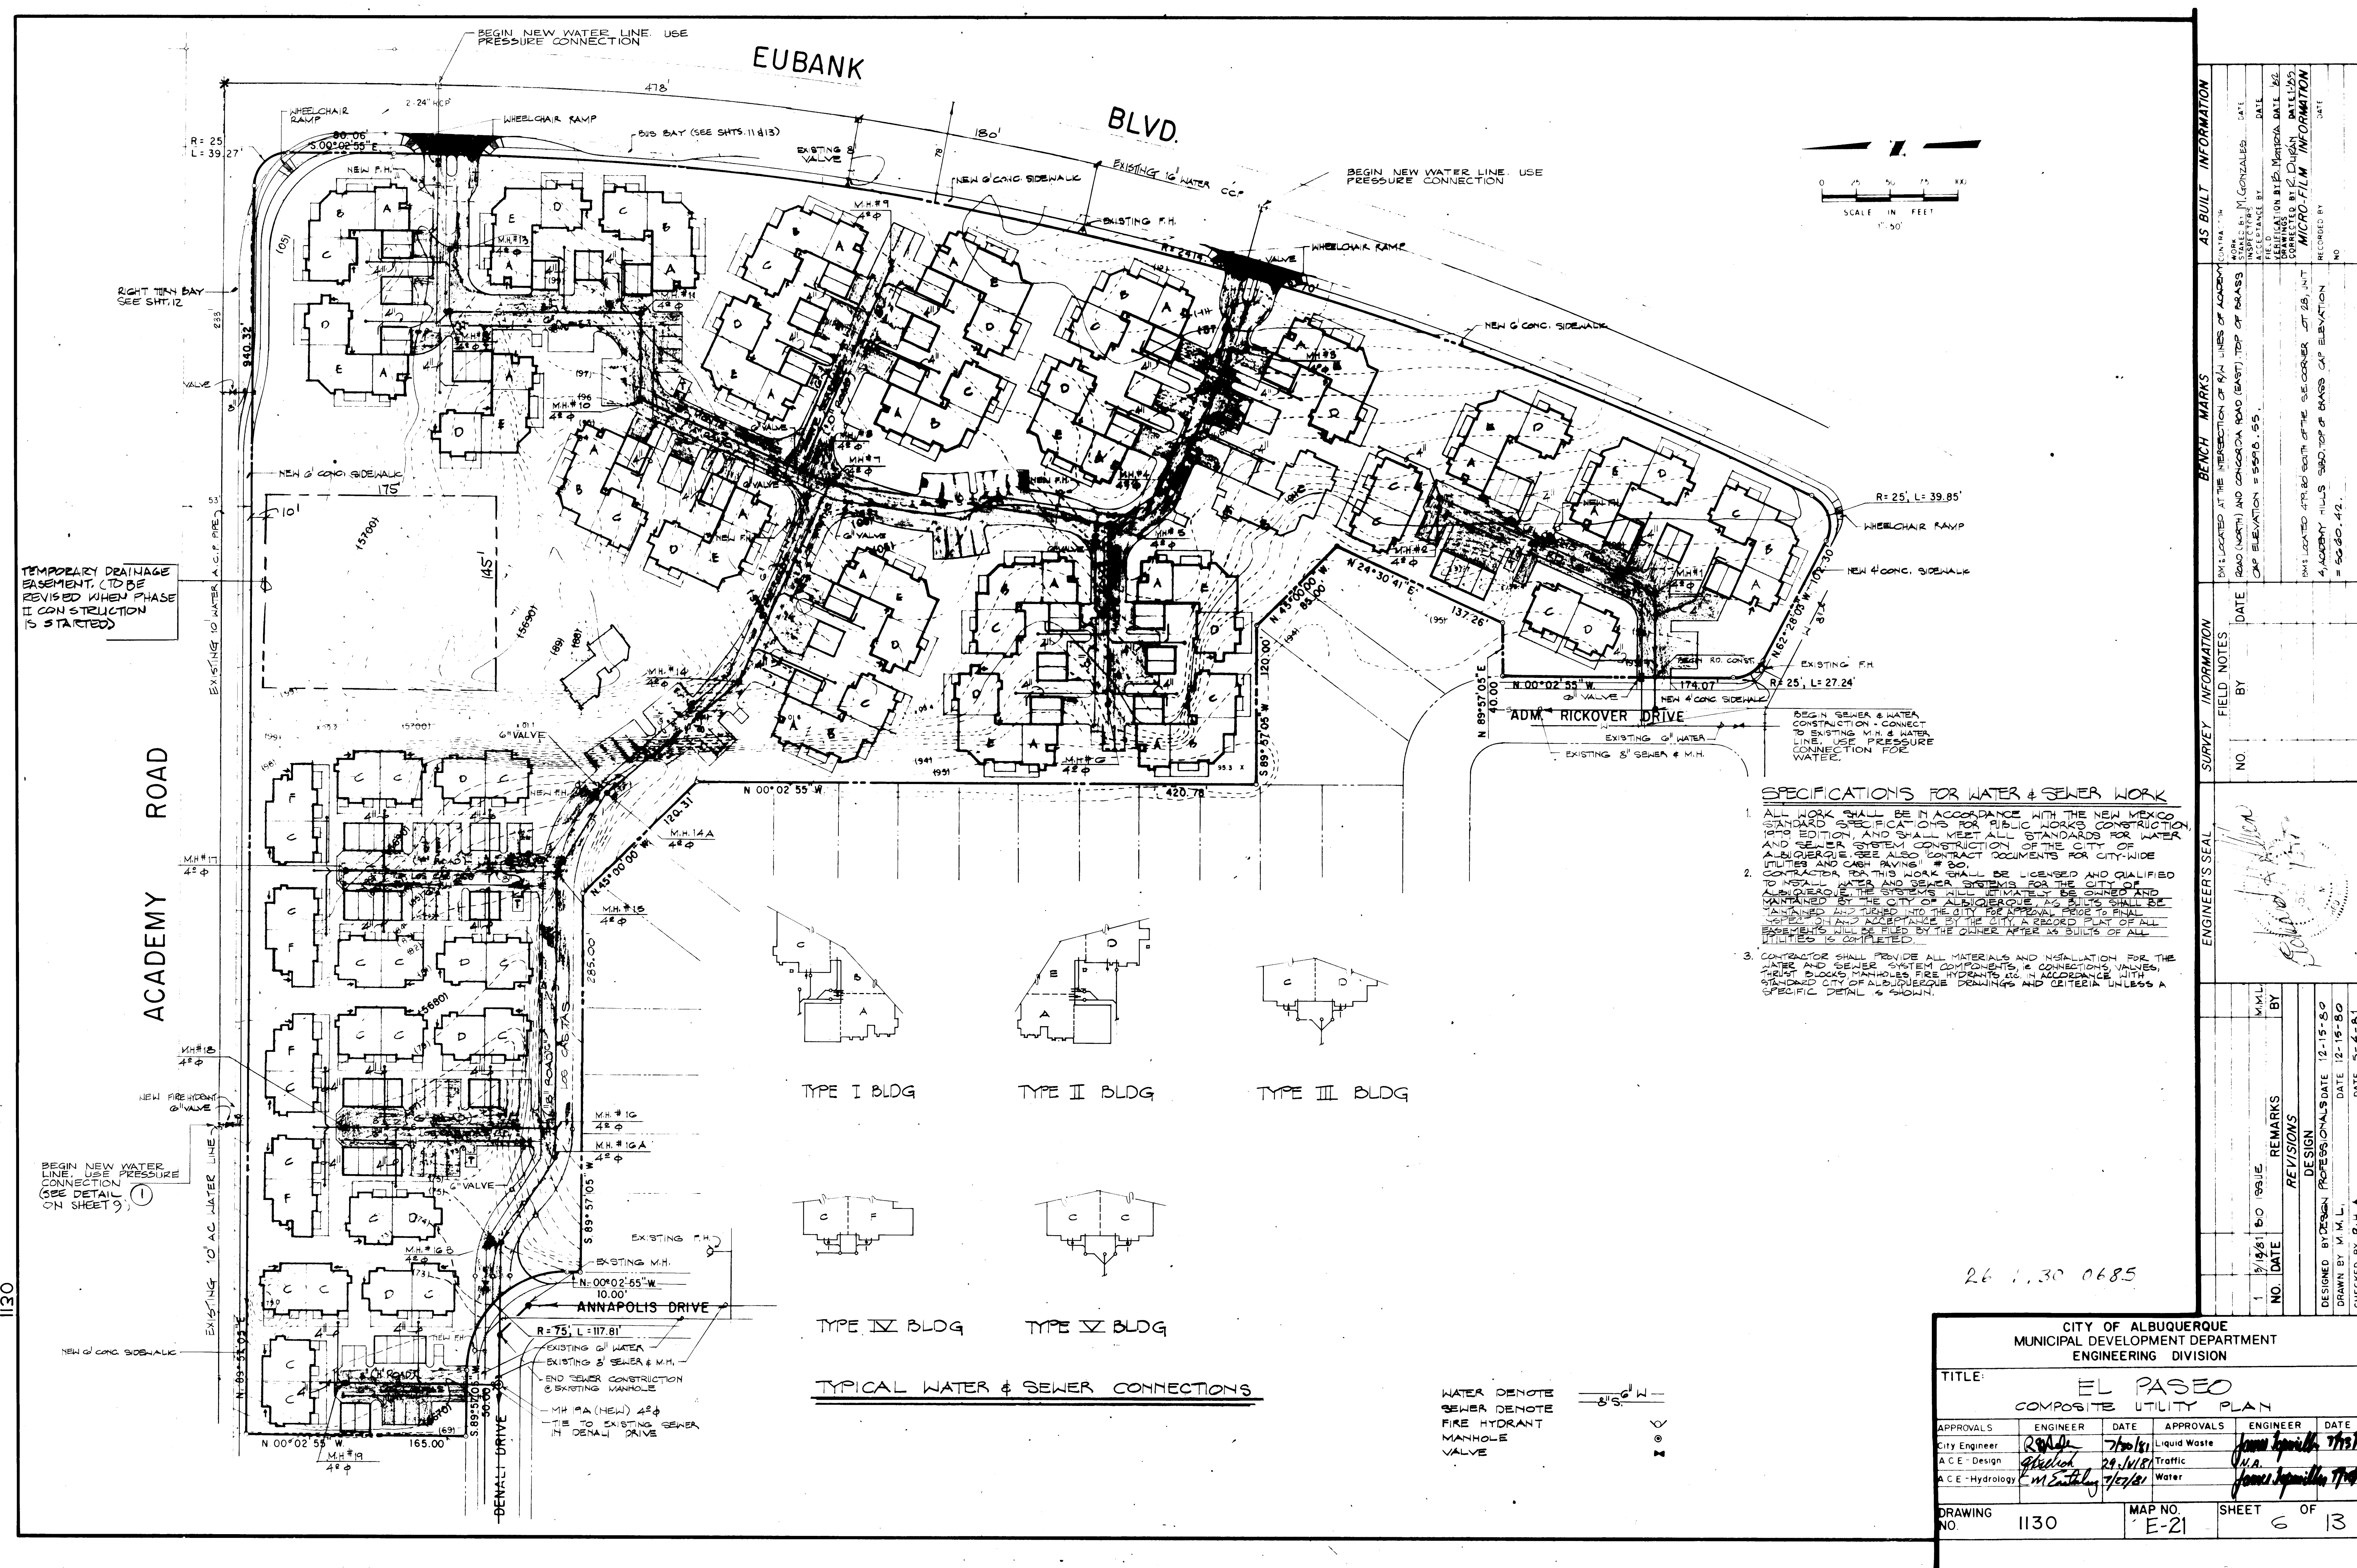

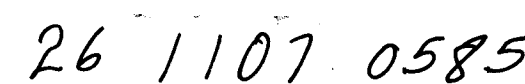

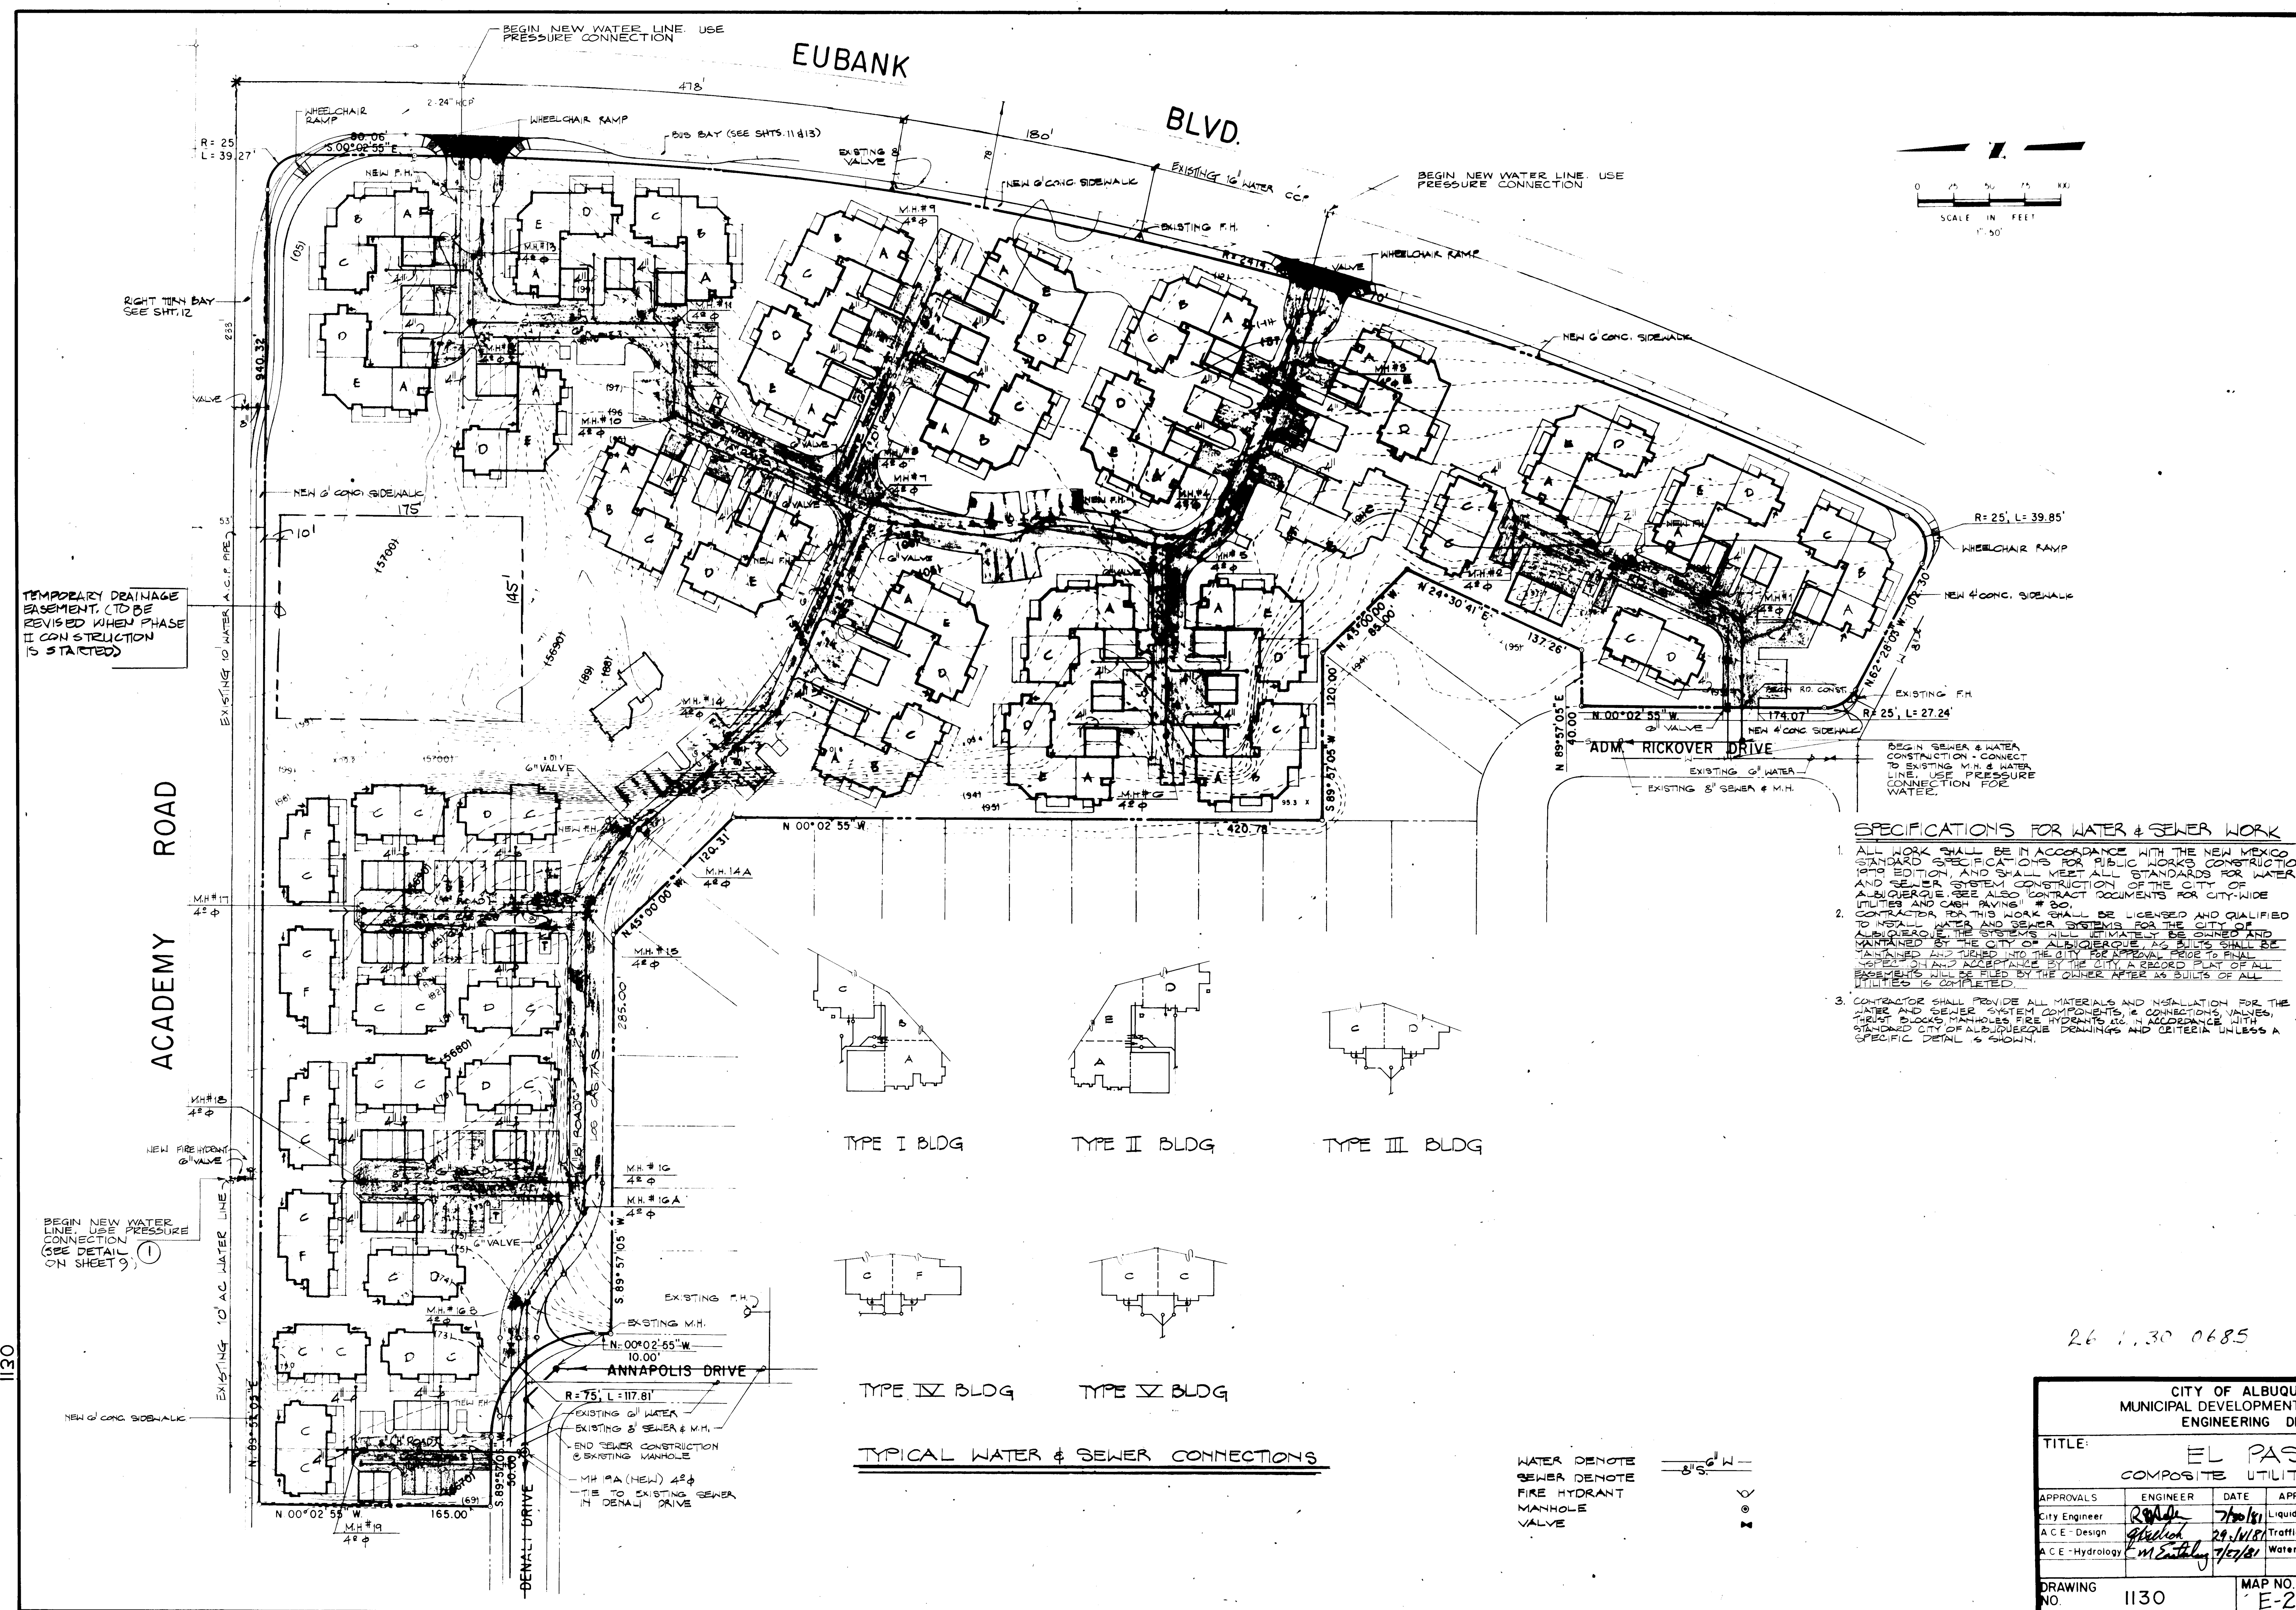

SPECIFICATIONS FOR WATER & SEWER WORK

1. ALL WORK SHALL BE IN ACCORDANCE WITH THE NEW MEXICO STANDARD SPECIFICATIONS FOR PUBLIC WORKS CONSTRUCTION, LATEST EDITION, AND SHALL MEET ALL STANDARDS FOR WATER AND SEWER SYSTEM CONSTRUCTION OF THE CITY OF ALBUQUERQUE. SEE ALSO CONTRACT DOCUMENTS FOR CITY-WIDE UTILITIES AND CASH PAYING. # 80.
2. CONTRACTOR FOR THIS WORK SHALL BE LICENSED AND QUALIFIED TO INSTALL WATER AND SEWER SYSTEMS FOR THE CITY OF ALBUQUERQUE. THE CITY OF ALBUQUERQUE SHALL BE SOLELY RESPONSIBLE FOR THE DESIGN AND CONSTRUCTION OF ALL WORKS. THE CITY OF ALBUQUERQUE SHALL BE SOLELY RESPONSIBLE FOR THE DESIGN AND CONSTRUCTION OF ALL WORKS. THE CITY OF ALBUQUERQUE SHALL BE SOLELY RESPONSIBLE FOR THE DESIGN AND CONSTRUCTION OF ALL WORKS.
3. CONTRACTOR SHALL PROVIDE ALL MATERIALS AND INSTALLATION FOR THE WATER AND SEWER SYSTEM COMPONENTS & CONNECTIONS. VALVES, RIGHT-OF-WAY MANHOLES, FIRE HYDRANTS, AND MANHOLES WITH RADIOMETER CITY OF ALBUQUERQUE DRAWINGS AND CRITERIA UNLESS A SPECIFIC DETAIL IS SHOWN.

TYPE I BLDG TYPE II BLDG TYPE III BLDG

TYPE IV BLDG TYPE V BLDG


TYPICAL WATER & SEWER CONNECTIONS

WATER DENOTE
SEWER DENOTE
FIRE HYDRANT
MANHOLE
VALVE

26 1.30 0685

CITY OF ALBUQUERQUE MUNICIPAL DEVELOPMENT DEPARTMENT ENGINEERING DIVISION	
TITLE: EL PASO COMPOSITE UTILITY PLAN	
APPROVALS	ENGINEER
City Engineer	2/24/81
A.C.E. Design	2/24/81
A.C.E. Hydrology	2/24/81
APPROVALS	ENGINEER
City Engineer	2/24/81
A.C.E. Design	2/24/81
A.C.E. Hydrology	2/24/81
DRAWING NO.	1130
MAP NO.	E-21
SHEET	6
OF	13

1130

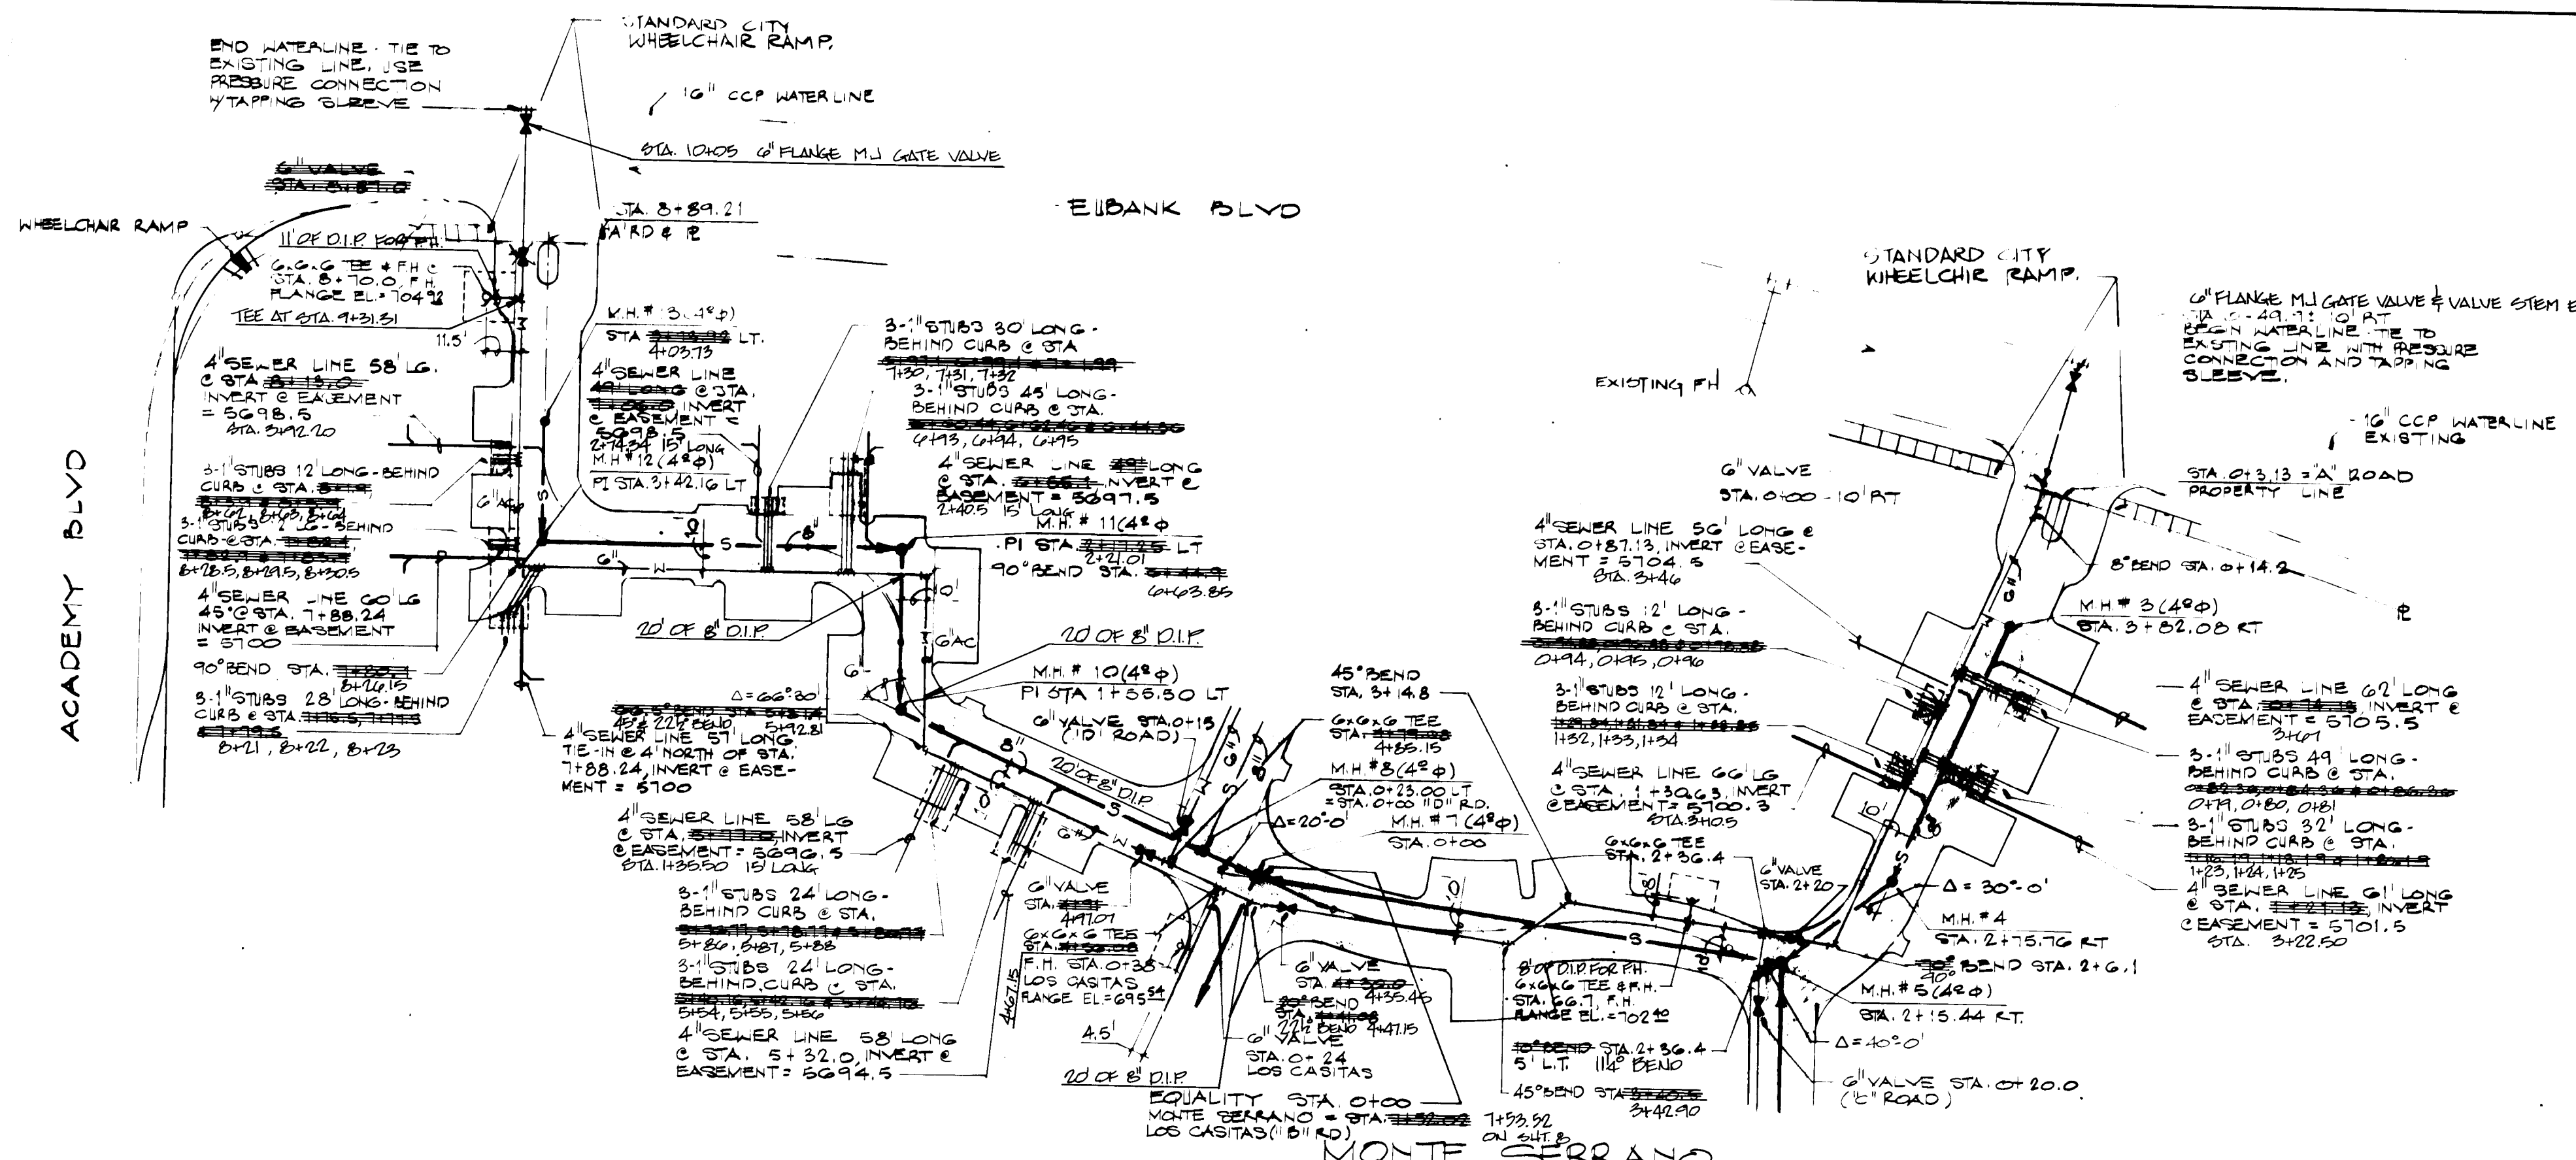


NOTE:
METER BOXES TO BE INSTALLED
BEHIND CURB FOR ALL WATER
SERVICE LINES

- GENERAL NOTES:**
1. UNLESS OTHERWISE SPECIFIED, ALL PIPES SHALL BE 15' MIN. DEPTH TO MIN. 10' MIN. DEPTH FOR 12" PIPE. ALL PIPES SHALL BE 15' MIN. DEPTH TO MIN. 10' MIN. DEPTH FOR 12" PIPE.
 2. ALL JUNCTIONS AND CAPS SHALL BE BLOCKED OFF WITH 12" MIN. DEPTH TO MIN. 10' MIN. DEPTH FOR 12" PIPE.
 3. SEE SHEET #10 FOR WATER METER BOX INFORMATION AND FOR WATER SERVICE LINE DEPTHS AT EASEMENT LINES.
 4. [] SHADDED AREAS DENOTE CITY OF ALBUQUERQUE UTILITY EASEMENTS.
 5. SEE SHEET #10 FOR DIMENSIONS FOR FIRE HYDRANT AND WATER METER BOX EASEMENTS.
 6. DIMENSIONS SHOWN FOR FIRE HYDRANTS ARE FROM C. OF WATER LINE TO C. OF P.H. (NOMINALLY 1'-6" B.C. OF CURB TO C. P.H.)

26 1130 0785



SCALE
HORIZ. = 1" = 50'
VERT. = 1" = 10'

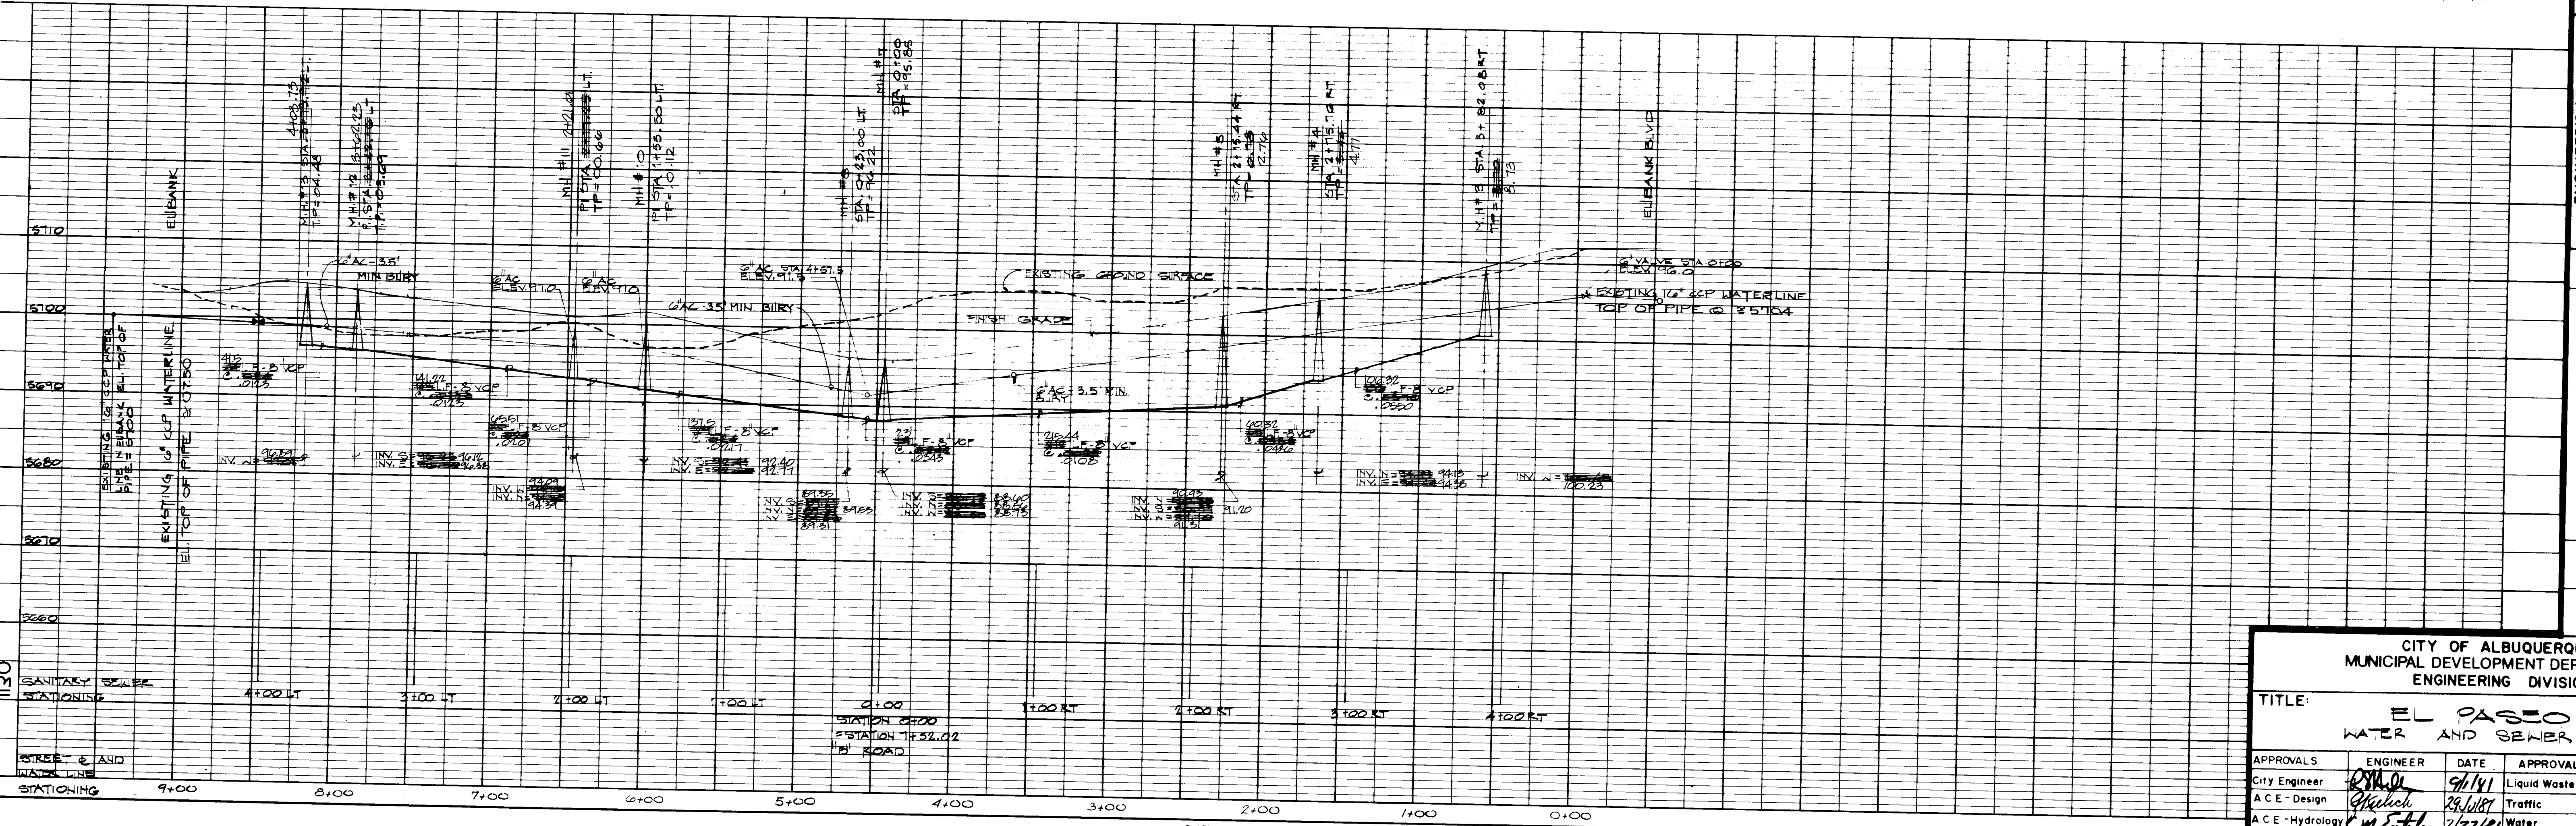

AS BUILT INFORMATION			BENCH MARKS			SURVEY INFORMATION			ENGINEER'S SEAL		
CONTRACTOR	DATE	BY	DATE	BY	NO.	DATE	BY	NO.	DATE	BY	REMARKS
CONTRACTOR	DATE	BY	DATE	BY	NO.	DATE	BY	NO.	DATE	BY	REMARKS
CONTRACTOR	DATE	BY	DATE	BY	NO.	DATE	BY	NO.	DATE	BY	REMARKS

CITY OF ALBUQUERQUE MUNICIPAL DEVELOPMENT DEPARTMENT ENGINEERING DIVISION					
TITLE: EL PASO WATER AND SEWER PLANS					
APPROVALS	ENGINEER	DATE	APPROVALS	ENGINEER	DATE
City Engineer	[Signature]	9/1/81	Liquid Waste	[Signature]	9/1/81
ACE - Design	[Signature]	8/2/81	Traffic	[Signature]	8/2/81
ACE - Hydrology	[Signature]	7/27/81	Water	[Signature]	7/27/81

DRAWING NO.	MAP NO.	SHEET	OF
1130			

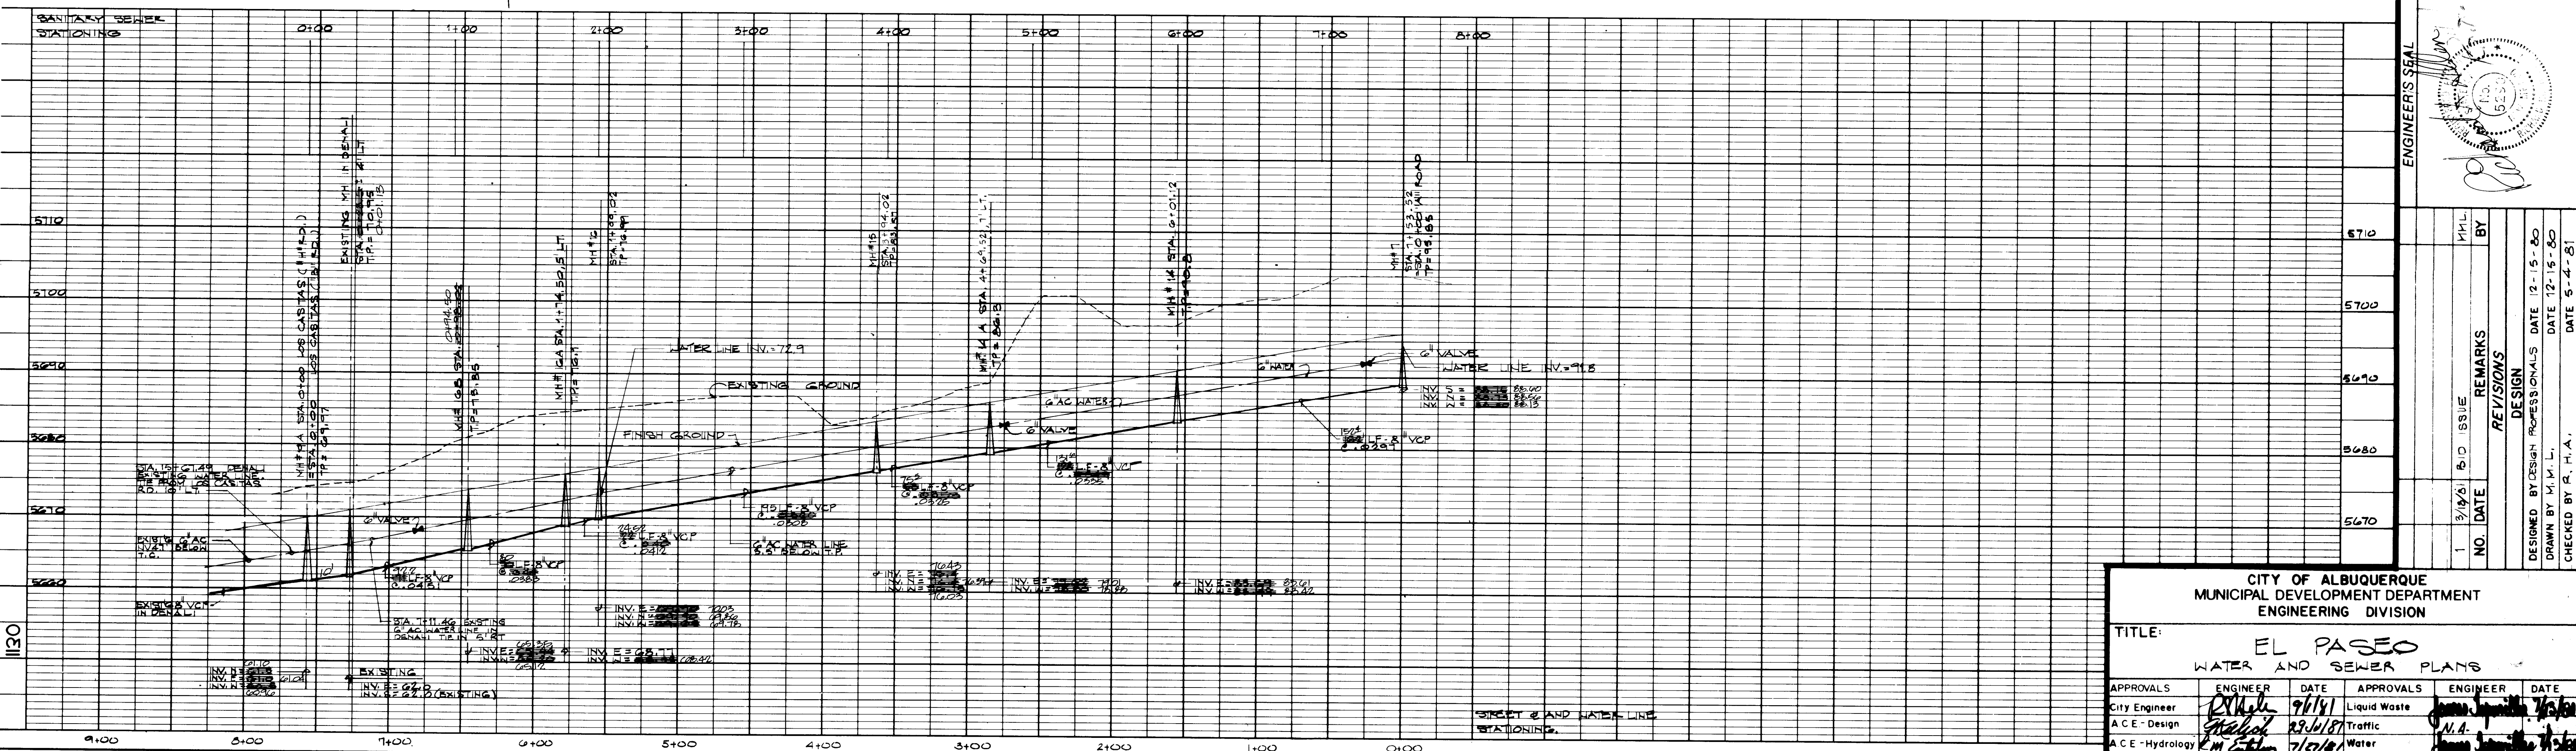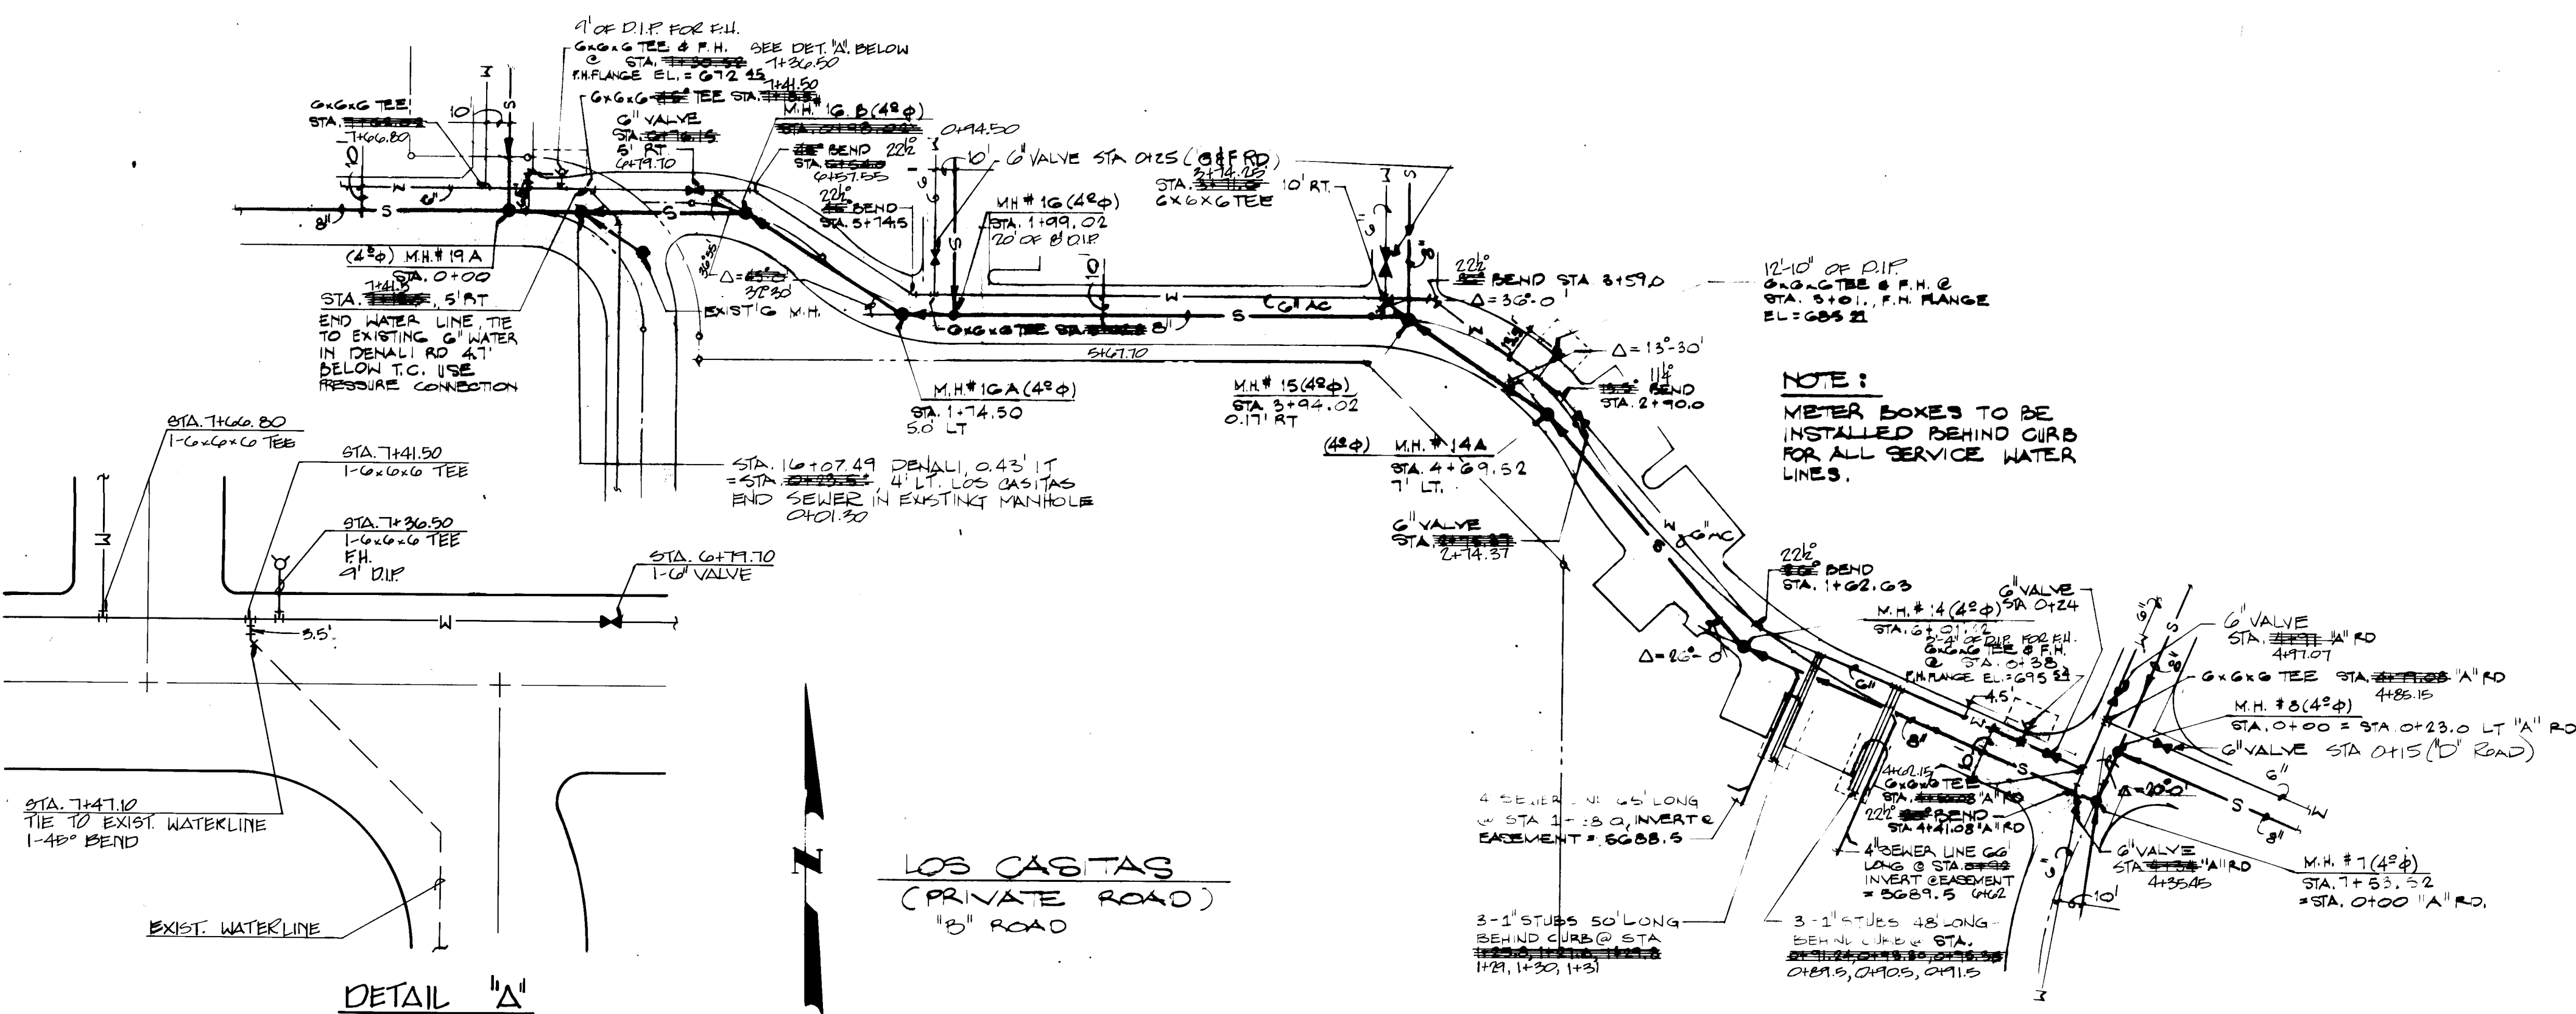


CITY OF ALBUQUERQUE
MUNICIPAL DEVELOPMENT DEPARTMENT
ENGINEERING DIVISION

TITLE:
EL PASEO
WATER AND SEWER PLANS



APPROVALS	ENGINEER	DATE	APPROVALS	ENGINEER	DATE
City Engineer	<i>[Signature]</i>	7/1/81	Liquid Waste	<i>[Signature]</i>	7/1/81
A.C.E. Design	<i>[Signature]</i>	7/1/81	Traffic	<i>[Signature]</i>	7/1/81
A.C.E. Hydrology	<i>[Signature]</i>	7/1/81	Water	<i>[Signature]</i>	7/1/81


DRAWING NO. 1130 **MAP NO.** E-21 **SHEET** 8 **OF** 13

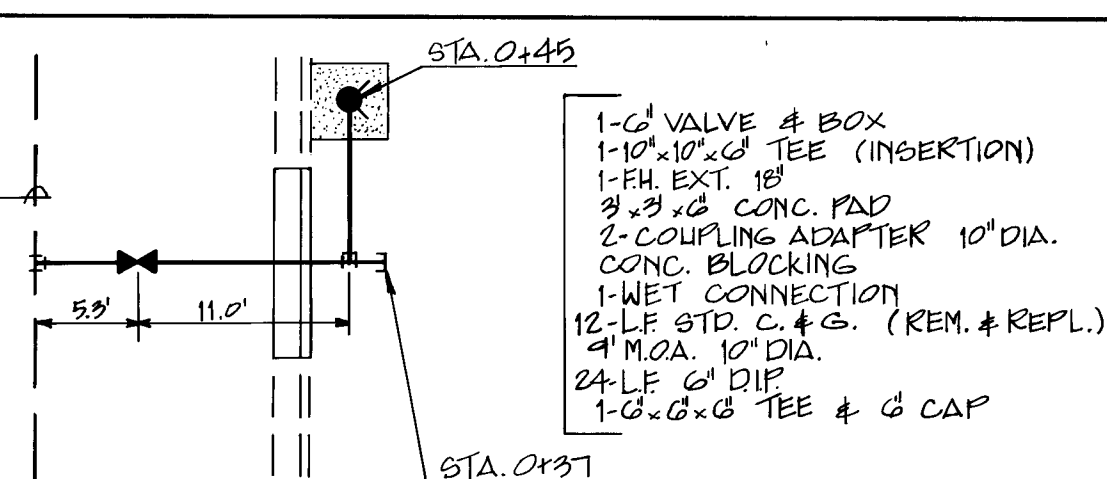

1. USE TYPE "C" MANHOLE FOR DEPTHS OF LESS THAN SIX FEET. WHEN INVERT TO RIM, CONTRACTOR MAY CONSTRUCT TYPE "C" WITHIN SIX FEET OF SURFACE. FOR DEPTHS OF MORE THAN SIX FEET OR MORE, A ALL M.H. TO BE 4' O.D. 1' D.
2. ALL TEST DEPTHS AND C.P.S. SHALL BE BLOCKED ACCORDING TO CURRENT CITY OF ALBUQUERQUE STANDARDS. SEE SHEET #10 FOR DETAILS.
3. SEE SHEET #10 FOR FIRE HYDRANT DETAILS AND TYPICAL WATER SERVICE PIPAL DETAILS.
4.  SHADED AREAS DENOTE CITY OF ALBUQUERQUE UTILITY BASEMENTS.
5. SEE SHEET #10 FOR WATER METER BOX INFORMATION AND FOR WATER SERVICE LINE DEPTHS AT BASEMENT LINES.

G. SEE SHEET #10 FOR DIMENSIONS FOR FIRE HYDRANT AND METER BOX EASEMENTS.

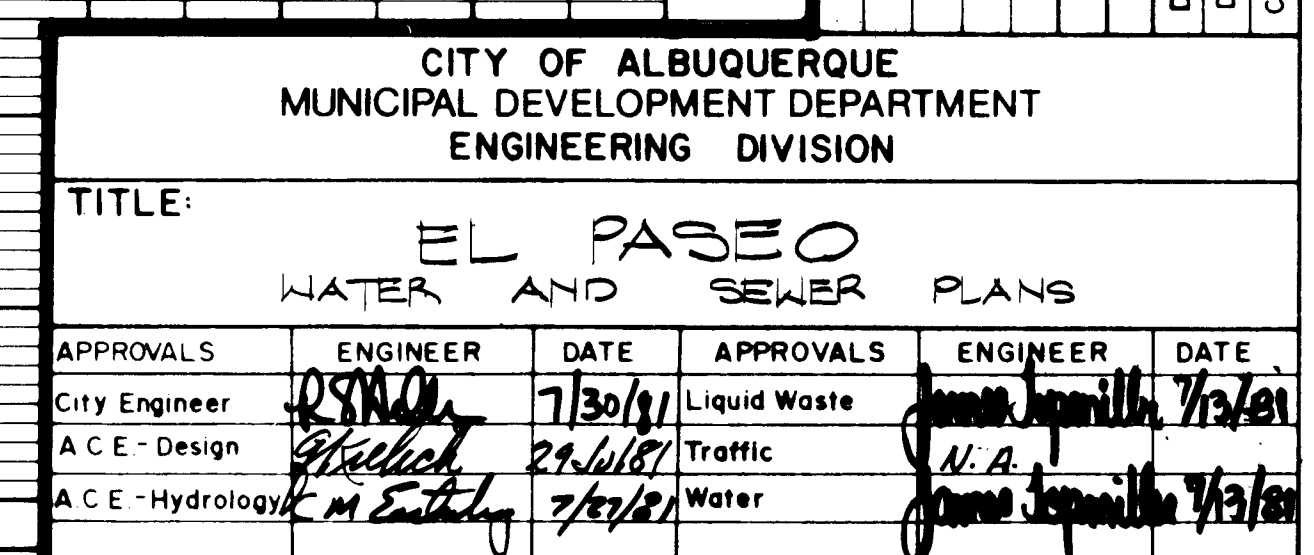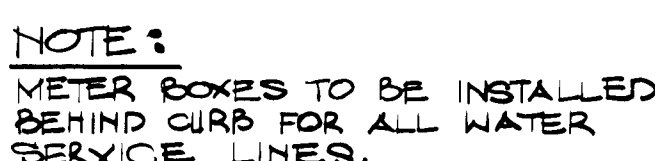

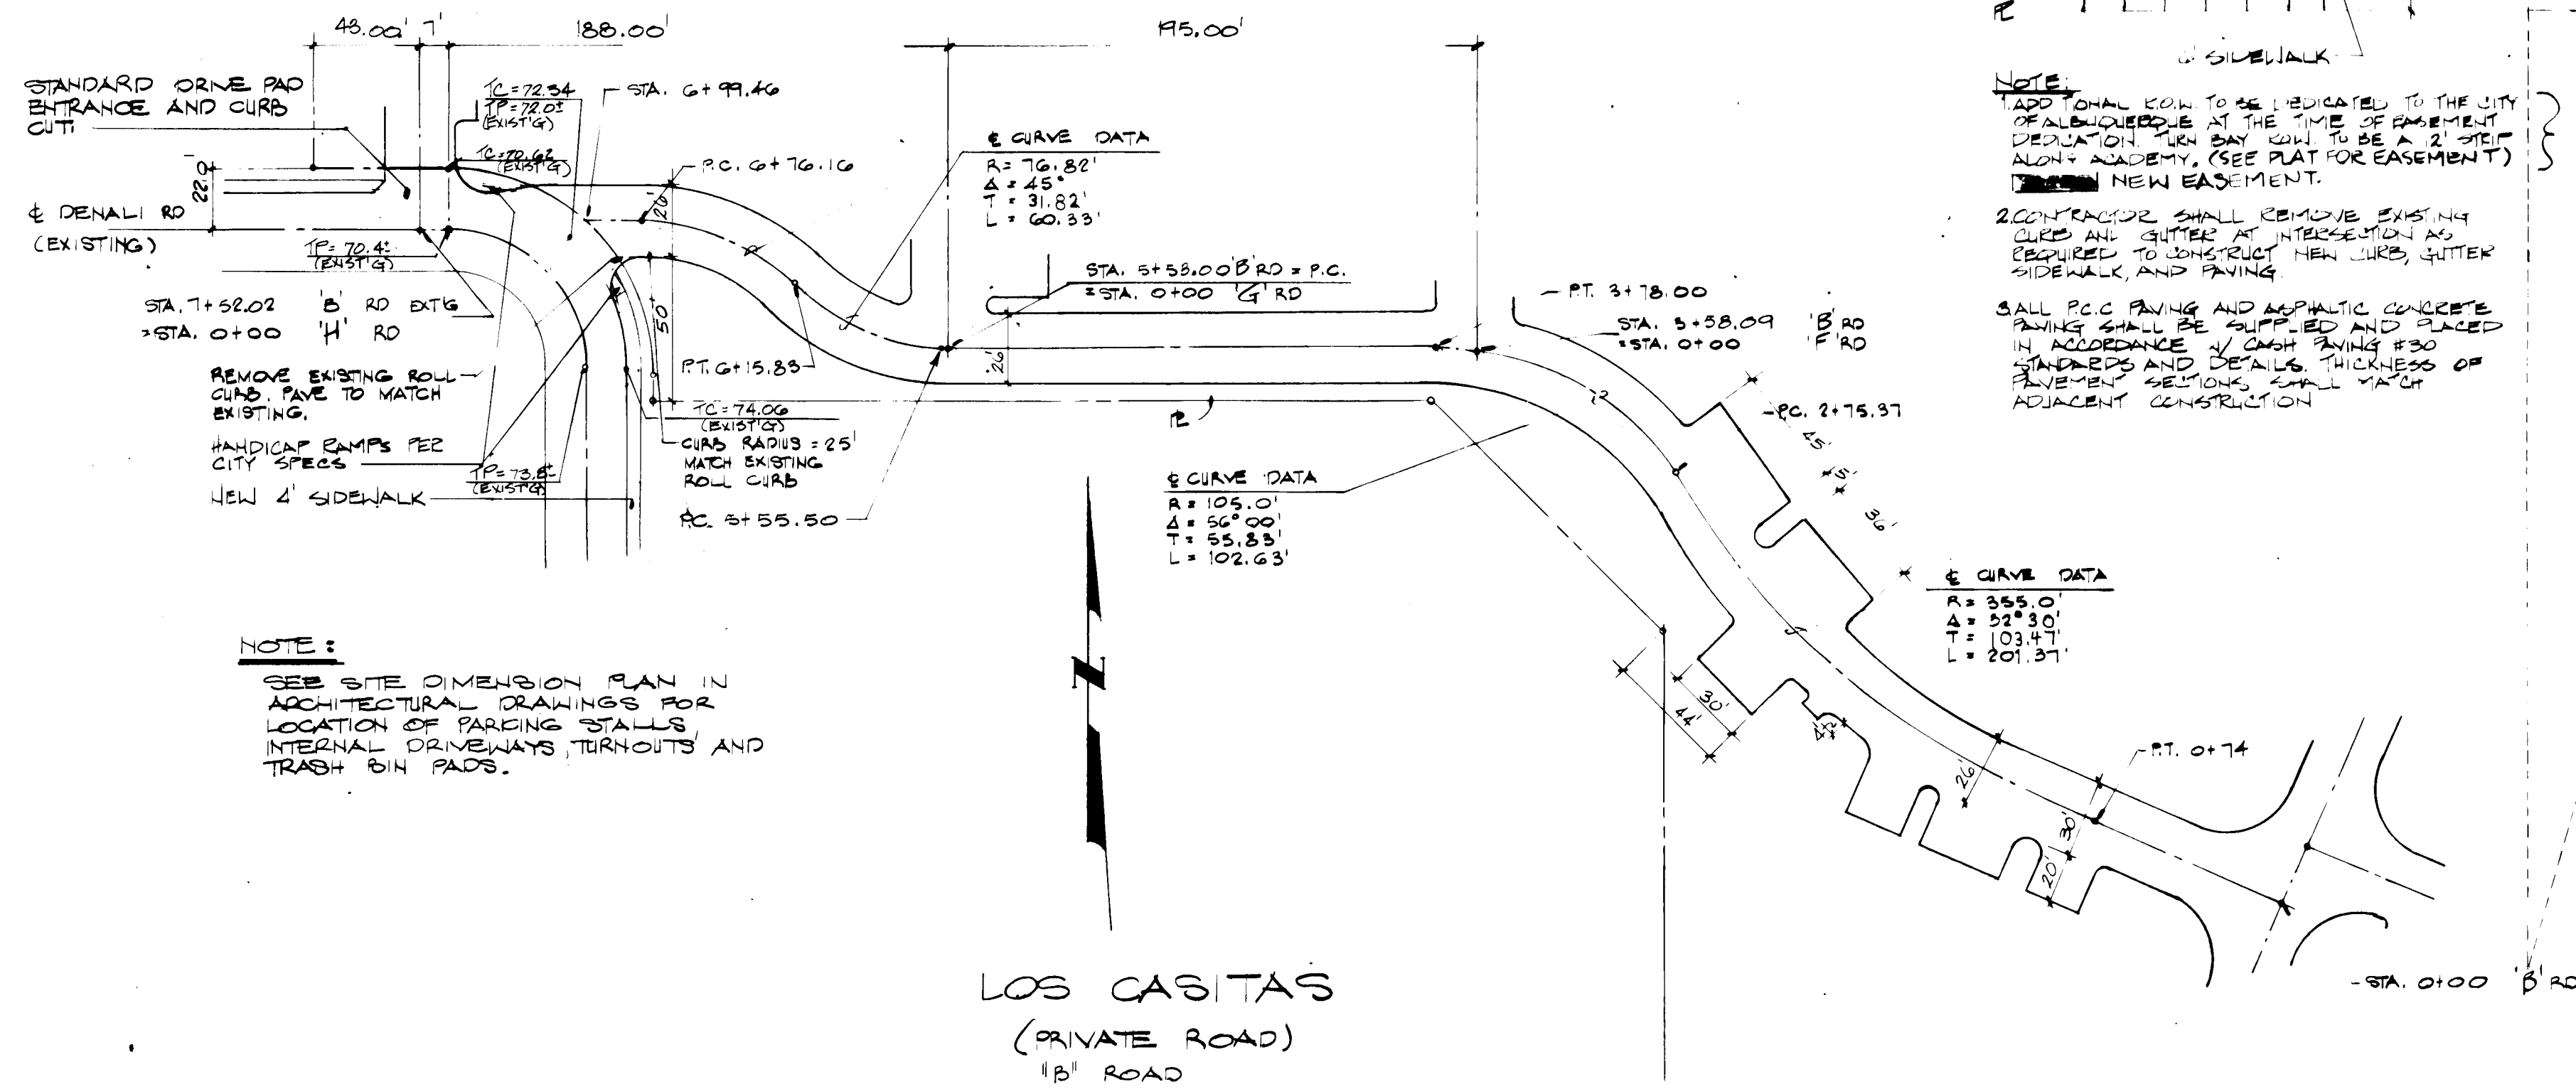

NO	Δ	R	T	L
1	16° 15' 37"	150'	21.43'	42.57'
2	18° 30'	180'	29.34'	56.12'
3	55°	58.07'	18.95'	53.72'
4	90°	25'	25'	57.27'

SCALE:
HORIZ: 1"=50'
VERT: 1"=10'

RIGHT TURN BAY - ACADEMY

26 1130 1285

FIELD VERIFY STATIONING AND ELEVATION USE DEPRESSURED CURB & GUTTER FROM P.C. ON EUBANK TO STA 25+62.17




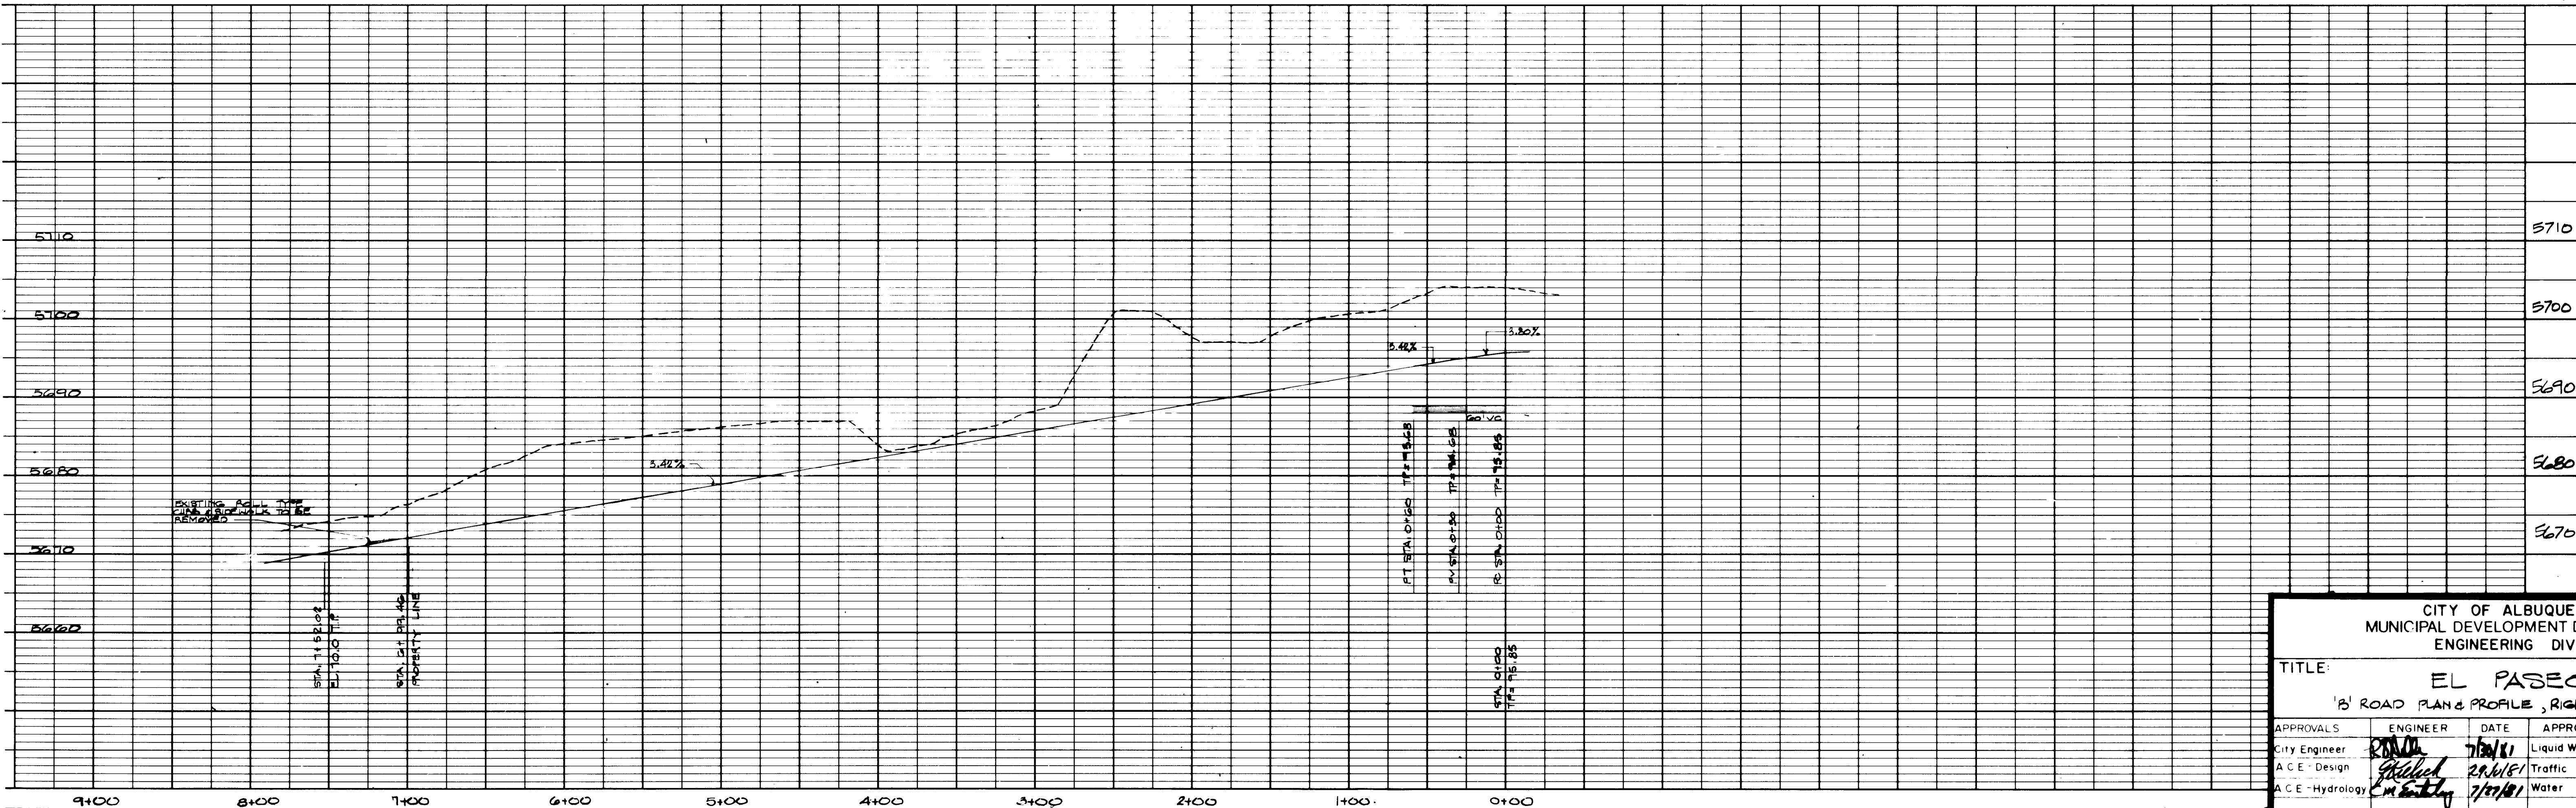


PLATE 1 PLAN PROFILE O. P. R. & E. STANDARD
EUGENE DIEZGEN CO.

CITY OF ALBUQUERQUE MUNICIPAL DEVELOPMENT DEPARTMENT ENGINEERING DIVISION					
TITLE: EL PASEO B' ROAD PLAN & PROFILE, RIGHT TURN BAY & SECTION.					
APPROVALS	ENGINEER	DATE	APPROVALS	ENGINEER	DATE
City Engineer	<i>[Signature]</i>	7/11/81	Liquid Waste	<i>[Signature]</i>	7/11/81
A.C.E. Design	<i>[Signature]</i>	7/11/81	Traffic	<i>[Signature]</i>	7/11/81
A.C.E. Hydrology	<i>[Signature]</i>	7/11/81	Water	<i>[Signature]</i>	7/11/81
DRAWING NO. 1130		MAP NO. E-21		SHEET 12 OF 13	

AS BUILT INFORMATION		BENCH MARKS		SURVEY INFORMATION	
DATE	DATE	DATE	DATE	DATE	DATE
BY	BY	BY	BY	BY	BY
NO.	NO.	NO.	NO.	NO.	NO.
BY: LOCATED AT THE INTERSECTION OF BAY LINES OF ACADEMY ROAD (NORTH) AND CONCORDIA ROAD (EAST). TOP OF BRASS CAP ELEVATION = 5698.15.		BY: LOCATED AT THE INTERSECTION OF BAY LINES OF ACADEMY ROAD (NORTH) AND CONCORDIA ROAD (EAST). TOP OF BRASS CAP ELEVATION = 5698.15.		BY: LOCATED AT THE INTERSECTION OF BAY LINES OF ACADEMY ROAD (NORTH) AND CONCORDIA ROAD (EAST). TOP OF BRASS CAP ELEVATION = 5698.15.	
BY: LOCATED AT THE INTERSECTION OF BAY LINES OF ACADEMY ROAD (NORTH) AND CONCORDIA ROAD (EAST). TOP OF BRASS CAP ELEVATION = 5698.15.		BY: LOCATED AT THE INTERSECTION OF BAY LINES OF ACADEMY ROAD (NORTH) AND CONCORDIA ROAD (EAST). TOP OF BRASS CAP ELEVATION = 5698.15.		BY: LOCATED AT THE INTERSECTION OF BAY LINES OF ACADEMY ROAD (NORTH) AND CONCORDIA ROAD (EAST). TOP OF BRASS CAP ELEVATION = 5698.15.	

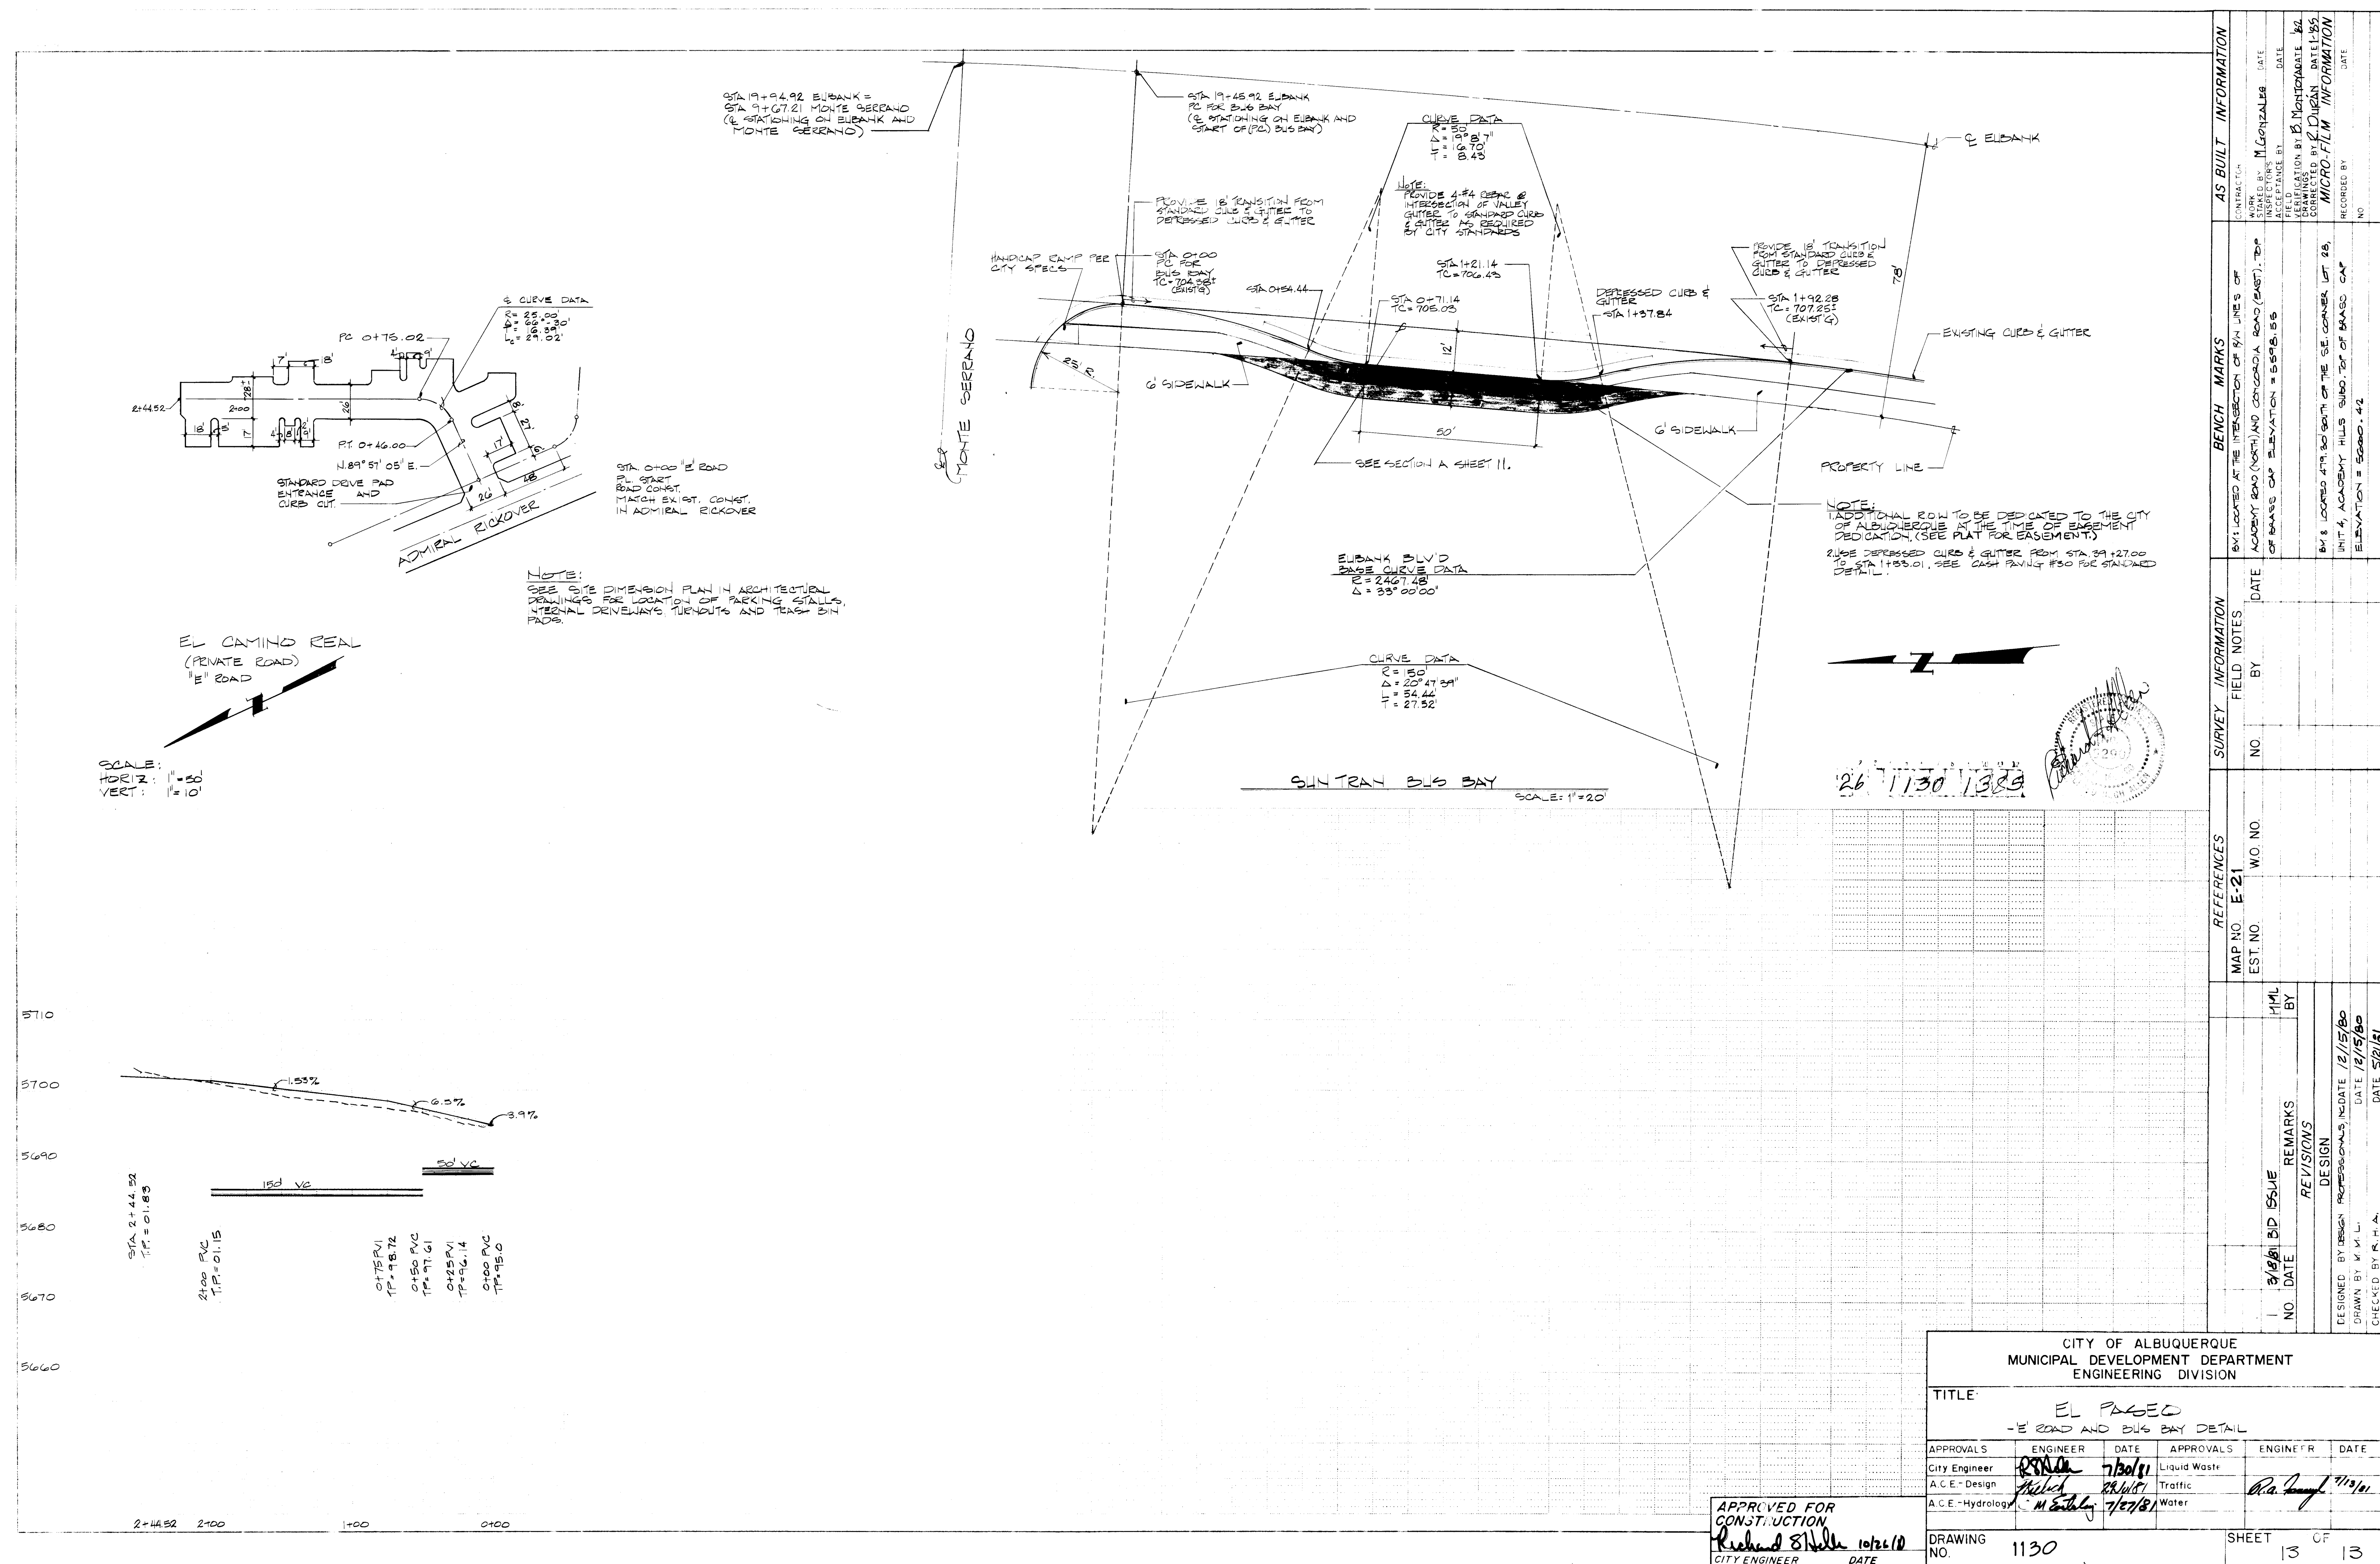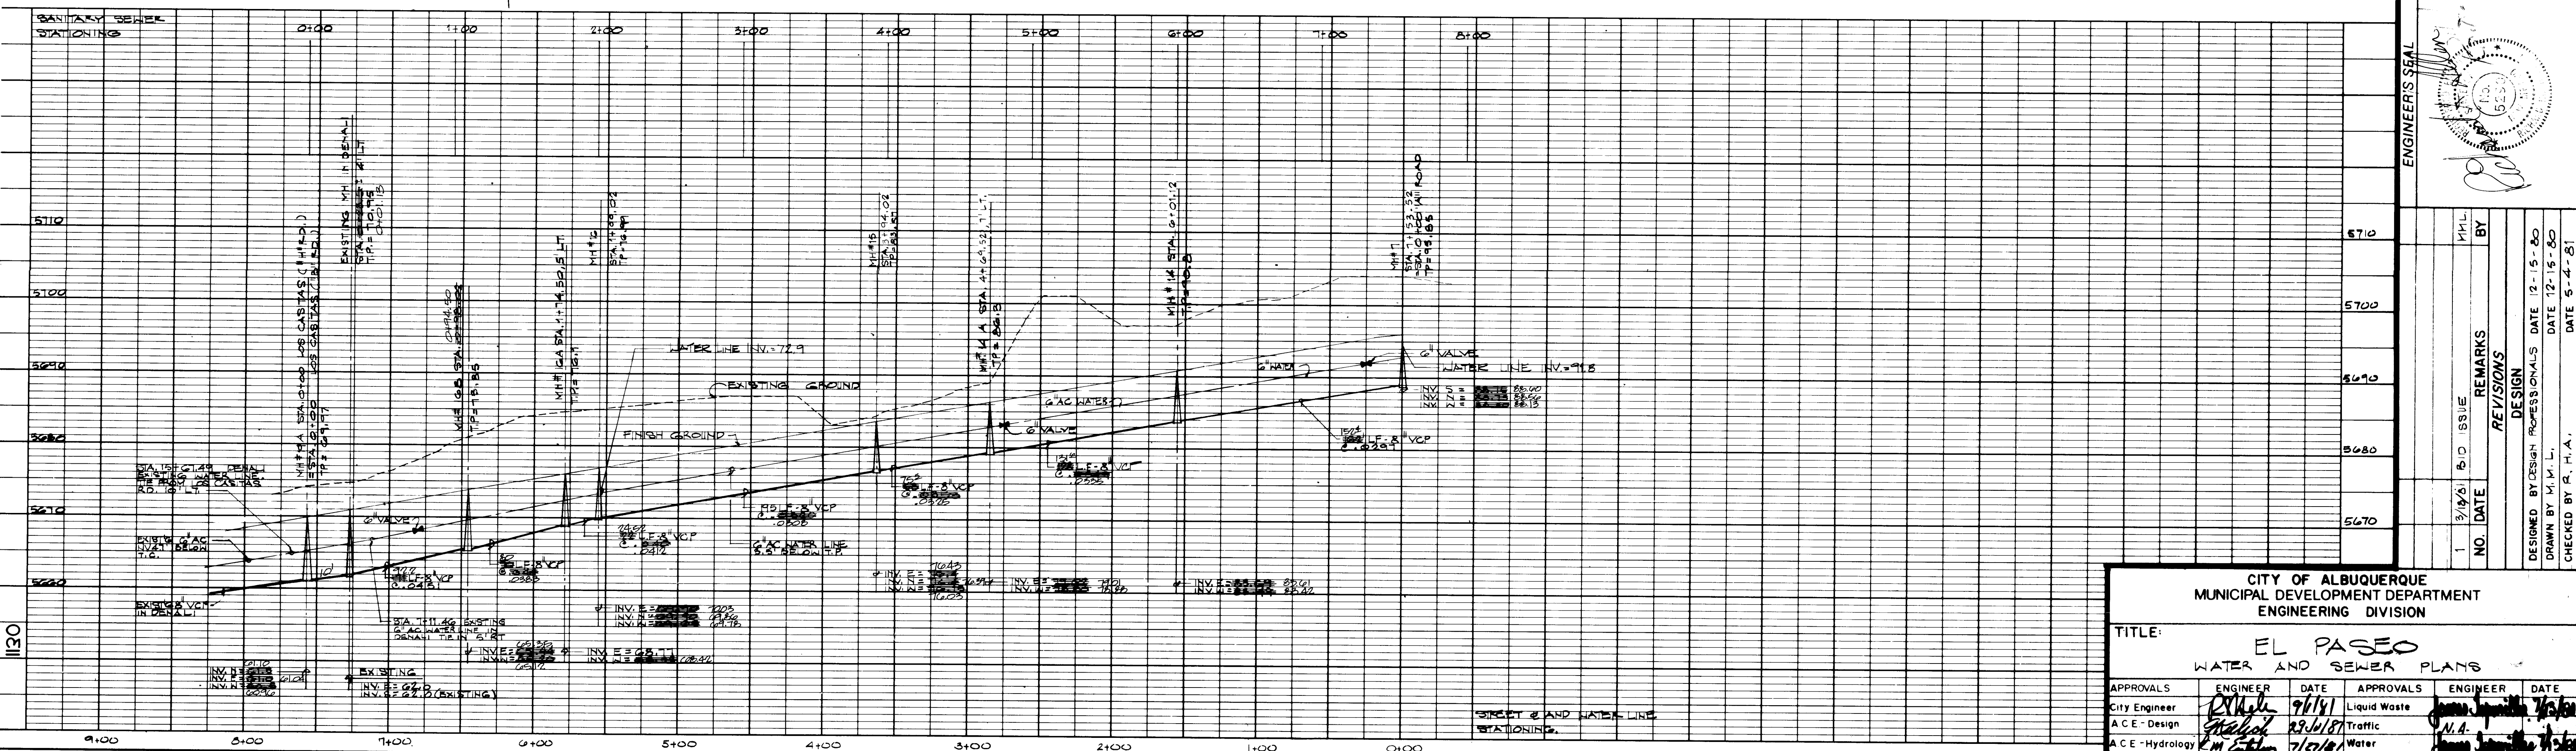

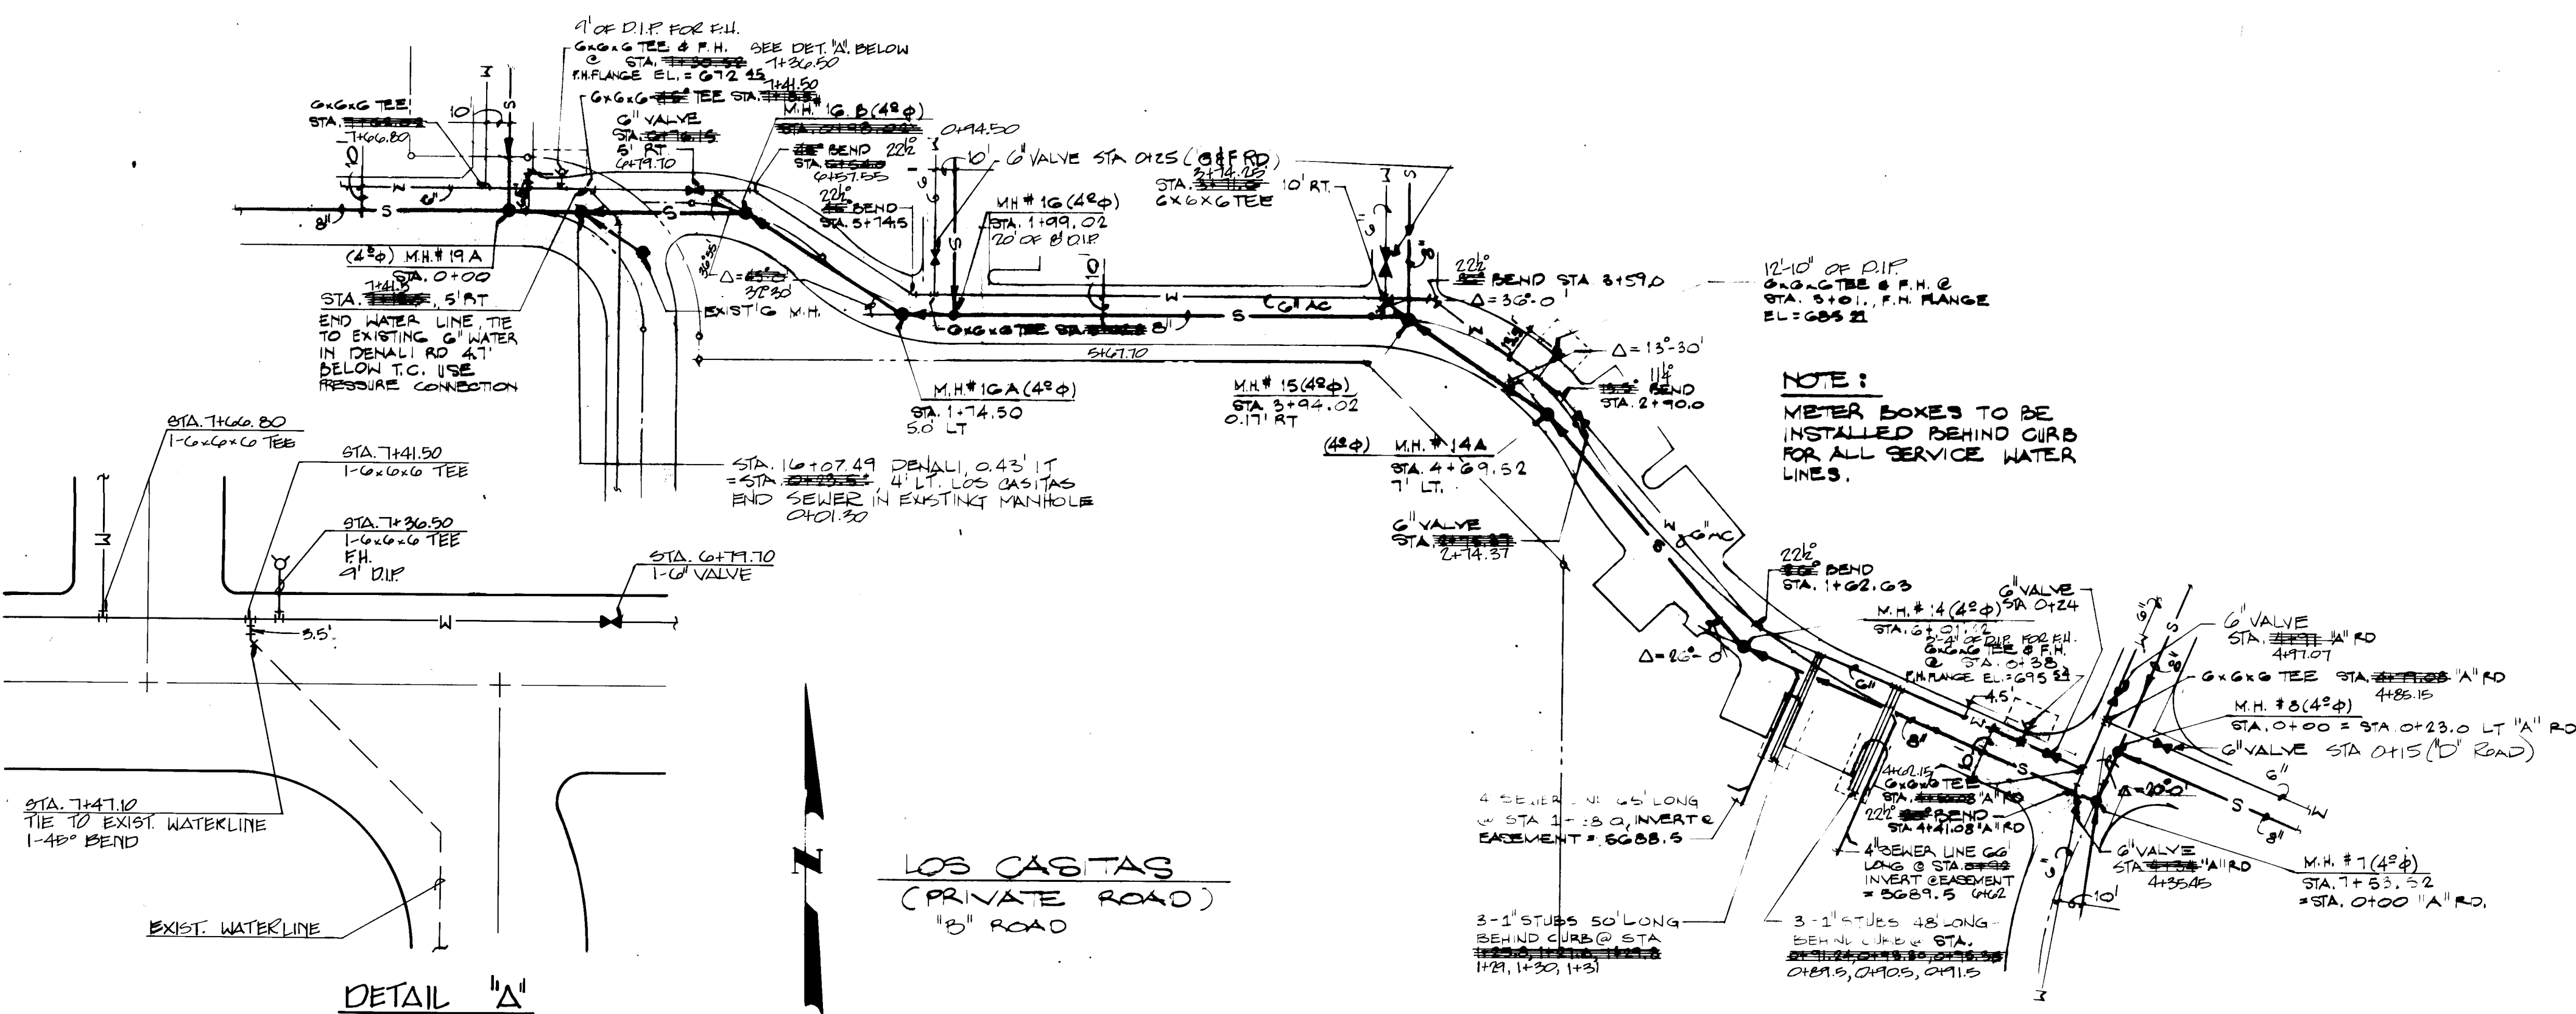



CITY OF ALBUQUERQUE
MUNICIPAL DEVELOPMENT DEPARTMENT
ENGINEERING DIVISION

TITLE:
EL PASEO
WATER AND SEWER PLANS



APPROVALS	ENGINEER	DATE	APPROVALS	ENGINEER	DATE
City Engineer	<i>[Signature]</i>	7/1/81	Liquid Waste	<i>[Signature]</i>	7/1/81
A.C.E. Design	<i>[Signature]</i>	7/1/81	Traffic	<i>[Signature]</i>	7/1/81
A.C.E. Hydrology	<i>[Signature]</i>	7/1/81	Water	<i>[Signature]</i>	7/1/81

 DRAWING NO. 1130 **MAP NO.** E-21 **SHEET** 8 **OF** 13

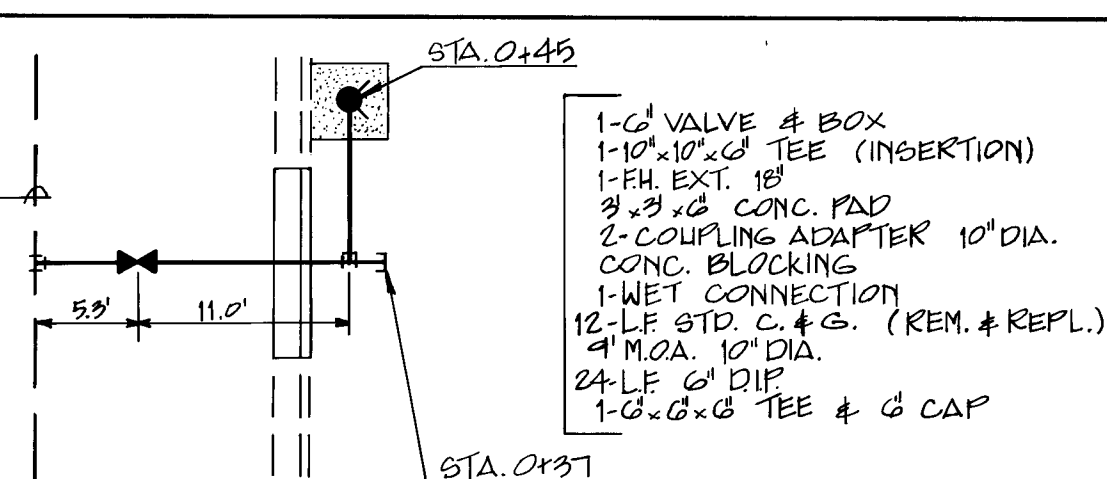


1. USE TYPE "C" MANHOLE FOR DEPTHS OF LESS THAN SIX FEET. WHEN INVERT TO RIM, CONTRACTOR MAY CONSTRUCT TYPE "C" WITHIN 4' OF MANHOLE. FOR DEPTHS OF MORE THAN SIX FEET OR MORE, A ALL M.H. TO BE 4' O.D. 4' I.D.
2. ALL TIES AND JOINTS AND CAPS SHALL BE BLOCKED ACCORDING TO CURRENT CITY OF ALBUQUERQUE STANDARDS. SEE SHEET #10 FOR DETAILS.
3. SEE SHEET #10 FOR FRIE HYDRANT DETAILS AND TYPICAL WATER SERVICE PIPAL DETAILS.
4.  SHADDED AREAS DENOTE CITY OF ALBUQUERQUE UTILITY BASEMENTS.
5. SEE SHEET #10 FOR WATER METER BOX INFORMATION AND FOR WATER SERVICE LINE DEPTHS AT BASEMENT LINES.

G. SEE SHEET #10 FOR DIMENSIONS FOR FIRE HYDRANT AND METER BOX EASEMENTS.

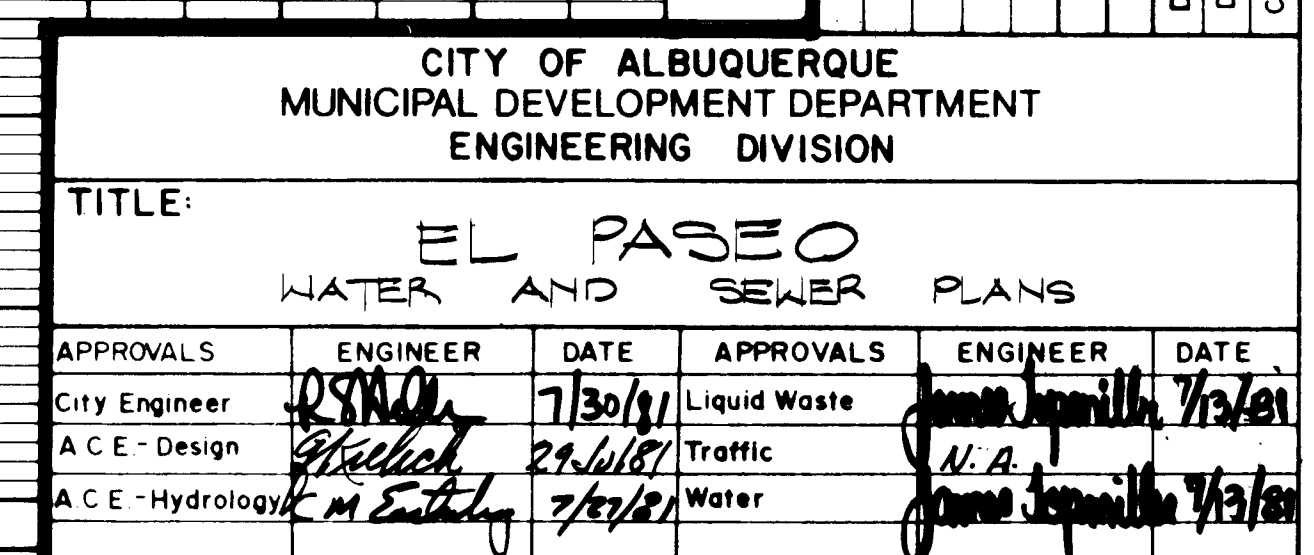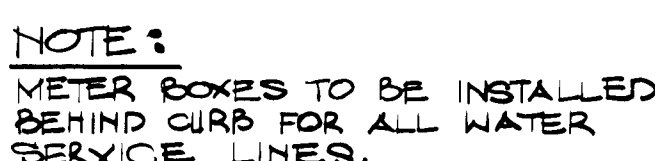

EL PASEO
TOWN HOUSES
GRUPE DEVELOPMENT COMPANY

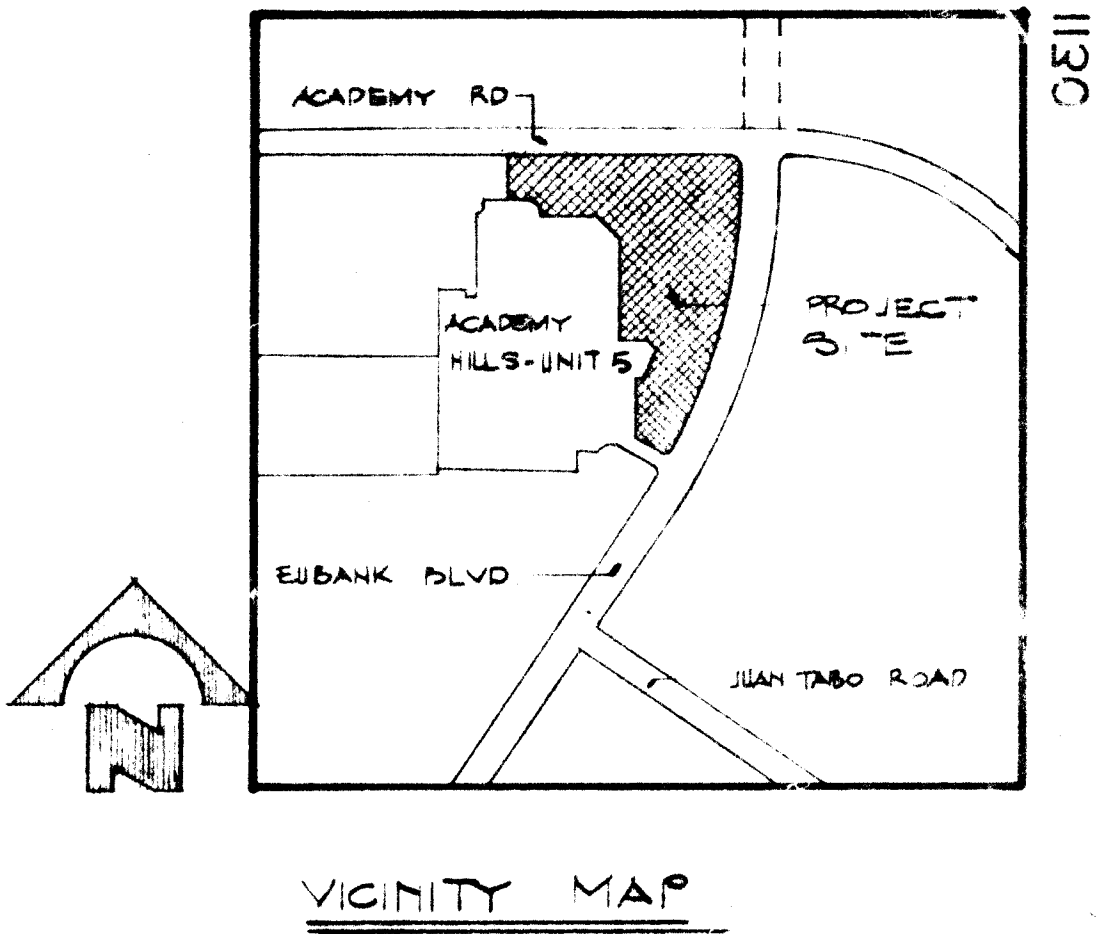

- NOTICE TO CONTRACTORS
1. NEW MEXICO STANDARD SPECIFICATIONS FOR HIGHWAY CONSTRUCTION, 1983 EDITION, SHALL BE REFERRED TO HEREON AS THE STANDARD SPECIFICATION.
 2. ALL WORK DETAIL ON THESE PLANS TO BE PERFORMED UNDER CONTRACT SHALL EXCEPT AS OTHERWISE STATED OR PROVIDED HEREIN, BE CONSTRUCTED IN ACCORDANCE WITH CONTRACT DOCUMENTS FOR CITY, STATE, AND CASH PAYING NO BID AND THE STANDARD SPECIFICATION.
 3. THE AGENCE OUVRE PRIOR TO ANY EXCAVATION CONTRACTOR MUST CONTACT THE LOCAL OFFICE OF THE CITY ENGINEER FOR LOCATION OF EXISTING UTILITIES.
 4. PRIOR TO CONSTRUCTION THE CONTRACTOR SHALL EXCAVATE AND VERIFY THE HORIZONTAL AND VERTICAL LOCATIONS OF ALL UTILITIES. SHOULD A CONFLICT EXIST THE CONTRACTOR SHALL NOTIFY THE ENGINEER OR OWNER SO THAT THE CONFLICT CAN BE RESOLVED WITH MINIMUM AMOUNT OF DELAY.

- THE FOLLOWING NOTES APPLY WHEN CHECKED
- ☒ ALL CURBS AND CURB GRADIENTS SHALL BE NOTED PRIOR TO PAVING.
 - ☒ BACKFILL COMPACTION SHALL BE ACCORDING TO SPECIFIED STREET USE.
 - ☒ TACK COAT REQUIREMENTS SHALL BE DETERMINED BY THE CITY ENGINEER.
 - ☒ SIDEWALKS AND WHEELCHAIR RAMPS WITHIN THE Curb RETURN SHALL BE CONSTRUCTED. HOWEVER, A NEW CURB RETURN IS CONSTRUCTED.
 - ☐ IF C&G IS REQUIRED FOR A DRIVEWAY, THE DRIVEWAY SHALL BE CONSTRUCTED PRIOR TO ACCEPTANCE OF THE C&G AND G&G&A.
 - ☐ ALL STORM DRAINAGE FACILITIES SHALL BE COMPLETED PRIOR TO FINAL ACCEPTANCE.
 - ☐ PAINT ALL NEW WATER VALVE BOXES, COVER BOXES, AND BLUE ENCASE OR PAINT ALL NEW WATER VALVE BOXES SHALL BE EQUIVALENT TO SAFETY BLUE.

PLANS FOR SITE GRADING,
WATER & SEWER

INDEX TO DRAWINGS


- 1. COVER SHEET
- 2-4. RECORD PLAT
- 5. GRADING PLAN
- 6. COMPOSITE UTILITY PLAN
- 7-10. WATER/SEWER PLAN & PROFILE SHEETS
- 11-13. BUS BAY/TURN BAY DETAILS (STREET P&P FOR INFORMATION ONLY)

NOTE: SHEET NO. 10 DELETED

134, 136, 130 PAVING ITEMS
14, 15, 16 GRADING PLAN, DRAINAGE & RETAINING WALLS


APPROVAL OF AS BUILT DRAWINGS
CITY ENGINEER FIELD
DATE 2/2/85

CITY OF ALBUQUERQUE MUNICIPAL DEVELOPMENT DEPARTMENT ENGINEERING DIVISION					
EL PASEO (PHASE I)					
APPROVALS	ENGINEER	DATE	APPROVALS	ENGINEER	DATE
CITY ENGINEER	12/1/84	7/30/84	JOJO WASTE	12/1/84	7/30/84
ACE ENGINEER	12/1/84	7/30/84	TRAMP	12/1/84	7/30/84
ACE ENGINEER	12/1/84	7/30/84	WATER	12/1/84	7/30/84
APPROVAL FOR CONSTRUCTION	10/26/84	DRAWING NO	1130	MAP NO	12/1/84
CITY ENGINEER	DATE			SHEET	1 OF 13

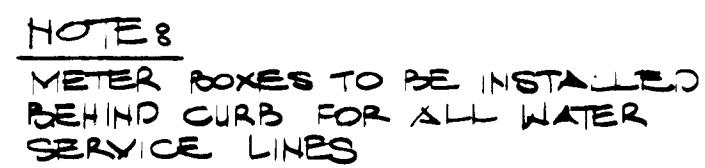

26 1130 0785

HORIZ = $1'' = 50'$
VERT = $1'' = 10'$

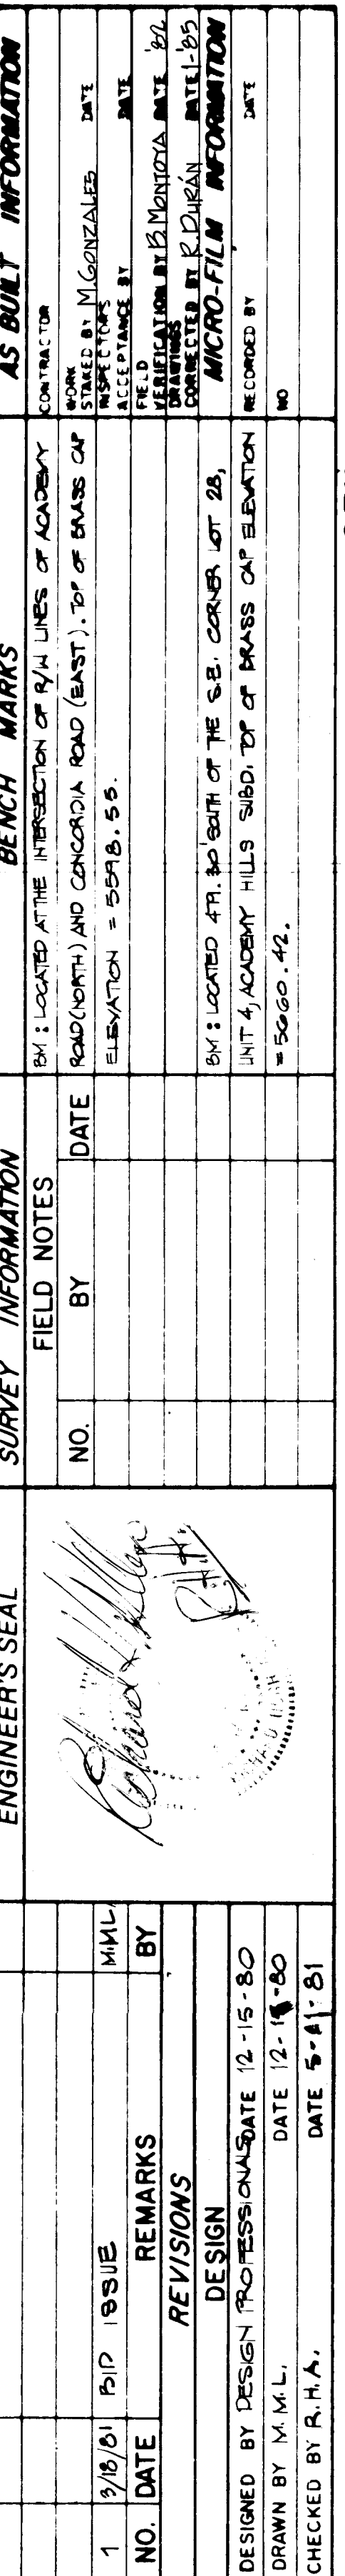

CITY OF ALBUQUERQUE MUNICIPAL WATER SUPPLY DEPARTMENT ENGINEERING DIVISION					
TITLE: EL PASO WATER AND SEWER PLANS					
APPROVALS	ENGINEER	DATE	APPROVALS	ENGINEER	DATE
City Engineer	<i>[Signature]</i>	9/1/81	Liquid Waste	<i>[Signature]</i>	7/2/81
A.C.E. - Design	<i>[Signature]</i>	28/10/81	Traffic	N.A.	
A.C.E. - Hydrology	<i>[Signature]</i>	7/2/81	Water	<i>[Signature]</i>	7/2/81
DRAWING NO.	1130		MAP NO.	E-21	
			SHEET	OF 1 7 13	

