



ACADEMY HILLS SUBDIVISION
UNIT 5

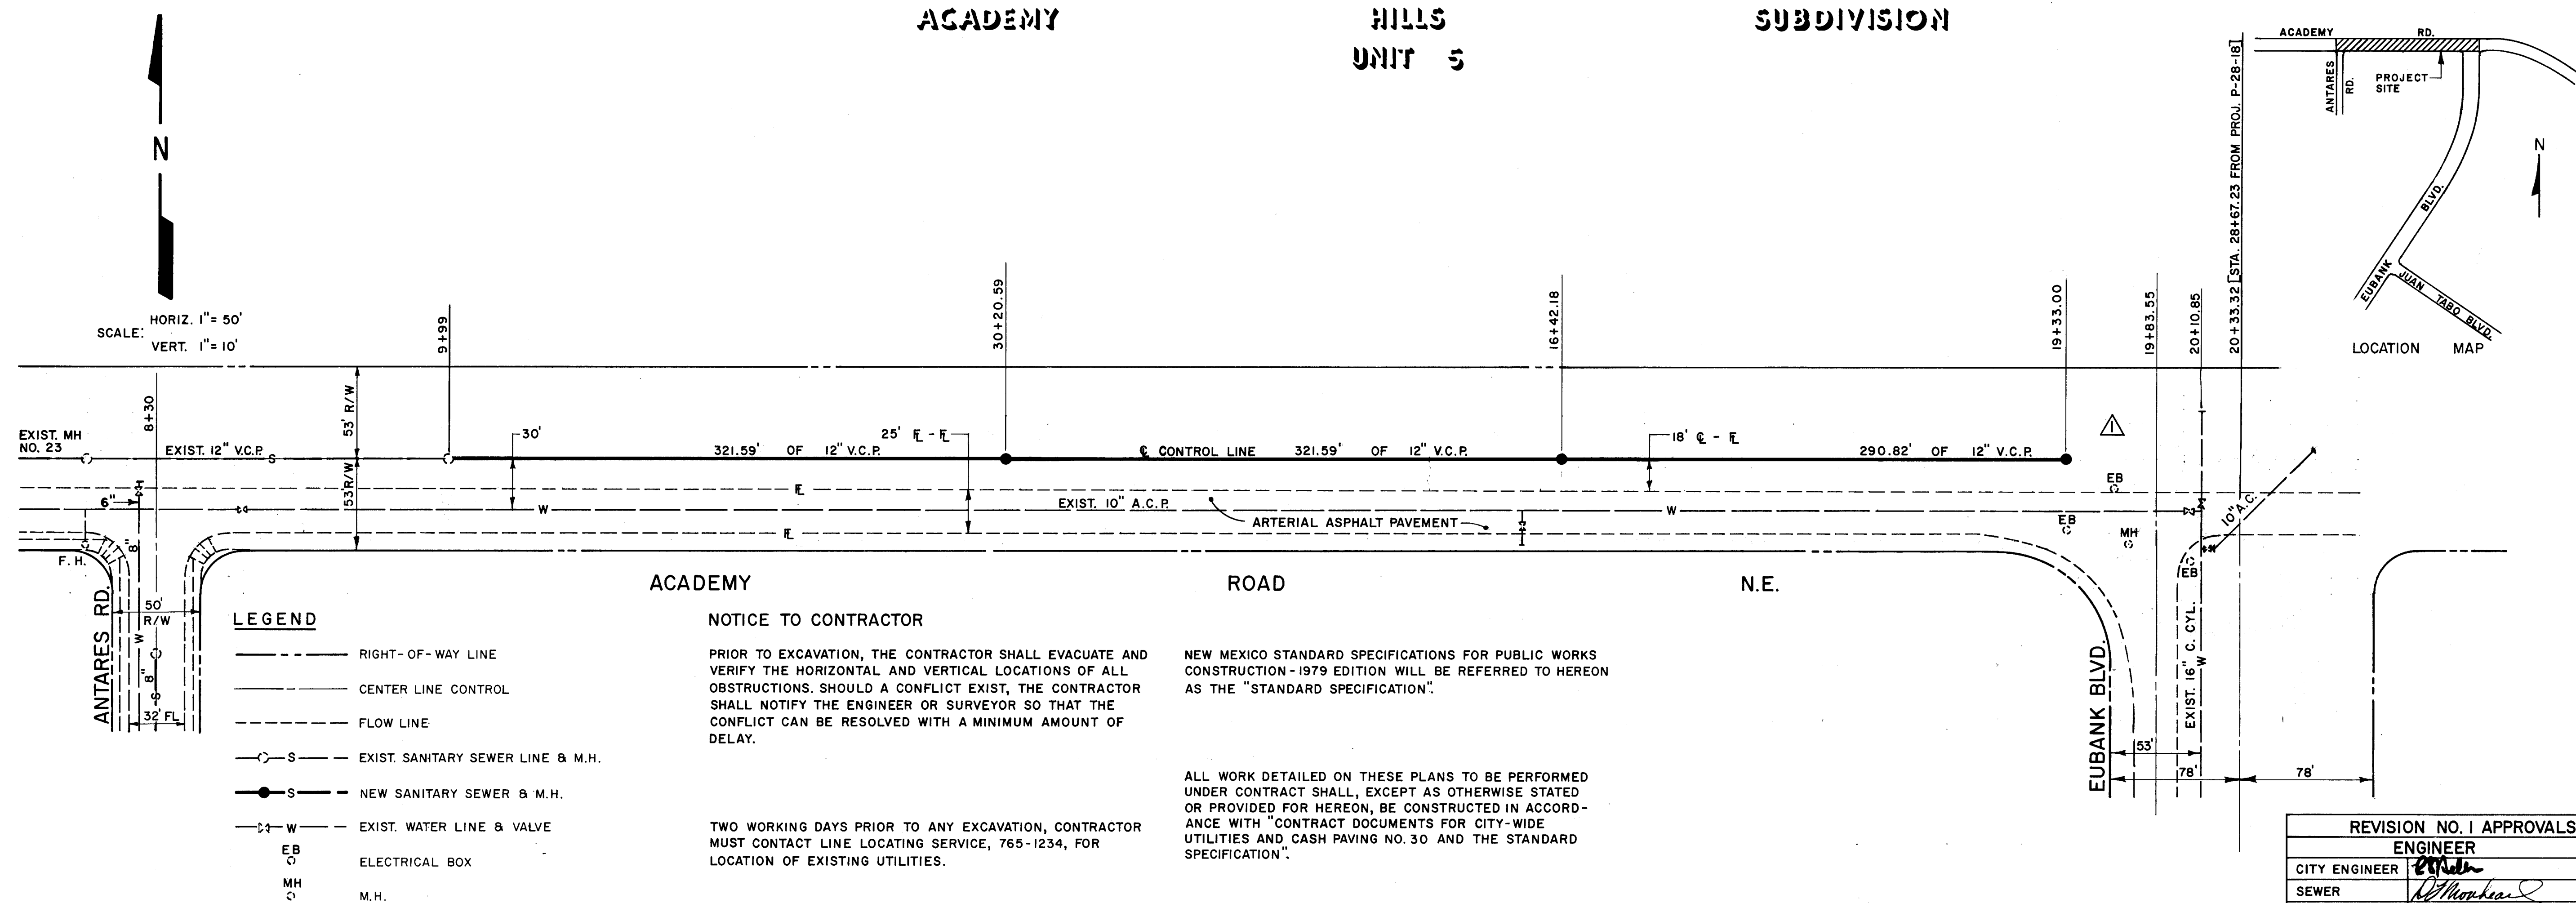

REVISION NO. 1 APPROVALS	
ENGINEER	DATE
CITY ENGINEER	7/13/81
SEWER	7/14/81

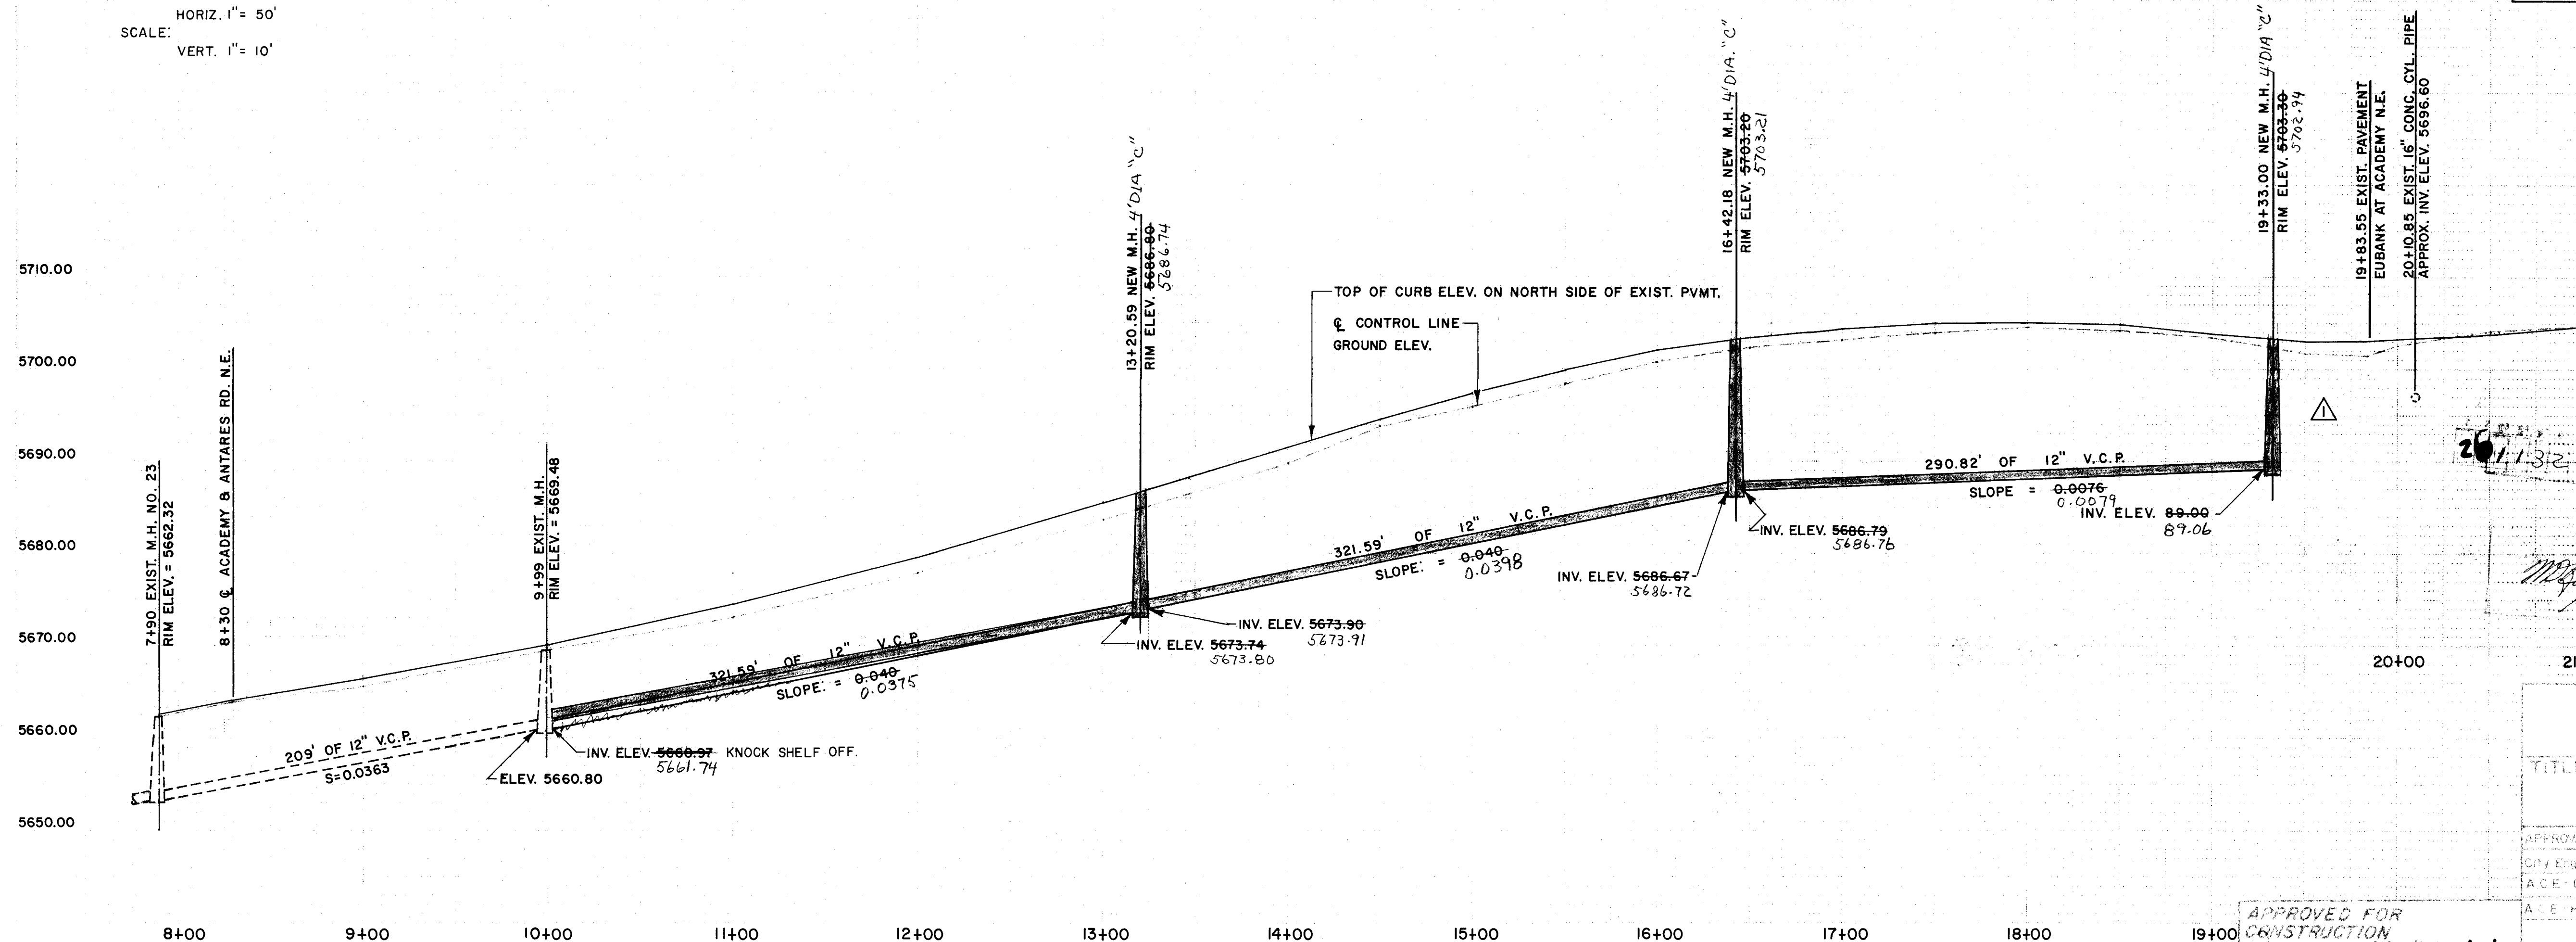

CITY OF ALBUQUERQUE MUNICIPAL DEVELOPMENT DEPT. ENGINEERING DIVISION			
TITLE: SANITARY SEWER LINE EXTENSION ON ACADEMY RD. N.E. BETWEEN ANTARES RD. AND EUBANK BLVD. N.E.			
APPROVALS	ENGINEER	DATE	APPROVALS
CITY ENGINEER	Philip Fischer	12/15/80	LIQUID WASTE
A.C.E. Design	Isaac E. Large	6/10/81	TRAFFIC
A.C.E. Hydrology			WATER
DRAWING NO. 1132		SHEET 1 OF 1	

SURVEY INFORMATION		BENCH MARKS		AS BUILT INFORMATION	
MAP NO.	E-21	DATE	11-5-80	C.B.M. X W.B.B. FIRE HYDRANT S.E. COR. ACADEMY RD. AND DENALI RD. N.E. ORIGIN UNKNOWN. ELEV. 5613.87.	DATE
EST. NO.	1132	NO.	PS-7	DATE	11/5/81
W.O. NO.		BY	ANGEL	DATE	
REVISIONS		REMARKS		DATE	
NO.	DATE	REMARKS		DATE	
1	10-29-80	7-6-81 LENGTH AND GRADE CHANGED		DATE	
2	12-15-80			DATE	