




INDEX TO DRAWINGS

1. TITLE SHEET
2. REMOVAL & CONSTRUCTION PLANS
3. STORM SEWER PROFILE & MISC. DETAILS

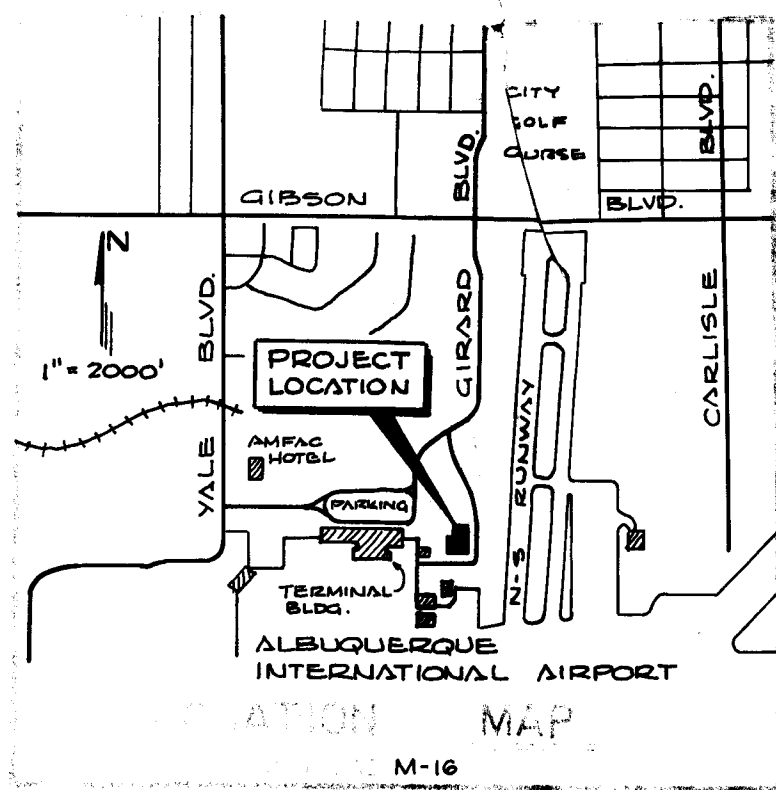

EAST EMPLOYEES' PARKING LOT

ALBUQUERQUE INTERNATIONAL AIRPORT

JUNE - 1981

NOTES TO CONTRACTORS

1. The drawings are prepared for Public Works Department, City of Albuquerque, New Mexico. The drawings are to be used for the construction of the East Employees' Parking Lot. The drawings are to be used for the construction of the East Employees' Parking Lot. The drawings are to be used for the construction of the East Employees' Parking Lot.

2. The drawings are to be used for the construction of the East Employees' Parking Lot. The drawings are to be used for the construction of the East Employees' Parking Lot. The drawings are to be used for the construction of the East Employees' Parking Lot.

3. The drawings are to be used for the construction of the East Employees' Parking Lot. The drawings are to be used for the construction of the East Employees' Parking Lot. The drawings are to be used for the construction of the East Employees' Parking Lot.


- ✓ The drawings are to be used for the construction of the East Employees' Parking Lot. The drawings are to be used for the construction of the East Employees' Parking Lot. The drawings are to be used for the construction of the East Employees' Parking Lot.
26 11340185

APPROVAL OF AS BUILT DRAWINGS
ASST. CITY ENGINEER - FIELD
[Signature]
DATE 10-28-85




ALBERT D. CORBIN & Associates
Professional Engineers
ALBUQUERQUE, NEW MEXICO

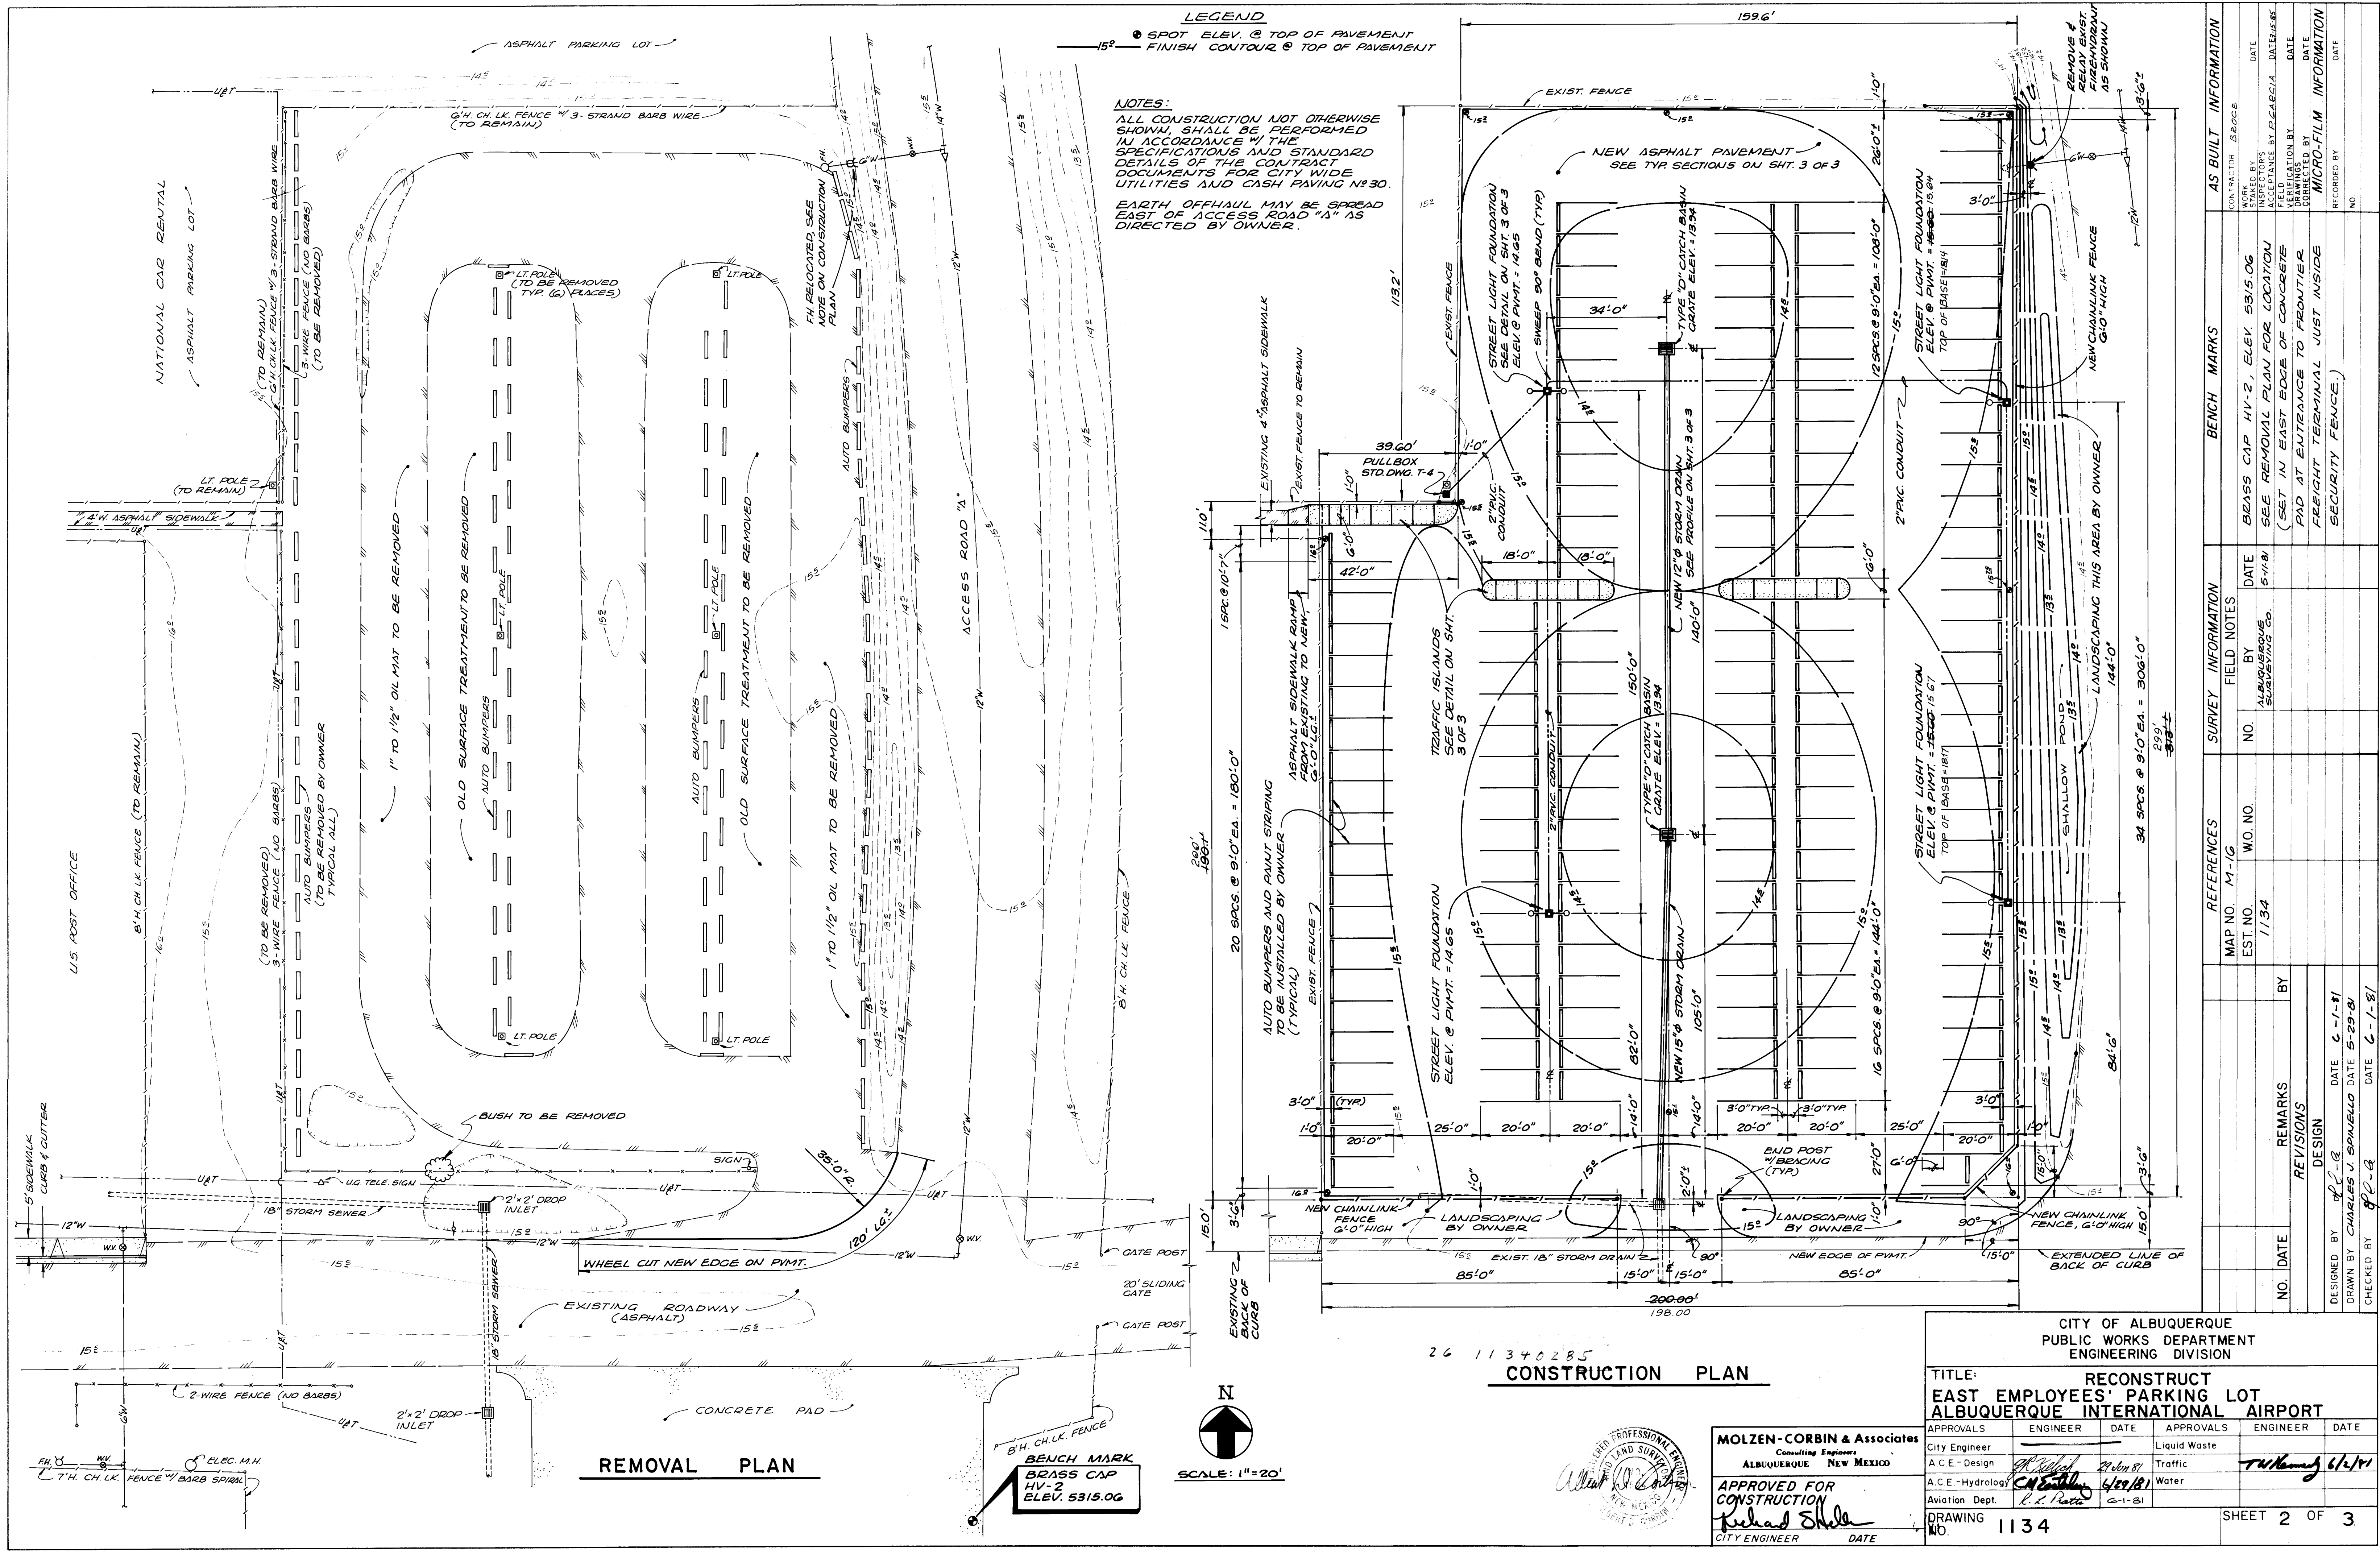

REFERENCES			SURVEY INFORMATION		BENCH MARKS		AS BUILT INFORMATION							
MAP NO. M-1/G	EST. NO. 1/34	W.O. NO.	NO.	BY ALBUQUERQUE SURVEYING CO.	DATE 5-1-81	BRASS CAP HV-2, ELEV. 5315.06 SEE REMOVAL PLAN FOR LOCATION (SET IN EAST EDGE OF CONCRETE PAD AT ENTRANCE TO FRONTIER FREIGHT TERMINAL JUST INSIDE SECURITY FENCE.)	CONTRACTOR 5802C	NO.						
			REVISIONS				NO. DATE		BY		DATE			
			DESIGN				1 6-1-81		C. J. Spivey		6-1-81			
			CHECKED BY				8-1-81		C. J. Spivey		8-1-81			


APPROVALS		ENGINEER	DATE	APPROVALS		ENGINEER	DATE
City Engineer				Liquid Waste			
A.C.E. - Design			6/29/81	Traffic			6/29/81
A.C.E. - Hydrology				Water			
Aviation Dept.			6-1-81				

DRAWING NO. 1134		SHEET 2 OF 3	
------------------	--	--------------	--

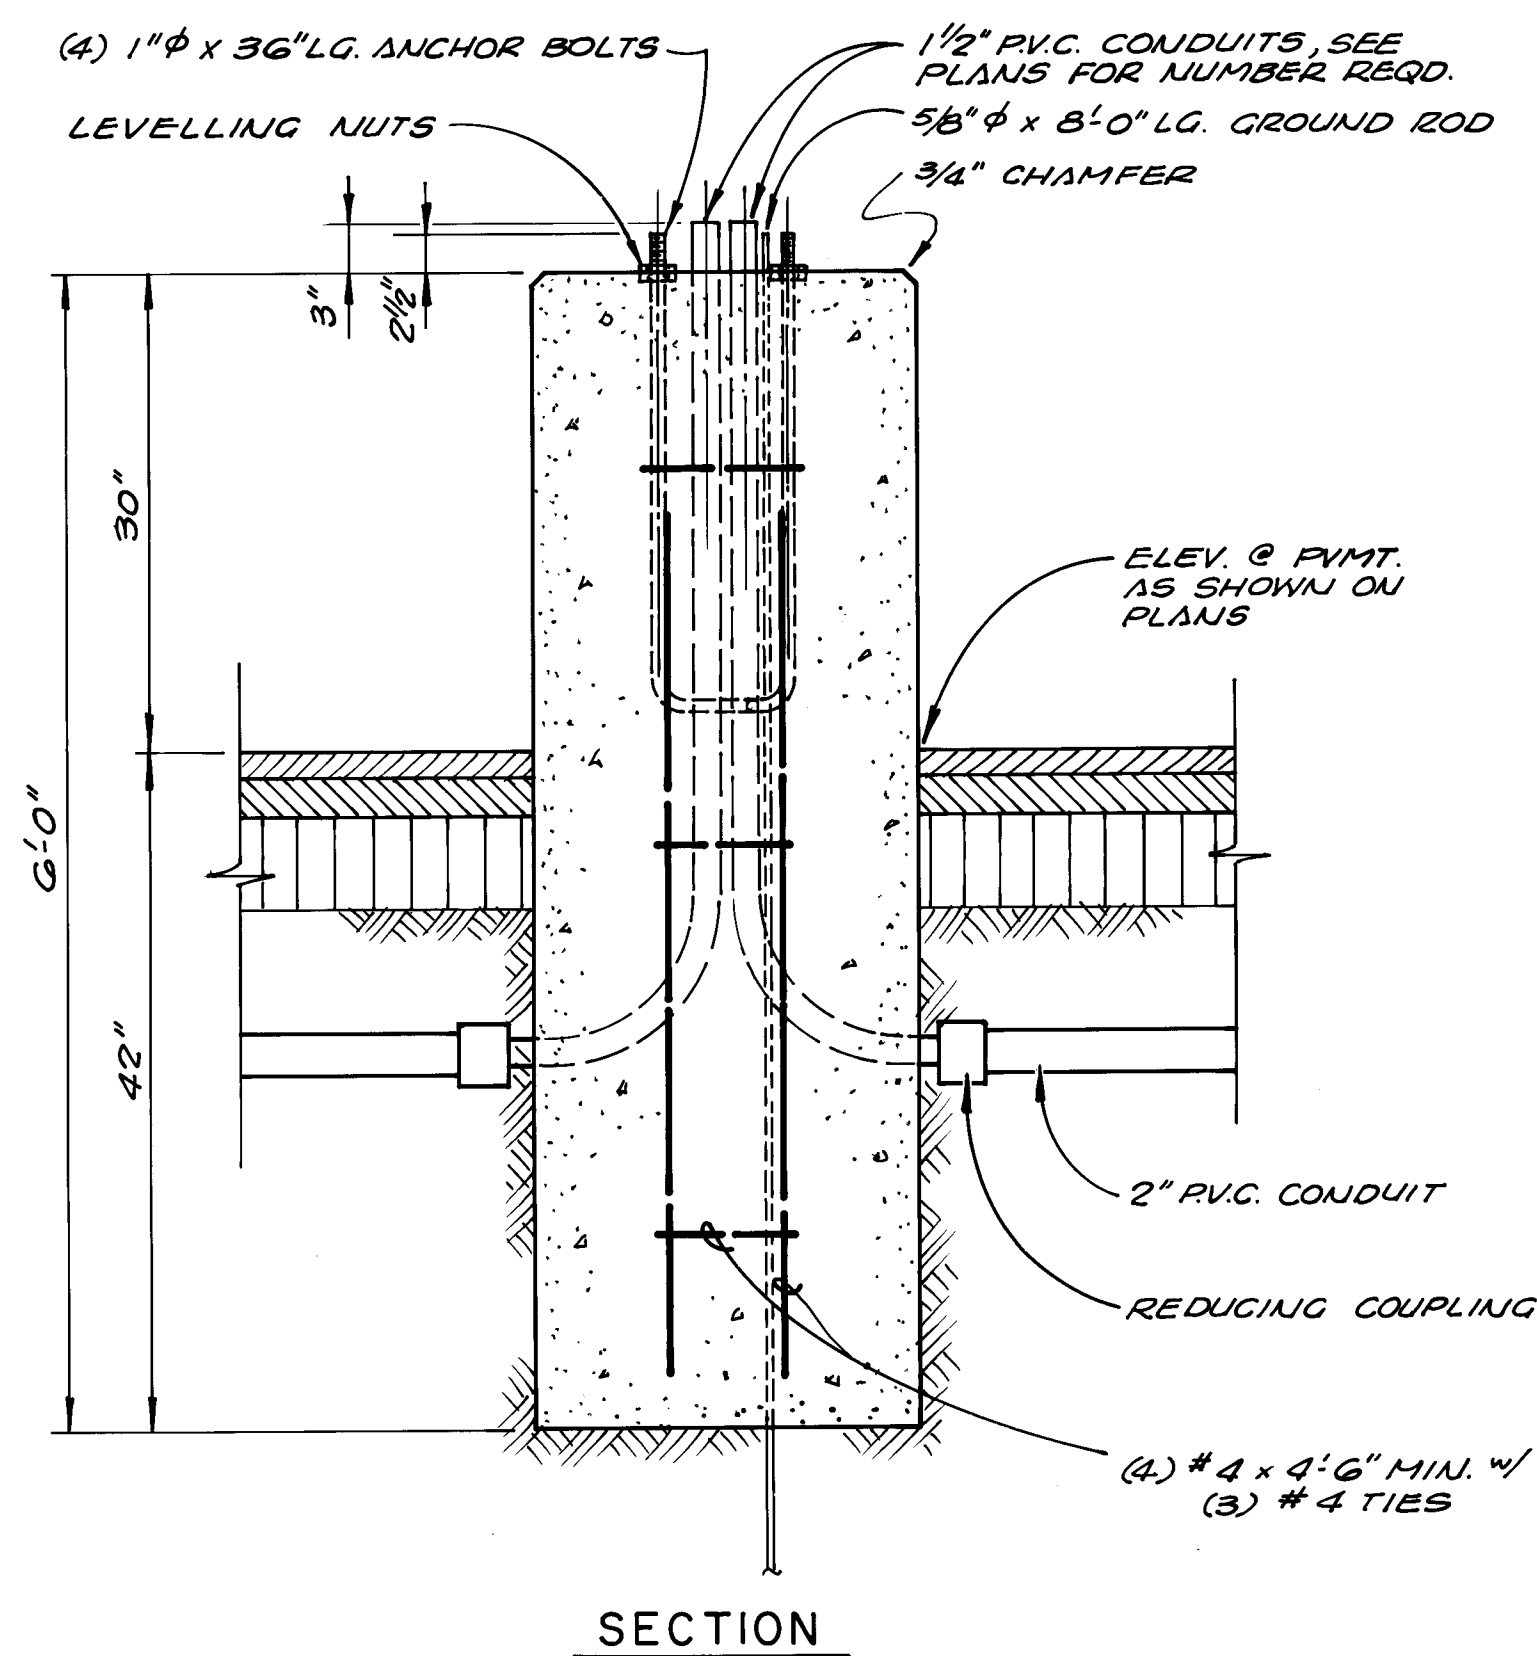

PLAN VIEW


TYPICAL STREET LIGHT FOUNDATION
SCALE: 1" = 1'-0"

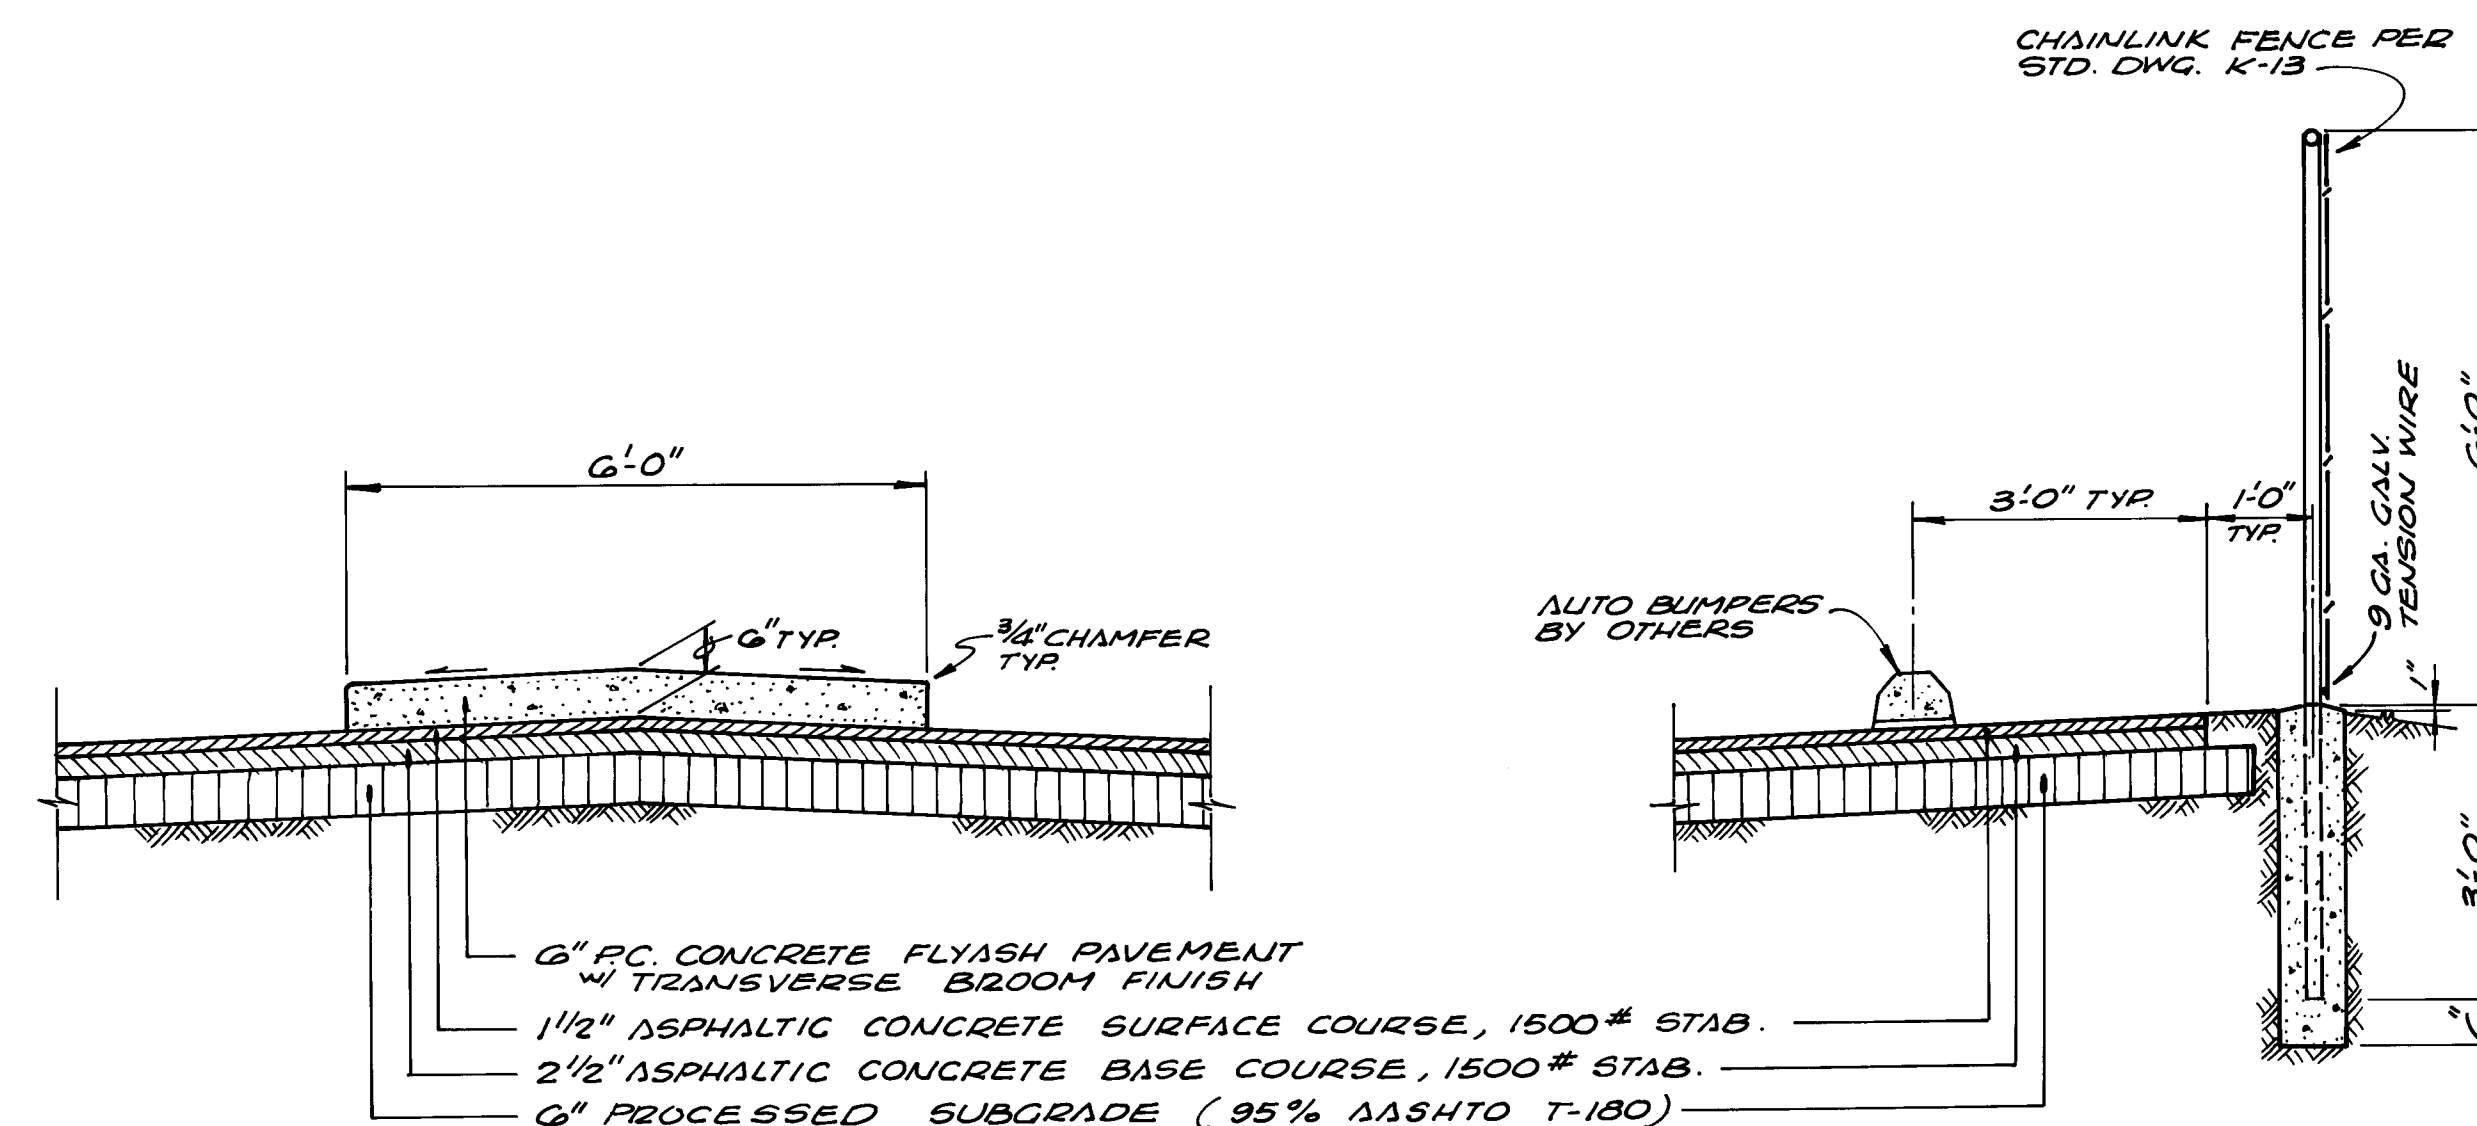


AT TRAFFIC ISLAND

AT PERIMETER FENCE

TYPICAL SECTIONS
NO SCALE

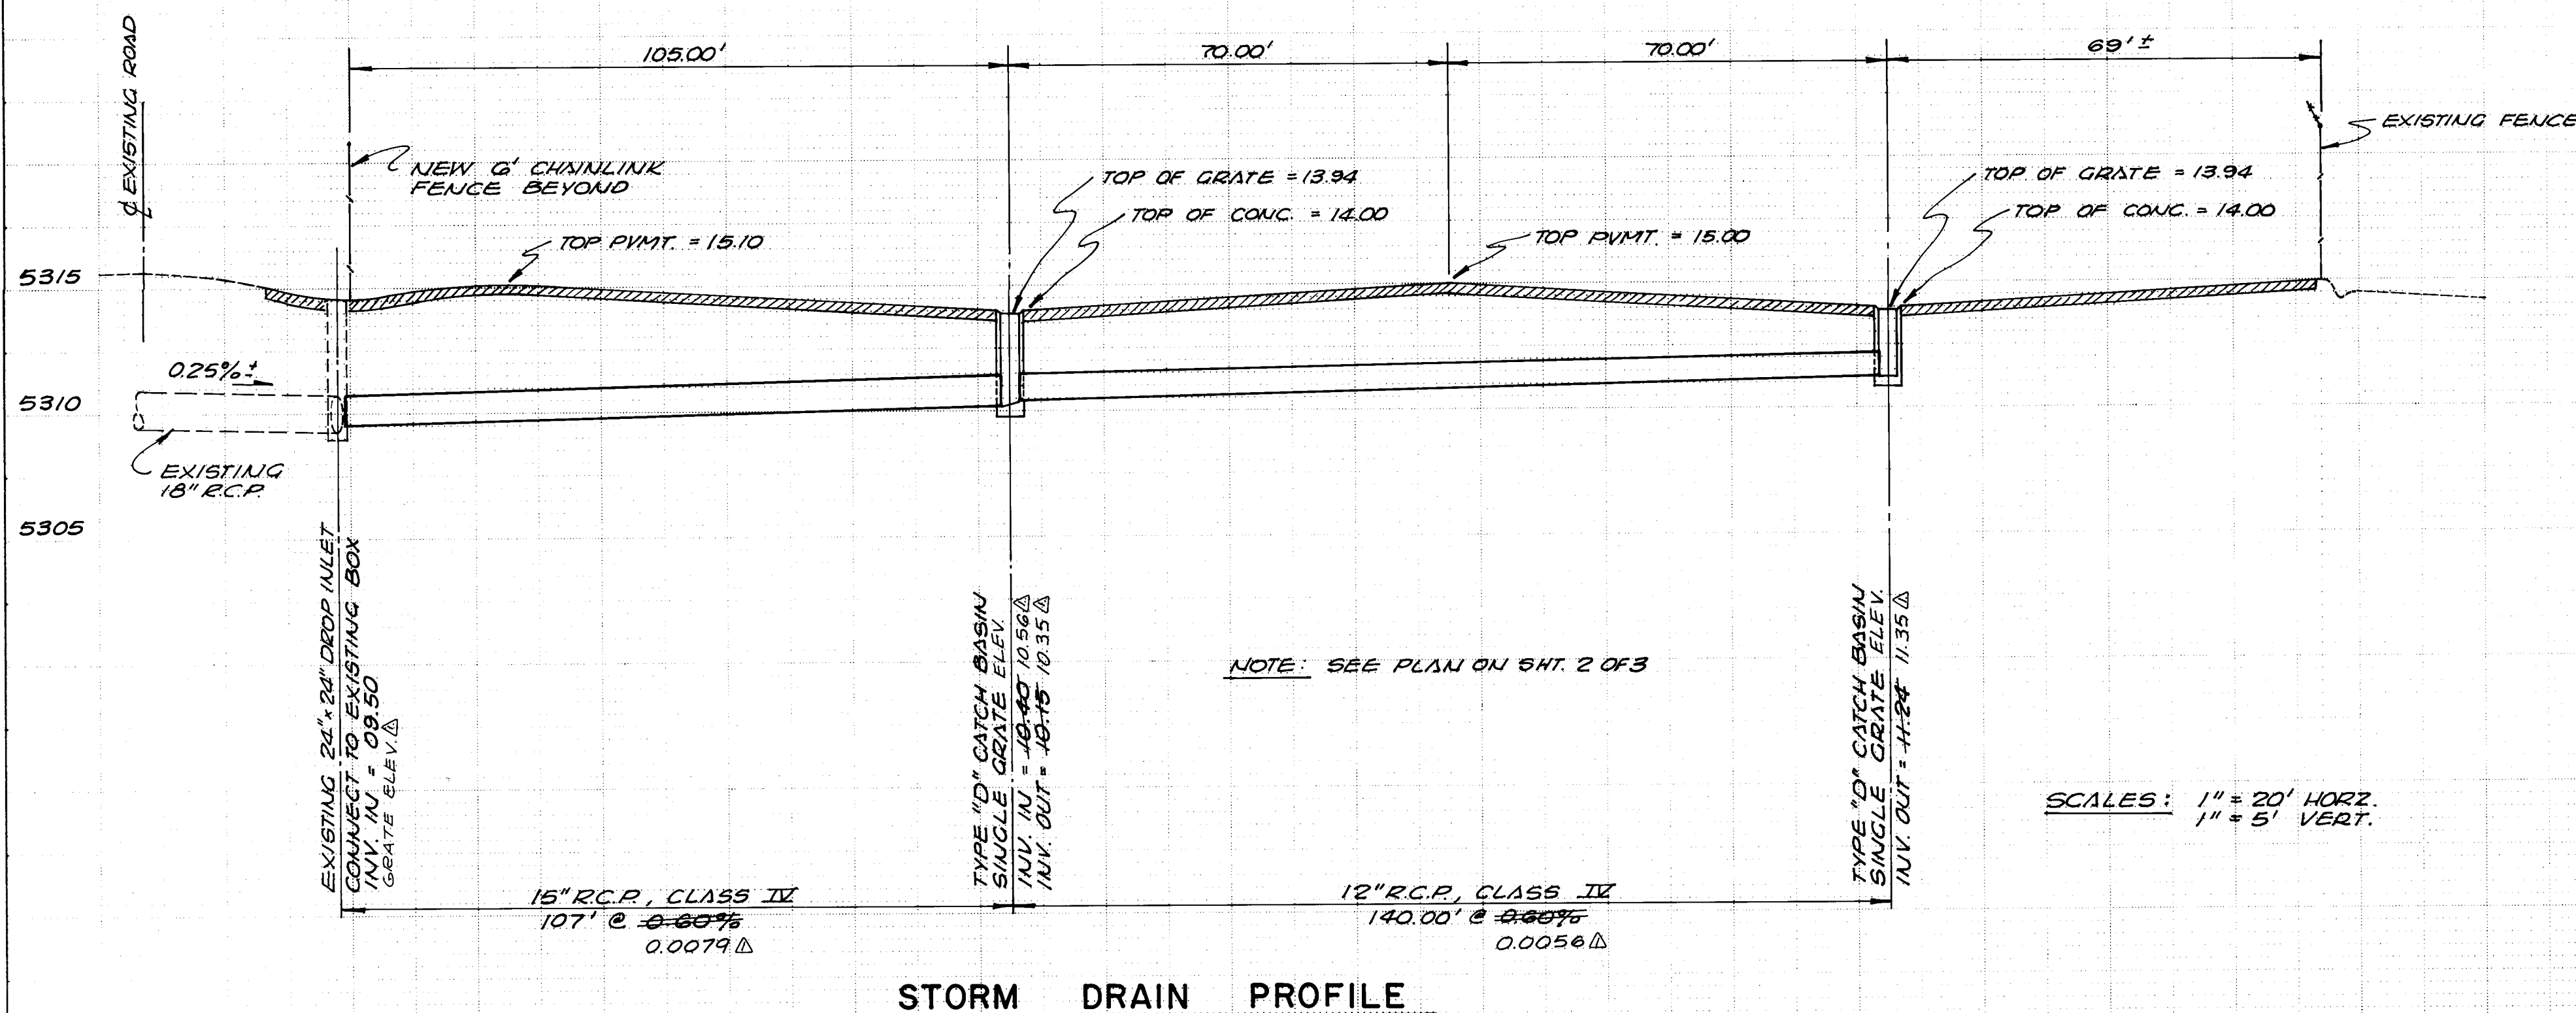

STORM DRAIN PROFILE

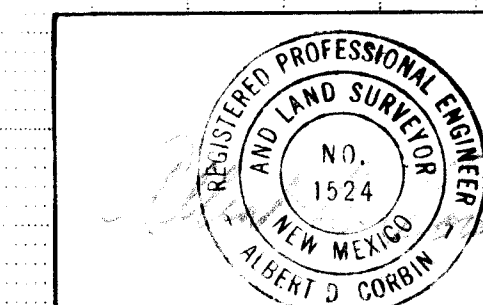

MOLZEN-CORBIN & Associates
Consulting Engineers
ALBUQUERQUE NEW MEXICO
APPROVED FOR CONSTRUCTION
Richard S. Hall 7/6/81
CITY ENGINEER DATE

CITY OF ALBUQUERQUE PUBLIC WORKS DEPARTMENT ENGINEERING DIVISION					
TITLE: RECONSTRUCT EAST EMPLOYEES' PARKING LOT ALBUQUERQUE INTERNATIONAL AIRPORT					
APPROVALS	ENGINEER	DATE	APPROVALS	ENGINEER	DATE
City Engineer			Liquid Waste		
A.C.E. - Design			Traffic		
A.C.E. - Hydrology			Water		
DRAWING NO. 1134			SHEET 3 OF 3		

REFERENCES		SURVEY INFORMATION		BENCH MARKS		AS BUILT INFORMATION	
MAP NO.	M-16	FIELD NOTES	NO.	BRASS CAP HV-2, ELEV. 5315.06	CONTRACT NO.	13806	
EST. NO.	1134	BY	DATE	SEE REMOVAL PLAN FOR LOCATION	WORKS BY		
		ALBUQUERQUE SURVEYING CO.	5-11-81		INSPECTED BY		
					ACCEPTANCE BY P. GARCIA	DATE	
					FIELD DRAWINGS	DATE	
					CORRECTIONS BY	DATE	
					REVISIONS	DATE	
					RECORDED BY	DATE	
					NO.		