


F.H. ON MENAUL BLVD.
TO SERVE LOTS 3-A-2 & 3-B-1, INDIAN RIDGE SUB'D BLK. 2

INDEX

SHT. 1 - TITLE SHEET
SHT. 2 - PLAN & PROFILE

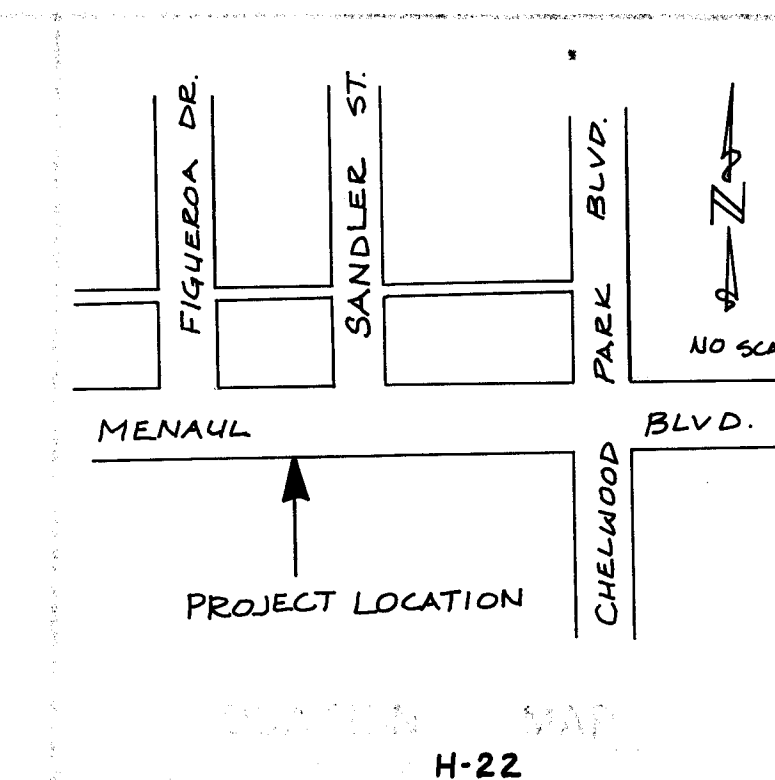

NOTICE TO CONTRACTORS

THESE PLANS WERE PREPARED BY THE ENGINEER AND THE CONTRACTOR SHALL BE RESPONSIBLE FOR THE ACCURACY OF THE INFORMATION PROVIDED TO THE ENGINEER. THE CONTRACTOR SHALL BE RESPONSIBLE FOR THE ACCURACY OF THE INFORMATION PROVIDED TO THE ENGINEER. THE CONTRACTOR SHALL BE RESPONSIBLE FOR THE ACCURACY OF THE INFORMATION PROVIDED TO THE ENGINEER.

✓

THE CONTRACTOR SHALL BE RESPONSIBLE FOR THE ACCURACY OF THE INFORMATION PROVIDED TO THE ENGINEER. THE CONTRACTOR SHALL BE RESPONSIBLE FOR THE ACCURACY OF THE INFORMATION PROVIDED TO THE ENGINEER. THE CONTRACTOR SHALL BE RESPONSIBLE FOR THE ACCURACY OF THE INFORMATION PROVIDED TO THE ENGINEER.




2011/11/30 01:32

SHEET 2 OF 2
APPROVAL OF AS BUILT DRAWING
DATE 2-28-12

Amold Conf. 11/11/11

1138

1 2

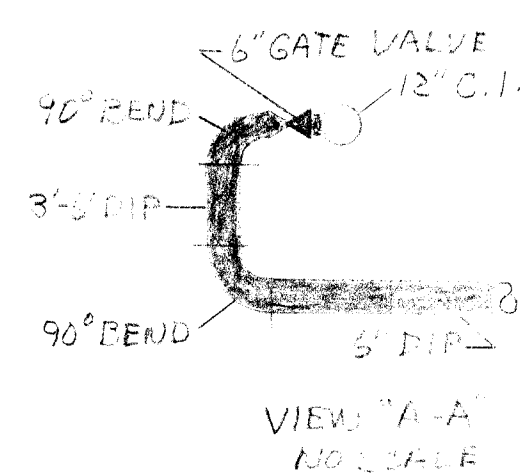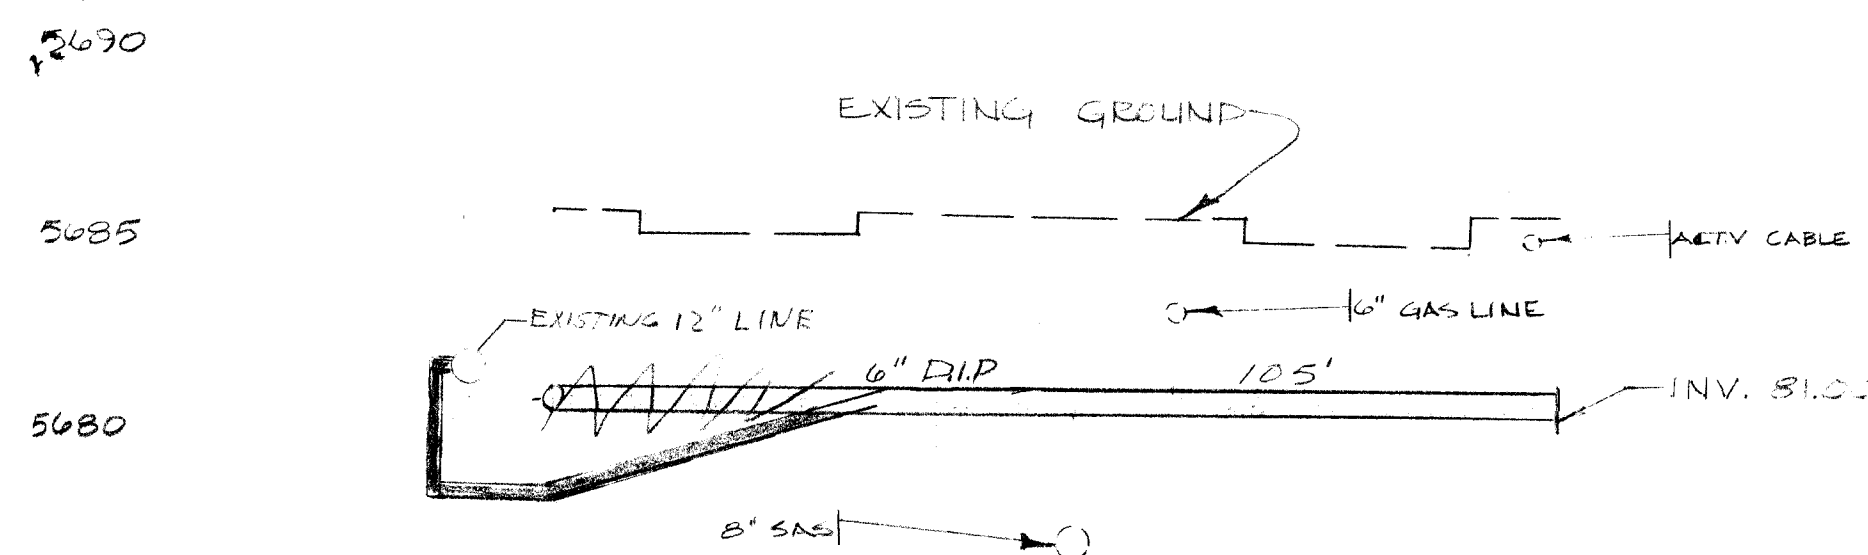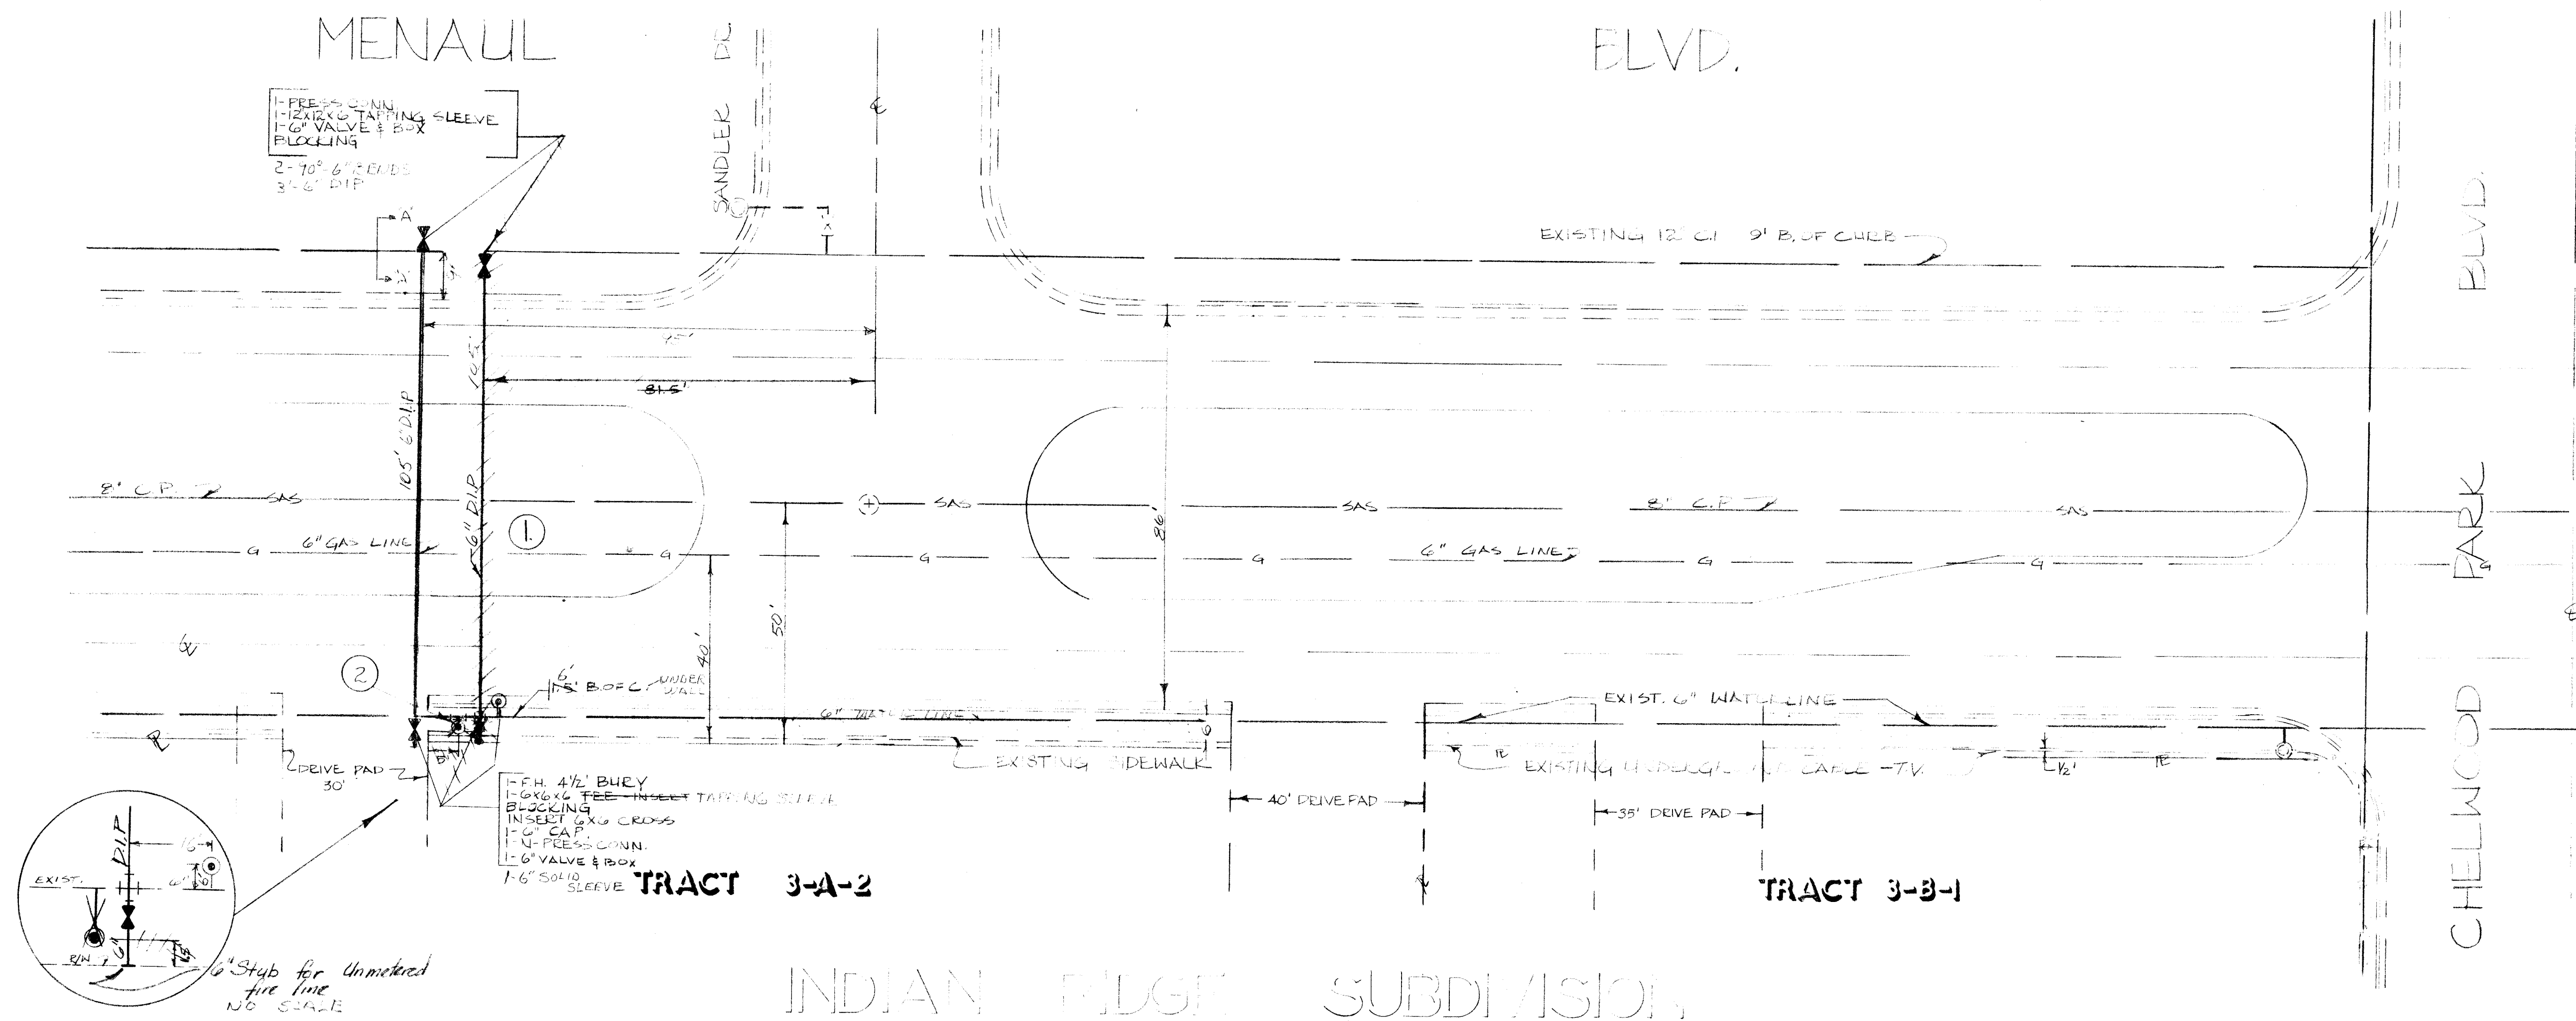

201138 0282

FH ON MENAUL BLVD N.E. AT SANDLER DR. TR. 3-A-2 & 3-B-1 - INDIAN RIDGE SUBD.

6/26/81
9/25/81

11/14
R/Handbook 4/25/81

1138

H-22

2 2

6-9-81
6-9-81
S. MIRANDA
C. CORREIA