

SEWER LINE CONSTRUCTION

FOR

BUDGET RENT-A-CAR SERVICE CENTER

CITY OF ALBUQUERQUE, BERNALILLO COUNTY

NEW MEXICO


MAY, 1981

PREPARED FOR


BUDGET RENT-A-CAR
OF NEW MEXICO INC.

PREPARED BY

FRED DENNEY & ASSOCIATES, INC.
ENGINEERS - PLANNERS
ALBUQUERQUE, NEW MEXICO 87107

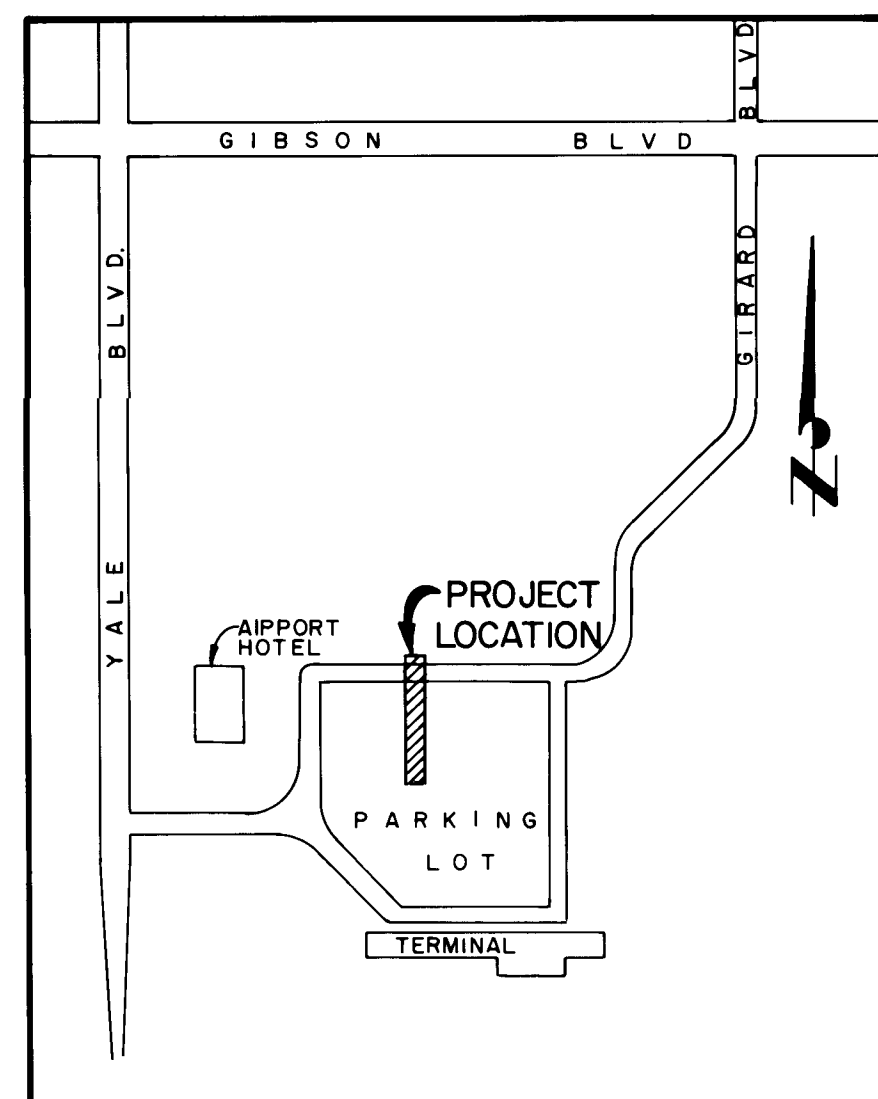

VICINITY MAP



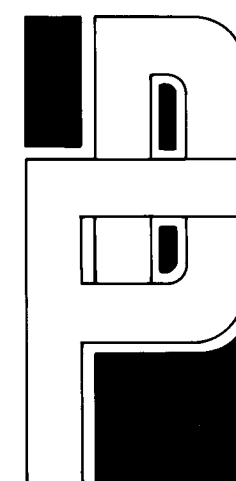


NOTICE TO CONTRACTORS


1. All work detailed on these plans to be performed under contract shall, except as otherwise stated or provided for hereon, be constructed in accordance with "Contract Documents for City - Wide Utilities and Cash Paving No. 30 and the Standard Specification.
2. Two working days prior to any excavation, Contractor must contact Line Locating Service, 765-1234, for location of existing utilities.
3. Prior to construction, the Contractor shall excavate and verify the horizontal and vertical location of all obstructions. Should a conflict exist, the Contractor shall notify the Engineer or Surveyor so that the conflict can be resolved with minimum amount of delay.

THE FOLLOWING NOTES APPLY WHEN CHECKED

- ☒ All utilities and utility service lines shall be installed prior to paving.
 - ☒ Backfill compaction shall be according to specified street use.
- Tack coat requirements shall be determined by the City Engineer.
- Sidewalks and wheelchair ramps within the curb returns shall be constructed wherever a new curb return is constructed.
- If curb is depressed for a drivepad, the drivepad shall be constructed prior to acceptance of the curb and gutter.
- All Storm Drainage Facilities shall be completed prior to final acceptance.

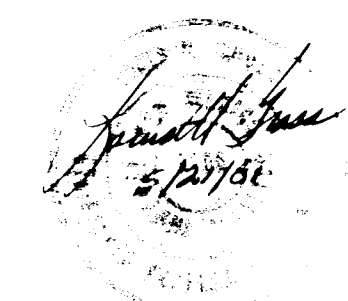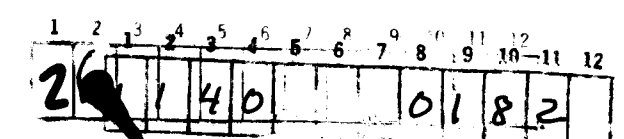
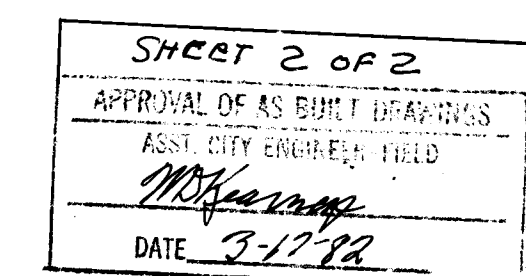


DWG. NO.
1140

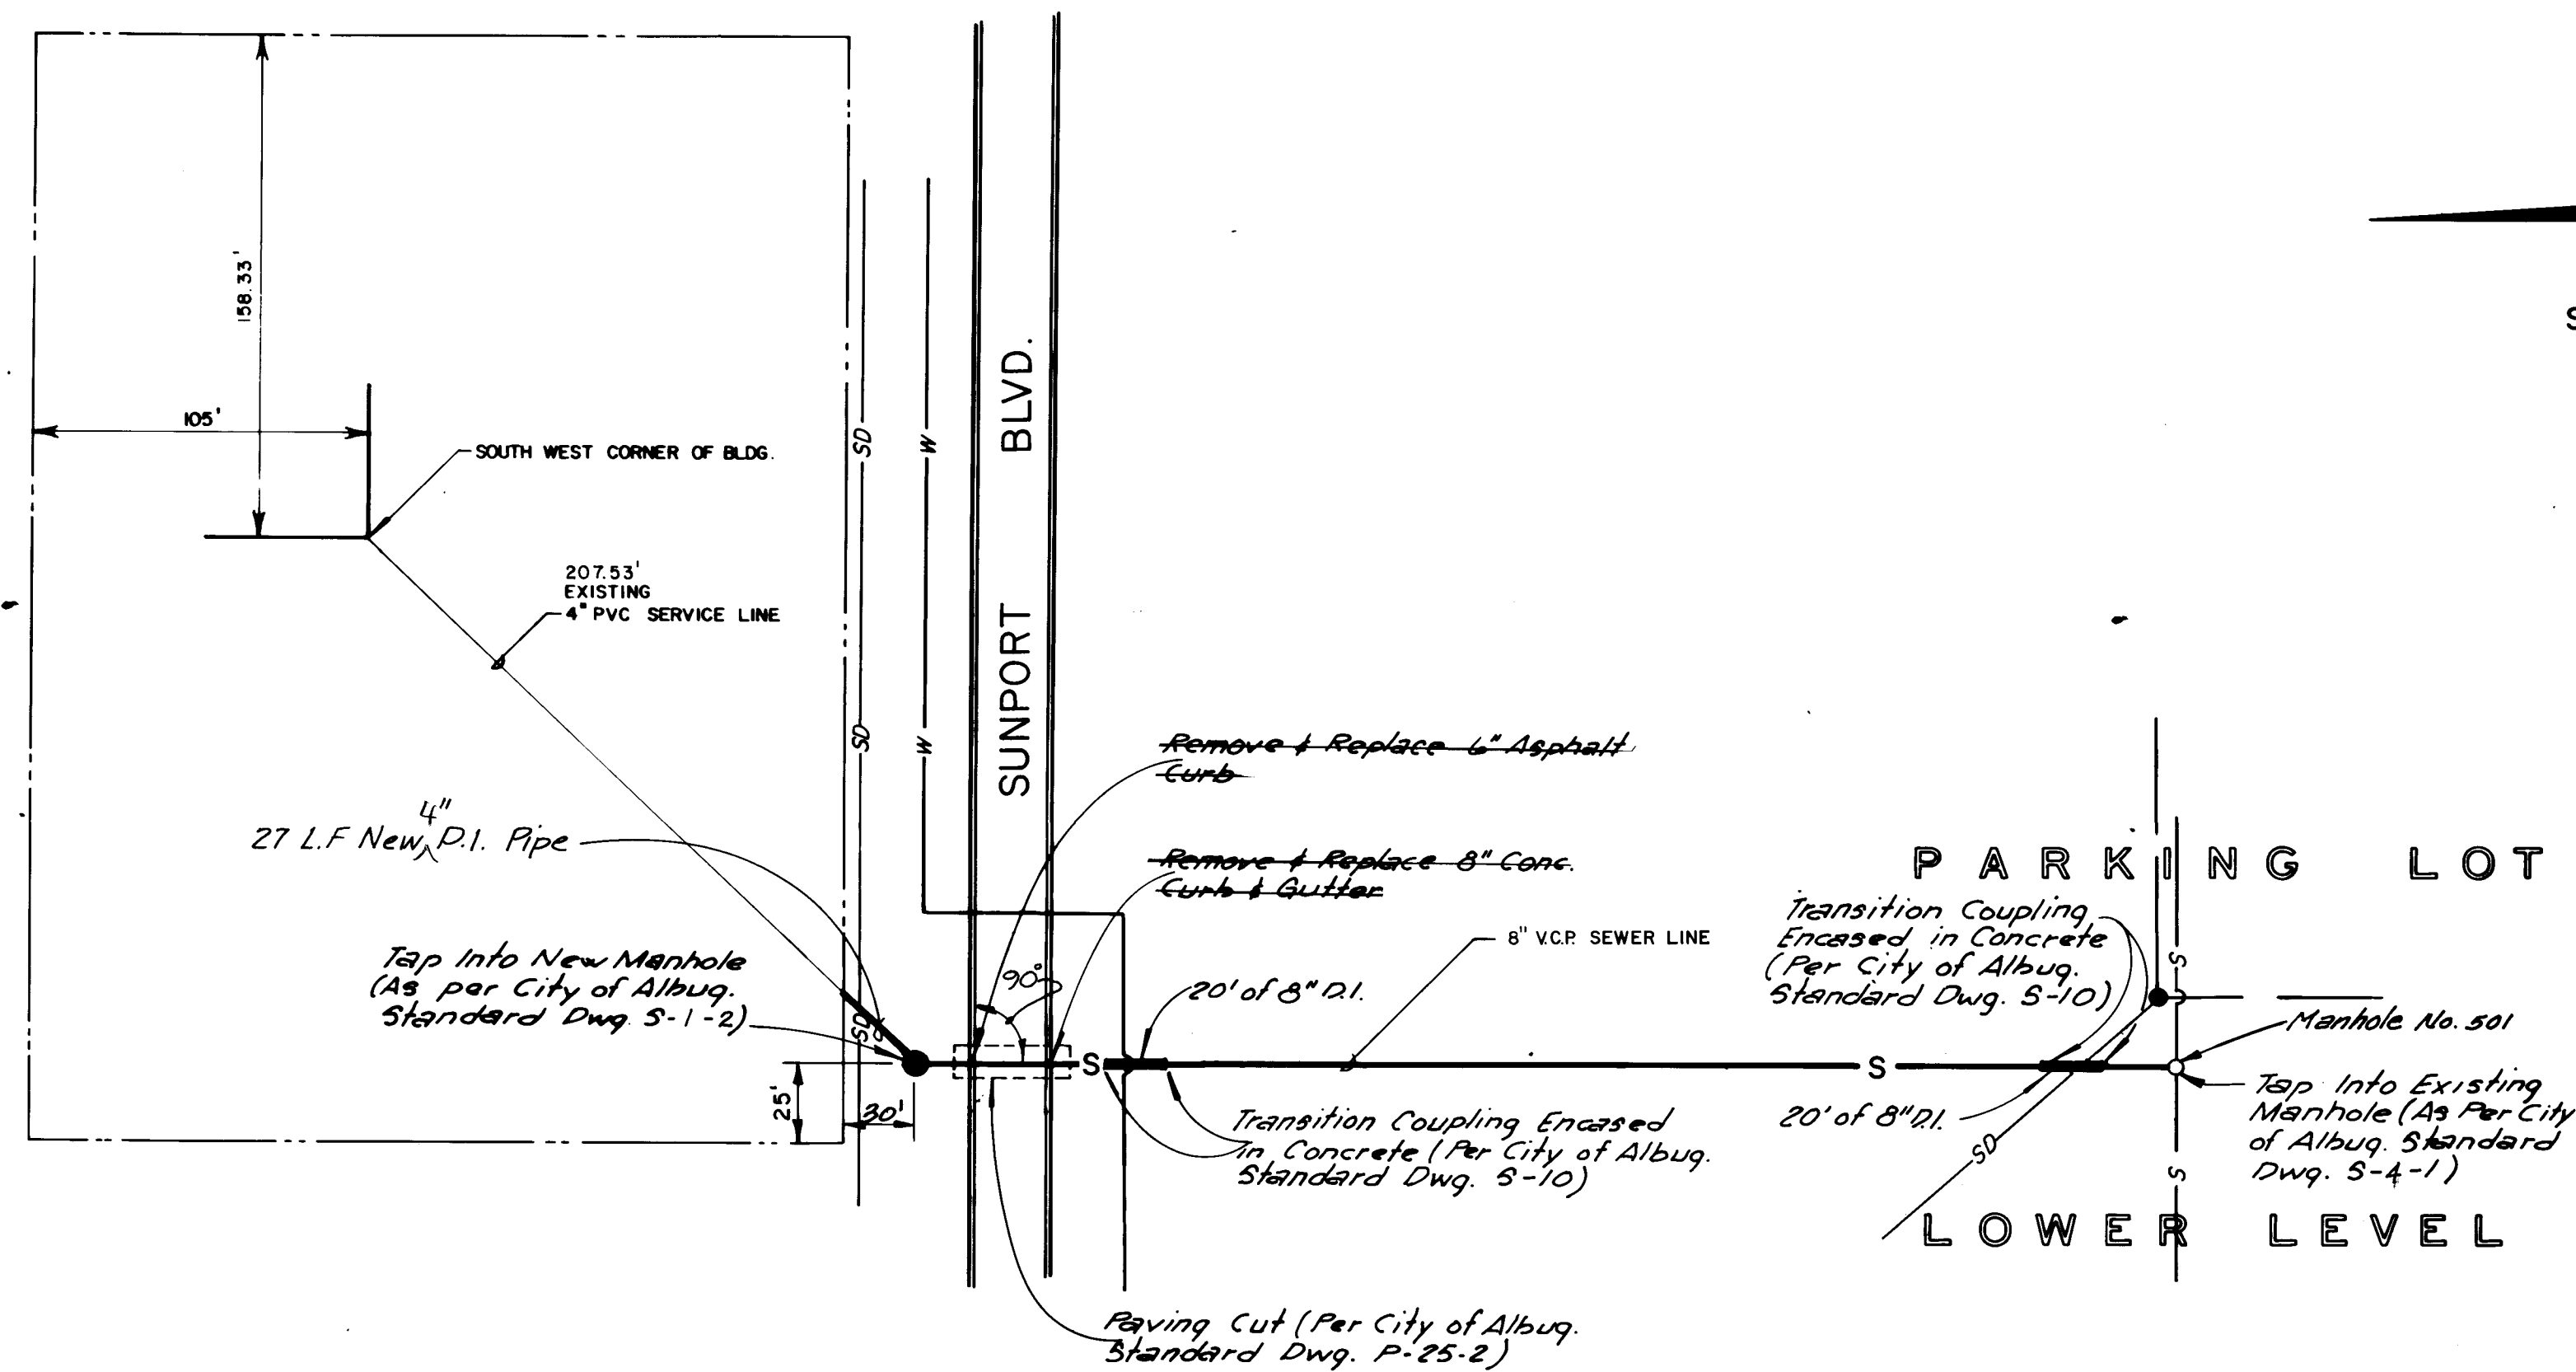

SCALE: 1" = 50' Horiz.
1" = 5' Vert.

Note:
Sewer lines shall be located as shown using Curb & Gutter as reference.

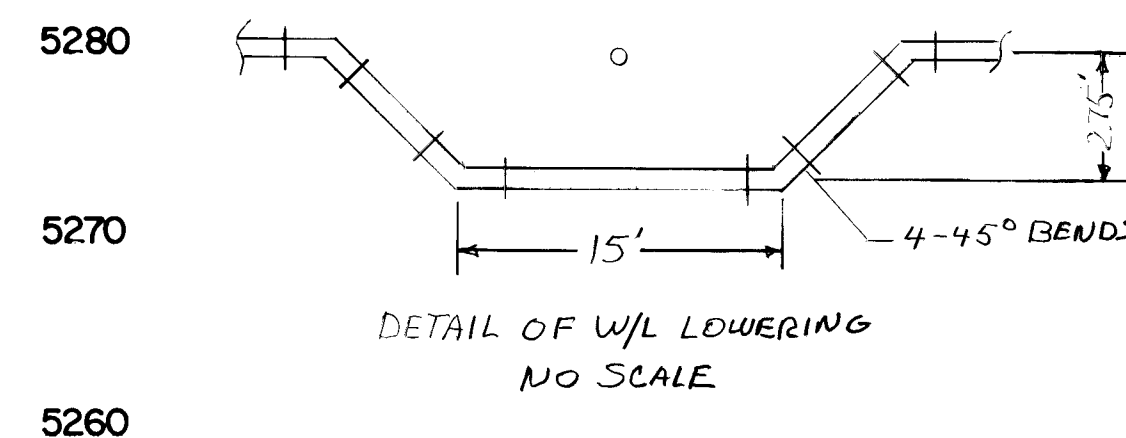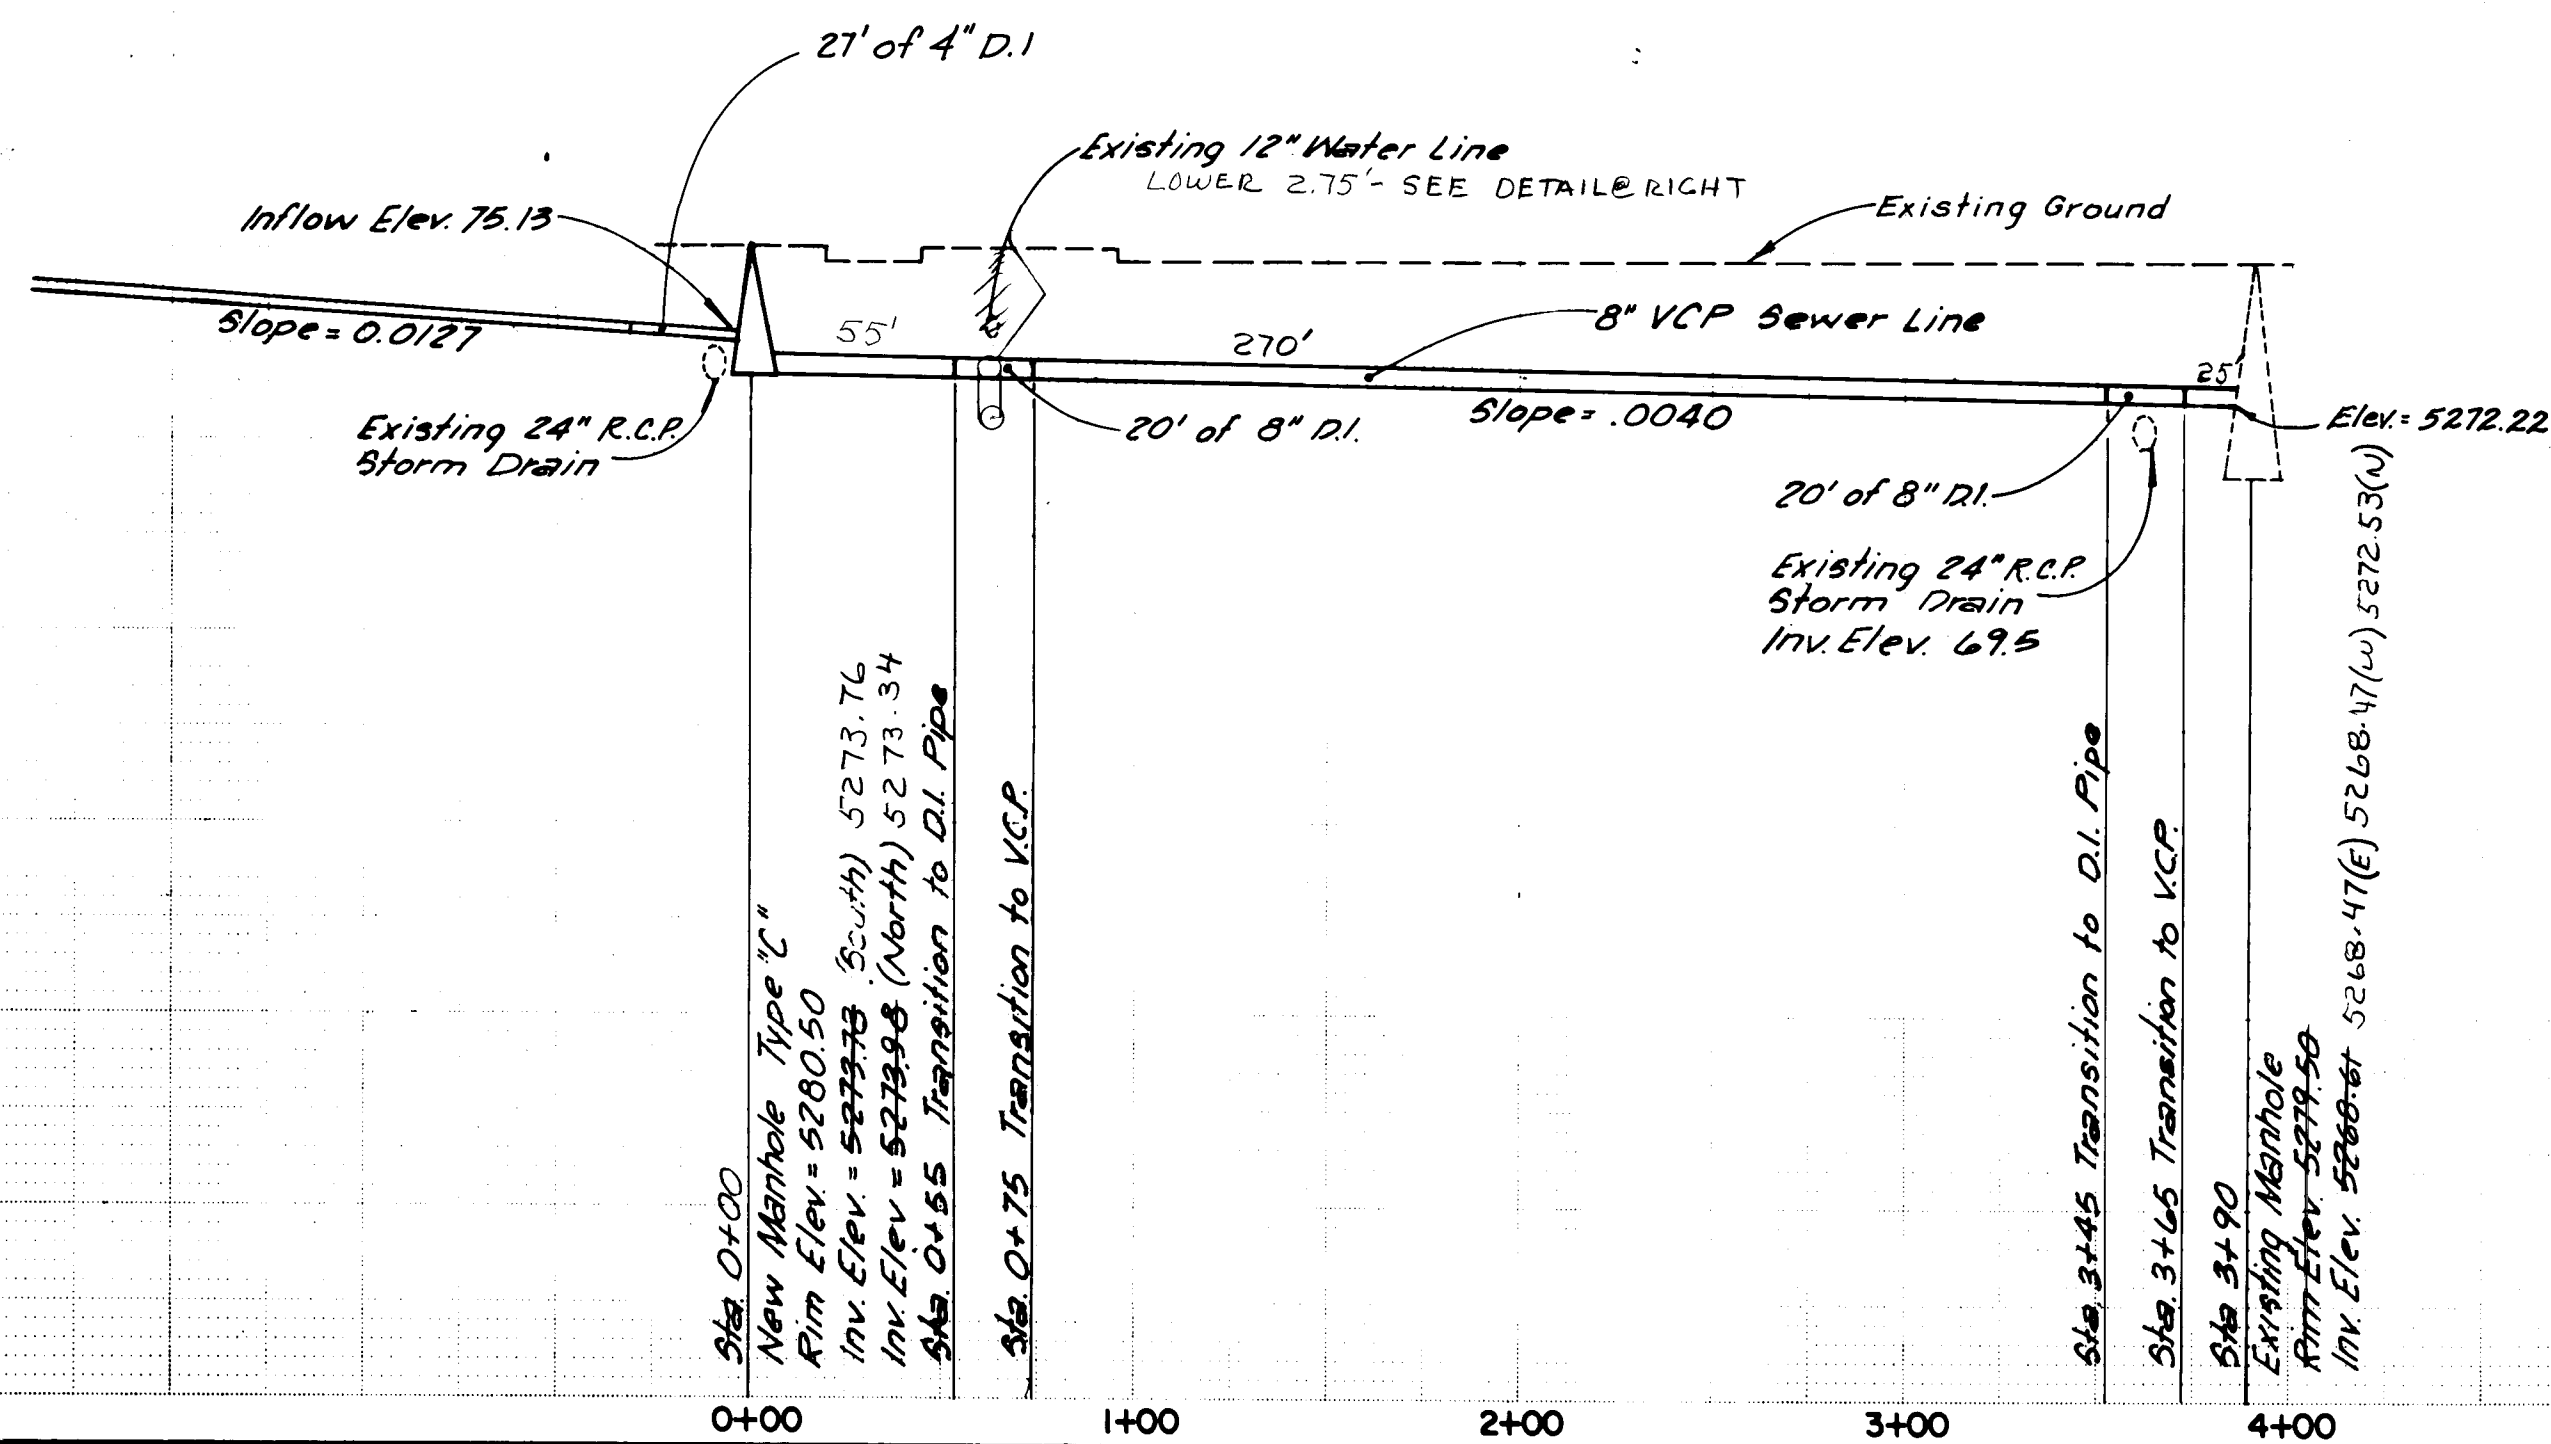

Fred Denney & Associates, Inc.
ENGINEERS PLANNERS
ALBUQUERQUE, NEW MEXICO

Richard S. Heller
5/24/81

APPROVED FOR
CONSTRUCTION
Richard S. Heller
CITY ENGINEER DATE 6/14/81

CITY OF ALBUQUERQUE PUBLIC WORKS DEPARTMENT ENGINEERING DIVISION					
TITLE: SEWER LINE for BUDGET RENT - A - CAR SERVICE CENTER					
APPROVALS	ENGINEER	DATE	APPROVALS	ENGINEER	DATE
CITY Engineer			Liquid Waste	<i>John H. Hays</i>	6/15/81
A.C.E. - Design	<i>Richard S. Heller</i>	5/24/81	Traffic		
A.C.E. - Hydrology			Water	<i>Richard S. Heller</i>	5/24/81
DESIGNED BY R. J. T. DATE 2-20-81			DRAWN BY G. A. DATE 2-24-81		
CHECKED BY			DATE		
NO. DATE REMARKS			BY		
REVISIONS			DESIGN		
DRAWING NO. 1140			SHEET 2 OF 2		