


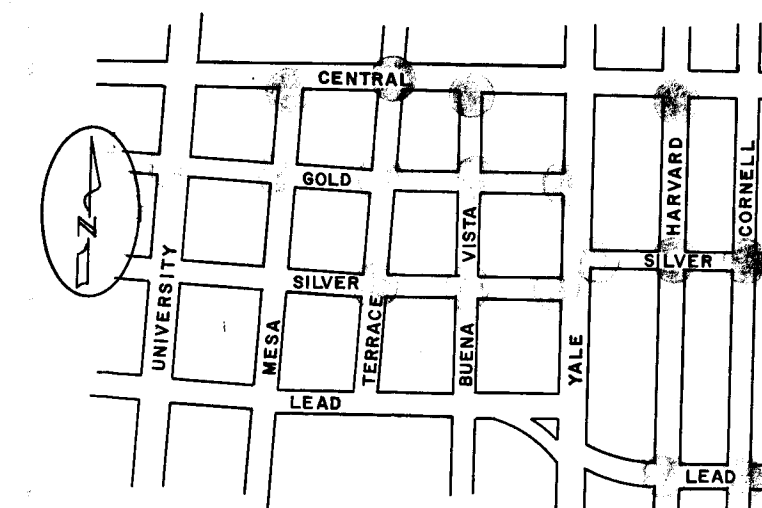

211 K-15/6

WHEEL CHAIR RAMPS
-FOR-
UNIVERSITY HEIGHTS NEIGHBORHOOD

30

×
×
×


1 2 3 4 5 6 7 8 9 10 11 12
26 1146 0183

APPROVAL OF AS BUILT DRAWINGS
ASST. CITY ENGINEER - FIELD
[Signature]
DATE 7.1.83


Richard S. Hill 3/18/82

1146


1146

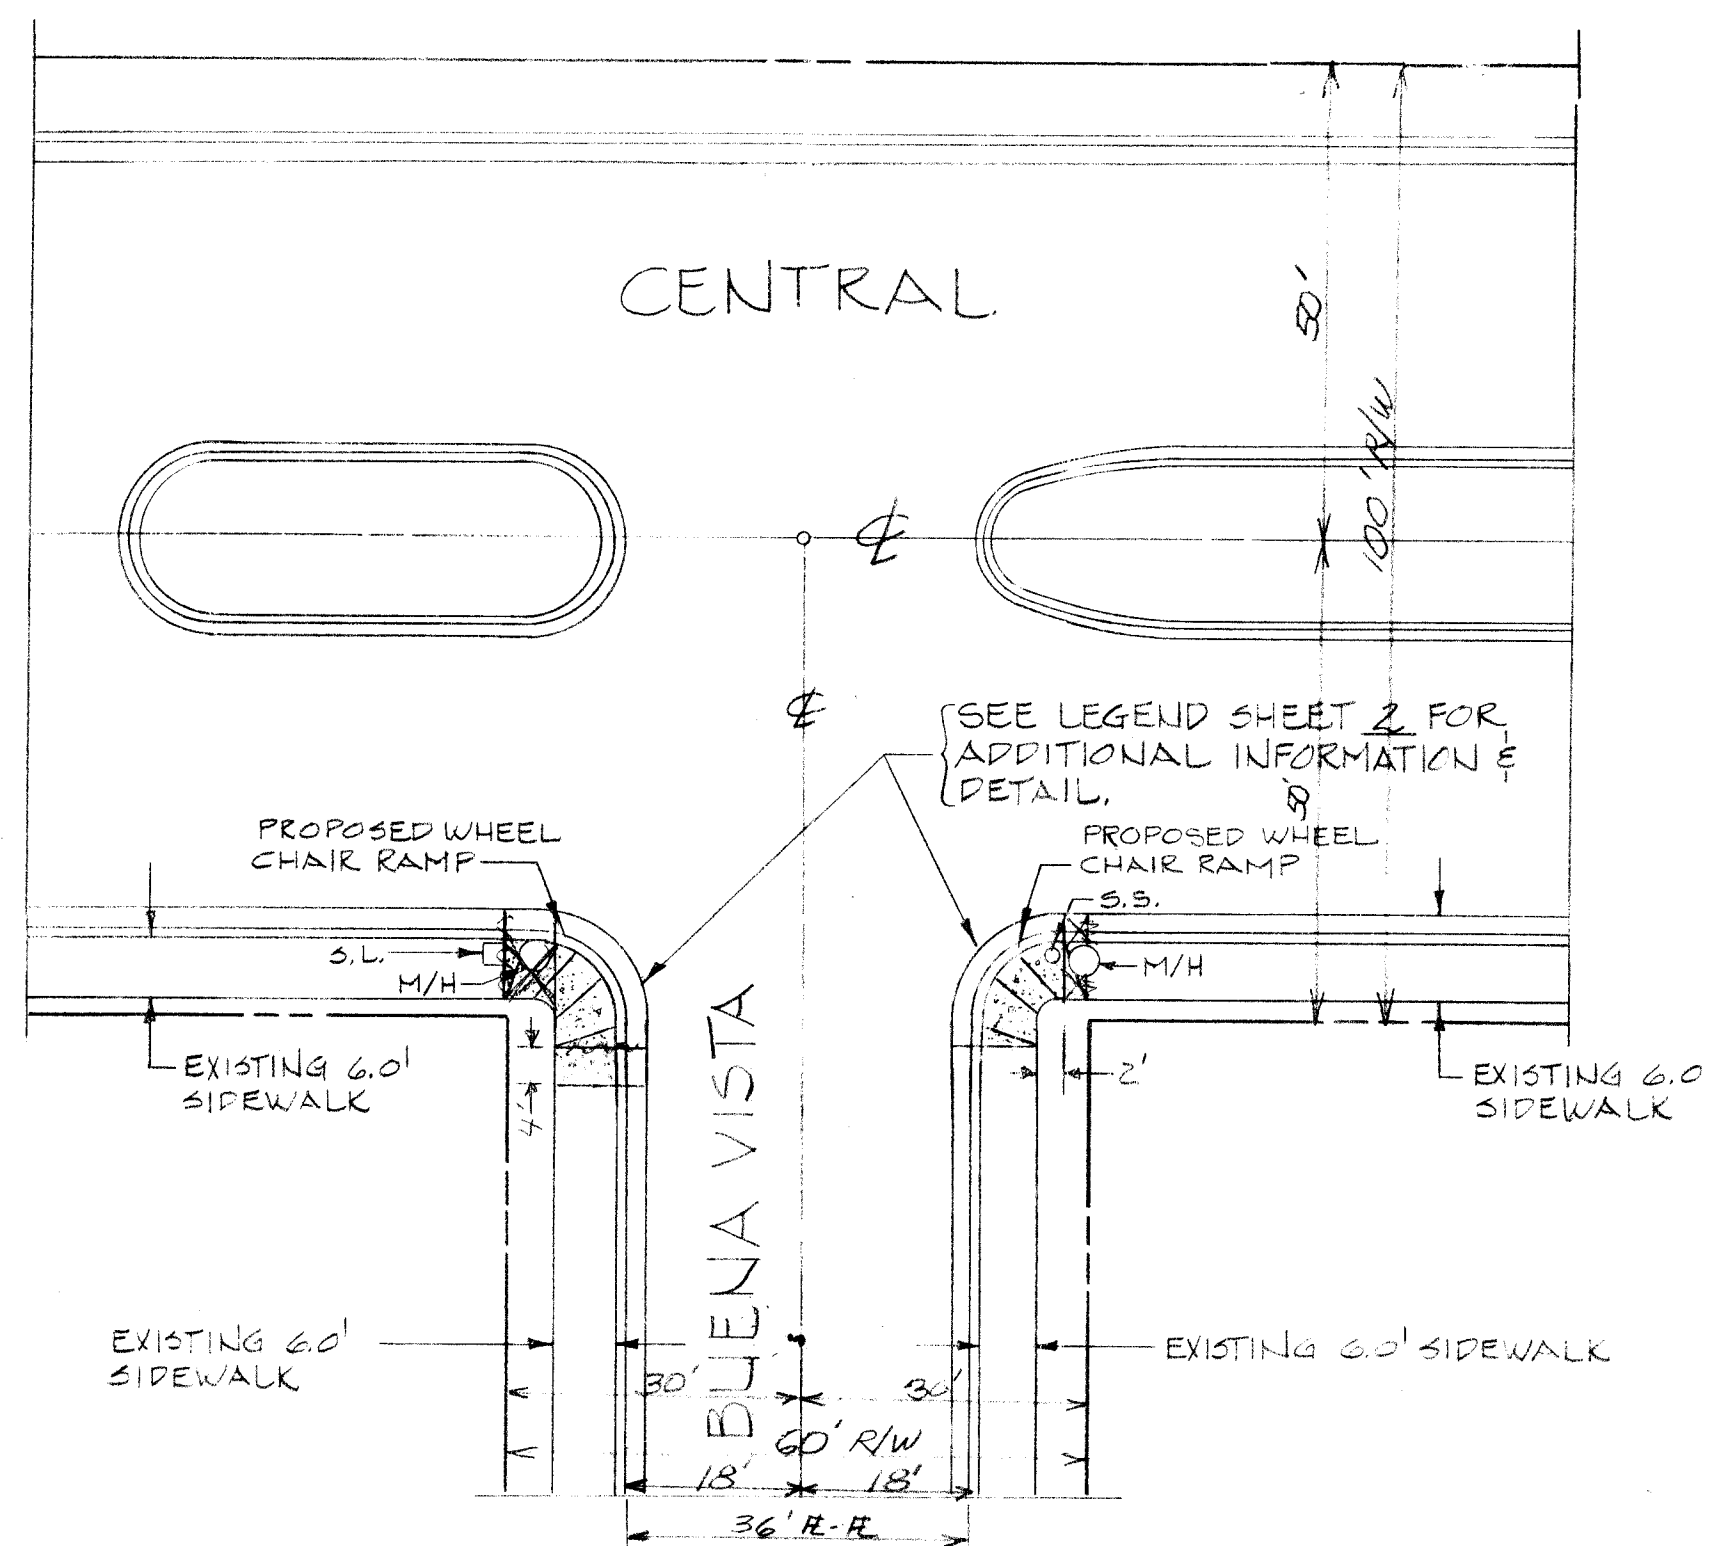


CENTRAL & BUENA VISTA
SCALE: 1"=20'

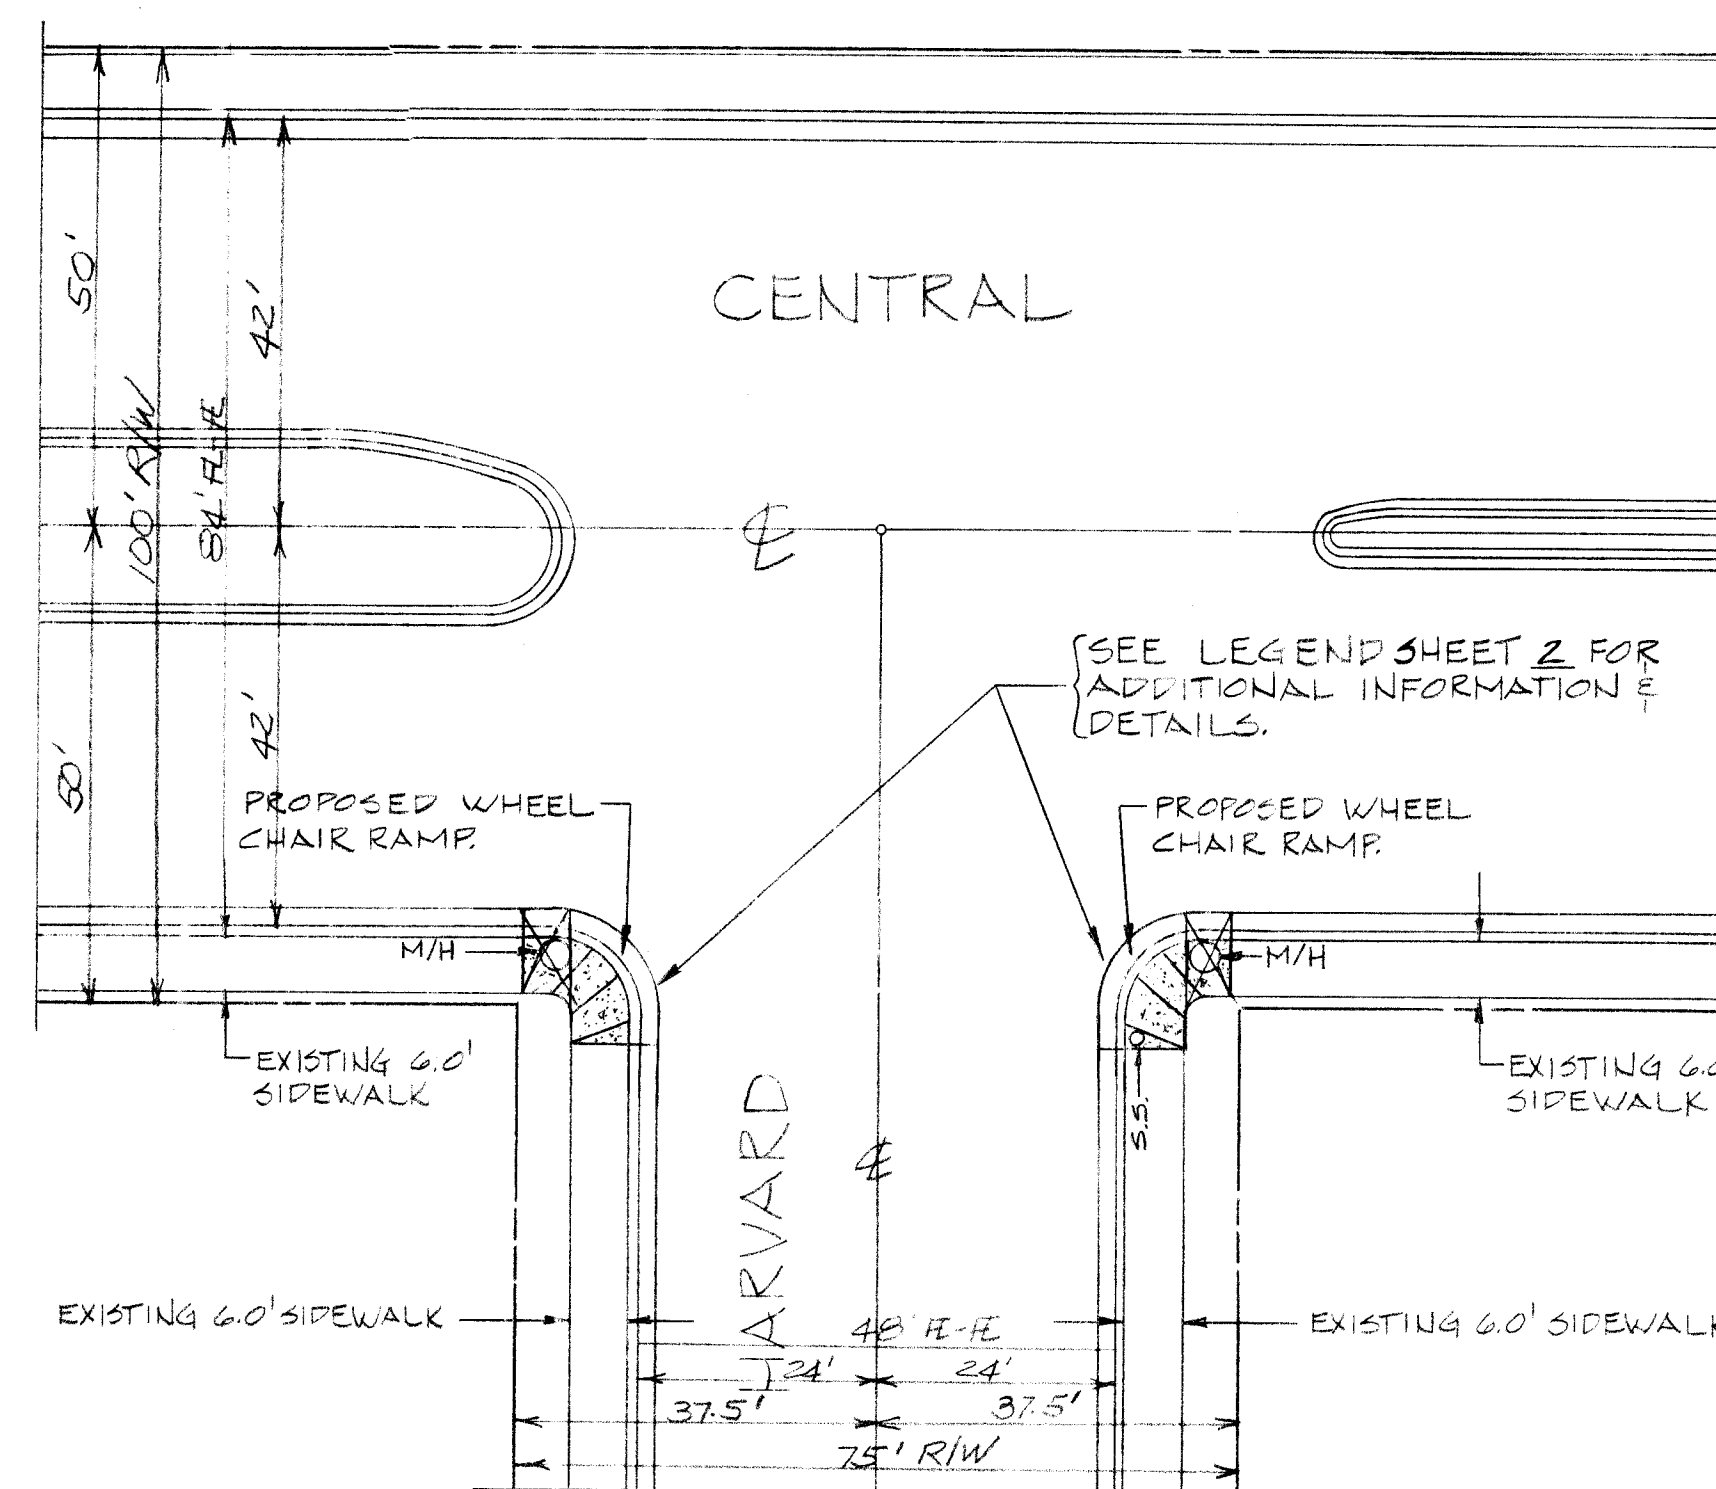


CENTRAL & HARVARD
SCALE: 1"=20'

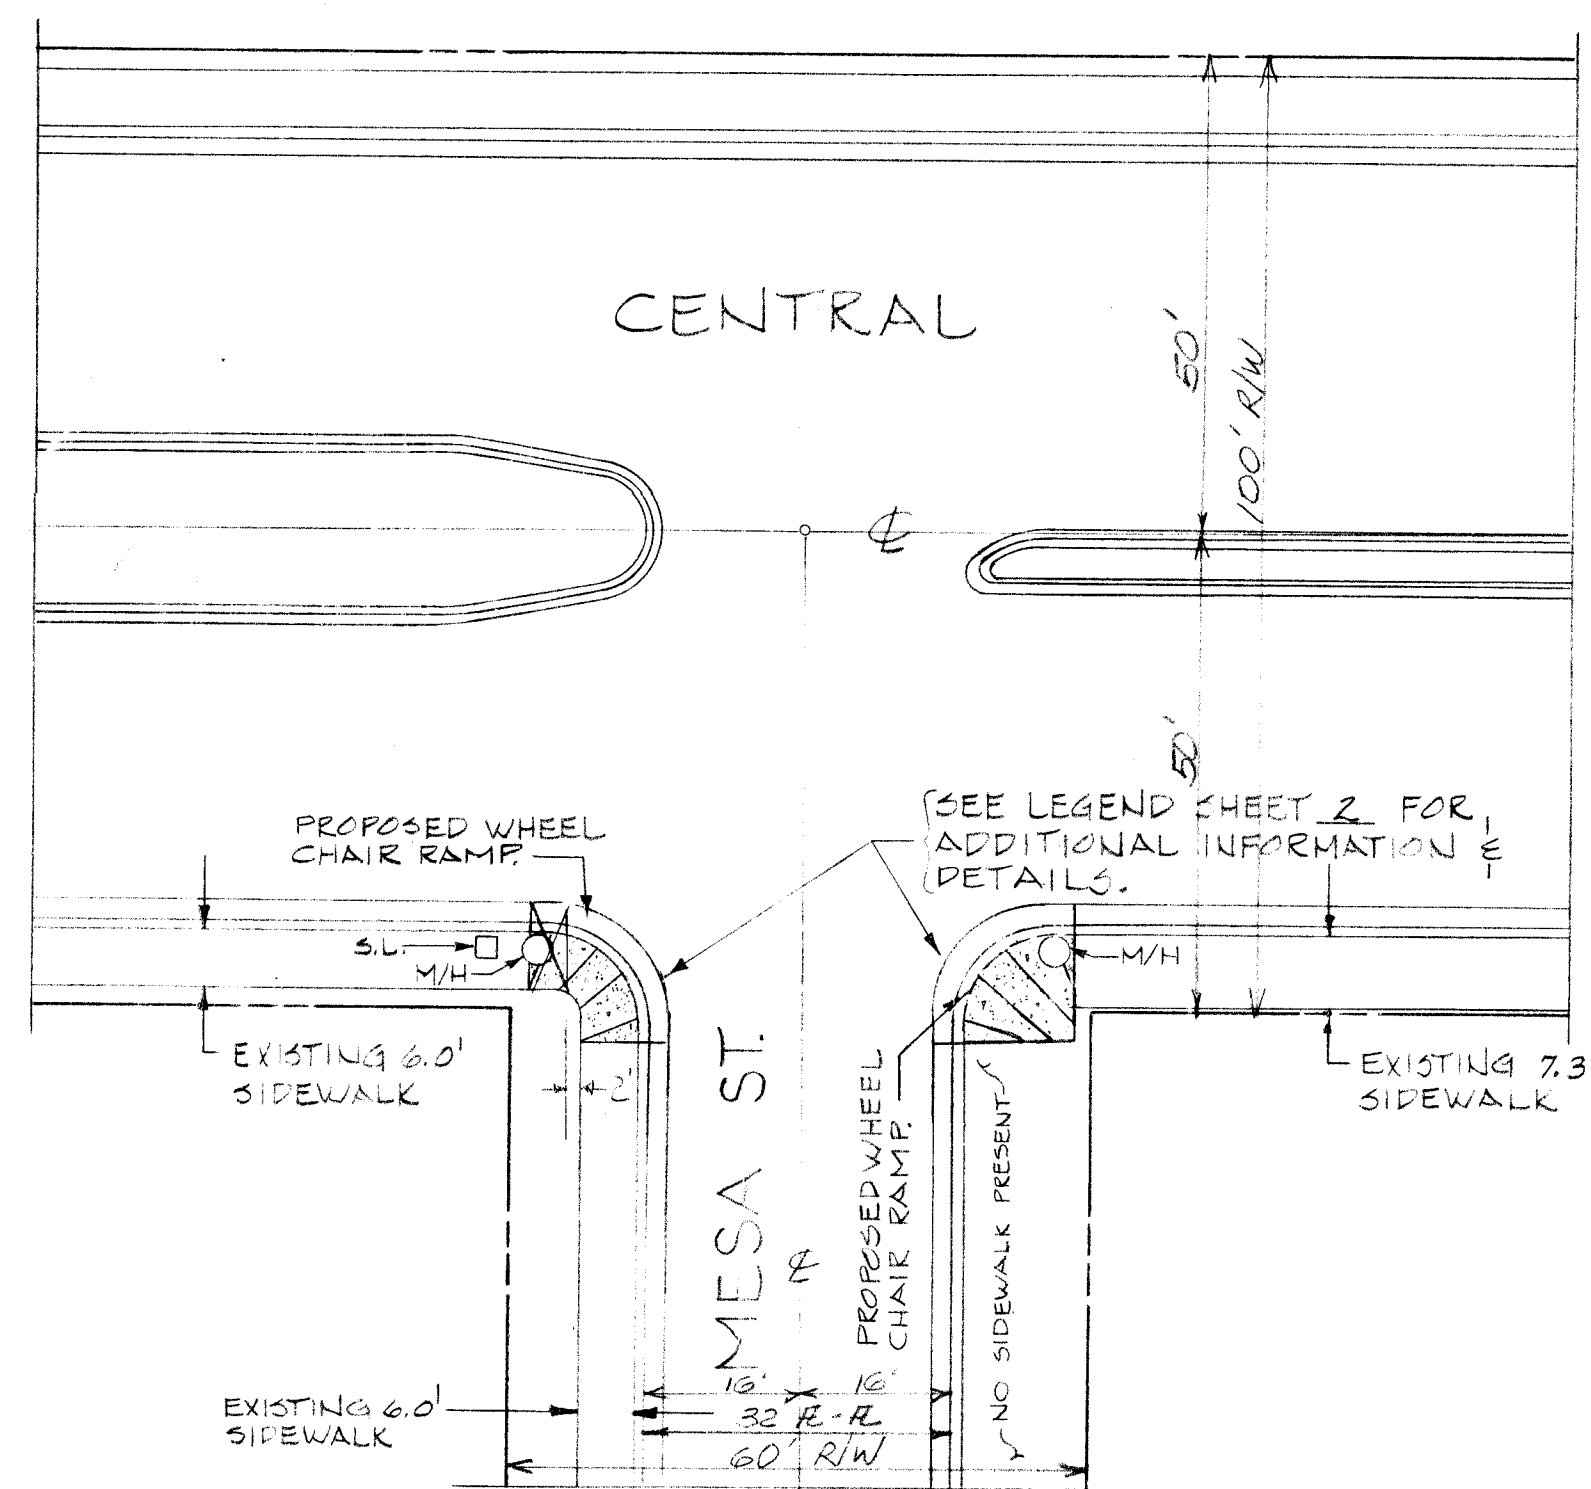

CENTRAL & MESA
SCALE: 1"=20'

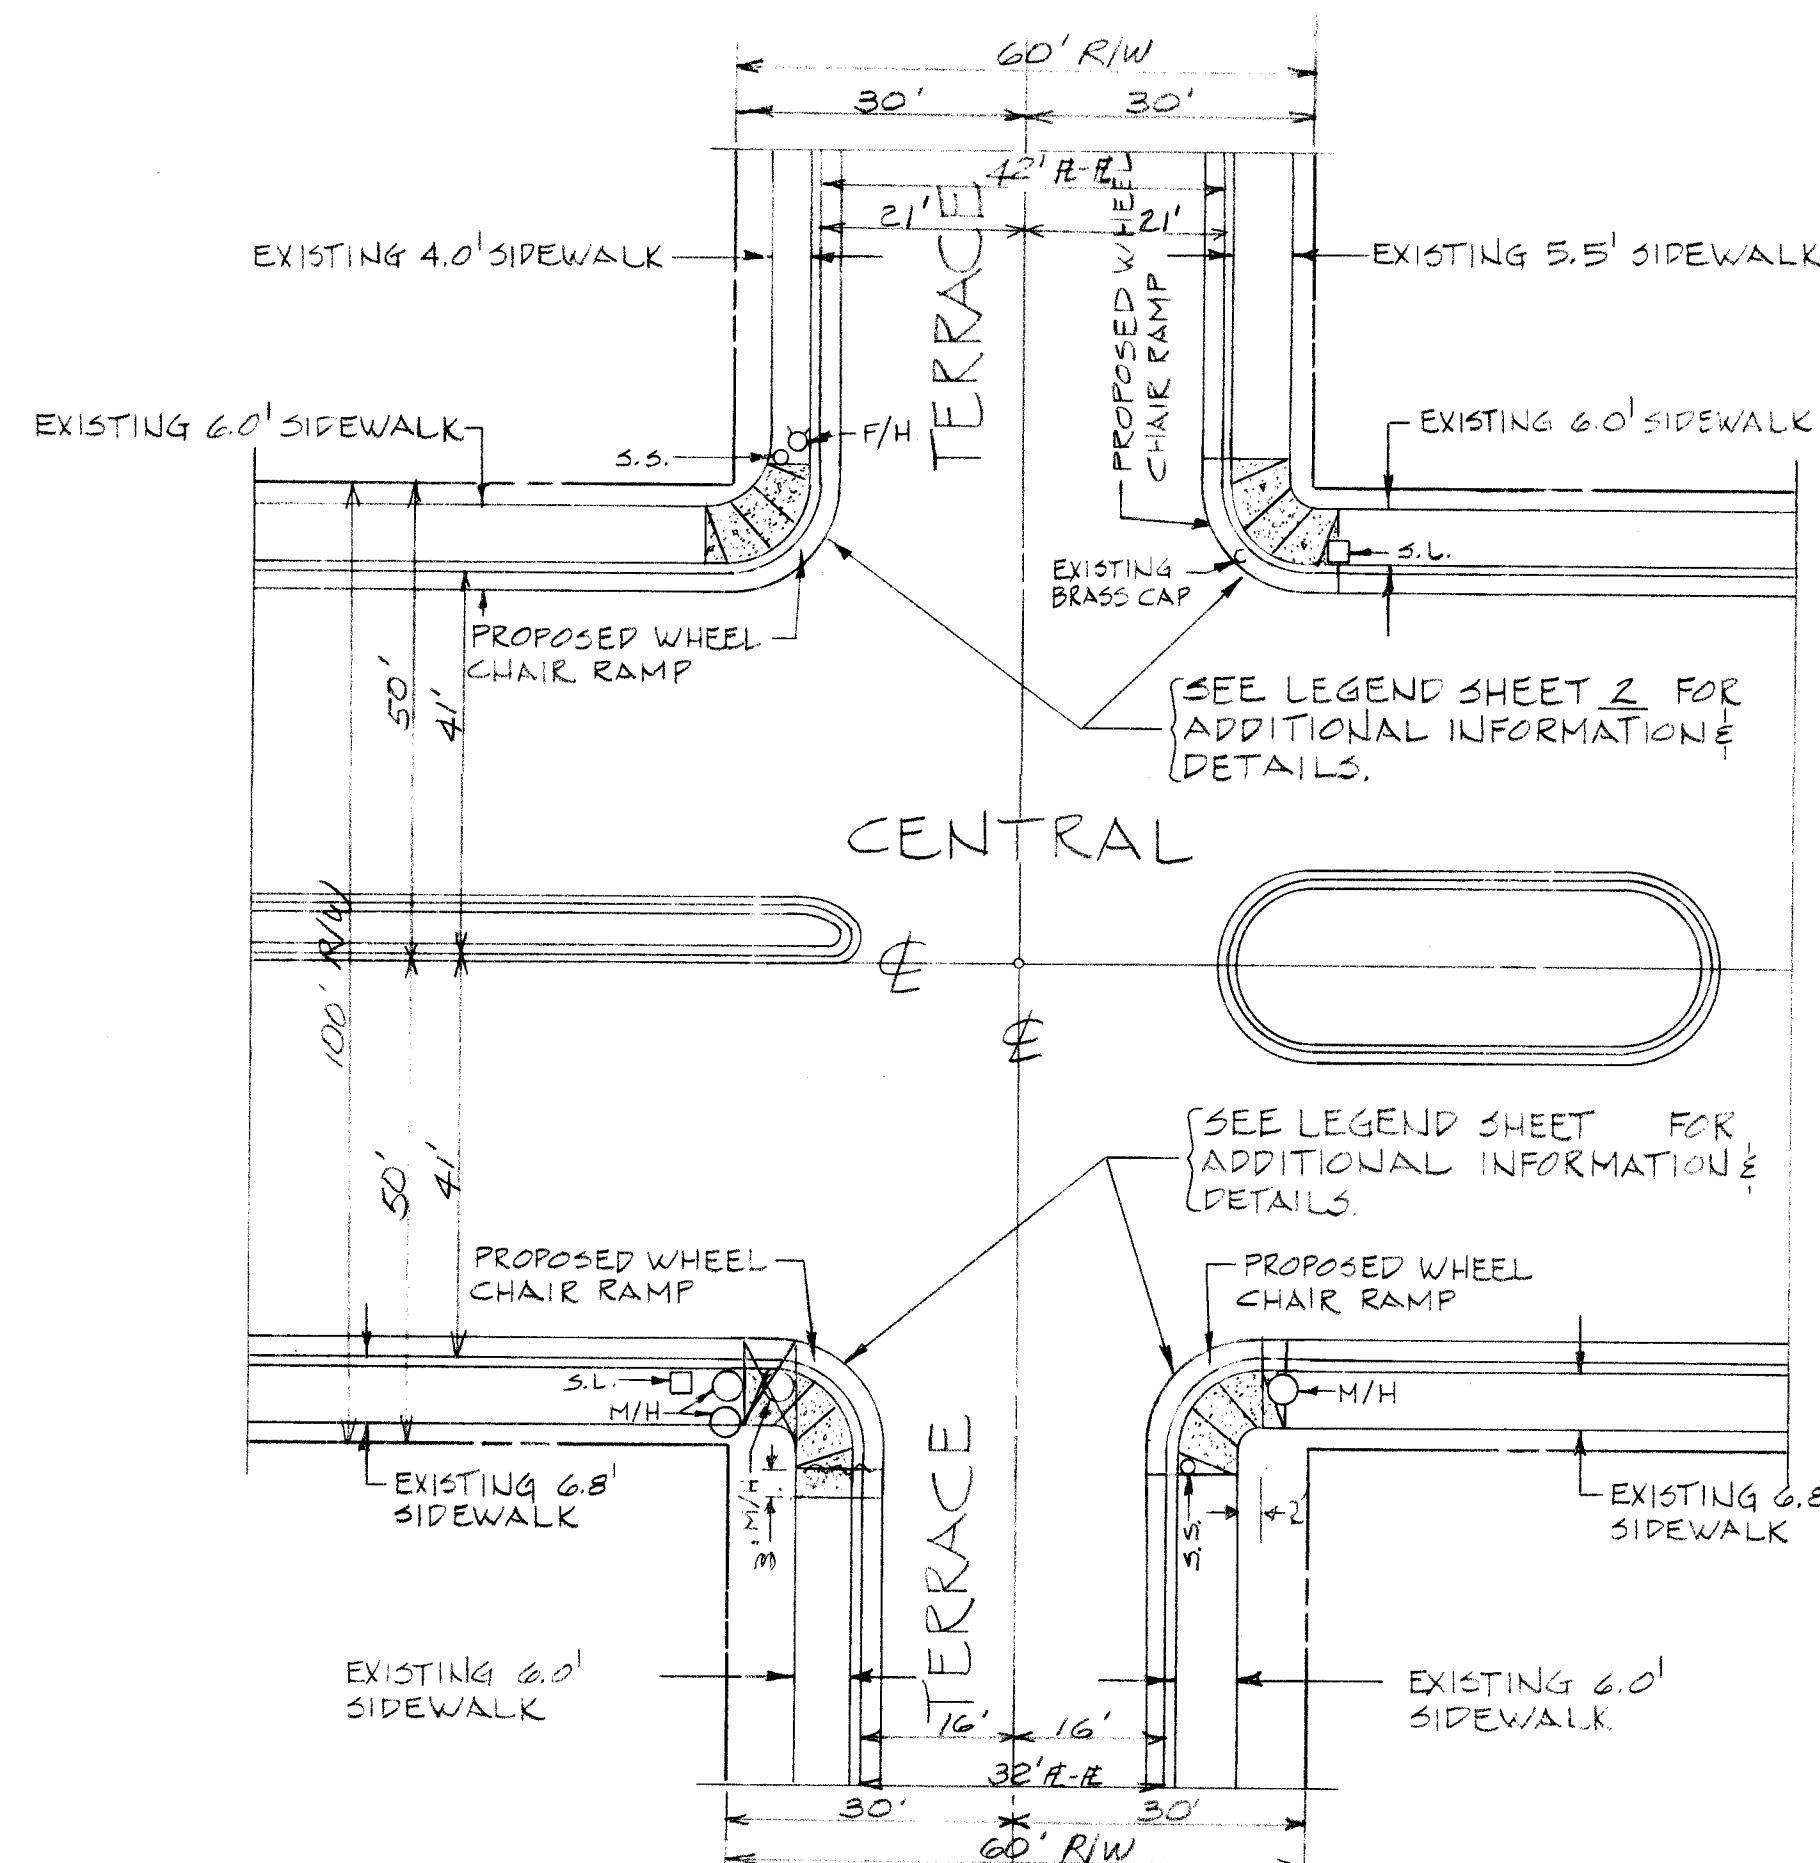

CENTRAL & TERRACE
SCALE: 1"=20'

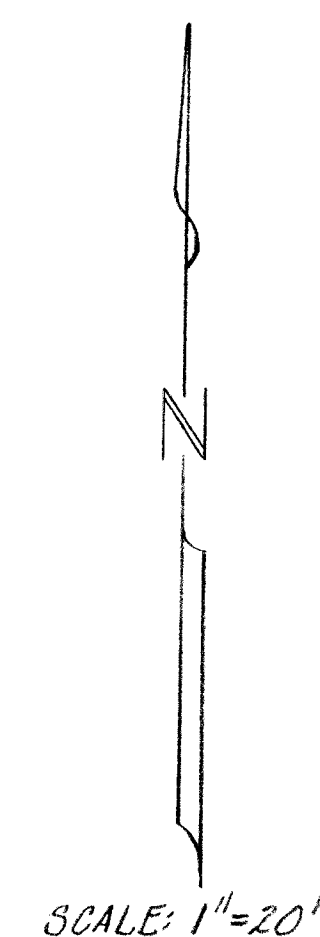


LEGEND:


- O-M/H EXISTING MANHOLE
NOTE: WHERE EXISTING MANHOLE LIES WITHIN A PROPOSED WHEEL CHAIR RAMP LOCATION M/H COVER IS TO BE ADJUSTED TO NEW FINISHED GRADE.
- O-PP EXISTING POWER POLE
NOTE: WHERE EXISTING POWER POLE LIES WITHIN A PROPOSED WHEEL CHAIR RAMP LOCATION PP IS TO BE RELOCATED BY PUBLIC SERVICE CO. OF NEW MEX.
- O-S.S. EXISTING STREET SIGNS (STOP SIGN, ONE WAY ETC.)
NOTE: WHERE EXISTING STREET SIGN LIES WITHIN A PROPOSED WHEEL CHAIR RAMP LOCATION S.S. IS TO BE RELOCATED BY CITY TRAFFIC ENGINEER.
- S.L. EXISTING STREET LIGHTS
- U-F/H EXISTING FIRE HYDRANT

NOTE:

1. ALL PROPOSED WHEEL CHAIR RAMP ARE TO BE BUILT IN ACCORDANCE WITH CONTRACT DOCUMENTS FOR CITY-WIDE UTILITIES AND CASH PAVING NO. 30. DRAWING NO. DWG P-17-1.
2. ALL AREAS WHERE GRASS, GRAVEL, ASPHALT, BLOCK OR DIRT IS INDICATED IS EXISTING. WHERE THESE AREAS ARE TO BE DISTURBED FOR CONSTRUCTION ARE TO BE REPLACED OR RESTORED TO ORIGINAL CONDITION PRIOR TO CONSTRUCTION.
3. CURB & GUTTER IS EXISTING IN ALL PROPOSED WHEEL CHAIR RAMP LOCATIONS. CURB & GUTTER IS TO BE REMOVED & REPLACED TO FINISH GRADE OF PROPOSED GRADE.

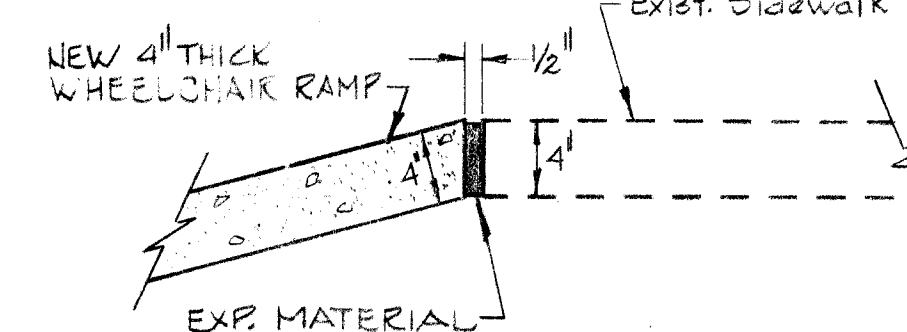

TYPICAL EXPANSION JOINT, WHEELCHAIR TO SIDEWALK DETAIL
SCALE: 1"=10'

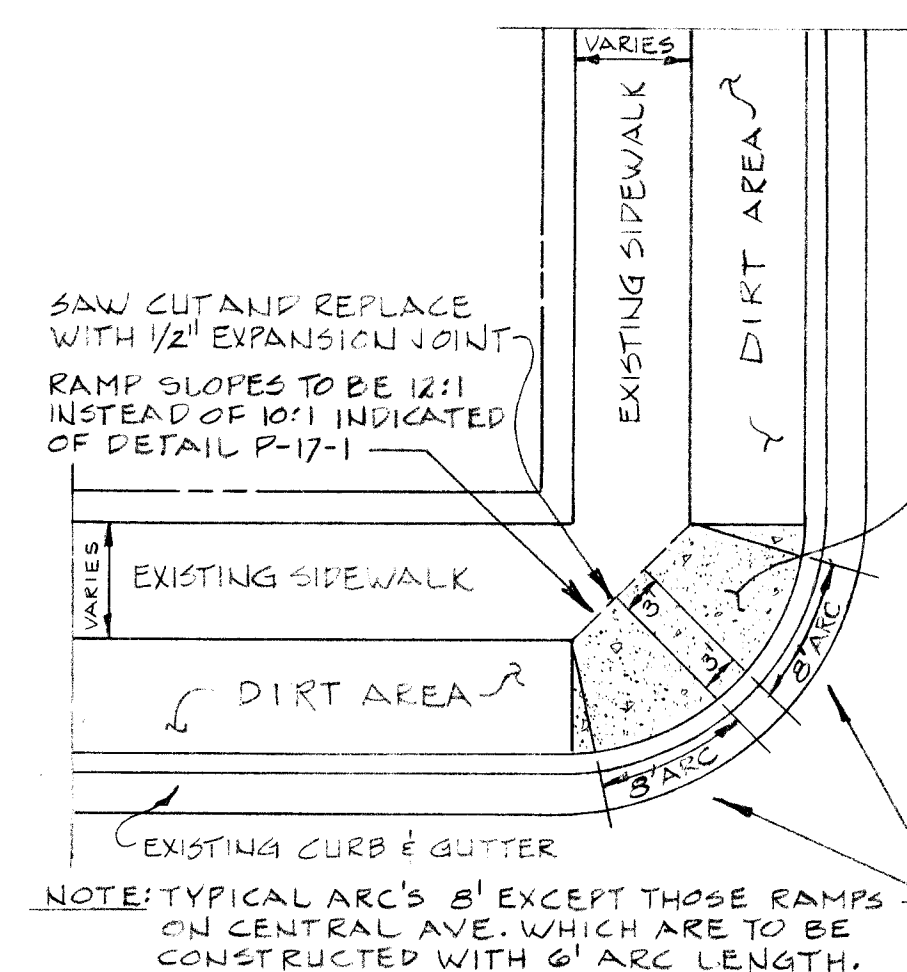

TYPICAL RAMP SCALE: 1"=10'
FOR ADDITIONAL INFORMATION ON DETAIL SEE STD. DWG. P-17-1 BIK-BIK30 REVISED 1-26-81.

EXISTING CONCRETE AREA TO BE REMOVED & REPLACED WITH NEW WHEEL CHAIR RAMP. WHERE DIRT EXISTS AREA IS TO BE COMPACTED AS PER STANDARD BLK TO BLK DETAIL DWG P-17-1.

26 1146 0288

CLINIQUE
MAINTENANCE DEPARTEMENT
CONSTRUCTION DIVISION

WHEEL CHAIR RAMP FOR UNIVERSITY HEIGHTS NEIGHBORHOOD







26 1146 0288

R.A. JENNIFER 1/20/81

1146

K-15, 10

2

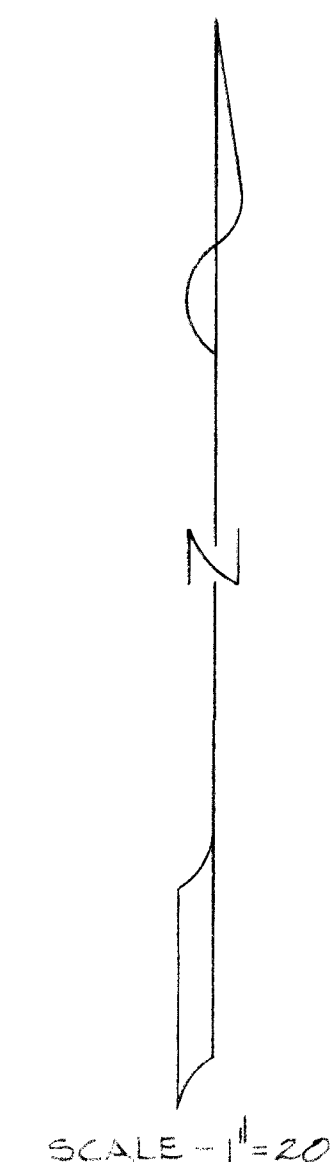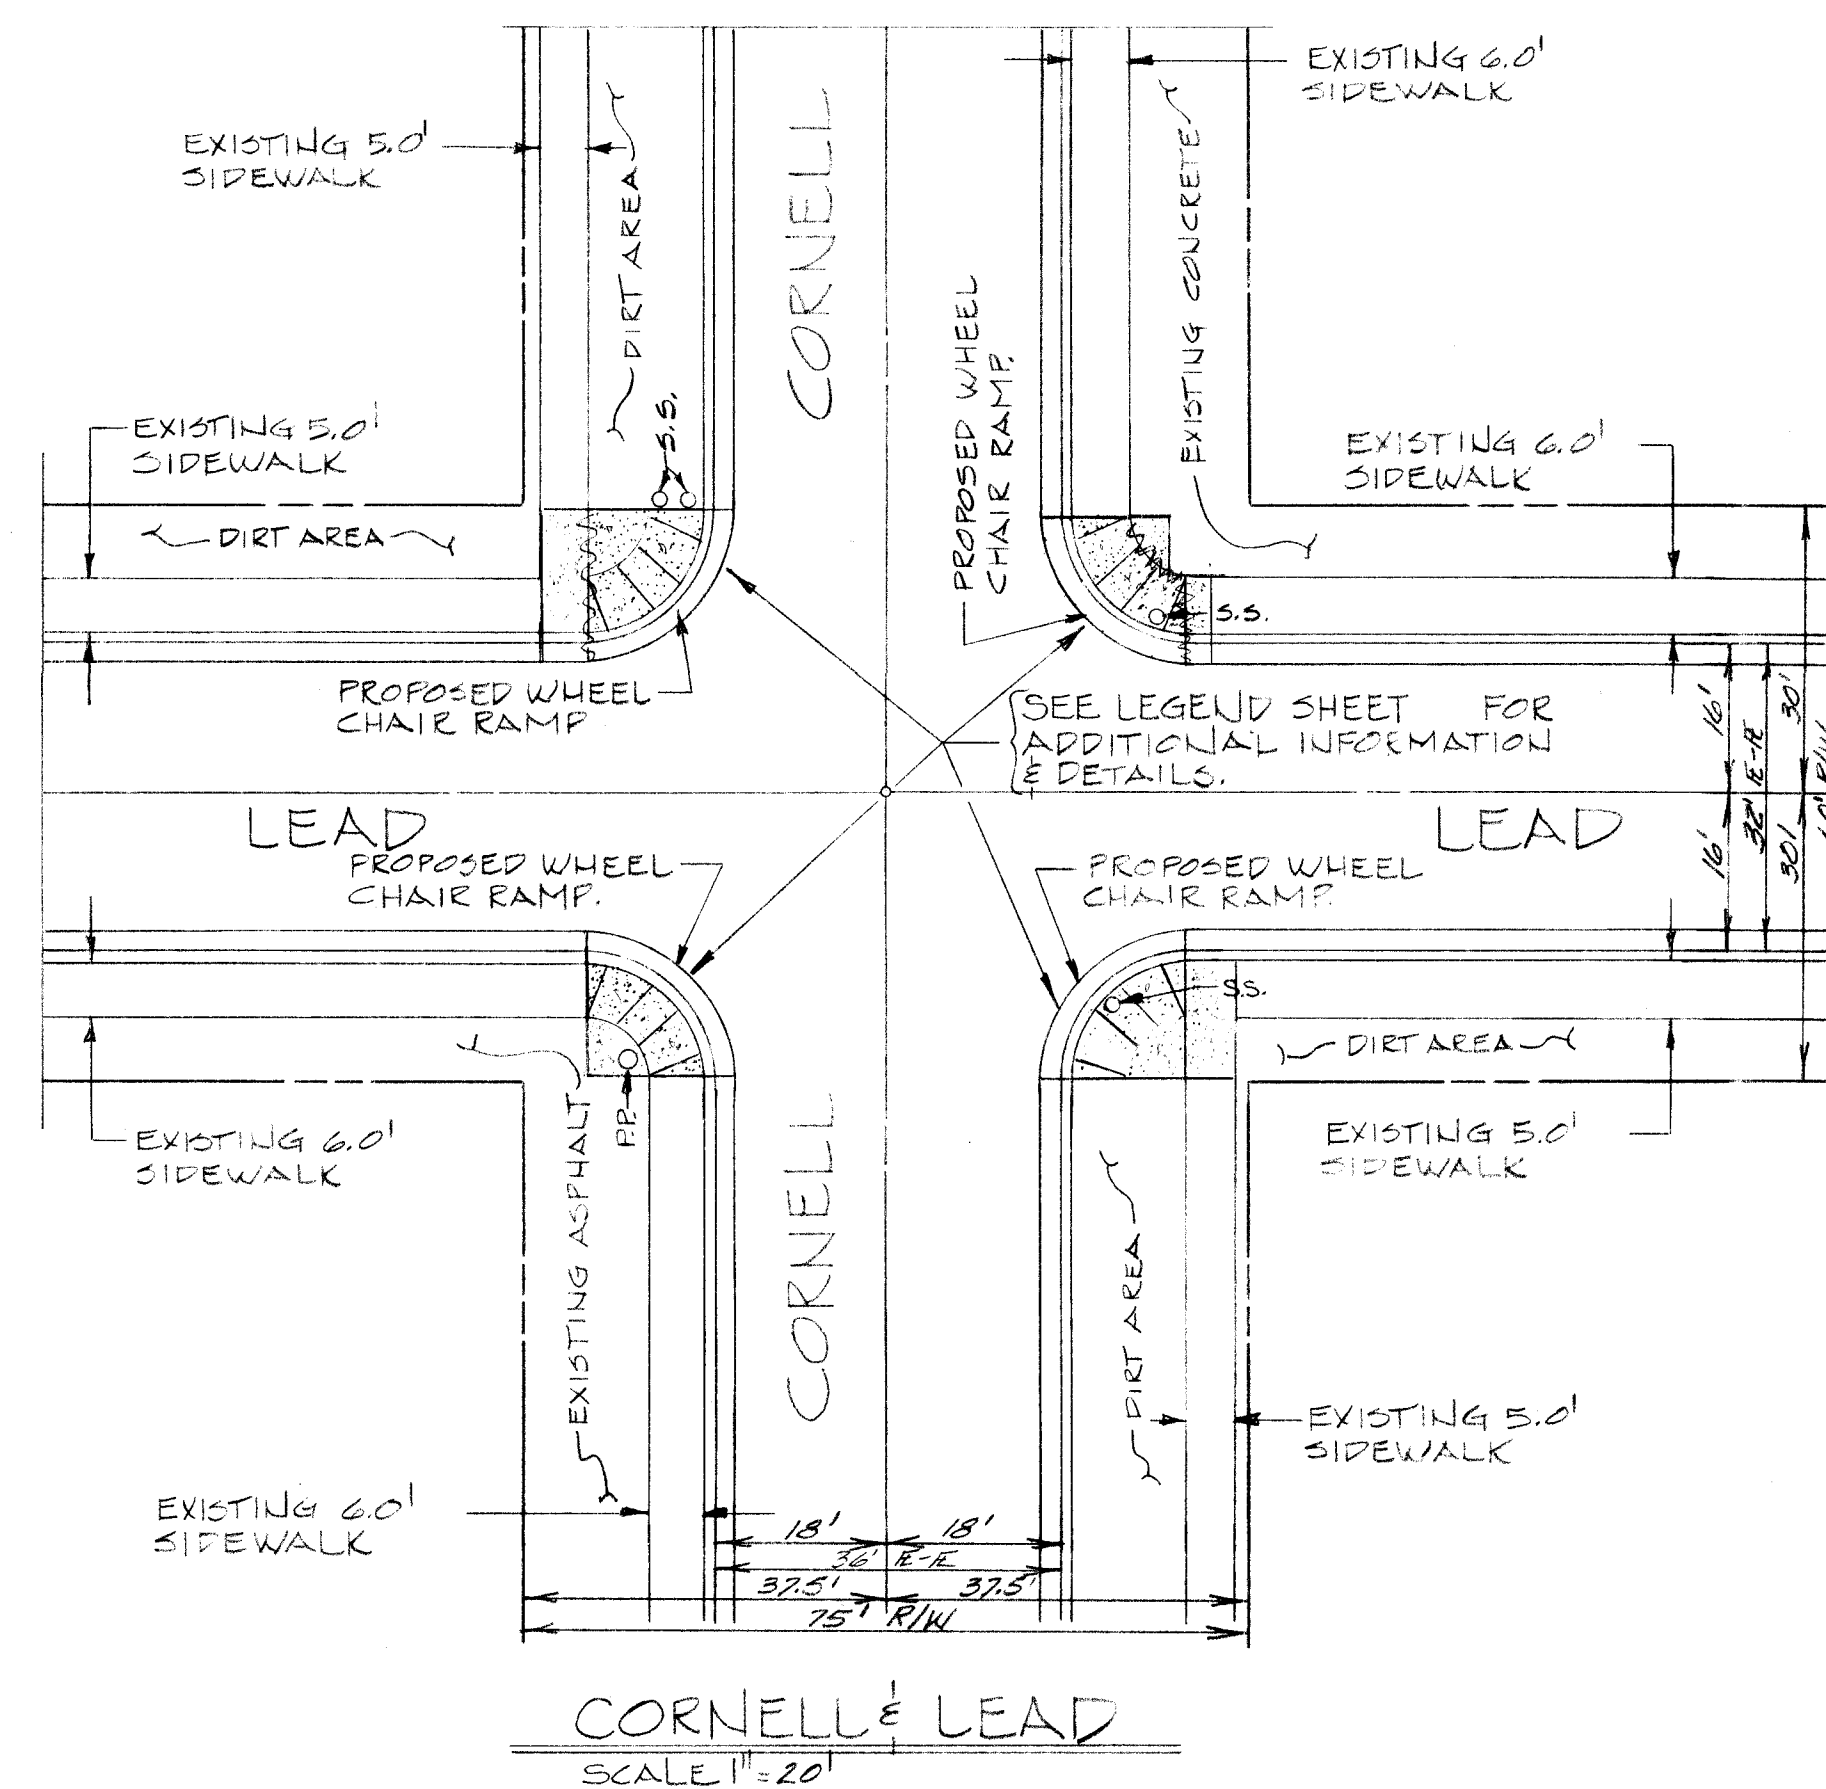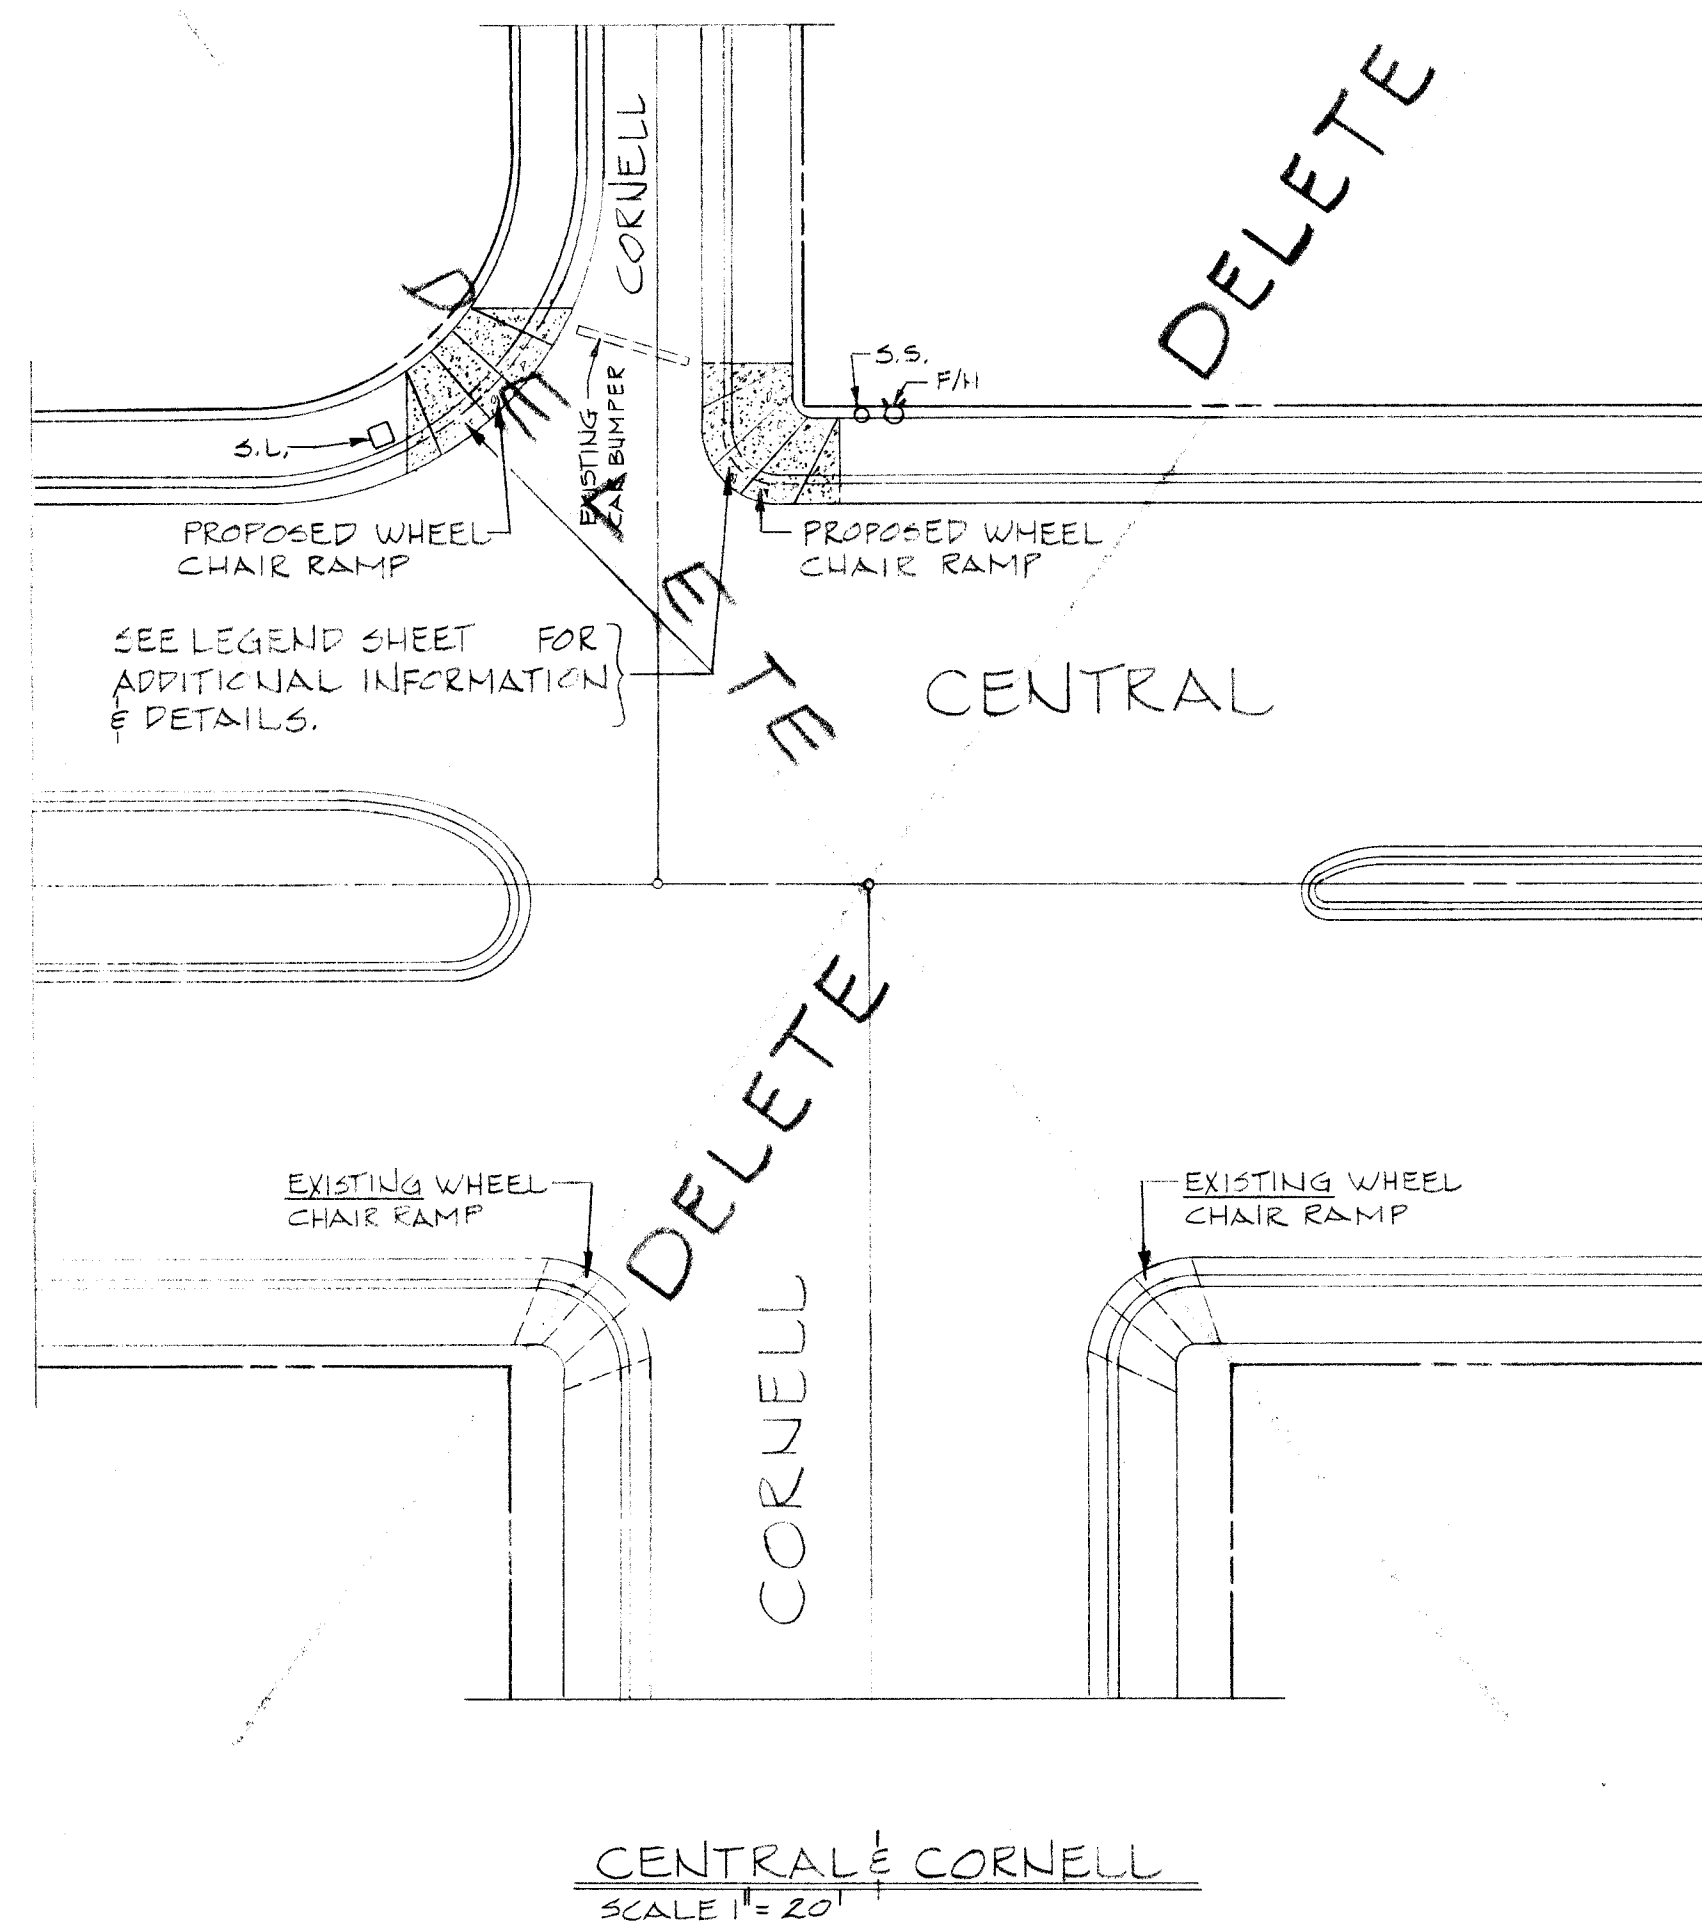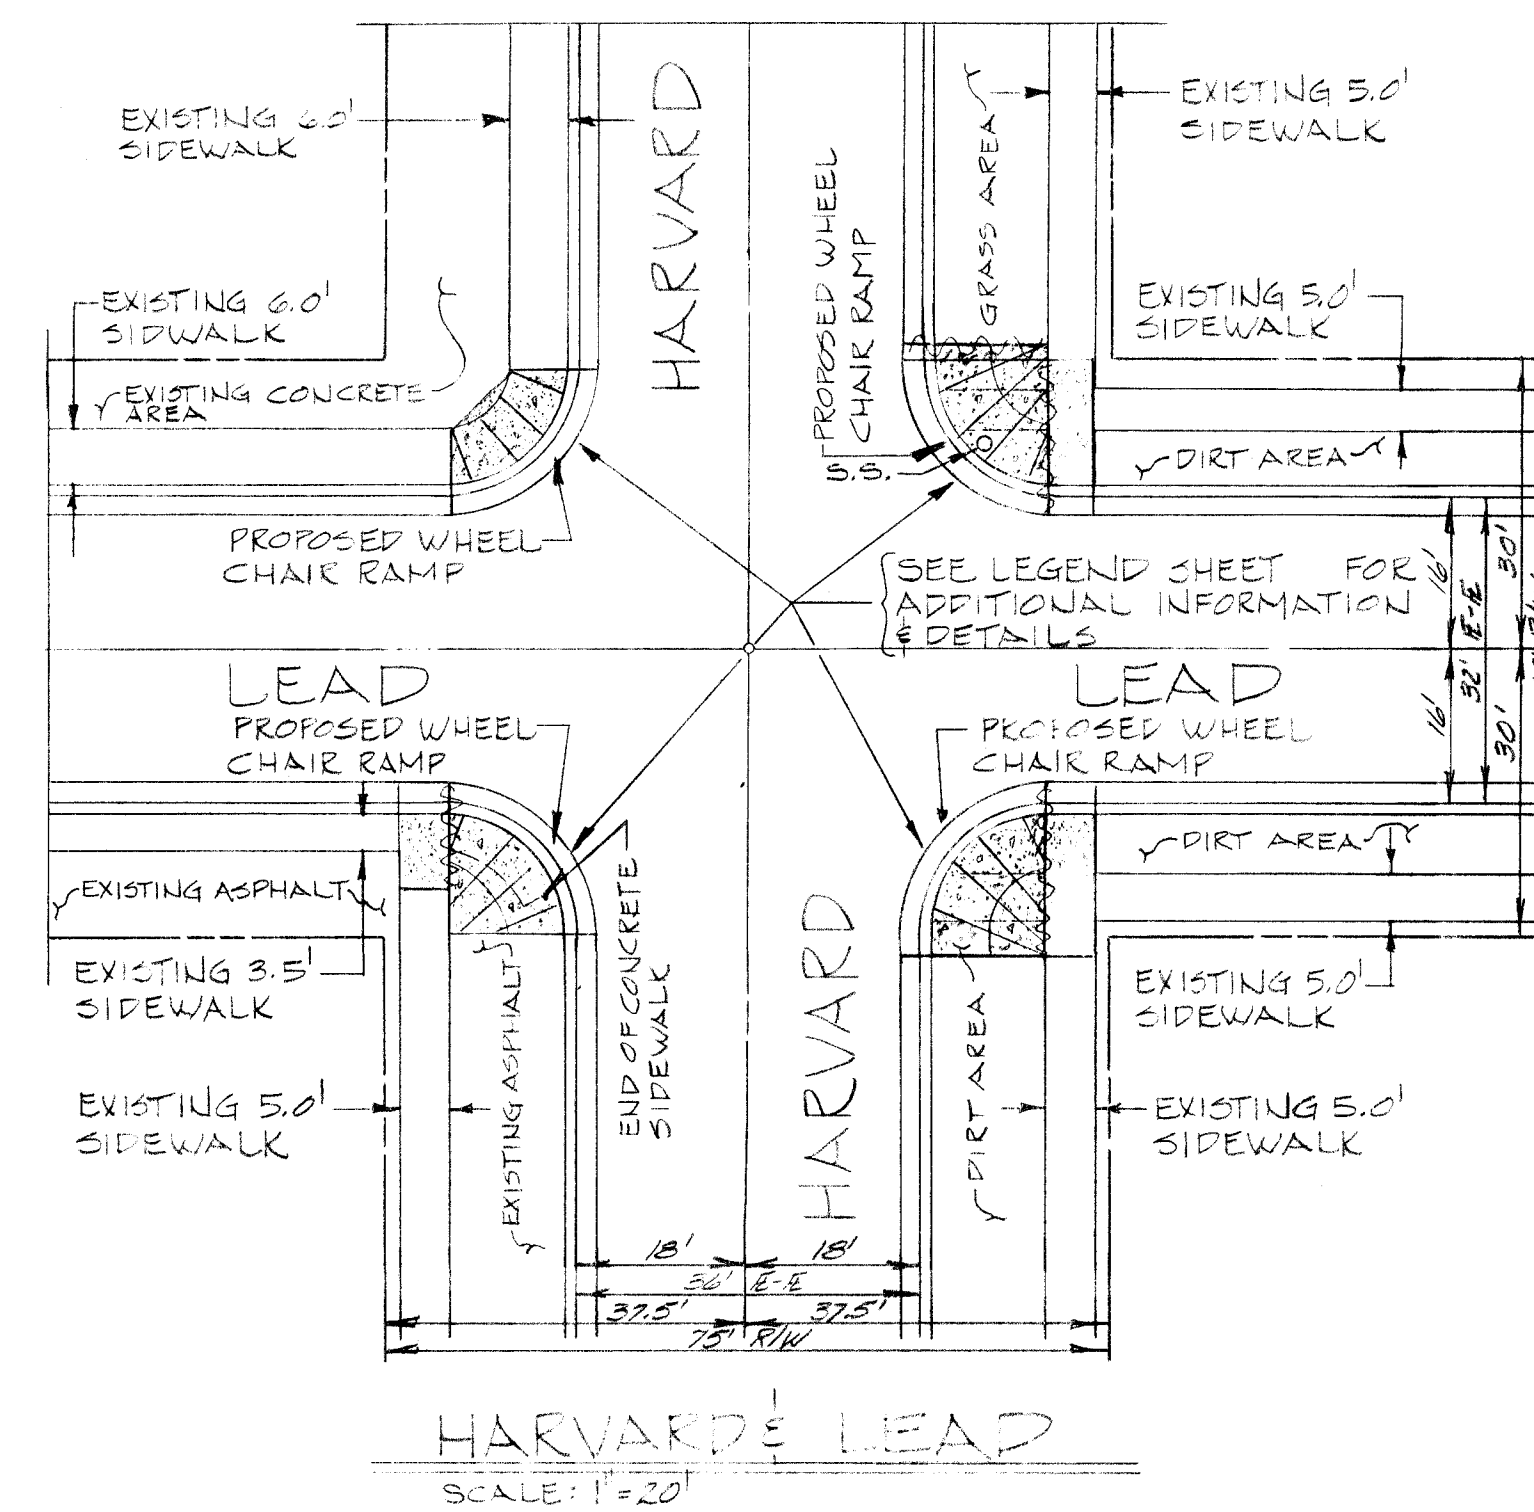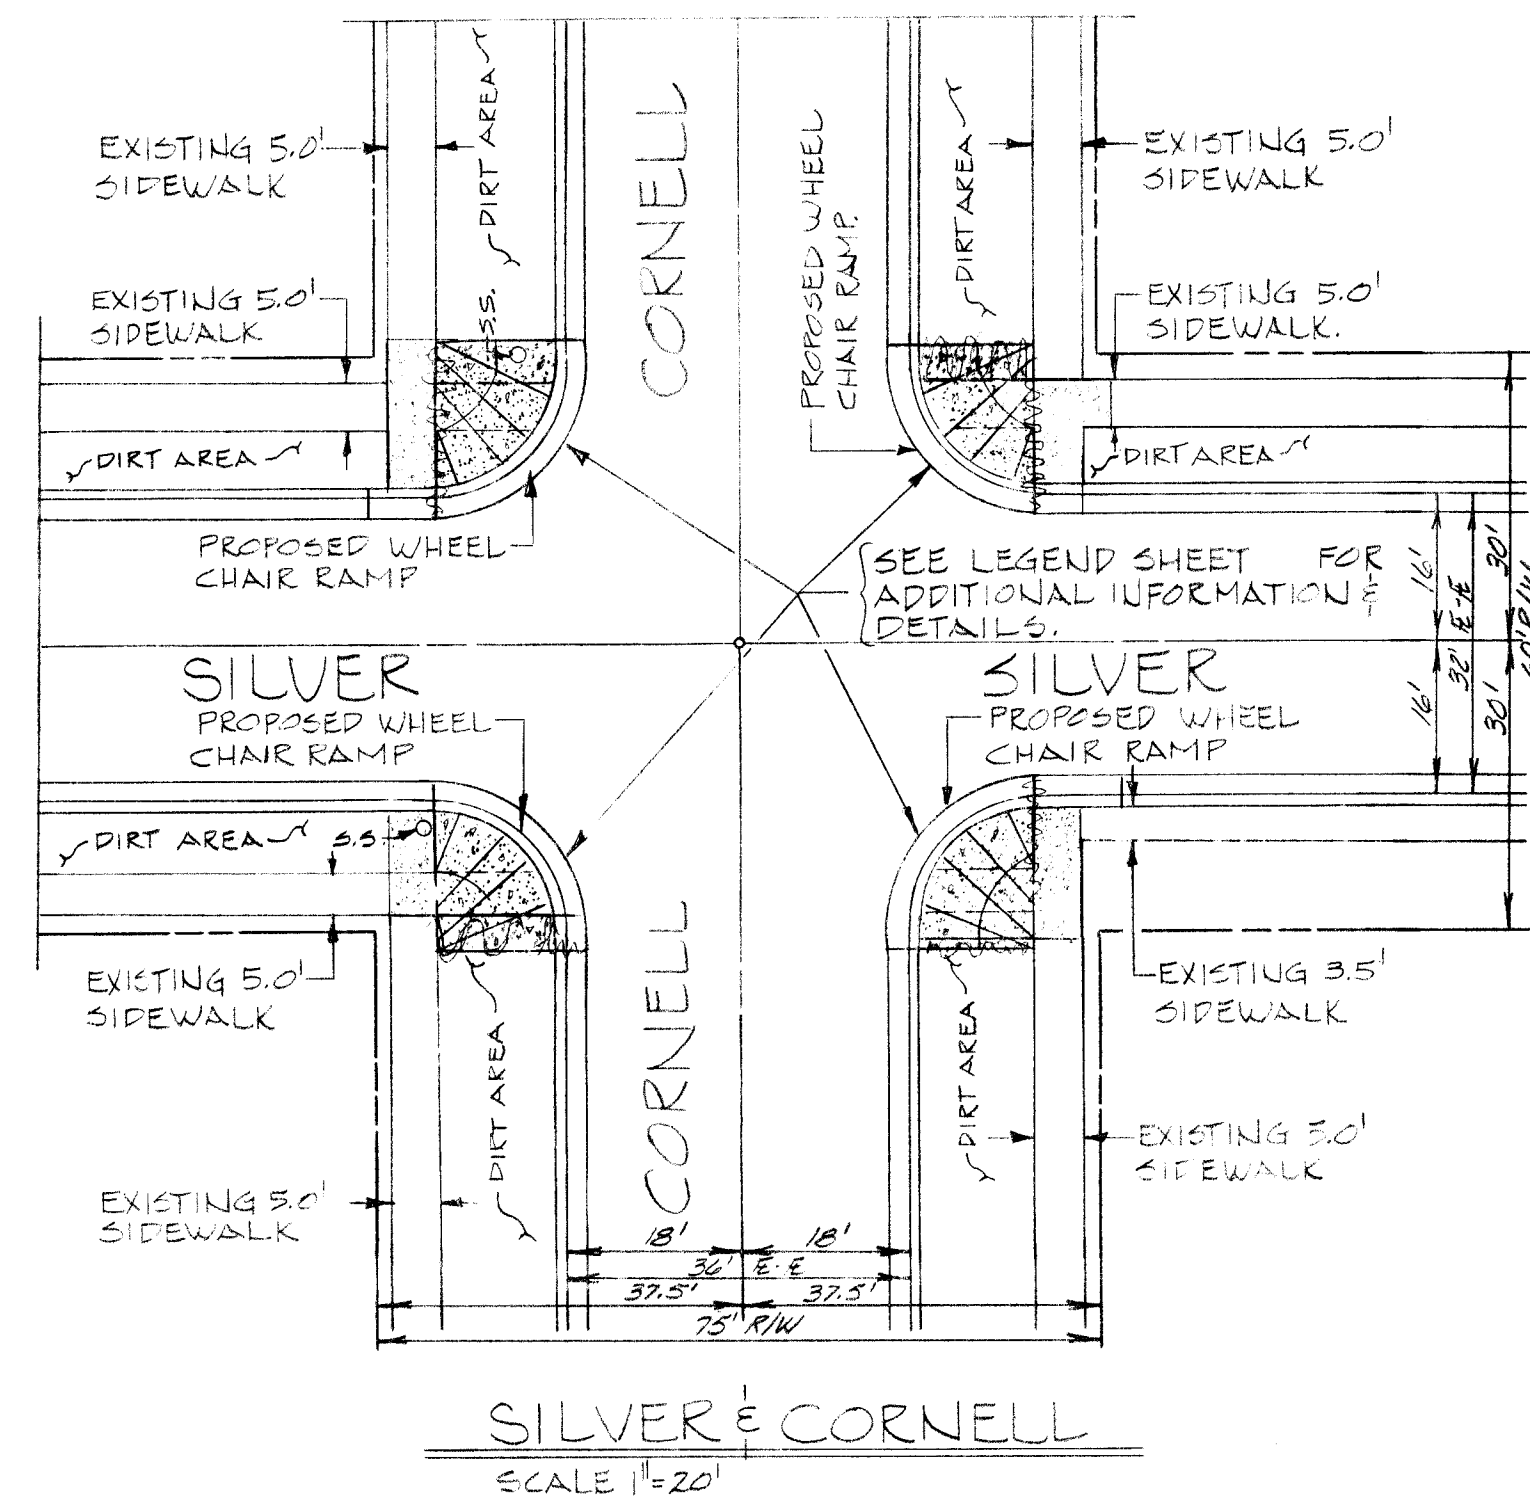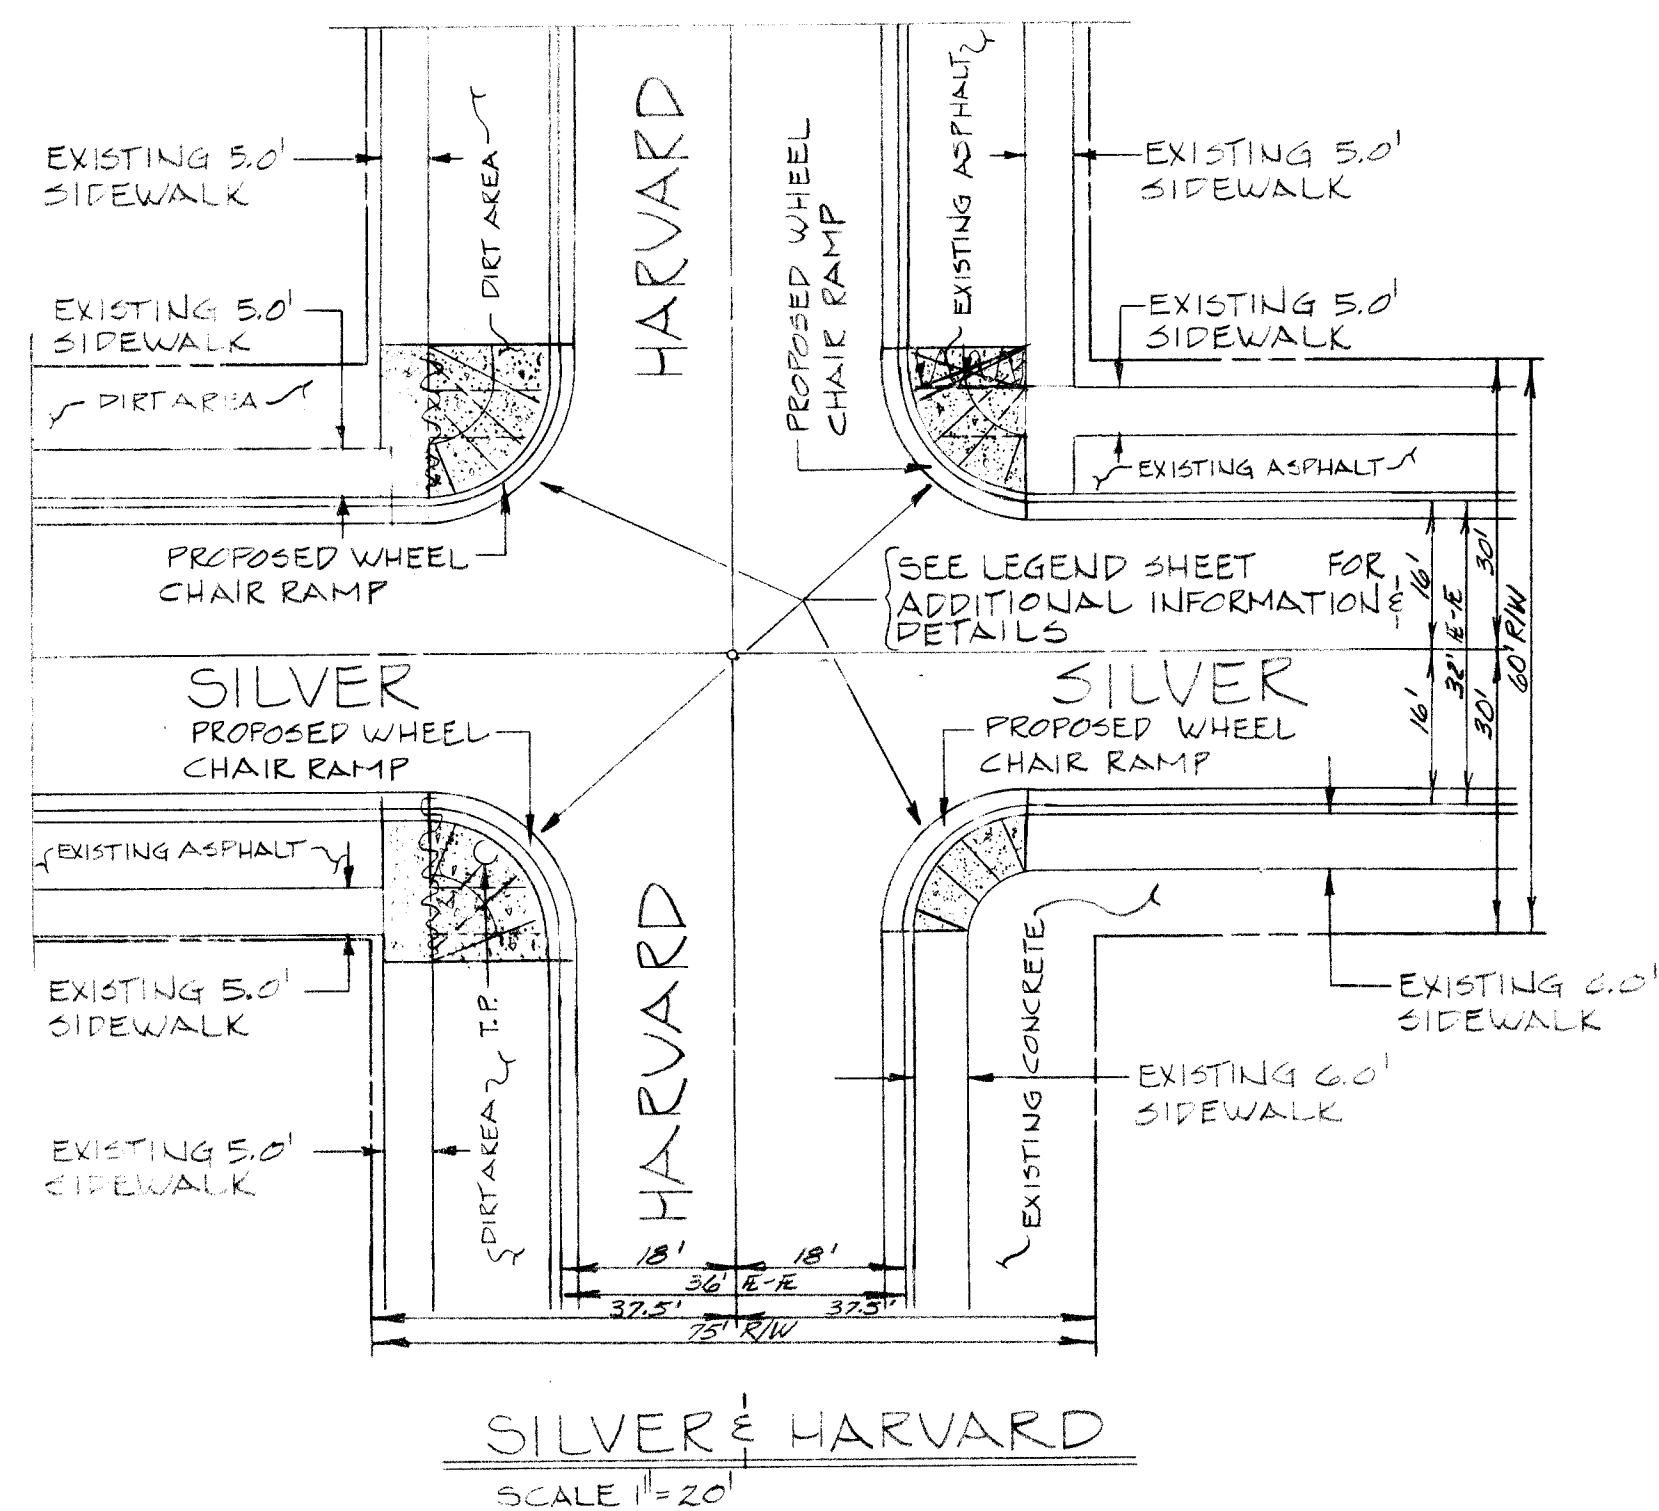

26 1146 0383

CITY OF ALBUQUERQUE
TRANSPORTATION DEPARTMENT
ENGINEERING DIVISION

TITLE: WHEEL CHAIR RAMPS FOR UNIVERSITY HEIGHTS NEIGHBORHOOD

DESIGNED BY	CHECKED BY	DATE	DESIGNED BY	CHECKED BY	DATE
g. h. h.	5/16/02	11/10/02	RA. J. J.		







1146

MAP NO. K-15, 16 SHEET 3 OF 5

DATE: 11/10/02
BY: T. J. J.
CHECKED BY: T. J. J.
DATE: 11/10/02

DATE: 11/10/02
BY: T. J. J.
CHECKED BY: T. J. J.
DATE: 11/10/02

DATE: 11/10/02
BY: T. J. J.
CHECKED BY: T. J. J.
DATE: 11/10/02

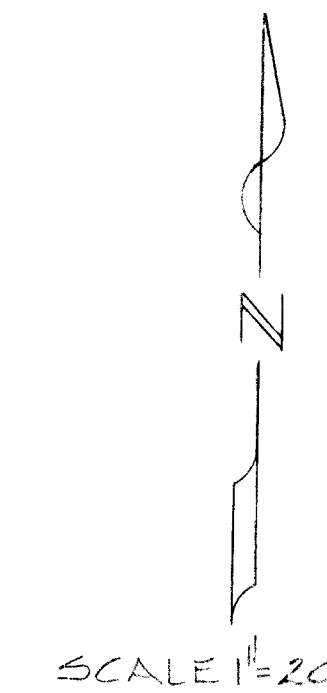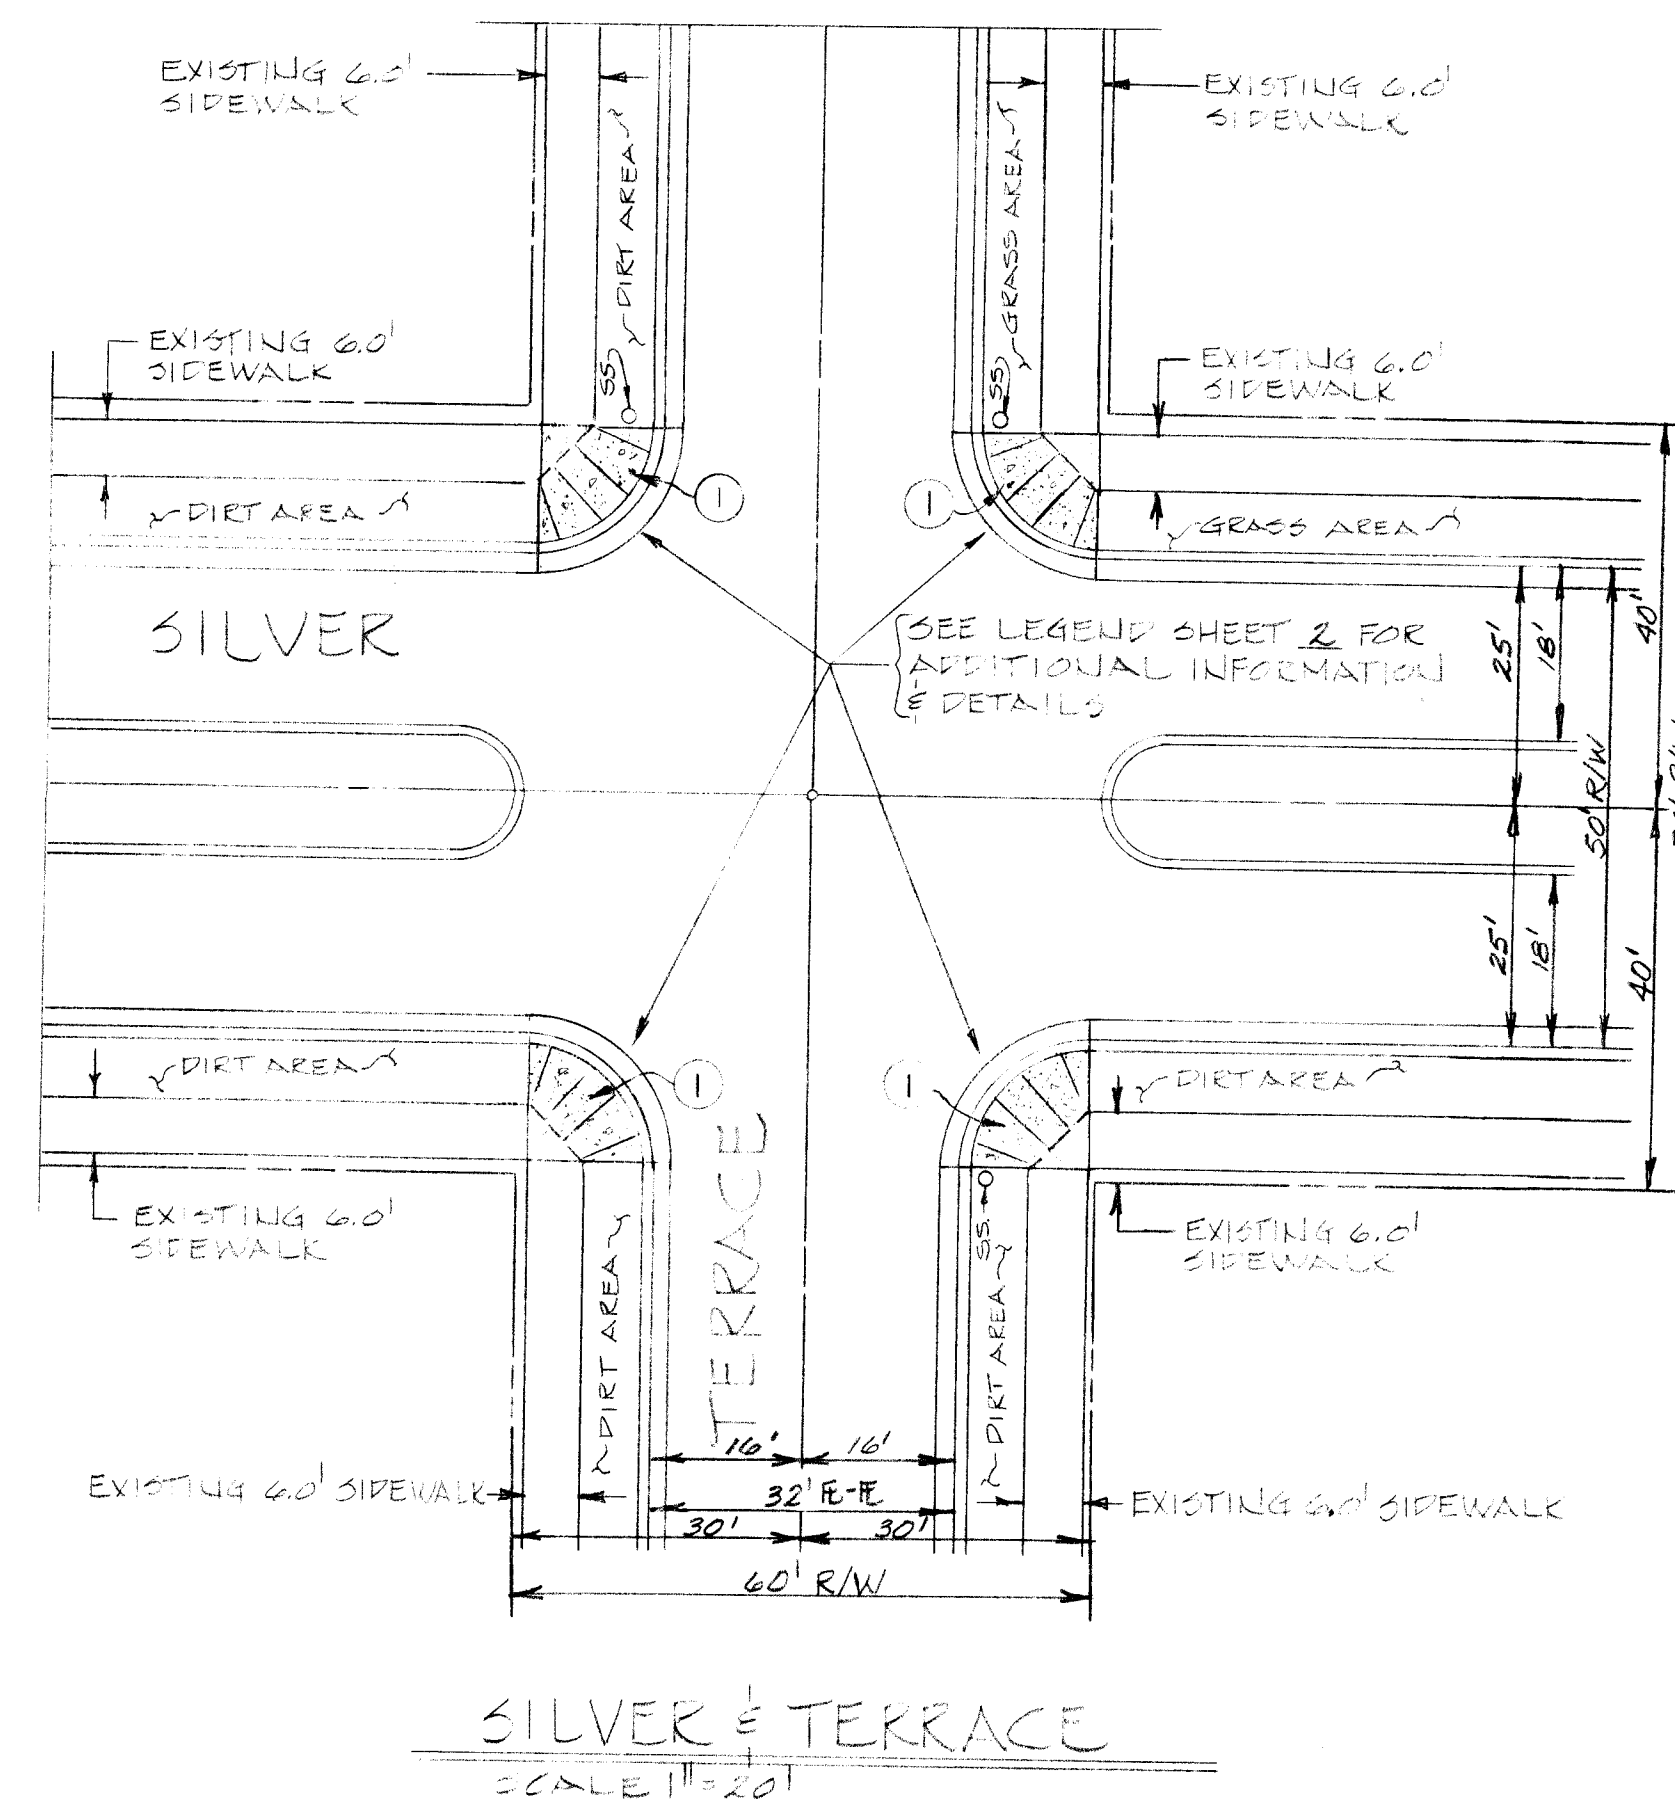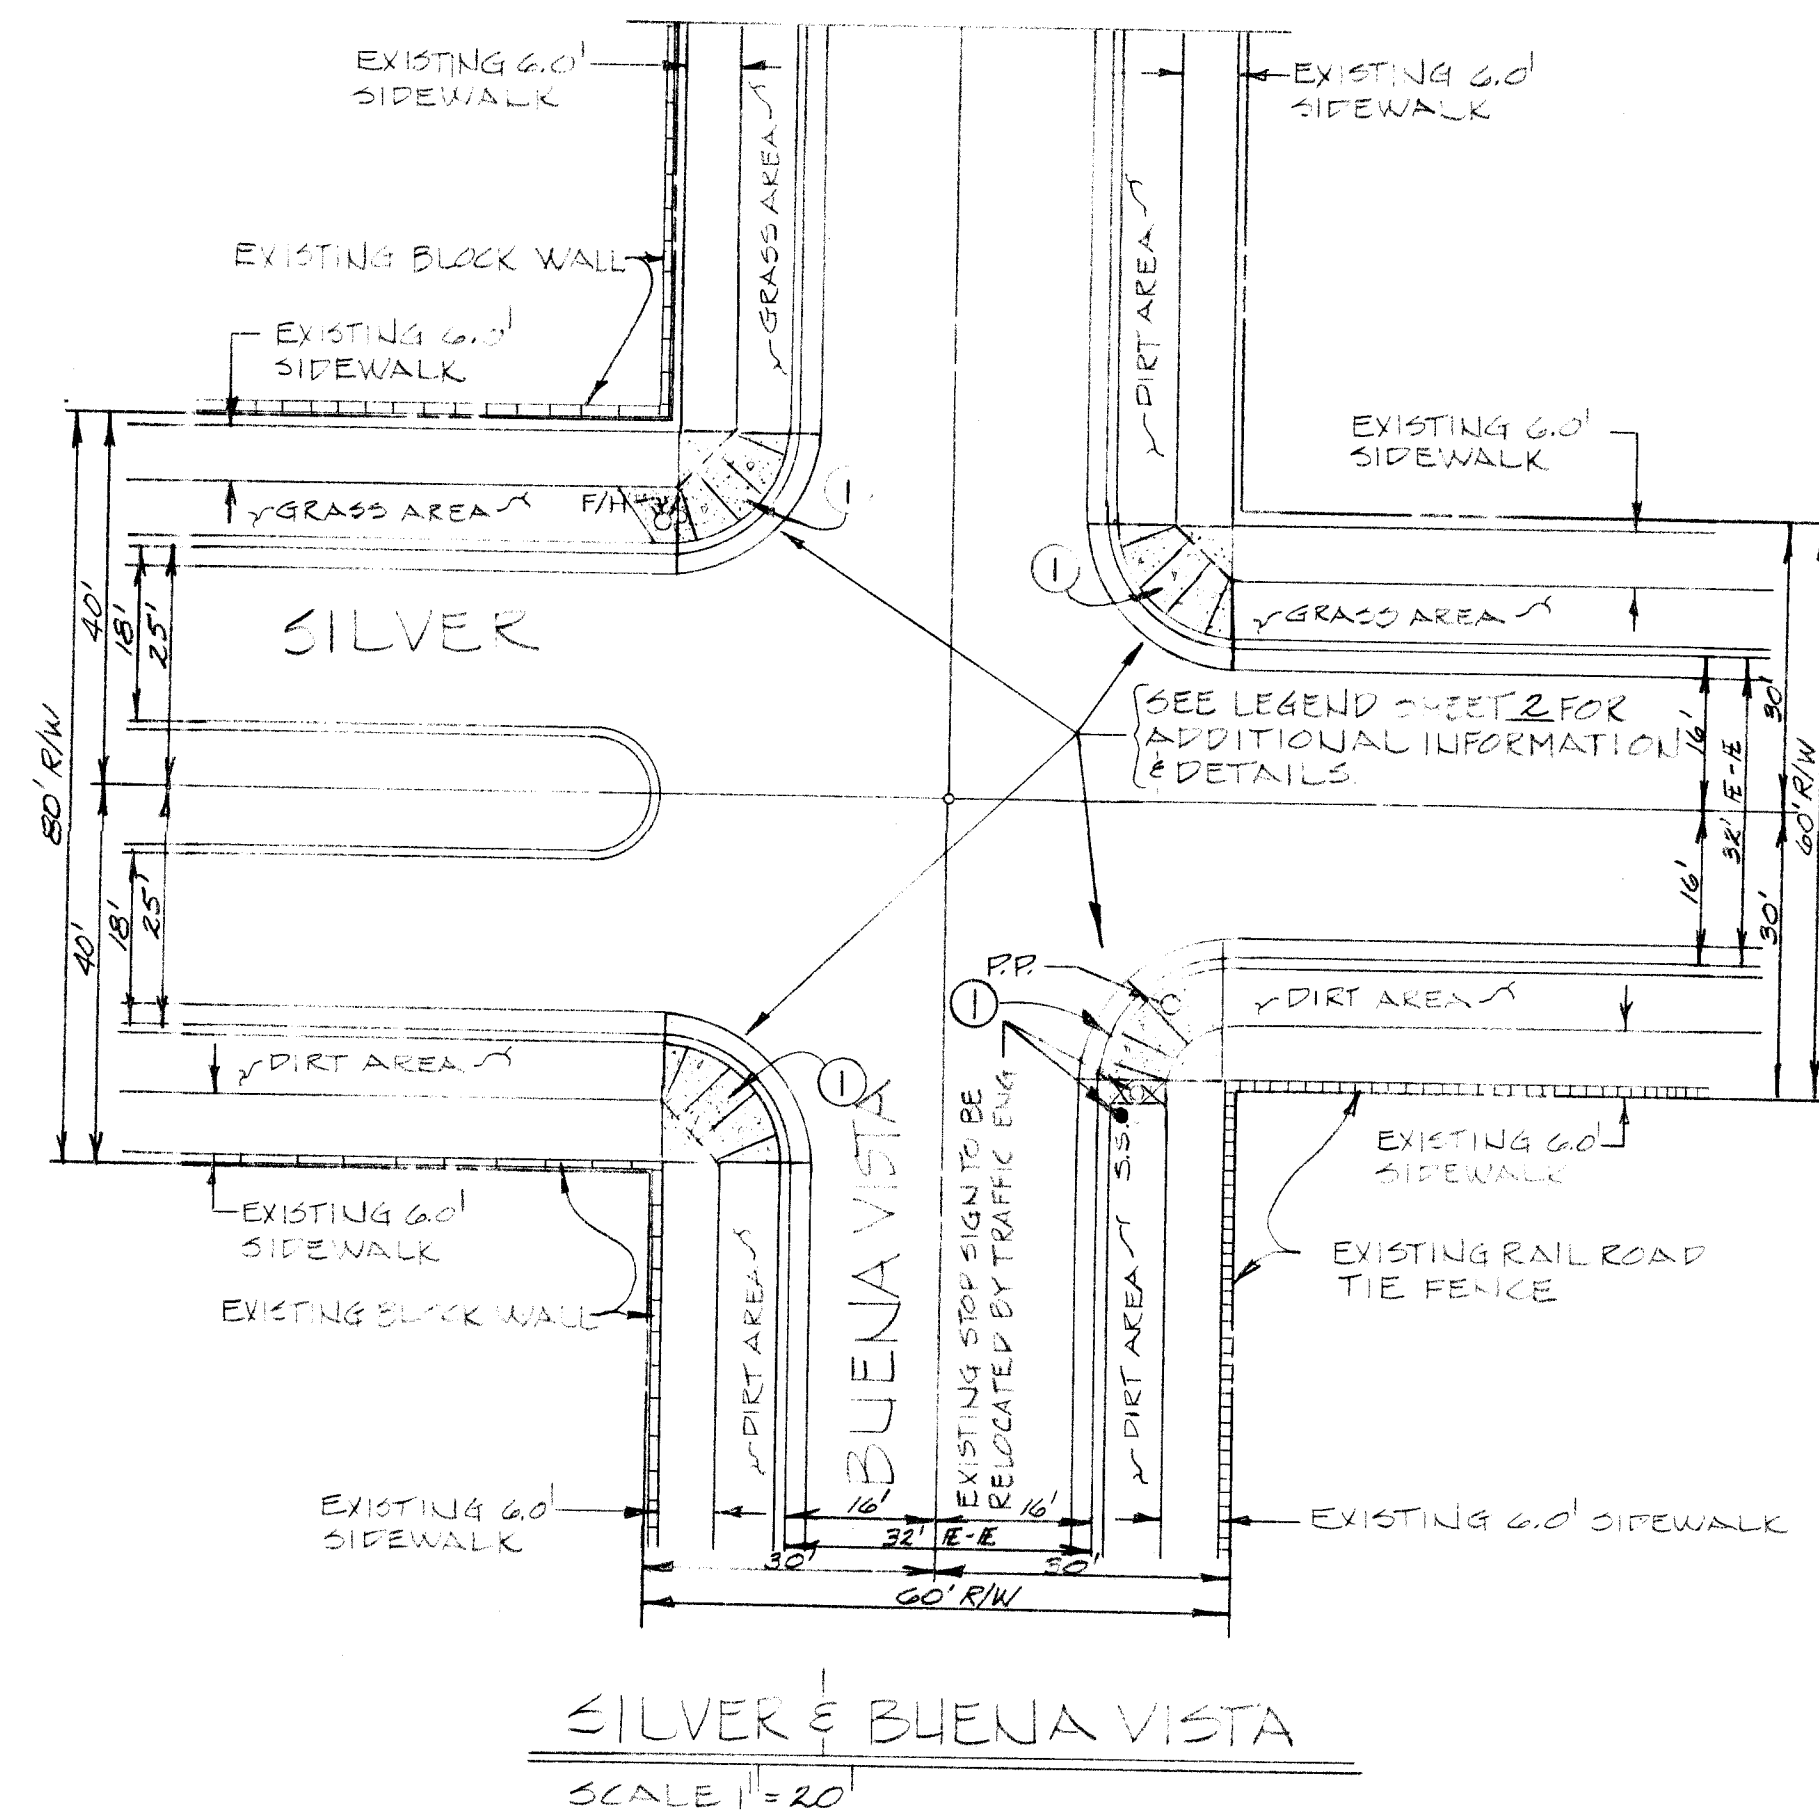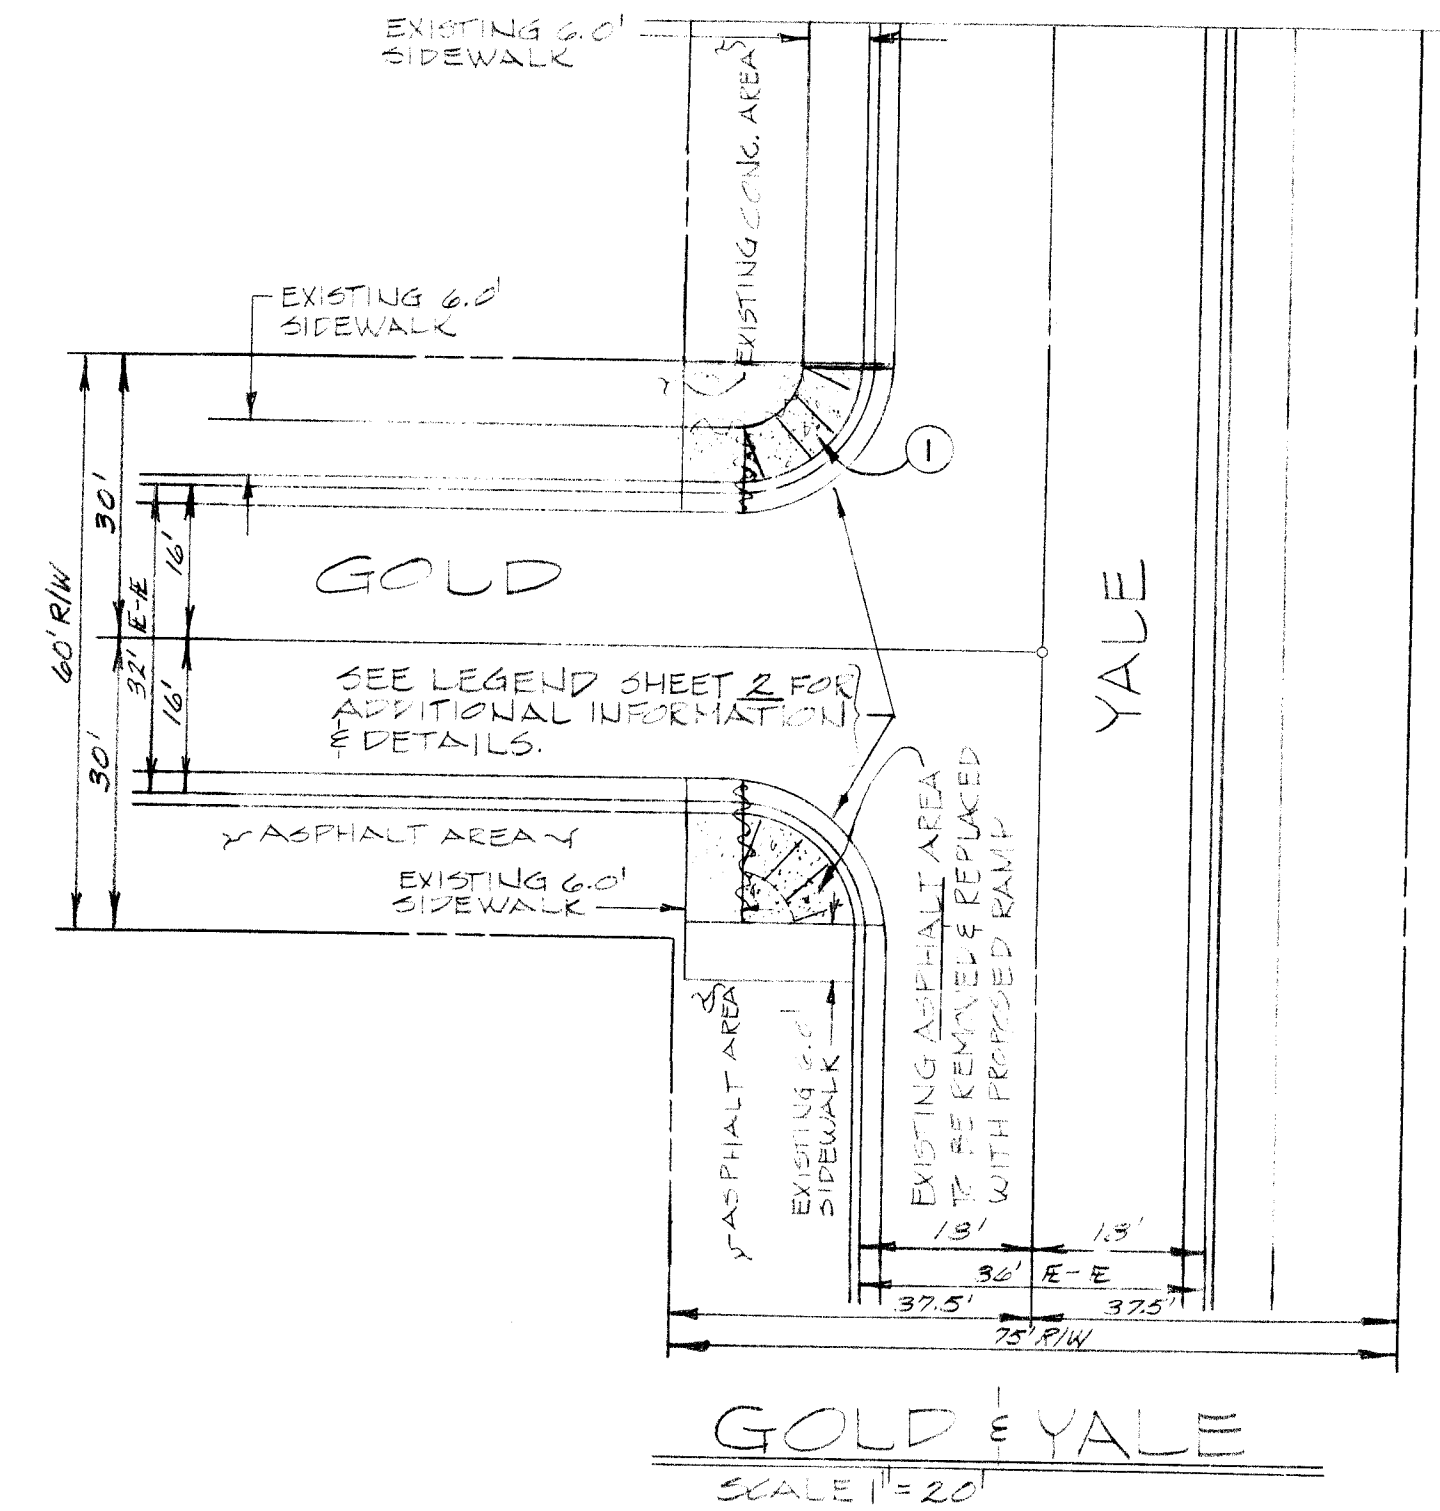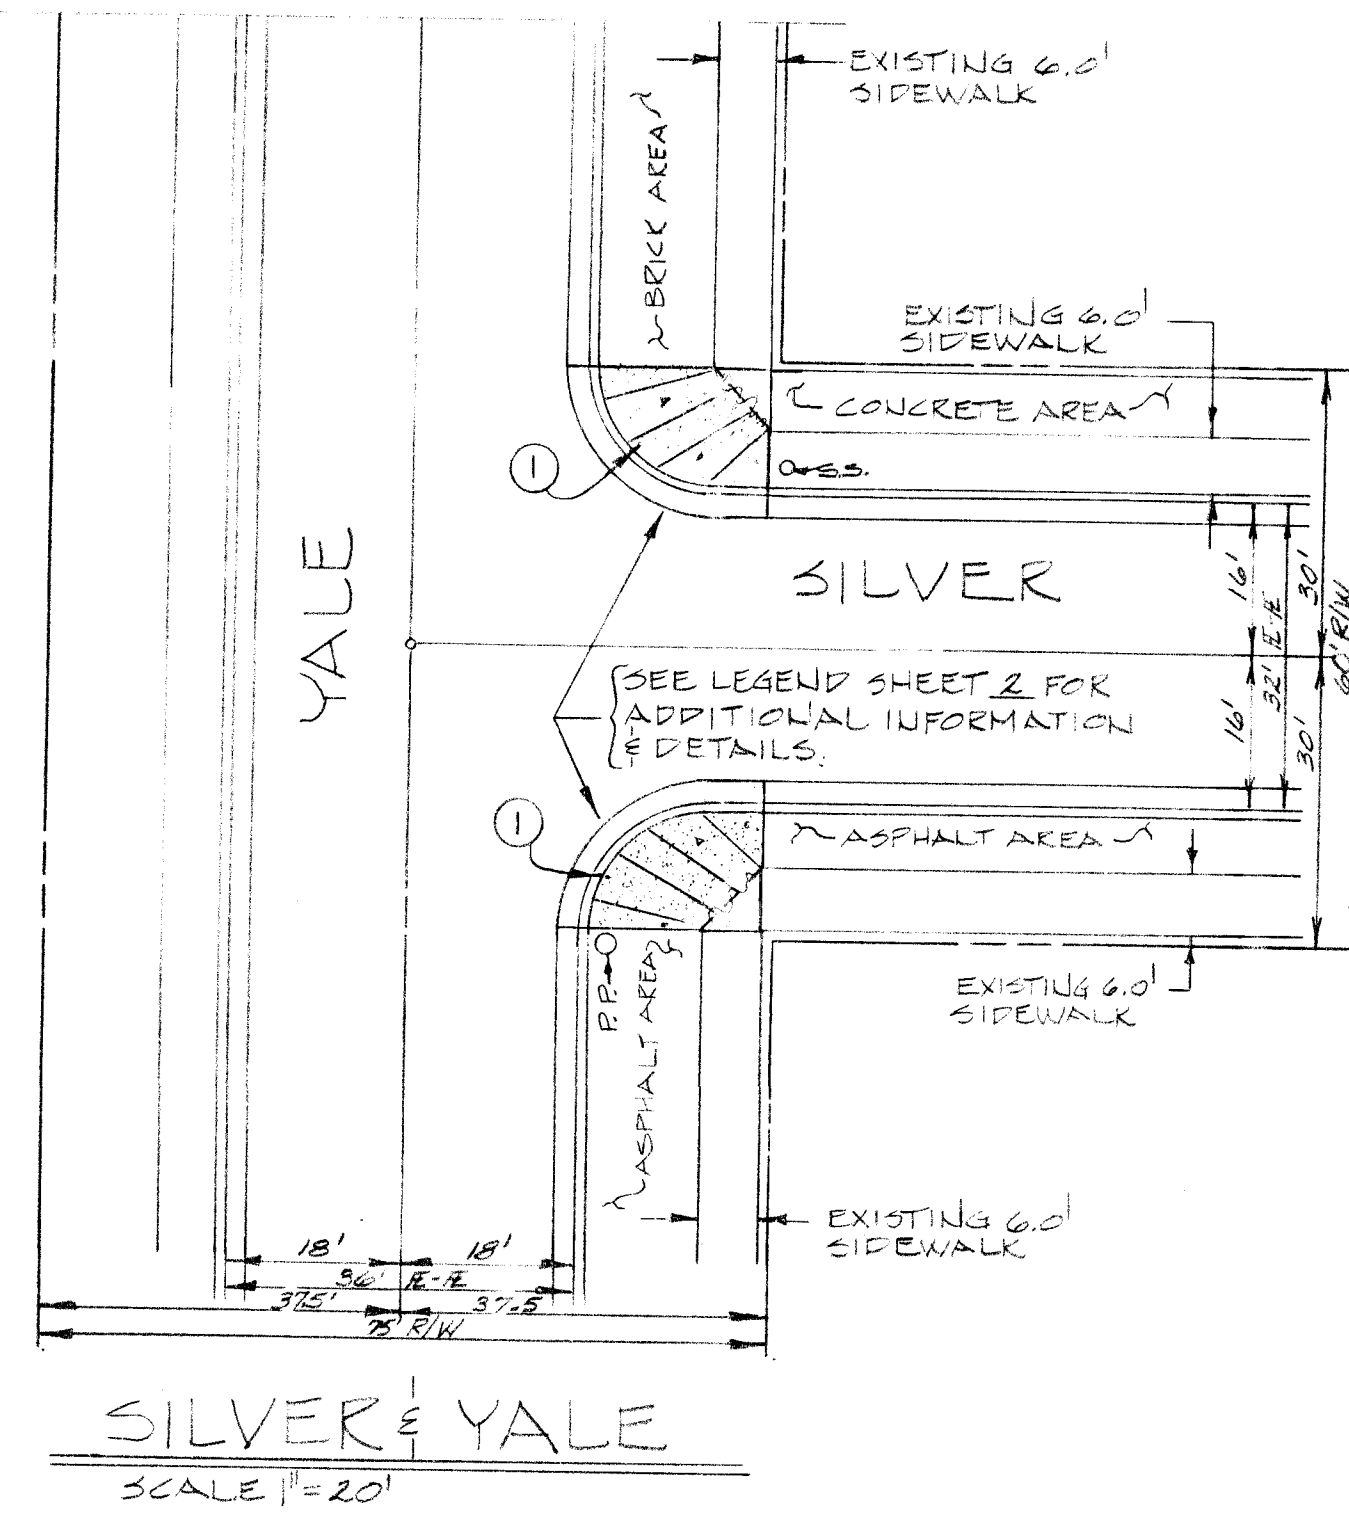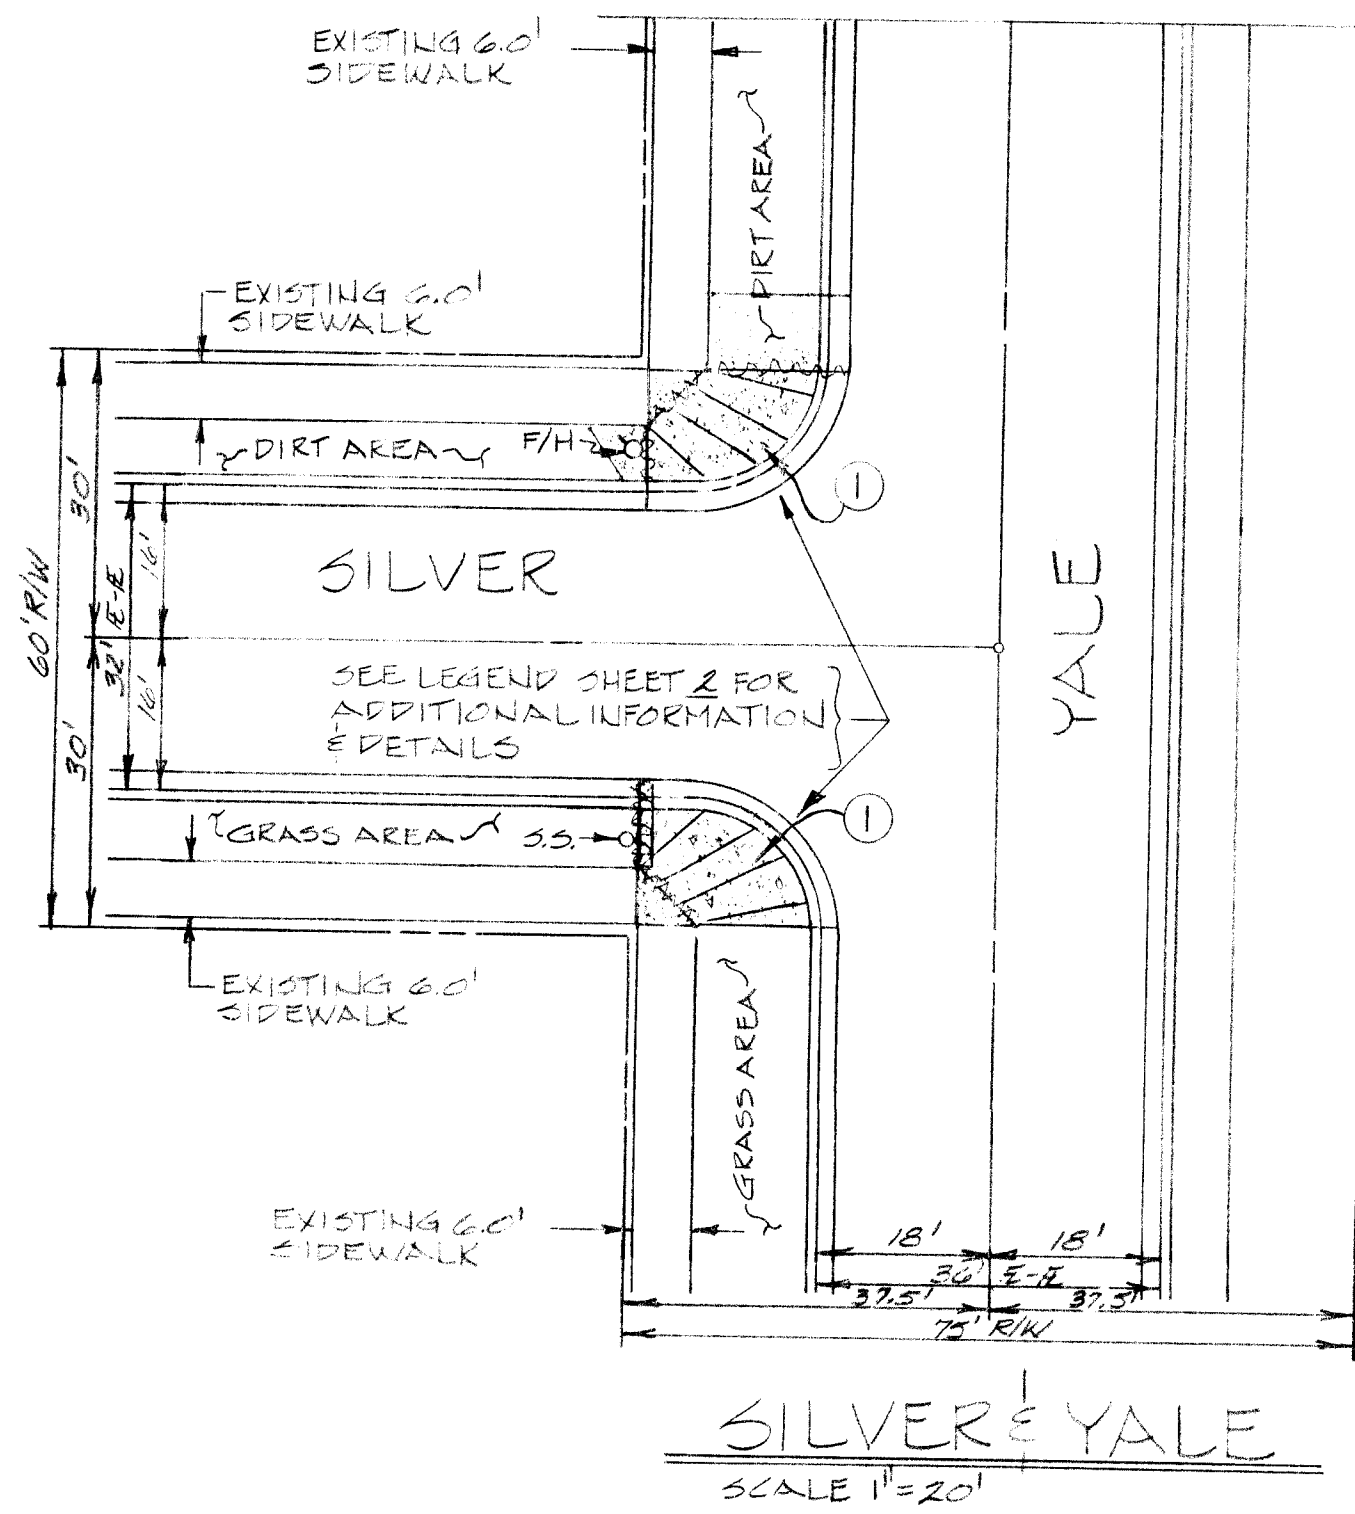

NOTE:
① AREA WHERE CONCRETE EXISTS THIS AREA TO BE REMOVED & REPLACED WITH FORMED WHEEL CHAIR RAMP.

26 1146 0483

OFFICE OF THE CHAIRMAN
PLANNING AND DEVELOPMENT DEPARTMENT
ENGINEERING DIVISION






WHEEL CHAIR RAMPS FOR UNIVERSITY HEIGHTS NEIGHBORHOOD

DATE: 5/16/02
BY: R.A. [Signature]
CHECKED BY: [Signature]

1146

K-15E161

4 5

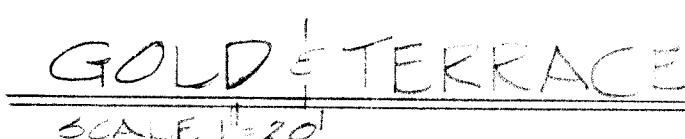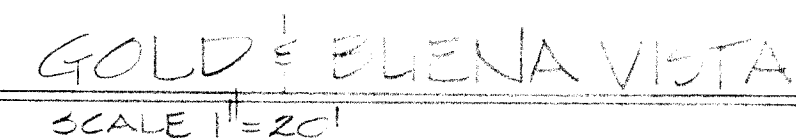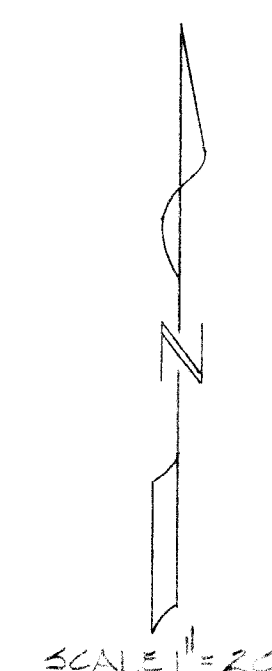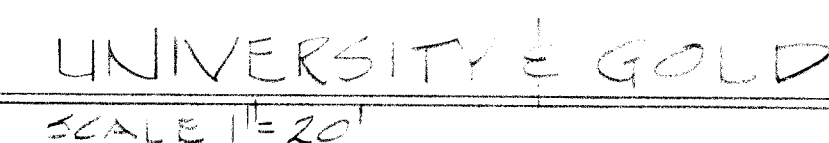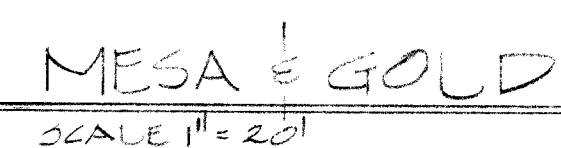

R.A. Zane 1/28/81