


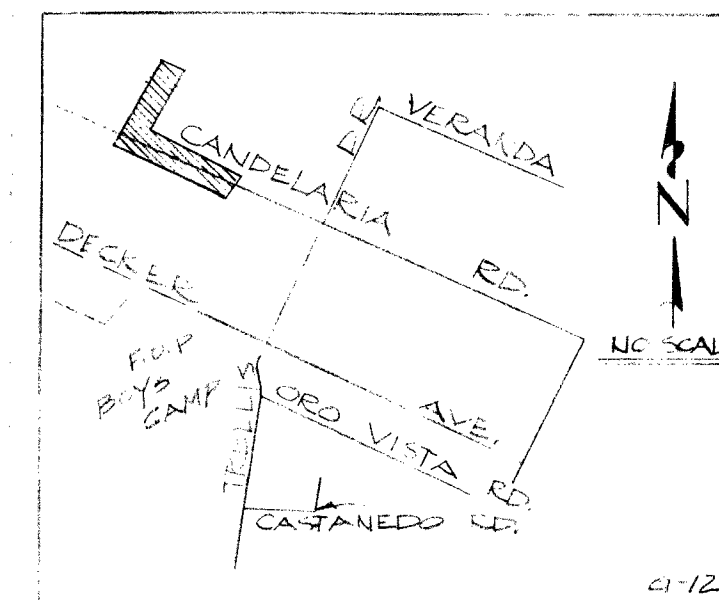

NOTES:

IF NECESSARY, DEFLECT WATERLINE
INSTALLATION TO MISS THE EXISTING
TREES.

BACKFILL COMPACTION SHALL BE
ACCORDING TO SPECIFIED
STREET USE (ARTERIAL FOR
CANDELARIA, RESIDENTIAL FOR
PARK AREA).


B.M. 5G-12 ELEV. 4965.63

B.M. 5 G-12 ELEV. 4965.63
STD. ACS BRASS TABLET STAMPED
5-G/12 1980 SET FLUSH WITH CURB
NORTH SIDE OF CANDELARIA WEST
OF TRELLIS DRIVE (APPROX.)
MAYBE 600' FROM TRELLIS &

~~PK-24~~ ~~46~~ ~~USA~~ ~~0.1.91~~

THIS INFORMATION
NECESSARY TO THE
2000000

CELIA TOMLINSON
ANDY J OLIVER

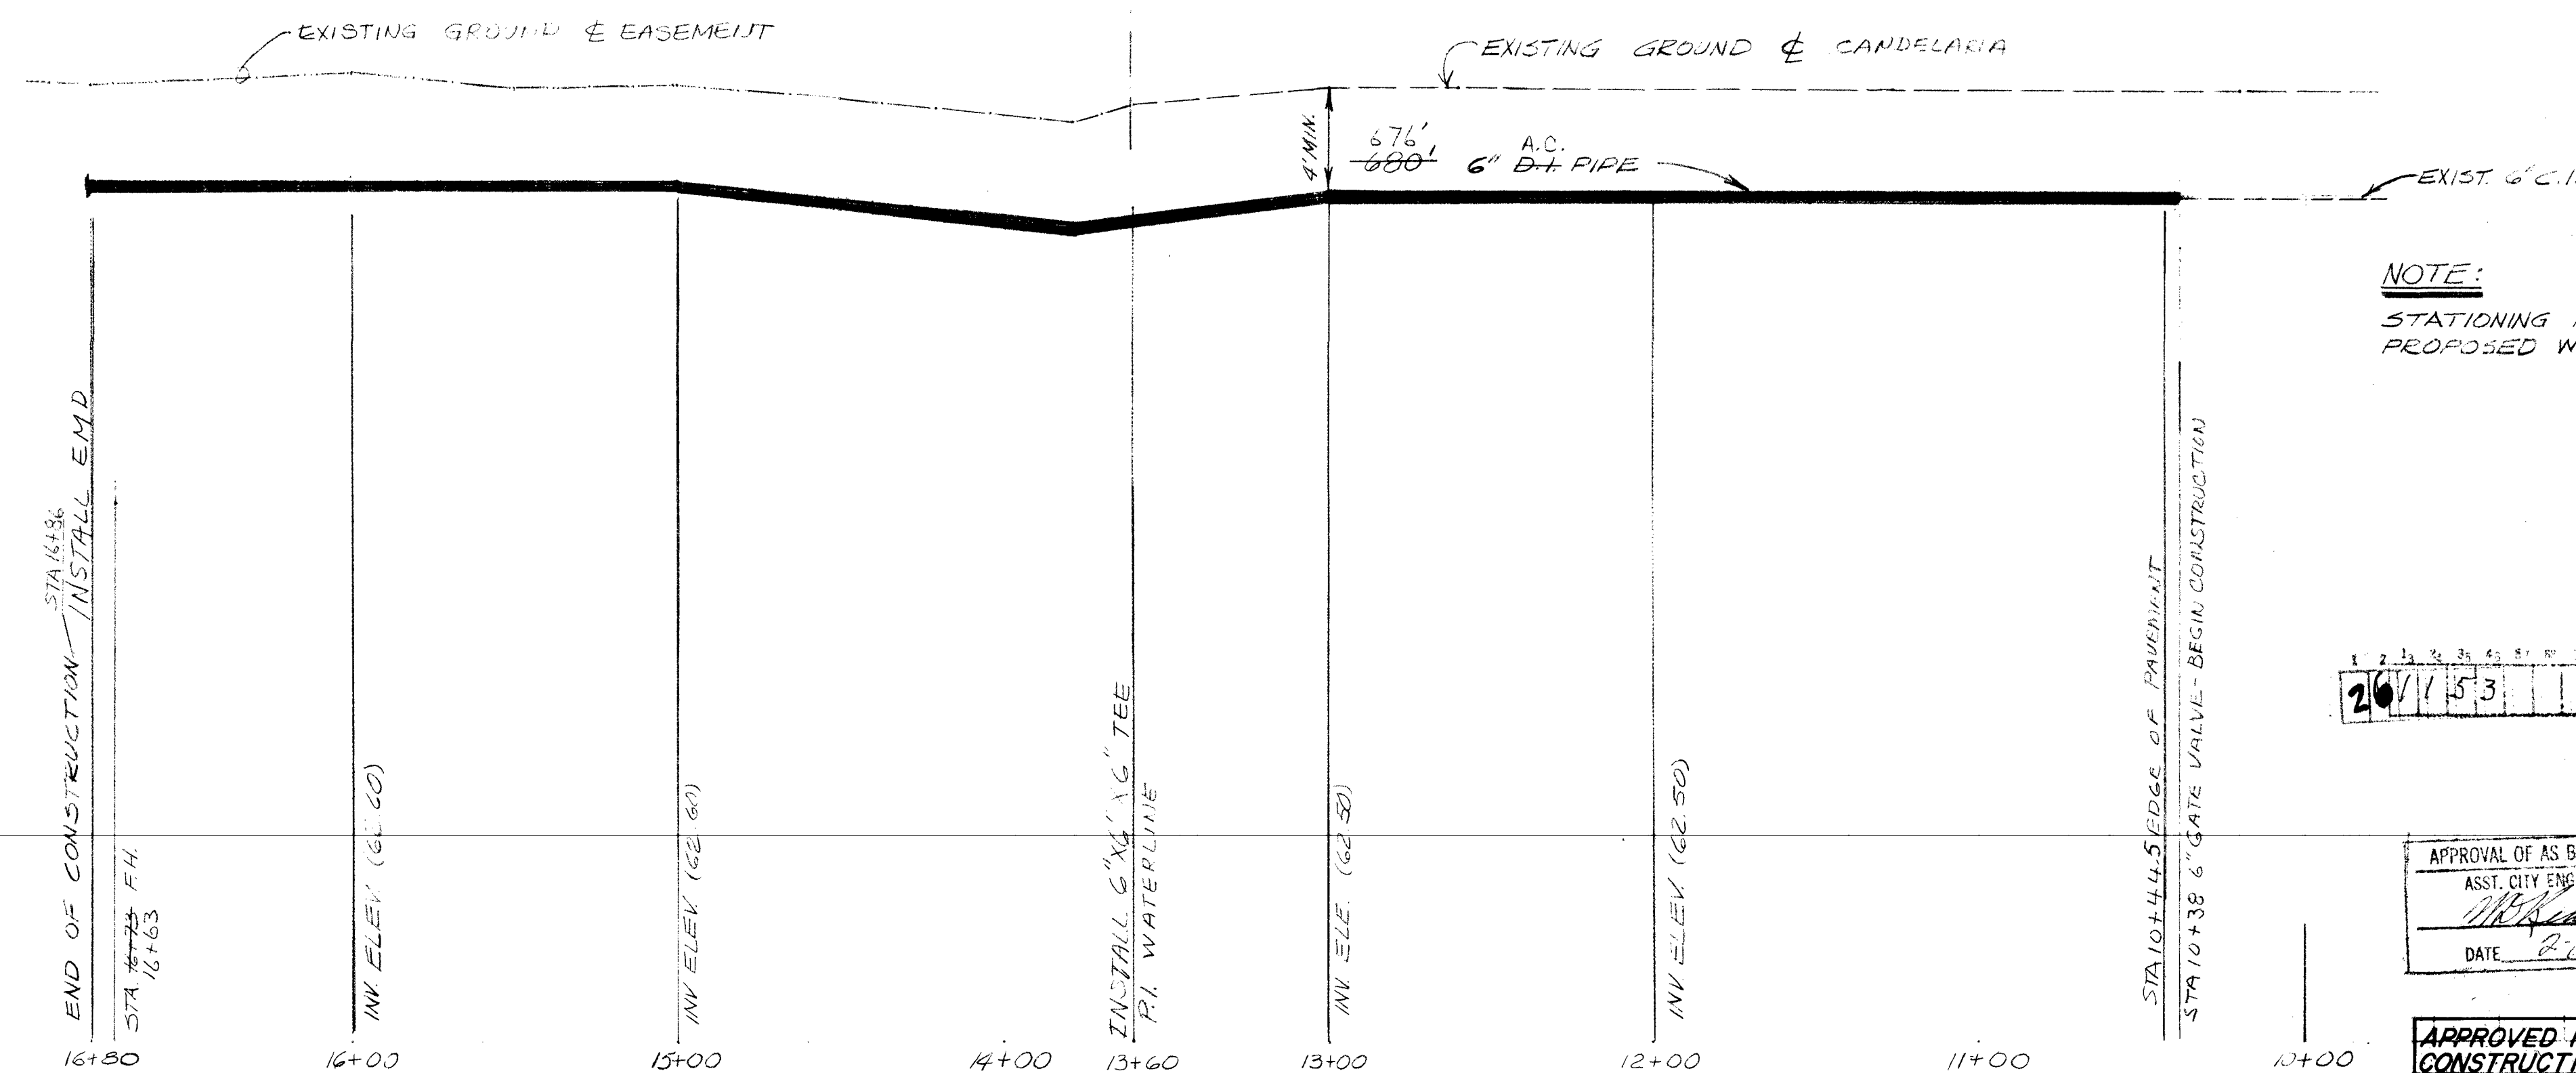

NOTE:

STATIONING IS ALONG
PROPOSED WATERLINE.

LEGEND



TREES

CURB & GUTTER (EXIST.)

 BUILD 6" D.I. PIPE

~~EXIST. SEWER~~

EXIST. STORM SEWER
(60,50) PROPOSED E.L. 1.

6-INCH WATERLINE EXTENSION FOR NATURE CENTER
ON CANDELARIA JUST WEST OF TRELLIS

APPROVAL OF AS BUILT DRAWINGS
ASST. CITY ENGINEER - FIELD
W. B. ...
DATE 2-27-82

APPROVED FOR
CONSTRUCTION
Richard S. Hill n/c
CITY ENGINEER DATE

10/27/81
 958957
 Parks & Rec. West Valley 10/9/81

N/A
N/A
D. Mouch, and 10/13/18

1153 G-12 1