


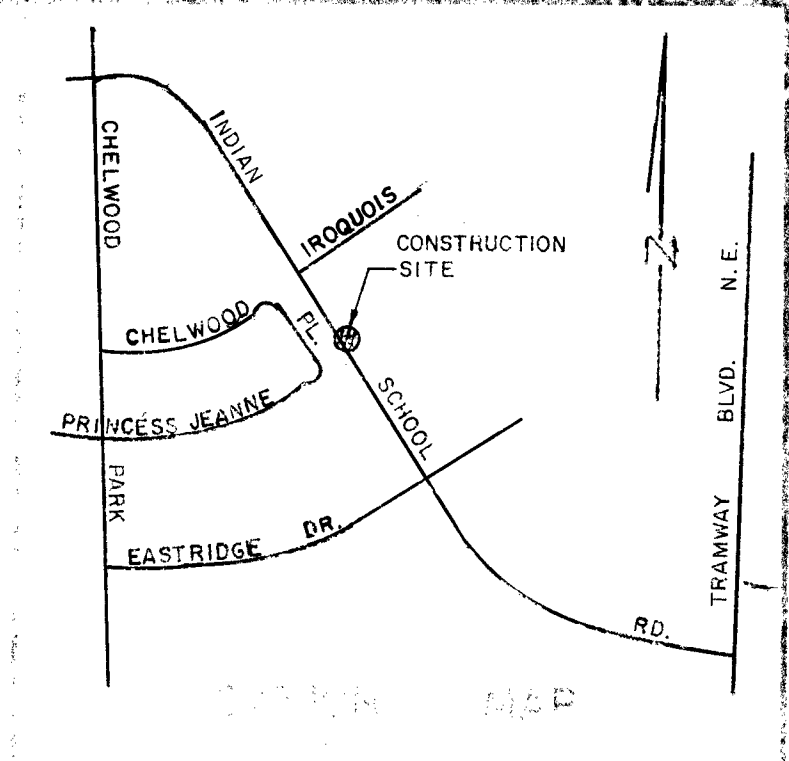

DRAINAGE IMPROVEMENT

INDIAN SCHOOL RD. BETWEEN IROQUOIS & EASTRIDGE

X
X

SHEET 2 ONLY	
APPROVAL OF ALL CITY DRAWINGS	
ASST. CITY ENGINEER - FIELD	
<i>M. J. [Signature]</i>	
DATE 9-9-82	


1	2	3	4	5	6	7	8	9	10	11	12
26	1	5	7					0	1	8	2

Richard Still 12/31/81

1157


1 OF 2

121

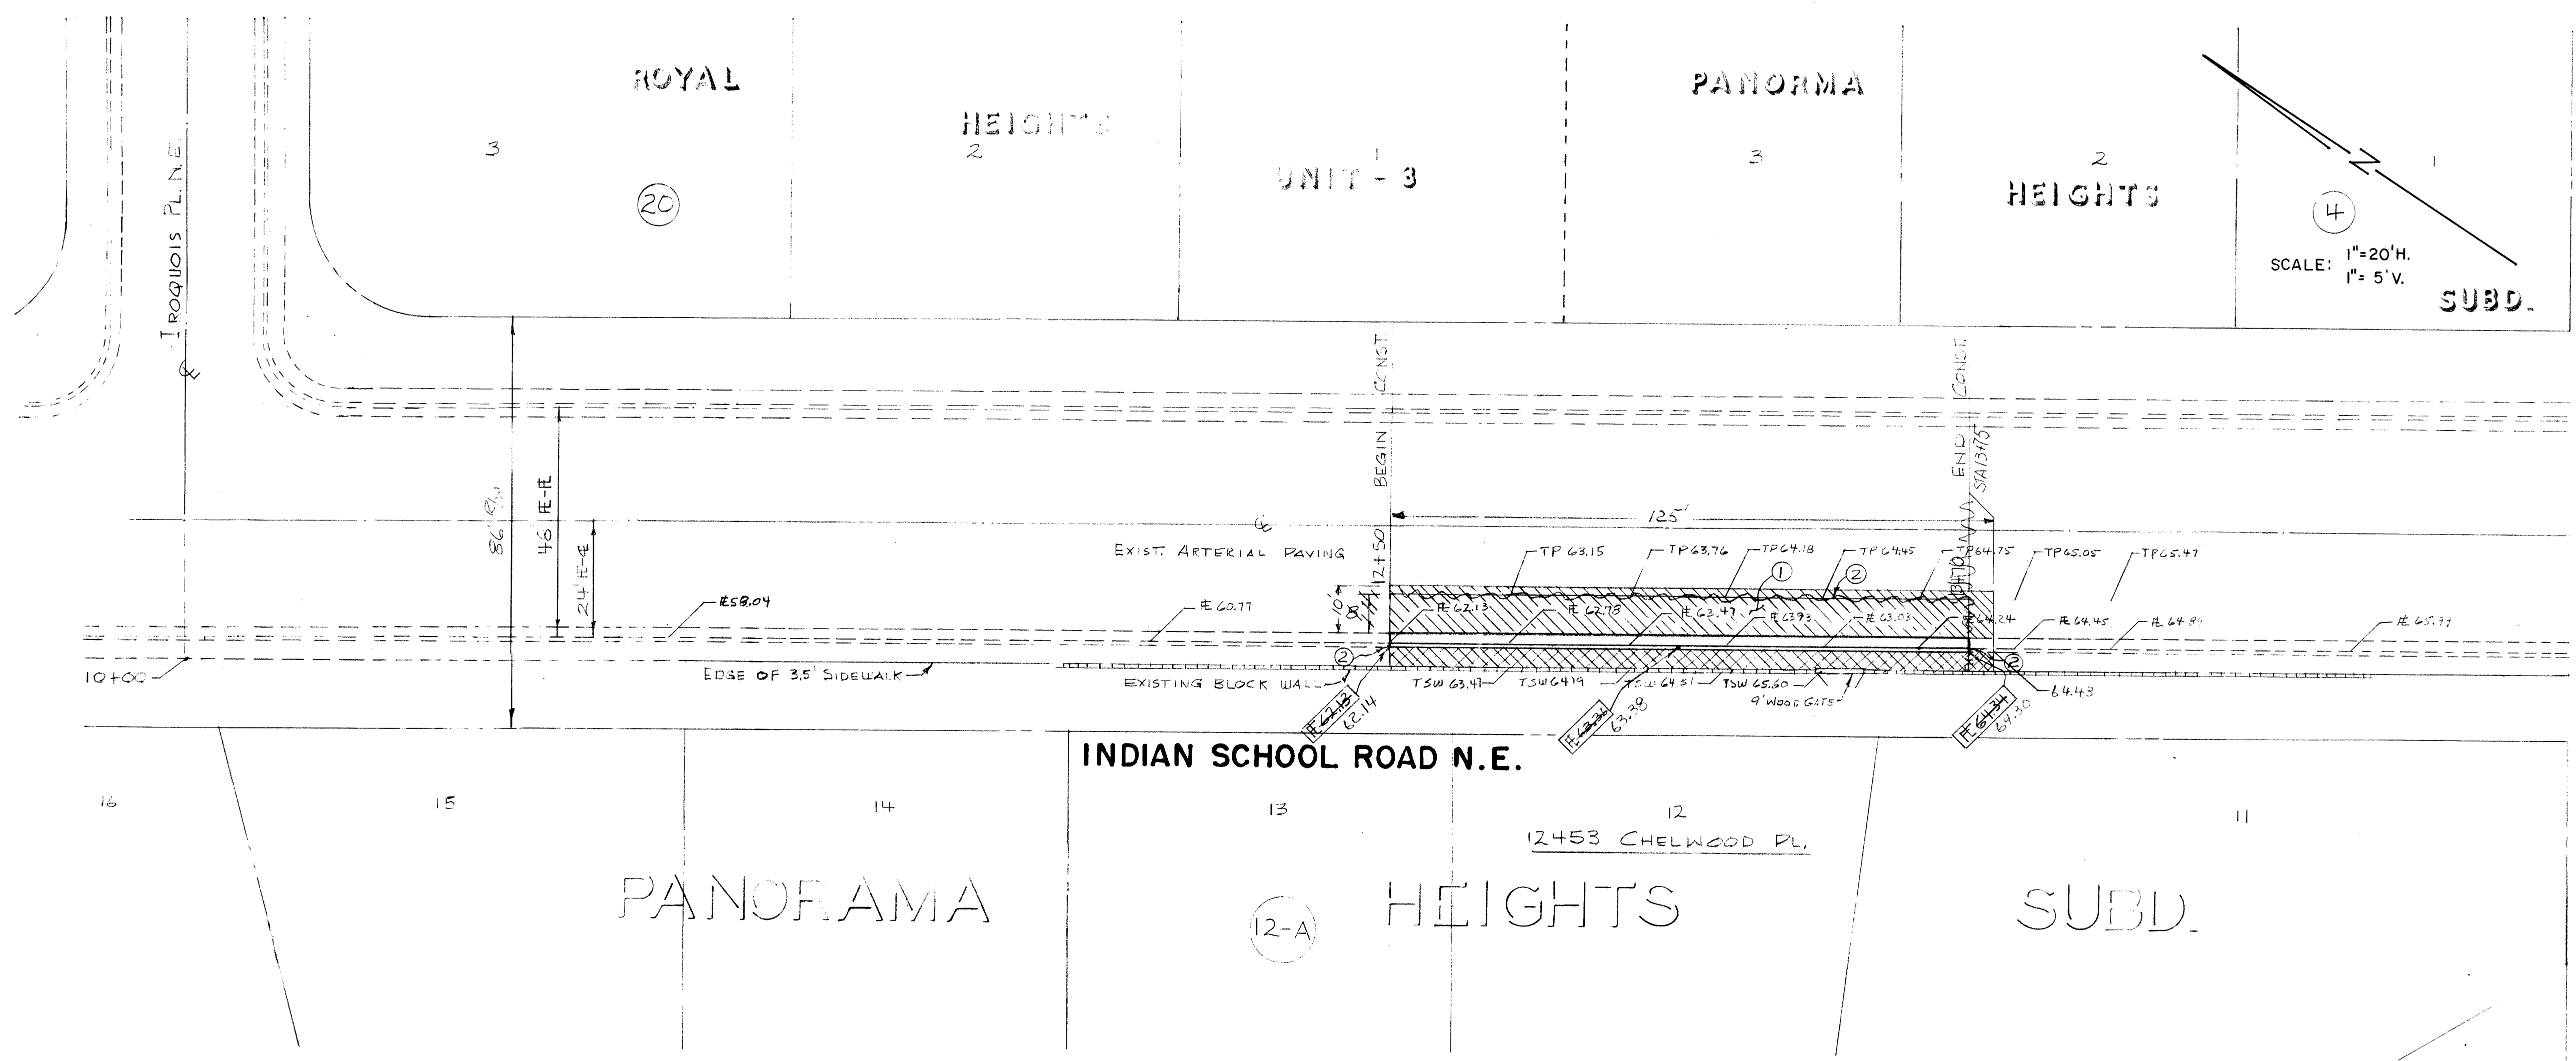

- NOTES:
- ① REMOVE AND REPLACE PAVING, SIDEWALK AND C & G TO NEW GRADES SHOWN.
 - ② MATCH EXISTING ELEVATIONS

- LEGEND
- E62.70 EXISTING ELEV.
 - E63.15 PROPOSED ELEV.
 - EXIST. CURB & GUTTER
 - PROPOSED CURB & GUTTER
 - REMOVE AND REPLACE PAVING, SIDEWALK TO MATCH EXISTING GRADES.
 - REMOVE AND REPLACE SIDEWALK TO MATCH NEW CURB GRADES.
 - EXISTING BLOCK WALL

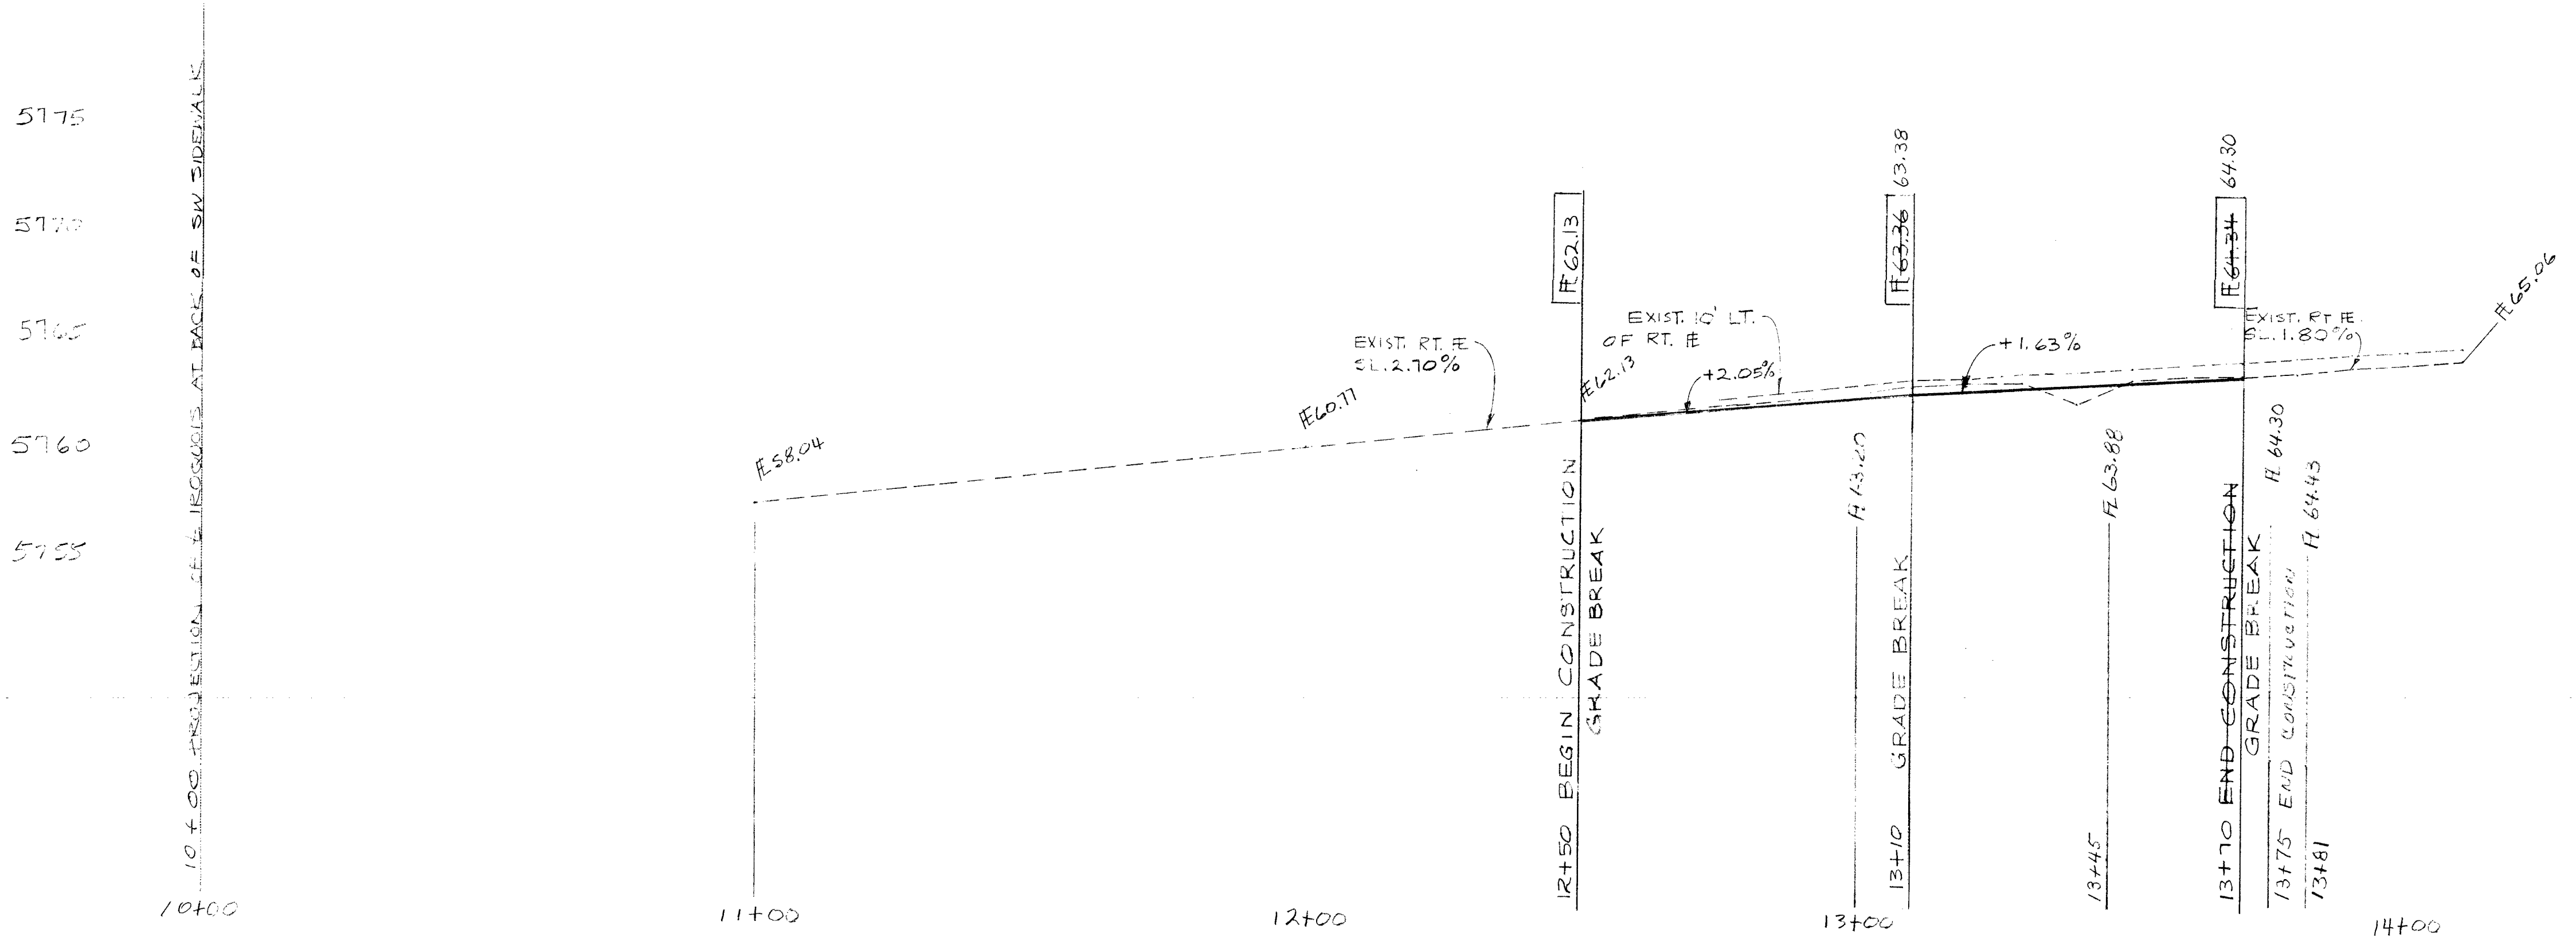

26/1/57 0282

DRAINAGE IMPROVEMENT
INDIAN SCHOOL ROAD BETWEEN IROQUOIS PL. & EASTRIDGE DR.

STREETS
1157
J-22
2
2

PS-119 H. MERCER 6-19-81 CHISELED ON T.C. N.E. SIDE OF INDIAN SCHOOL RD. @ COMMON R. TO L.D.S. CHURCH & HOUSE # 12621 ELEV. 5768.13

S. MIRANDA
T. SANCHEZ