


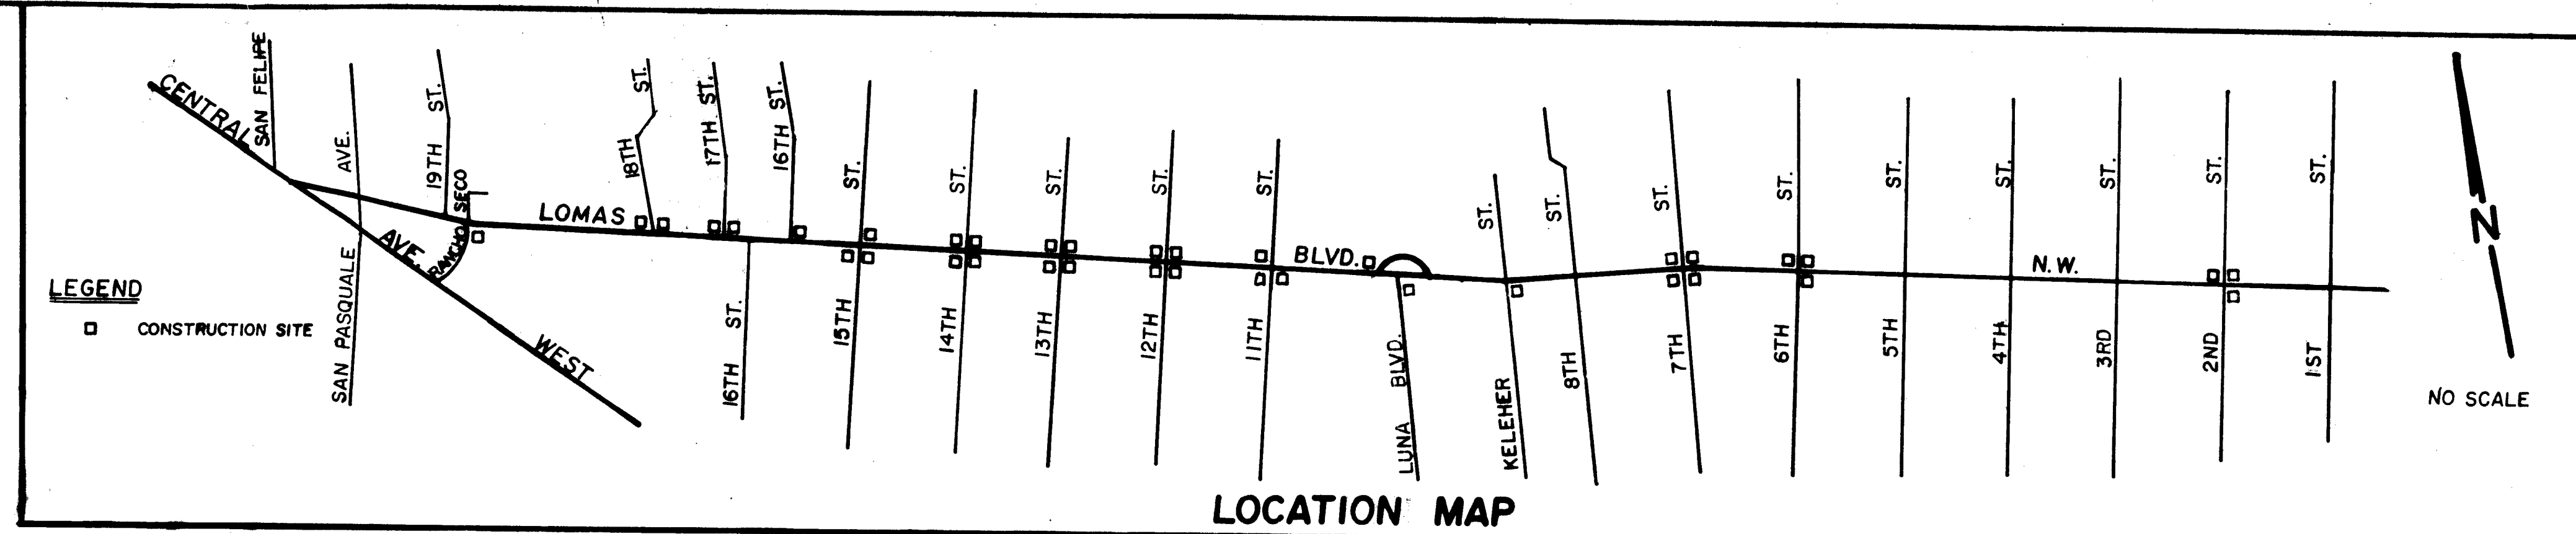

WHEELCHAIR RAMPS & CURB REPLACEMENT

LOMAS BLVD., N.W. FROM CENTRAL TO 2ND STREET

"NOTICE TO CONTRACTORS"

- 1) New Mexico Standard Specifications for Public Works Construction - 1979 Edition will be referred to hereon as the "Standard Specification."
- 2) All work detailed on these plans to be performed under contract shall, except as otherwise stated or provided for hereon, be constructed in accordance with "Contract Documents for City-Wide Utilities and Cash Paving No. 30" and the Standard Specification."
- 3) Two working days prior to any excavation, contractor must contact Line Locating Service, 765-1234, for location of existing utilities.
- 4) Prior to construction, the contractor shall excavate and verify the horizontal and vertical locations of all obstructions. Should a conflict exist, the contractor shall notify the engineer or surveyor so that the conflict can be resolved with minimum amount of delay.

THE FOLLOWING NOTES APPLY WHEN CHECKED

- ☐ All utilities and utility service lines shall be installed prior to paving.
- ☐ Backfill compaction shall be according to specified street use.
- ☒ Tack coat requirements shall be determined by the City Engineer.
- ☒ Sidewalks and wheelchair ramps within the curb return shall be constructed wherever a new curb return is constructed.
- ☐ If curb is depressed for a driveway, the driveway shall be constructed prior to acceptance of the curb and gutter.
- ☐ All storm drainage facilities shall be completed prior to final acceptance.

INDEX

SHEET 1:

1. RANCHO SECO RD., SE COR.
2. 18TH STR., NW COR.
3. 18TH STR., NE COR.
4. 17TH STR., NW COR.
5. 17TH STR., NE COR.
6. 16TH STR., NE COR.
7. 15TH STR., SW COR.
8. 15TH STR., NE COR.
9. 15TH STR., SE COR.
10. 14TH STR., NW COR.
11. 14TH STR., SW COR.
12. 14TH STR., NE COR.
13. 14TH STR., SE COR.
14. 13TH STR., NW COR.
15. 13TH STR., SW COR.
16. 13TH STR., NE COR.

SHEET 2:

17. 13TH STR., SE COR.
18. 12TH STR., NW COR.
19. 12TH STR., SW COR.
20. 12TH STR., NE COR.
21. 12TH STR., SE COR.
22. 11TH STR., NW COR.
23. LUNA CIRCLE, NW COR.
24. LUNA BLVD., SE COR.
25. KELEHER ST., SE COR.
26. 7TH STR., NW COR.
27. 7TH STR., SW COR.
28. 7TH STR., NE COR.
29. 7TH STR., SE COR.
30. 6TH STR., NW COR.
31. 6TH STR., NE COR.
32. 6TH STR., SE COR.

SHEET 3:

33. 2ND STR., NW COR.
34. 2ND STR., NE COR.
35. 2ND STR., SE COR.
36. 11TH STR., SW COR.
37. 11TH STR., SE COR.

APPROVAL OF AS BUILT DRAWINGS
ASST. CITY ENGINEER - FIELD
[Signature]
DATE 12-1-12


20 11850182

APPROVED FOR CONSTRUCTION
[Signature] 3/29/12
CITY ENGINEER DATE


DRAWING NO.

1185


SHEET 1 OF 4

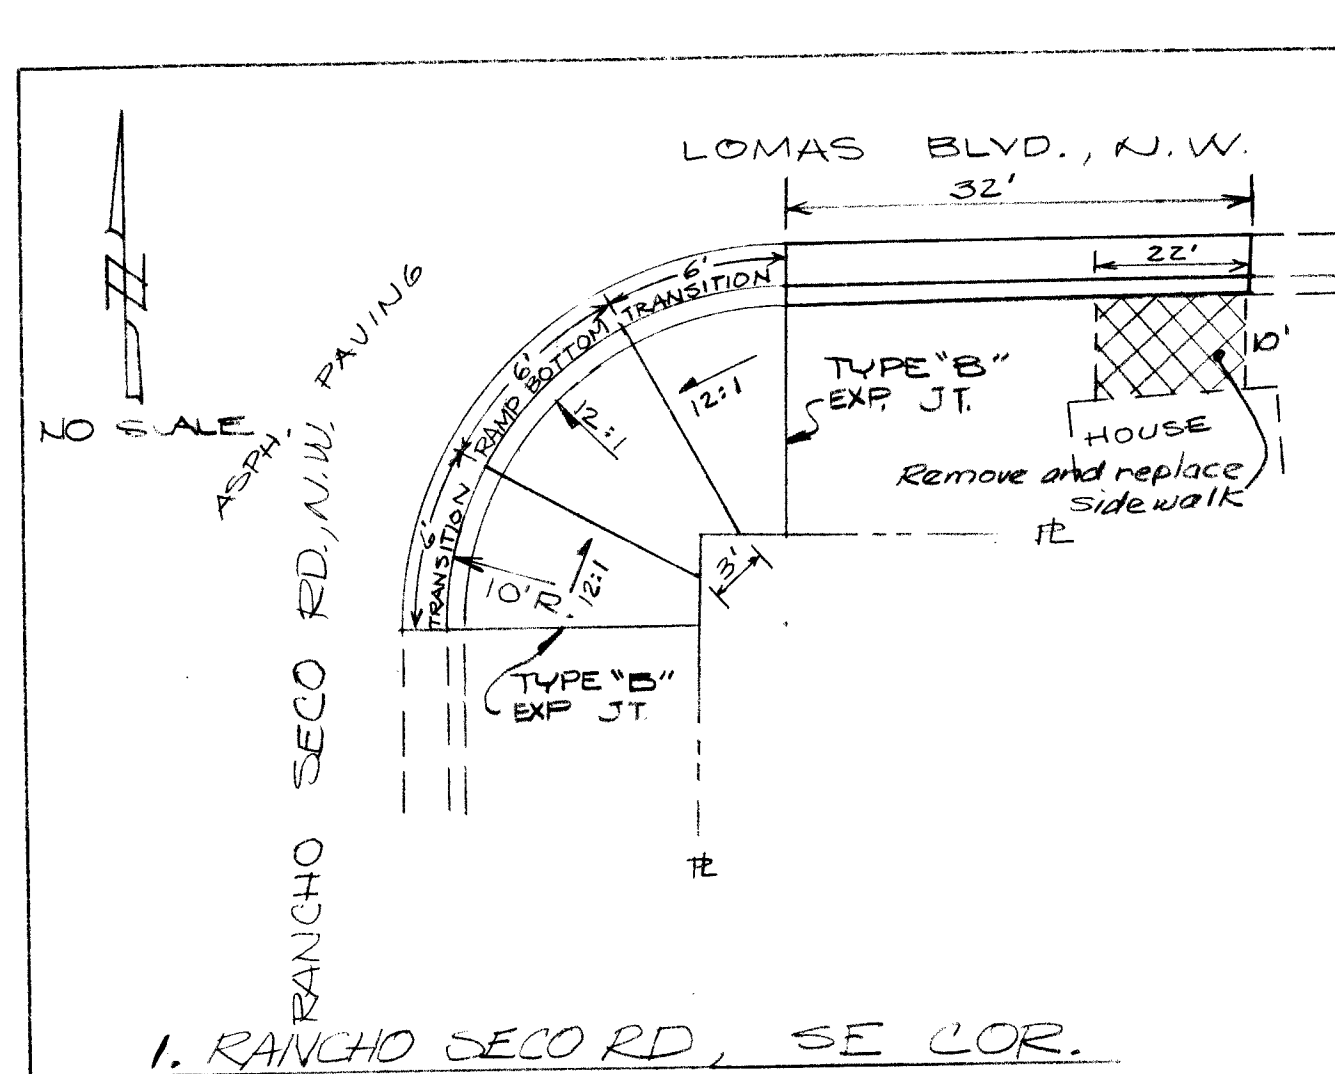


1. ¹² RANCHO SECO RD, SE COR.

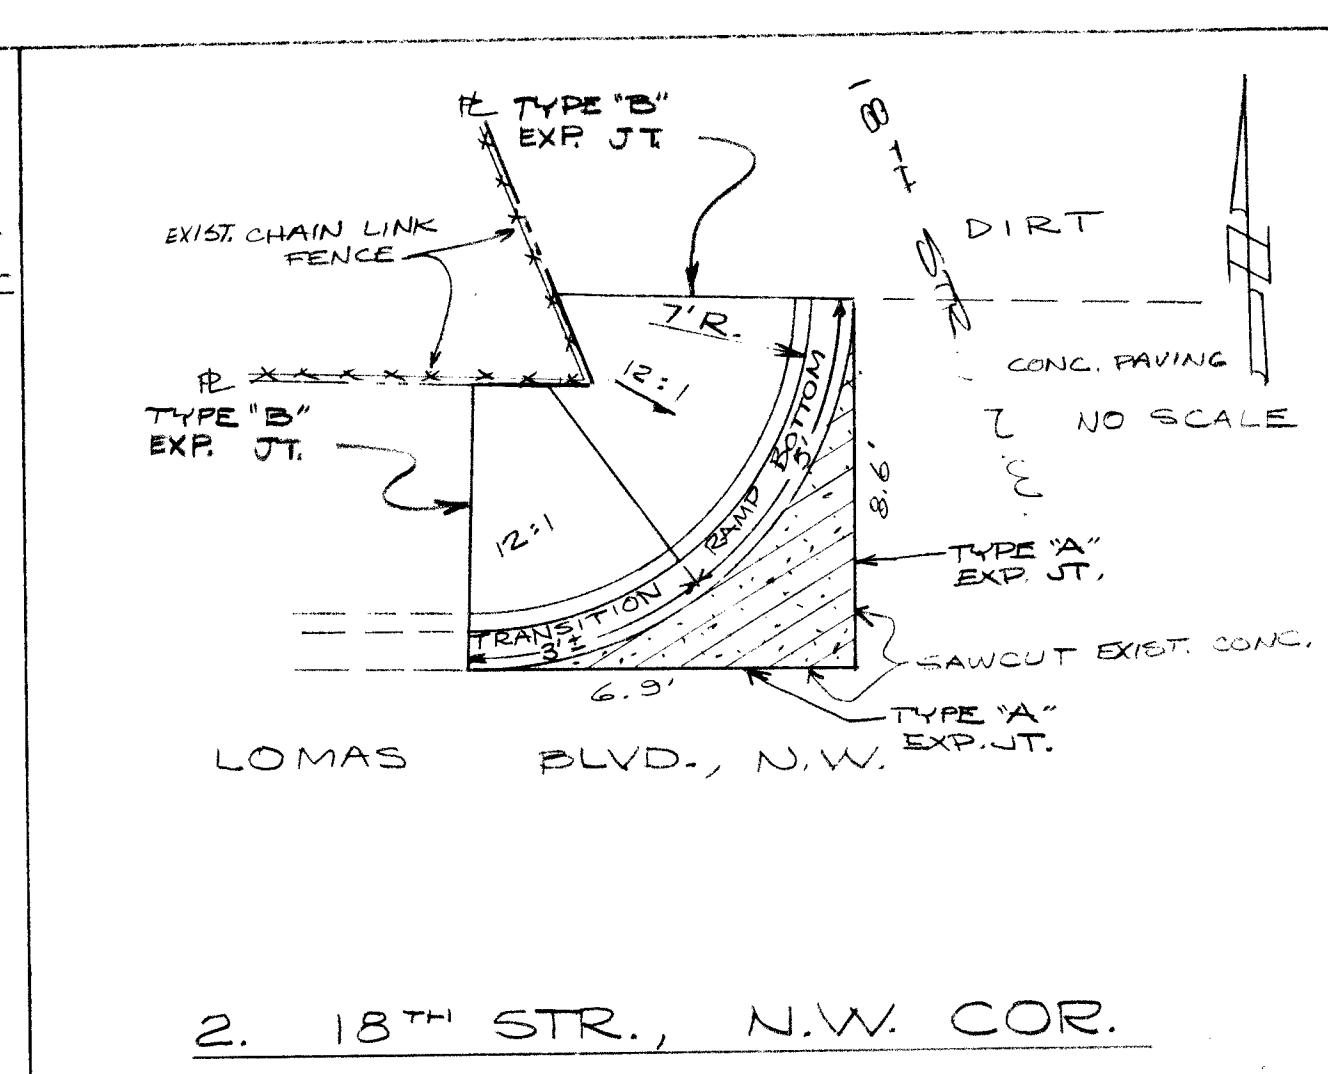


2. 18TH STR., N.W. COR.

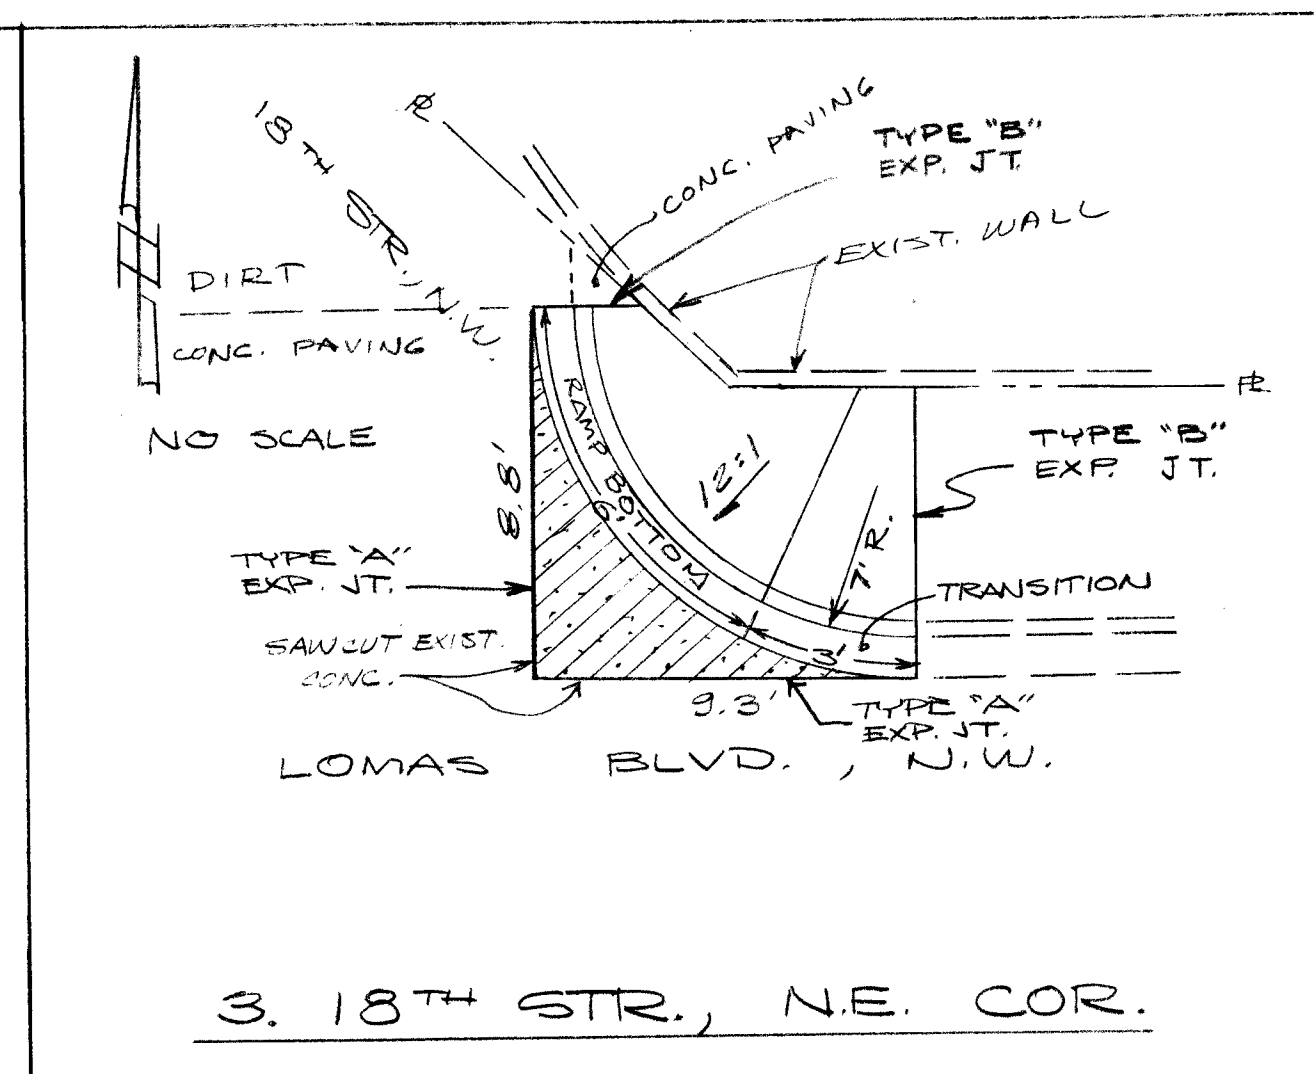


3. 18TH STR., N.E. COR.

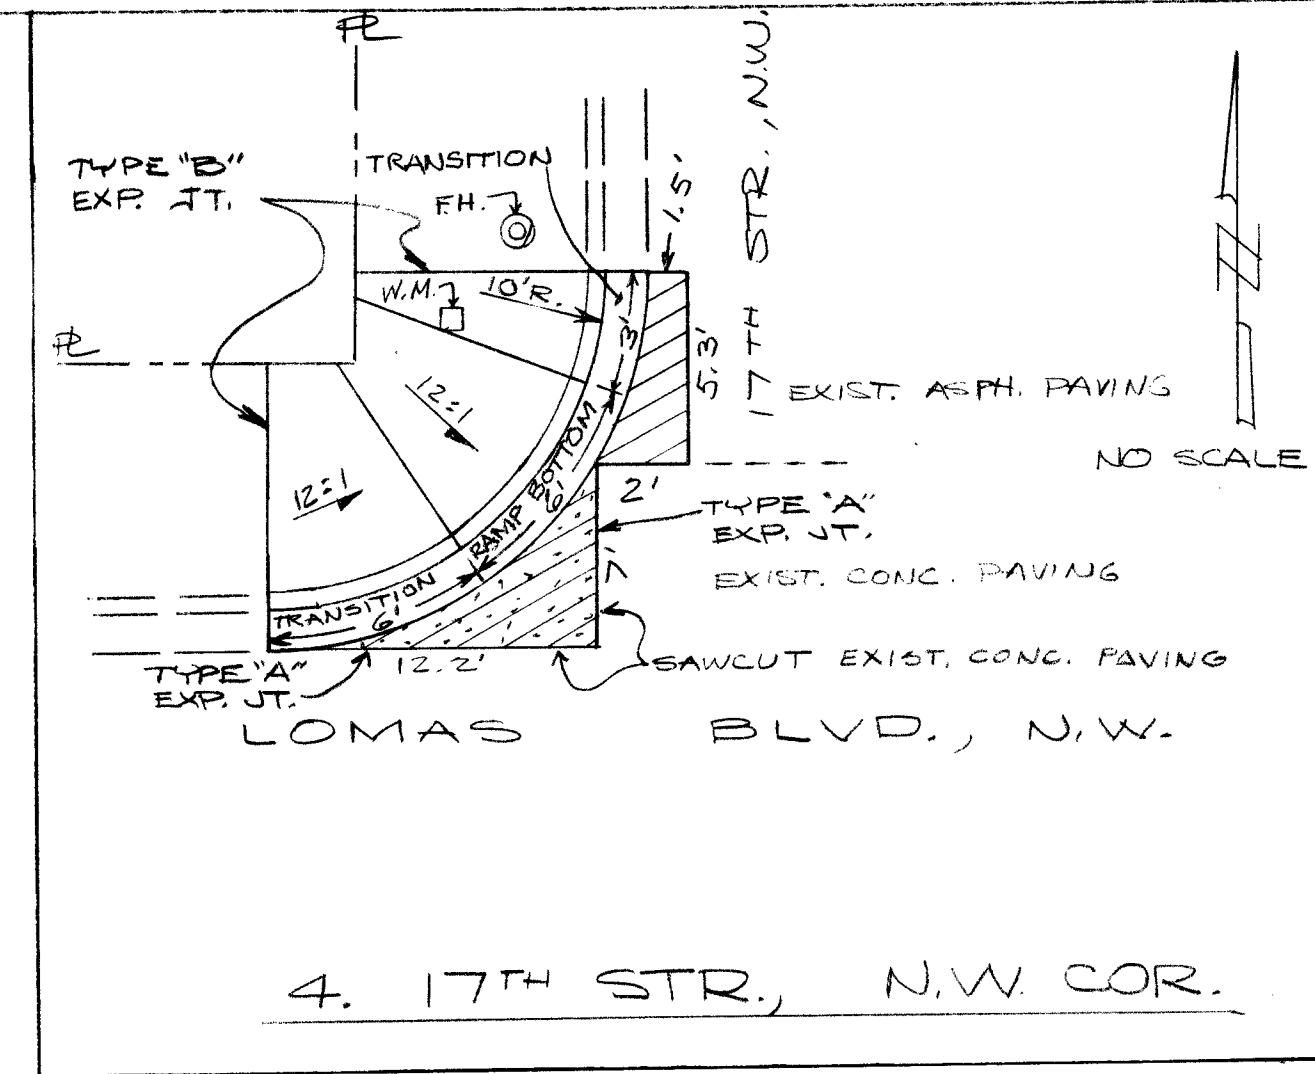


4. 17TH STR., N.W. COR.

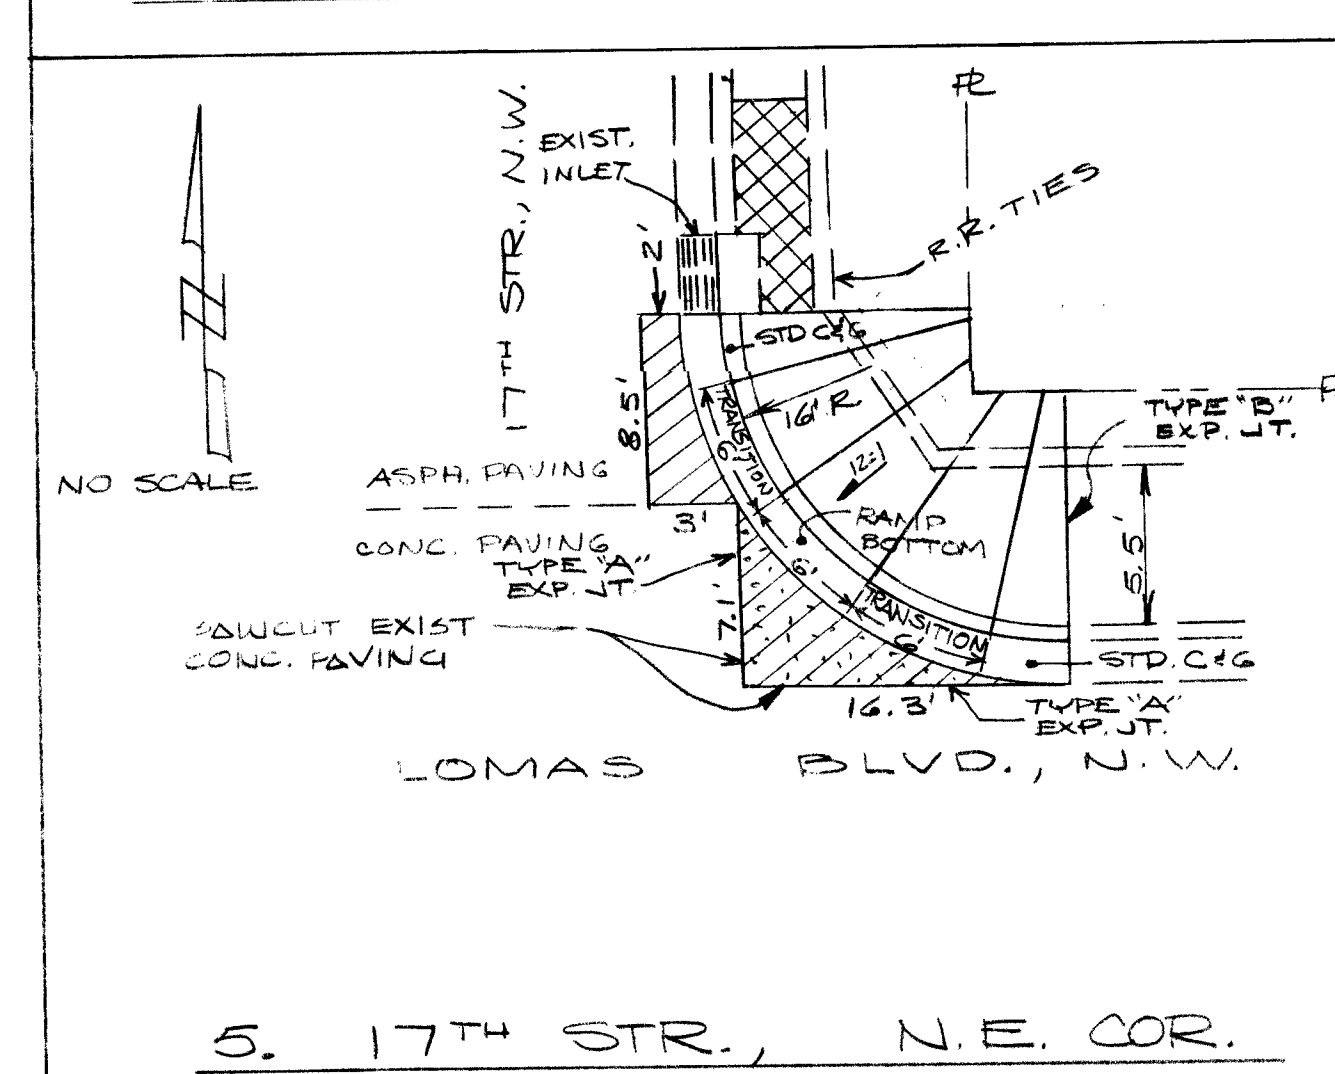


5. 17TH STR., N.E. COR.

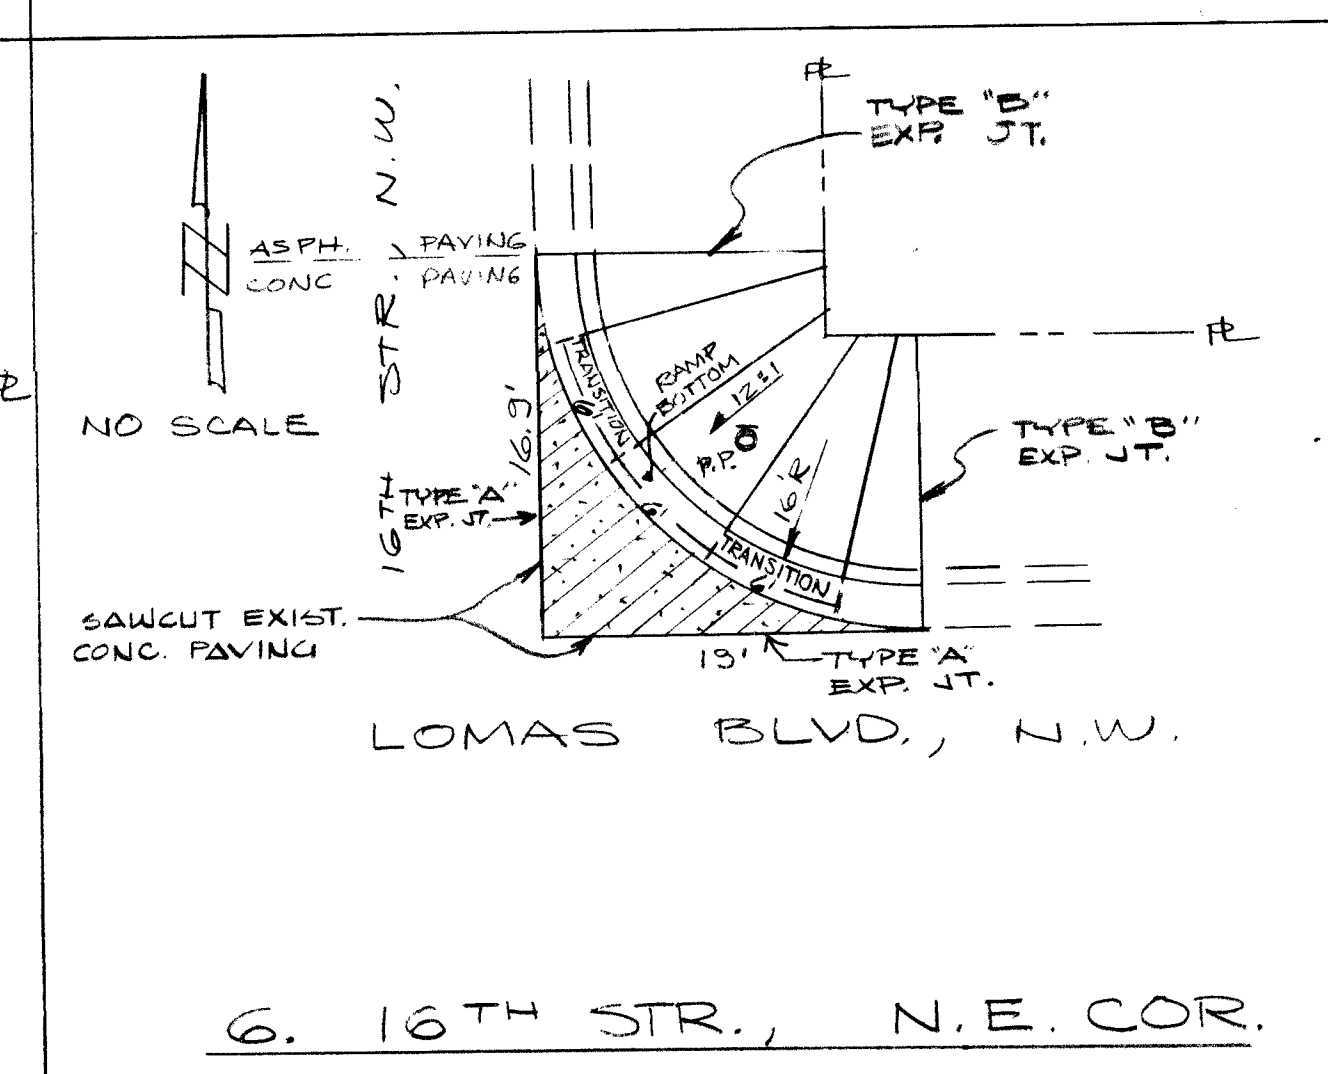


6. 16TH STR., N.E. COR.

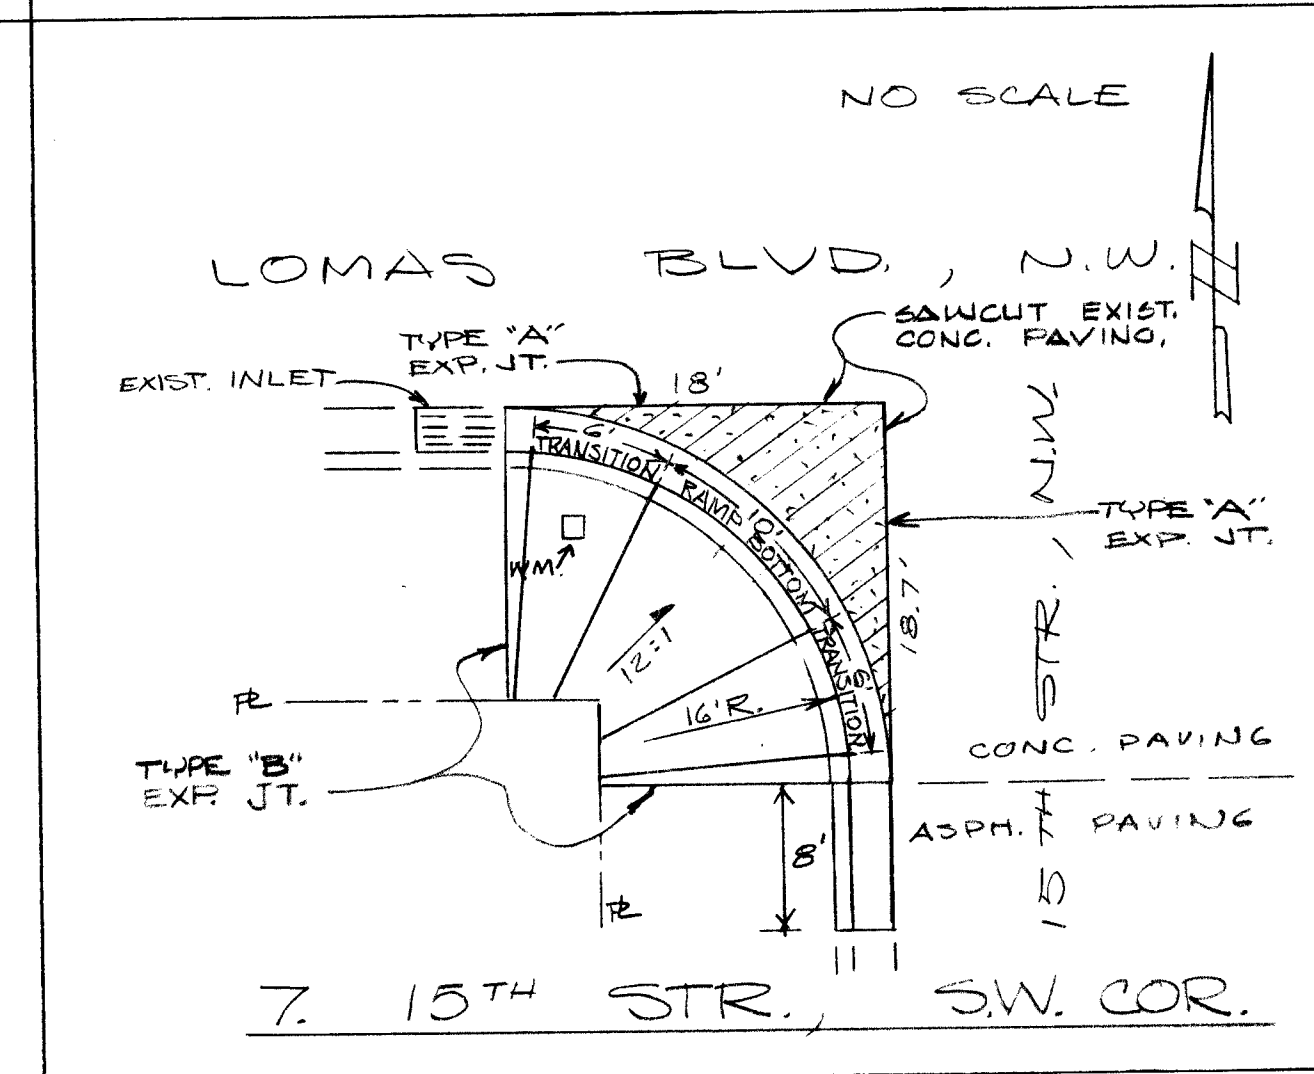


7. 15TH STR., S.W. COR.

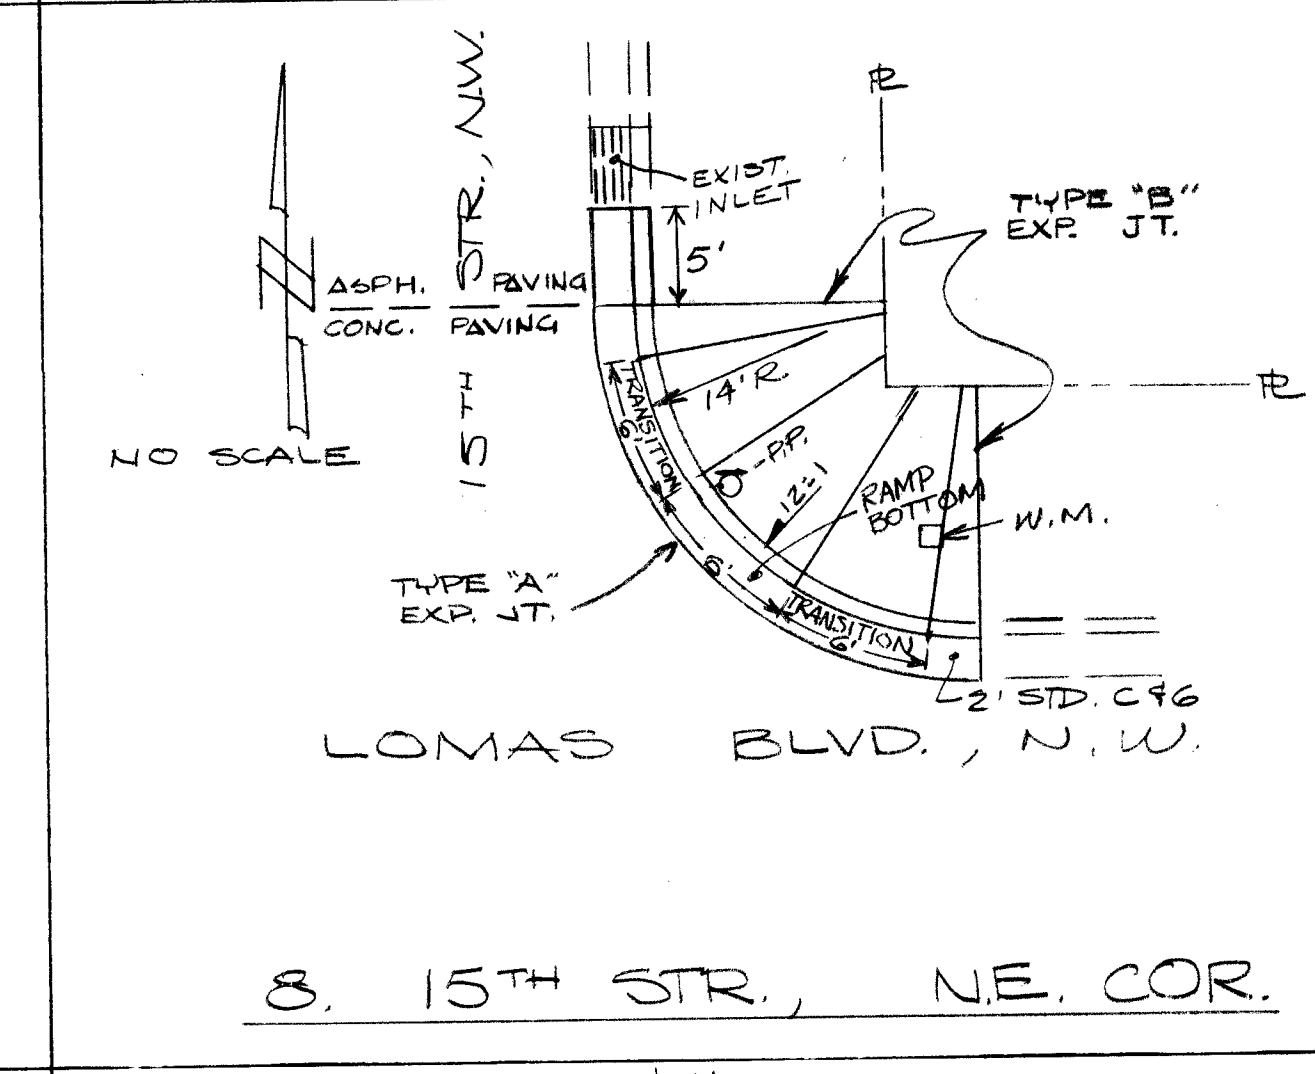


8. 15TH STR., N.E. COR.

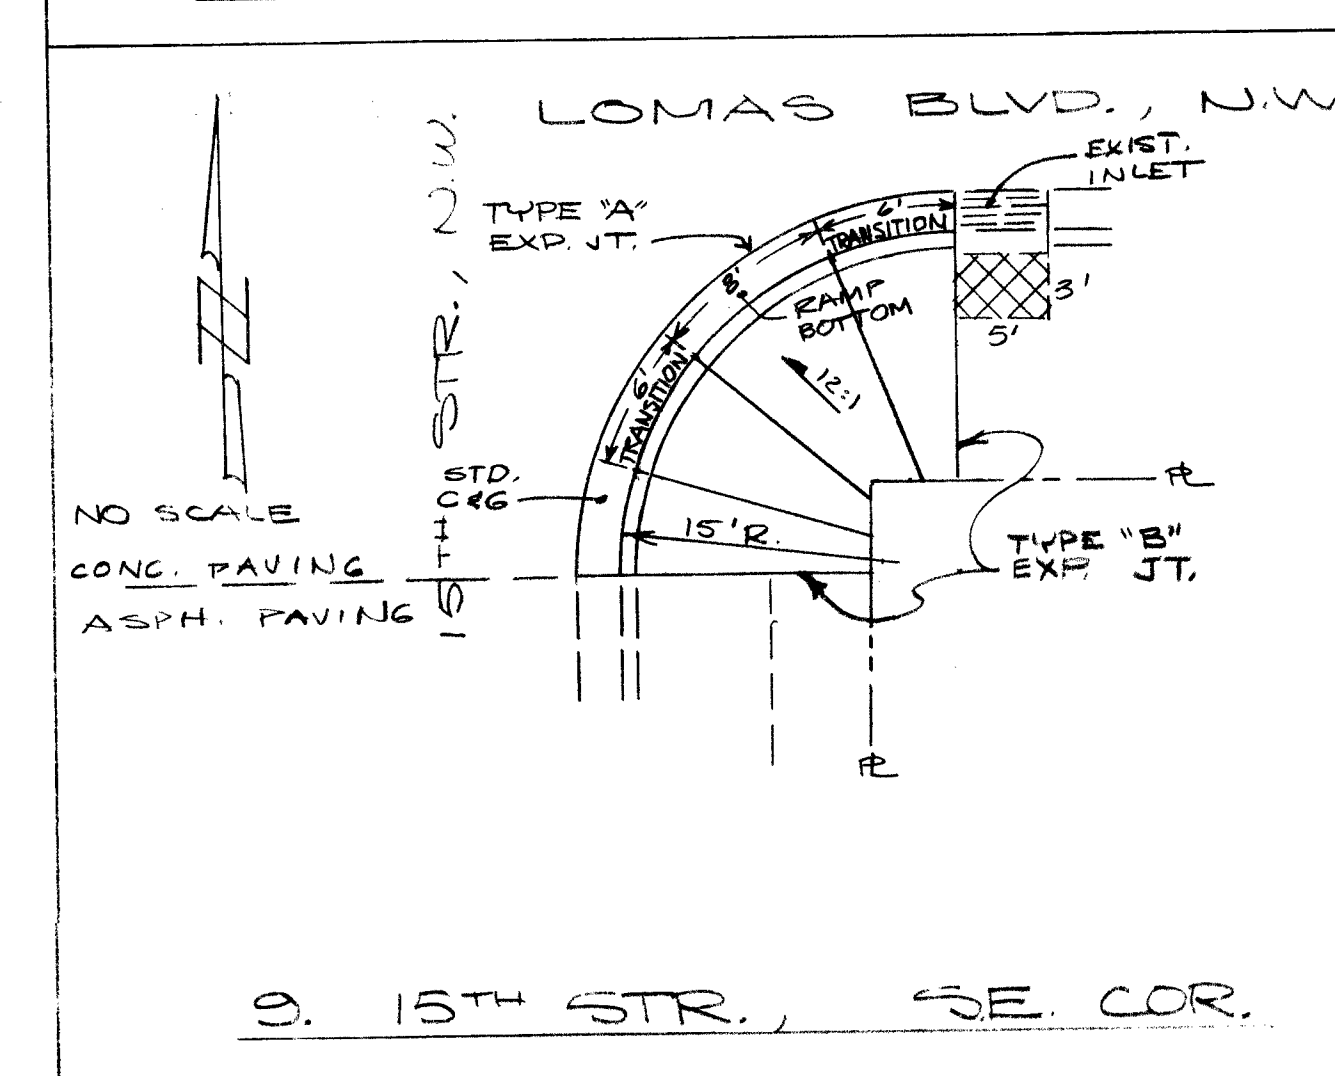


9. 15TH STR., S.E. COR.

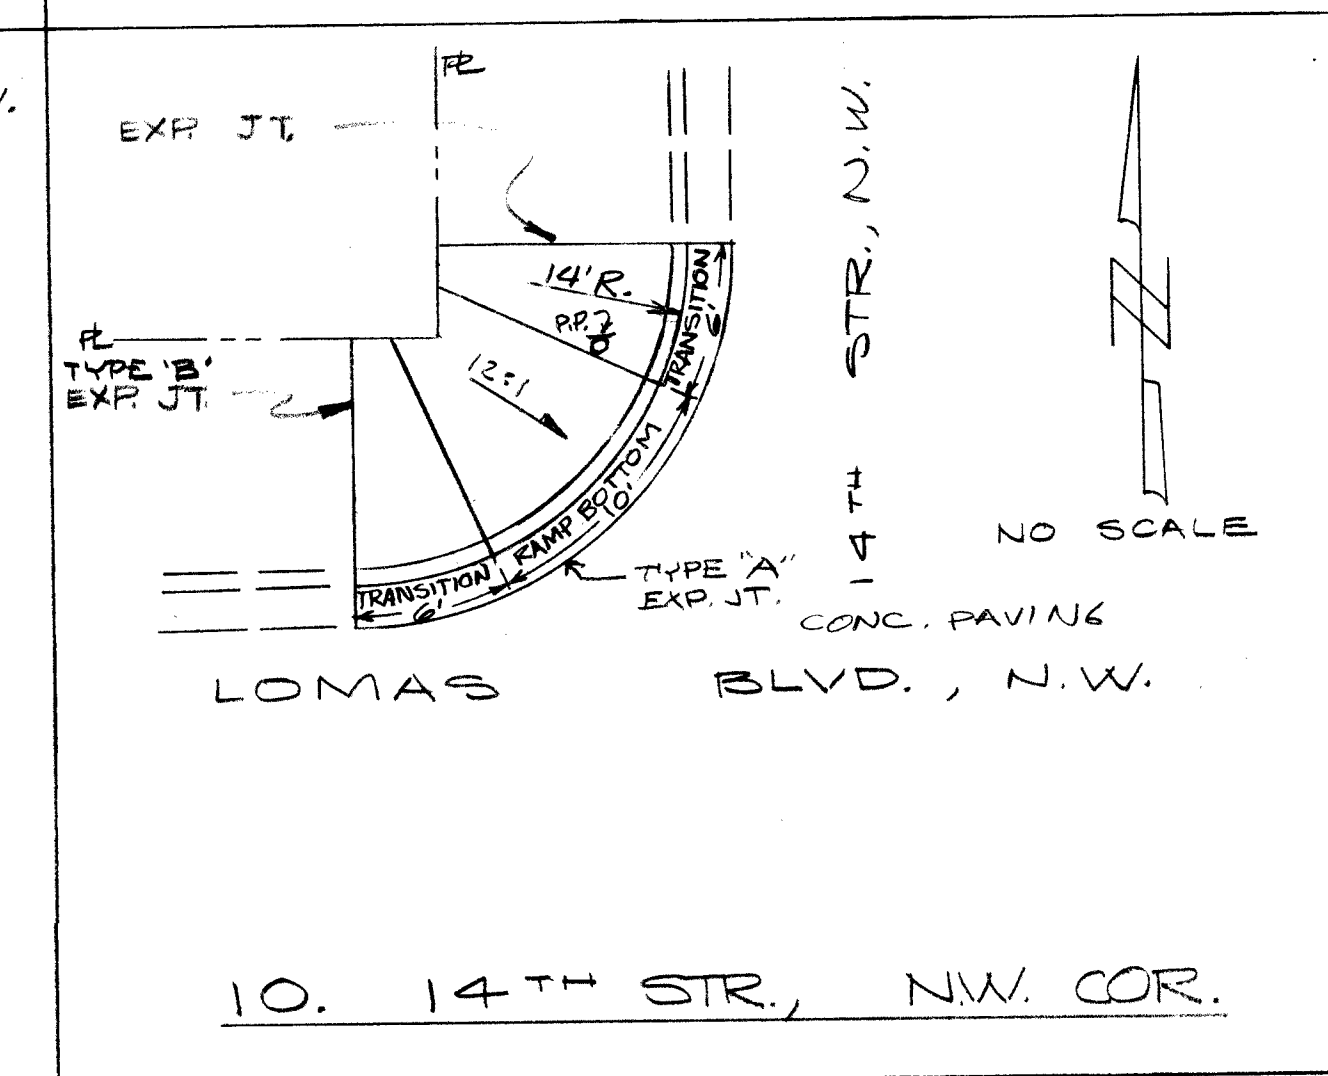


10. 14TH STR., N.W. COR.

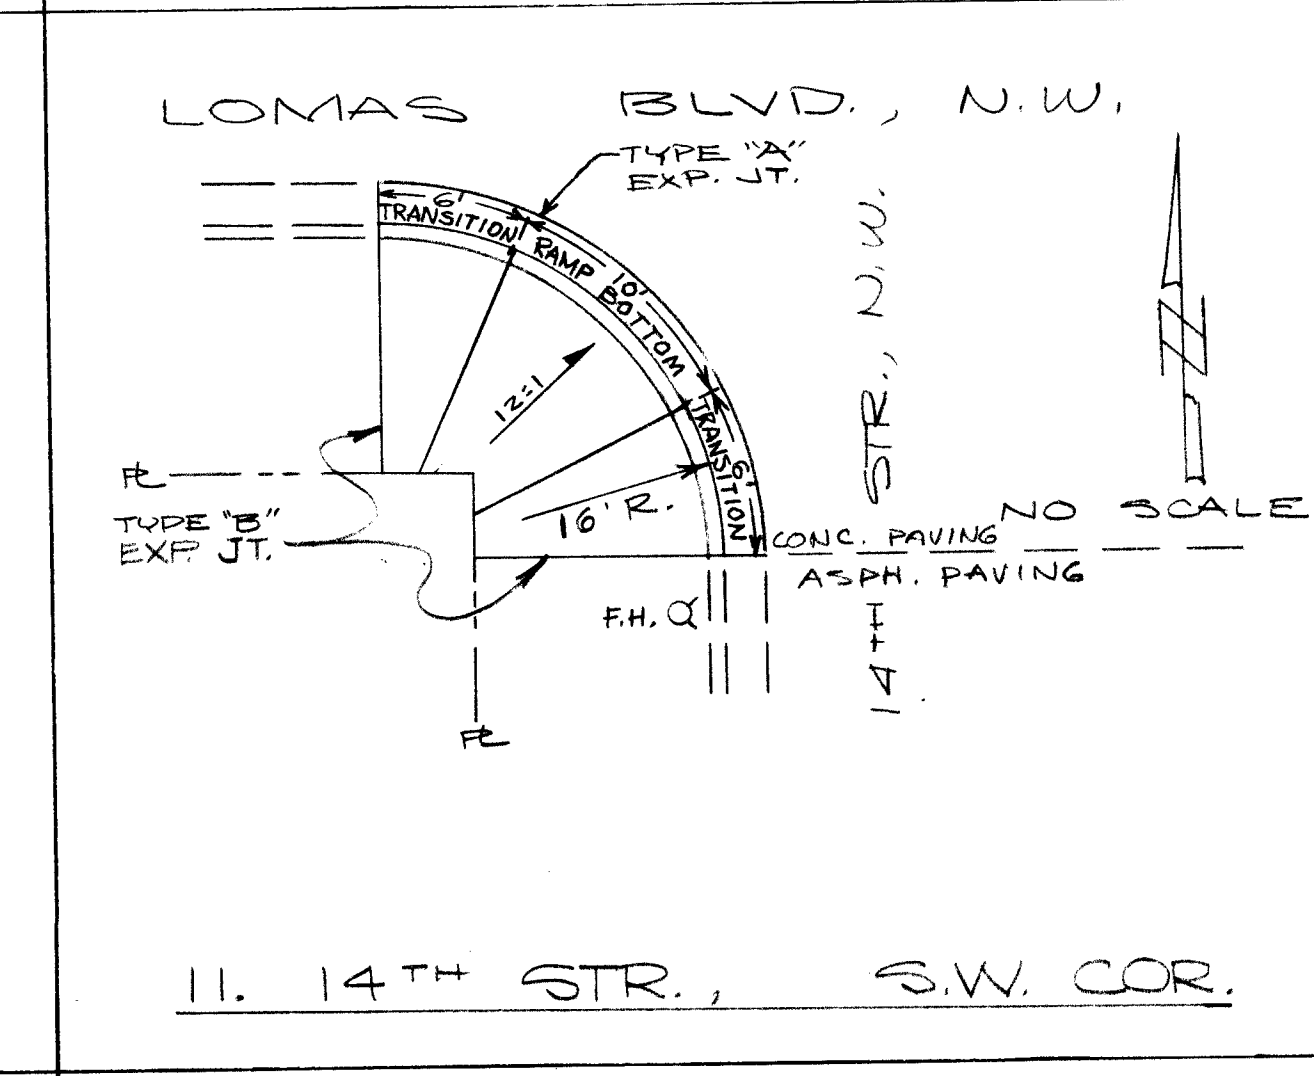


11. 14TH STR., S.W. COR.

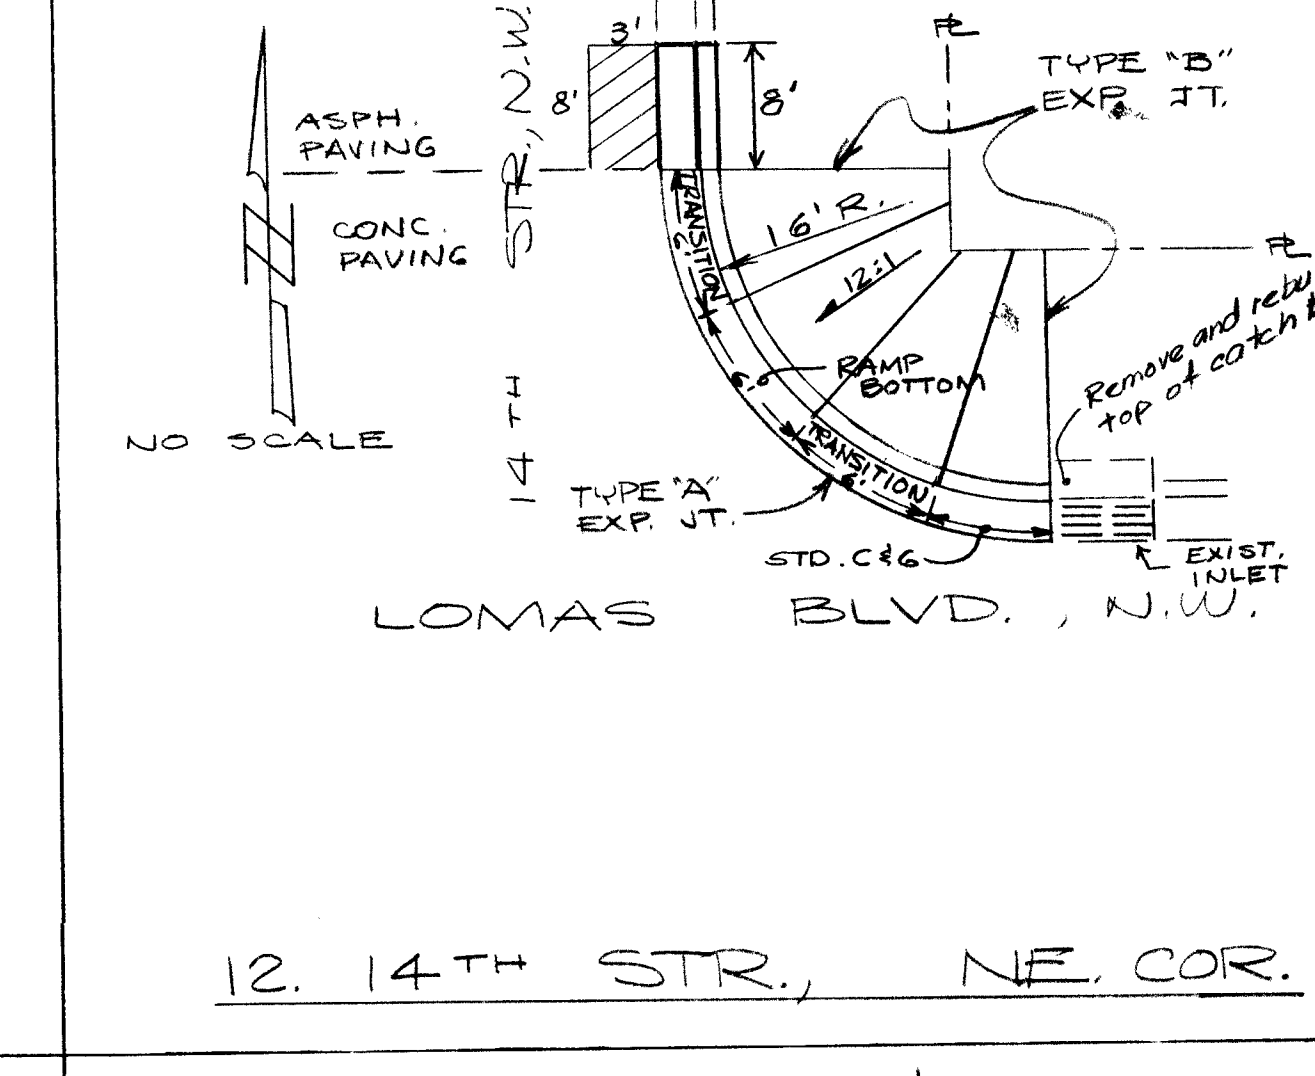


12. 14TH STR., N.E. COR.

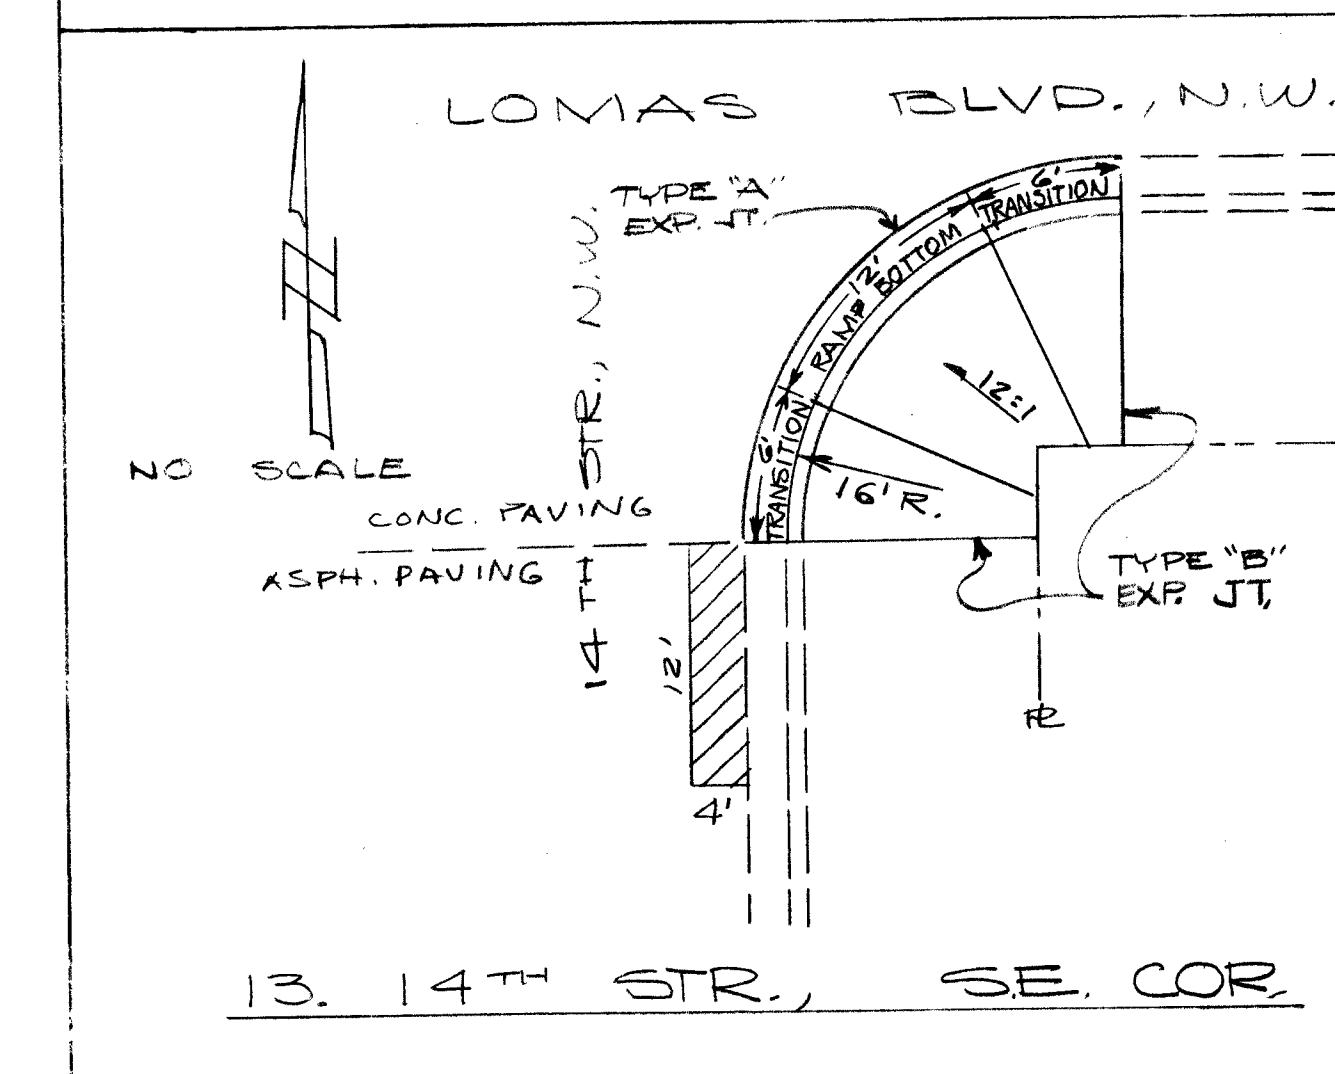


13. 14TH STR., S.E. COR.

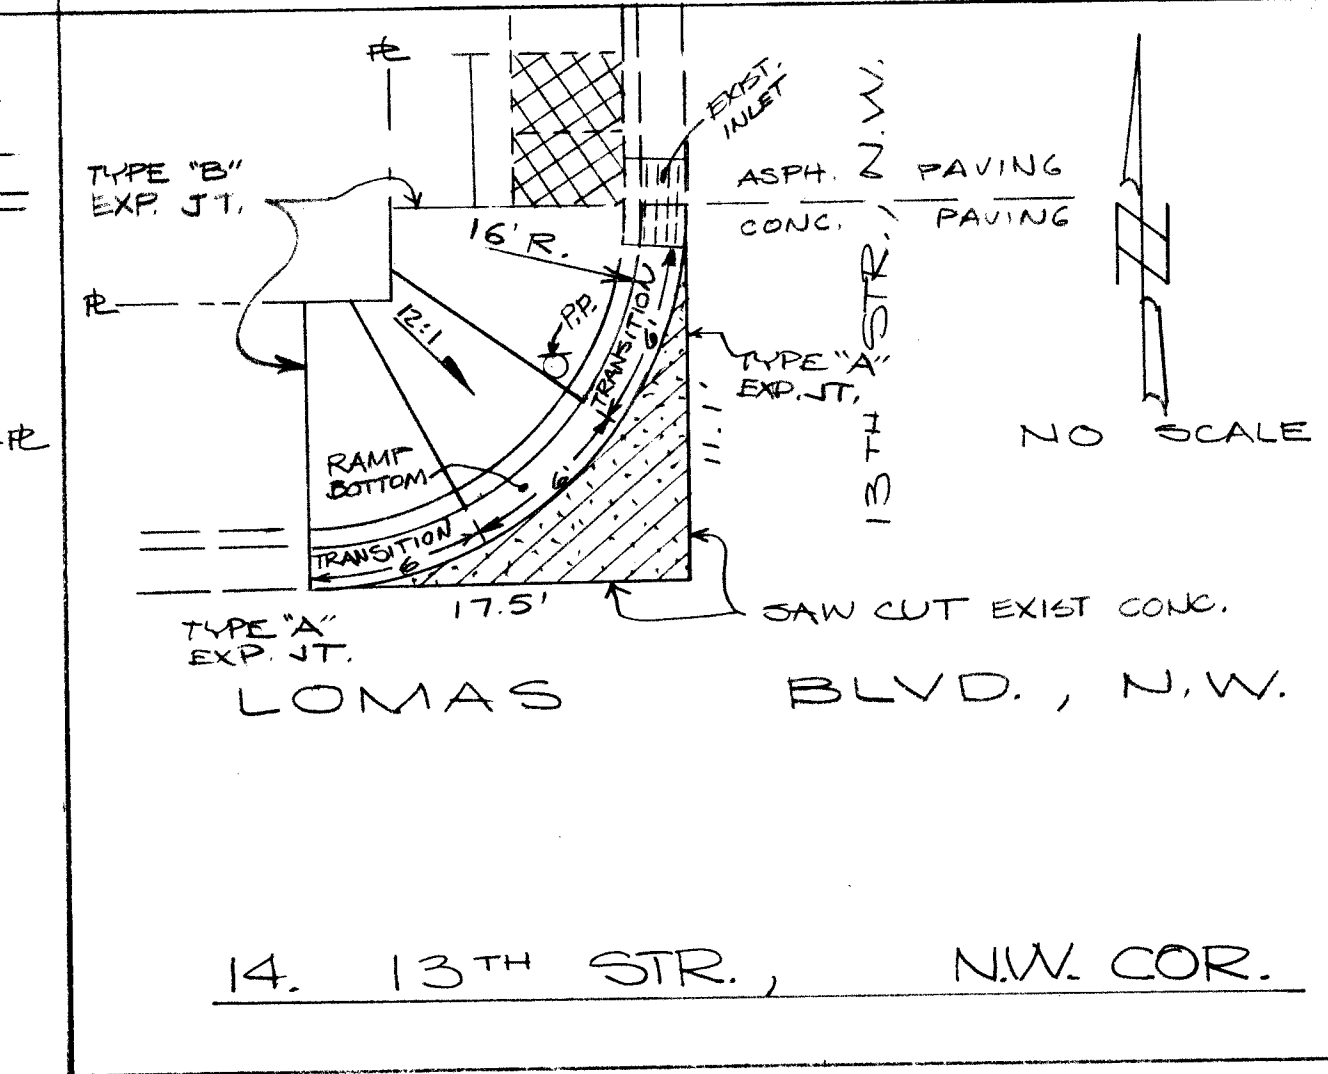

14. 13TH STR., N.W. COR.



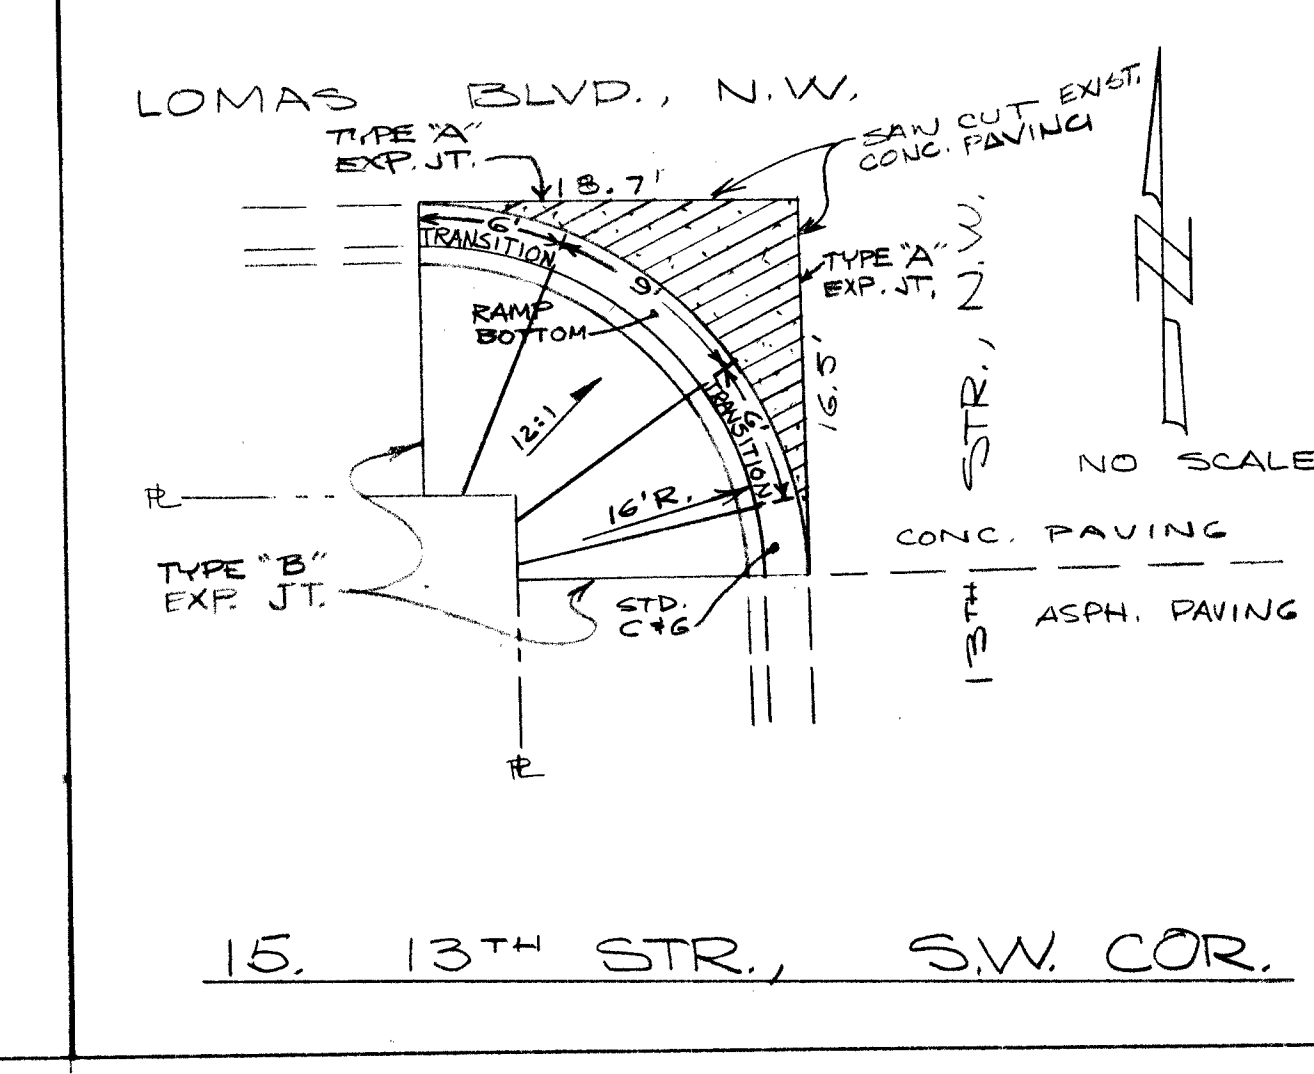



15. 13TH STR., S.W. COR.

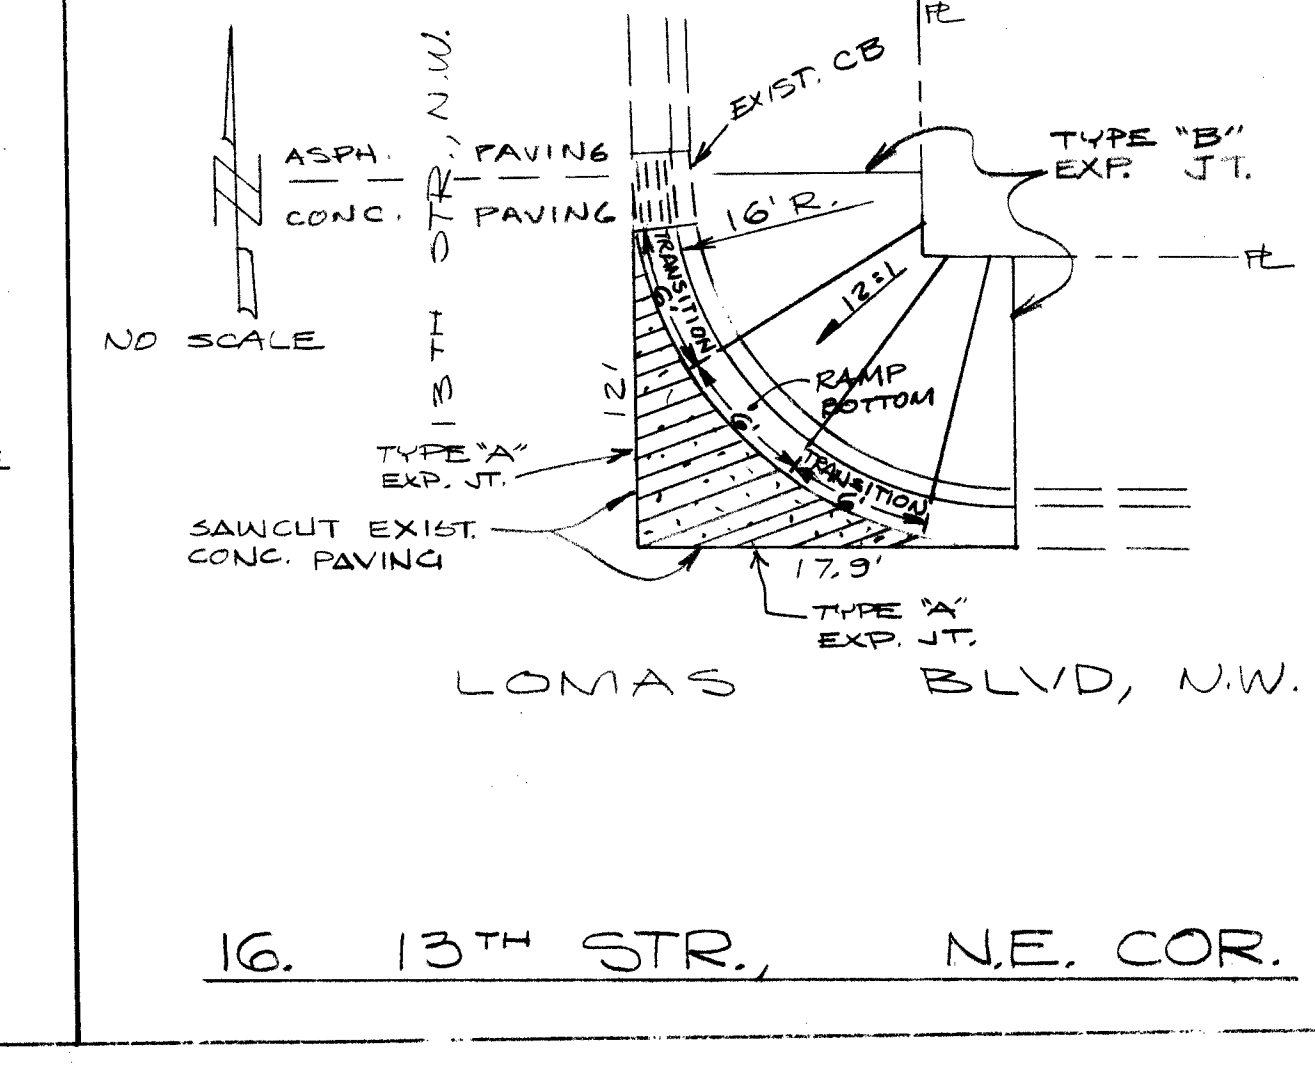


16. 13TH STR., N.E. COR.

LEGEND

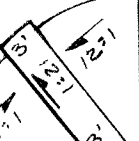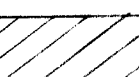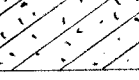-  REMOVE & REPLACE
EXISTING CURB & GUTTER
- =====
- =====
- EXISTING CURB & GUTTER
-  REMOVE EXISTING SIDE
WALK IN RETURN AREA.
BUILD WHEELCHAIR
RAMP AS SHOWN.
-  REMOVE AND REPLACE
EXISTING ASPHALT
PAVING.
-  REMOVE & REPLACE EXIST-
ING CONC. PAVEMENT WITH
3\" data-bbox="115 935 305 1000"/> REMOVE AND REPLACE
EXISTING SIDEWALK.

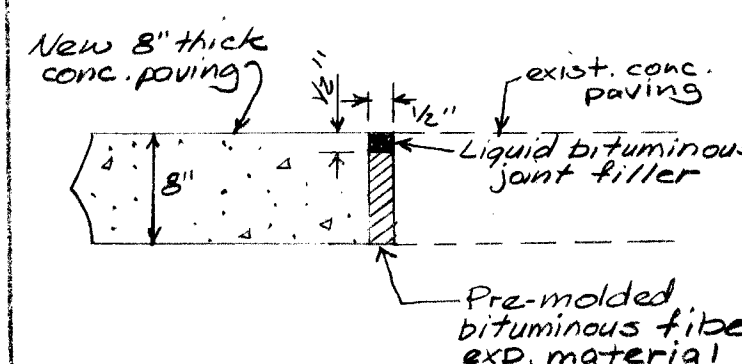

TYPE "A" EXPANSION
JOINT DETAIL
NO SCALE

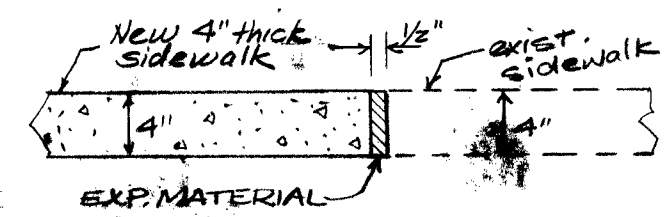

TYPE "B" EXPANSION
JOINT DETAIL
NO SCALE

NOTES:

- ① Expansion material must cover full thickness of concrete.
- ② All measurements given are along curb face. Measurements are approximate and may need minor adjustments in construction. Where ramps are not shown symmetric, measurements are made in a specified direction around the arc and should be constructed in like manner with any unaccounted distance being made up in standard C & G.

1	2	3	4	5	6	7	8	9	10	11	12
20			11	85	02	82					

CITY OF ALBUQUERQUE
MUNICIPAL DEVELOPMENT DEPARTMENT
ENGINEERING DIVISION

TITLE: LOMAS BLVD., N.W., FROM
CENTRAL TO 2nd STR. - WHEELCHAIR
RAMPS AND CURB REPLACEMENT

APPROVALS	ENGINEER	DATE	APPROVALS	ENGINEER	DATE
City Engineer	<i>R.A. [Signature]</i>	<i>3/7/92</i>	Liquid Waste		
A.C.E. - Design	<i>[Signature]</i>	<i>6/08/81</i>	Traffic	<i>R.A. [Signature]</i>	<i>3/29/92</i>
A.C.E. - Hydrology	<i>[Signature]</i>		Water		

ST-MAINTENANCE	<i>St Paul</i>	9-28-61	
DRAWING NO.	1185	MAP NO.	J13-14
		SHEET	2 OF 4

