


CASA GRANDE MANOR
DRAINAGE EASEMENT NE. OF LILLIAN PLACE

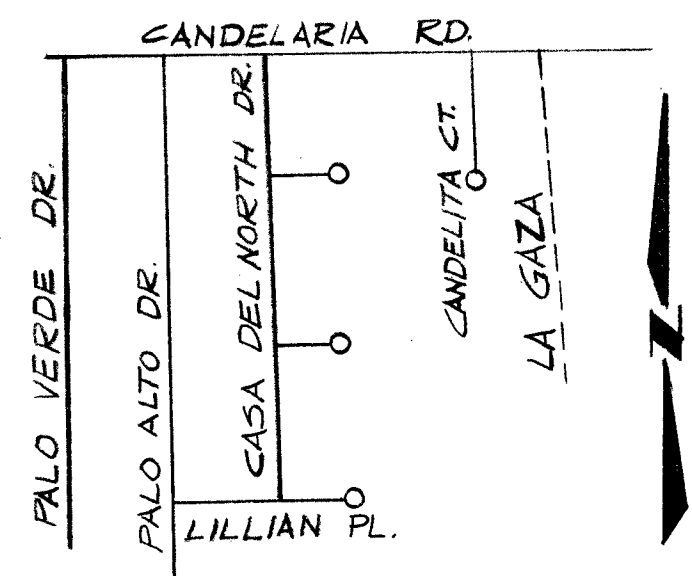

4-23 PM

APPROVAL OF AS BUILT DRAWINGS
ASST. CITY ENGINEER - FIELD
[Signature]
DATE 7-27-88

1	2	3	4	5	6	7	8	9	10	11	12
2	6	1	1	8	7	0	1	8	2		

Richard S. Hiller 5/12/82

1187

1 2

LILLIAN PL

LOT 22A

LOT 23

CASA GRANDE MANOR

SCALE: 1"=10'

EXIST. CURB & GUTTER
EXIST. 4' SIDEWALK

STR. CURB & GUTTER

EXPANSION JOINT

STA. 10+41.67 TO STA. 10+50
TRANSITION FROM FLAT SECTION
TO 4" INVERTED CROWN (SEE
DWG. P-12-1)

4' SIDEWALK

10+50 BEGIN WALL

SURVEYORS @ R/W LINE

EXISTING BLOCK WALL

NEW BLOCK WALL

SECTION "C-C"

BUILD PILASTAR

SEE SECTION "C-C"

SECTION "B-B" NO SCALE

SECTION "B-B" NO SCALE


NOTE:
BREAK OUT AND LIST OF ROCK
IN SHIPPER AREA

DETAIL "A"

SECTION A-A

LEGEND:

- 86.2' - EXIST. GROUND ELEV.
- NEW BLOCK WALL
- NEW C&G

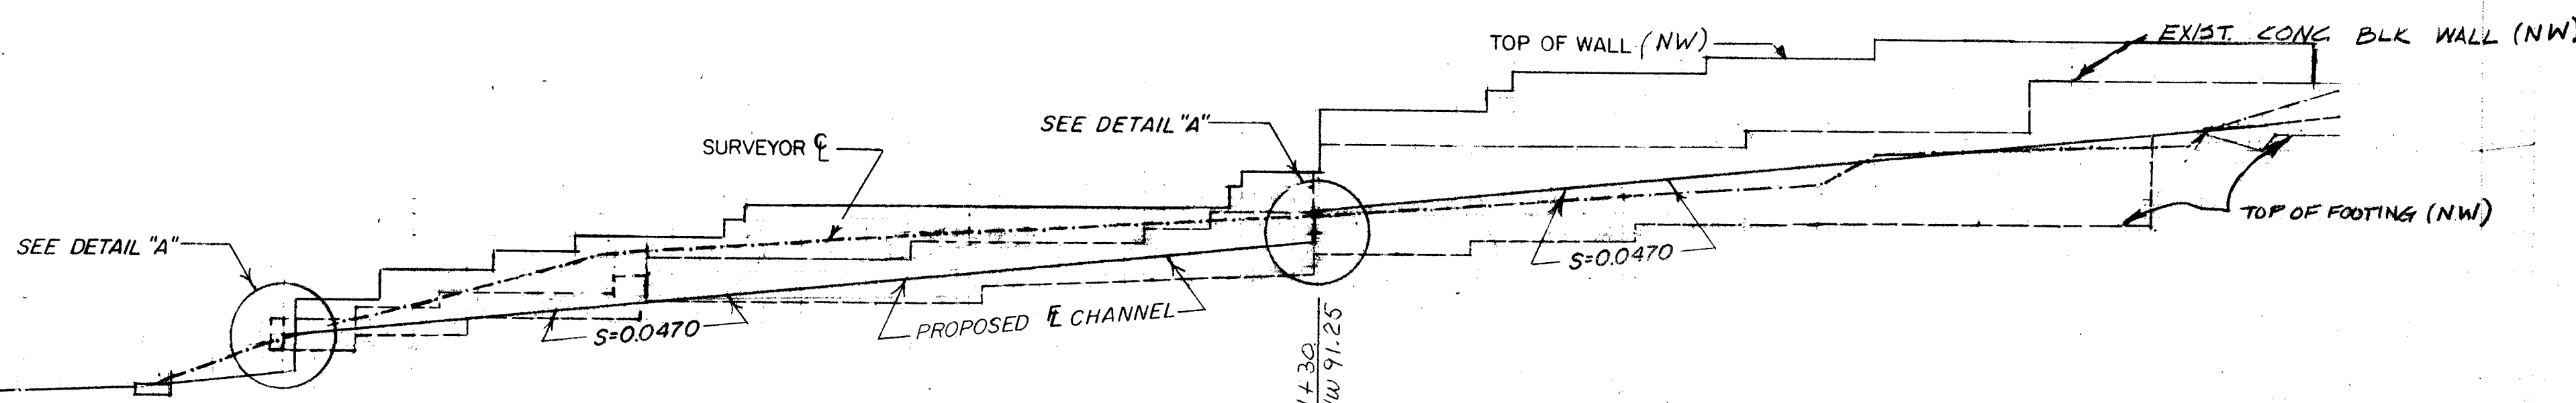

10+39 EDGE OF PAVING
ELEV. 79.87
10+41 CONST. STD. C&G
ELEV. 79.81 80.02
10+50 R/W OF CUL-DE-SAC T/W 83.31
ELEV. 80.44 DOWNSTREAM ELEV. 80.75 #
ELEV. 81.98 UPSTREAM ELEV. 80.86 #
10+57 T/W 84.61

10+66 T/W 85.26
10+72 T/W 85.91
10+84 T/W 86.35
10+86 T/W 87.21
10+90 T/W 83.74

11+23 T/W 87.90
11+24 T/W 88.57
11+29.8
ELEV. 85.74 DOWNSTREAM ELEV. 85.75 #
ELEV. 86.81 UPSTREAM ELEV. 86.81 #

11+43 T/W 91.25
11+45 T/W 92.57
11+60 T/W 93.25
11+66 T/W 88.75
11+73 T/W 93.92

11+98.7 END BLOCK WALL RT.
12+02.85 END OF CHANNEL
ELEV. 90.50 90.36
12+07 END BLOCK WALL LT.

26 11870282

DRAINAGE EASEMENT NE. OF LILLIAN PLACE
BETWEEN LOTS 22 & 23-CASA GRANDE MANOR SUBDIVISION

2/18/82
2/18/82

DRAWING NO. 1187 MAP NO. H-23 SHEET 2 OF 2

C.B.M. - "D" CHISELED ON T.C. ENE
RET @ INT. CASA DEL NORTE & LILLIAN PL.
11/13/81 ELEV. 5867.52
P.S. 18 MERCER P.C.