


SUNSET & CENTRAL REALIGNMENT

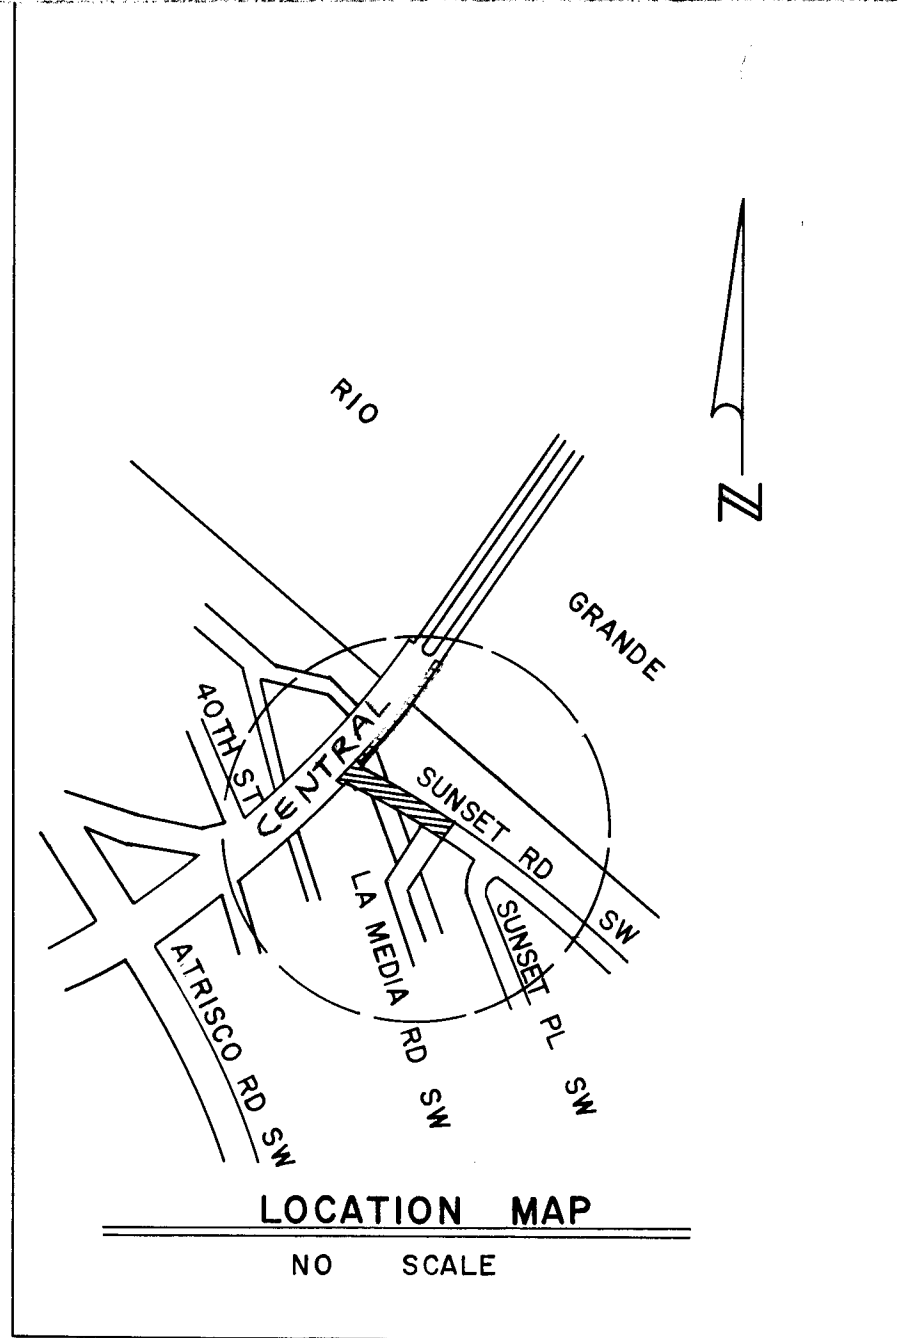

INDEX	
SHEET NUMBER	DESCRIPTION
1	TITLE
2	RIGHT OF WAY
3	LAYOUT OF IMPROVEMENTS
4	PLAN AND PROFILE
5	CROSS SECTIONS


APPROVAL OF AS BUILT DRAWINGS
AUST. CIVIL ENGINEER - FIELD
[Signature]
DATE 12/30/11

26 111980182

REV Δ 1/21/12
APPROVED FOR
CONSTRUCTION
Richard S. Hill 9/23/10


CITY OF ALBUQUERQUE PUBLIC WORKS DEPARTMENT ENGINEERING DIVISION					
FILE SUNSET & CENTRAL REALIGNMENT					
APPROVALS	ENGINEER	DATE	APPROVALS	DATE	DATE
Civil Engineer	<i>[Signature]</i>	11/1/11	Civil Engineer	N/A	5/21/11
Public Works	<i>[Signature]</i>	2/4/12	Public Works	N/A	
Water	<i>[Signature]</i>	9/3/11	Water		
DRAWING NO.	1198				
SHEET 1			OF 4		

BENCH MARKS		SURVEY INFORMATION		REVISIONS	
DATE	BY	NO.	DESCRIPTION	DATE	BY
12-21-78	MRGCD	OTB # 2-4962.13	ANGEL	11/1/12	REV SHTS 3 & 4 (GRADES)
MICROFILM INFORMATION		REVISIONS			
		DATE	BY	DESCRIPTION	DATE
				C. TOMLINSON	
				B. EMMETT	

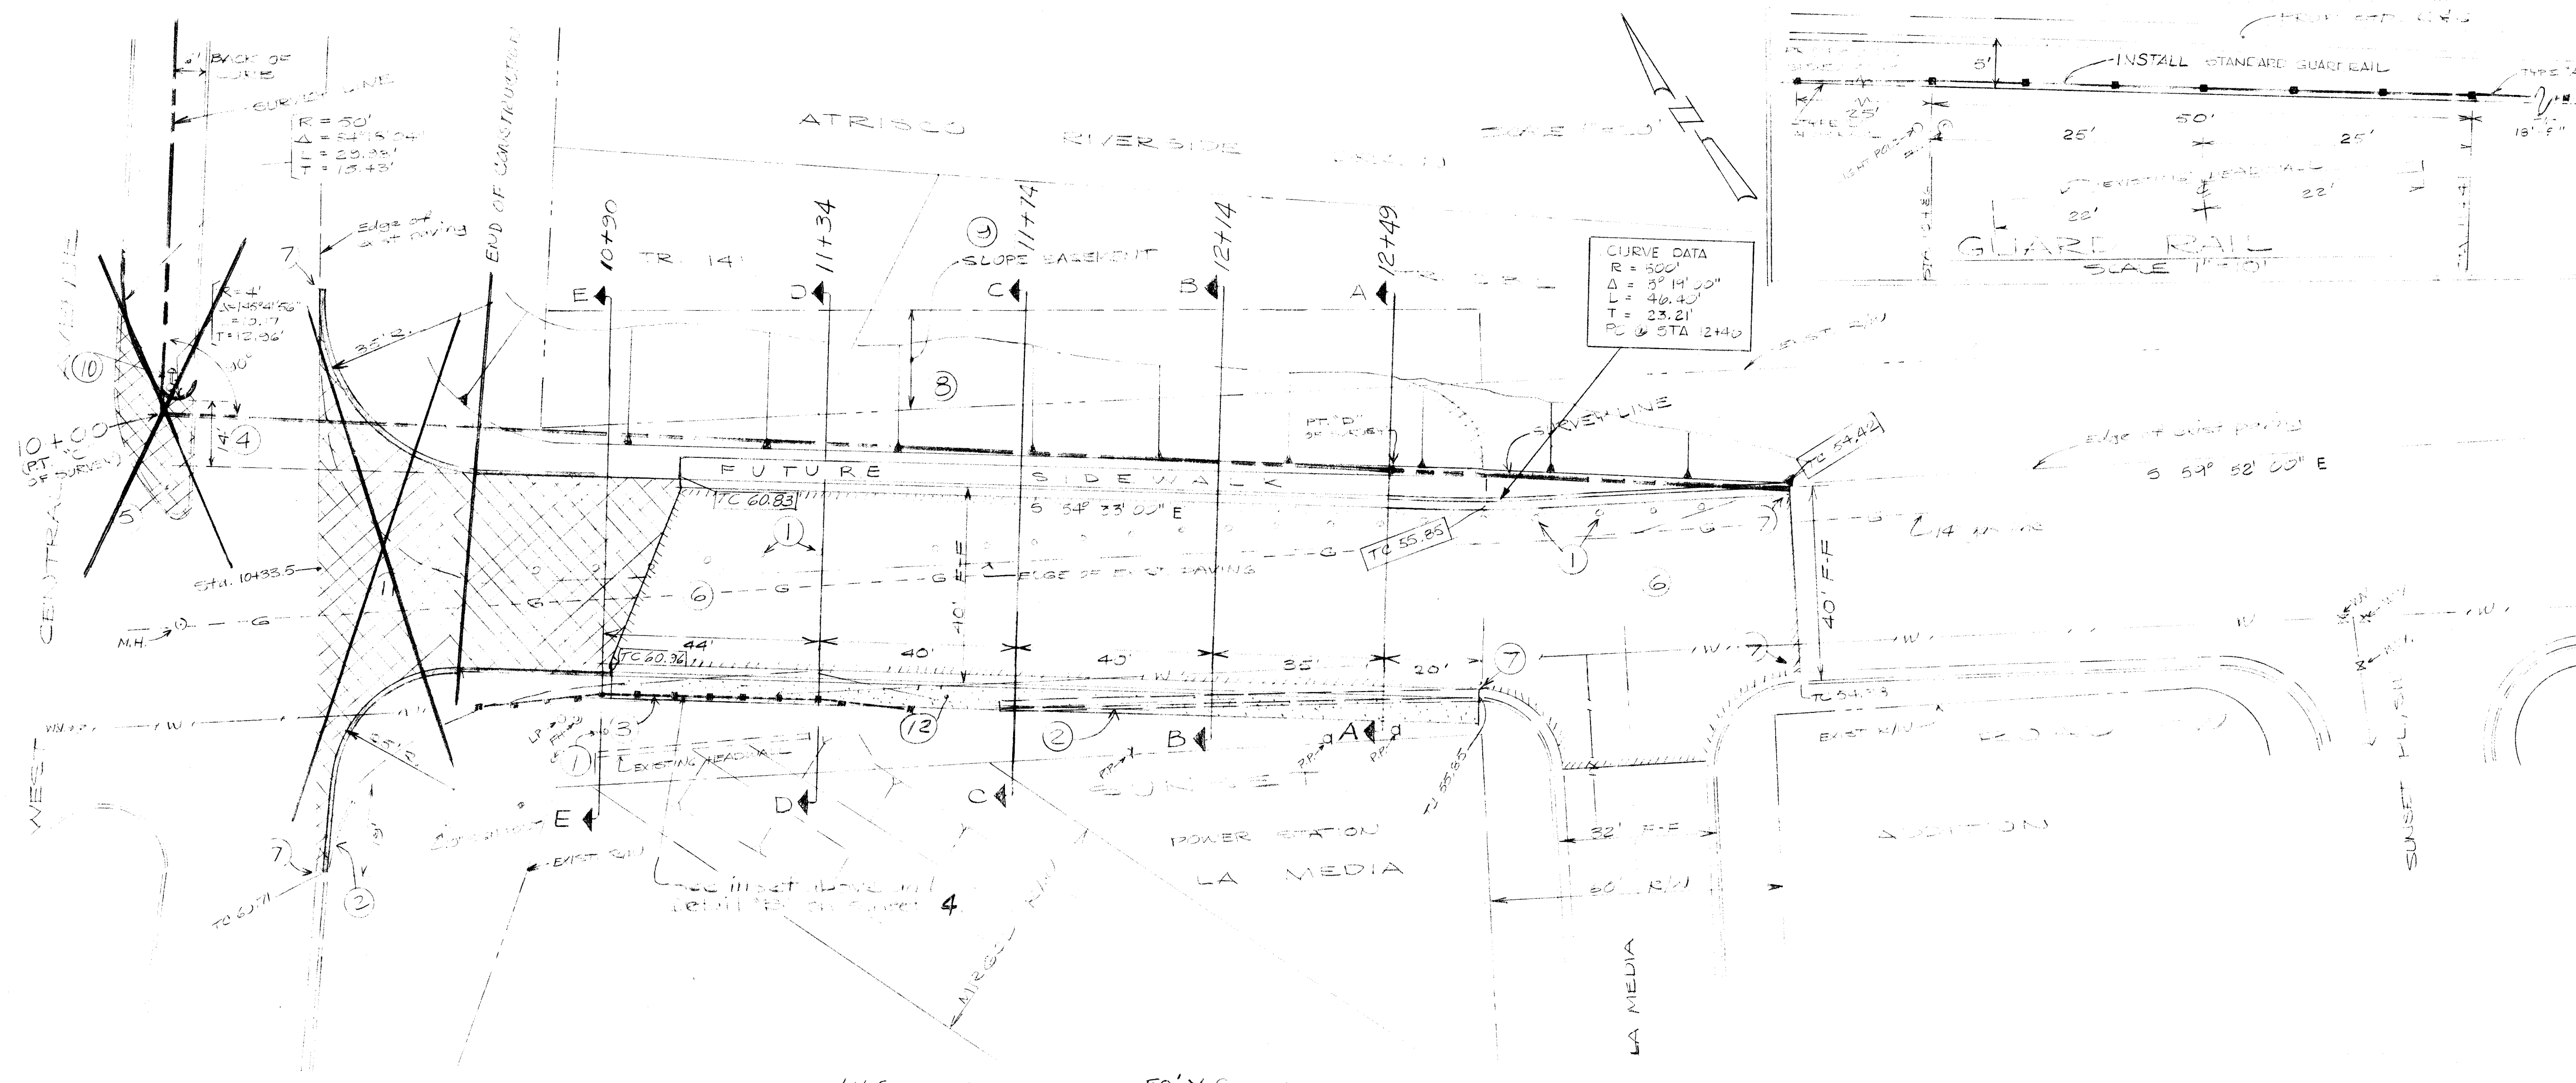

- ### NOTES
1. Remove guard rail.
 2. Remove existing curb & gutter.
 3. Build 55' of 4' standard gutter curb inside sidewalk with Types 2A, 2B, and 2C. (See Detail E, sheet 4).
 4. Relocate median rise 14' east of N. E. of Sunset Rd.
 5. Remove median asphalt curb. Replace with 2" AC surface course.
 6. Remove existing oil mat between E. 10+88.5 and 13+81.5. Build 5" curb & gutter. Repave with residential-type pavement from beginning of curb & gutter to Sta. 13+81.5.
 7. Match existing grades.
 8. Build embankment per section on sheet 4.
 9. Slope embankment as shown on sheet 2. Slope embankment prior to construction.
 10. PNM to move offset part of curb to new location.
 11. Remove 2" AC surface course and 2" AC base course.
 12. Build 4' wide sidewalk.

- ### LEGEND
- PROPOSED STD. CURB & GUTTER
 - EXISTING CURB & GUTTER
 - PROPOSED 2" AC SURFACE COURSE (TRAFFIC LANE)
 - PROPOSED ASPHALT CURBING
 - PROPOSED FINISH ELEVATION
 - EXISTING ELEVATION
 - EXISTING WATER LINE
 - EXISTING GAS LINE
 - EXISTING POWER POLE
 - EXISTING MANHOLE
 - EXISTING FIRE HYDRANT
 - EXISTING WATER VALVE
 - EXISTING LIGHT POLE

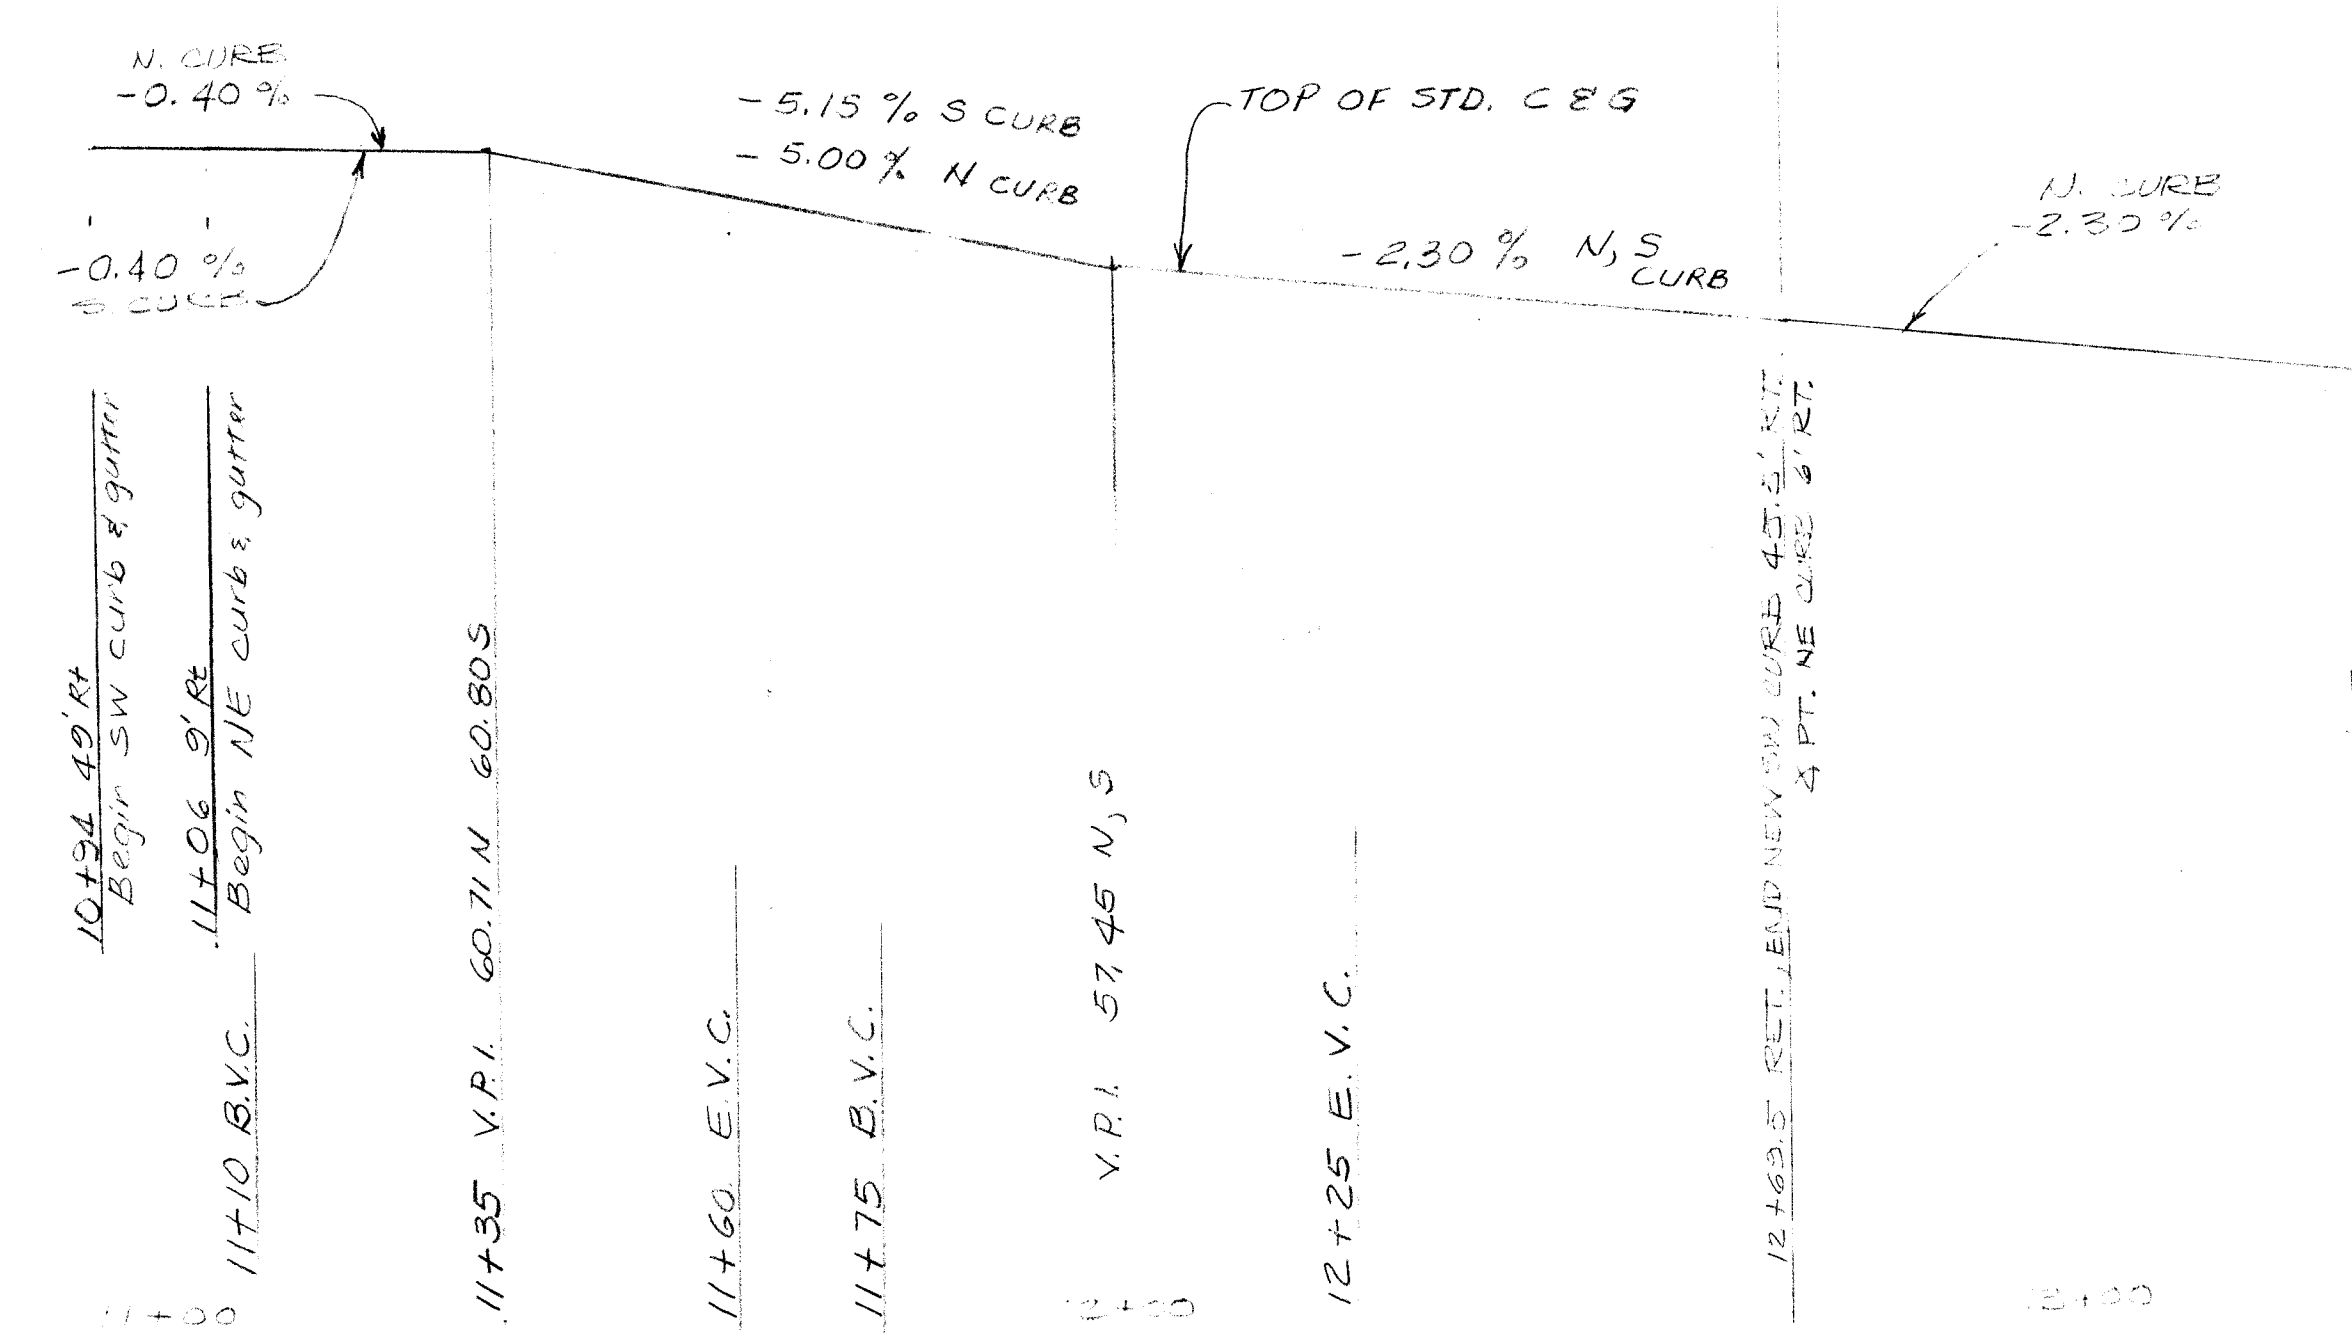




26 11/98 0387

SUNSET BLVD. AND CENTRAL AVENUE - PLAN & PROFILE



8/18/01
C. Tolunbo
B. Emmett

11/98 K12

3 OF 4

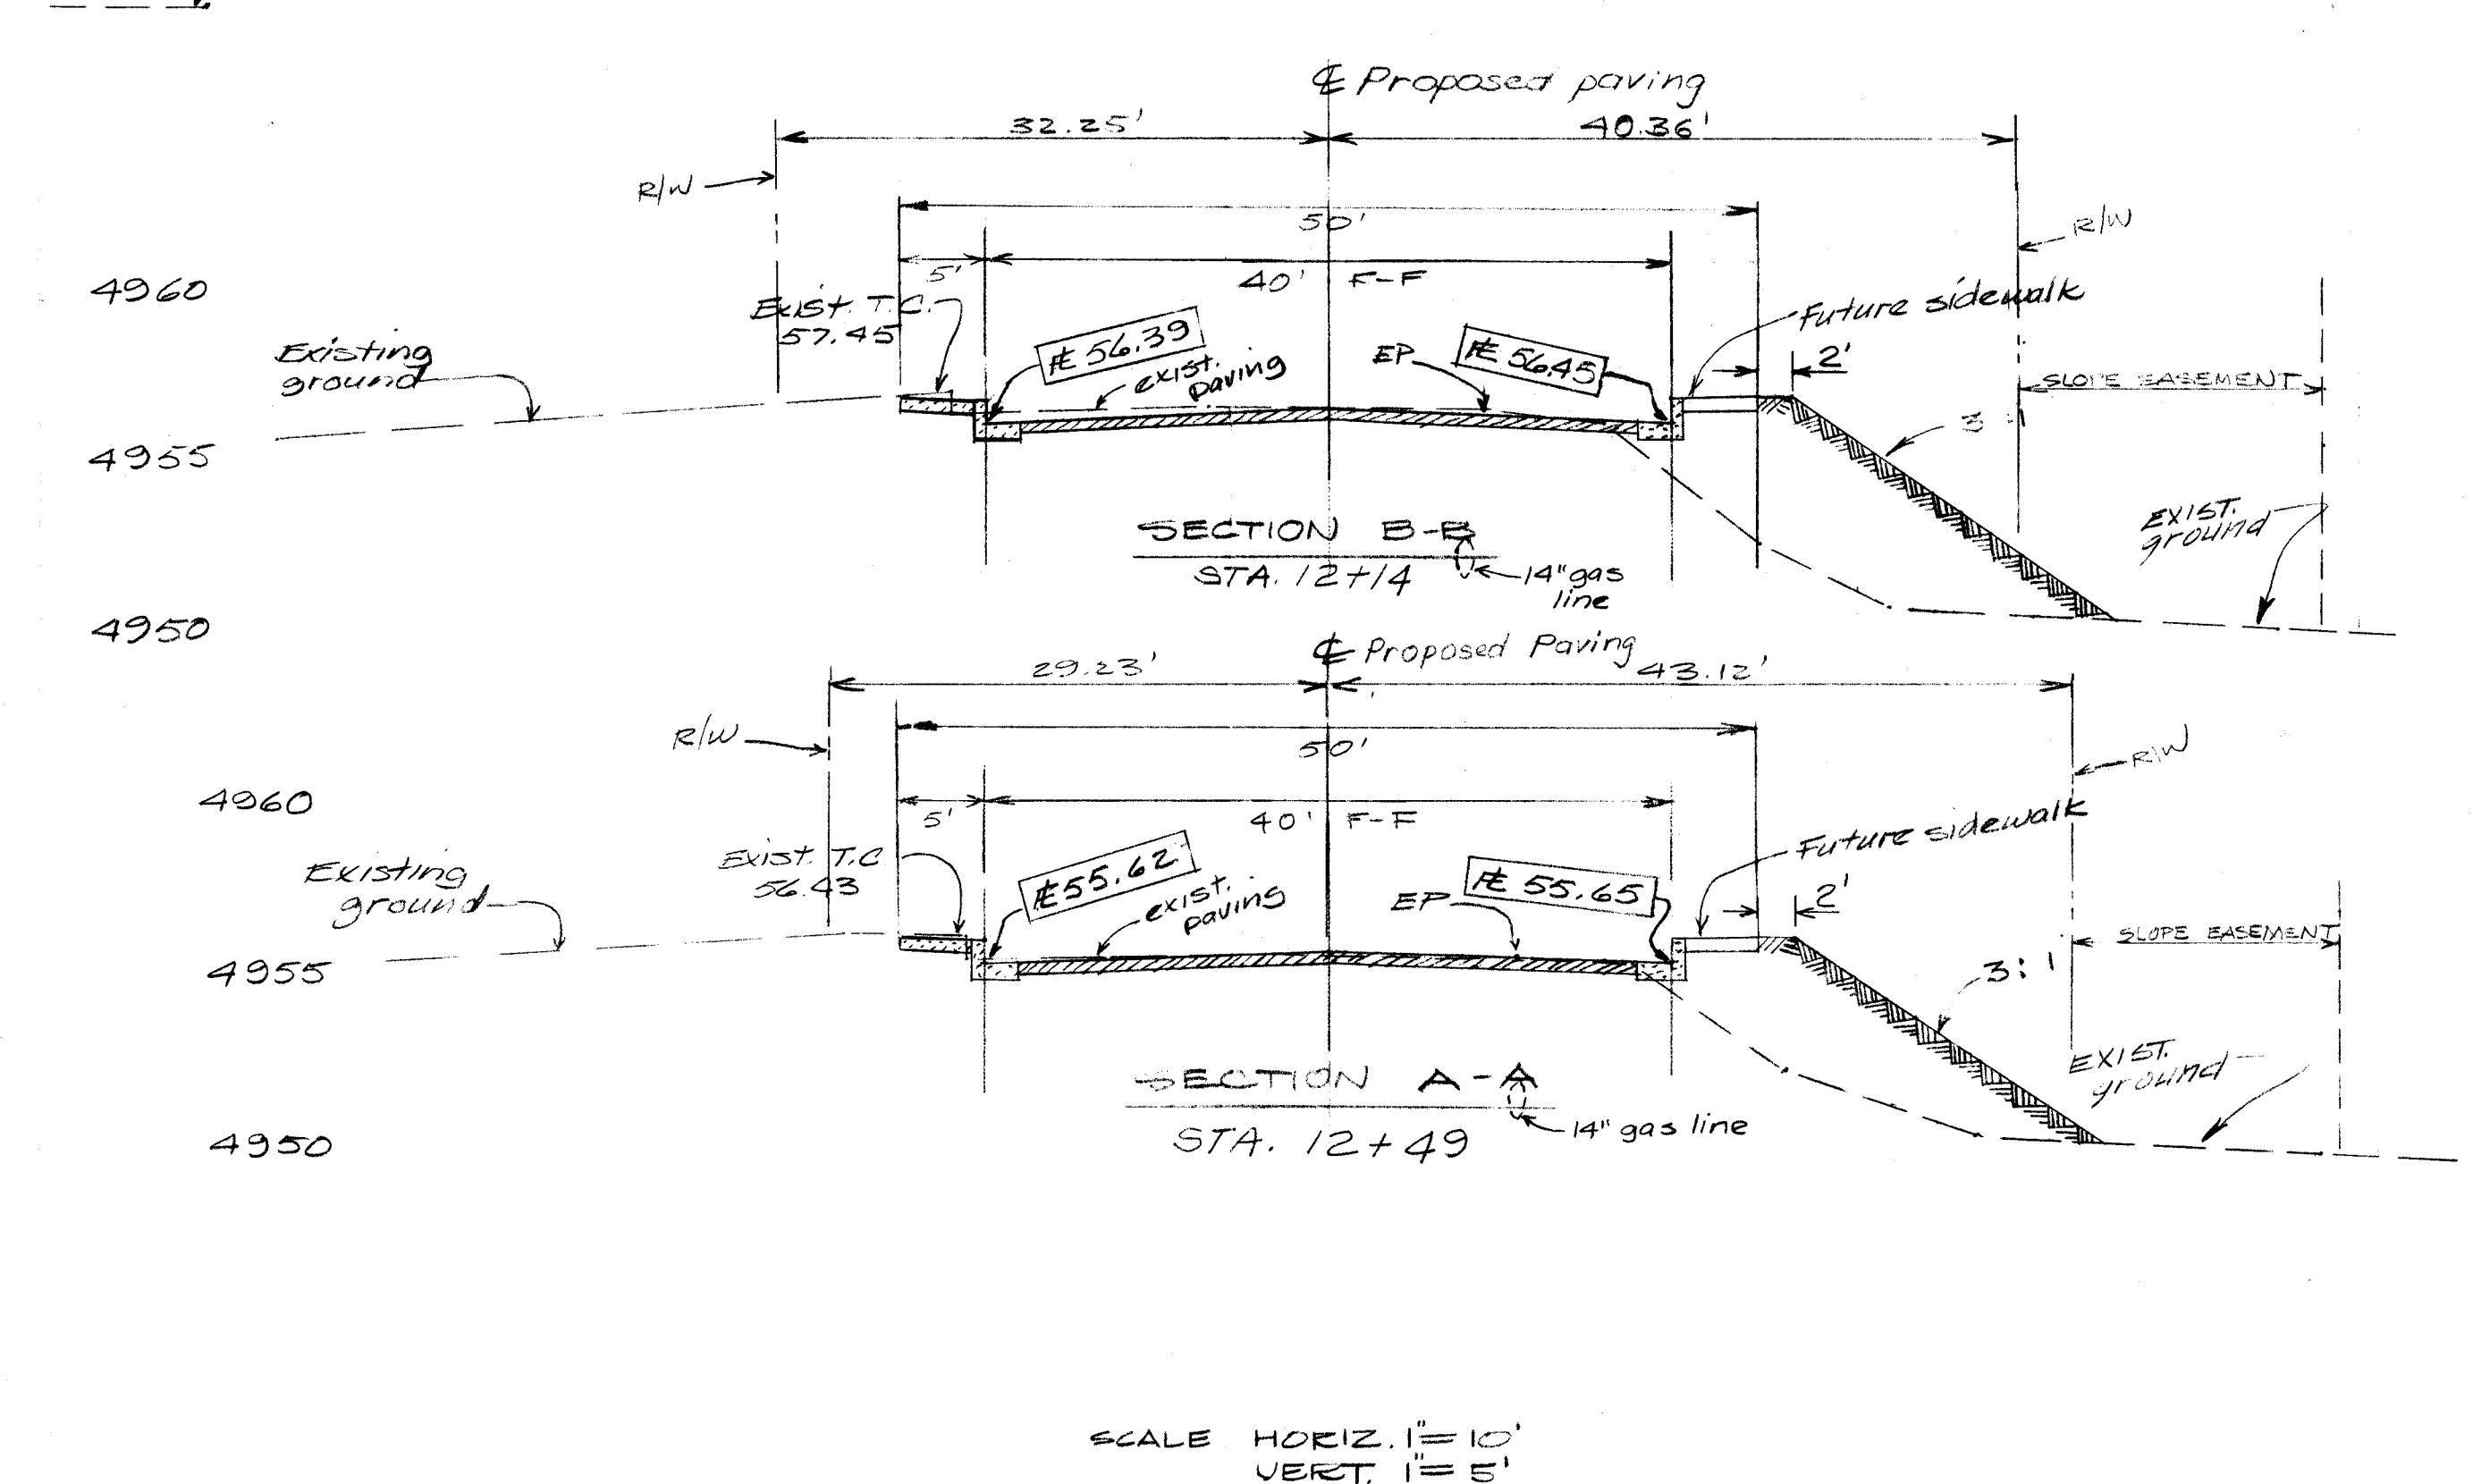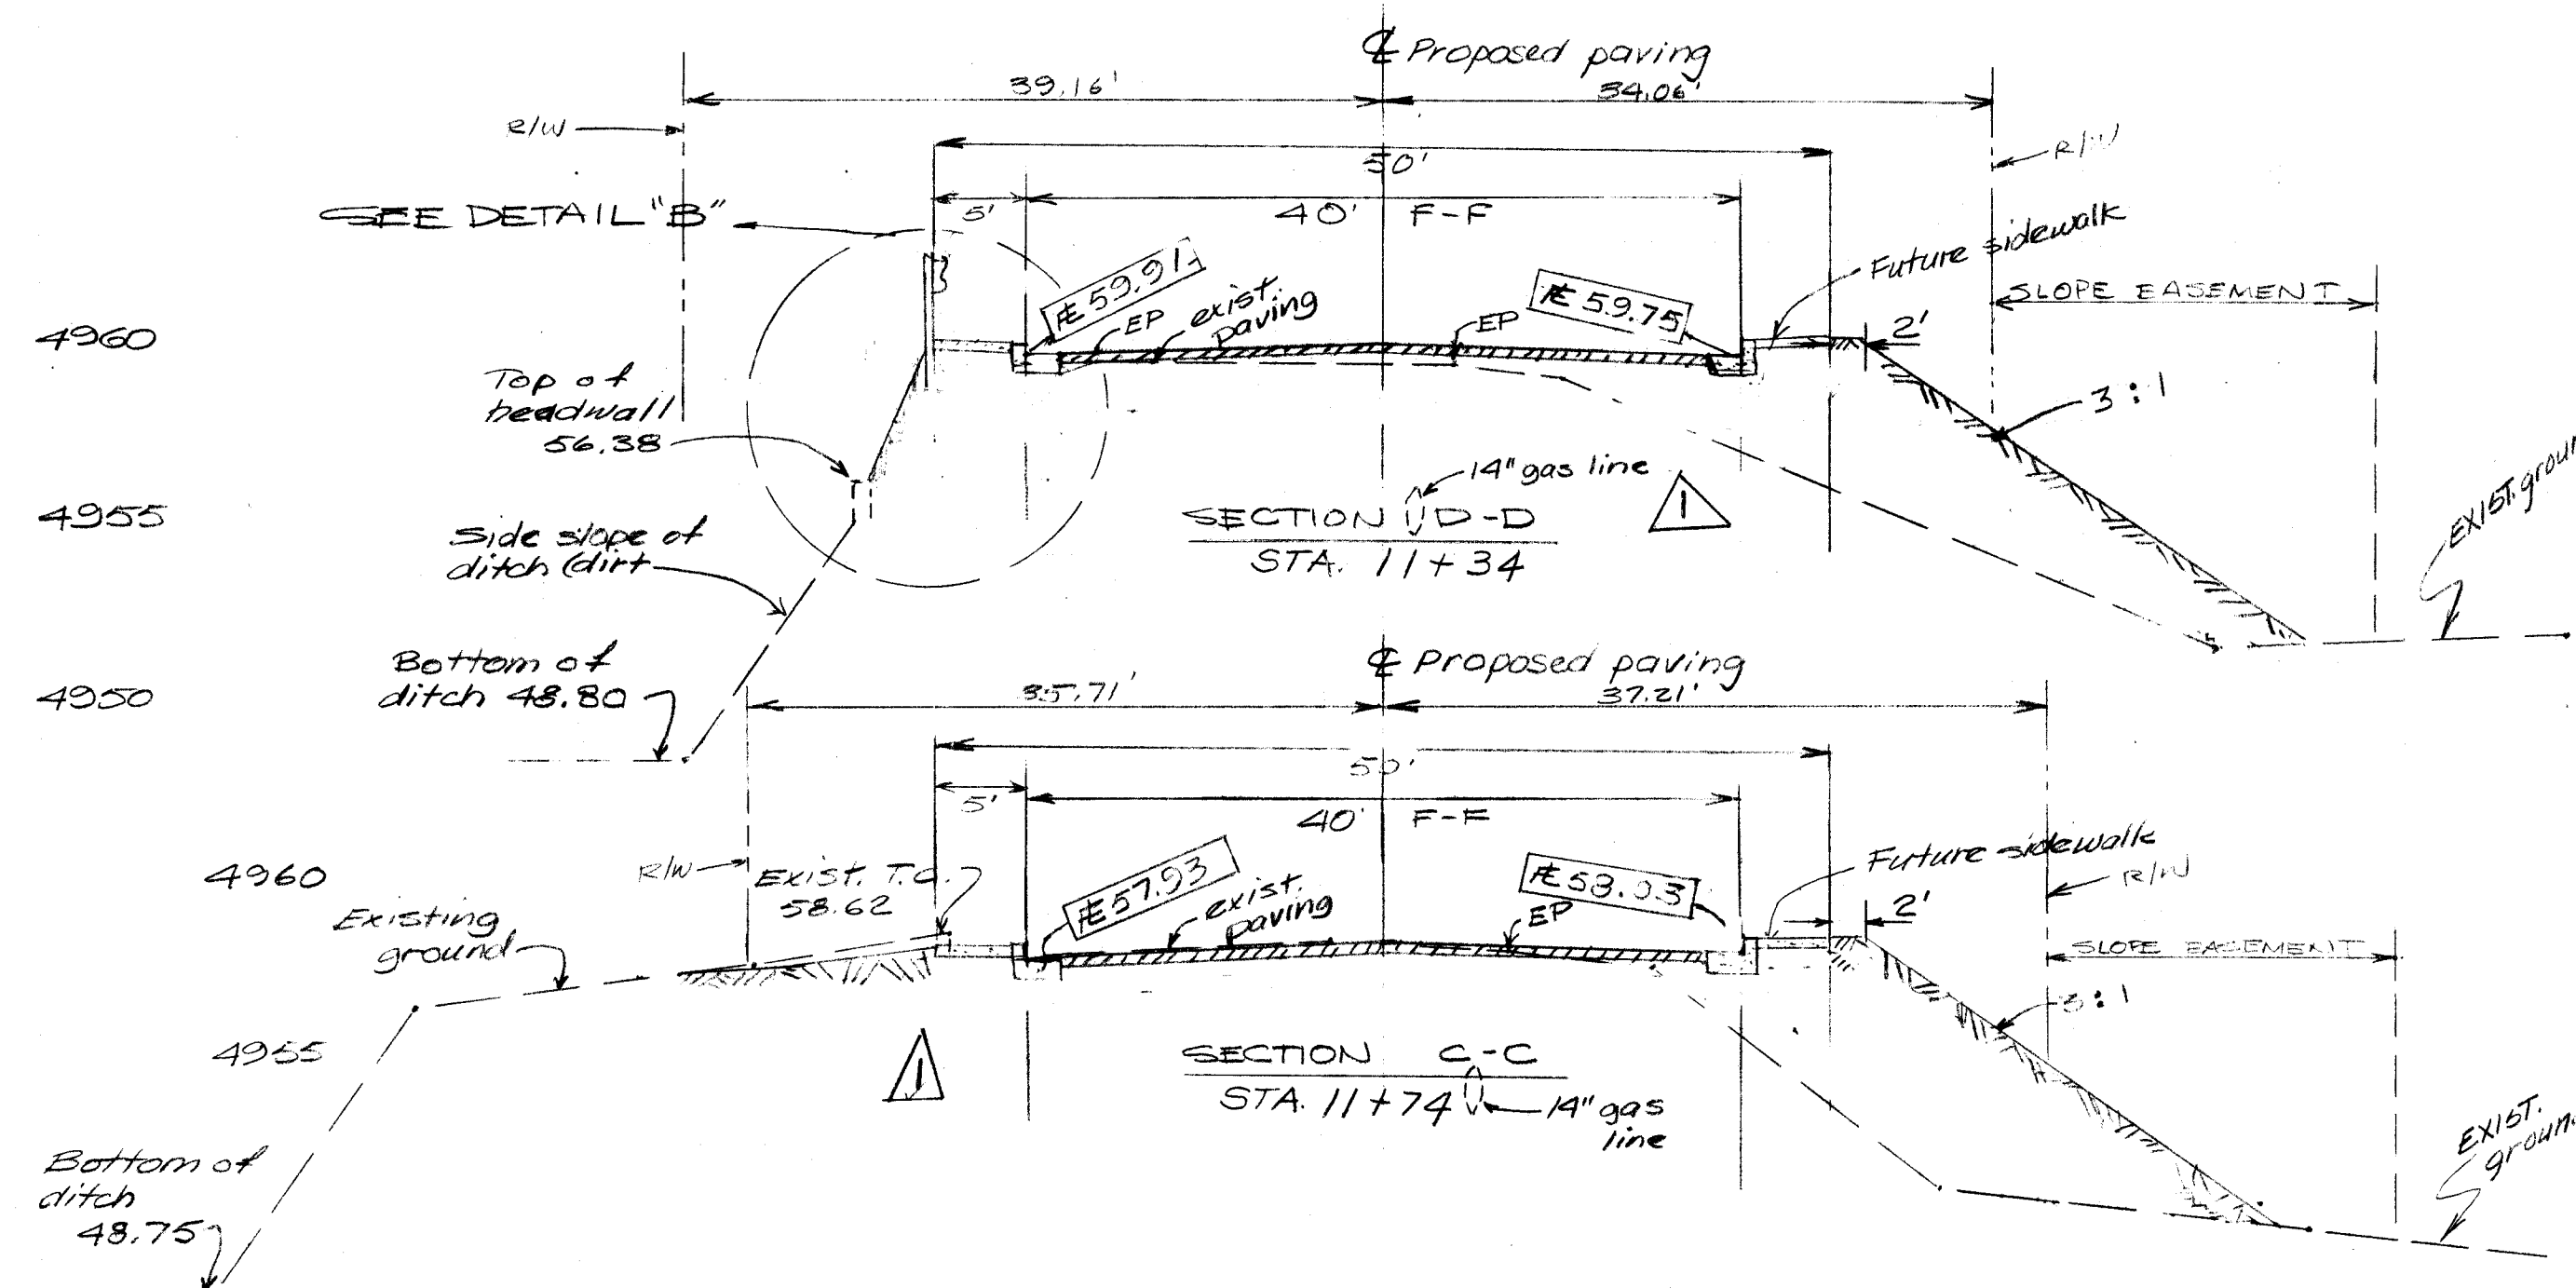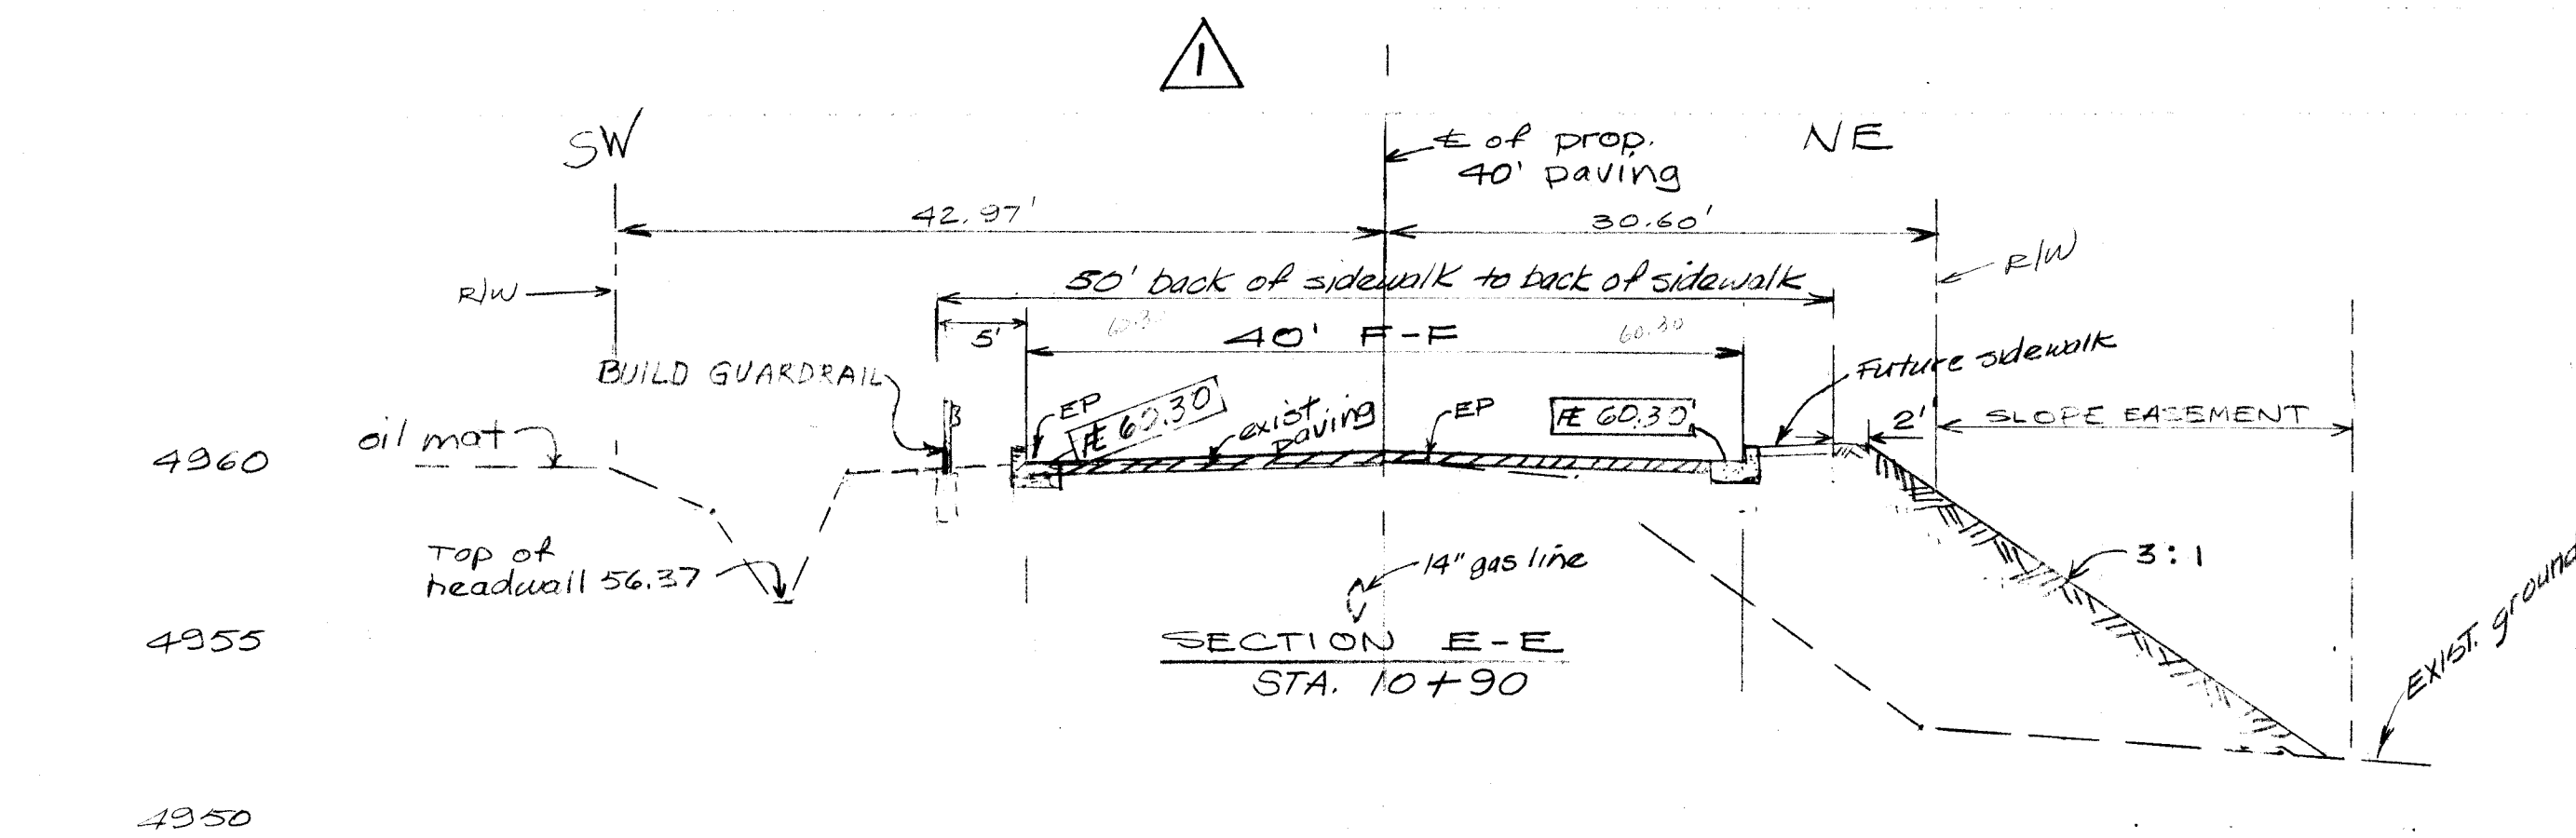

SCALE HORIZ. 1" = 10'
VERT. 1" = 5'

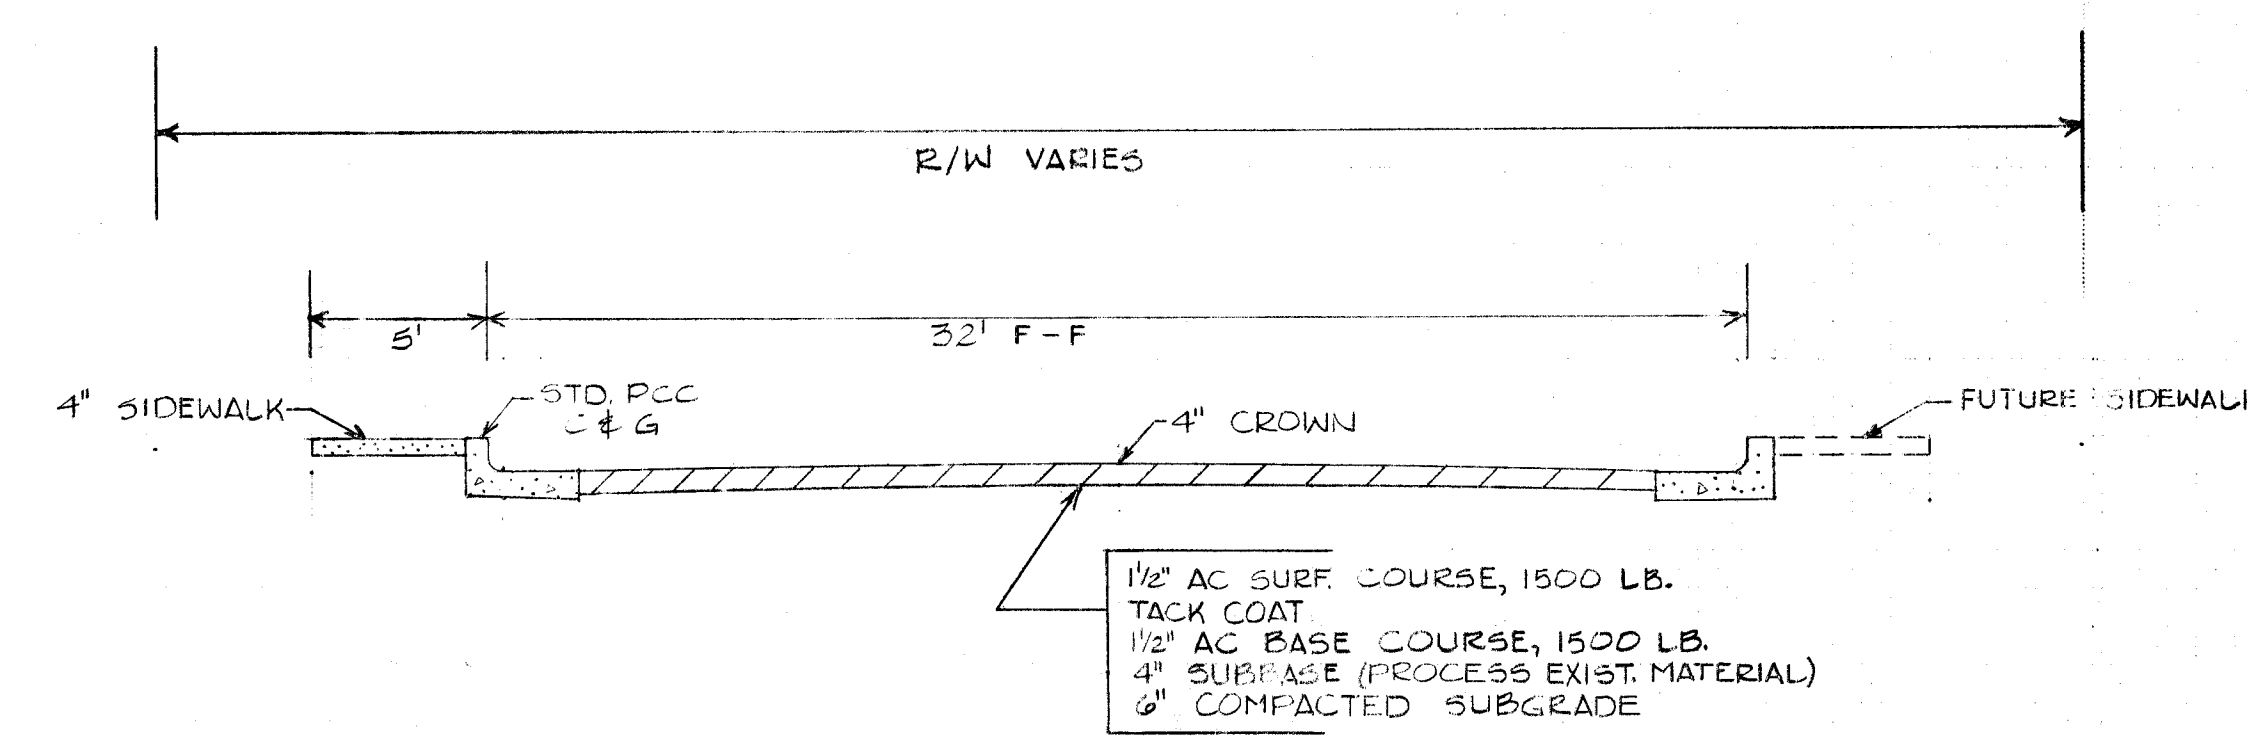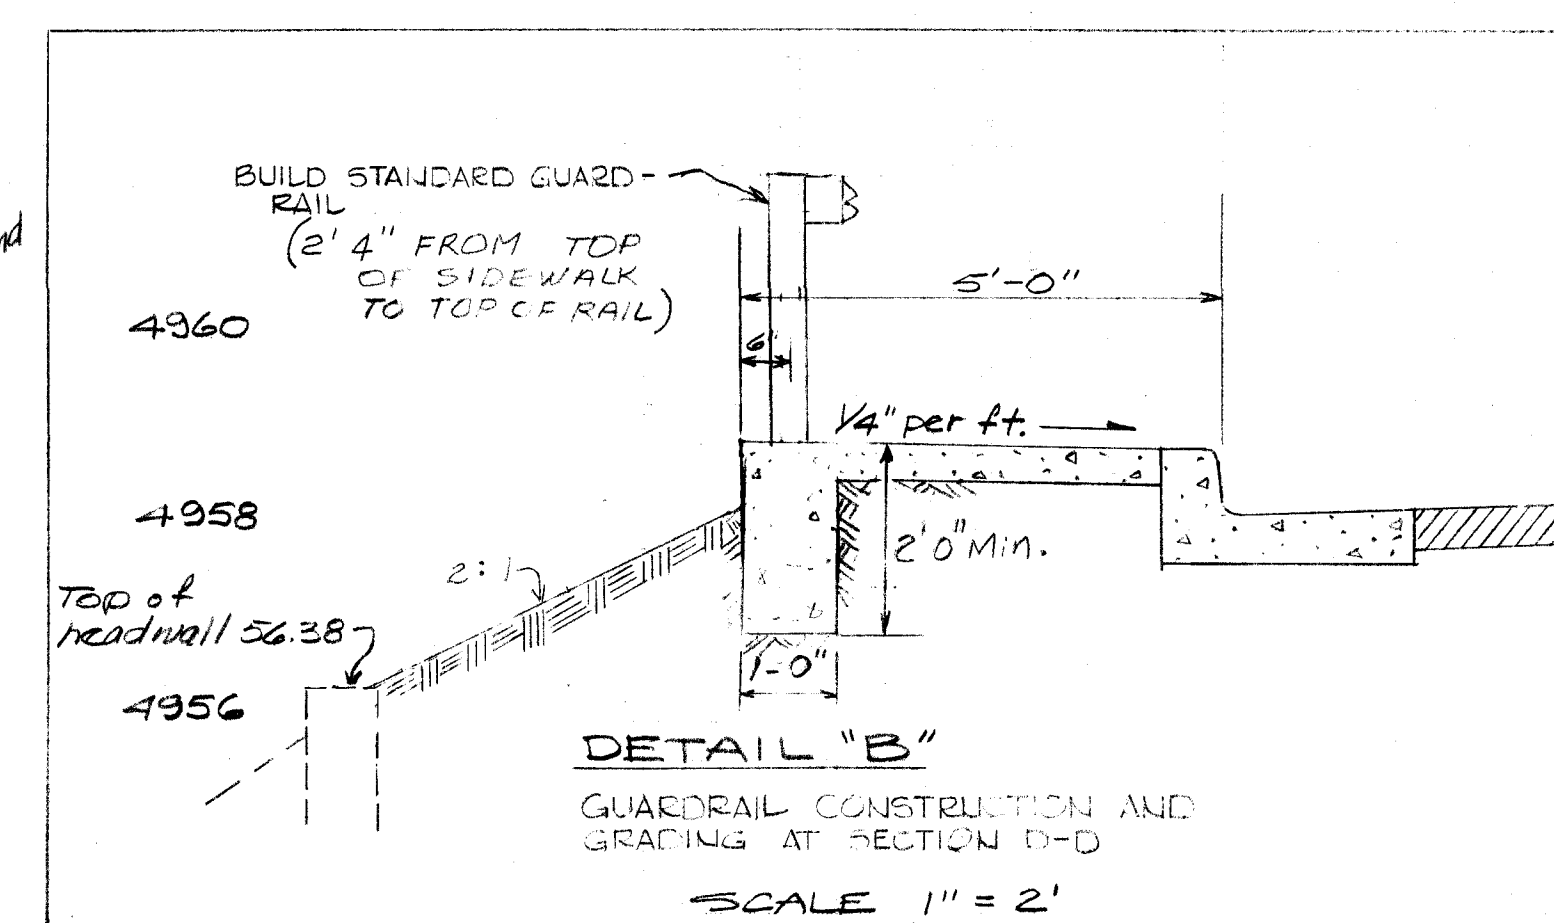

TYPICAL PAVING SECTION
SCALE 1" = 5'

48 HOURS PRIOR TO ANY
EXCAVATION, CONTRACTOR
MUST CONTACT LINE AND
CABLE LOCATING SERVICE,
765-1234, FOR LOCATION
OF EXISTING UTILITIES.

26 1198 0431

CITY OF ALBUQUERQUE
PUBLIC WORKS DEPARTMENT
ENGINEERING DIVISION
TITLE: SUNSET ROAD, S.W.
CROSS SECTIONS AND DETAILS

APPROVED FOR
CONSTRUCTION

DESIGNED BY: [Signature] 9/8/81
CHECKED BY: [Signature] 9/8/81
DATE: 9/8/81

DRAWING NO. 1198

SHEET 4 OF 4

PROJECT: 1198
DATE: 9/8/81
DRAWN BY: ANGEL

K-12

11/982 REVISED GRADE CROSS SECTION

C. TOMLINSON
E. FARMETT