



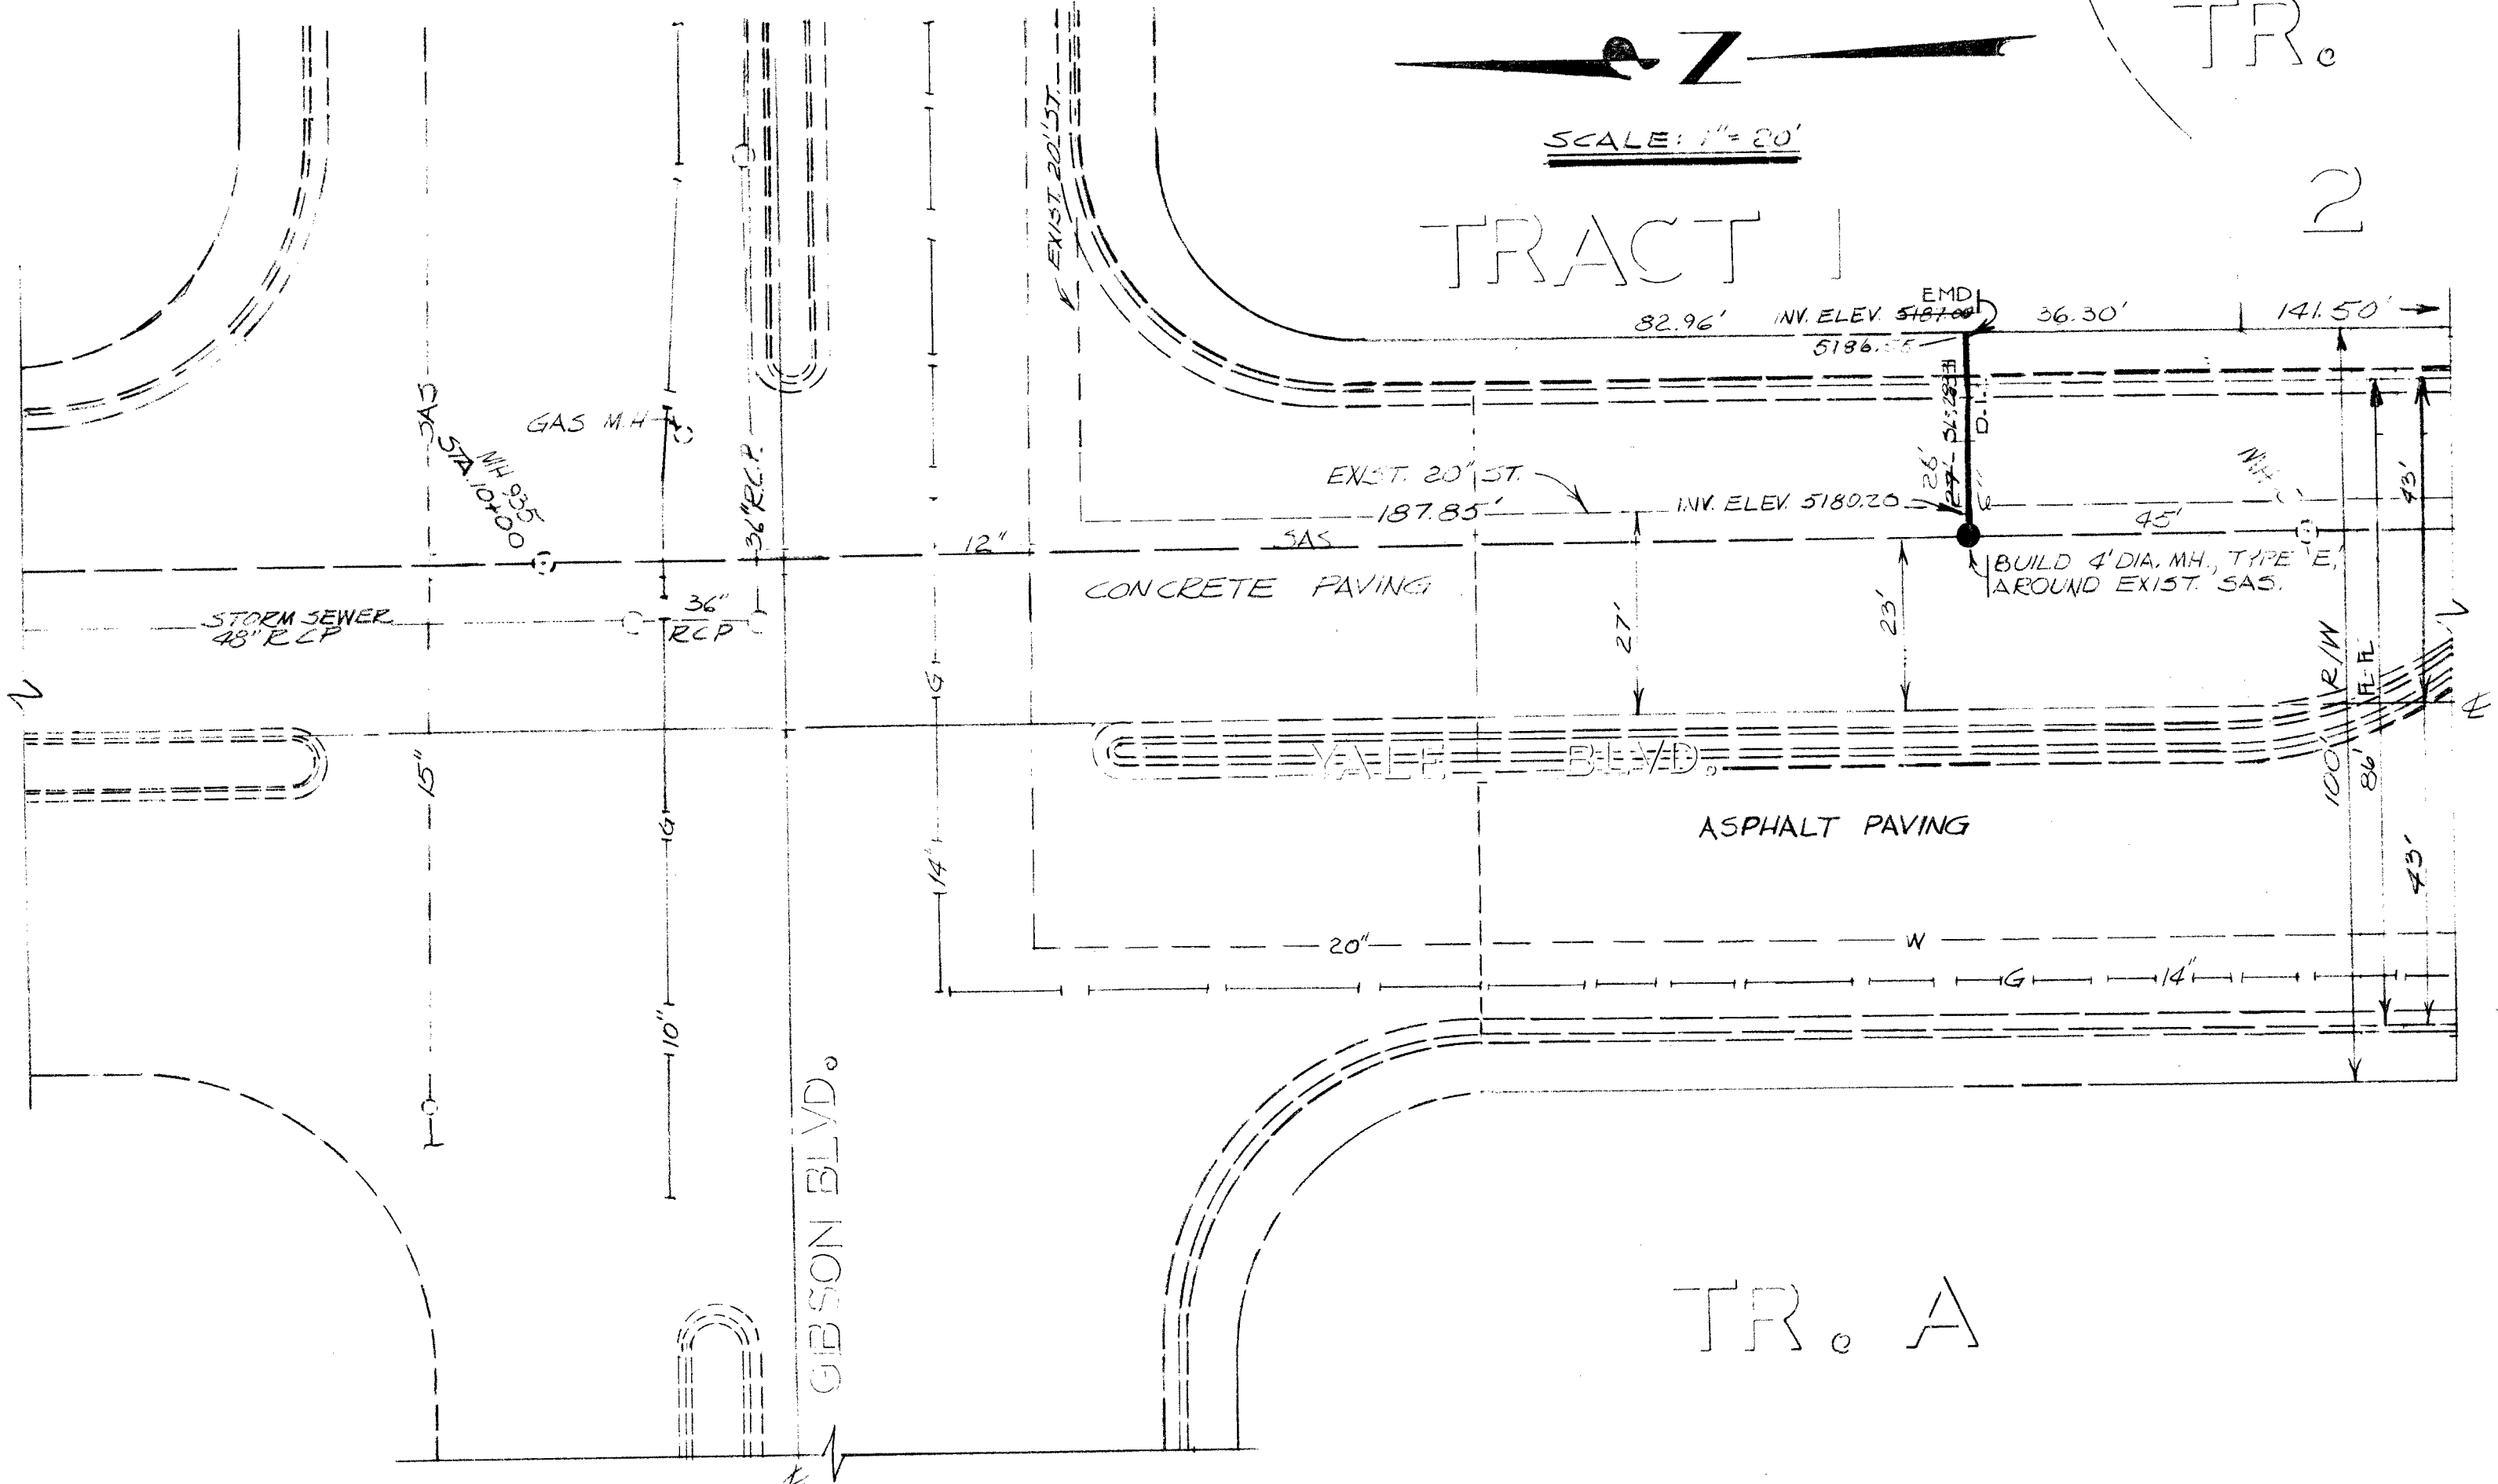

CLAYTON HEIGHTS BUSINESS ADD.

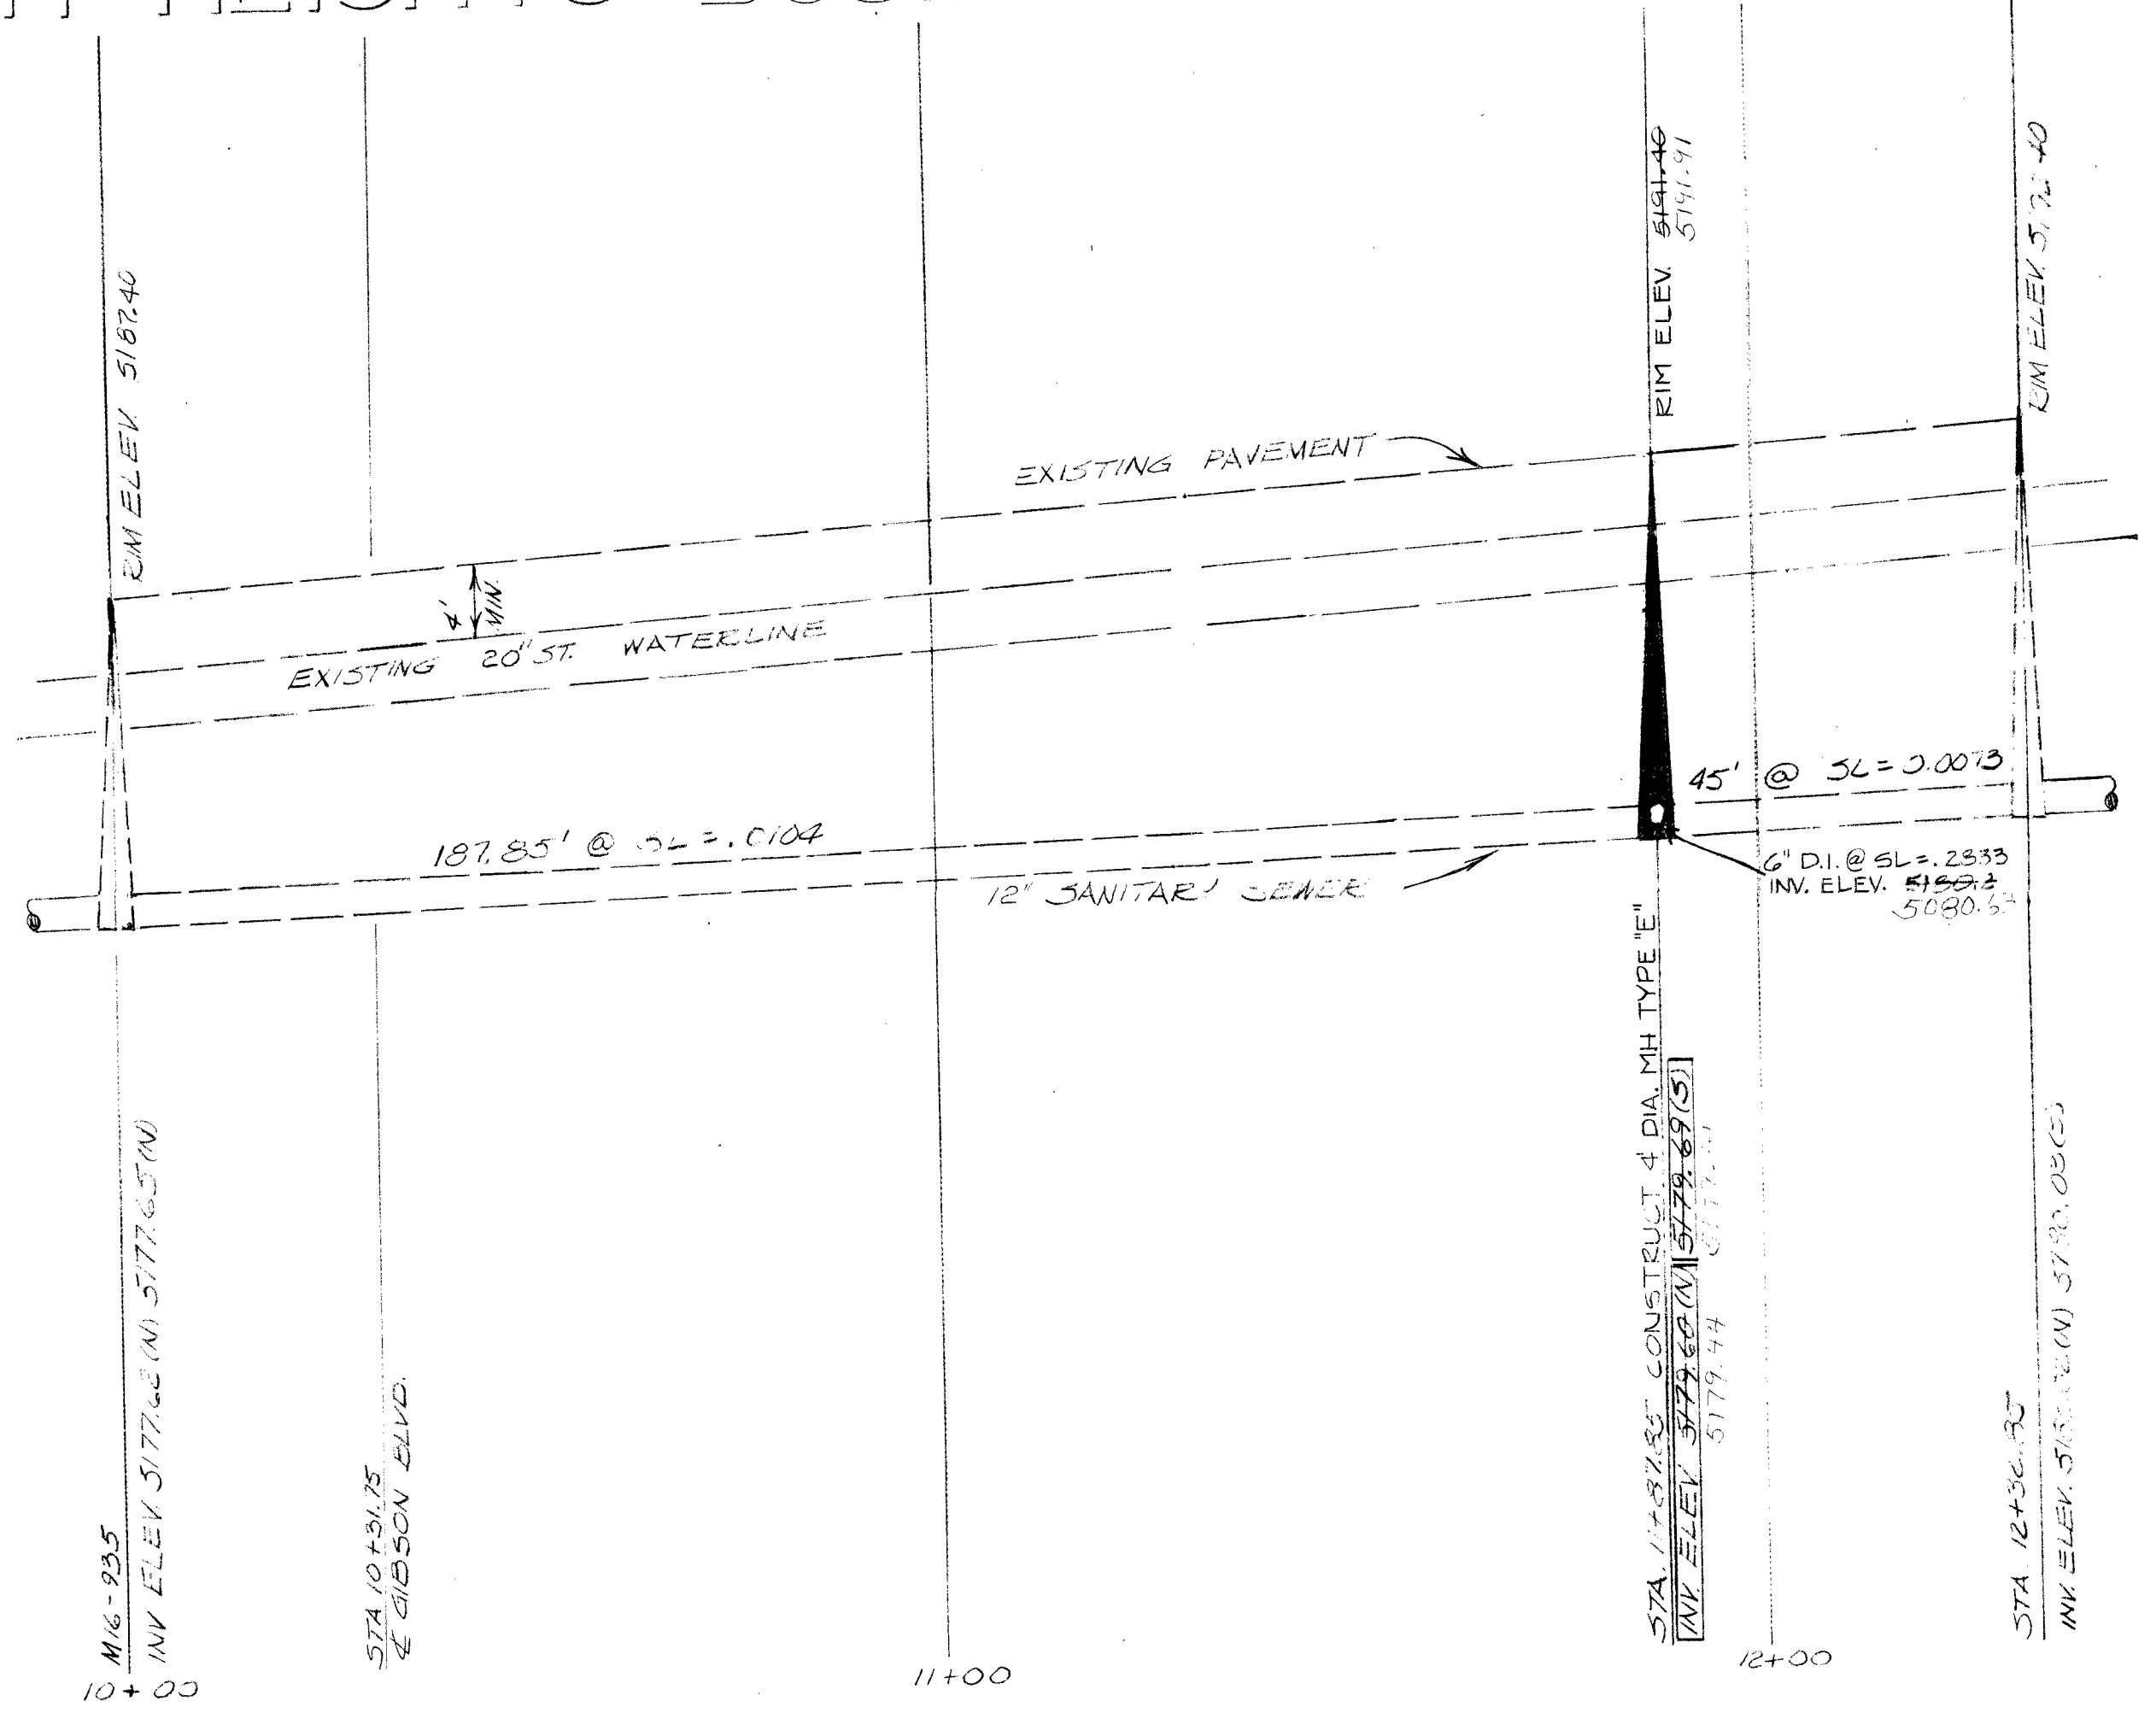

- 1) New Mexico Standard Specification for Public Works Construction - 1979 Edition will be referred to hereon as the "Standard Specification."
- 2) All work detailed on these plans to be performed under contract shall, except as otherwise stated or provided for hereon, be constructed in accordance with "Contract Documents for City-Wide Utilities and Cash Paving No. 30" and the Standard Specification."
- 3) Two working days prior to any excavation, contractor must contact Line Locating Service, 765-1234, for location of existing utilities.
- 4) Prior to construction, the contractor shall excavate and verify the horizontal and vertical locations of all obstructions. Should a conflict exist, the contractor shall notify the engineer or surveyor so that the conflict can be resolved with minimum amount of delay.

THE FOLLOWING NOTES APPLY WHEN CHECKED

- ☐ All utilities and utility service lines shall be installed prior to paving.
- ☒ Backfill compaction shall be according to specified street use.
- ☐ Tack coat requirements shall be determined by the City Engineer.
- ☐ Sidewalks and wheelchair ramps within the curb returns shall be constructed wherever a new curb return is constructed.
- ☐ If curb is depressed for a driveway, the driveway shall be constructed prior to acceptance of the curb and gutter.
- ☐ All storm drainage facilities shall be completed prior to final acceptance.
- ☒ Contractor must submit a construction signing and barricading plan to the Traffic Engineering Division and receive a barricading permit prior to construction. Hours of construction may be restricted.

NOTE:
TWO LANES MUST BE MAINTAINED AT ALL TIMES ON THE EAST SIDE OF THE MEDIAN ON YALE. THESE TWO LANES MAY BE SPLIT ON EACH SIDE OF THE HANDBLOCK DURING CERTAIN STAGES OF THE CONSTRUCTION. HOWEVER, IT IS NECESSARY TO MAINTAIN THE TWO LANES.

HORIZONTAL 1"=20'
VERTICAL 1"=5'

LEGEND

- SAS— EXIST. SANITARY
- W— EXIST. WATERLINE
- G— EXIST. CURB & GUTTER
- G— EXIST. GASLINE
- PROPOSED SERVICE LINE

20 12030182

Handwritten signature
12/10/81

APPROVED FOR
CONSTRUCTION
Handwritten signature
CITY ENGINEER

1203

M-16

SEEKING MEANDA
A.J. OLIVAS

1503