



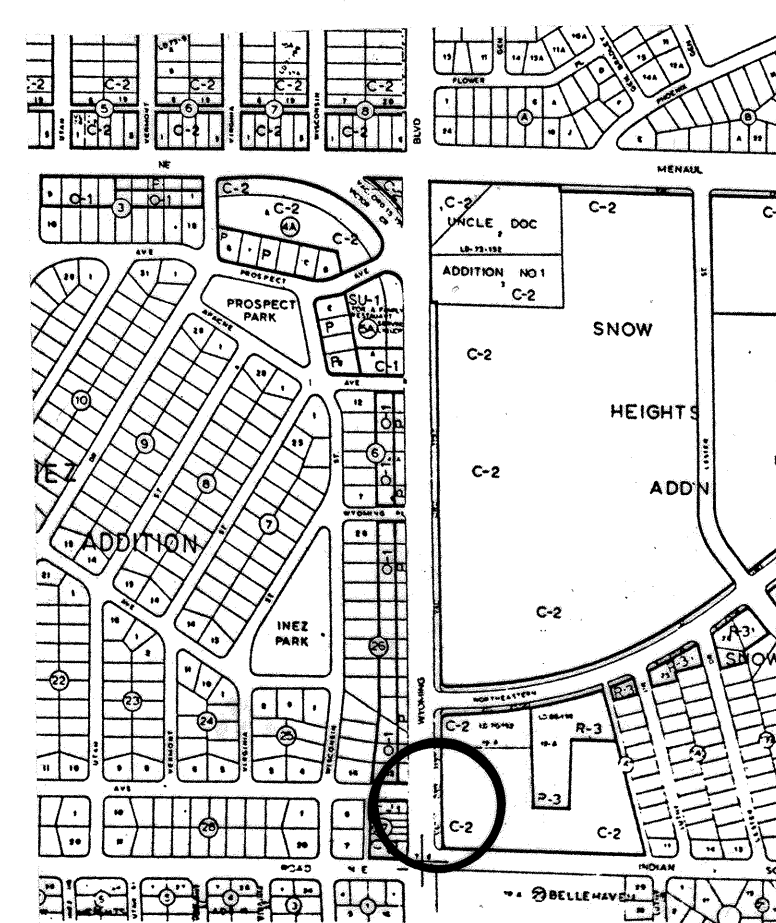


LOCATION MAP
ZONE ATLAS H-20

CURVE DATA
CURVE A
Δ = 10° 15' 37"
R = 150.00'
T = 21.43'
L = 42.57'

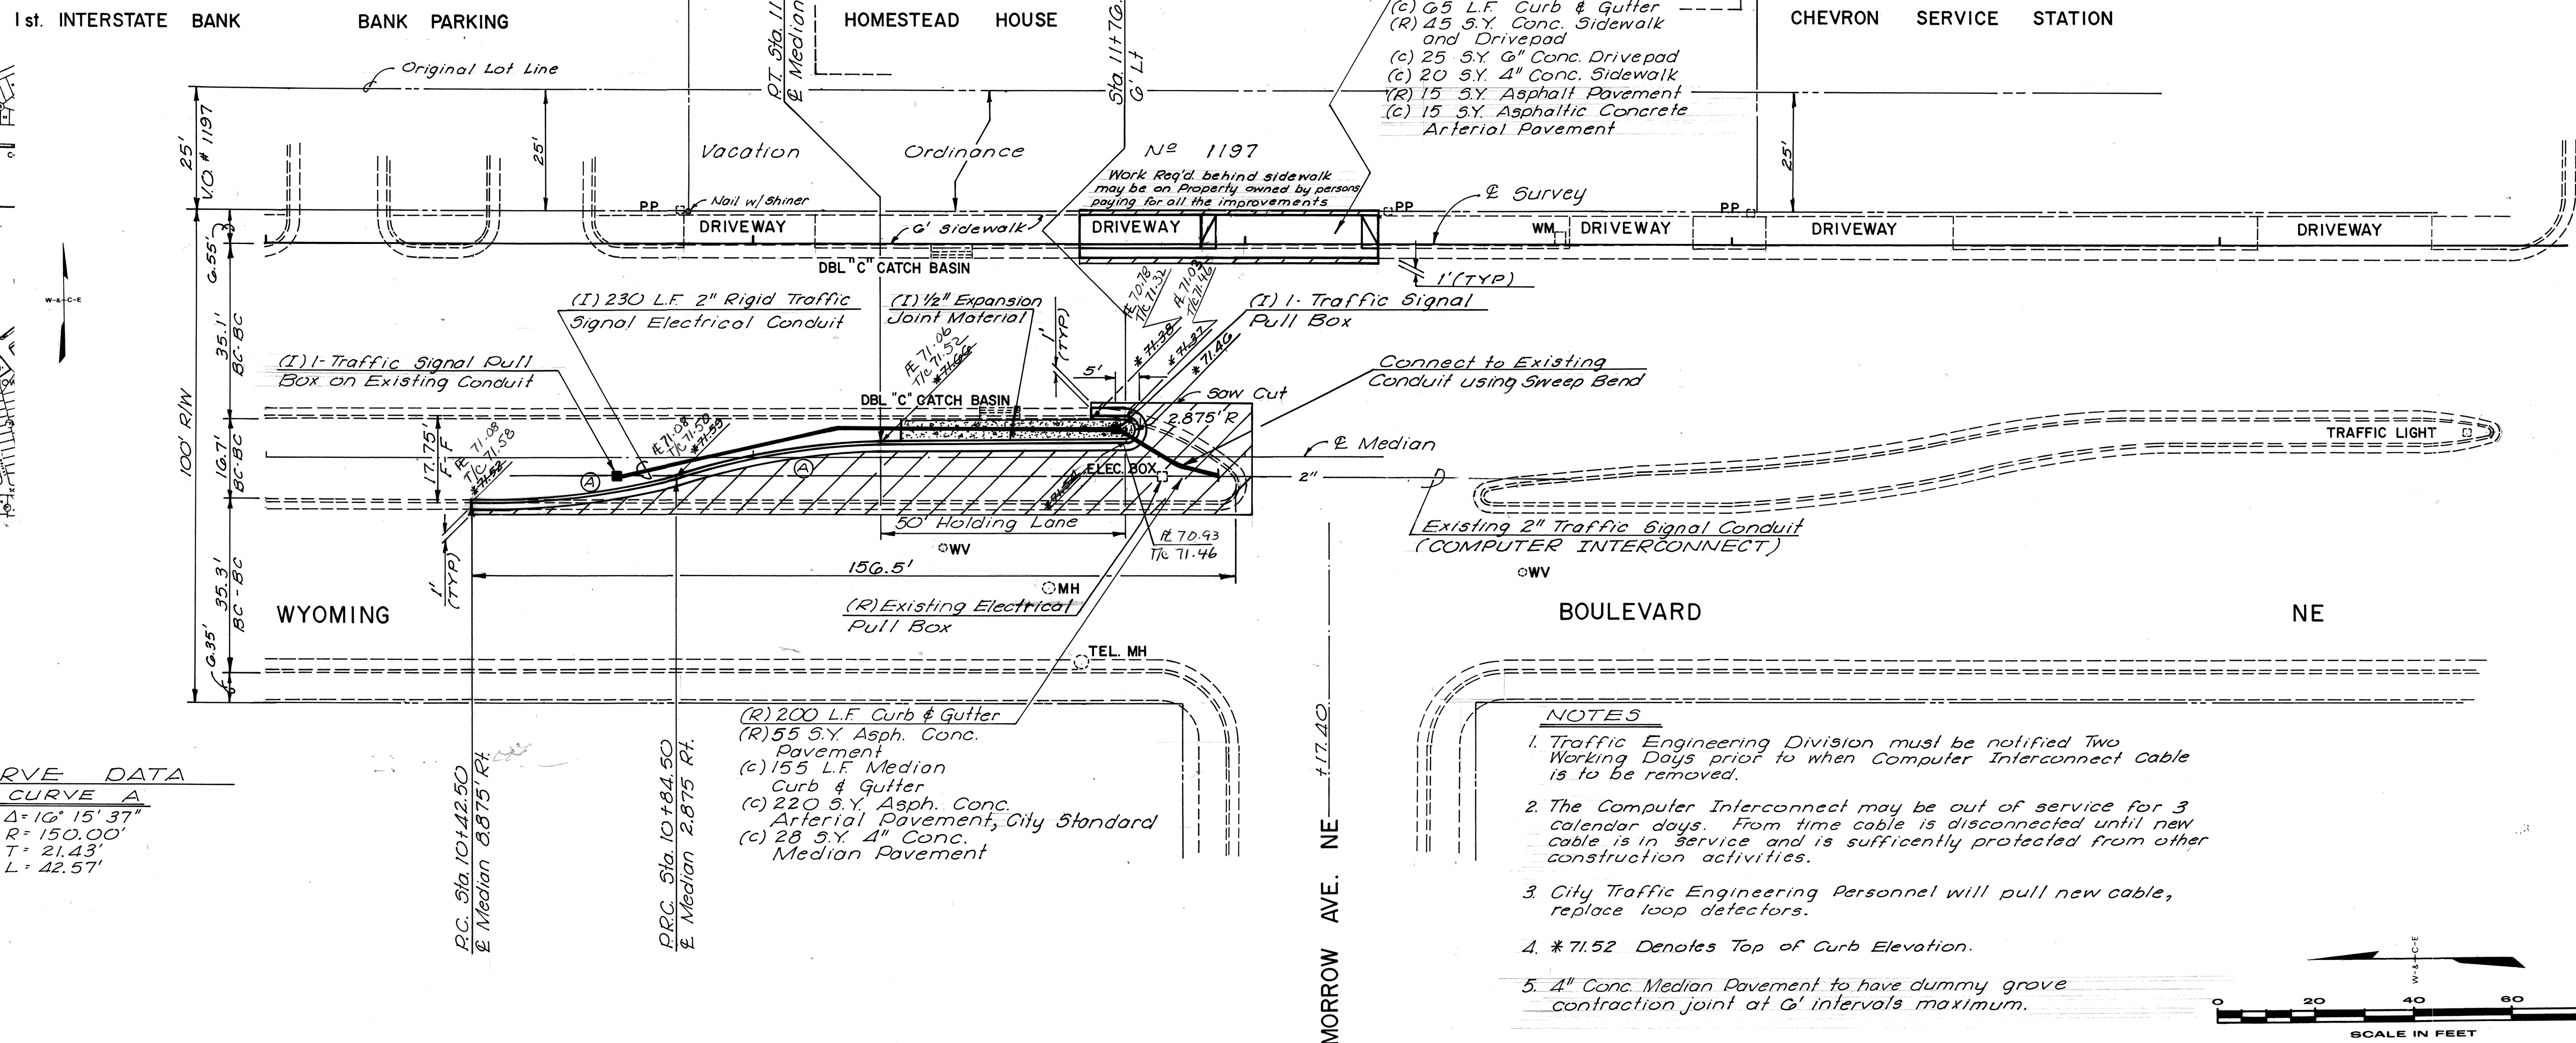

- NOTES**
1. Traffic Engineering Division must be notified Two Working Days prior to when Computer Interconnect Cable is to be removed.
 2. The Computer Interconnect may be out of service for 3 calendar days. From time cable is disconnected until new cable is in service and is sufficiently protected from other construction activities.
 3. City Traffic Engineering Personnel will pull new cable, replace loop detectors.
 4. * 71.52 Denotes Top of Curb Elevation.
 5. 4" Conc. Median Pavement to have dummy groove contraction joint at 6' intervals maximum.

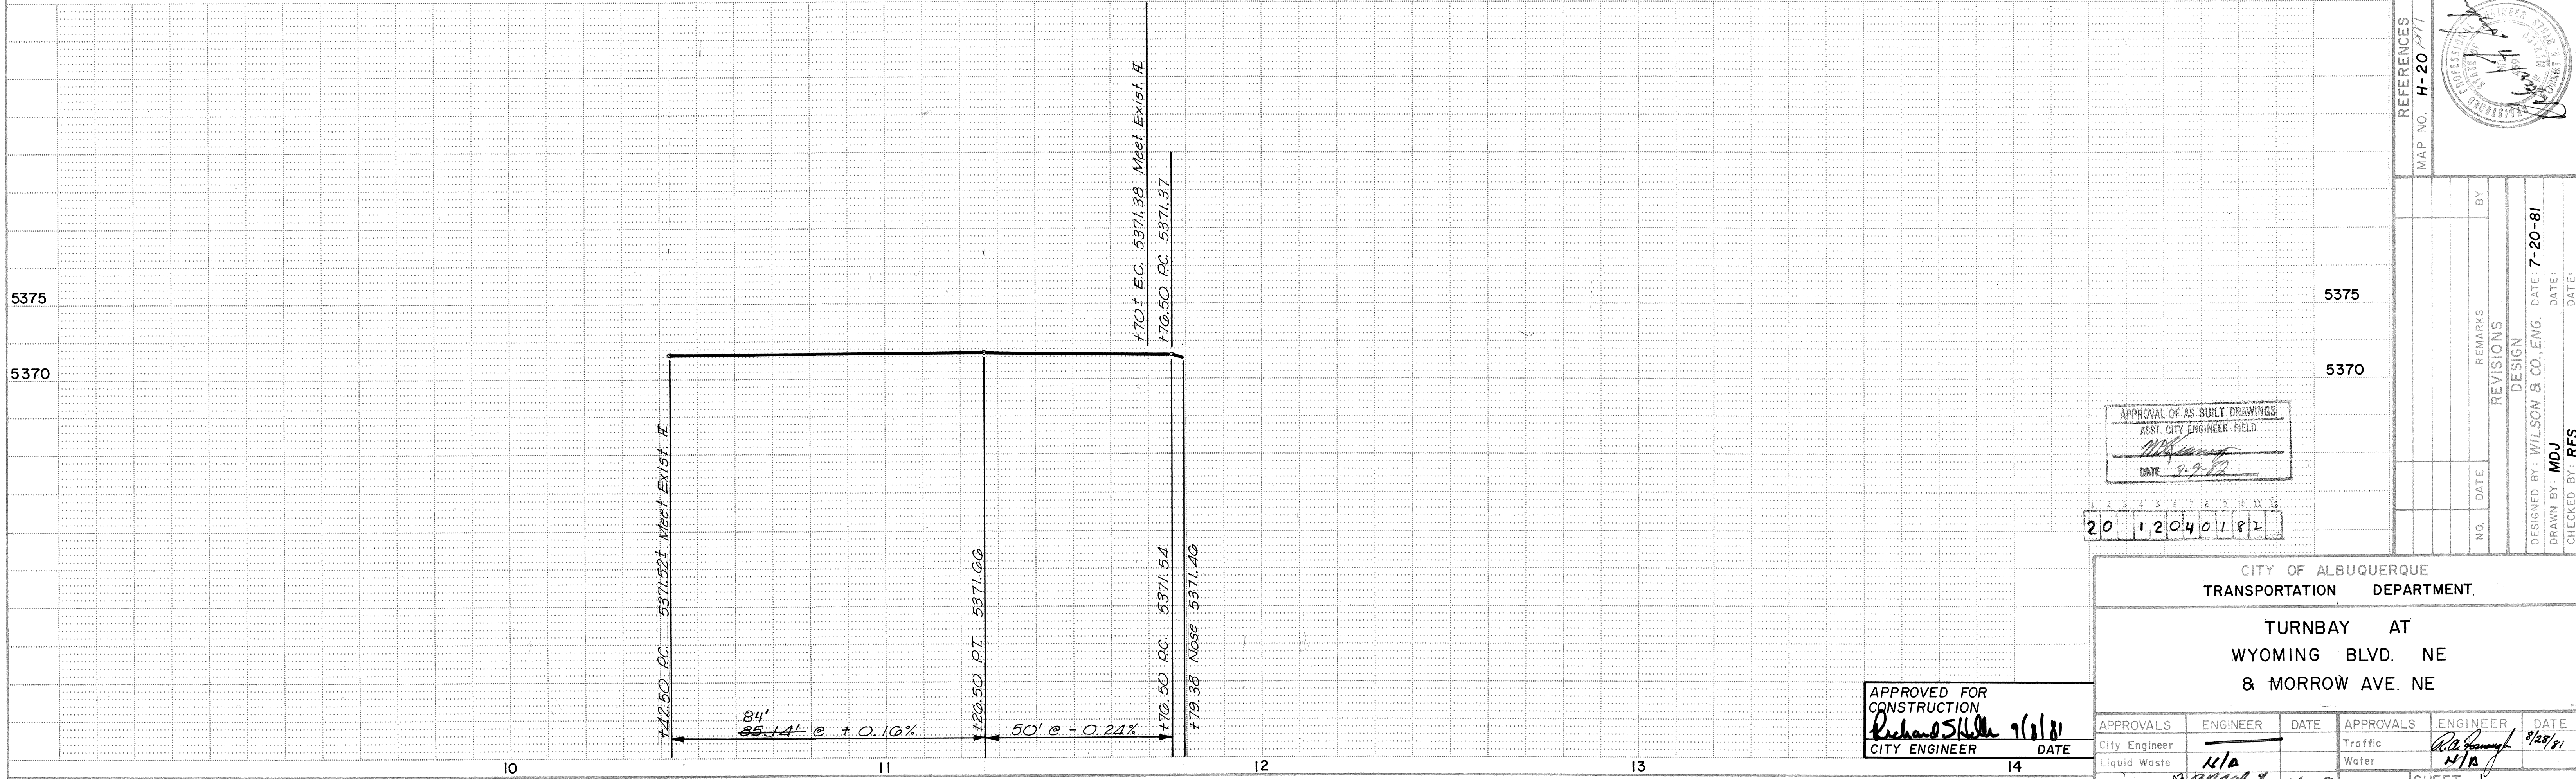

APPROVAL OF AS BUILT DRAWINGS
ASST. CITY ENGINEER - FIELD
DATE: 7-7-81

20 12040182

APPROVED FOR CONSTRUCTION
Richard S. Hahn 7/6/81
CITY ENGINEER DATE

CITY OF ALBUQUERQUE TRANSPORTATION DEPARTMENT					
TURNBAY AT WYOMING BLVD. NE & MORROW AVE. NE					
APPROVALS	ENGINEER	DATE	APPROVALS	ENGINEER	DATE
City Engineer	12/1		Traffic	12/1	7/27/81
Liquid Waste	12/1		Water	12/1	
A.C.E. - Design	12/1				
A.C.E. - Hydrology	12/1				
DESIGNED BY: WILSON & CO., ENG. DATE: 7-20-81			DRAWN BY: MDJ DATE: 7-20-81		
CHECKED BY: RFS			DATE: 7-20-81		
SHEET 1			OF 1		

AS BUILT INFORMATION	
CONTRACTOR	INFORMATION
STAKE BY	DATE
ACCEPTED BY	DATE
VERIFICATION BY	DATE
CORRECTED BY	DATE
MICRO-FILM INFORMATION	
RECORDED BY	DATE
NO.	

BENCH MARKS
Brass Cap Stamped "7-H-20, 1975 ACS" at the Northeast Corner of Indian School Rd. and Wyoming Blvd NE ~ Elevation = 5371.077

REFERENCES
MAP NO. H-20-271

NO.	DATE	REVISIONS	BY
1			
2			
3			
4			
5			
6			
7			
8			
9			
10			