


SCANNED
BY LASON

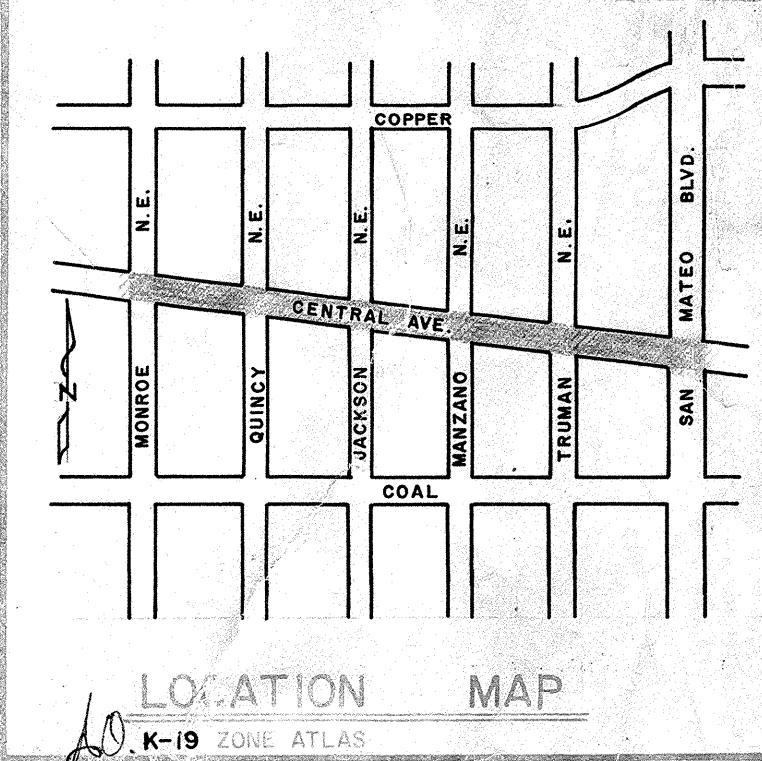

INSTALLATION OF TRAFFIC CONTROL CONDUIT

- IN CENTRAL AVE -

BETWEEN SAN MATEO & MONROE AND AT THE INTERSECTION
OF CENTRAL & SAN MATEO

INDEX OF DRAWINGS

SHEET NO.	TITLE
1	
2	PLAN VIEW CENTRAL & SAN MATEO INTERSECTION
3	PLAN & PROFILE CENTRAL & SAN MATEO
4	PLAN VIEW CENTRAL AVE. SAN MATEO TO MONROE

"NOTICE TO CONTRACTORS"

- 1) New Mexico Standard Specifications for Public Works Construction - 1979 Edition will be referred to hereon as the "Standard Specification."
- 2) All work detailed on these plans to be performed under contract shall, except as otherwise stated or provided for herein, be constructed in accordance with "Contract Documents for City-Wide Utilities and Cash Paving No. 30" and the Standard Specification.
- 3) Two working days prior to any excavation, contractor must contact Line Locating Service, 745-1234, for location of existing utilities.
- 4) Prior to construction, the contractor shall excavate and verify the horizontal and vertical locations of all obstructions. Should a conflict exist, the contractor shall notify the engineer or surveyor so that the conflict can be resolved with a minimum amount of delay.
- 5) Barricading & excavation permits required before start of construction.

THE FOLLOWING NOTES APPLY WHEN CHECKED

- ☐ All utilities and utility service lines shall be installed prior to paving.
- ☒ Backfill compaction shall be according to specified street use. (ARTERIAL PAVEMENT).
- ☒ Tack coat requirements shall be determined by the City Engineer.
- ☐ Sidewalks and wheelchair ramps within the curb returns shall be constructed whenever a new curb return is constructed.
- ☐ If curb is depressed for a driveway, the driveway shall be constructed prior to acceptance of the curb and gutter.
- ☐ All storm drainage facilities shall be completed prior to final acceptance.

1 2 3 4 5 6 7 8 9 10 11 12
20 12060181

APPROVAL OF AS BUILT DRAWINGS
ASST. CITY ENGINEER - FIELD
[Signature]
DATE 7-27-81

APPROVED FOR
CONSTRUCTION
[Signature] 7/27/81
CITY ENGINEER

DRAWING
NO.

1206

SHEET OF
1 4

DRAWING NUMBER

DRAWING NUMBER

DRAWING NUMBER

DRAWING NUMBER

STA. 0+41.3 U-034-1(G)
BEGIN ASPHALTIC CONCRETE PAVEMENT
CONSTRUCTION

TRUMAN STREET N.E.

ELEVATIONS TOP OF CURB RETURN

STA. 2+52.35 END ASPHALTIC
CONCRETE PAVEMENT
BEGIN CONCRETE PAVEMENT CONSTRUCTION

STA. 4+79.80 END CONCRETE PAVEMENT
BEGIN ASPHALTIC CONCRETE PAVEMENT
CONSTRUCTION

STA. 3+66.29 Central Ave. East-
STA. 71+59.76 San Mateo

STA. 3+66.27 Central Ave. West-
STA. 71+59.88 San Mateo

STA. 8+87.88 U-034-1(G)
END ASPHALTIC CONCRETE PAVEMENT
CONSTRUCTION



CURVE DATA				
CURVE	R	Δ	L	T
"A"	150'	16°06'	42.15'	21.21'
"B"	156'	16°06'	43.84'	22.06'
"C"	156'	16°06'	43.84'	22.06'
"D"	150'	16°06'	42.15'	21.21'
"E"	50'	27°31'40"	24.02'	12.25'
"F"	56'	27°31'40"	26.91'	13.72'
"G"	56'	27°31'40"	26.91'	13.72'
"H"	50'	27°31'40"	24.02'	12.25'

LEGEND:
DENOTES NEW CONSTRUCTION FOR
TRAFFIC CONDUIT INSTALLATION

NO.	DESCRIPTION	DATE	BY
6			
5			
4			
3			
2			
1			

CITY OF ALBUQUERQUE MUNICIPAL DEVELOPMENT DEPARTMENT ENGINEERING DIVISION					
TITLE: CENTRAL AVE. TRAFFIC CONDUIT INSTALLATION CONDUIT LOCATION IN INTERSECTION OF CENTRAL AVE. & SAN MATEO BLVD.					
APPROVALS	ENGINEER	DATE	APPROVALS	ENGINEER	DATE
City Engineer			Liquid Waste		
A.C.E.-Design			Traffic		
A.C.E.-Hydrology			Water		
DRAWING NO. 1206		MAP NO. K-17		SHEET 2 OF 4	

SACCO PRODUCTS • NEW HOPE, MINNESOTA
DESIGNED BY: GORDON HERKENHOFF AND ASSOCIATES
SACCO PRODUCTS • NEW HOPE, MINNESOTA
DESIGNED BY: GORDON HERKENHOFF AND ASSOCIATES
SACCO PRODUCTS • NEW HOPE, MINNESOTA
DESIGNED BY: GORDON HERKENHOFF AND ASSOCIATES
SACCO PRODUCTS • NEW HOPE, MINNESOTA
DESIGNED BY: GORDON HERKENHOFF AND ASSOCIATES

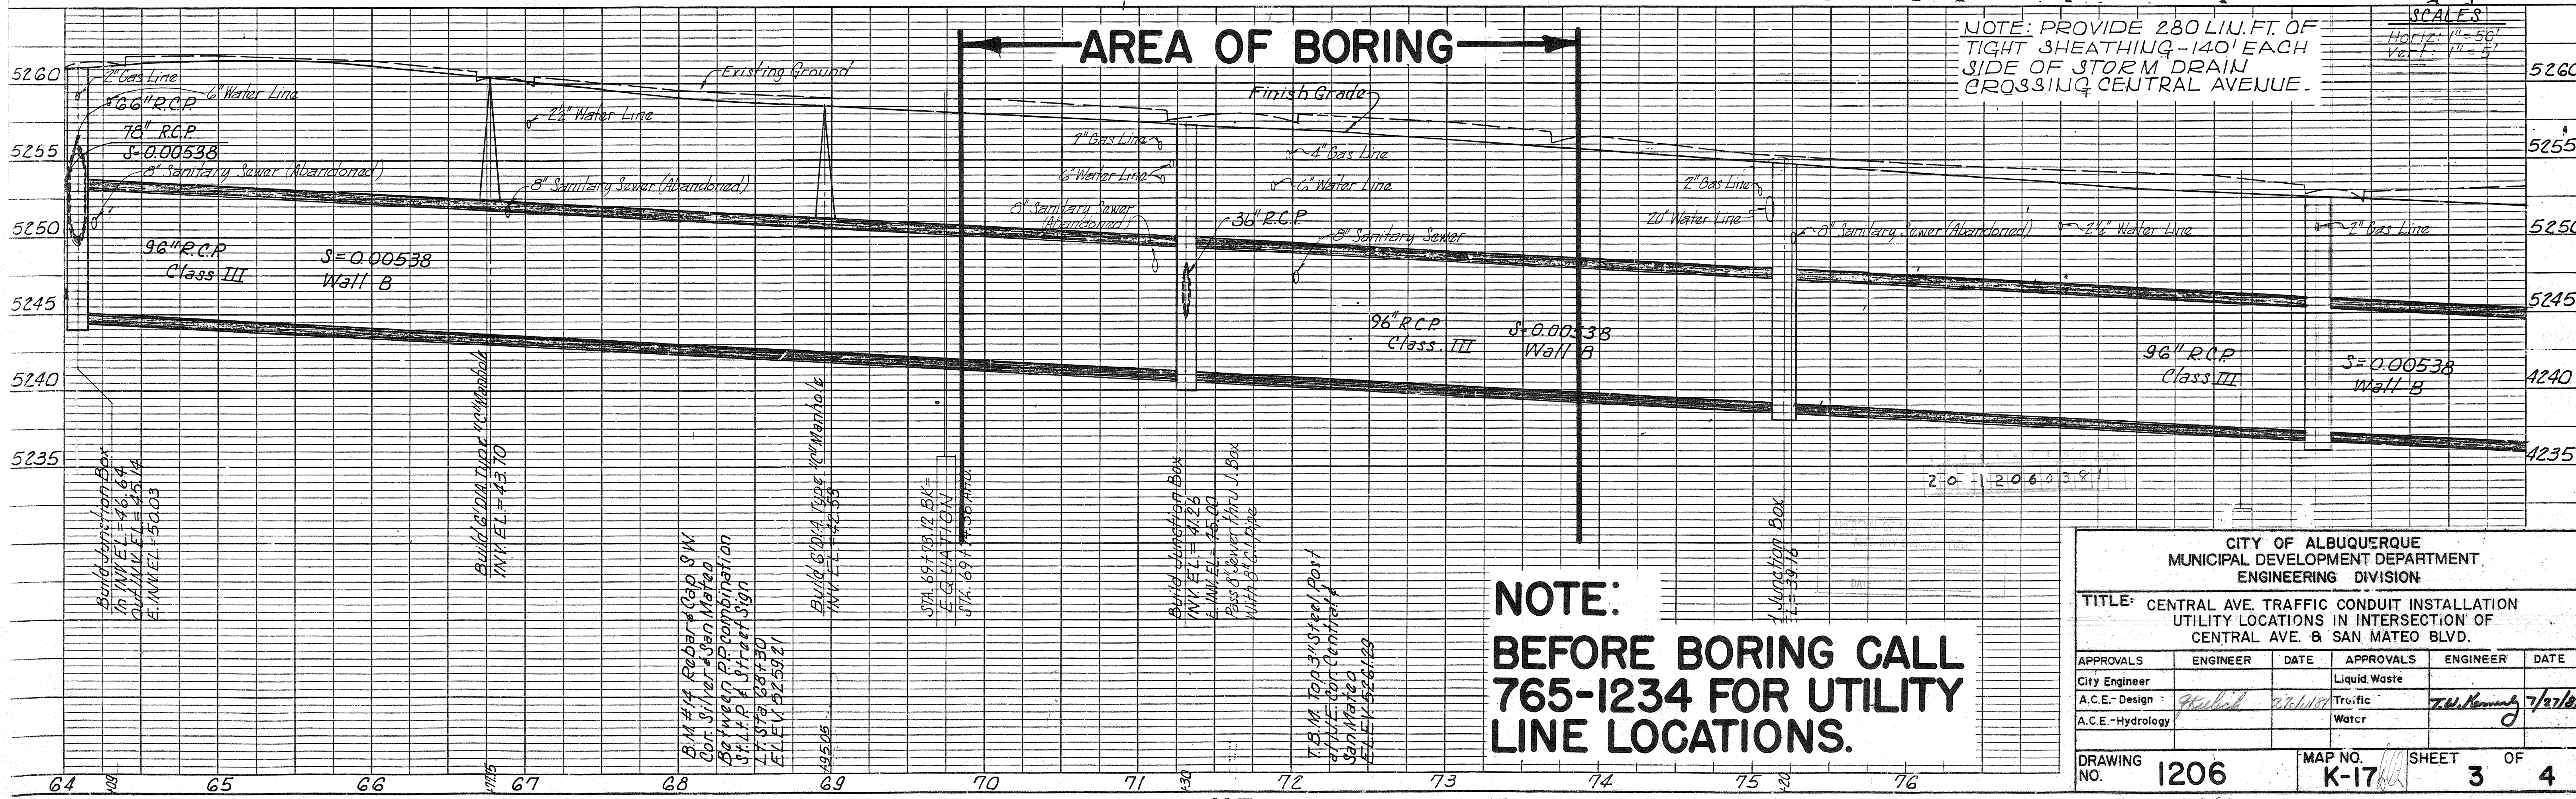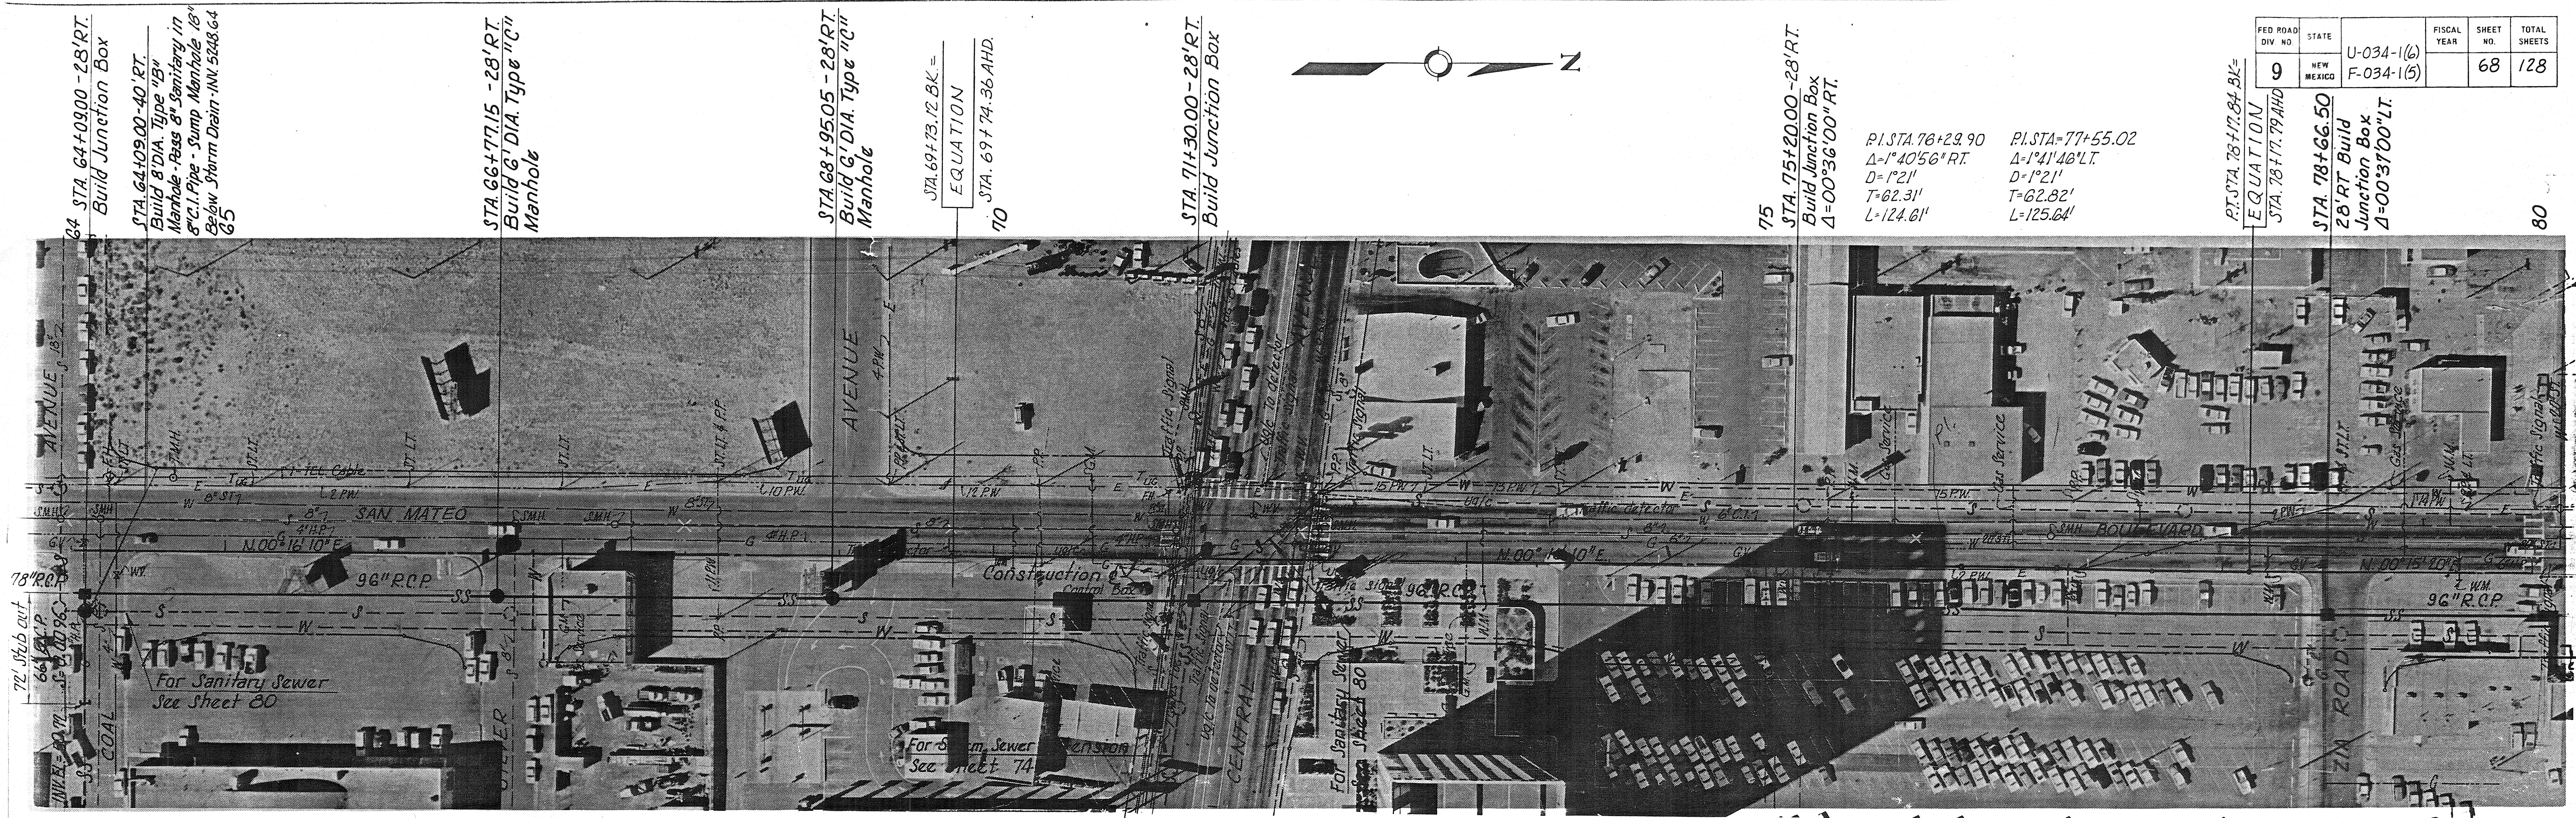



CITY OF ALBUQUERQUE MUNICIPAL DEVELOPMENT DEPARTMENT ENGINEERING DIVISION					
TITLE: CENTRAL AVE. TRAFFIC CONDUIT INSTALLATION UTILITY LOCATIONS IN INTERSECTION OF CENTRAL AVE. & SAN MATEO BLVD.					
APPROVALS	ENGINEER	DATE	APPROVALS	ENGINEER	DATE
City Engineer			Liquid Waste		
A.C.E. - Design	gordon herkenhoff	7/27/81	Traffic	7/27/81	7/27/81
A.C.E. - Hydrology			Water		
DRAWING NO.	1206	MAP NO.	K-17	SHEET	3 OF 4

CON



1. USE .
2. INSTALL
3. ALL PAVEMENT PAVING MATERIAL.
4. CONDUIT WILL BE THE MEDIANS AND CONDITIONS.
5. MEDIAN SURFACES CONCRETE.
6. MEDIAN CONCRETE SURF. CONCRETE.
7. CONDUIT MAY BE JACKED IN.

NOTE:

1. TRAFFIC ENGINEER WILL FURNISH AN INSPECTOR FOR THE INSTALLATION OF THE CONDUIT, PULL BOXES AND MANHOLE. FIELD ENGINEER (OCE) WILL INSPECT THE REMAINDER OF THE CONSTRUCTION WORK ASSOCIATED WITH THIS PROJECT.

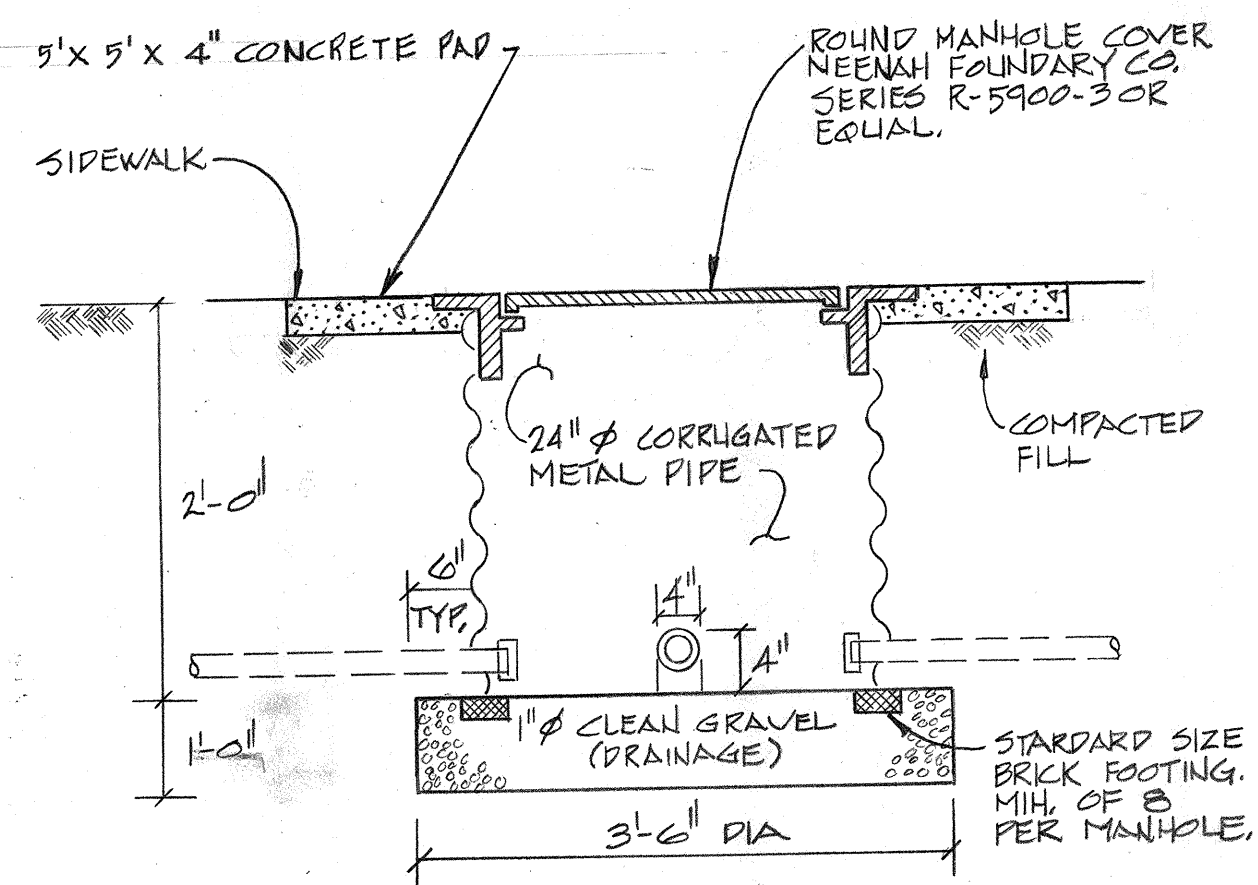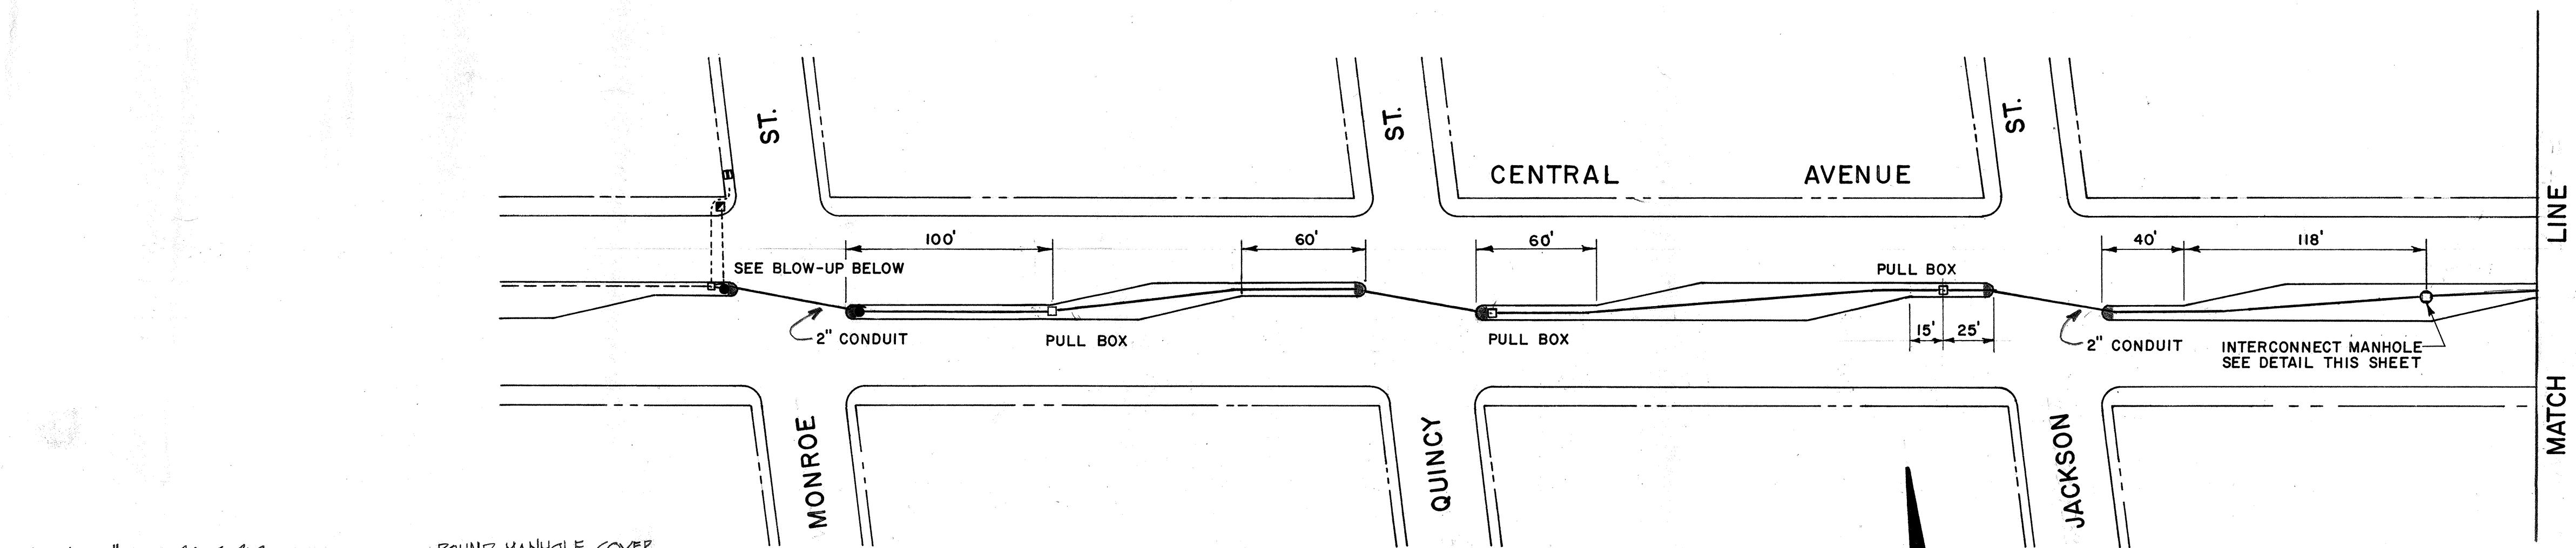

INTERCONNECT MANHOLE DETAIL

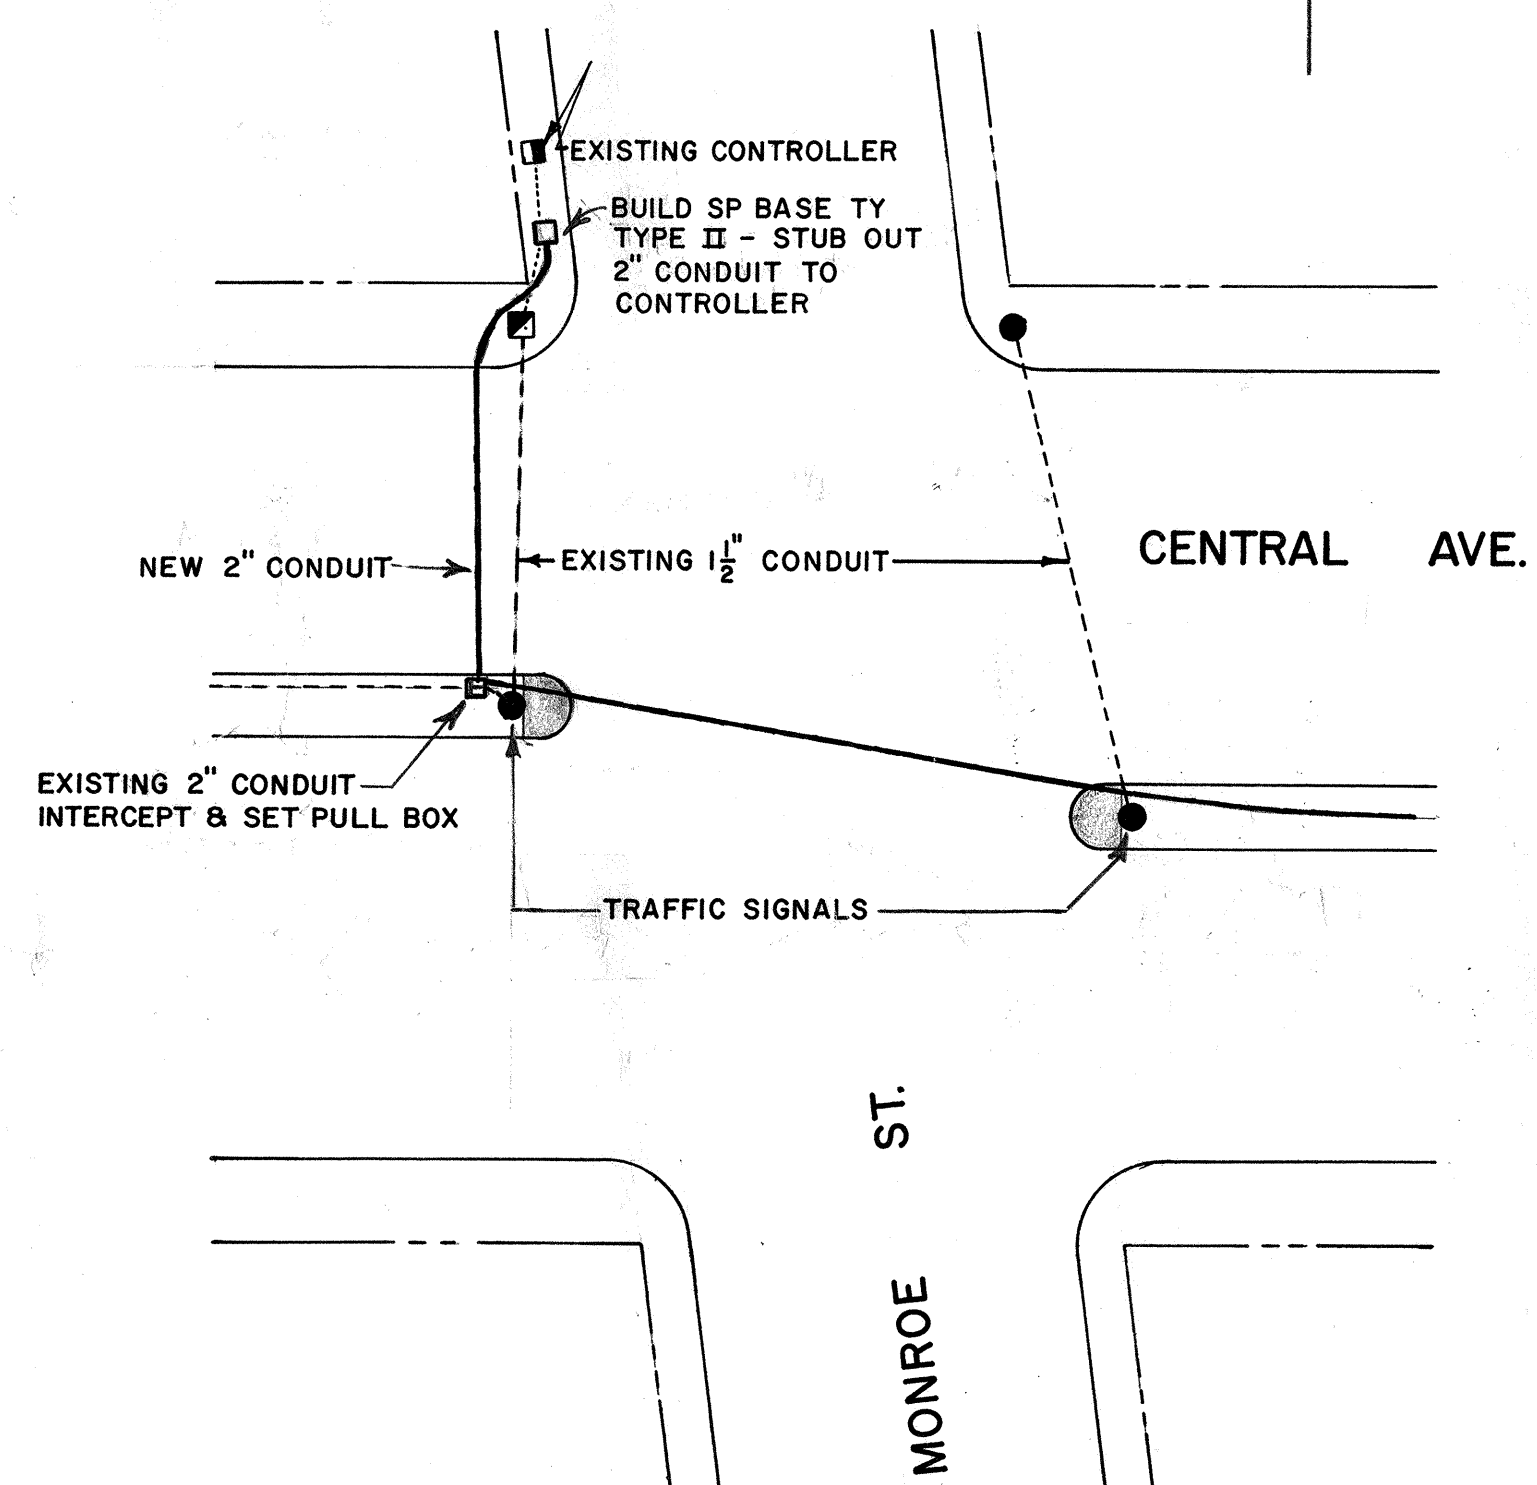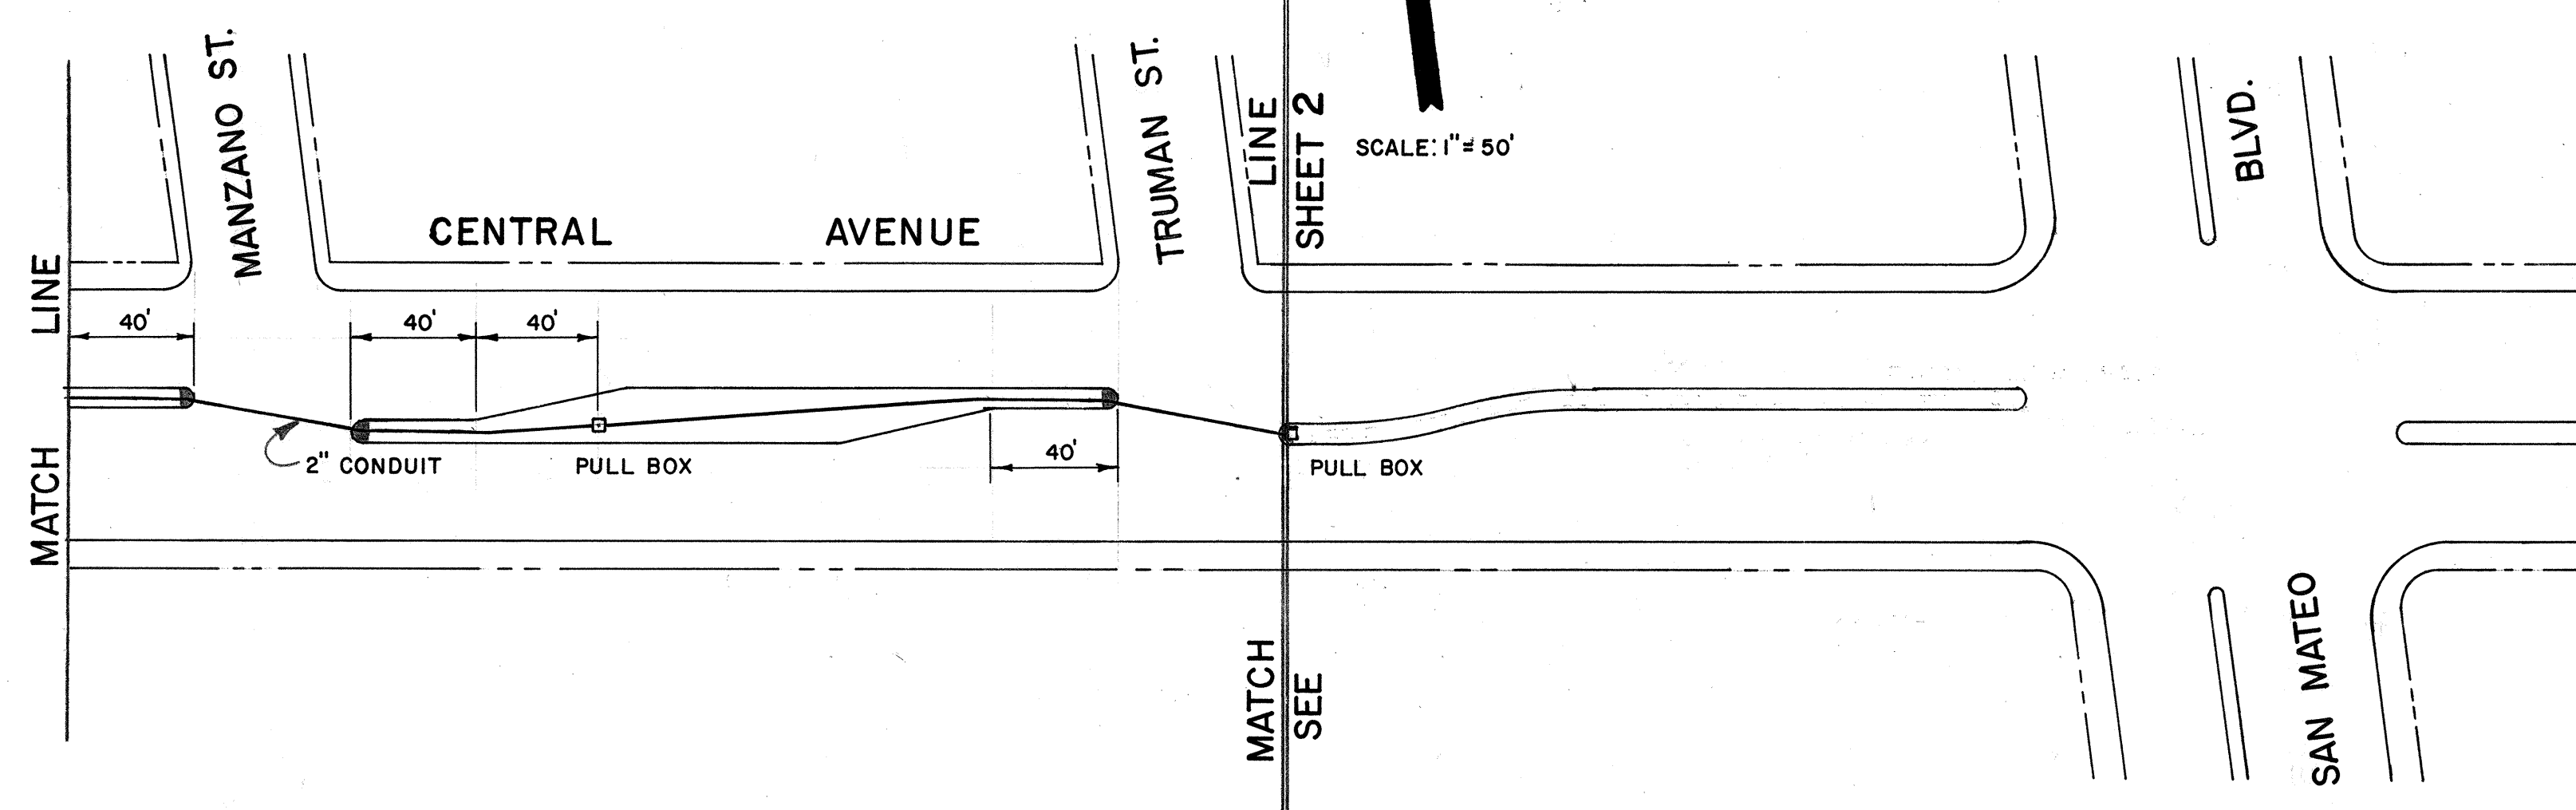

1 2 3 4 5 6 7 8 9 10 11 12
20 12060481

APPROVAL OF AS BUILT DRAWINGS
ASST. CITY ENGINEER - FIELD
DATE: _____

CITY OF ALBUQUERQUE MUNICIPAL DEVELOPMENT DEPARTMENT ENGINEERING DIVISION					
TITLE: CENTRAL AVE. TRAFFIC CONDUIT INSTALLATION LOCATION OF CONDUIT IN CENTRAL AVE. FROM TRUMAN ST. TO MONROE ST.					
APPROVALS	ENGINEER	DATE	APPROVALS	ENGINEER	DATE
City Engineer			Liquid Waste		
A.C.E.-Design	<i>Handwritten Signature</i>	2/16/81	Traffic	<i>Handwritten Signature</i>	7/27/81
A.C.E.-Hydrology			Water		
DRAWING NO.	1206	MAP NO.	K-17	SHEET	4 OF 4