



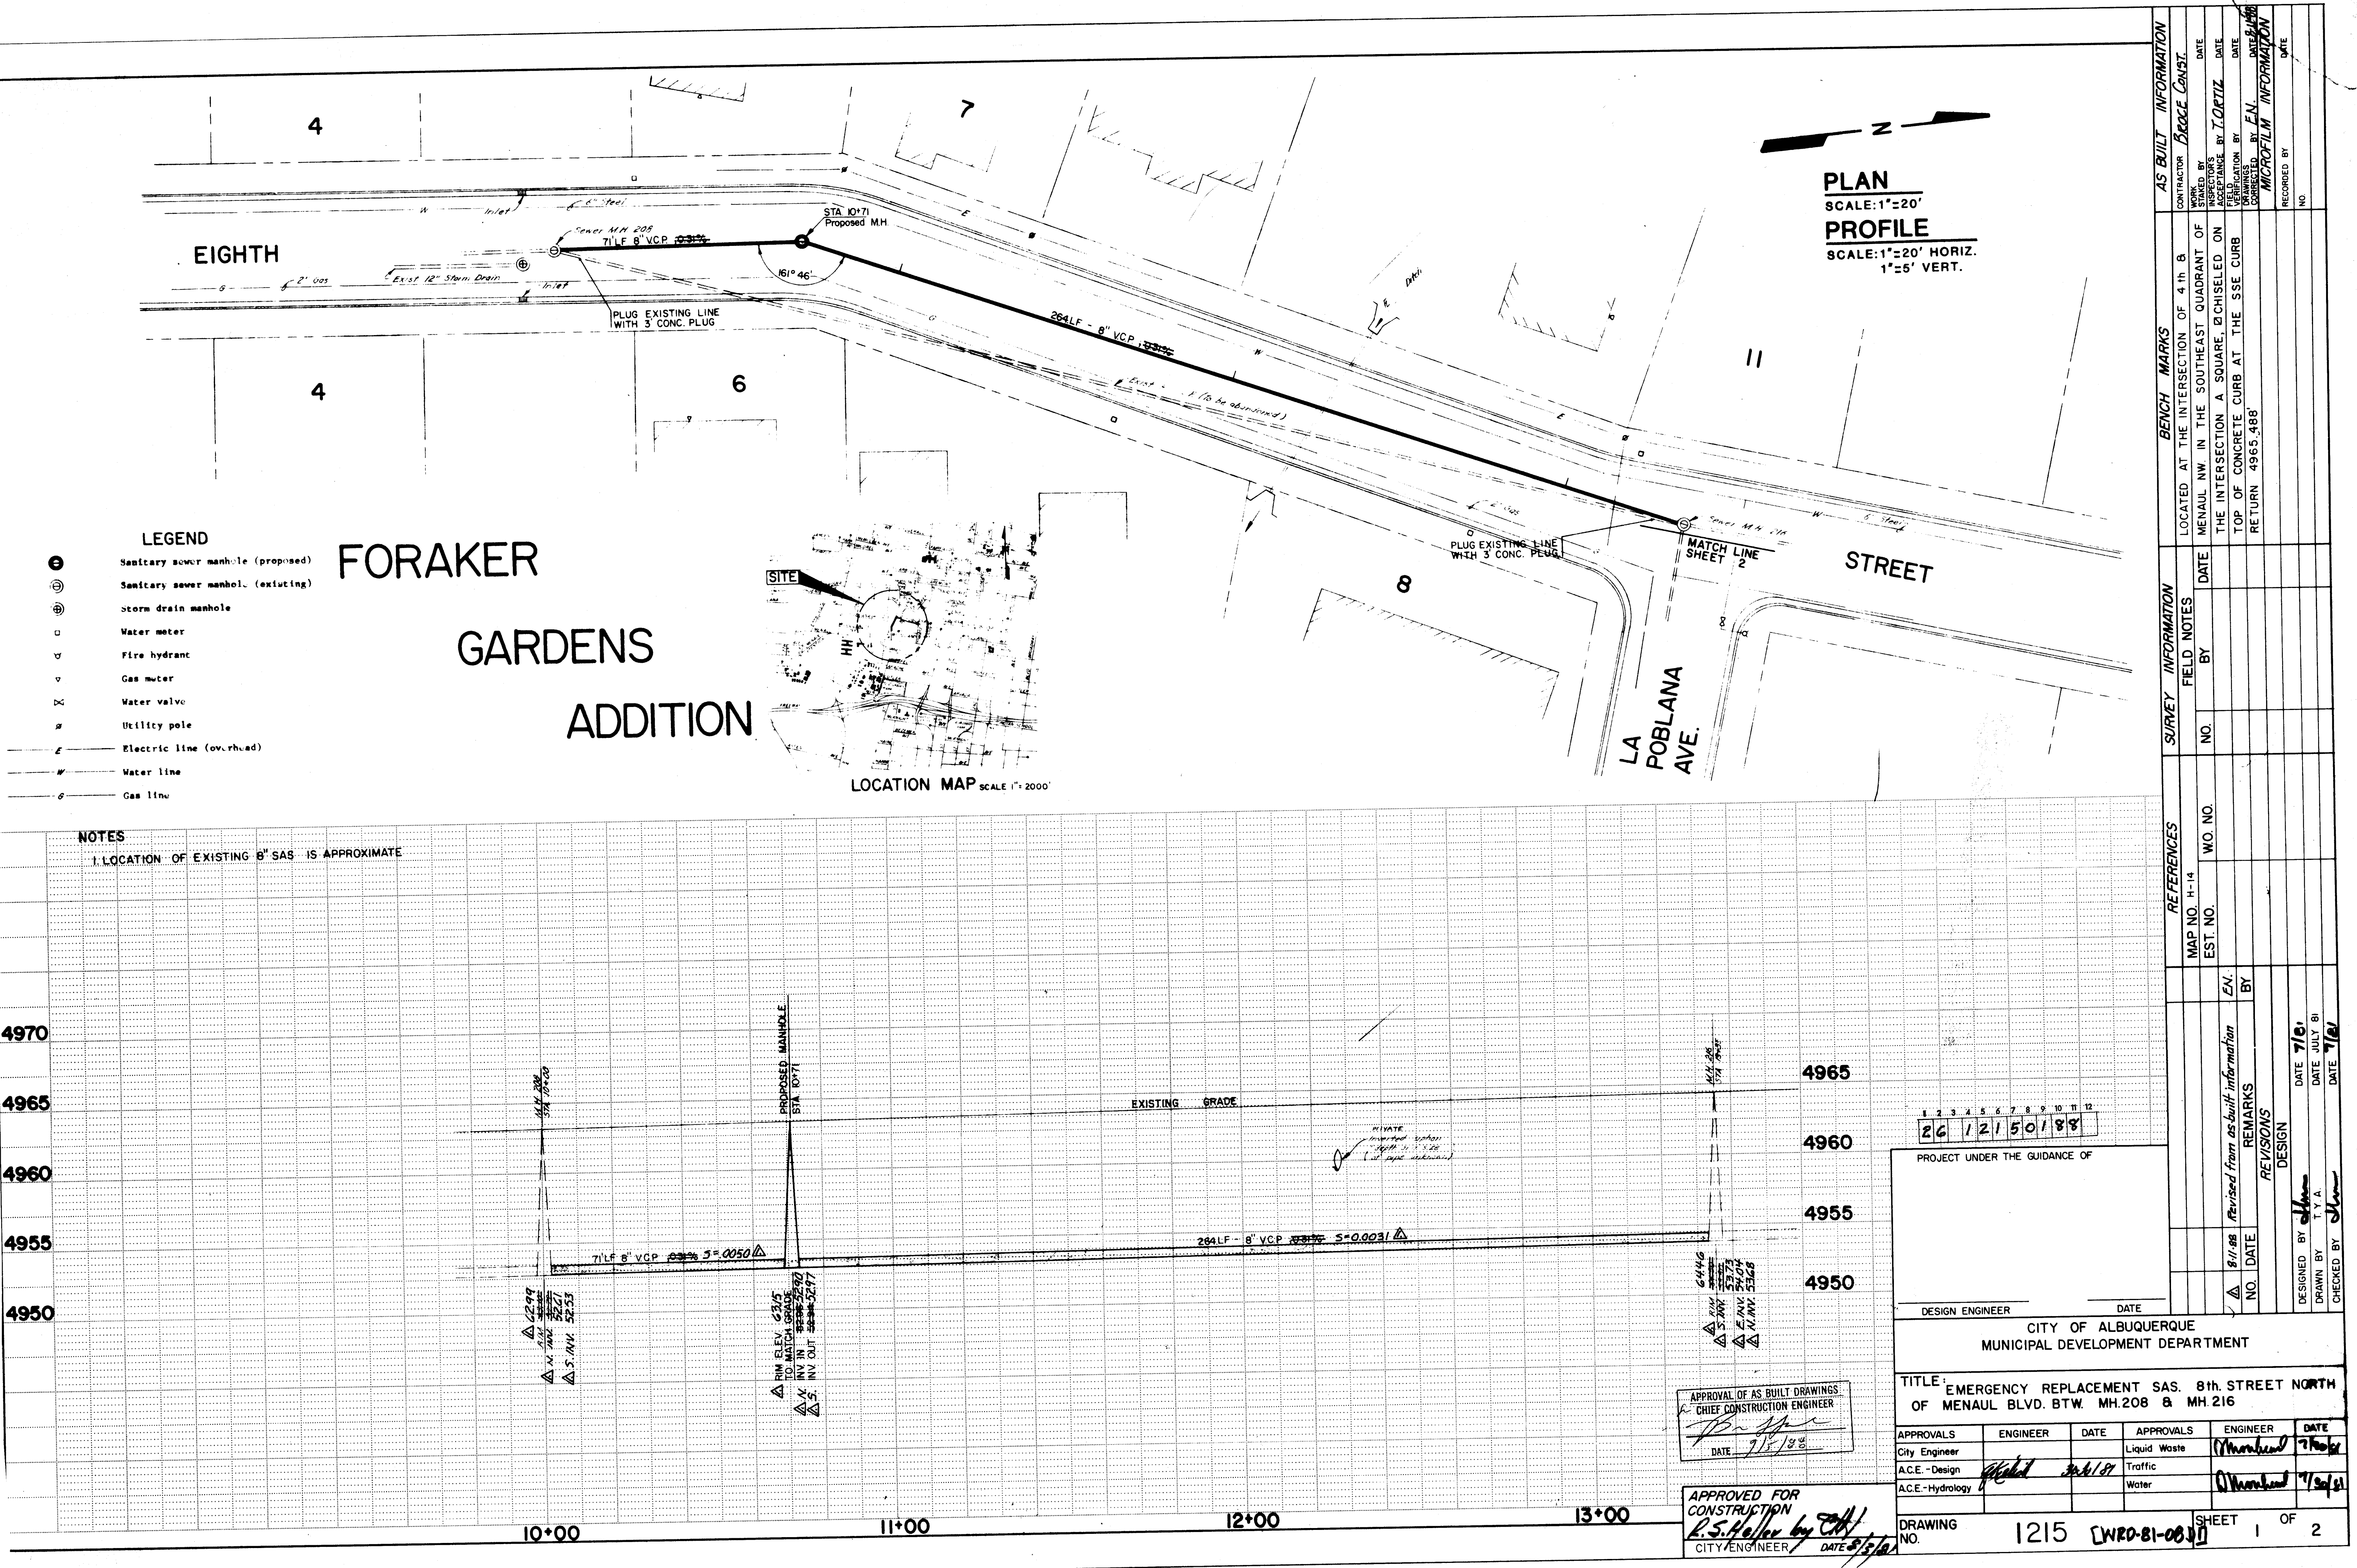

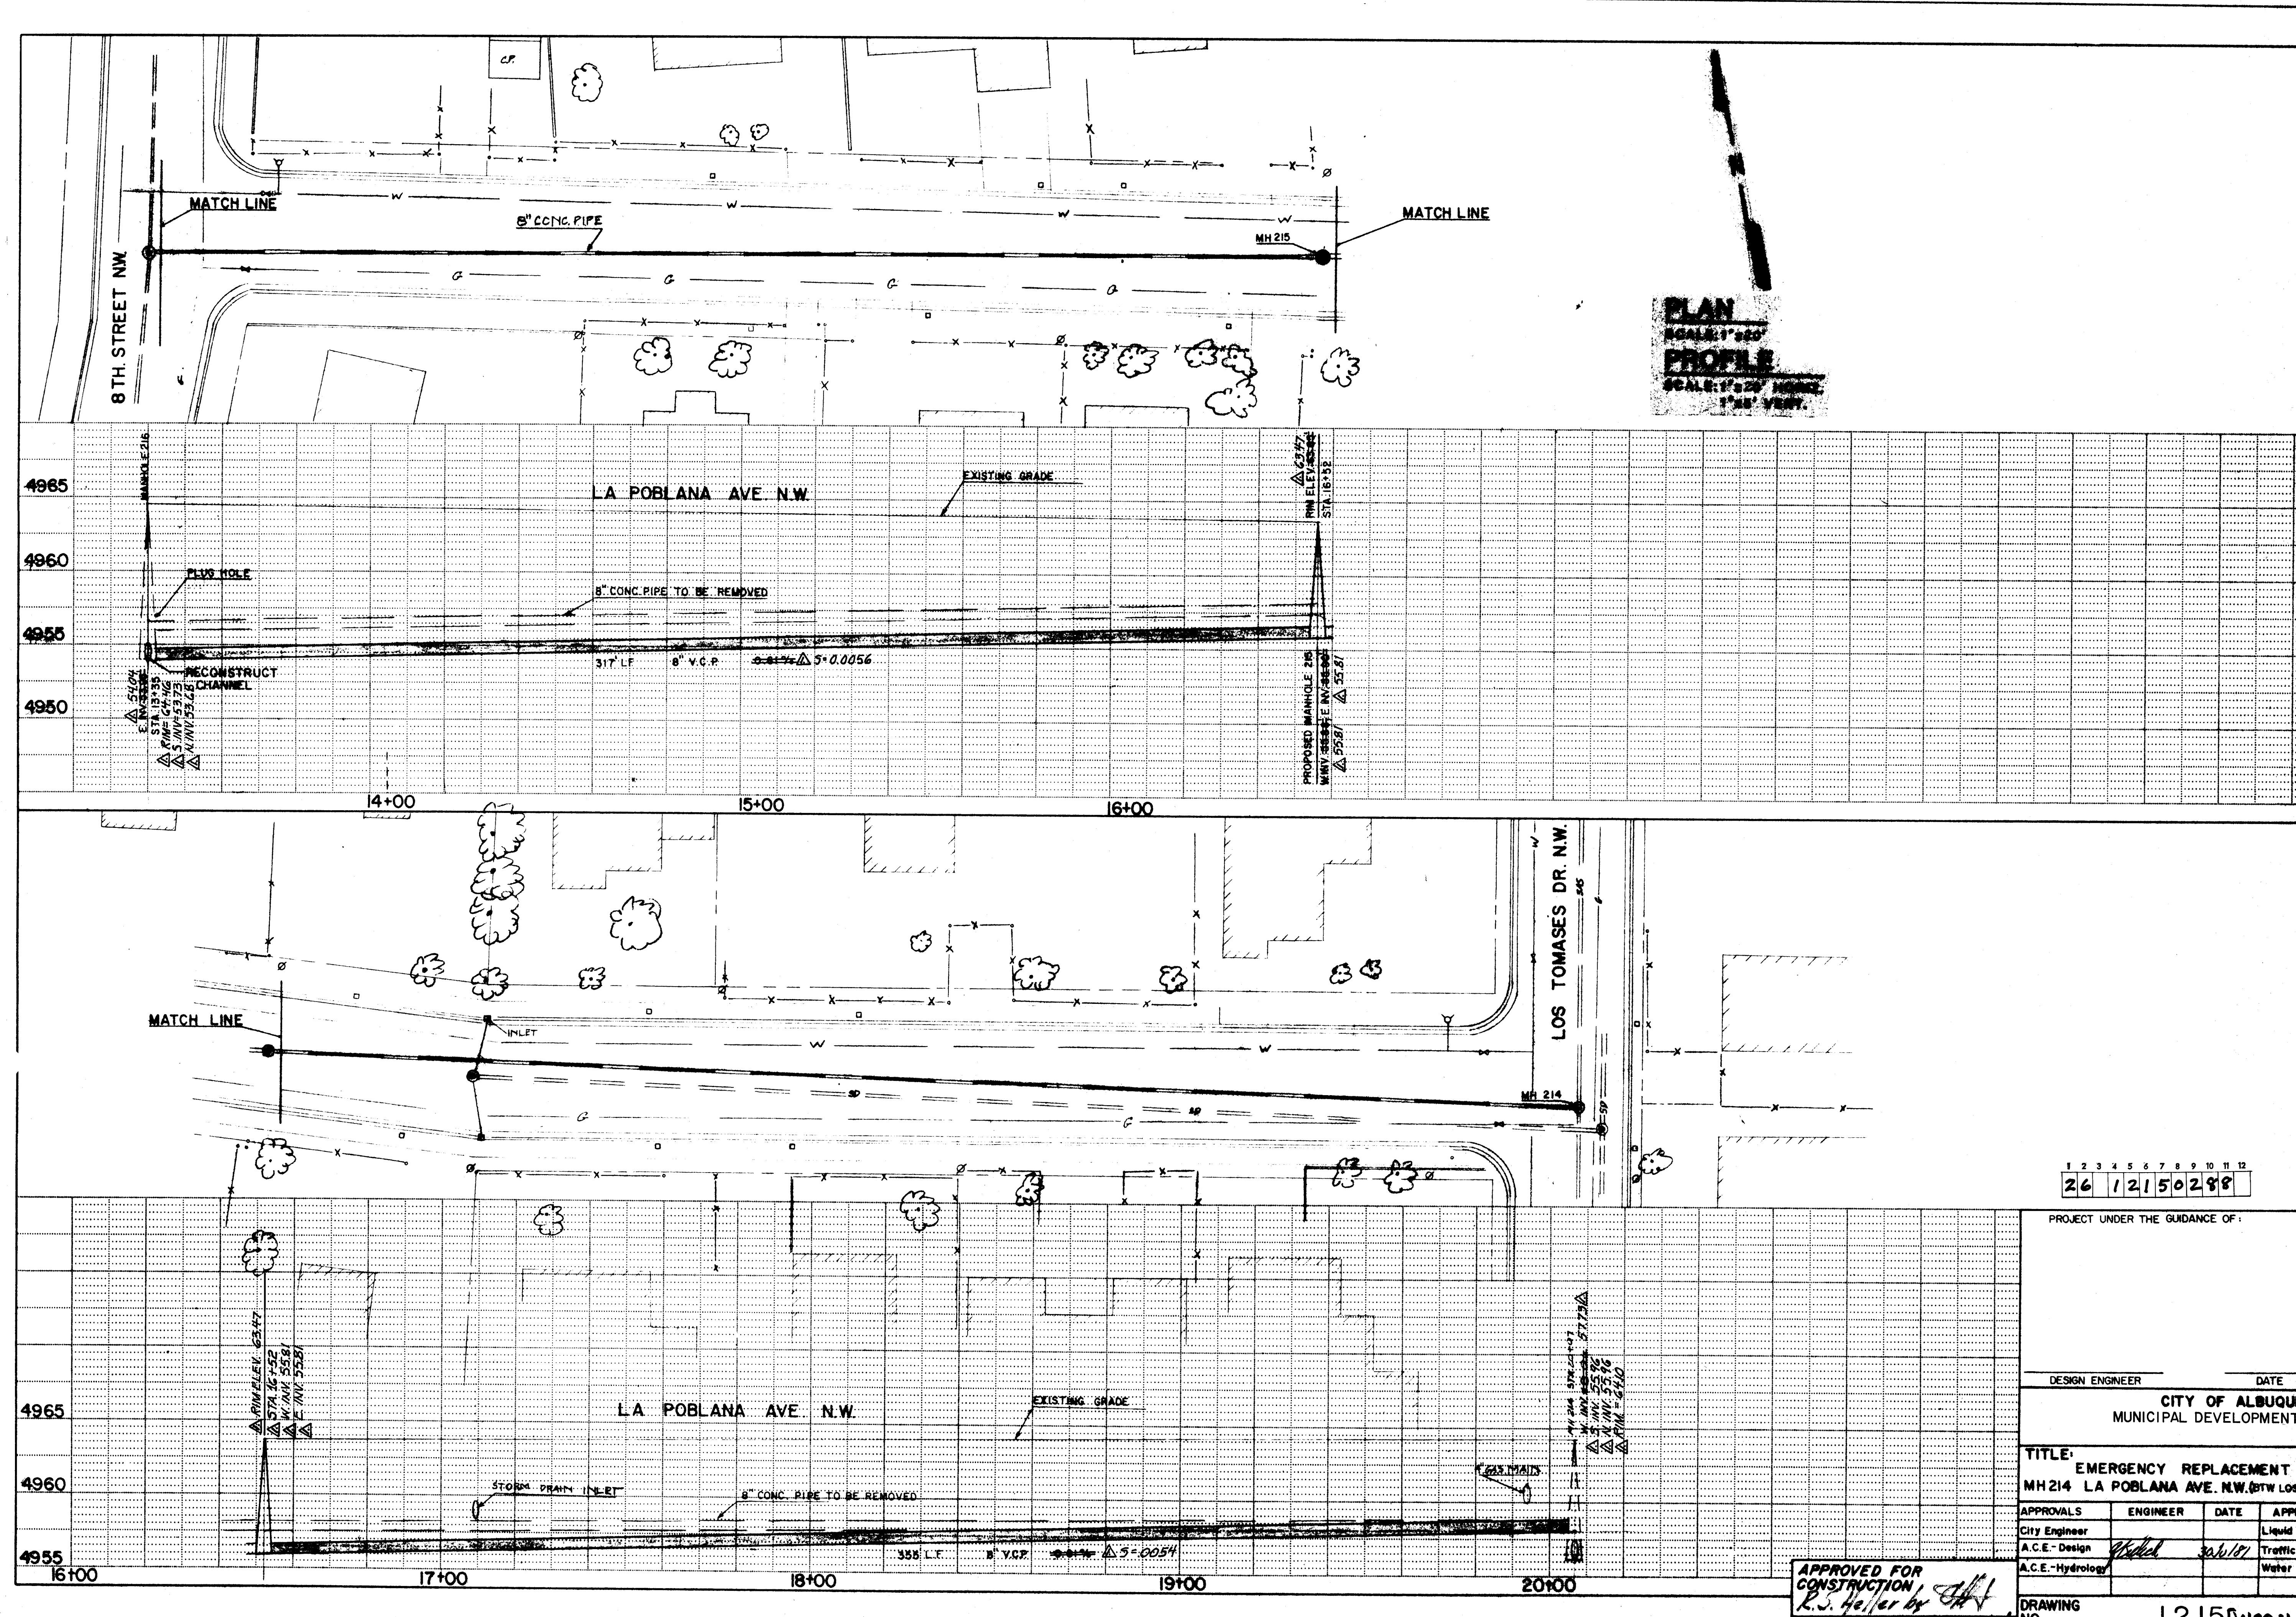

PLAN
PROFILE
SCALE: 1\"/>

1 2 3 4 5 6 7 8 9 10 11 12
26 12150289

PROJECT UNDER THE GUIDANCE OF:

DESIGN ENGINEER DATE
CITY OF ALBUQUERQUE
MUNICIPAL DEVELOPMENT DEPARTMENT

TITLE: EMERGENCY REPLACEMENT SAS BTW MH 214 & MH 215
MH 214 LA POBLANA AVE. N.W. BTW LOS TOMASES DR. & 8TH STREET NW

APPROVALS	ENGINEER	DATE	APPROVALS	ENGINEER	DATE
City Engineer			Liquid Waste	Checked	7/1/01
A.C.E. - Design	W. J. Heiler	6/1/01	Traffic		
A.C.E. - Hydrology			Water	Checked	7/1/01

DRAWING NO. 12150289 SHEET 2 OF 2

APPROVED FOR
CONSTRUCTION
R. J. Heiler
CITY ENGINEER DATE 6/1/01

AS BUILT INFORMATION	
CONTRACTOR	Basell Castl.
DATE	7/1/01
BY	W. J. Heiler
SURVEY INFORMATION	
FIELD NOTES	BY
NO.	
REFERENCES	
MAP NO. H-14	EST. NO.
NO.	
DATE	BY
REVISIONS	BY
DESIGN	
DATE JULY 1/01	DATE JULY 1/01
CHECKED BY	DATE 7/1/01