


SCALE 1"=20' HORIZ.
1"=2' VERT.

M R G C D MAP 46

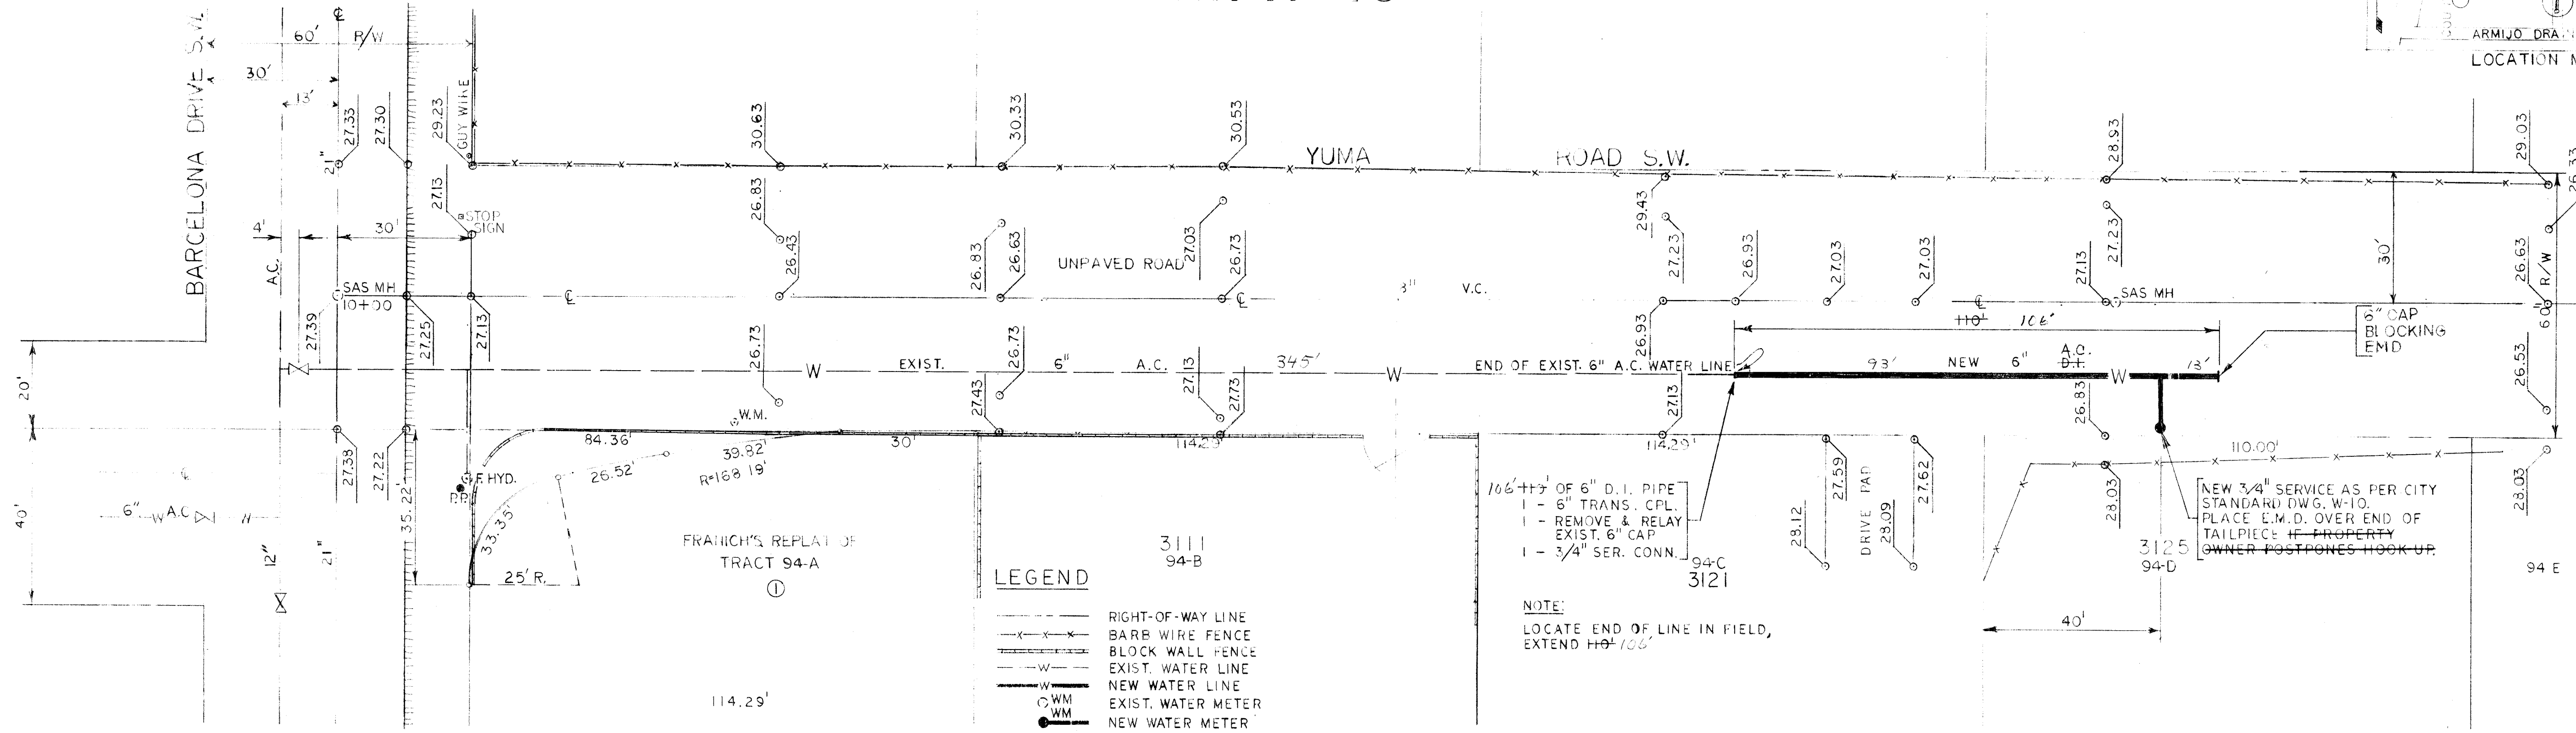


C.B.M. "X" CUT ON TOP SW. B.B. ON FIRE
HYDRANT IN S.W. QUAD. INT. BARCELONA DR.
S.W. AND YUMA RD. S.W. ELEVATION 4923.76

PS-12 H. MERCER
D. KERR
A. GONZALES

SCALE HORIZONTAL 1"=20'
VERTICAL 1"=2'

4930.00
4928.00
4926.00
4924.00
4922.00
4920.00
4918.00

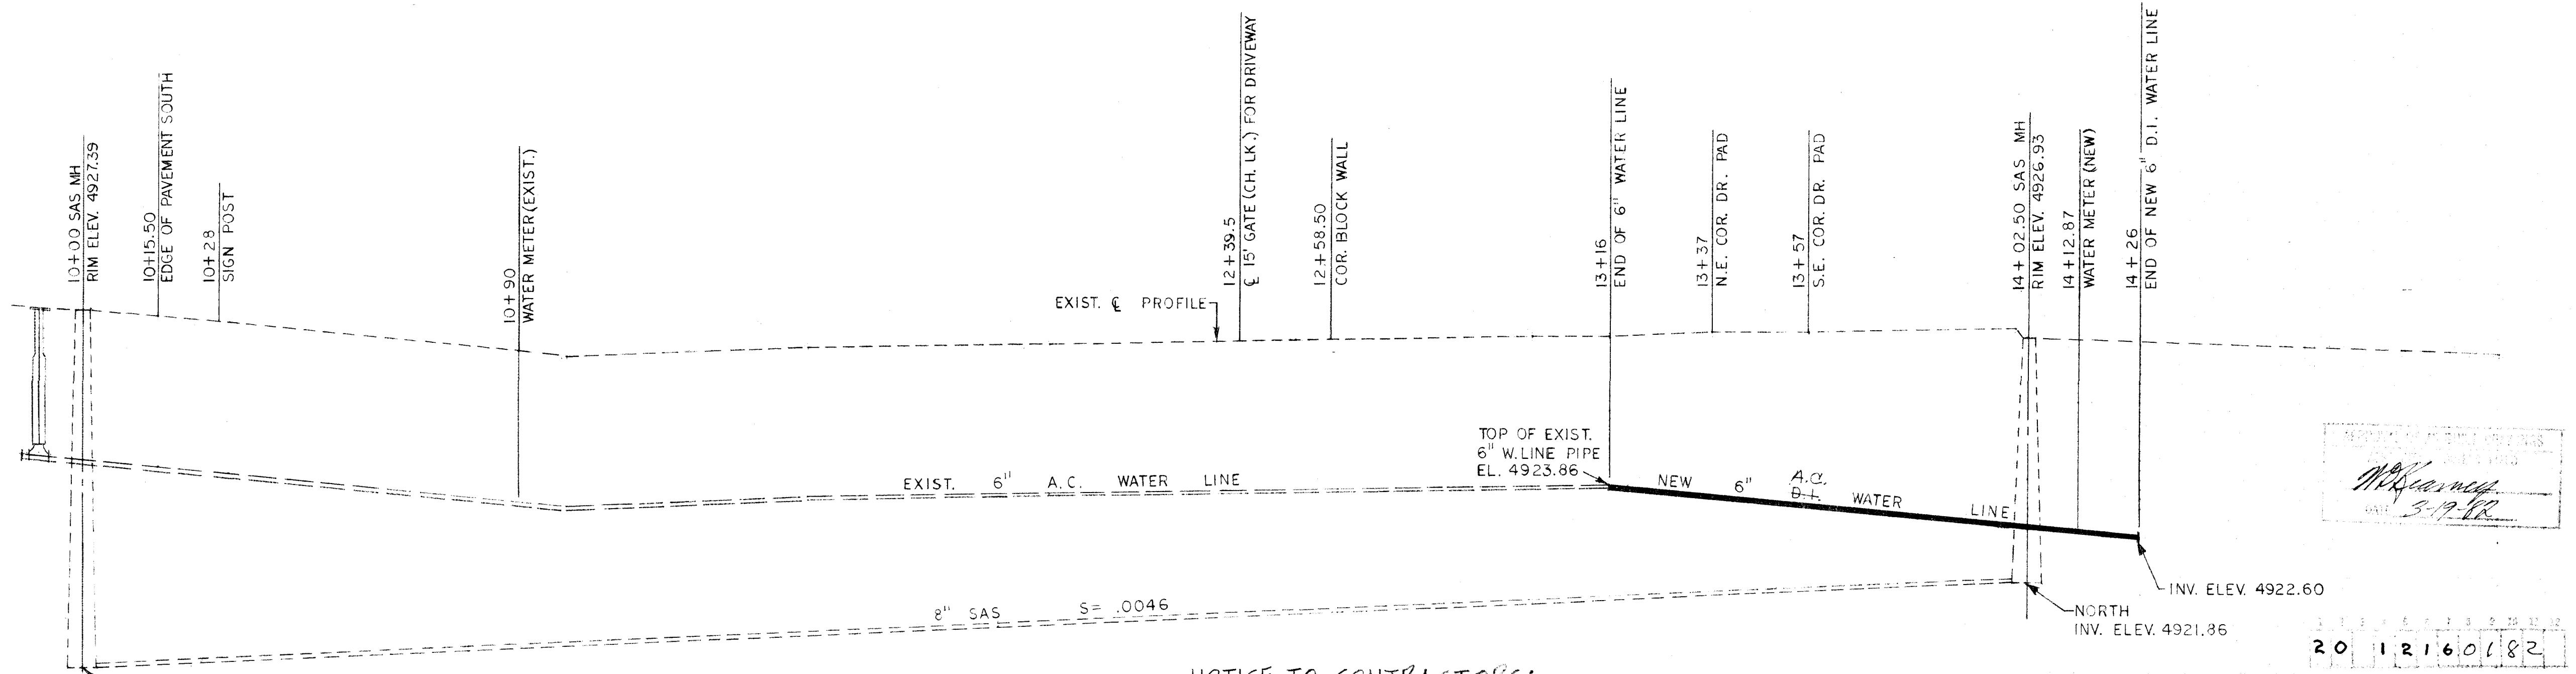

NOTICE TO CONTRACTORS:

1. NEW MEXICO STANDARD SPECIFICATIONS FOR PUBLIC WORKS CONSTRUCTION - 1979 EDITION WILL BE REFERRED TO HEREON AS THE "STANDARD SPECIFICATION."
2. ALL WORK DETAILLED ON THESE PLANS TO BE PERFORMED UNDER CONTRACT SHALL, EXCEPT AS OTHERWISE STATED OR PROVIDED FOR HEREON, BE CONSTRUCTED IN ACCORDANCE WITH "CONTRACT REQUIREMENTS FOR CITY-WIDE UTILITIES AND CASH PAYING NO. 90" AND THE STANDARD SPECIFICATION."

NOTICE TO CONTRACTOR
PRIOR TO EXCAVATION, THE CONTRACTOR SHALL EXCAVATE AND VERIFY THE HORIZONTAL AND VERTICAL LOCATIONS OF ALL EXISTING UTILITIES. SHOULD A CONFLICT EXIST, THE CONTRACTOR SHALL NOTIFY THE ENGINEER OR SURVEYOR SO THAT THE CONFLICT CAN BE RESOLVED WITH A MINIMUM AMOUNT OF DISRUPTION.

TWO WORKING DAYS PRIOR TO ANY EXCAVATION, CONTRACTOR MUST CONTACT LINE LOCATING SERVICE, 765-1234, FOR LOCATION OF EXISTING UTILITIES.

MUNICIPAL DEVELOPMENT DEPARTMENT
6" WATER LINE EXTENSION SOUTH OF
BARCELONA DR. S.W. ON YUMA RD. S.W. TO SOUTH
END OF LOT 94 F

Handwritten signatures and initials.

1216

Handwritten signature: R.S. Garcia by [initials] 7/16