


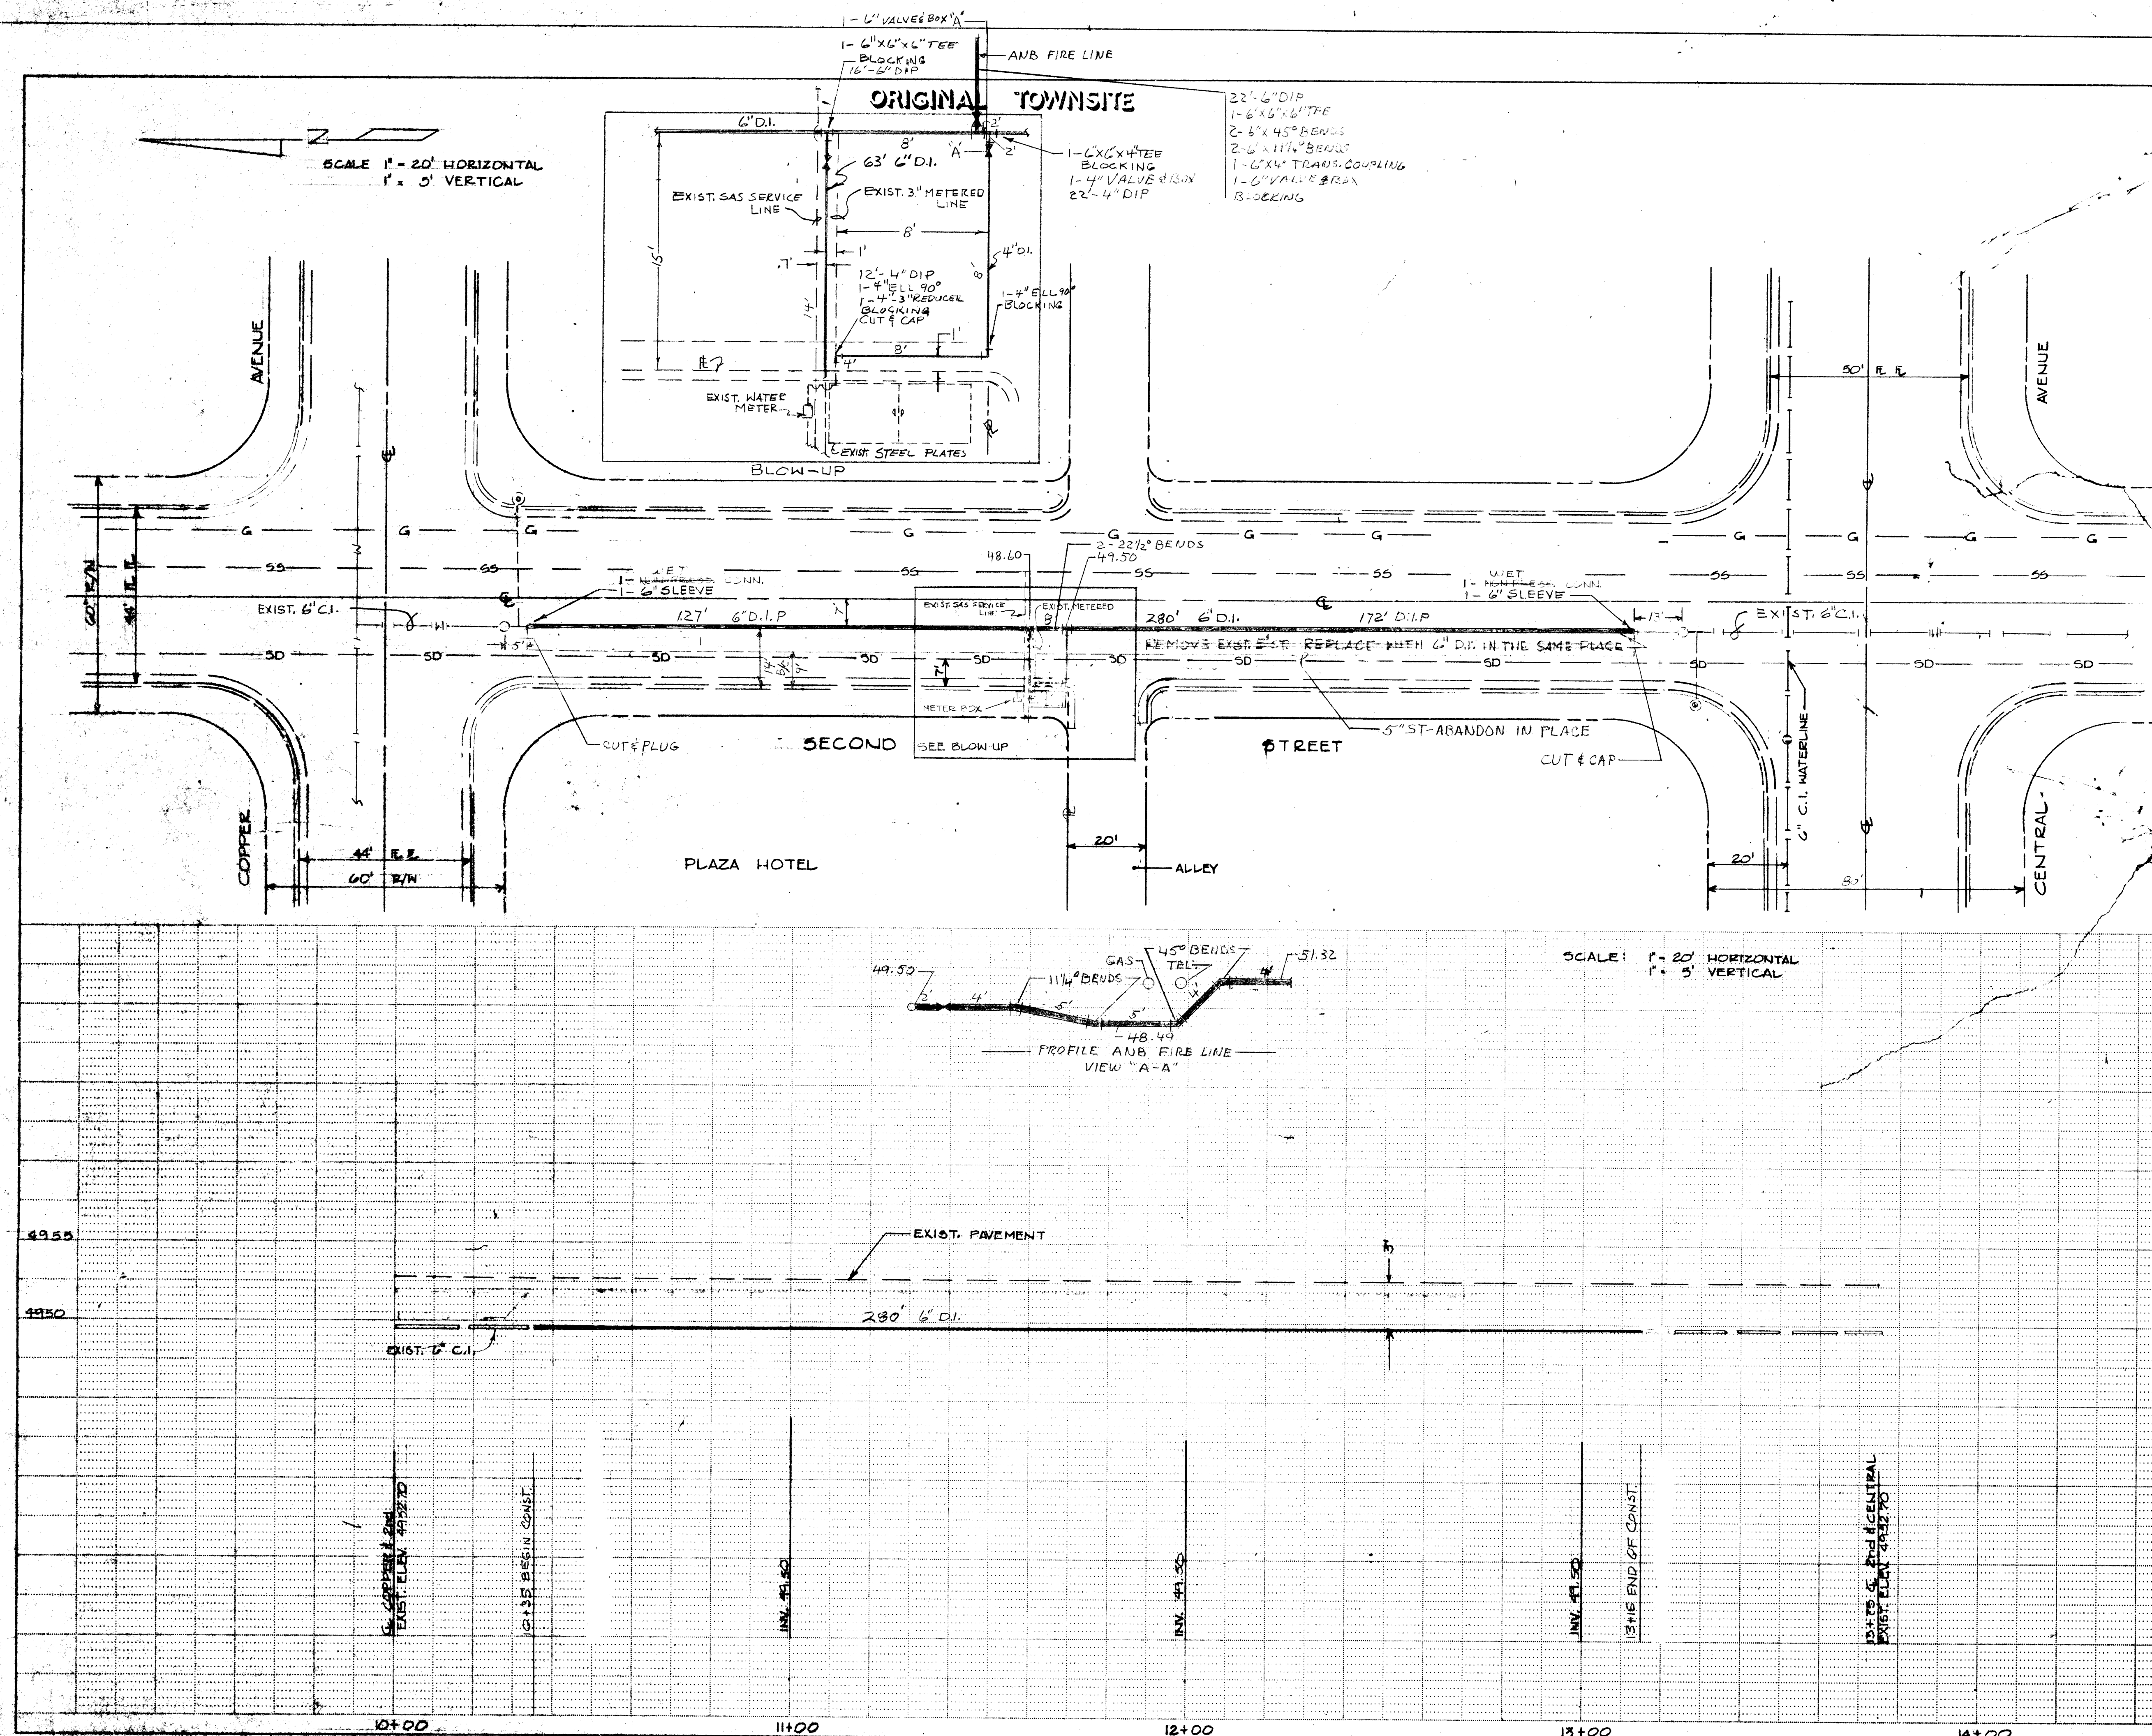

"NOTICE TO CONTRACTORS"

- 1) New Standard Specifications for Public Works Construction - 1979 Edition will be required in all work on the "Standard Specifications."
- 2) All work detailed on these plans is to be performed under contract and shall conform to all other standards or provided for herein, be constructed in accordance with "Contract Documents for City-wide Utilities and Cash Paying No. 32, and the Standard Specifications."
- 3) Two working days prior to any excavation, contractor must contact Line Locating Service, 755-1234, for location of existing utilities.
- 4) Prior to construction, the contractor shall locate and verify the horizontal and vertical locations of all obstructions. Should a conflict arise, the contractor shall notify the engineer or surveyor so that the conflict can be resolved with minimum amount of delay.

THE FOLLOWING NOTES APPLY WHEN CHECKED

- ☐ All utilities and utility service lines shall be located prior to paving.
- ☒ Backfill compaction shall be according to specified street use.
- ☒ Test cost requirements shall be determined by the City Engineer.
- ☐ Sidewalks and wheelchair ramps within the curb return shall be constructed wherever a new curb return is constructed.
- ☐ If curb is depressed for a driveway, the driveway shall be constructed prior to acceptance of the curb and gutter.
- ☐ All storm drainage facilities shall be completed prior to final acceptance.

LEGEND

- EXIST. 5" STEEL
- NEW 6" D.I.
- W. WATER VALVE
- F. FIRE HYDRANT
- S. SANITARY SEWER
- SD. STORM DRAIN
- G. GAS LINE

APPROVED FOR AS BUILT DRAWINGS
CITY ENGINEER - FIELD
DATE 8/23/99

20 121701812

CITY OF ALBUQUERQUE MUNICIPAL DEVELOPMENT DEPARTMENT ENGINEERING DIVISION			
TITLE: WATERLINE REPLACEMENT IN 2nd BETWEEN COPPER AND CENTRAL AVENUES			
APPROVALS	ENGINEER	DATE	APPROVALS
City Engineer	<i>[Signature]</i>	9/16/99	Liquid Waste
A.C.E. - Design	<i>[Signature]</i>	9/30/99	Traffic
A.C.E. - Hydrology	<i>[Signature]</i>		Water
DESIGNED BY	S. MICANCA	DATE	5/12/98
DRAWN BY	L. CHAVEZ	DATE	5/12/98
CHECKED BY		DATE	
DRAWING NO.	1217	MAP NO.	K-14
		SHEET	1 OF 1