


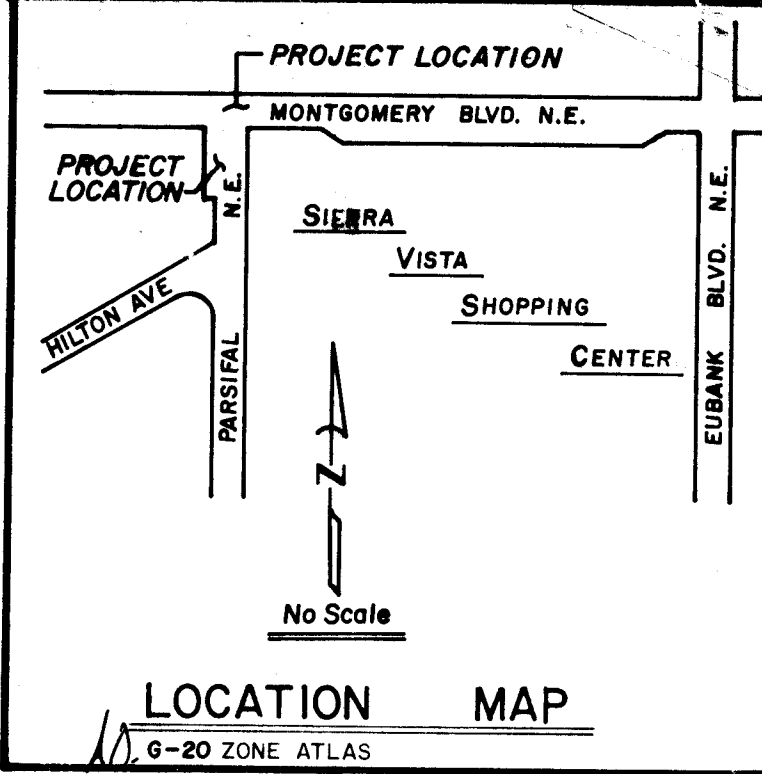

MEDIAN REVISION ON MONTGOMERY

WEST OF EUBANK FOR SIERRA VISTA SHOPPING CENTER

— ALSO —

CONSTRUCTION OF PARSIFAL

SOUTH OF MONTGOMERY

"NOTICE TO CONTRACTORS"

- 1.) New Mexico Standard Specifications for Public Works Construction - 1979 Edition will be referred to hereon as the "Standard Specification."
- 2.) All work detailed on these plans to be performed under contract shall, except as otherwise stated or provided for hereon, be constructed in accordance with "Contract Documents for City-Wide Utilities and Cash Paving No. 31" and the Standard Specification."
- 3.) Two working days prior to any excavation, contractor must contact Line Locating Service, 765-1234, for location of existing utilities.
- 4.) Prior to construction, the contractor shall excavate and verify the horizontal and vertical locations of all obstructions. Should a conflict exist, the contractor shall notify the engineer or surveyor so that the conflict can be resolved with minimum amount of delay.

THE FOLLOWING NOTES APPLY WHEN CHECKED

- ☒ All utilities and utility service lines shall be installed prior to paving.
- ☒ Backfill compaction shall be according to specified street use.
- ☒ Tack coat requirements shall be determined by the City Engineer.
- ☒ Sidewalks and wheelchair ramps within the curb returns shall be constructed wherever a new curb return is constructed.
- ☒ If curb is depressed for a driveway, the driveway shall be constructed prior to acceptance of the curb and gutter.
- ☐ All storm drainage facilities shall be completed prior to final acceptance.

APPROVAL OF AS BUILT DRAWINGS
ASST. CITY ENGINEER - FIELD
W.F. McManis
DATE 4-12-84



26 1227 0189

REVISION APPROVAL					
REV	SHEET	CITY ENGINEER	DATE	USER	DEPT.
Δ	123				

APPROVED FOR CONSTRUCTION
C. L. [Signature]
CITY ENGINEER DATE

APPROVED FOR CONSTRUCTION
[Signature]
CITY ENGINEER DATE

DRAWING NO. 1227 SHEET OF 3

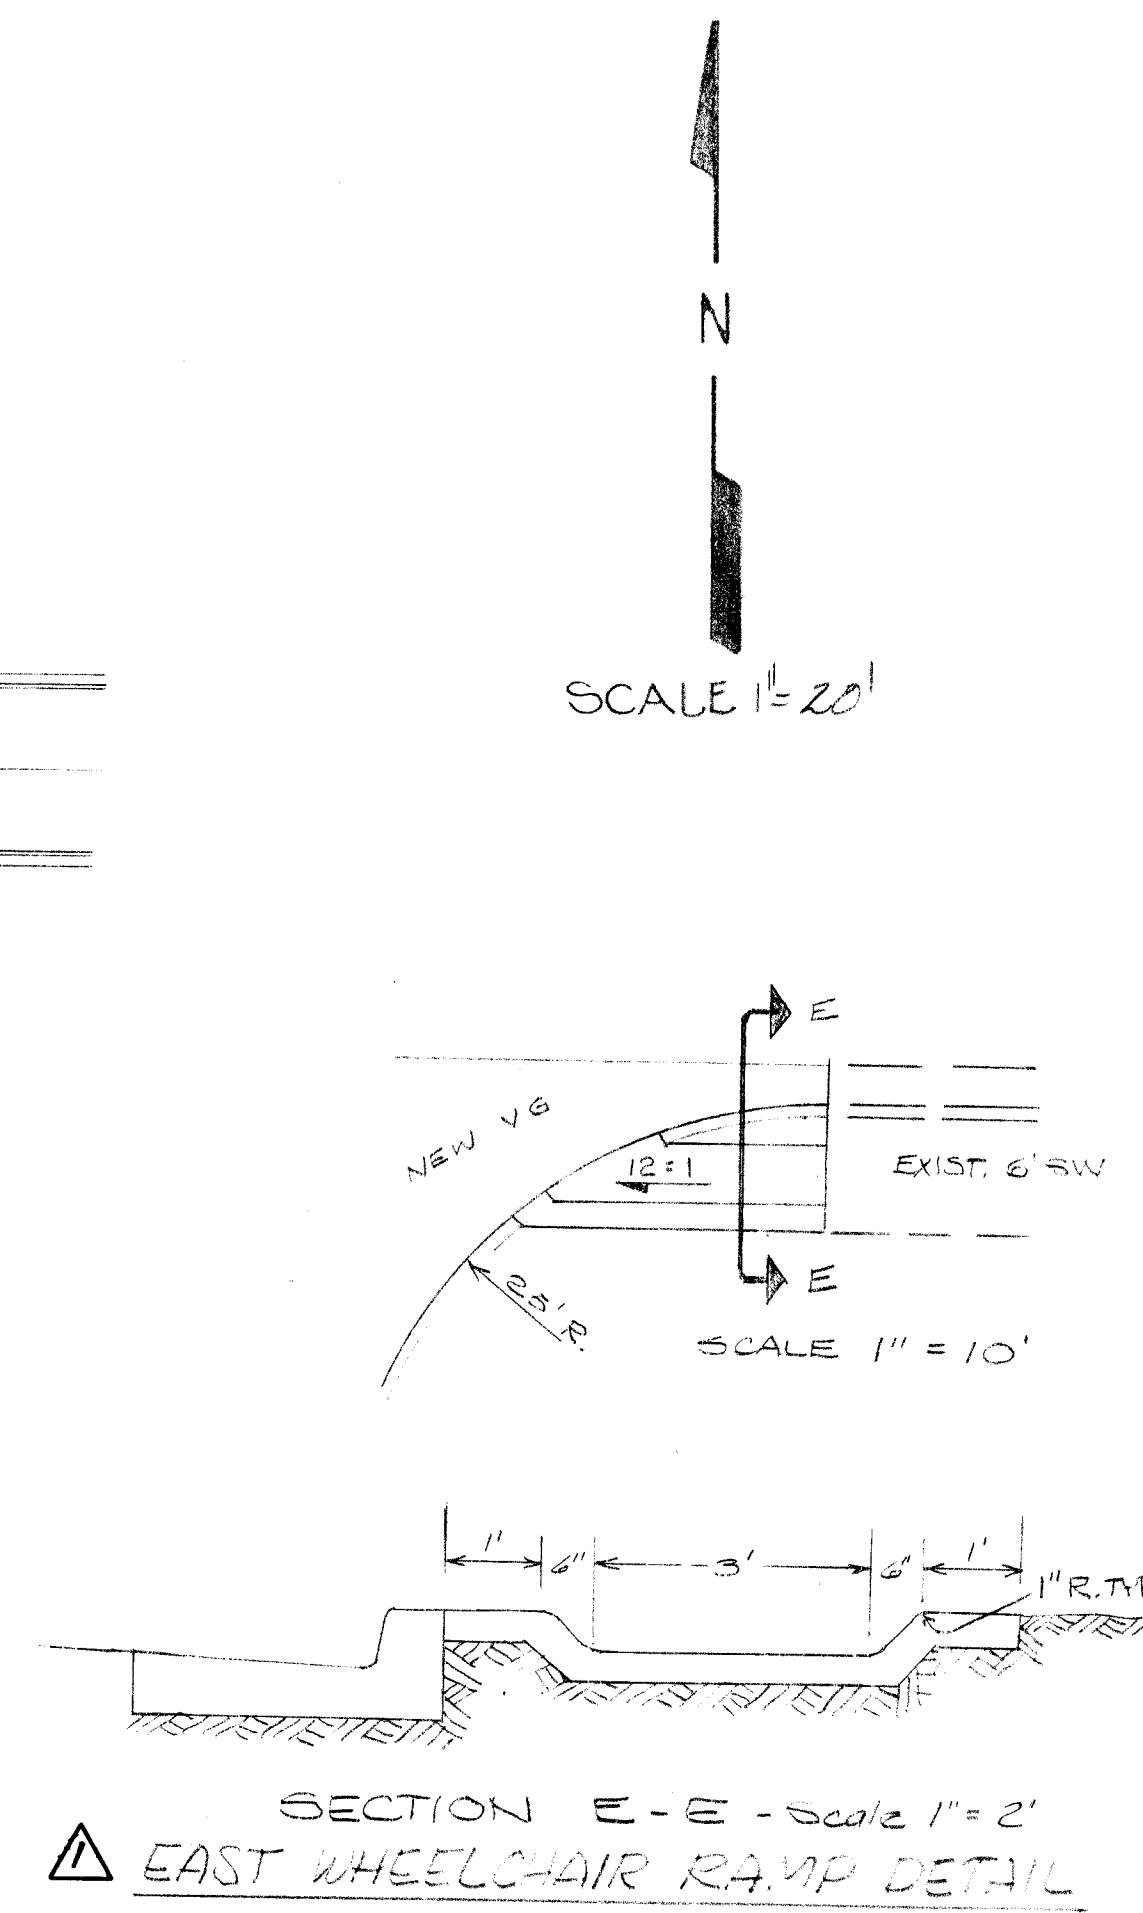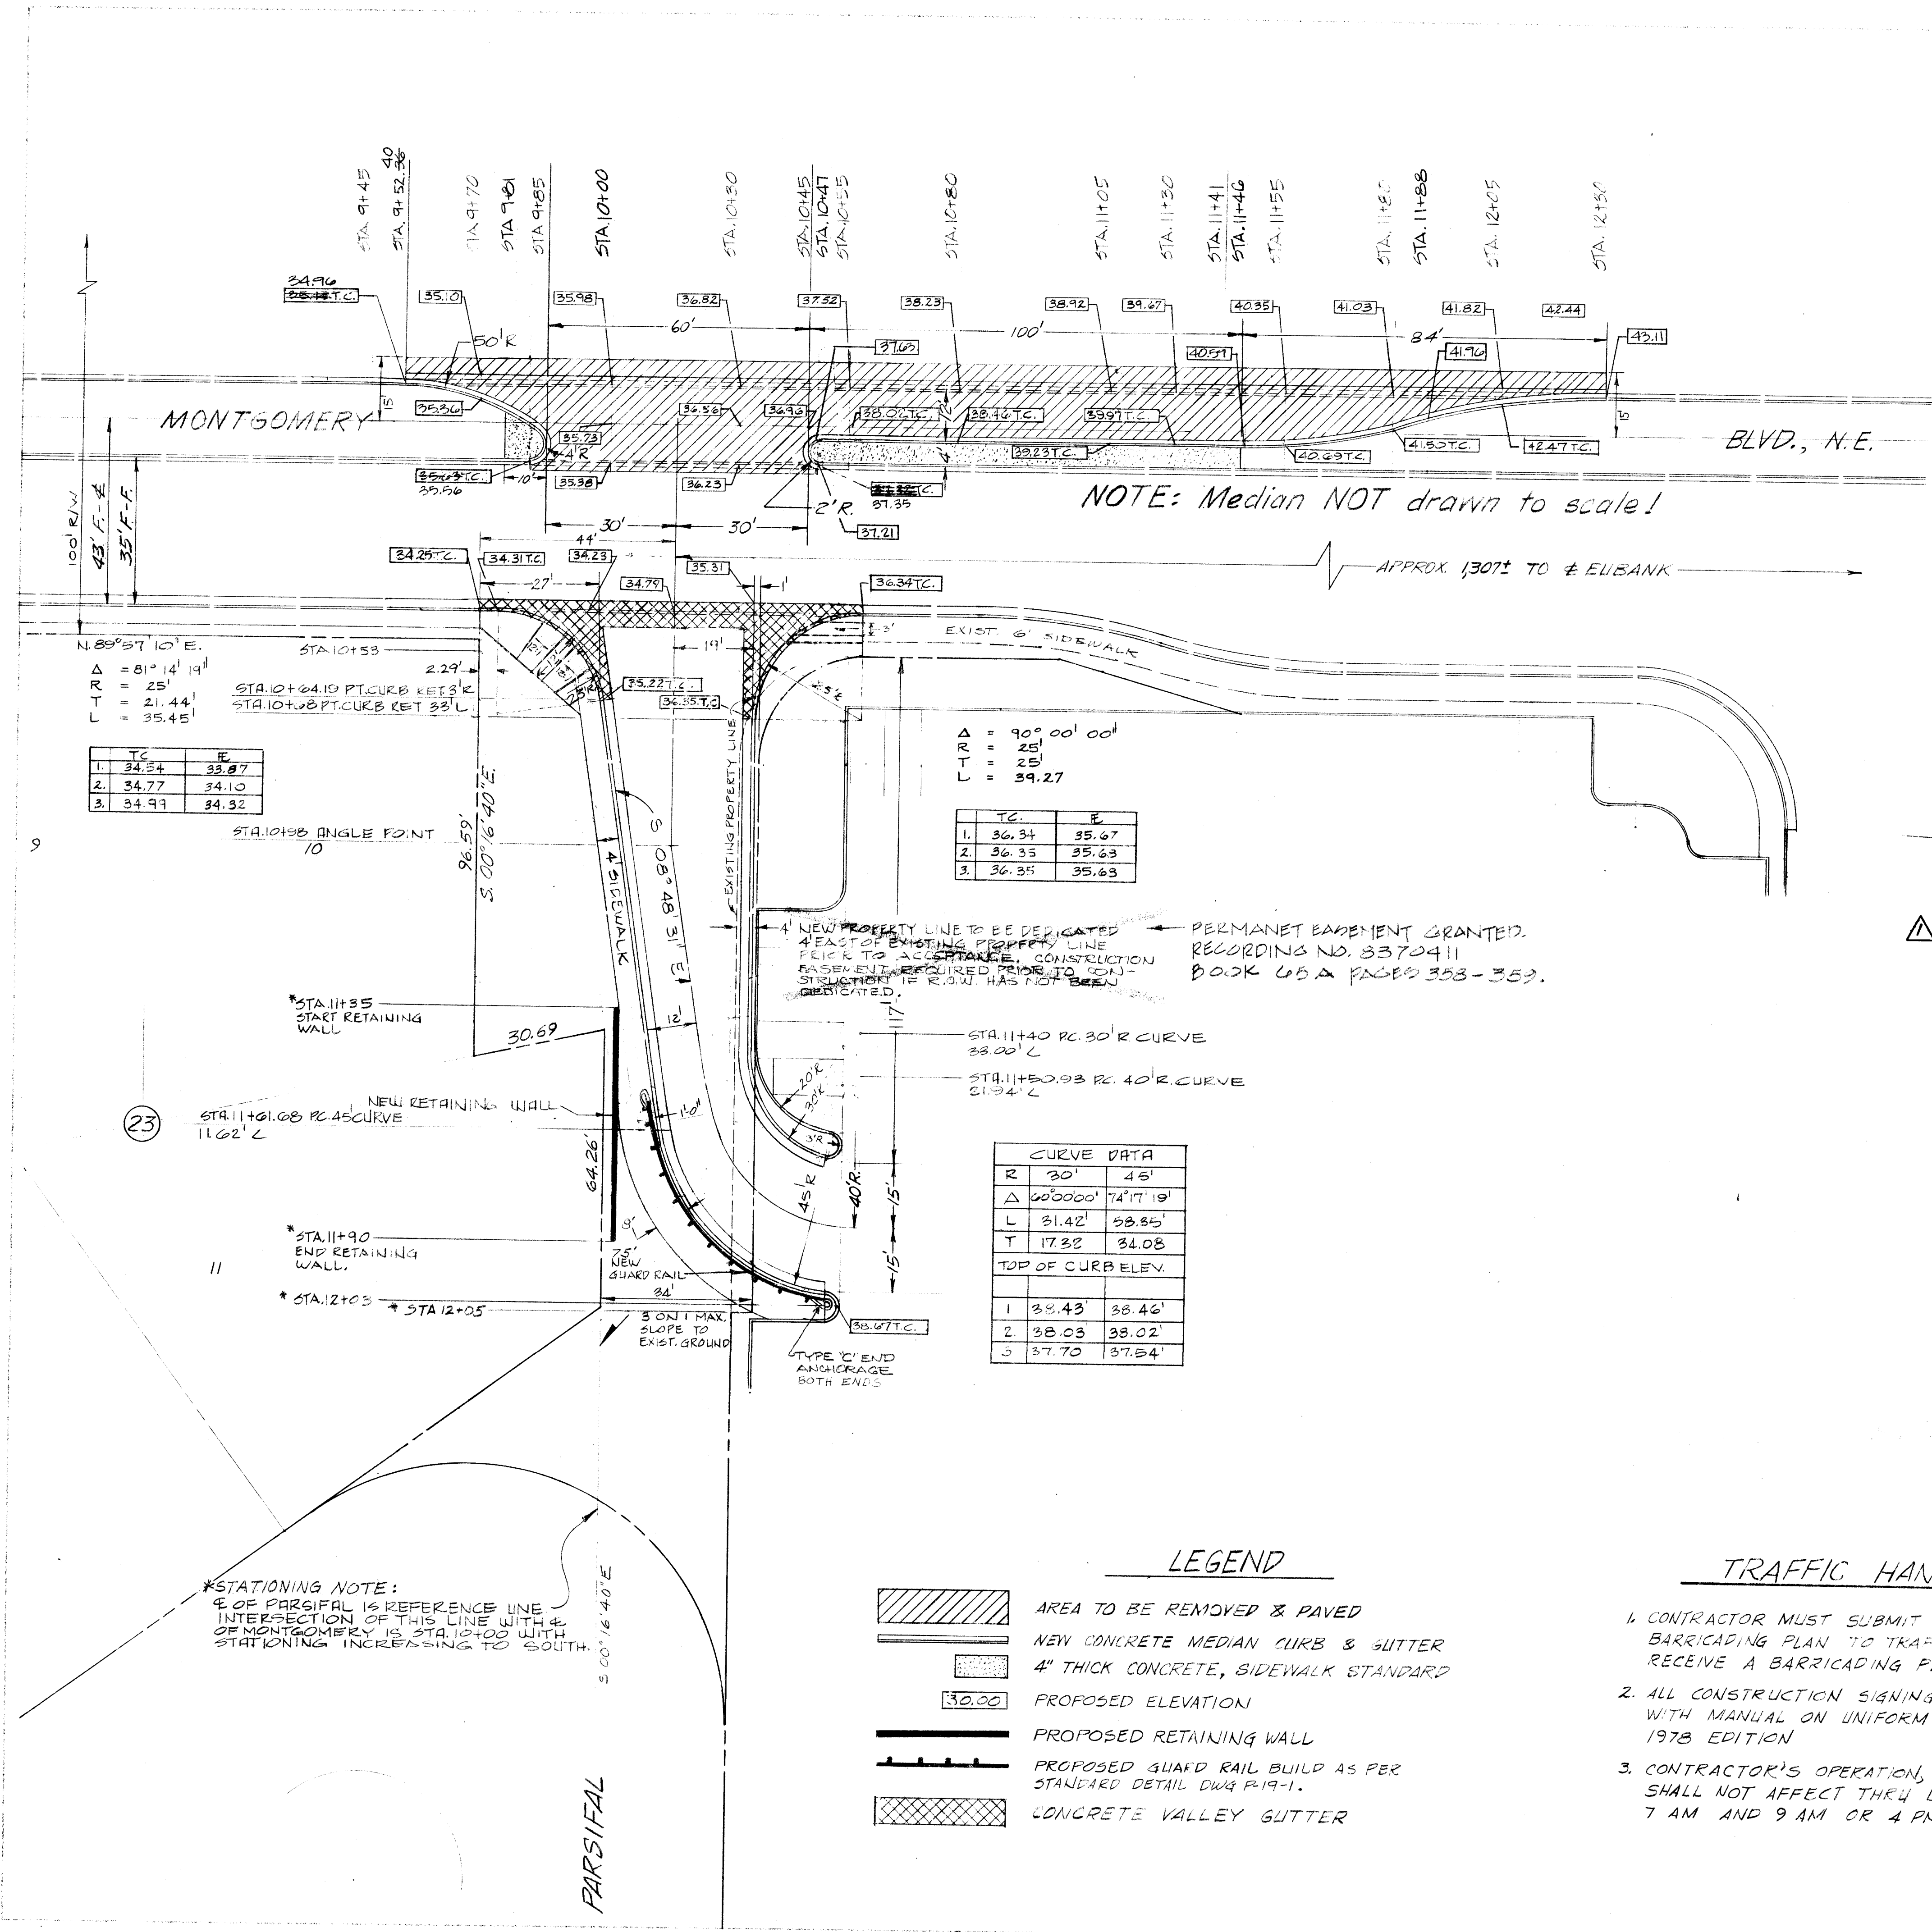

GENERAL NOTE

ALL WORK SHOWN BOTH ON AND OFF R.O.W. TO BE DONE BY A.H.B.A. CONTRACTOR. ONLY THE QUANTITIES SHOWN ON R.O.W. ARE TO BE USED IN DETERMINING CITY ENGINEERING FEES.

TRAFFIC HANDLING NOTES

- CONTRACTOR MUST SUBMIT A CONSTRUCTION SIGNING AND BARRICADING PLAN TO TRAFFIC ENGINEERING DIVISION AND RECEIVE A BARRICADING PERMIT PRIOR TO CONSTRUCTION.
- ALL CONSTRUCTION SIGNING AND BARRICADING TO COMPLY WITH MANUAL ON UNIFORM TRAFFIC CONTROL DEVICES, 1978 EDITION
- CONTRACTOR'S OPERATION, BARRICADING AND SIGNING SHALL NOT AFFECT THRU LANES OF MONTGOMERY BETWEEN 7 AM AND 9 AM OR 4 PM AND 6 PM.

26 1227 0284

CITY OF ALBUQUERQUE
 MEDIAN REVISION ON MONTGOMERY WEST OF ELBANK FOR SIERRA VISTA SHOPPING CENTER

MR 31-E

DATE: 8/16/83
 DRAWN BY: [Signature]
 CHECKED BY: [Signature]
 DATE: 8/16/83

1227 G-20 2 3




VARIOUS CLARIFYING NOTES AND DETAILS

8-3-83

12-81
 8-18-81
 8/12/81

ANGEL
 PROMEIO
 J. GARCIA
 ARCHLUDE
 ABEYTA

NYLIE CORP.
 E. GARCIA
 E. DUBAN

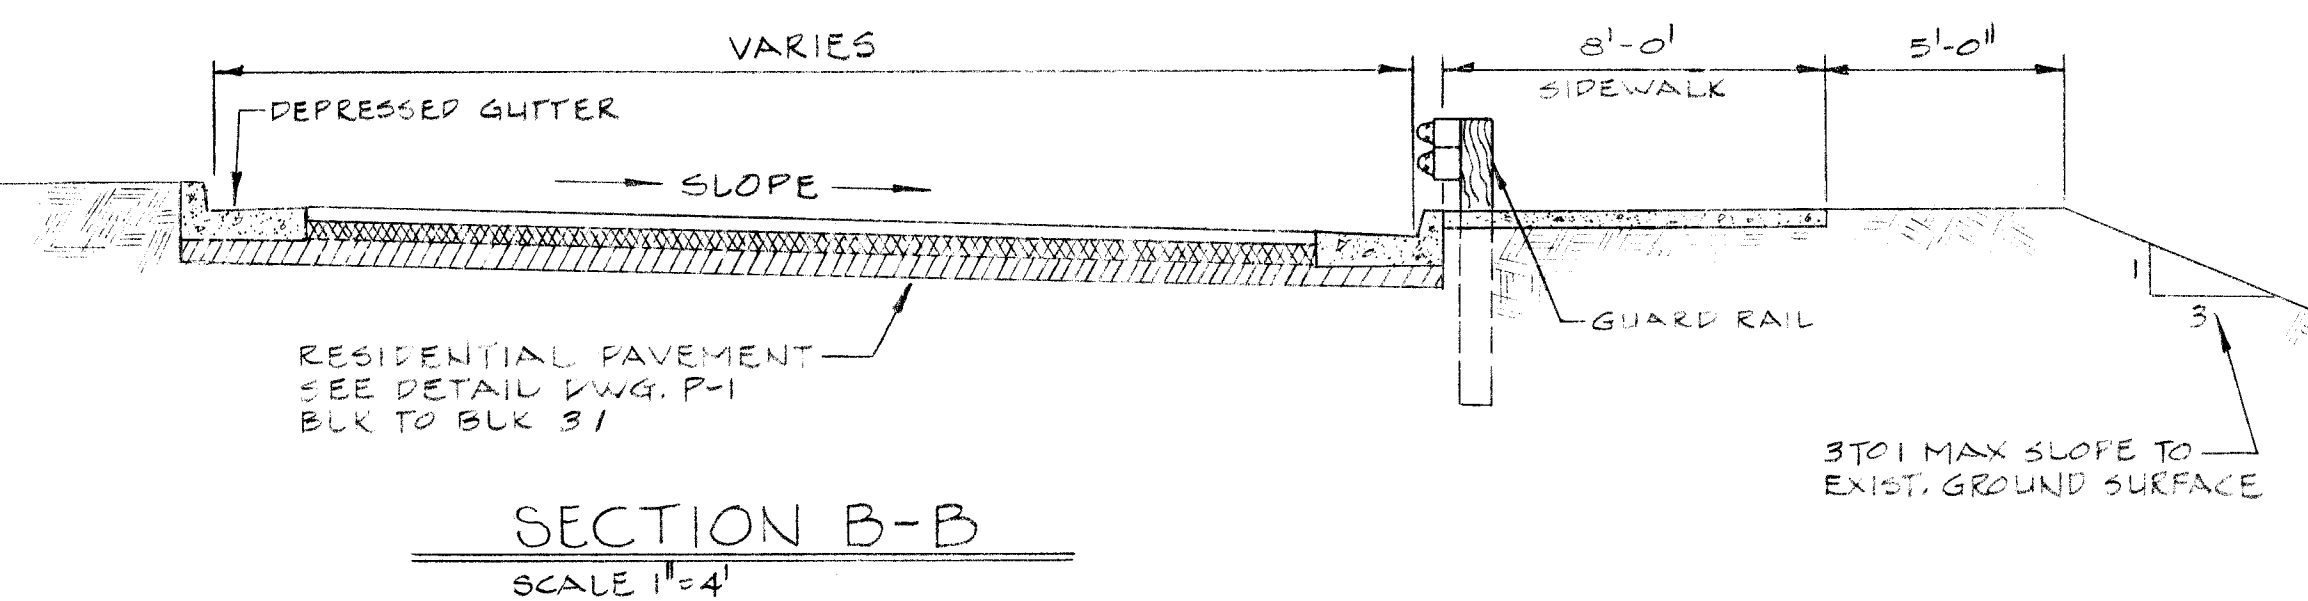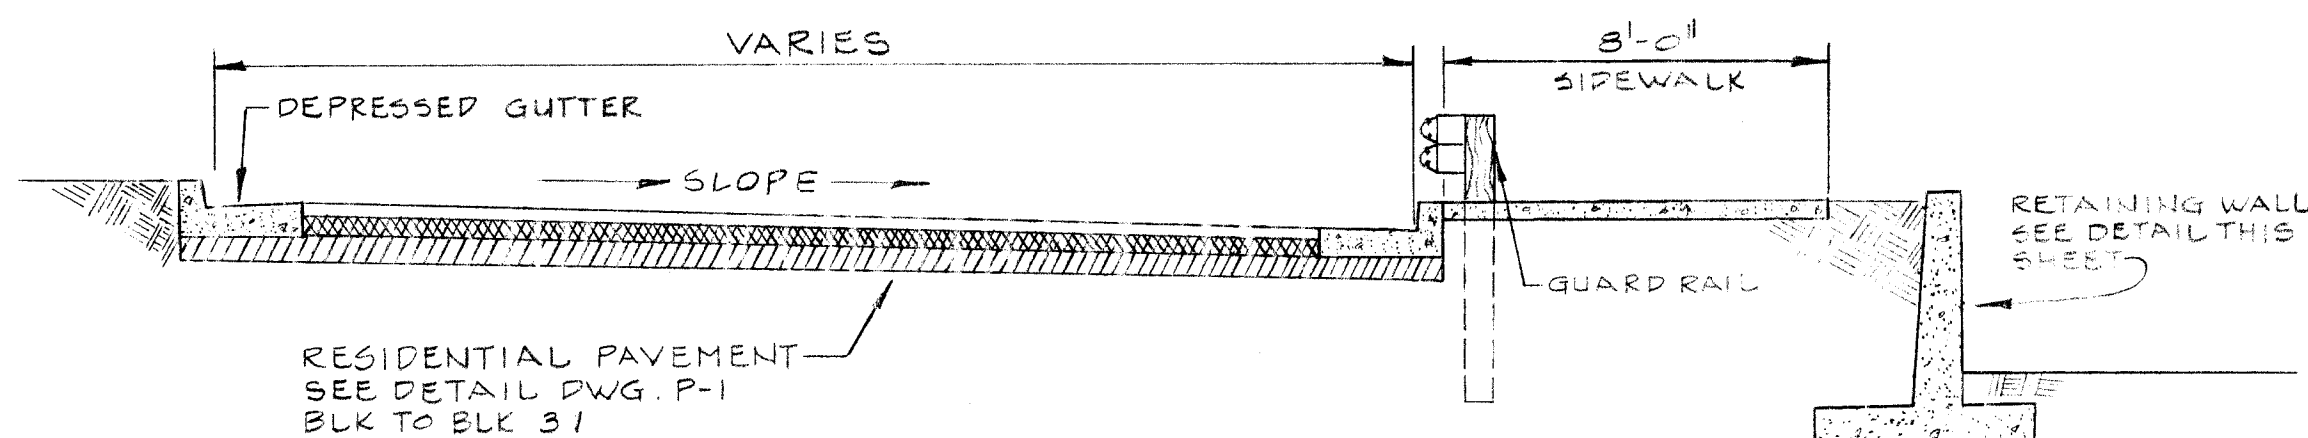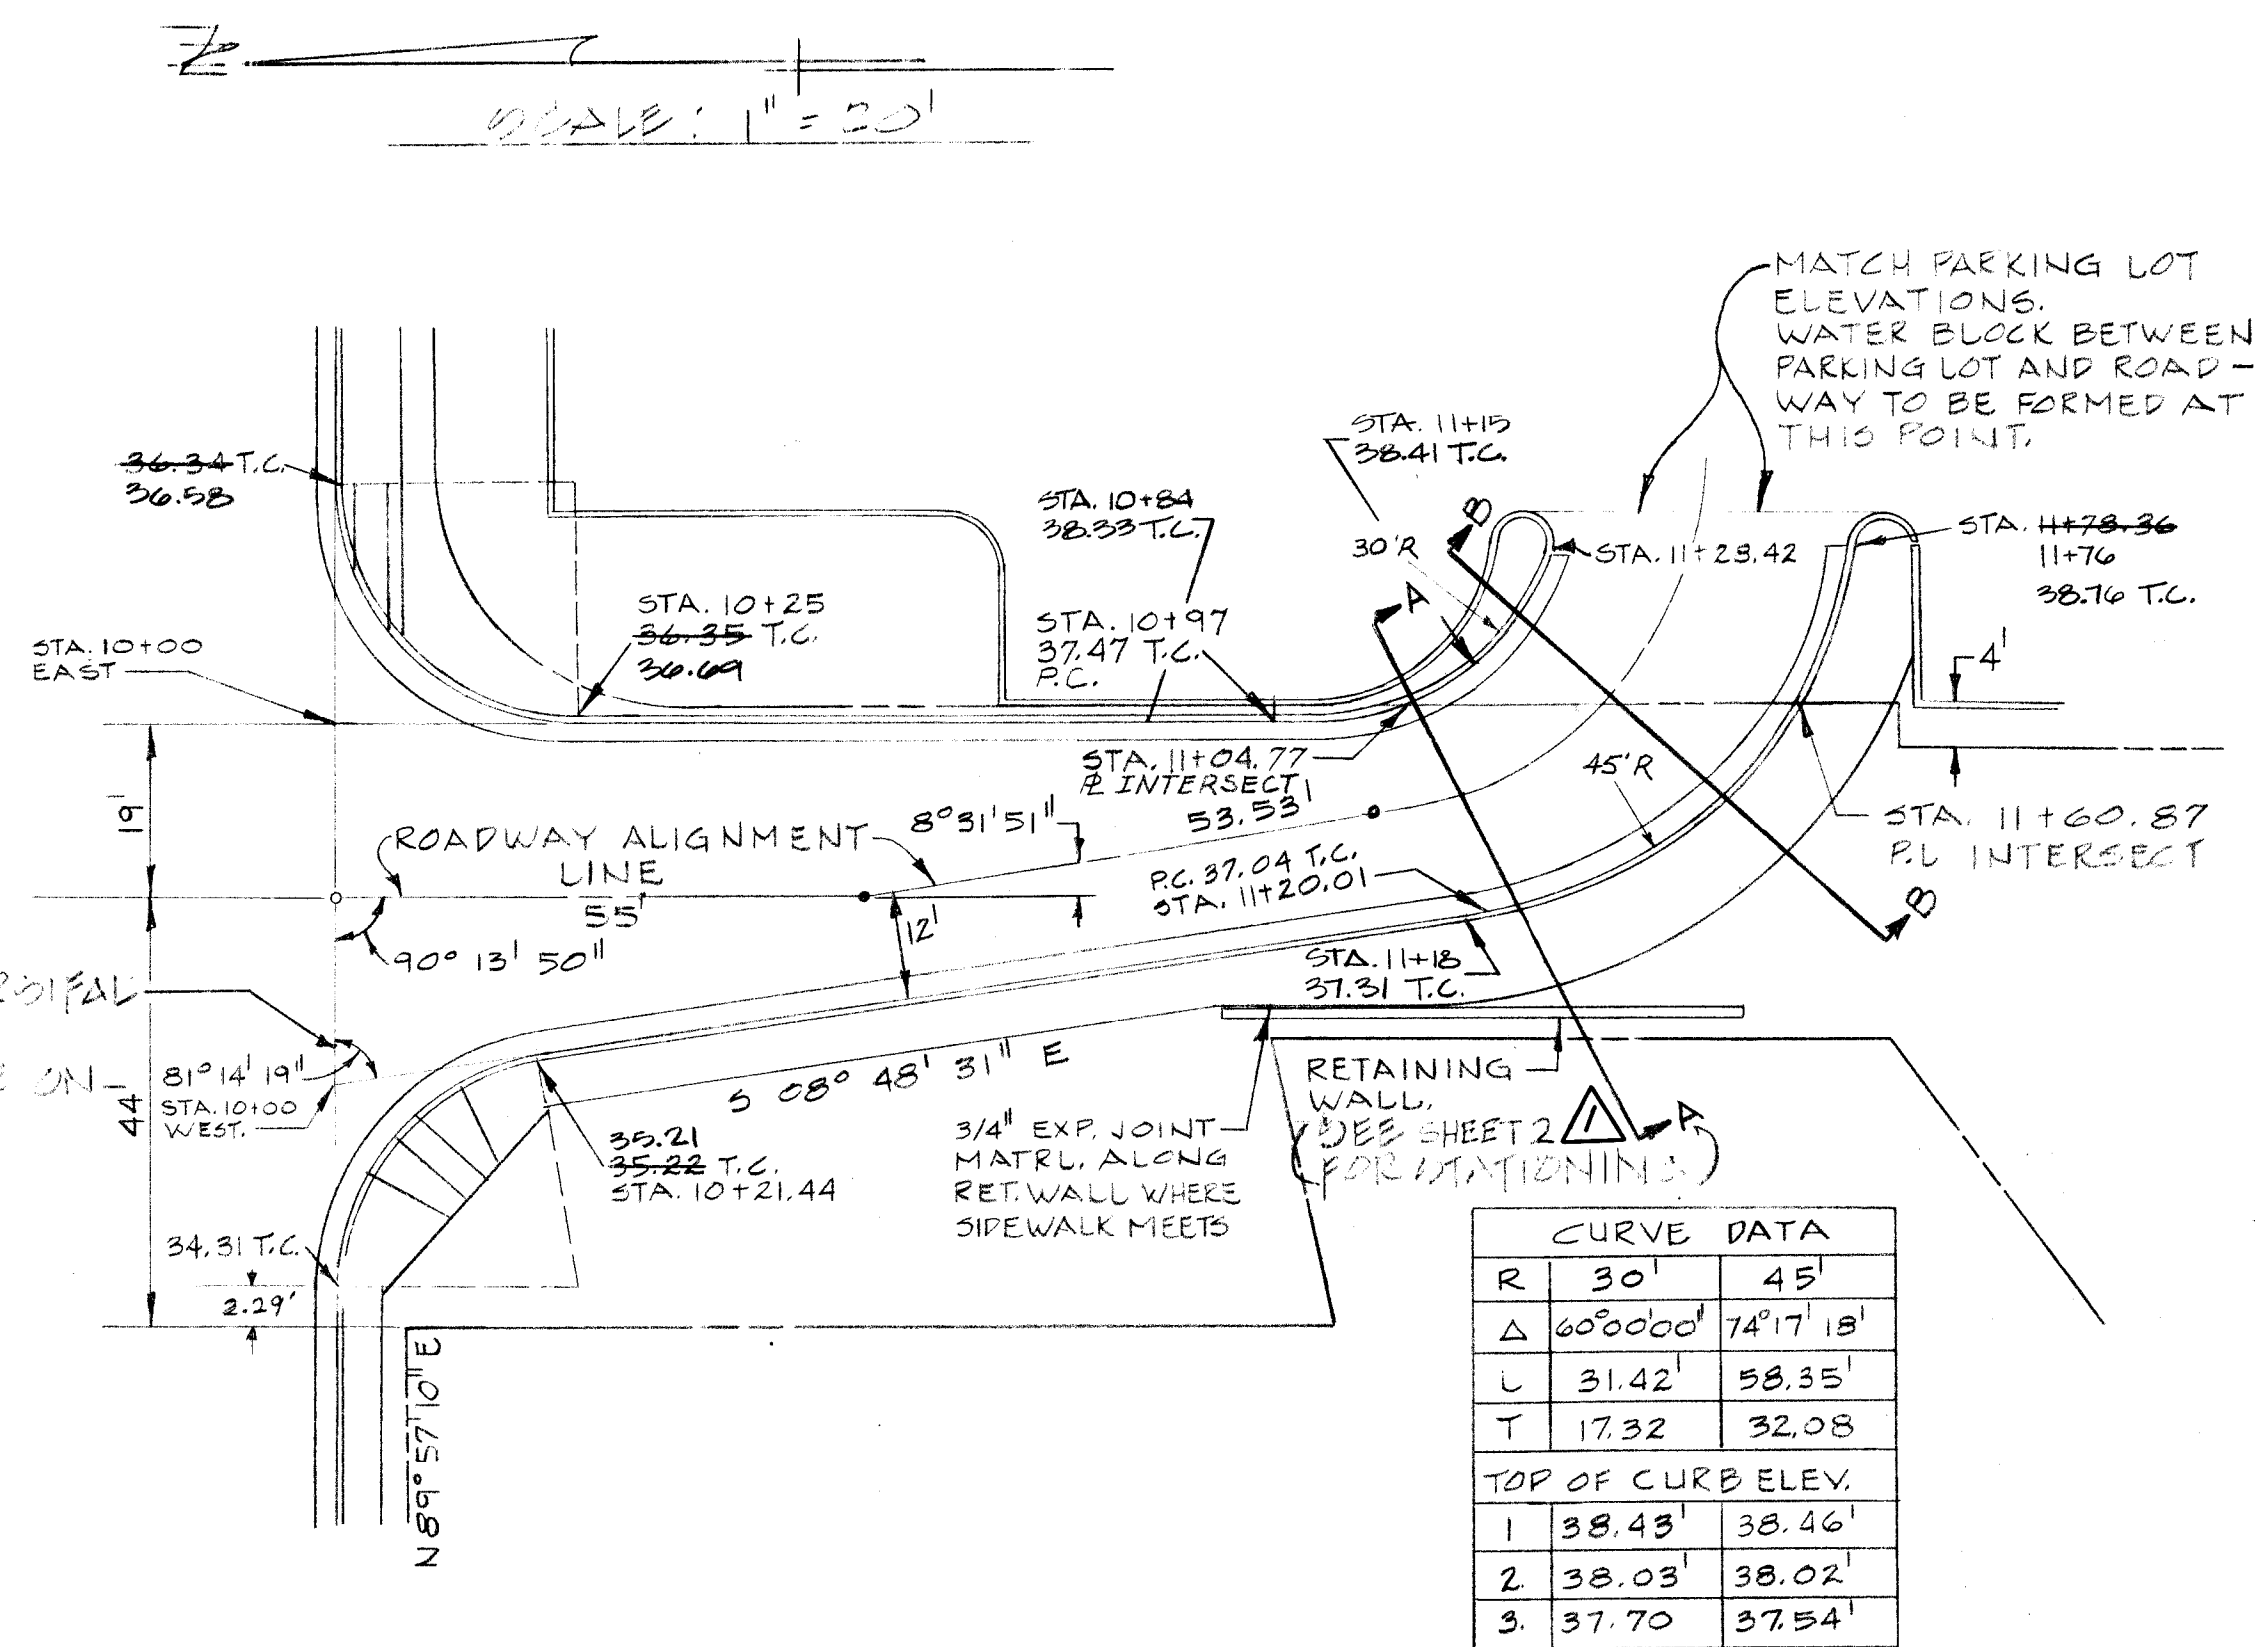



GENERAL NOTE

ALL WORK SHOWN BOTH ON AND OFF R.O.W. TO BE DONE BY A.M.E.A. CONTRACTOR. ONLY THE QUANTITIES SHOWN ON R.O.W. ARE TO BE USED IN DETERMINING CITY ENGINEERING FEES.

STATIONING NOTES:

STATIONING FOR E&W TOP OF CURB PROFILES BEGIN AT THE P.I.'S OF E&W R.L.'S WITH THE SOUTH E. OF MONTGOMERY. STATIONING INCREASES SEPARATELY ALONG BOTH E&W CURB ALIGNMENTS.

5538
5537
5536
5535
5534

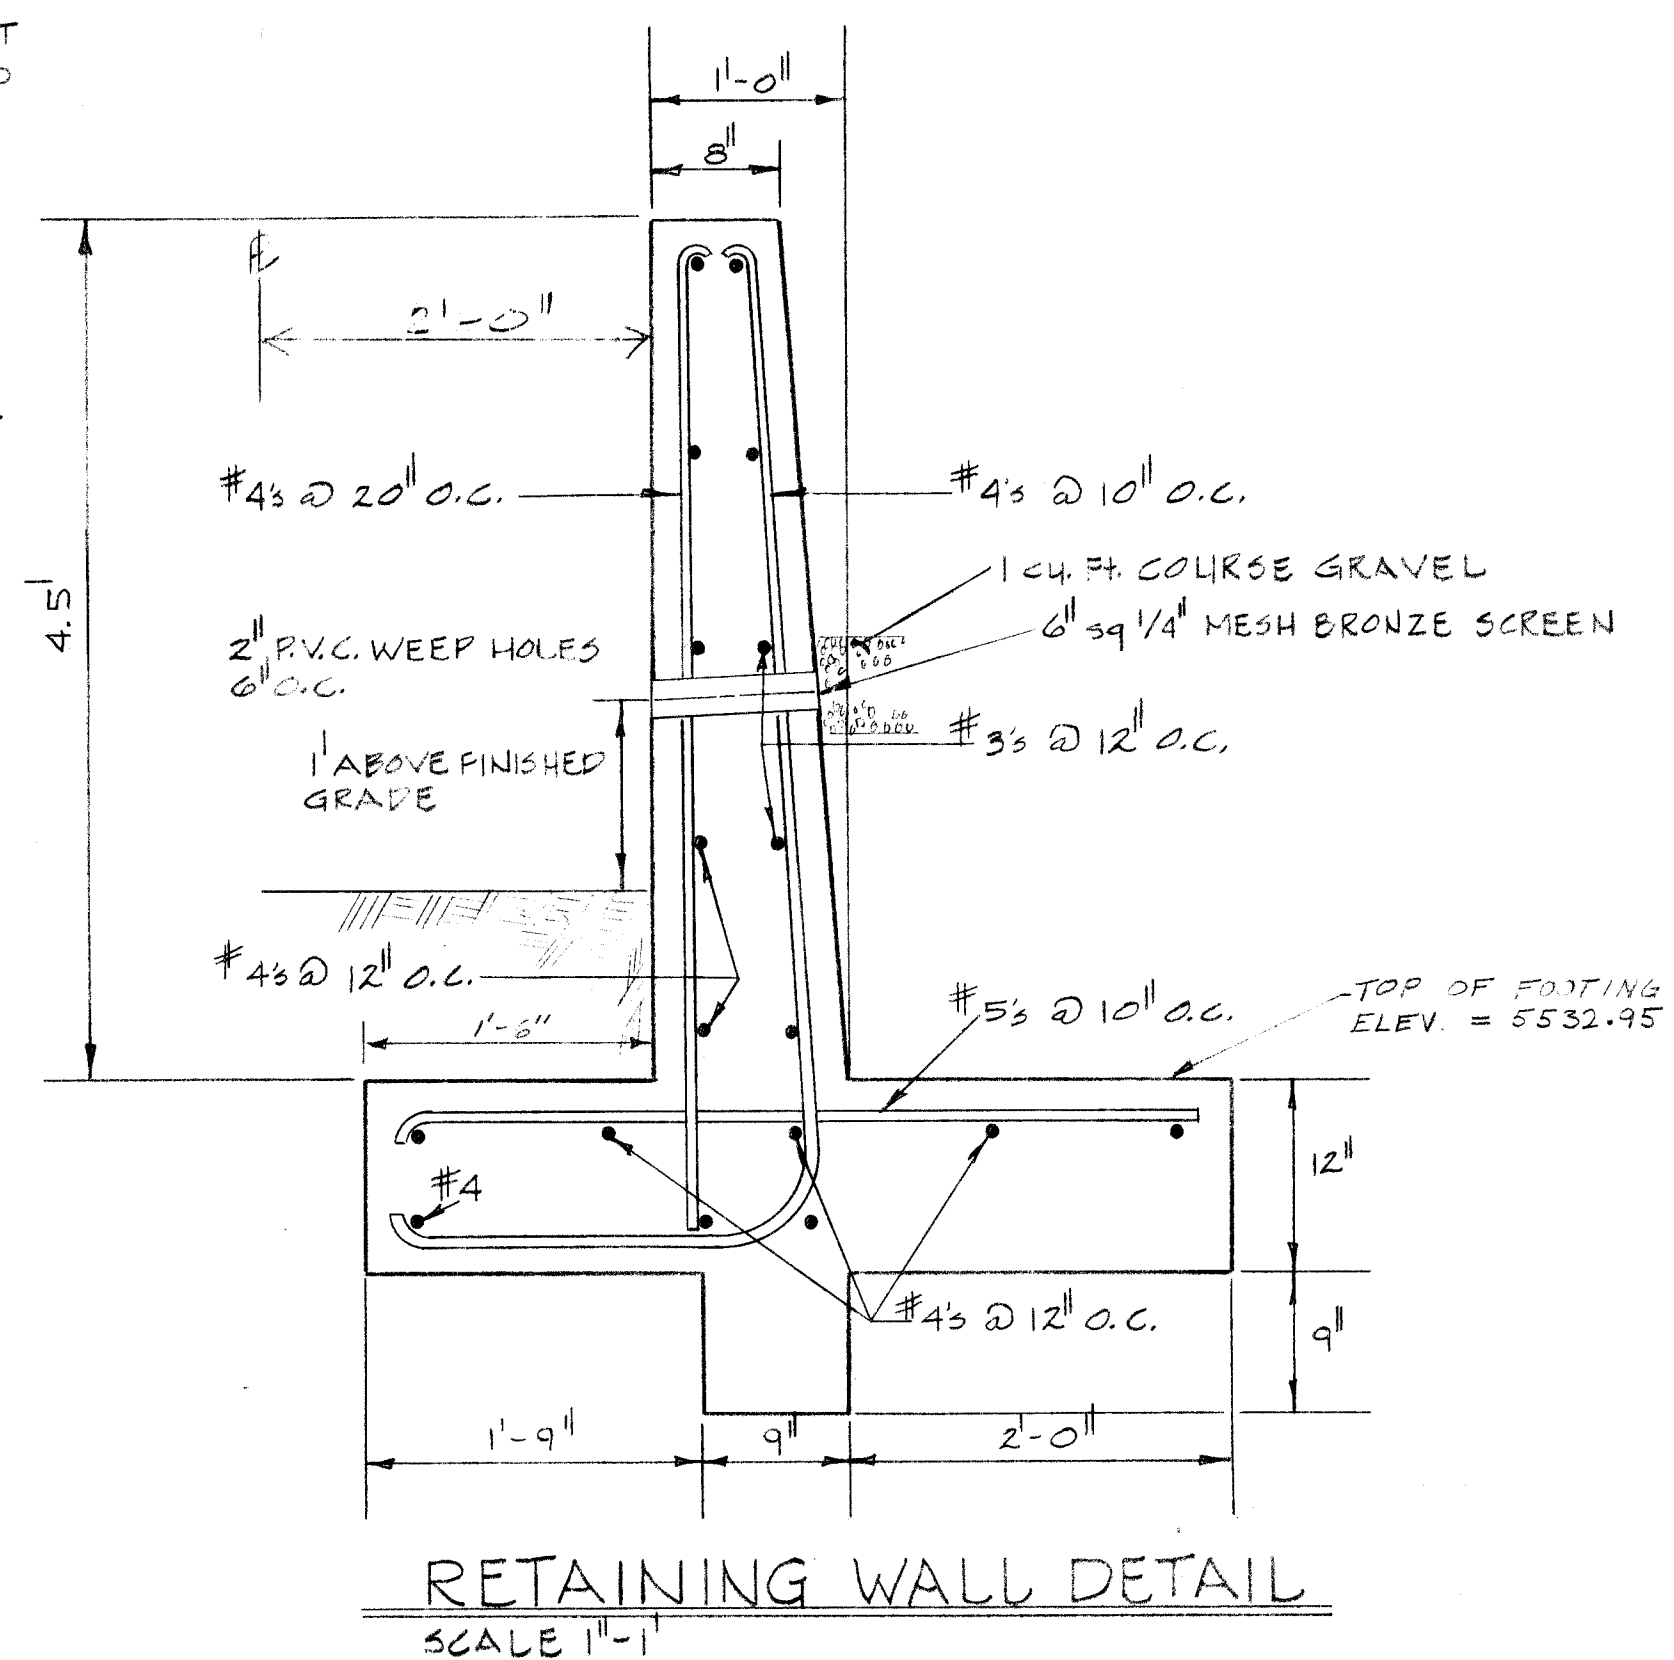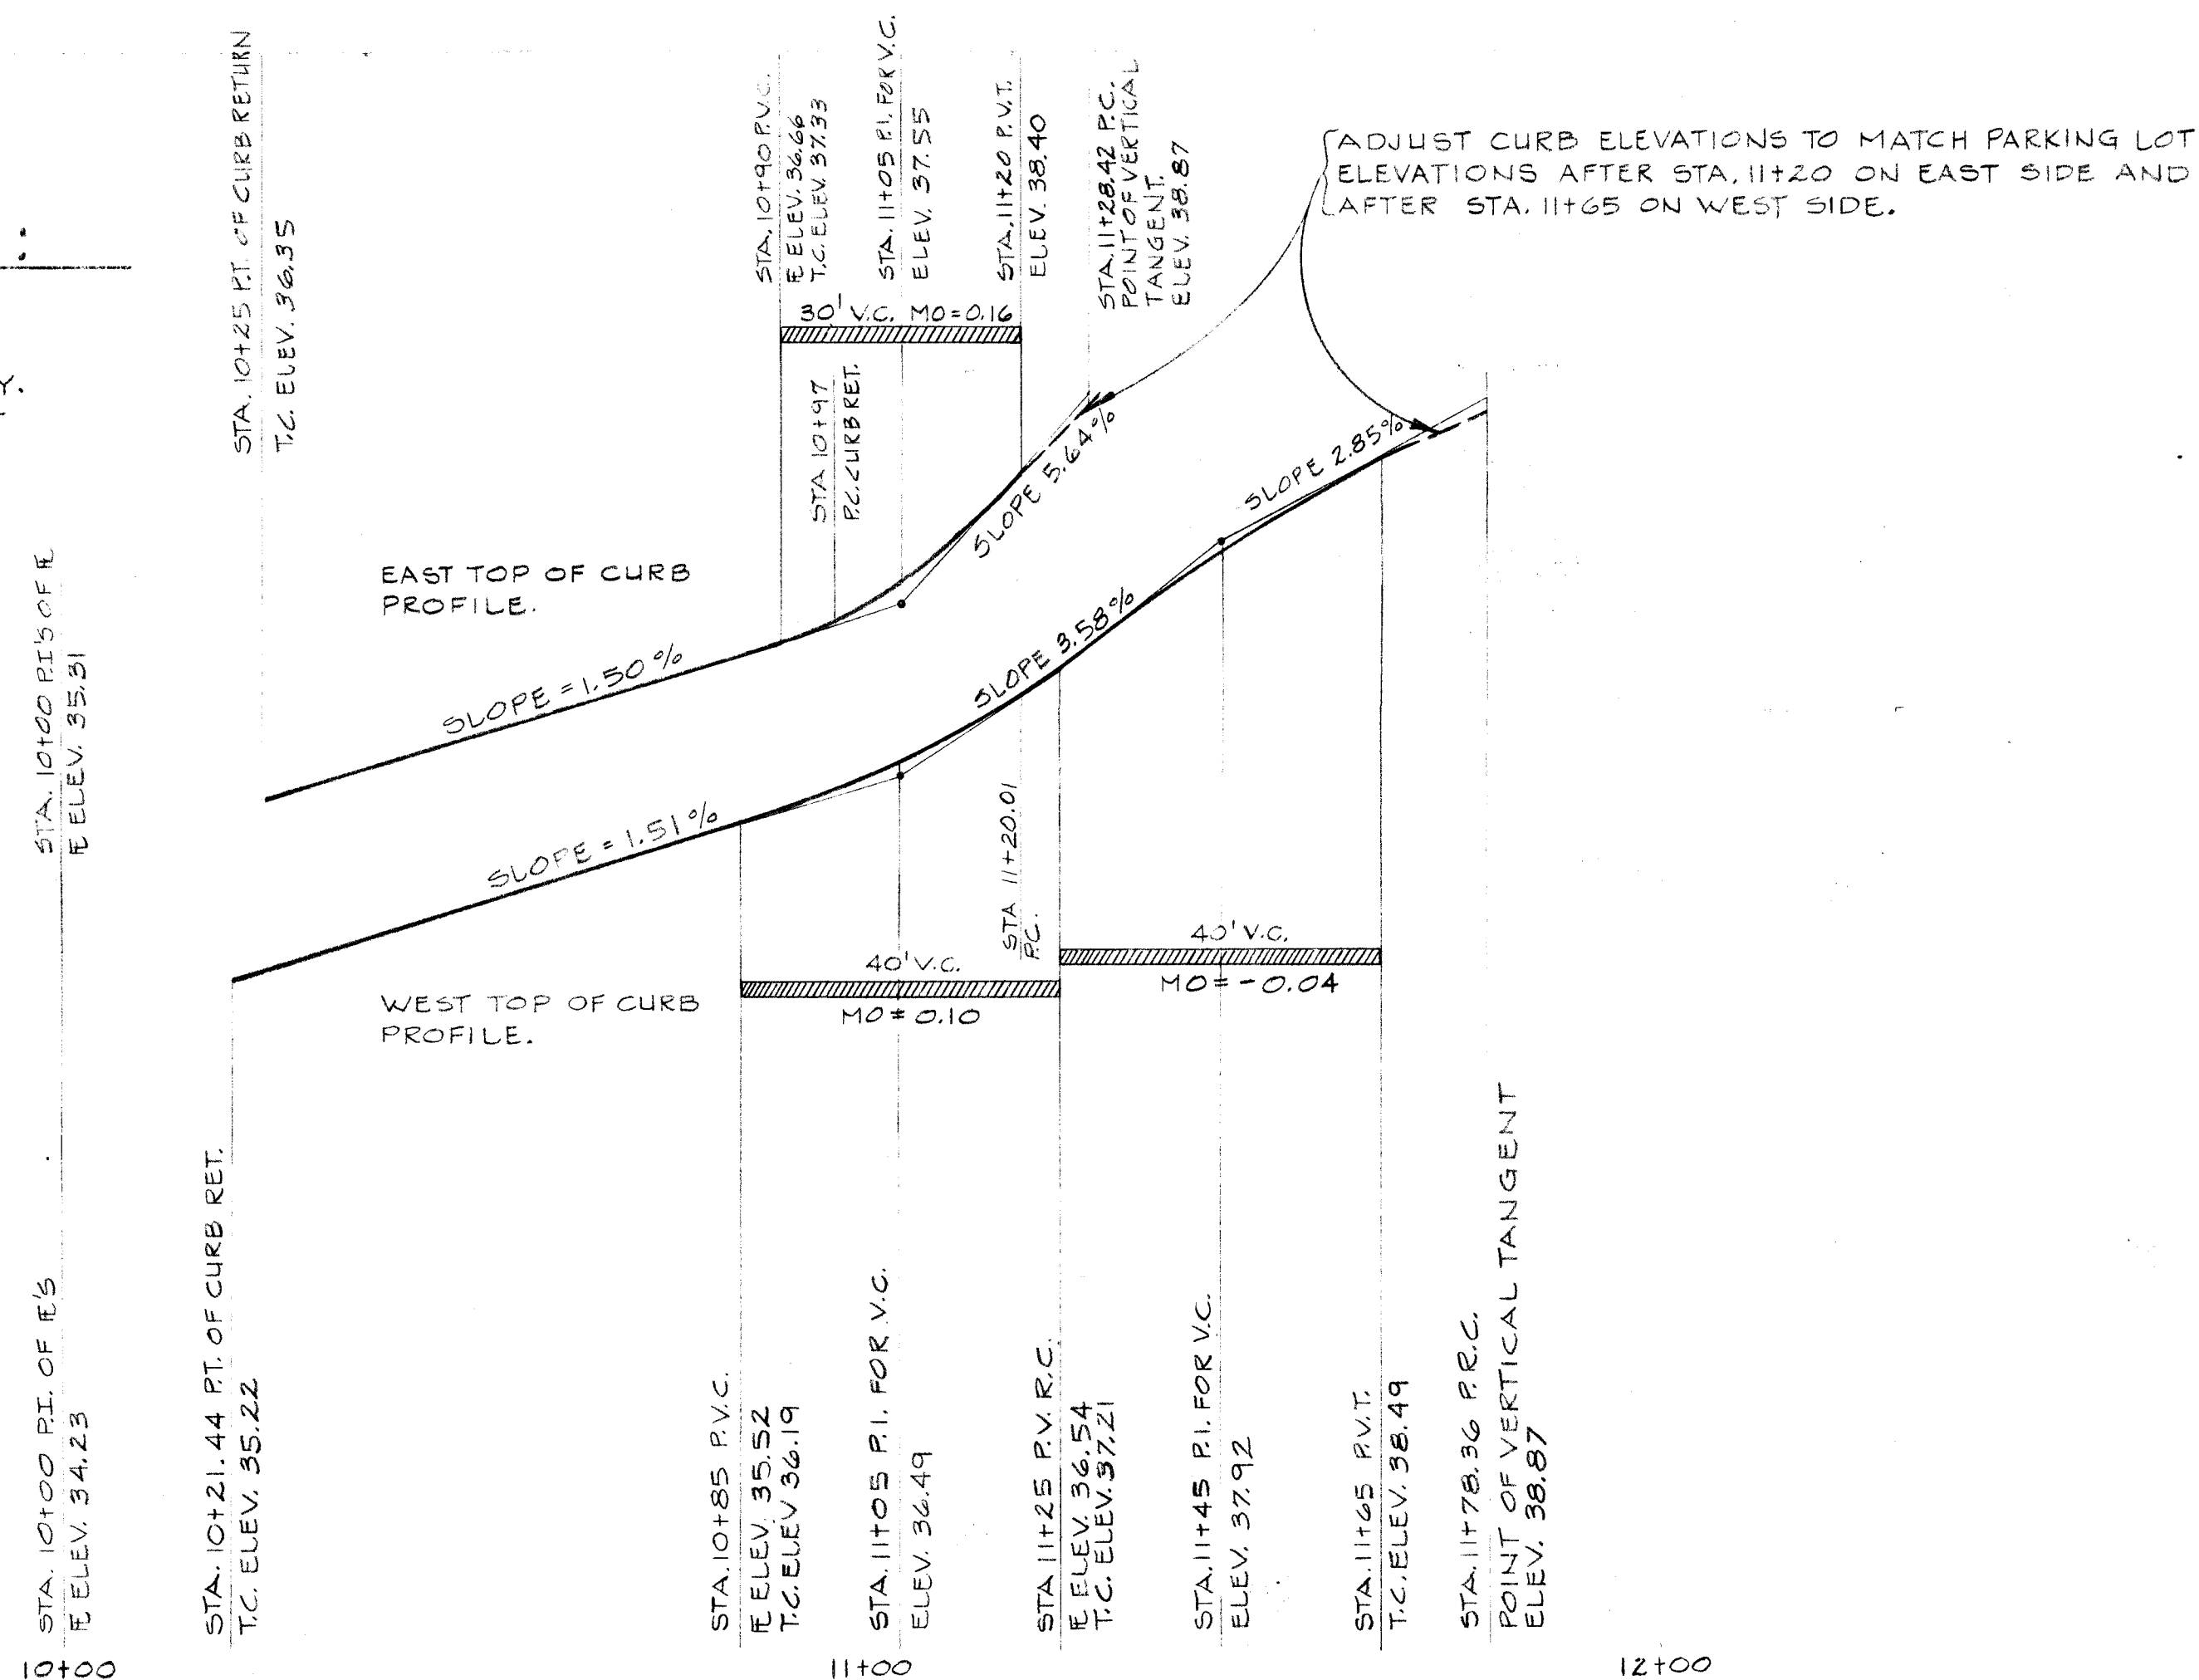

DETAILS AND PROFILE OF MEDIAN REVISION ON MONTGOMERY WEST OF EUBANK FOR SIERRA VISTA SHOPPING CENTER.

APPROVED FOR CONSTRUCTION
CITY ENGINEER
DATE

QA.

1227

6-20

3

3

8-3-83 VARIOUS CLARIFYING NOTES AND DETAILS.

PHIL FISCHER
STEVE R. CHAVEZ

12-81
12-81

WYLE CORP.

P.M. 12-20 ELEVATION: 5534.59

12-81

12-81

8-3-83 VARIOUS CLARIFYING NOTES AND DETAILS.

PHIL FISCHER
STEVE R. CHAVEZ

12-81
12-81

WYLE CORP.

P.M. 12-20 ELEVATION: 5534.59

12-81

12-81

8-3-83 VARIOUS CLARIFYING NOTES AND DETAILS.

PHIL FISCHER
STEVE R. CHAVEZ

12-81
12-81