


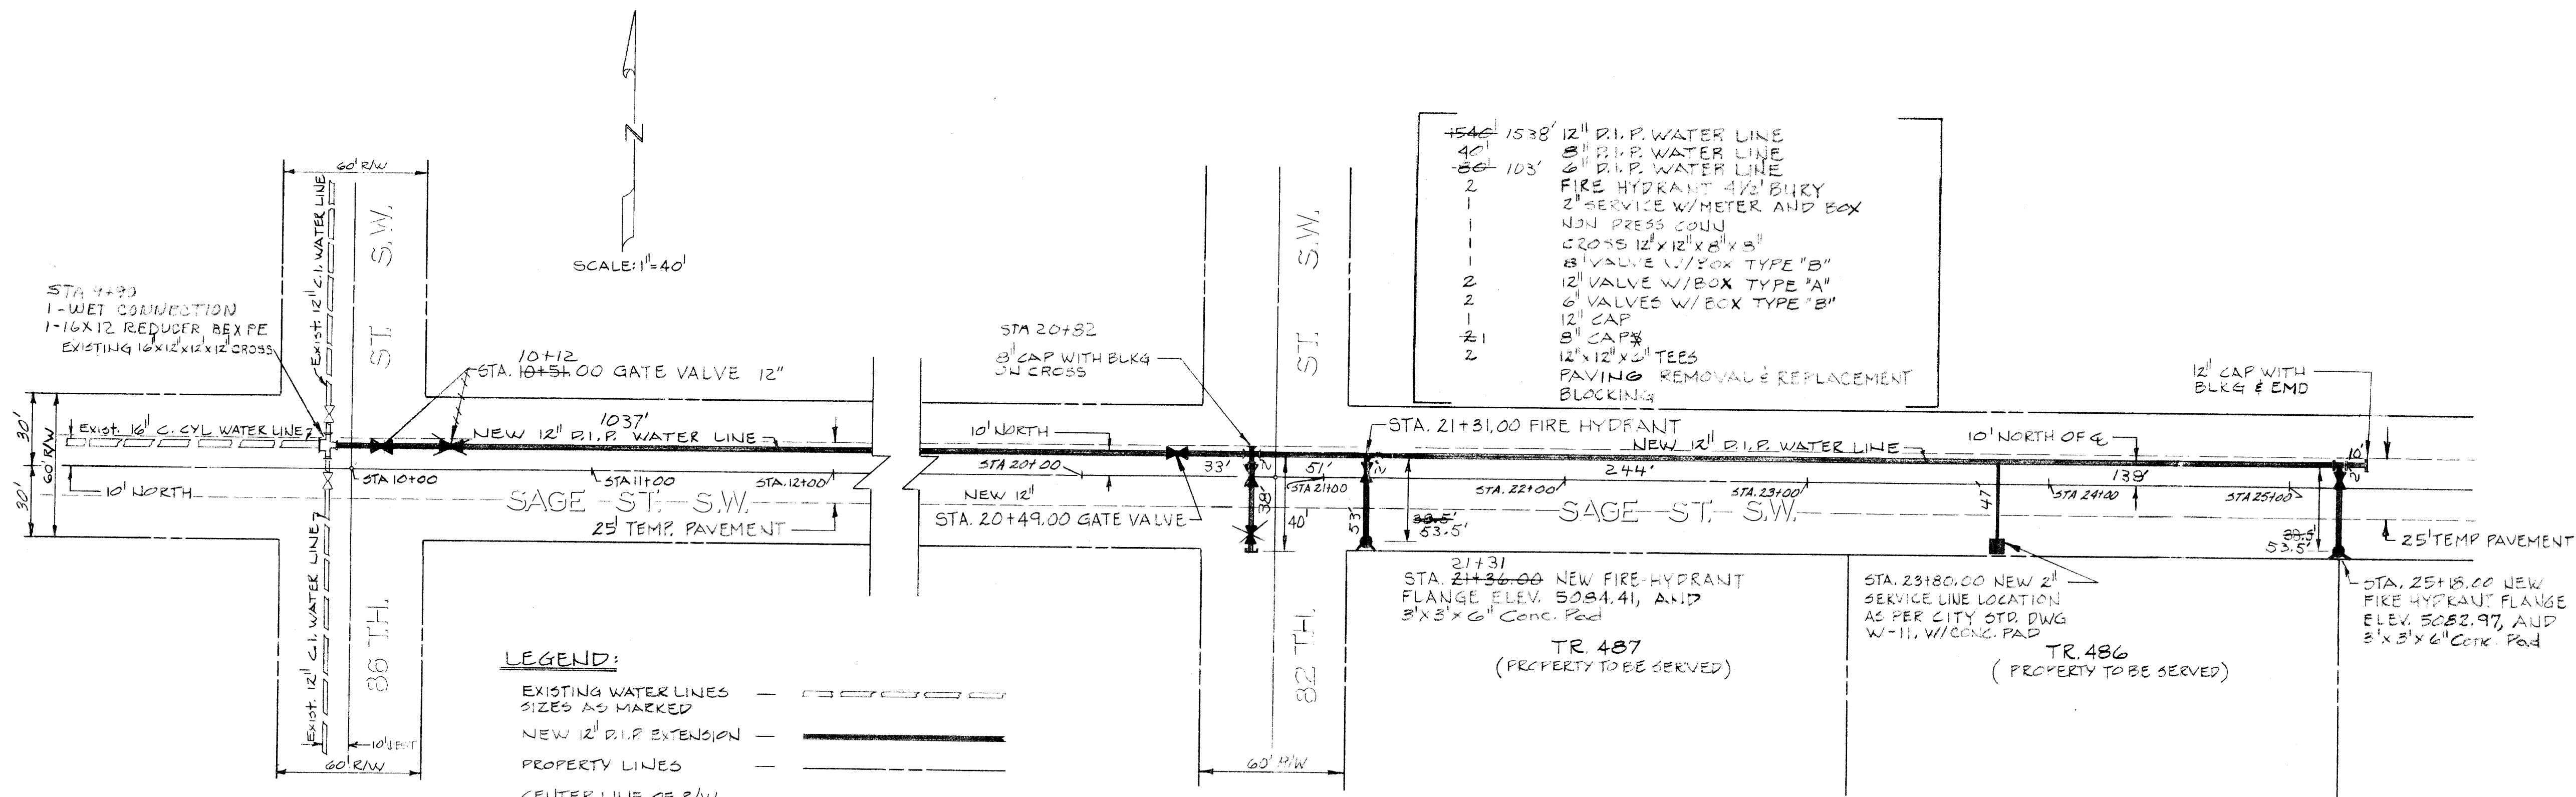

- 1538' 12" D.I.P. WATER LINE
- 40' 8" D.I.P. WATER LINE
- 103' 6" D.I.P. WATER LINE
- 2' FIRE HYDRANT 4 1/2" BURY
- 2' SERVICE W/METER AND BOX
- 10' PRESS COUPL
- 2' CROSS 12" 12" X 8" X 8"
- 2' VALVE 1" / BOX TYPE "B"
- 2' VALVE W/BOX TYPE "A"
- 2' VALVES W/BOX TYPE "B"
- 2' 12" CAP
- 2' 8" CAP
- 2' 12" X 8" TEES
- 2' PAVING REMOVAL & REPLACEMENT
- 2' BLOCKING

LEGEND:

EXISTING WATER LINES
SIZES AS MARKED

NEW 12" D.I.P. EXTENSION

PROPERTY LINES


CENTER LINE OF R/W

CROSS SIZES & TYPE AS MARKED

NOTES:

1. PRIOR TO CONNECTION OF NEW 12" D.I.P. WATER LINE VALVES AT INTERSECTIONS OF SAPPHIRE ST & SAGE, AND BLAZICK & SAGE MUST BE TURNED OFF.

2. NEW WATER LINE EXTENSION TO EAST PROPERTY LINE OF TR. 486, APPROX. 1600 FEET EXISTING CROSS.

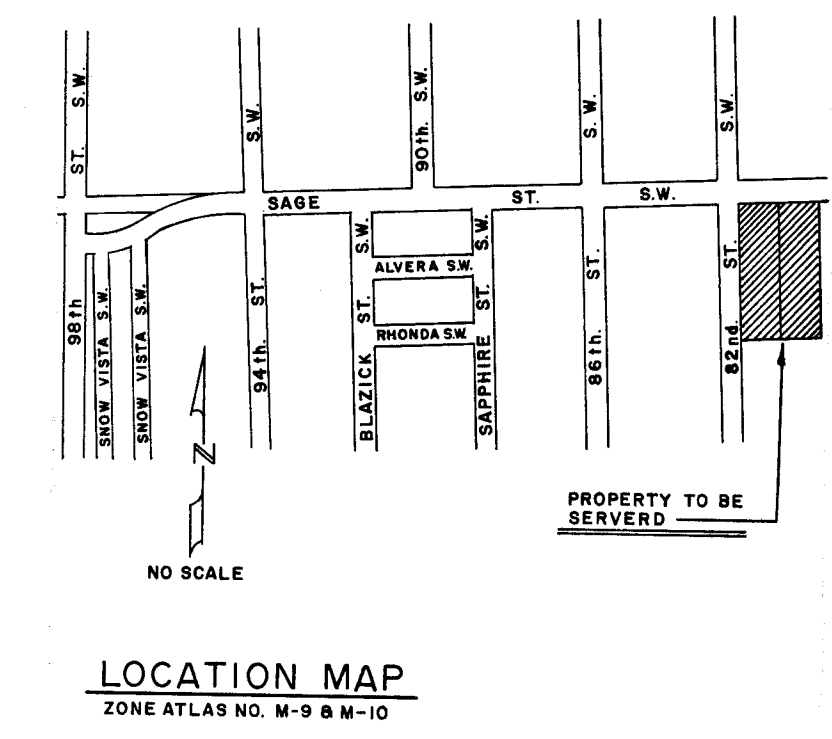


J. Johnson 9/82
P. Romero 10/82

B.M. 1-M-10 BRASS CAP S.E. COR. 75 TH. & SAGE ELEV. 5079.90

12-21-81
ANGEL P. ROMERO
D. MCCANN

PS-25
" "

PHIL FISCHER
STEVE CHAVEZ

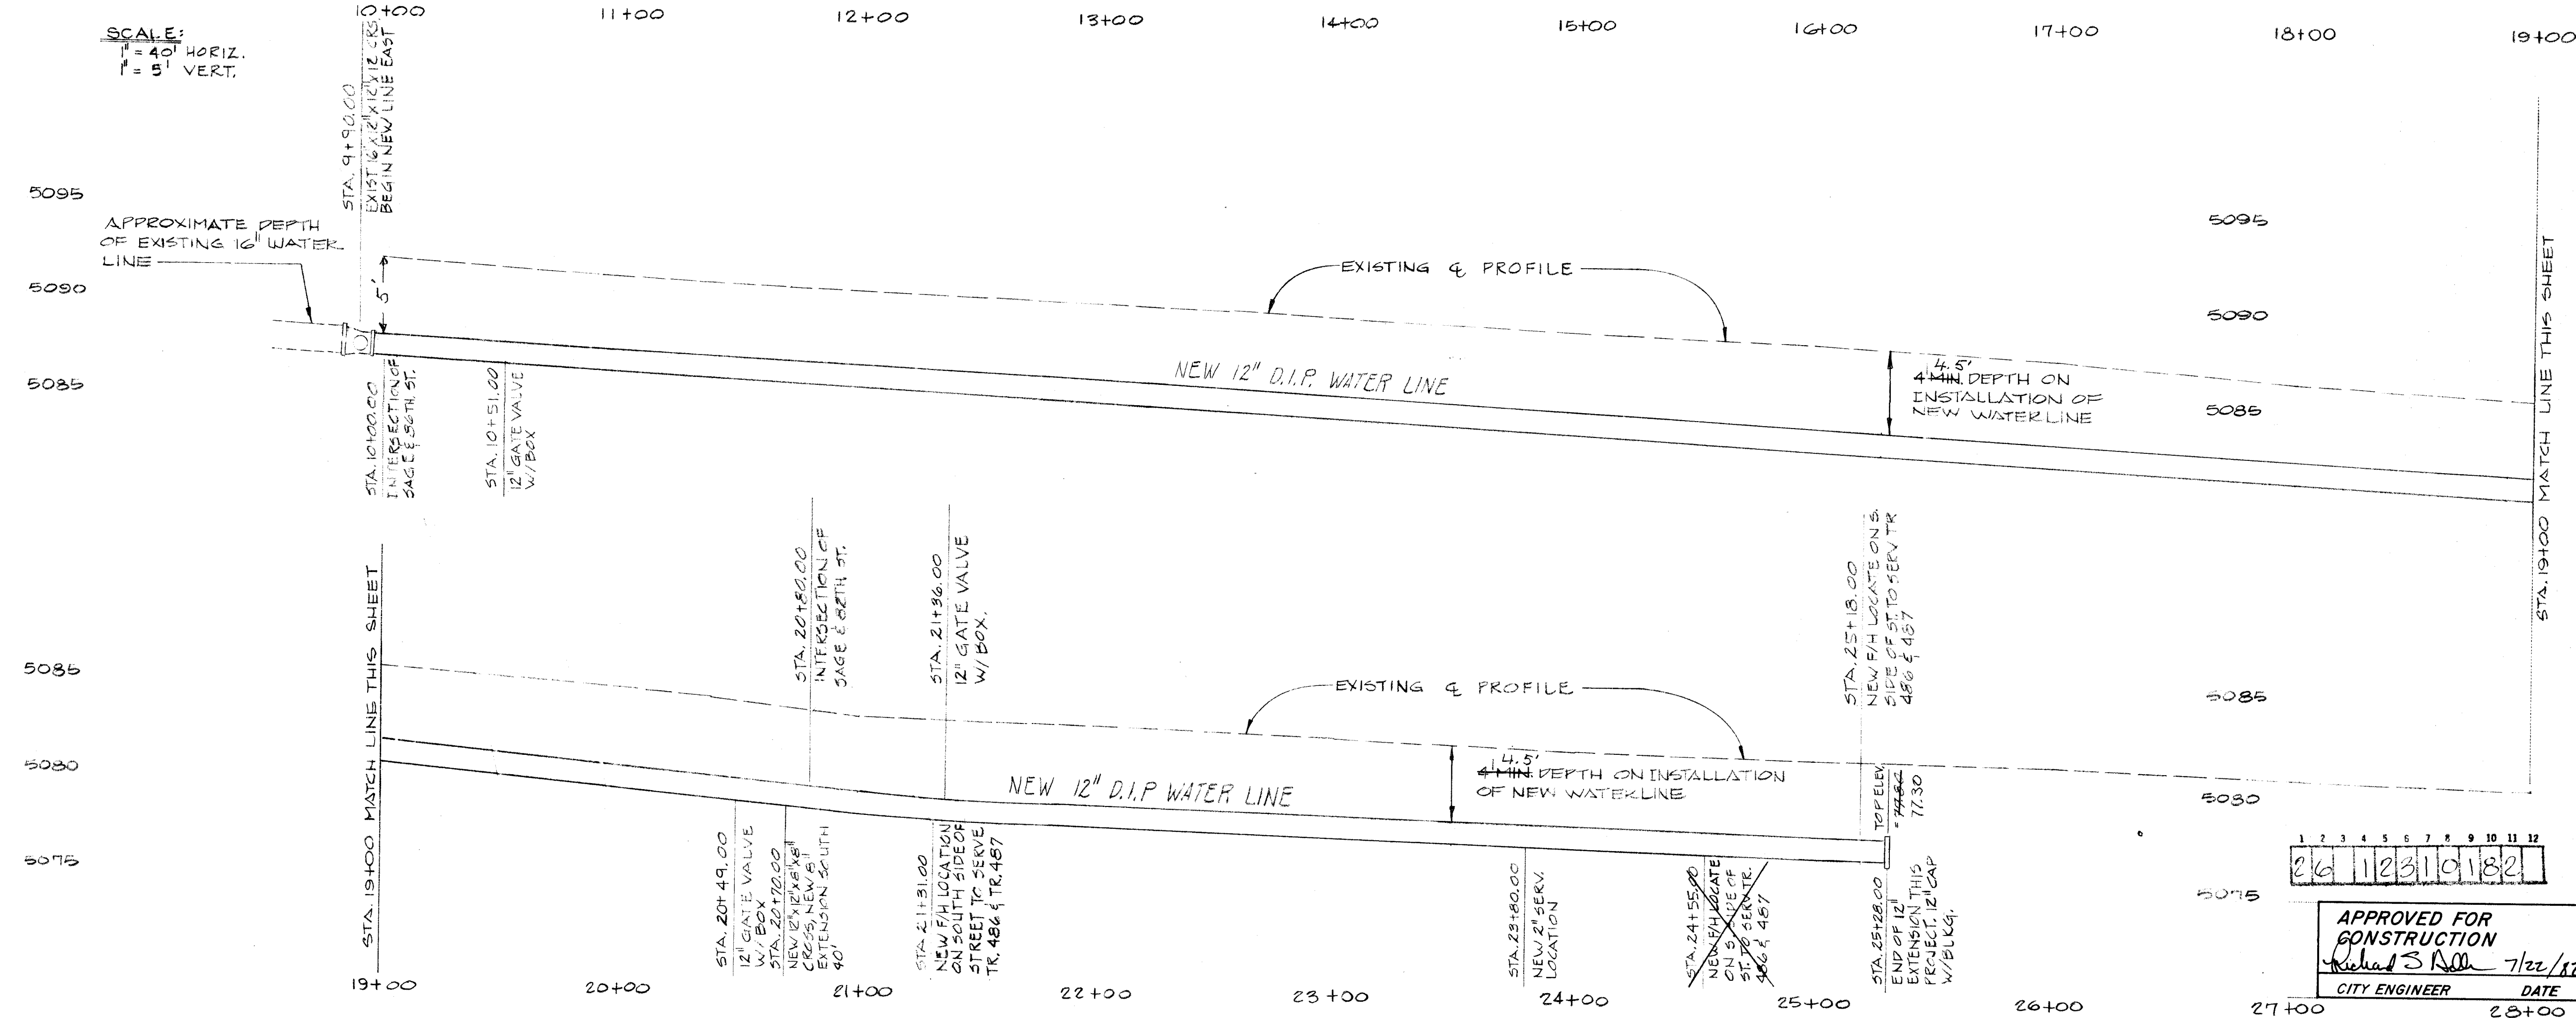

1	2	3	4	5	6	7	8	9	10	11	12
26	12	31	01	82							

APPROVED FOR CONSTRUCTION
Richard S. Allen 7/22/82
CITY ENGINEER DATE

APPROVAL OF AS BUILT DRAWINGS
DATE 8/2/82

WATER LINE EXTENSION ON SAGE S.W. FROM INTERSECTION OF 86TH ST. & SAGE EAST 1600 FT. EAST TO EAST PROPERTY LINE TR. 486