


FINAL
SURVEY
NOTED
NO.


SCALE: 1"=20' (HORIZ.)
1"=1' (VERT.)



THE ARDENS ADDN.

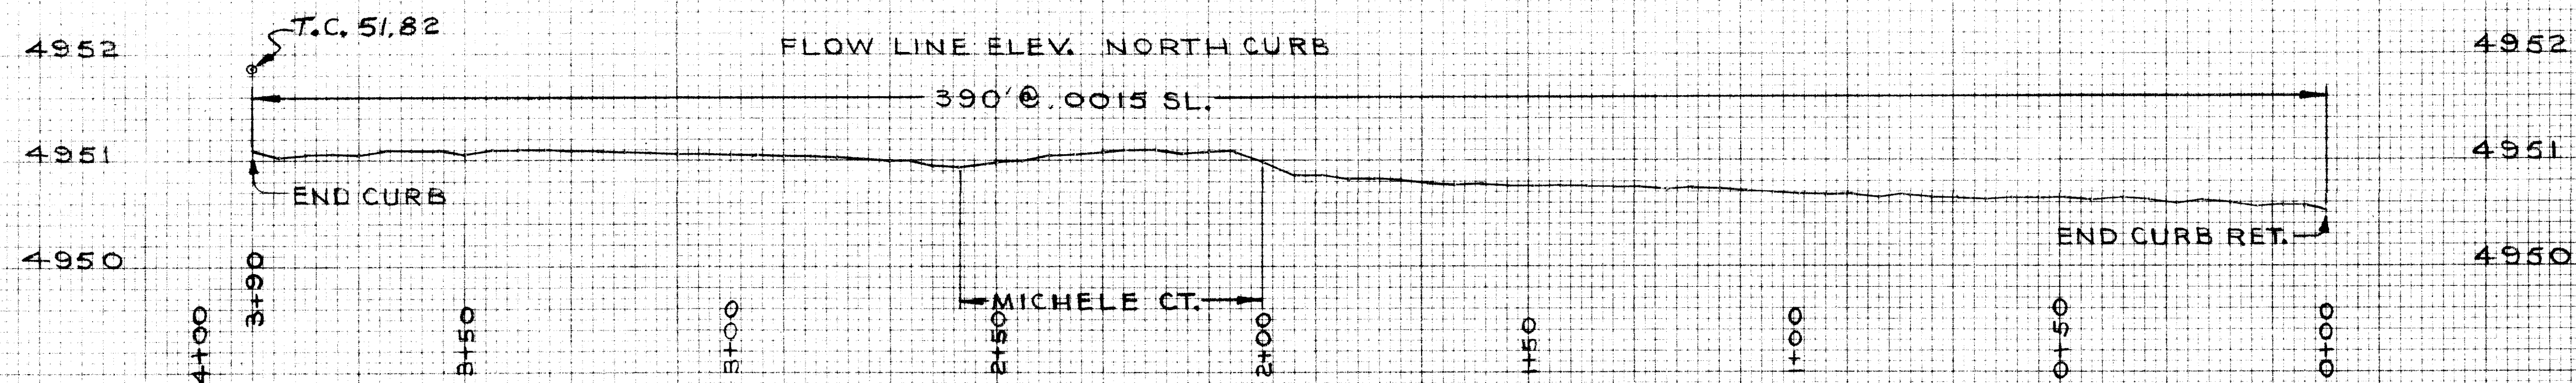

OLYMPIA RD., N.W.

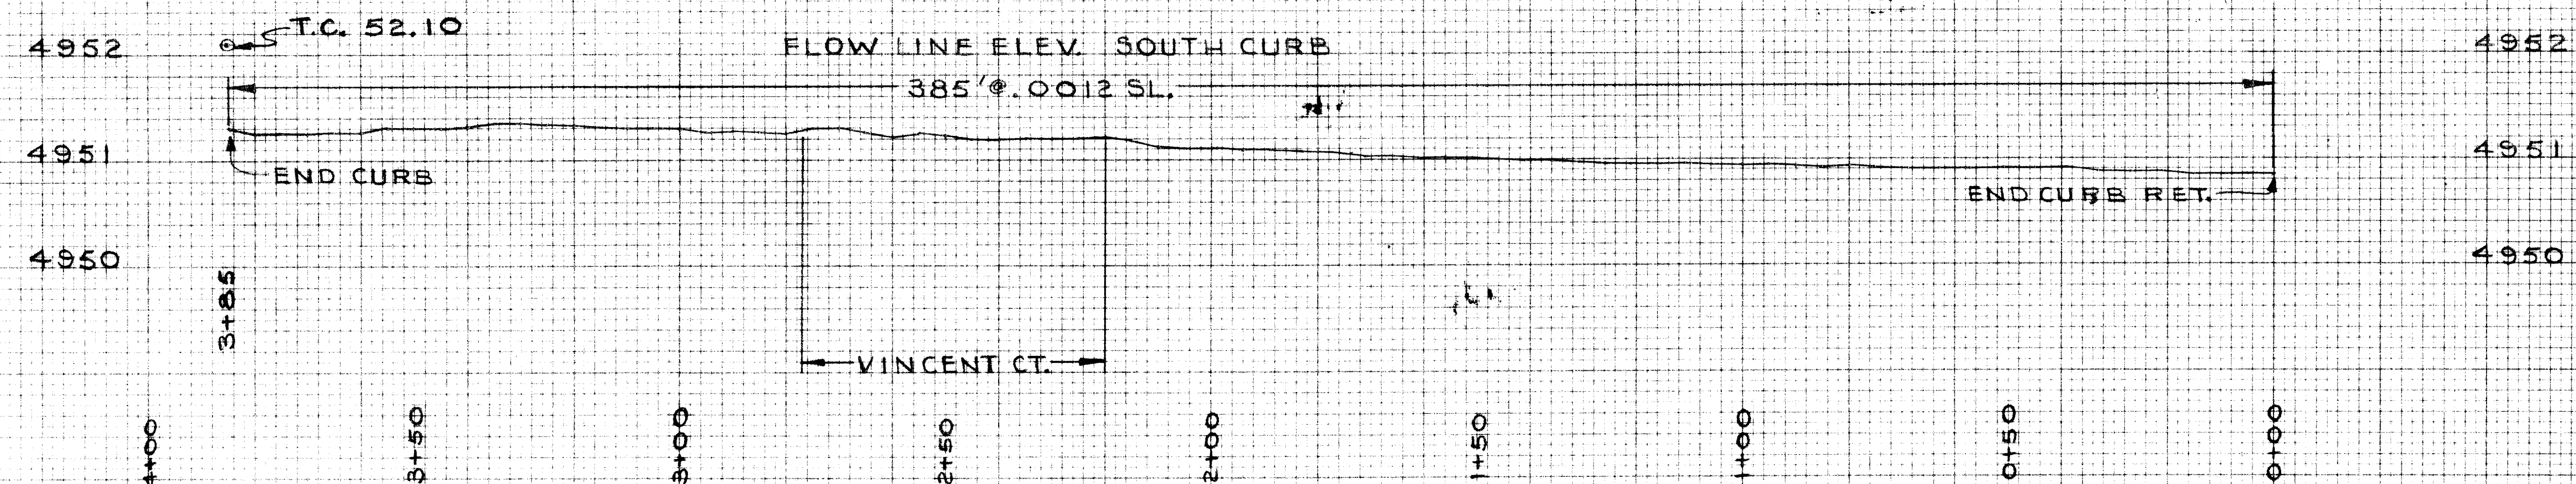

ORIGINAL
SURVEY
NOTED
NO.

BY LASUN

04 1 1 2 3 1 1 0 4 7 0 1 1 1 5 8 1 1 2