



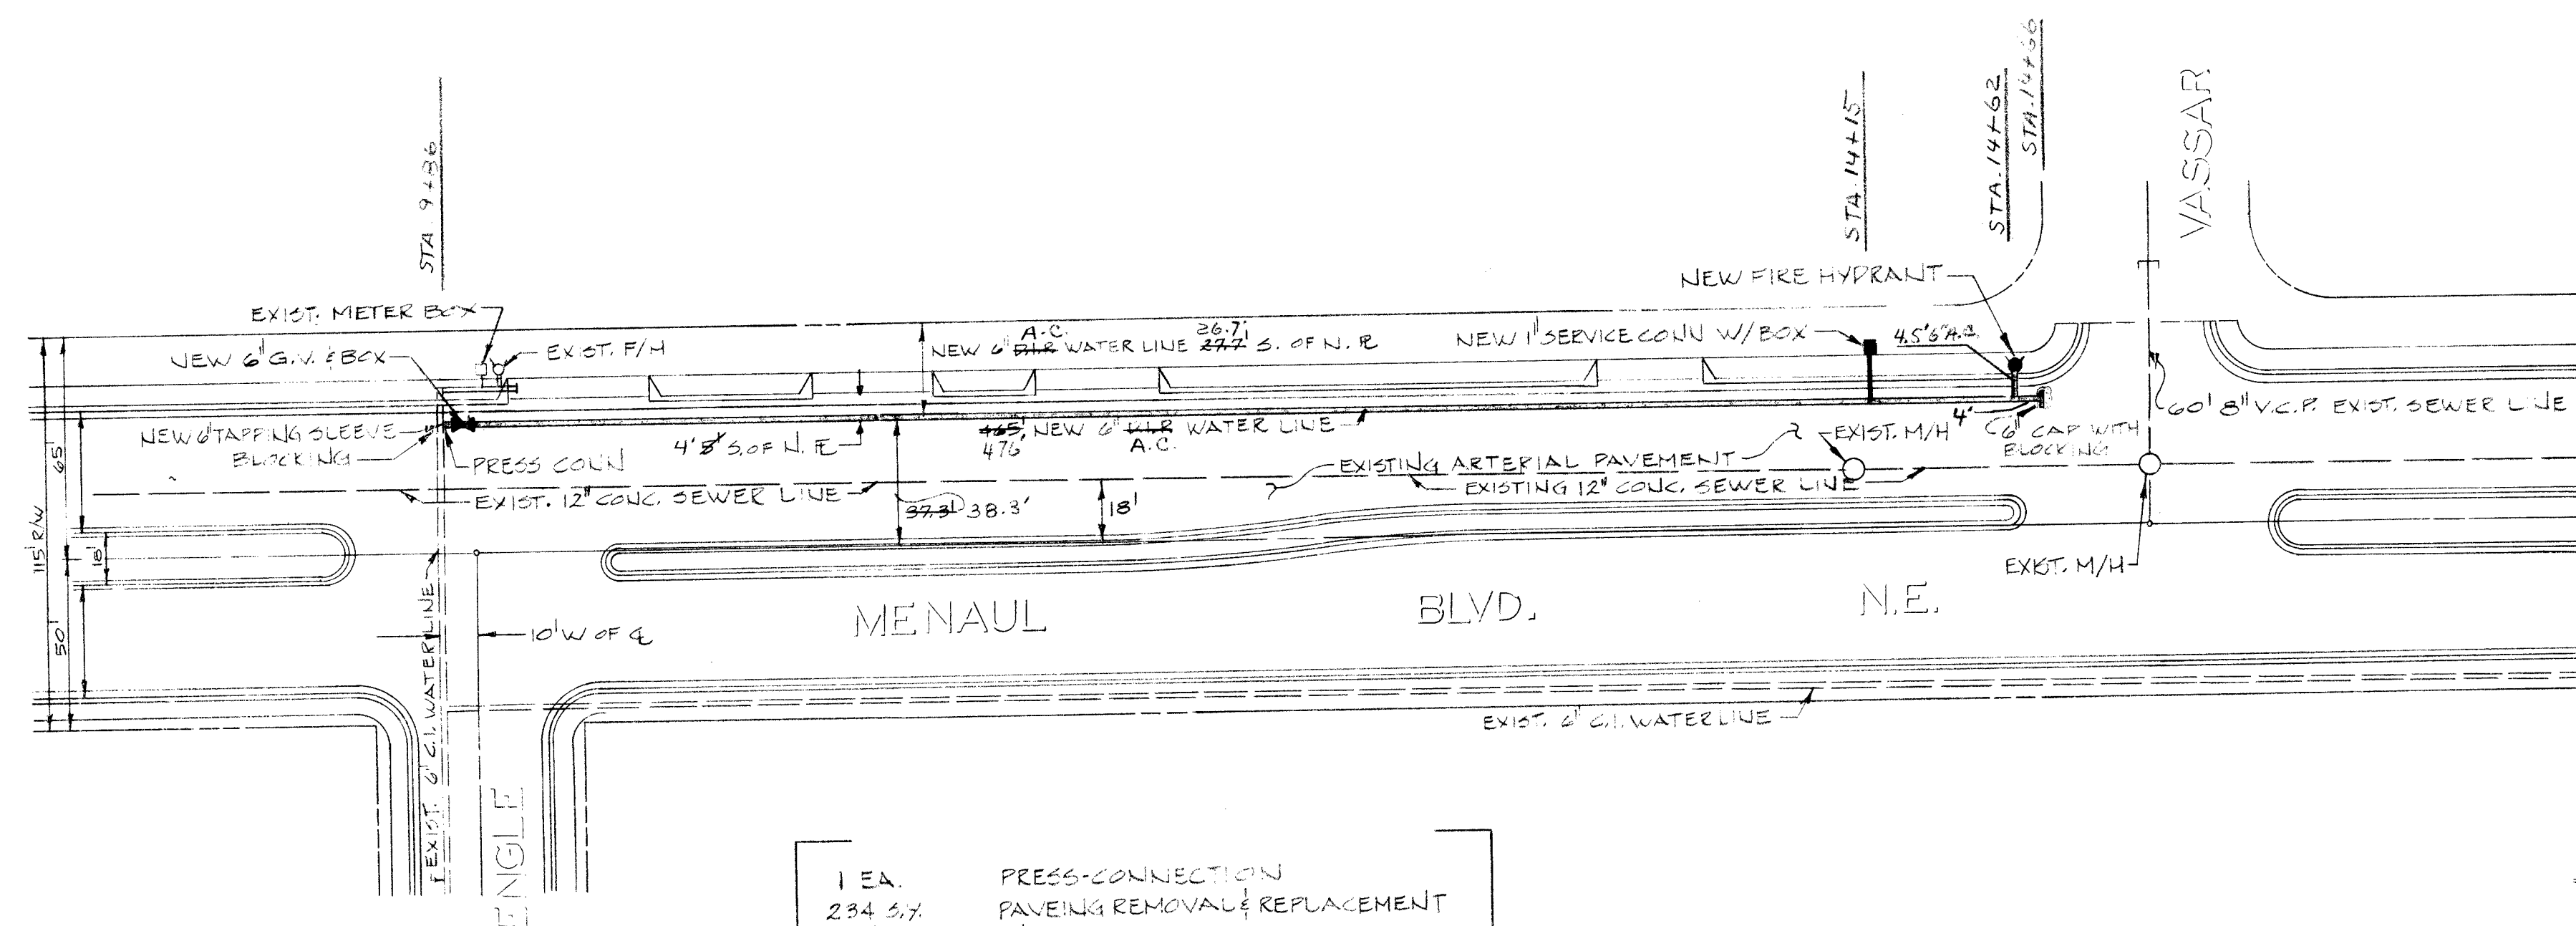


NOTE:
ELECTRONIC MARKER DISKS INSTALLED
AS SPECIFIED IN SECTION 131, OF CITY
OF ALBUQUERQUE CONTRACT DOCUMENTS
FOR CITY-WIDE UTILITIES AND CASH
PAVING 100.30

- | | |
|-----------|---------------------------------------|
| 1 EA. | PRESS-CONNECTION |
| 234 3/4 | PAVING REMOVAL & REPLACEMENT |
| 405' L.F. | 6" D.I.P. |
| 1 EA. | 6" CAP |
| 1 EA. | FIRE HYDRANT 4 1/2" FURY |
| 1 EA. | 6" GATE VALVE & BOX |
| 1 EA. | 6" TAPPING SLEEVE |
| 1 EA. | 1" SINGLE SERVICE LINE WITH METER BOX |
| 1 EA. | BLOCKING |


LEGEND:

- | | |
|--|---|
| | EXISTING STANDARD CURB & GUTTER AND 6" SIDEWALK |
| | EXISTING MEDIAN CURB & GUTTER |
| | EXISTING WATER LINE SIZES AS MARKED |
| | EXISTING FIRE HYDRANT |
| | EXISTING PROPERTY LINES |
| | EXISTING CENTER LINE OF R/W |
| | PROPOSED 6" DIP WATER LINE |
| | PROPOSED 1" SERVICE CONN. W/ BOX |

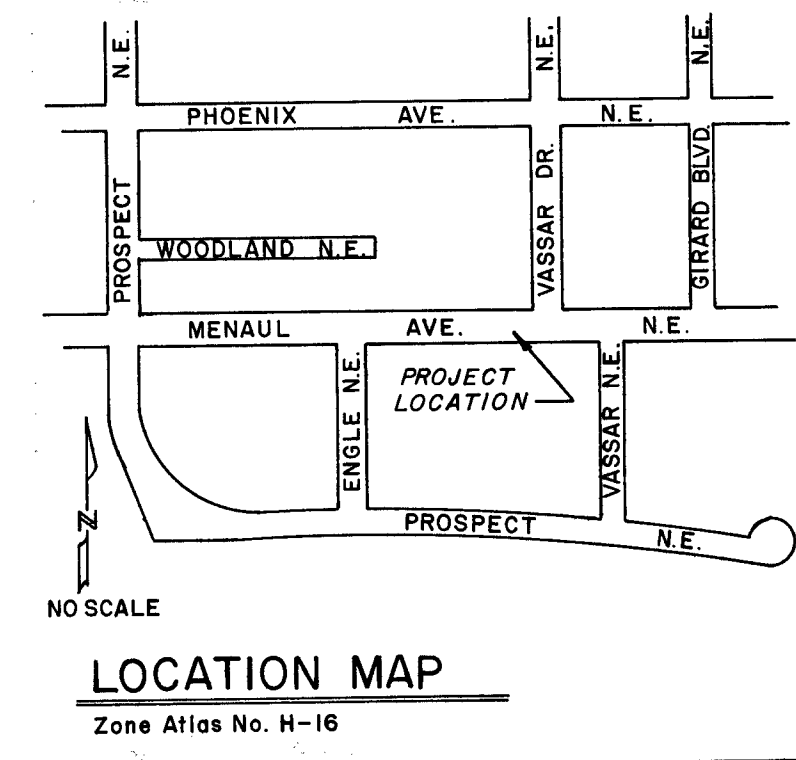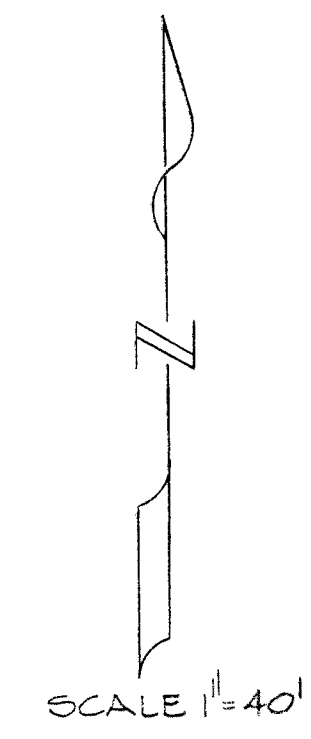

I-40-12, CENTER OF MEDIAN, MENAUL AT
NORTH DIVISION CHANNEL: 5114.55'
CBM, 0 CUT EYE RET. MENAUL &
VASSAR: 5091.67

5095
5090
5085
5080
5075

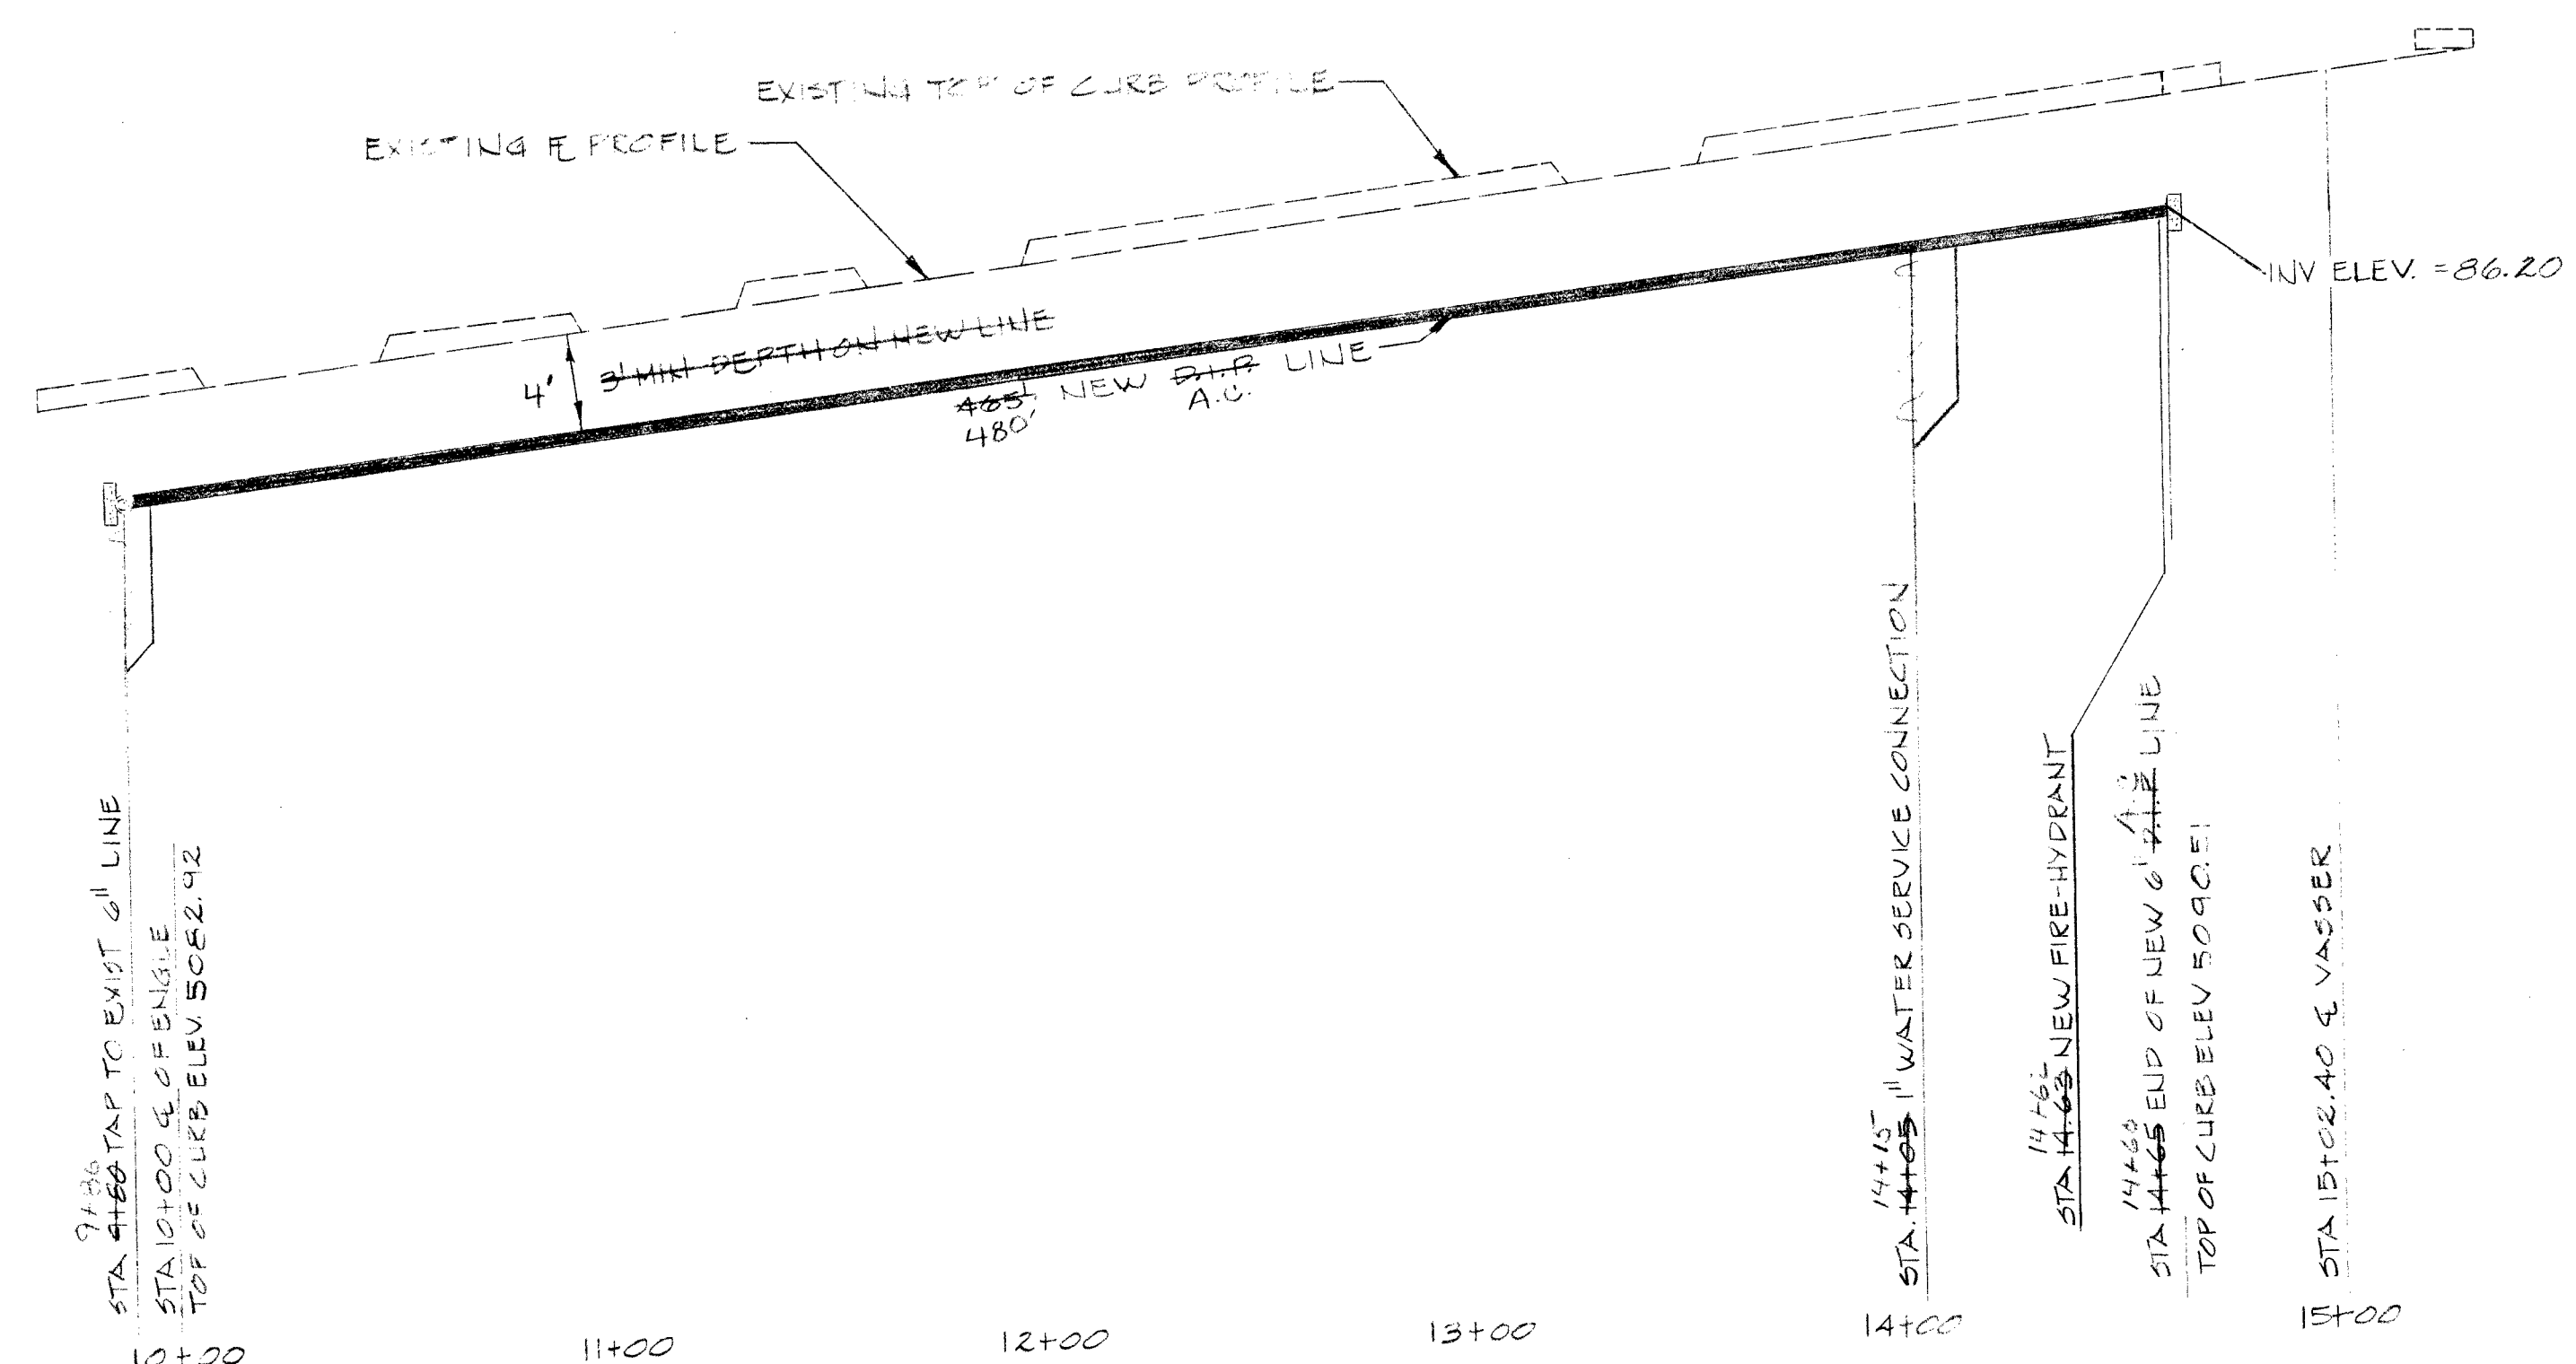

NOTE:

THE CONTRACTOR MUST SUBMIT
A CONSTRUCTION SIGNING AND
BARRICADE PLAN TO TRAFFIC
ENGINEERING AND RECEIVE A
BARRICADE PERMIT PRIOR
TO CONSTRUCTION IF POSSIBLE.
THIS WORK SHOULD BE DONE
AT SAME TIME AS WORK
UNDER SAS 195 IS DONE.

1	2	3	4	5	6	7	8	9	10	11	12
2	0	1	2	4	3	0	1	8	1		

McKenna
12-23-01

APPROVED FOR
CONSTRUCTION
Richard S. Hall 10/24/01
CITY ENGINEER DATE

6" WATER LINE EXTENSION ON MENAUL BLVD.
FROM ENGLE DR. EAST TO VASSAR DR. N.E.

Ch. Eddy 9/13/01
Ch. Eddy 9/13/01

H/A
T. W. Penney 9/13/01
D. M. Mendenhall 9/13/01

1243 H-16

PHIL FISCHER
STEVE CHAVEZ
9/81
9/81